

# STATE OF OHIO DEPARTMENT OF TRANSPORTATION

## WAR-SR 63-IORY

CITY OF MONROE  
WARREN COUNTY

### PROJECT DESCRIPTION

IMPROVING THE INTERSECTION OF SR 63 AND UNION ROAD AND THE INDIANA & OHIO RAIL SYSTEM BY INSTALLING A TRAFFIC SIGNAL (FLASHING) AND UPDATING SIGNING AND PAVEMENT MARKINGS

### EARTH DISTURBED AREAS

PROJECT EARTH DISTURBED AREA: 0.02 ACRES  
ESTIMATED CONTRACTOR EARTH DISTURBED AREA: 0.00 ACRES  
NOTICE OF INTENT EARTH DISTURBED AREA: (NOI NOT REQUIRED)

### 2019 SPECIFICATIONS

THE STANDARD SPECIFICATIONS OF THE STATE OF OHIO, DEPARTMENT OF TRANSPORTATION, INCLUDING SUPPLEMENTAL SPECIFICATIONS LISTED IN THE PLANS AND CHANGES LISTED IN THE PROPOSAL SHALL GOVERN THIS IMPROVEMENT.

 
I HEREBY APPROVE THESE PLANS AND DECLARE THAT THE MAKING OF THIS IMPROVEMENT WILL NOT REQUIRE THE CLOSING TO TRAFFIC OF THE HIGHWAY AND THAT PROVISIONS FOR THE MAINTENANCE AND SAFETY OF TRAFFIC WILL BE AS SET FORTH ON THE PLANS AND ESTIMATES.



**LOCATION MAP**

LATITUDE: 39°26'25" N LONGITUDE: 84°19'23" W

SCALE IN MILES



PORTION TO BE IMPROVED	_____
INTERSTATE HIGHWAY	=====
FEDERAL ROUTES	-----
STATE ROUTES	-----
COUNTY & TOWNSHIP ROADS	-----
OTHER ROADS	-----

### DESIGN DESIGNATION

CURRENT ADT (20 )	-----	N/A
DESIGN YEAR ADT (20 )	-----	N/A
DESIGN HOURLY VOLUME (20 )	-----	
DIRECTIONAL DISTRIBUTION	-----	
TRUCKS (24 HOUR B&C)	-----	
DESIGN SPEED	-----	50/55 MPH
LEGAL SPEED	-----	50/55 MPH
DESIGN FUNCTIONAL CLASSIFICATION:		
MINOR ARTERIAL (URBAN)	-----	
NHS PROJECT	-----	NO

### DESIGN EXCEPTIONS

NONE

**UNDERGROUND UTILITIES**

**Contact Two Working Days  
Before You Dig**




**OHIO811.org**  
Before You Dig

**OHIO811, 8-1-1, or 1-800-362-2764**  
(Non-members must be called directly)

PLAN PREPARED BY:  
**MEAD & HUNT**  
4700 LAKEHURST CT, SUITE 110  
COLUMBUS OH, 43016



### ENGINEERS SEAL:

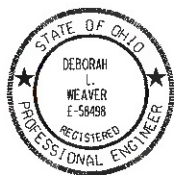

SIGNED: *Deborah L. Weaver*  
DATE: 01/03/2020

### STANDARD CONSTRUCTION DRAWINGS

HL-30.11	7/19/19	TC-52.10	10/18/13
HL-30.21	1/17/14	TC-52.20	7/20/18
HL-30.22	1/17/14	TC-71.10	1/19/18
		TC-81.21	1/18/19
MT-95.31	7/19/19	TC-83.10	1/19/18
MT-95.32	4/19/19	TC-83.20	7/21/17
MT-97.10	4/19/19	TC-85.20	7/20/18
MT-105.10	7/19/13	TC-85.22	1/19/18
MT-120.00	1/19/18	TC-86.10	7/19/19
TC-12.30	1/19/18		
TC-16.21	7/20/18		
TC-21.20	7/20/18		
TC-22.10	10/18/13		
TC-41.20	10/18/13		
TC-41.41	10/18/13		

SUPPLEMENTAL SPECIFICATIONS		SPECIAL PROVISIONS
800-2019	1/17/20	NONE
809	10/18/19	
819	1/15/16	
821	4/20/12	
828	1/19/18	
919	1/20/17	
921	4/20/12	
926	7/19/18	
832	10/19/18	

APPROVED: *Tammy K Campbell*  
DATE: 1/3/2020 DISTRICT DEPUTY DIRECTOR

APPROVED: \_\_\_\_\_  
DATE: \_\_\_\_\_ DIRECTOR, DEPARTMENT OF TRANSPORTATION

FEDERAL PROJECT NO.	E190369
RAILROAD INVOLVEMENT	INDIANA & OHIO RAILWAY CO.
CONSTRUCTION PROJECT NO.	TITLE SHEET
DESIGN AGENCY	Mead & Hunt
CLIENT	
DESIGNER	DLW
REVIEWER	SJS 12/19/19
PROJECT ID	109049
SHEET TOTAL	P.01   15

WAR-SR 63-IORY MODEL: Sheet PAPER SIZE: 11x17 DATE: 1/3/2020 TIME: 10:38:54 AM USER: l670cjdw \\corporate\meadandhunt.com\shared\meadandhunt\109049\109049\WAR-63-IORY\400-Engineer\ing\Roadway\Sheet\109049\_GTO01.dgn