



- A** 12.0'  
STA. 1072+76.25 TO STA. 1073+88.00  
6.0'  
STA. 1074+44.00 TO STA. 1075+34.00  
VARIES 6.0' TO 12.0'  
STA. 1075+34.00 TO STA. 1075+82.00  
12.0'  
STA. 1075+82.00 TO STA. 1075+83.00
- B** 12.0'  
STA 1072+76.25 TO STA 1072+77.00  
VARIES 12.0' TO 6.0'  
STA 1072+77.00 TO STA 1073+25.00  
6.0'  
STA 1073+25.00 TO STA 1073+88.00  
12.0'  
STA 1074+44.00 TO STA 1075+83.00
- C** VARIES 8.0' TO 0.0'  
STA 1072+76.25 TO STA 1073+75.01  
0.0'  
STA 1073+75.01 TO STA 1073+88.00  
0.0'  
STA 1074+44.00 TO STA 1074+84.00  
VARIES 0.0' TO 14.0'  
STA 1074+84.00 TO STA 1075+83.00
- D** 19.3'  
STA 1070+90.00 TO STA 1071+02.83  
VARIES 19.3' TO 10.0'  
STA 1071+02.83 TO STA 1071+40.00  
10.0'  
STA 1071+40.00 TO STA 1072+76.25
- E** VARIES 4.8' TO 2.0'  
STA 1070+90.00 TO STA 1071+02.83  
2.0'  
STA 1071+02.83 TO STA 1072+76.25
- F** VARIES 0.0' TO 12.0'  
STA 1070+90.00 TO STA 1071+40.00  
12.0'  
STA 1071+40.00 TO STA 1072+76.25

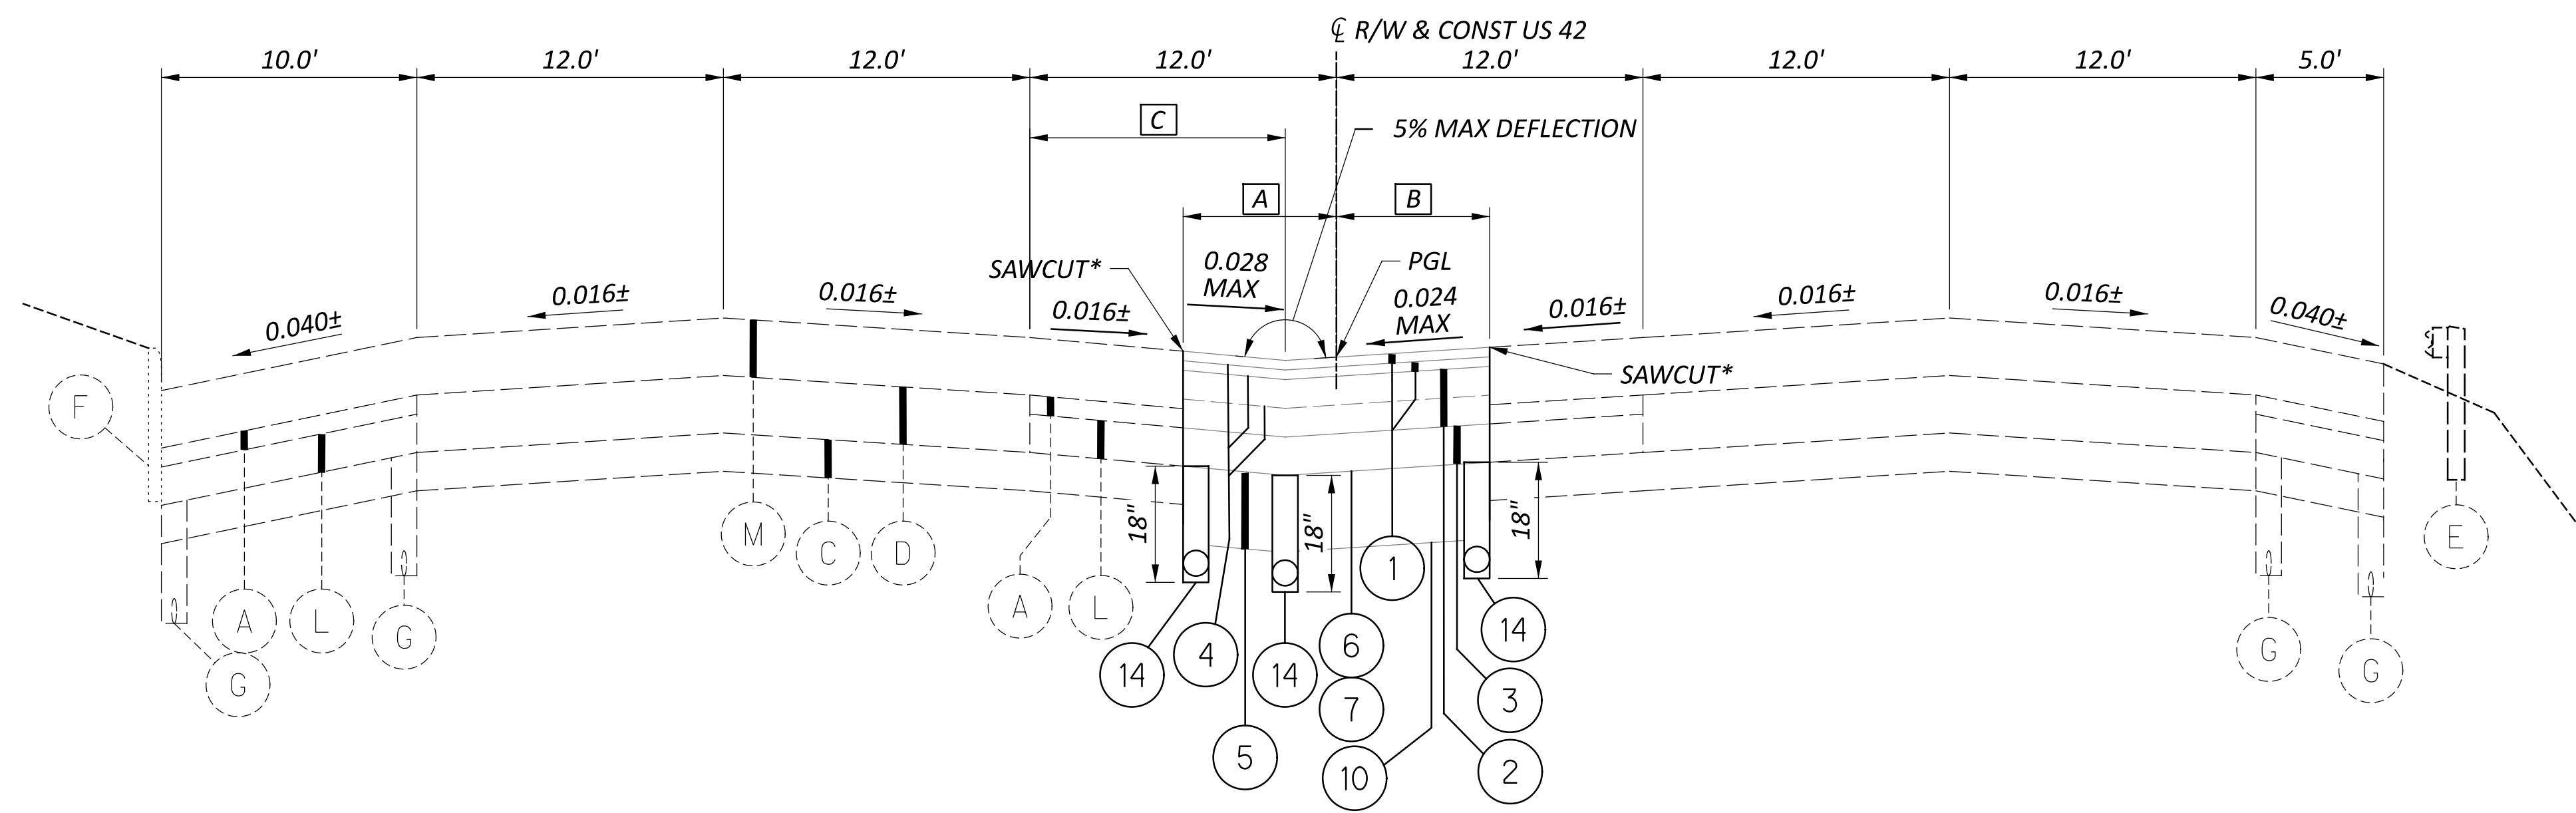


PROPOSED SECTION - US 42

STA 1072+76.25 TO STA 1073+88.00  
STA 1073+88.00 TO STA 1074+44.00 (SEE INTERSECTION DETAIL SHEET P.47)  
STA 1074+44.00 TO STA 1075+83.00

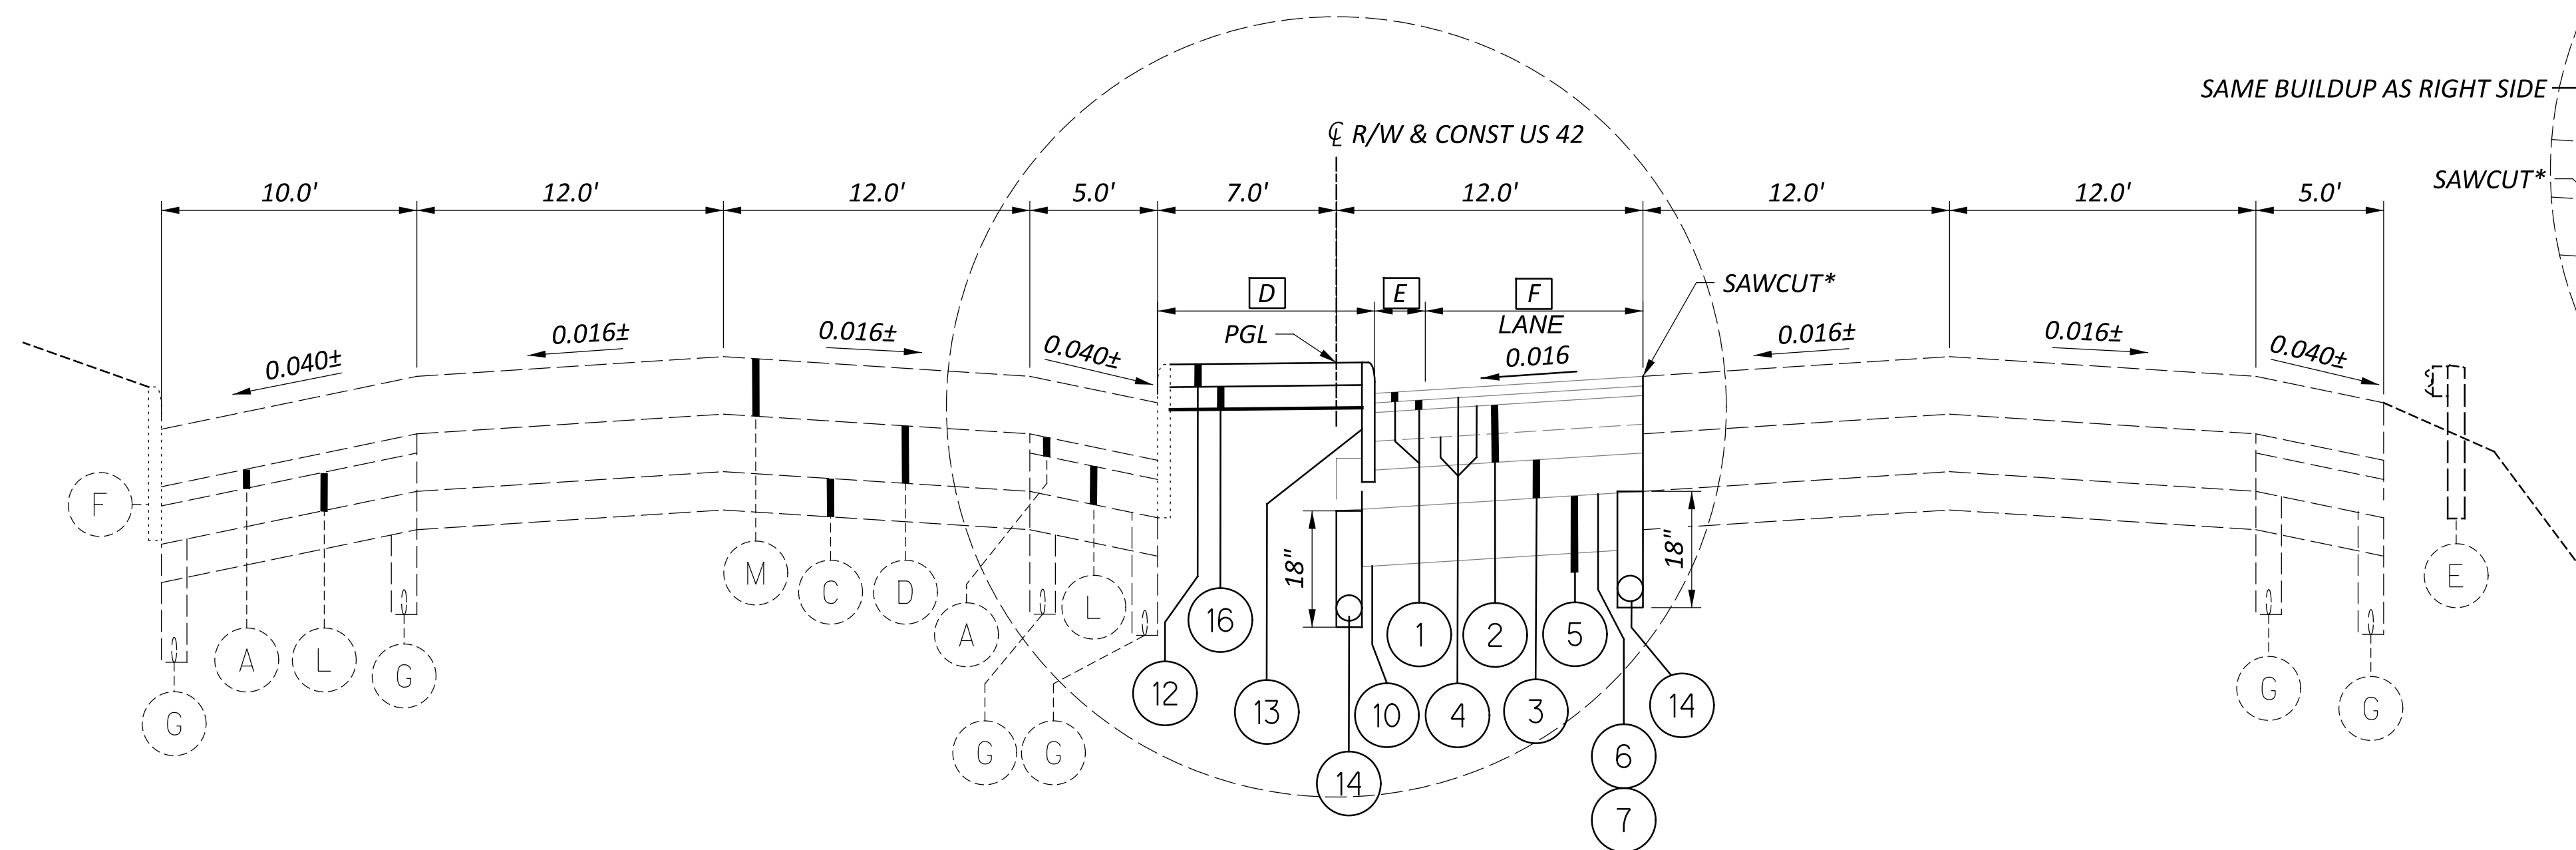

PROPOSED SECTION - US 42

STA 1070+90.00 TO STA 1072+76.25  
SEED AND MULCH FROM 1070+90.00 TO 1071+26.00,  
THEN BEGIN CONCRETE MEDIAN AS SHOWN

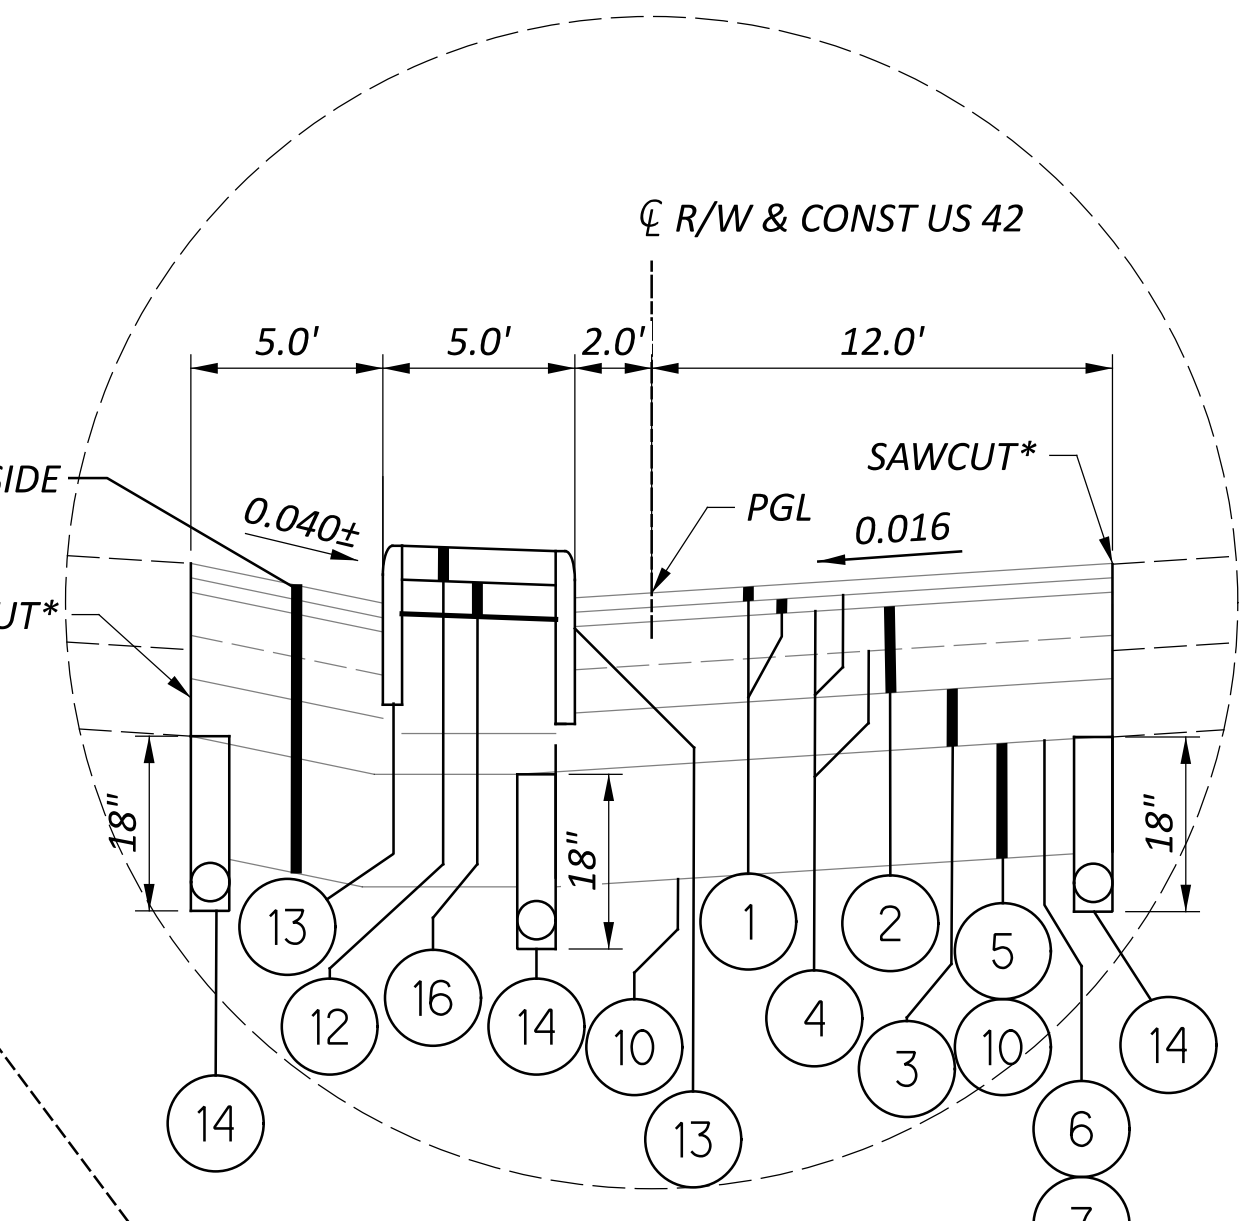

PROPOSED SECTION - NB US 42

STA 1072+54.00 TO STA 1072+76.25


\* CONTRACTOR TO ENSURE SOUND EDGE BEFORE WIDENING OR CONSTRUCTING CURB

PROPOSED LEGEND

- 1 ITEM 442 - 1.5" ASPHALT CONCRETE SURFACE COURSE, 12.5MM, TYPE A (449)
- 2 ITEM 301 - 9" ASPHALT CONCRETE BASE, PG 64-22, (449), (PLACED IN 2-4.5" LIFTS)
- 3 ITEM 304 - 6" AGGREGATE BASE
- 4 ITEM 407 - NON-TRACKING TACK COAT
- 5 UNDERCUT - 12" DEPTH  
ITEM 204 - EXCAVATION OF SUBGRADE  
ITEM 204 - GRANULAR MATERIAL, TYPE C
- 6 ITEM 204 - SUBGRADE COMPACTION

- 7 ITEM 204 - PROOF ROLLING
- 8 ITEM 659 - SEEDING AND MULCHING
- 9 ITEM 609 - CURB, TYPE 6
- 10 ITEM 204 - GEOTEXTILE FABRIC
- 11 ITEM 452 - 8" NON-REINFORCED CONCRETE PAVEMENT, CLASS QC 1P
- 12 ITEM 609 - 4" CONCRETE MEDIAN
- 13 ITEM 609 - CURB, TYPE 4-C

- 14 ITEM 601 - 6" BASE PIPE UNDERDRAIN
- 15 ITEM 608 - 4" CONCRETE WALK
- 16 ITEM 304 - 4" AGGREGATE BASE

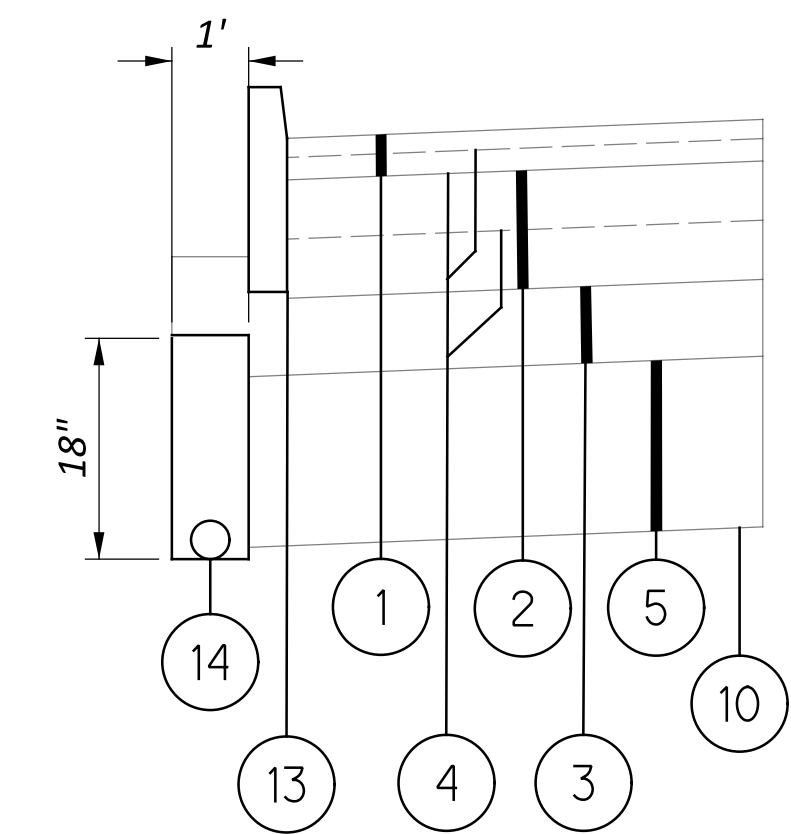


PROPOSED CURB DETAIL

STA 1070+90.00 TO STA 1072+76.26.00

FOR EXISTING LEGEND, SEE PAGE P.2

SHEET NUM.													PART.	ITEM	ITEM	GRAND	UNIT	DESCRIPTION	SEE SHEET NO.
P.6	P.27	P.28	P.29	P.30	P.46	P.50							01/SAF/21	EXT	TOTAL				
<b>ROADWAY</b>																			
LS			765										LS	201	11000	LS		CLEARING AND GRUBBING	
													765	202	23000	765	SY	PAVEMENT REMOVED	
	1,185												1,185	202	30000	1,185	SF	WALK REMOVED	
	74												74	202	30600	74	SY	CONCRETE MEDIAN REMOVED	
	974												974	202	32000	974	FT	CURB REMOVED	
	60												60	202	35100	60	FT	PIPE REMOVED, 24" AND UNDER	
	5												5	202	58100	5	EACH	CATCH BASIN REMOVED	
	1												1	202	98100	1	EACH	REMOVAL MISC.:DECORATIVE PLAQUE	
					567								567	203	10000	567	CY	EXCAVATION	
					131								131	203	20000	131	CY	EMBANKMENT	
			1,506										1,506	204	10000	1,506	SY	SUBGRADE COMPACTION	
			465										465	204	13000	465	CY	EXCAVATION OF SUBGRADE	
			465										465	204	30020	465	CY	GRANULAR MATERIAL, TYPE C	
			0.9										0.9	204	45000	0.9	HOUR	PROOF ROLLING	
			1,393										1,393	204	50000	1,393	SY	GEOTEXTILE FABRIC	
	1,140												1,140	608	10000	1,140	SF	4" CONCRETE WALK	
	332												332	608	52000	332	SF	CURB RAMP	
<b>EROSION CONTROL</b>																			
2													2	659	00100	2	EACH	SOIL ANALYSIS TEST	
85													85	659	00300	85	CY	TOPSOIL	
763													763	659	10000	763	SY	SEEDING AND MULCHING	
38													38	659	14000	38	SY	REPAIR SEEDING AND MULCHING	
38													38	659	15000	38	SY	INTER-SEEDING	
0.17													0.17	659	20000	0.17	TON	COMMERCIAL FERTILIZER	
0.16													0.16	659	31000	0.16	ACRE	LIME	
4													4	659	35000	4	MGAL	WATER	
2													2	659	40000	2	MSF	MOWING	
													20,000	832	30000	20,000	EACH	EROSION CONTROL	
<b>DRAINAGE</b>																			
		1.1											1.1	601	32200	1.1	CY	ROCK CHANNEL PROTECTION, TYPE C WITH FILTER	
		0.2											0.2	602	20000	0.2	CY	CONCRETE MASONRY	
				1,502									1,502	605	14000	1,502	FT	6" BASE PIPE UNDERDRAINS	
				132									132	611	00510	132	FT	6" CONDUIT, TYPE F FOR UNDERDRAIN OUTLETS	
		304											304	611	04400	304	FT	12" CONDUIT, TYPE B	
		10											10	611	04600	10	FT	12" CONDUIT, TYPE C	
		28											28	611	05900	28	FT	15" CONDUIT, TYPE B, 706.02	
		16											16	611	10400	16	FT	24" CONDUIT, TYPE B, 706.02	
		14											14	611	10600	14	FT	24" CONDUIT, TYPE C, 706.02	
		2											2	611	98150	2	EACH	CATCH BASIN, NO. 3	
		4											4	611	98180	4	EACH	CATCH BASIN, NO. 3A	
		2											2	611	98370	2	EACH	CATCH BASIN, NO. 6	
		1											1	611	98470	1	EACH	CATCH BASIN, NO. 2-2B	
		3											3	611	99574	3	EACH	MANHOLE, NO. 3	
		190											190	839	29000	190	FT	TRENCH DRAIN, TYPE A WITH STANDARD GRATE	
<b>PAVEMENT</b>																			
			297										297	301	56000	297	CY	ASPHALT CONCRETE BASE, PG64-22, (449)	
			240										240	304	20000	240	CY	AGGREGATE BASE	
			198										198	407	20000	198	GAL	NON-TRACKING TACK COAT	
			100										100	442	22100	100	CY	ASPHALT CONCRETE SURFACE COURSE, 12.5 MM, TYPE A (449)	
			113										113	452	12010	113	SY	8" NON-REINFORCED CONCRETE PAVEMENT, CLASS QC 1P	
	523												523	609	24510	523	FT	CURB, TYPE 4-C	
	208												208	609	26000	208	FT	CURB, TYPE 6	
	138												138	609	72000	138	SY	CONCRETE MEDIAN	
<b>WATER WORK</b>																			
						1							1	638	10300	1	EACH	FIRE HYDRANT EXTENDED AND ADJUSTED TO GRADE	

GENERAL SUMMARY

DESIGN AGENCY  
  
 DESIGNER  
 TGW  
 REVIEWER  
 SJB 05/16/24  
 PROJECT ID  
 118273  
 SHEET TOTAL  
 P.24 P.62



