

WAR-SR 73-1.49 S MAIN ST RESURF

SHEET NUM.													PART.	ITEM	ITEM	GRAND	UNIT	DESCRIPTION	SEE SHEET NO.
4	5	7	8	16	22								01/MPO/F RA		EXT	TOTAL			
													LS	201	11000	LS		ROADWAY	
		620	432										1,052	202	23000	1,052	SY	CLEARING AND GRUBBING	
		8,429											8,429	202	30000	8,429	SF	PAVEMENT REMOVED	
		2,222											2,222	202	32000	2,222	FT	WALK REMOVED	
			24										24	202	34900	24	FT	CURB REMOVED	
			4										4	202	58100	4	EACH	PIPE REMOVED	
																		CATCH BASIN REMOVED	
				3									3	203	10000	3	CY	EXCAVATION	
				41									41	203	20000	41	CY	EMBANKMENT	
		240											240	203	35110	240	CY	GRANULAR MATERIAL, TYPE B	
		988											988	204	10000	988	SY	SUBGRADE COMPACTION W/ PROOF ROLLING	
			24										432	204	10000	24	SY	SUBGRADE COMPACTION	
		240											240	204	13000	240	CY	EXCAVATION OF SUBGRADE	
		8,745											8,745	608	10000	8,745	SF	4" CONCRETE WALK	
		375											375	608	52000	375	SF	CURB RAMP	
																		EROSION CONTROL	
160													160	659	00300	160	CY	TOPSOIL	
1,437													1,437	659	00500	1,437	SY	SEEDING AND MULCHING, CLASS 1	
0.2													0.2	659	20000	0.2	TON	COMMERCIAL FERTILIZER	
0.3													0.3	659	31000	0.3	ACRE	LIME	
8													8	659	35000	8	MGAL	WATER	
													5,200	832	30000	5,200	EACH	EROSION CONTROL	
																		PAVEMENT	
32													32	253	02001	32	CY	PAVEMENT REPAIR, AS PER PLAN	
		3,813											3,813	254	01000	3,813	SY	PAVEMENT PLANING, ASPHALT CONCRETE, 3"	
		83											83	301	56000	83	CY	ASPHALT CONCRETE BASE, PG64-22, (449)	
		125											125	304	20000	125	CY	AGGREGATE BASE	
		380											380	407	20000	380	GAL	NON-TRACKING TACK COAT	
		180											180	441	70000	180	CY	ASPHALT CONCRETE SURFACE COURSE, TYPE 1, (449), PG64-22	
		180											180	441	70300	180	CY	ASPHALT CONCRETE INTERMEDIATE COURSE, TYPE 2, (449)	
			270										270	452	10010	270	SY	6" NON-REINFORCED CONCRETE PAVEMENT, CLASS QC 1P	
			162										162	452	12010	162	SY	8" NON-REINFORCED CONCRETE PAVEMENT, CLASS QC 1P	
		2,222											2,222	609	24510	2,222	FT	CURB, TYPE 4-C	
																		DRAINAGE	
			2,140										2,140	605	06000	2,140	FT	4" BASE PIPE UNDERDRAINS	
			40										40	611	00406	40	FT	4" CONDUIT, TYPE F	
			20										20	611	04400	20	FT	12" CONDUIT, TYPE B, 706.02	
			4										4	611	04600	4	FT	12" CONDUIT, TYPE C, 707.33	
			3										3	611	98150	3	EACH	CATCH BASIN, NO. 3	
			1										1	611	98370	1	EACH	CATCH BASIN, NO. 6	
5													5	611	99654	5	EACH	MANHOLE ADJUSTED TO GRADE	
12													12	638	10800	12	EACH	VALVE BOX ADJUSTED TO GRADE	
					75								75	630	03100	75	FT	TRAFFIC CONTROL	
					1								1	630	08600	1	EACH	GROUND MOUNTED SUPPORT, NO. 3 POST	
					21								21	630	80100	21	SF	SIGN POST REFLECTOR	
					7								7	630	84900	7	EACH	SIGN, FLAT SHEET	
					5								5	630	86002	5	EACH	REMOVAL OF GROUND MOUNTED SIGN AND DISPOSAL	
																		REMOVAL OF GROUND MOUNTED POST SUPPORT AND DISPOSAL	
					0.4								0.4	644	00104	0.4	MILE	EDGE LINE, 6"	
					0.21								0.21	644	00300	0.21	MILE	CENTER LINE	
					40								40	644	00500	40	FT	STOP LINE	
					88								88	644	00620	88	FT	CROSSWALK LINE, 12"	
					169								169	644	00700	169	FT	TRANSVERSE/DIAGONAL LINE	
					1								1	644	01000	1	EACH	RAILROAD SYMBOL MARKING	
																		MAINTENANCE OF TRAFFIC	
	8												8	614	11110	8	HOUR	LAW ENFORCEMENT OFFICER WITH PATROL CAR FOR ASSISTANCE	
	0.4												0.4	614	22010	0.4	MILE	WORK ZONE EDGE LINE, CLASS I, 6"	
	0.4												0.4	614	22360	0.4	MILE	WORK ZONE EDGE LINE, CLASS III, 6", 642 PAINT	
	169												169	614	25000	169	FT	WORK ZONE TRANSVERSE/DIAGONAL LINE, CLASS I	

MAIN STREET RESURFACING
GENERAL SUMMARY

DESIGN AGENCY



DESIGNER

GAC

REVIEWER

SEF 09-01-25

PROJECT ID

119985

SHEET

P:6

TOTAL




27

REF NO.	SHEET NO.	STATION TO STATION					202	605	611	611	611	611	452	452	202	202	204										
							CATCH BASIN REMOVED	4" BASE PIPE UNDERDRAINS	4" CONDUIT, TYPE F	12" CONDUIT, TYPE B, 706.22	12" CONDUIT, TYPE C, 707.33	CATCH BASIN, NO. 3	CATCH BASIN, NO. 6	6" NON-REINFORCED CONCRETE PAVEMENT, CLASS QC 1P, 1P	8" NON-REINFORCED CONCRETE PAVEMENT, CLASS QC, 1P	PAVEMENT REMOVED	PIPE REMOVED	SUBGRADE COMPACTION									
							EACH	FT	FT	FT	FT	EACH	EACH	SY	SY	SY	FT	SY									
UD1	9-10	13+03.54	LT	TO	19+71.26	LT		670																			
UD2	9-11	13+03.54	RT		23+67.35	RT		1080																			
UD3	10-11	19+85.11	LT		23+67.35	LT		390																			
DR1	9	13+00.00	LT				1		10	4	4	1															
DR2	9	13+00.00	RT				1		10	4		1															
DR3	11	23+70.00	LT				1		10	4			1														
DR4	11	23+70.00	RT				1		10	8		1															
D1	9	13+42.47	RT		13+54.47	RT							8		8		8										
D2	9	13+81.02	LT		13+97.13	LT							13		13		13										
D3	9	13+90.09	RT		14+06.03	RT							12		12		12										
D4	9	14+57.07	LT		14+73.06	LT							14		14		14										
D5	9	14+70.77	RT		14+93.38	RT							19		19		19										
D6	9	14+98.70	LT		15+12.49	LT							12		12		12										
D7	9	15+94.98	LT		16+13.96	LT							17		17		17										
D8	9	16+63.31	RT		16+99.26	RT							34		34		34										
D9	9-10	16+92.21	LT		17+06.21	LT							10		10		10										
D10	10	17+40.92	RT		17+54.92	RT							11		11		11										
D11	10	17+69.57	RT		17+91.57	RT							18		18		18										
D12	10	18+05.22	LT		18+22.22	LT							13		13		13										
D13	10	18+15.97	RT		18+33.59	RT							15		15		15										
D14	10	19+11.33	RT		19+35.33	RT							21		21		21										
D15	10	19+93.51	RT		20+13.87	RT								21	21		21										
D16	10	20+57.27	LT		20+71.27	LT							12		12		12										
D17	10	20+72.12	RT		20+89.10	RT								15	15		15										
D18	10	21+08.59	LT		21+26.87	LT							15		15		15										
D19	10	21+51.18	RT		21+78.14	RT							26		26		26										
D20	10-11	21+83.30	LT		22+40.89	LT								57	57		57										
D21	11	23+16.37	RT		23+55.24	RT								35	35		35										
D22	11	23+45.83	LT		23+74.57	LT								34	34		34										
PR1	9	12+97.45	LT		13+00.64	LT											8										
PR2	9	13+01.11	RT		13+01.11	RT											4										
PR3	11	23+69.37	RT		23.69.37	RT											4										
PR4	11	23+69.54	LT		23+73.33	LT											8										


MAIN STREET RESURFACING SUBSUMMARY

LEGEND

- PROP. WALK
- FULL DEPTH
- RESURFACING LIMITS
- PROP. DRIVE
- DO NOT DISTURB
- ADJUST TO GRADE
- REMOVE AND REPLACE
- ADJUST TO GRADE BY OTHERS
- RELOCATE BY OTHERS

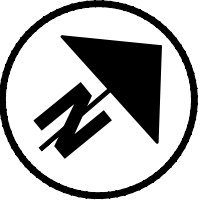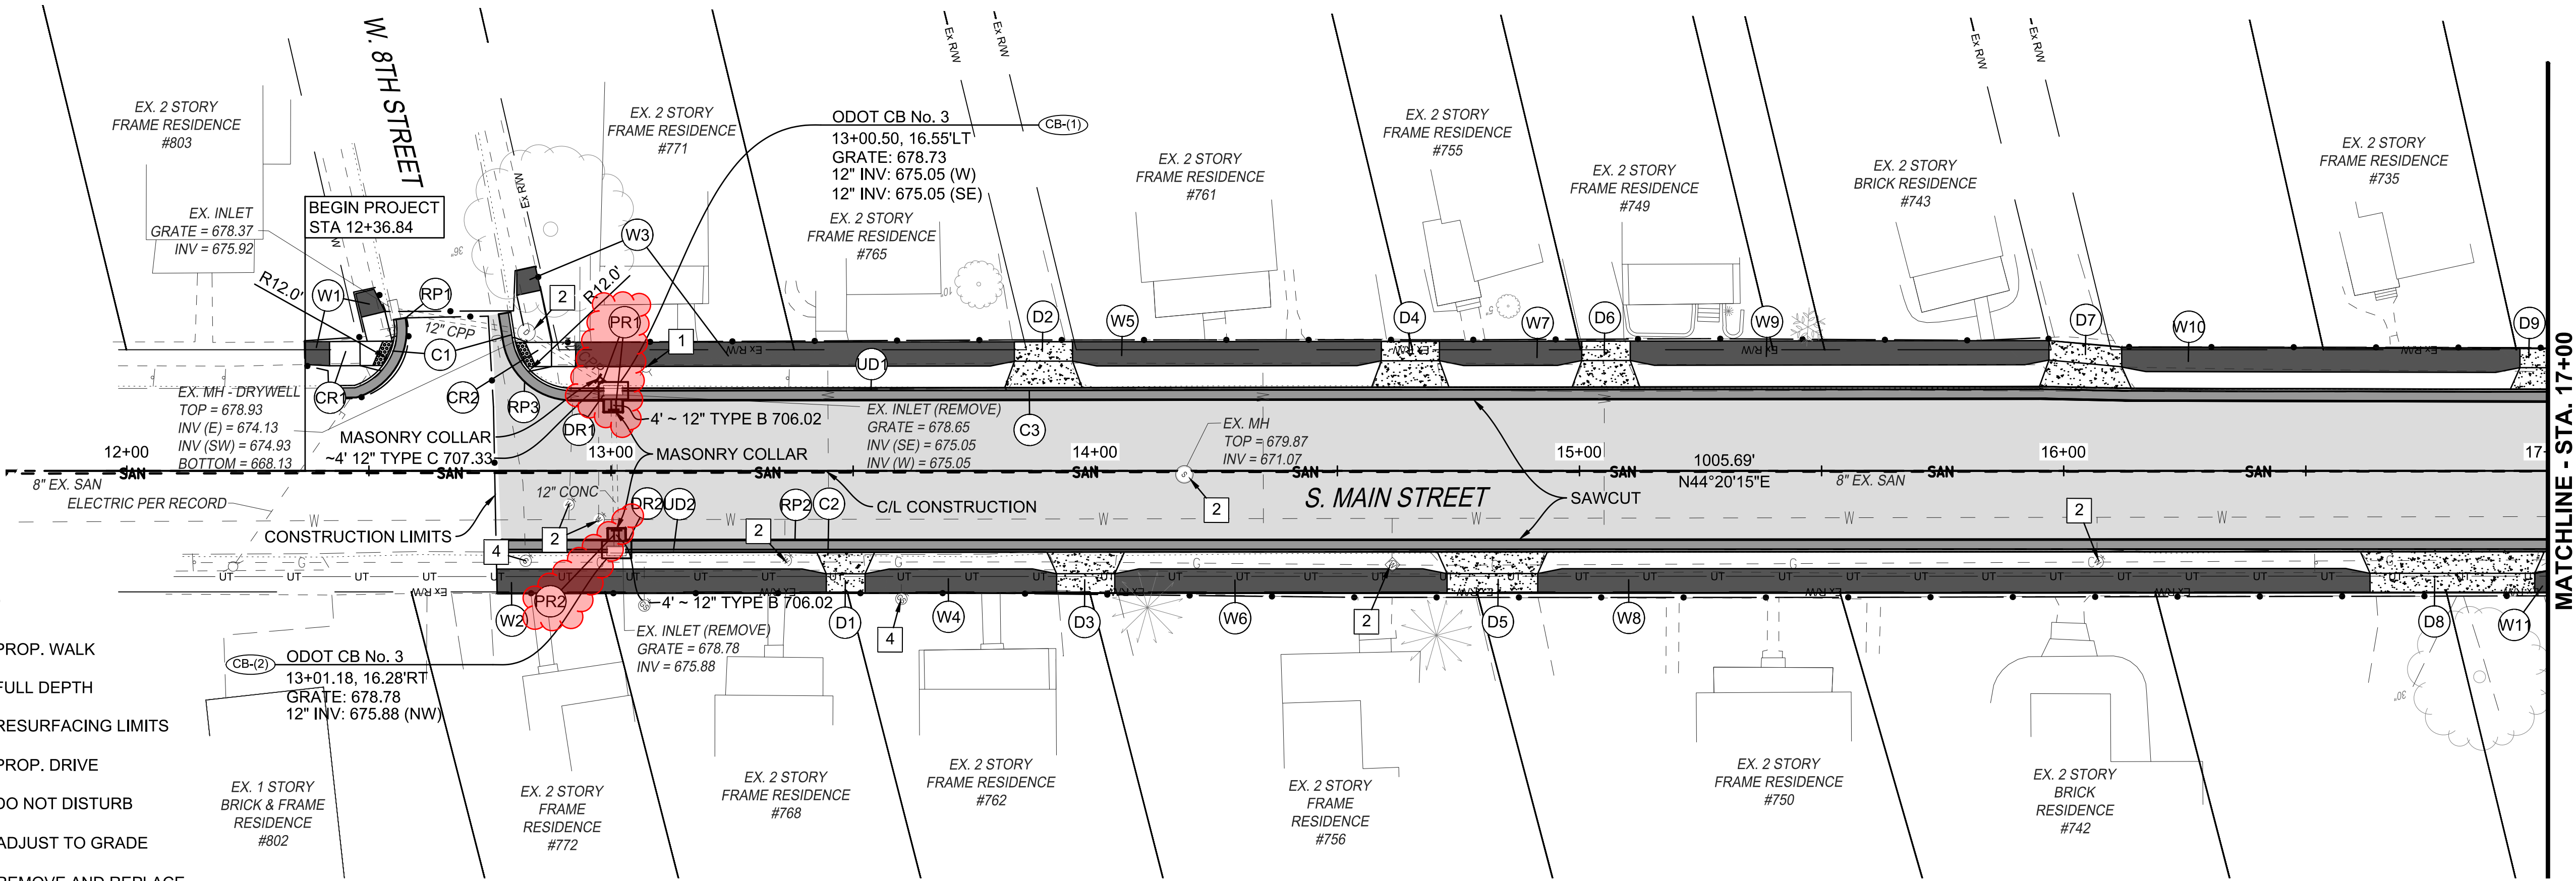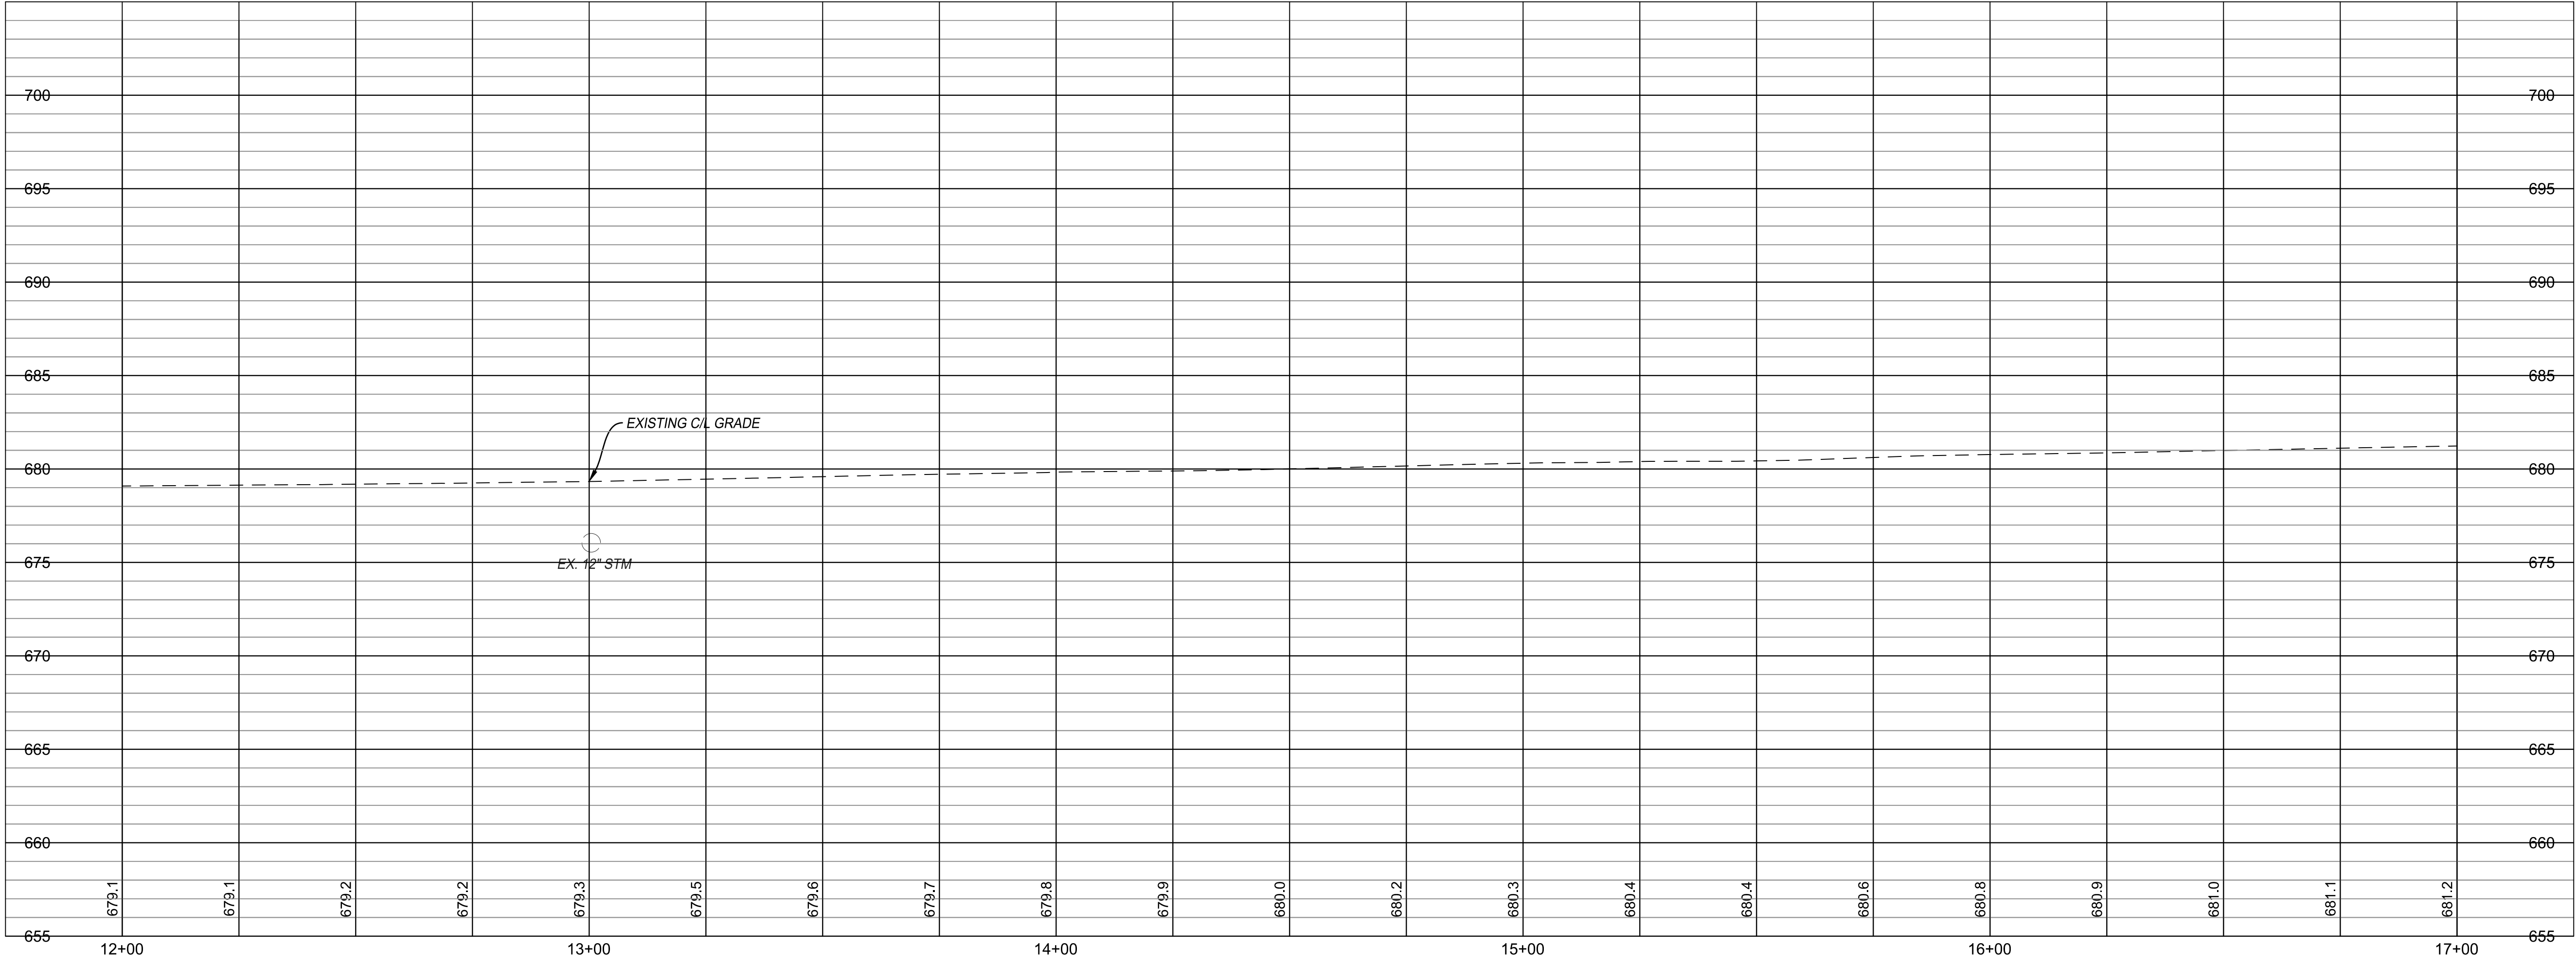

PLAN AND PROFILE
STA 12+00.00 TO STA 17+00.00

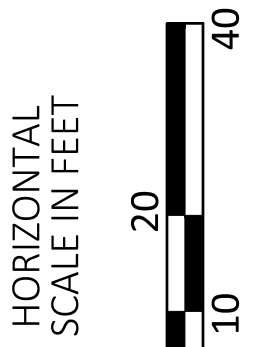

DESIGN AGENCY



DESIGNER

GAC

REVIEWER

SEF 09-01-25

PROJECT ID

119985

SHEET

P.9

TOTAL

27

- | | |
|---|---------------------------|
|  | PROP. WALK |
|  | FULL DEPTH |
|  | RESURFACING LIMITS |
|  | PROP. DRIVE |
|  | DO NOT DISTURB |
|  | ADJUST TO GRADE |
|  | REMOVE AND REPLACE |
|  | ADJUST TO GRADE BY OTHERS |
|  | RELOCATE BY OTHERS |

