

STATE OF OHIO
DEPARTMENT OF HIGHWAYS
WAR-71-(14.21-15.00)(14.82)
TURTLE CREEK AND WASHINGTON TOWNSHIPS
WARREN COUNTY
SCENIC OVERLOOKS

NOTE: THIS IMPROVEMENT HAS BEEN DECLARED LIMITED ACCESS HIGHWAY FROM STATION 900+00 TO STATION 60+00 BY ACTION OF THE DIRECTOR OF HIGHWAYS & RECORDED IN VOLUME 46 PAGE 469 OF THE DIRECTORS JOURNAL PURSUANT TO LAW.

14.21-15.00 LSI-71-1(II) 37
14.82 LSI-71-1(I)

FED. RD. DIVISION	STATE	PROJECT	
2	OHIO		19


WAR-71-(14.21-15.00)(14.82)
R/W PLANS
LIMITED ACCESS

CONVENTIONAL SIGNS

Property Line	---
County Line	---
Township Line	---
Section Line	---
Center Line	---
Corporation Line	---
Limited Access and Right-of-Way	---
Limited Access Only	LA
Right-of-Way Only	RW
Existing Right-of-Way	---
Fence Line	x x x x x x x x
Guard Rail (existing)	o o o o o o o o
Guard Rail (proposed)	o o o o o o o o
Steam Railroad	---
Power Poles	o o o o o o o o
Telephone Poles	o o o o o o o o
Trees or Stumps (existing)	o o o o o o o o
Trees or Stumps (to be removed)	x x x x x x x x

INDEX OF SHEETS

BEGIN WORK
WAR-71-(14.21-15.00)
S.L.M. 14.21

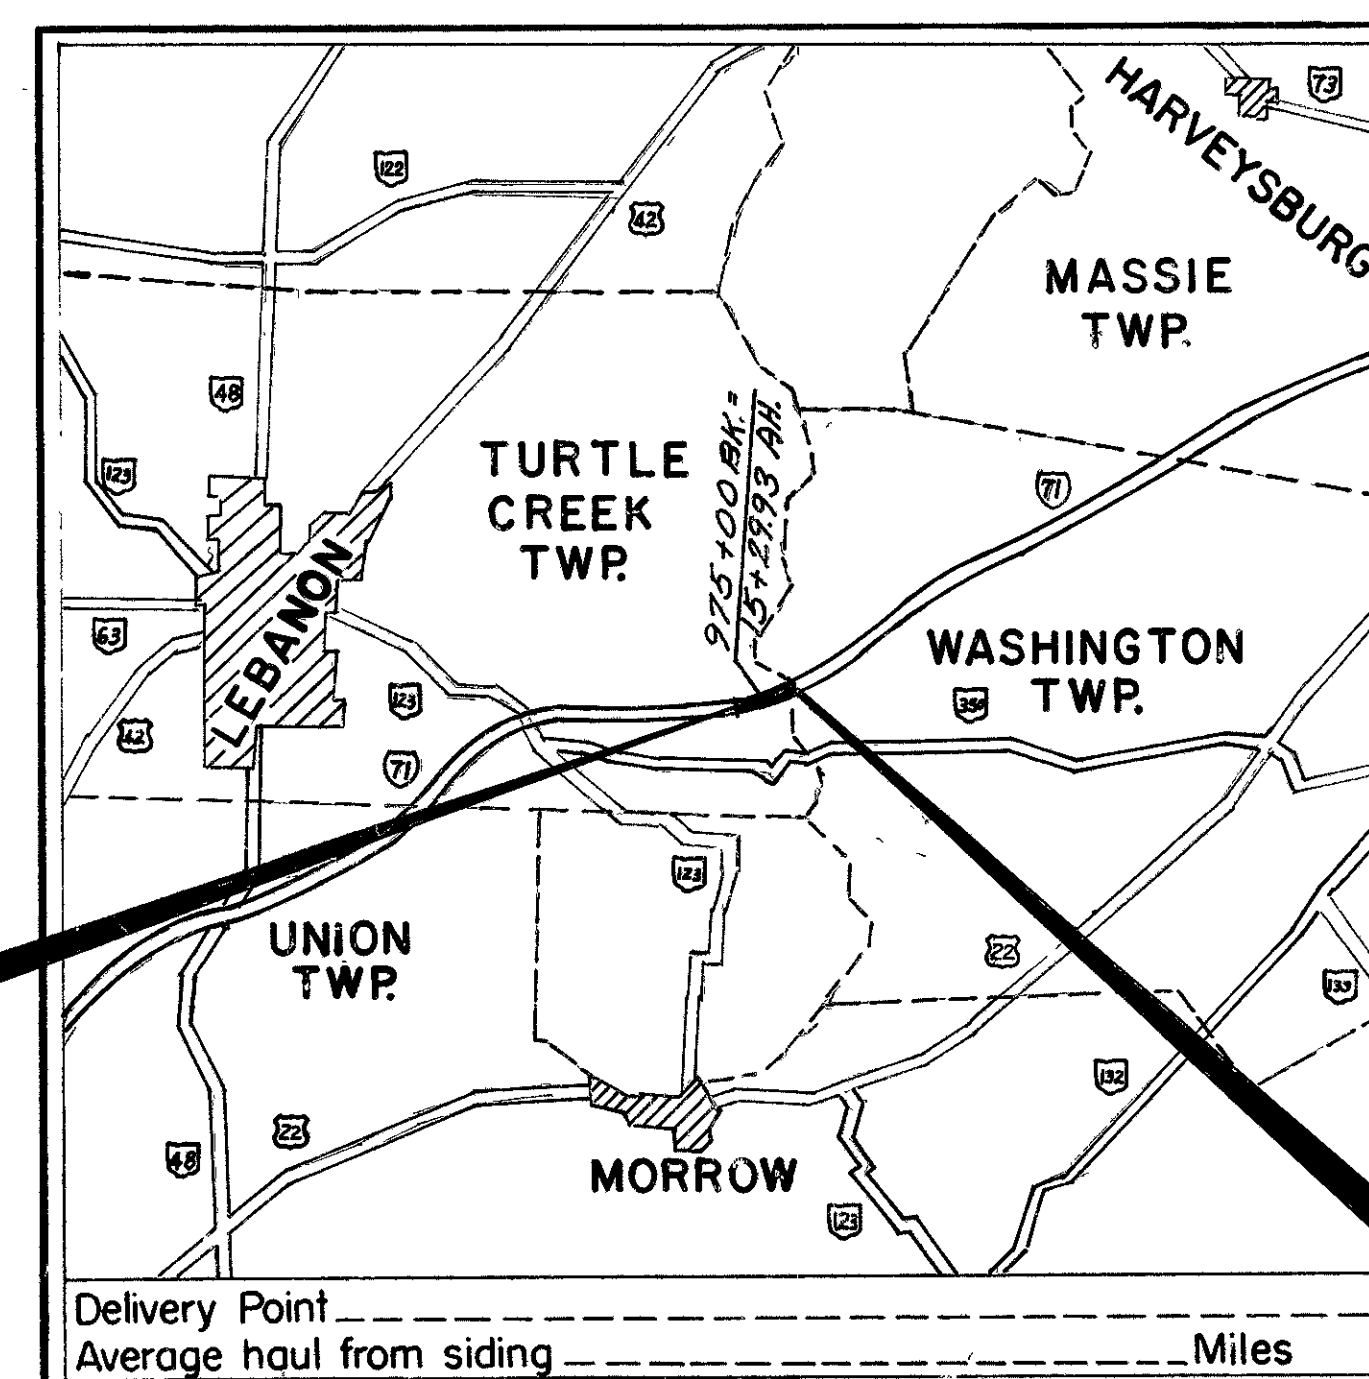

LOCATION MAP

SCALE OF MILES



Portion to be improved
State Roads
Other Roads

The standard specifications of the State of Ohio, Department of Highways, including changes and supplemental specifications listed in the proposal shall govern this improvement.

The right of way for this improvement will be provided by the State of Ohio.

Approved _____
Date _____ Deputy Director of Right of Way

Approved _____
Date _____ Director of Highways

R/W INFORMATION SHEET ONLY

DEPARTMENT OF COMMERCE
BUREAU OF PUBLIC ROADS

APPROVED:


DIVISION ENGINEER DATE

12

0 800 1600 2400 3200

Scale

FED. RD. DIVISION	STATE	PROJECT	
2	OHIO		
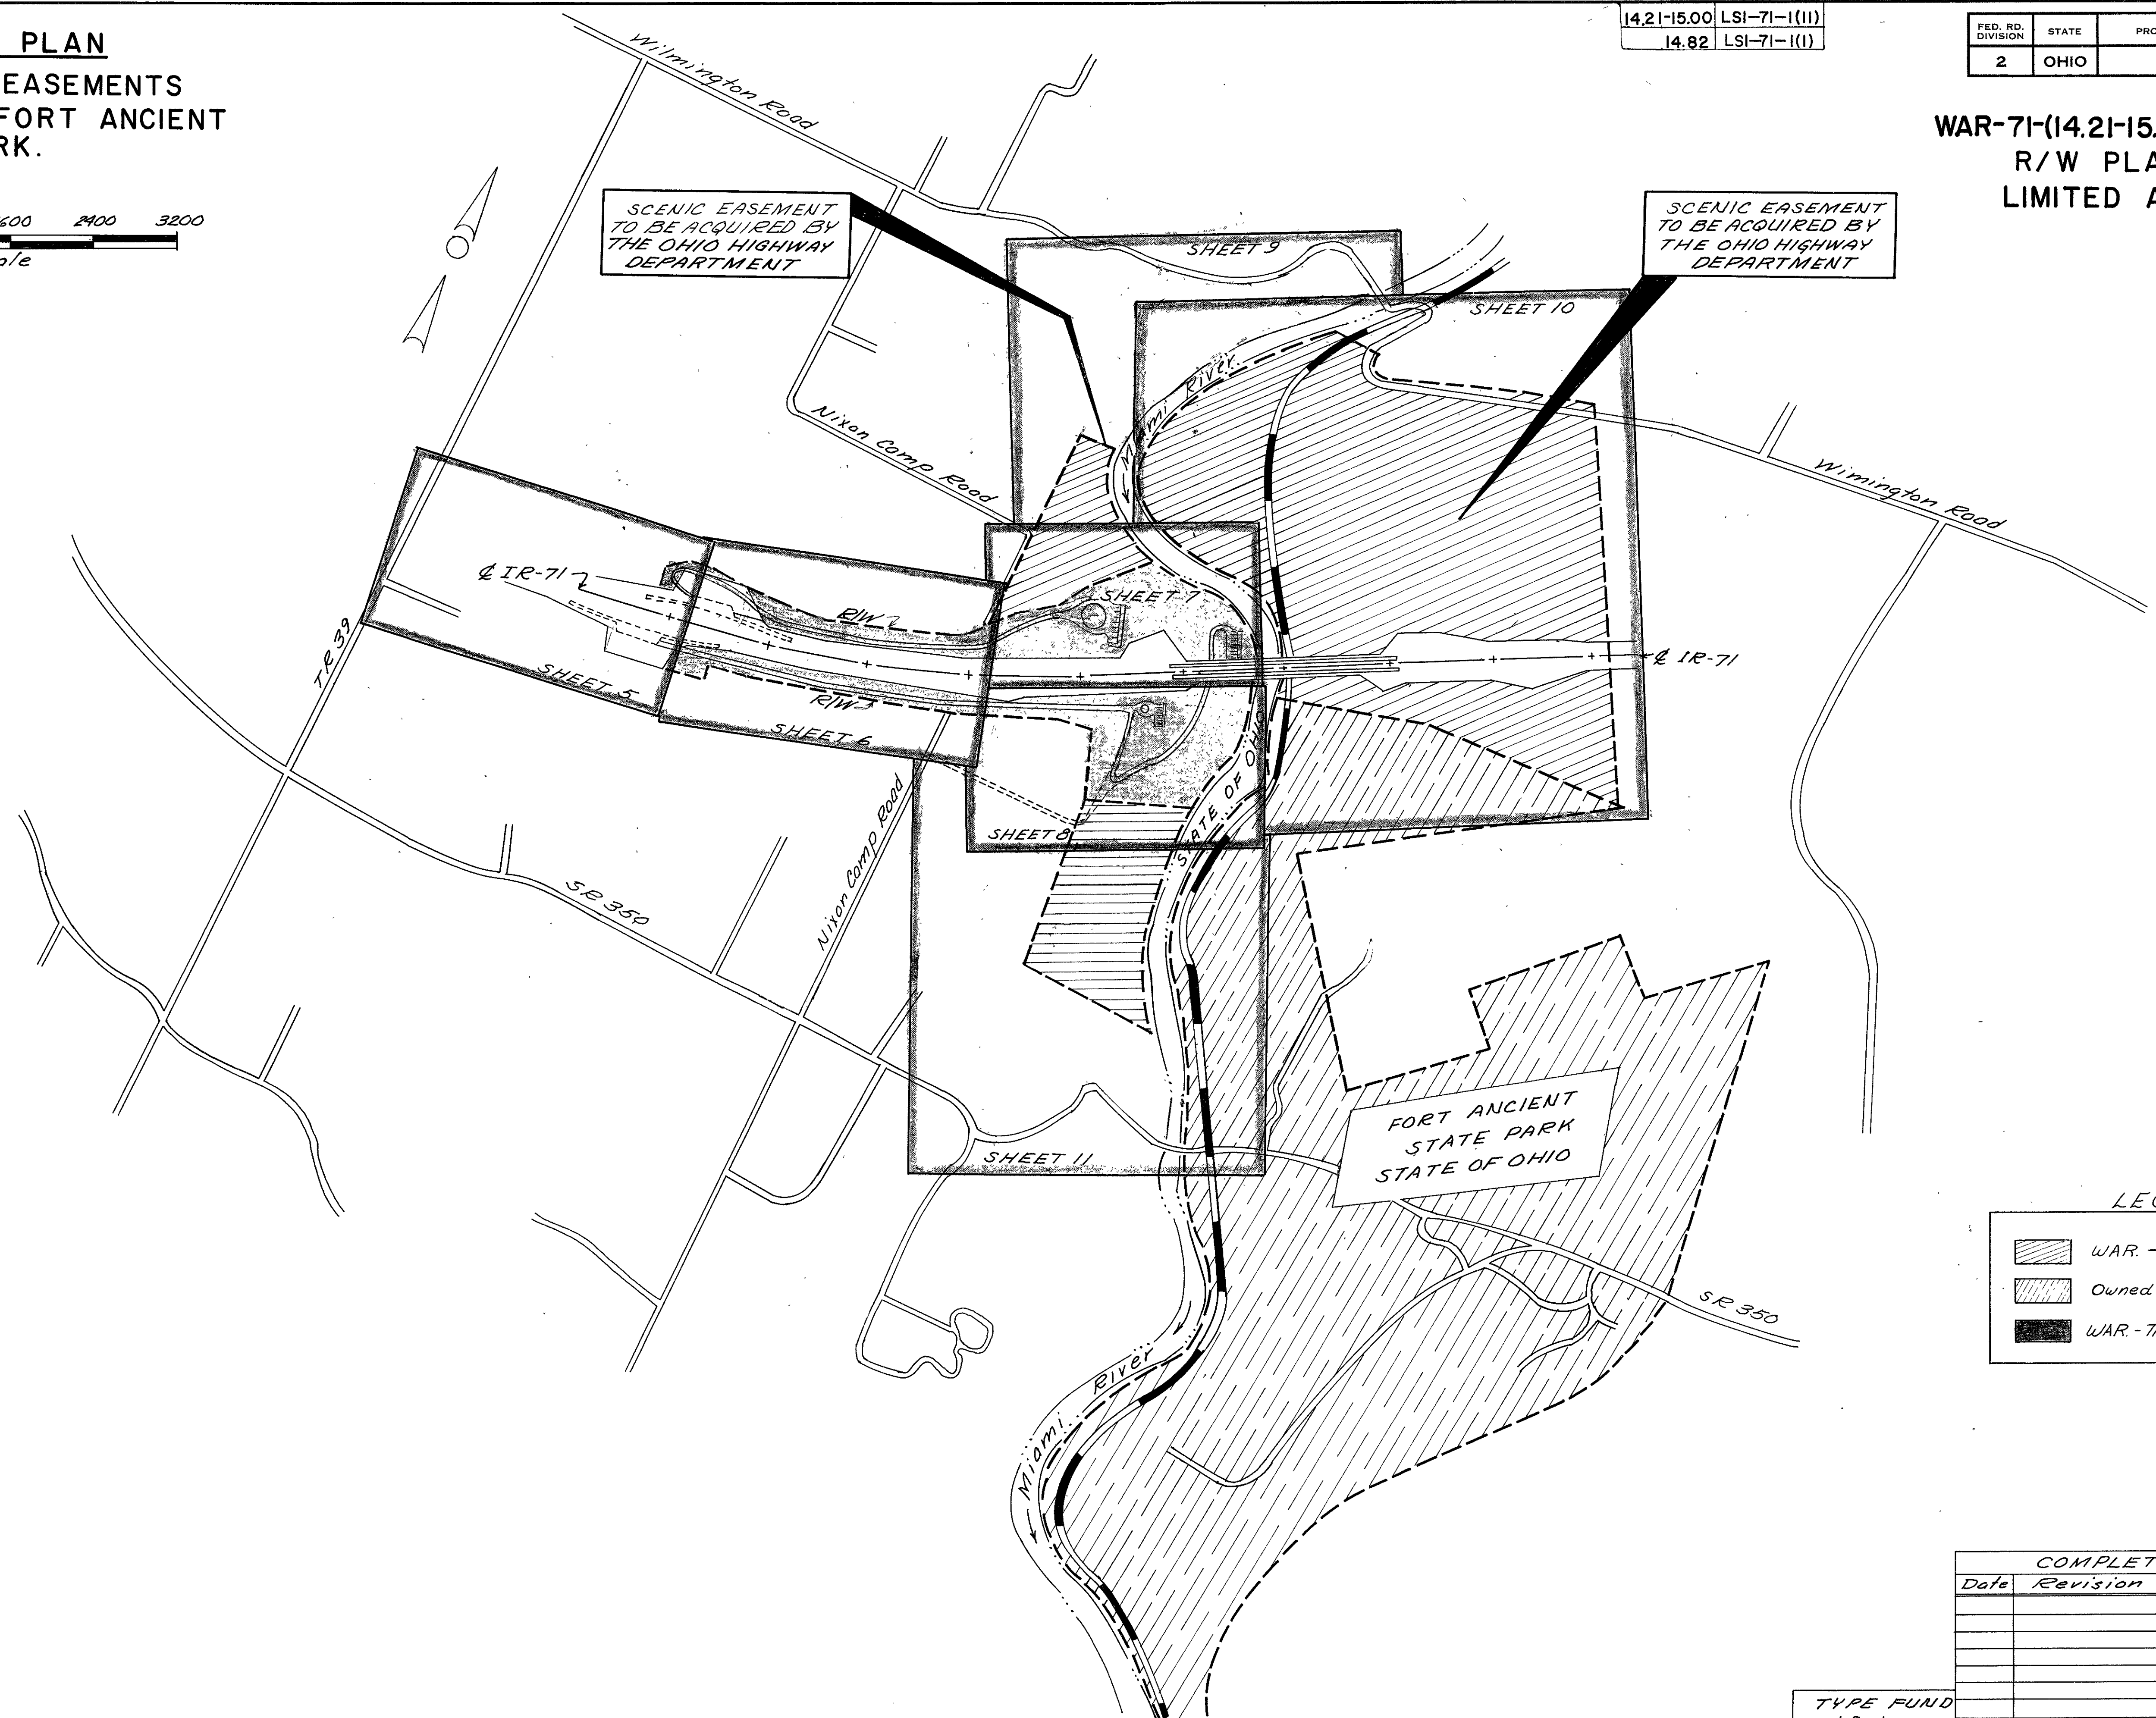
$$\frac{83}{3}$$


LEGEND

- WAR. - 71-1482 Project
- Owned by State of Ohio
- WAR. - 71-(421+500) Project

FORT ANCIENT
STATE PARK
STATE OF OHIO

TYPE FUND
LS-1

[illegible]

Schematic Plan

SUMMARY OF ADDITIONAL RIGHT OF WAY REQUIRED

14.21 15.00 LSI-71-1(III)
14.82 LSI-71-1(I)WAR-71-(14.21-15.00)(14.82)
R/W PLANS
LIMITED ACCESS

FED RD DIVISION	STATE	PROJECT
2	OHIO	

84
4
12

TOTAL NO. OWNERS-16

TOTAL NO. COMPLETE TAKES-

TOTAL PARCELS WITH STRUCTURES INVOLVED-2

PARCEL NO.	OWNER	DEED RECORD			RECORD AREA	TOTAL PRO	TOTAL TAKE	PRO IN TAKE	NET TAKE	NET RES. LT.	NET RES. RT.	BLDG'S TO BE ACQ'D	SHEET NO.	REMARKS	OTHER DESIGNATED EASEMENTS	TYPE FUND	
		BOOK	PAGE	DATE													
1 WL 1 AWL	HUBERT TERRY AND BETTY TERRY	360	280	2-10-65	123.947	1.125	7.548 4.258	0 0	7.548 4.258	97.274	13.742 Incl. P.S. Area	NO	5, 6 5, 6			LC-1	
2 WL 2 AWL	HERMAN R. CLARK AND AUDREY L. CLARK	254	286	5-16-56	4.600	0.000 0.023	3.902 0.106	0.000 0.023	3.902 0.085	.590 (L)	0	NO NO	6 6			LC-1	
3 WL 3 AWL	OAKLEY RAY AND PHYLLIS I. WILLIAMS	306	141	11-25-60	30.130	0.512 0	4.955 .057	0.036 0	4.919 0.057	0.000 0	24.642 0	YES	6 6			LS-1	
4 WL 4 PS	CHARLES WILLIAMS	236	373	12-4-54	47.740	0.644	18.230 0.521 1.541	0.342 0.130	17.888 0.391 1.541	0	28.817 Incl. P.S. Area	YES	6, 8 6 11			LS-1	
5 WL 5 AWL 5 PS	ALBERT A. MATRE	131	460	9-17-36	42.40(Deed) 43.732(Calc.)	0.000	16.153 16.904 10.675	0.000	16.153 16.904 10.675	10.675 P.S. Area	0	NO	7, 9 7, 8 7, 9	Used Calculated Area		LC-1	
6 WL 6	EDSEL JOHNSON, WILLA JO JOHNSON, EDWIN JOHN JOHNSON, &SHIRLEY JOHNSON	378	366	8-31-66	88.87	2.163	3.354 0.863	0.476 0.079	2.878 0.784	83.045	0	NO	6, 7 6			LS-1	
7 WL 7 PS	ROBERT JENKINS AND IRENE JENKINS	348 192	331 317	2-21-64 3-1-50	22.82	0.409	17.767 5.053	0.188 0.221	17.579 4.832	4.832 Net P.S. Area	0	NO	6, 7 7, 9			LS-1	
8 WL 8 WS	MYRTLE COLLETT	238	327	2-18-55	8.00(Deed) 9.473(Calc.)	0.139	5.711 3.762	0.000 0.139	5.711 3.623	0	0	S	7 7, 9	Used Calculated Area		LC-1	
9	OHIO STATE ARCHAEOLOGICAL AND HISTORICAL SOCIETY	160	165										10	NO EASEMENT REQUIRED			
10 WL	MICHAEL LAMPL	228	553	3-18-54	5.500	-0-	5.500	0	5.500	0		NO	8	TOTAL TAKE		LC-1	
11 PS	Y. M. C. A.	98 98	326 256	5-1-14 3-17-14	66.384	1.449	8.174	0	8.174	0	64.935 Incl. P.S. Area	NO	11			LC-1	
12	WILLIAM D. DORFMEIER	366	135	7-30-65	8.00								9	EASEMENT REQUIRED			
13 PS	ALTA MAY DANBURY	252	329	3-27-56	20.89	0.256	4.127	0.082	4.045	20.634 Incl. P.S. Area	0	NO	7, 9			LC-1	
14	EDWARD C. SHAW AND ELIZABETH SHAW	201	333	4-5-51	29.40								9	NO EASEMENT REQUIRED		LC-1	
15	CLARENCE STEGEMOLLER	231	167	6-9-54	4.742							NO	9	" " "		LC-1	
16	SALOS O. THOMAS AND EVA M. THOMAS	187	315	5-28-49	4.30							NO	9	" " "		LC-1	
17	COLD SPRINGS SUBDIVISION 32 OWNERS	140	258	4-15-41	12.70							NO	9	COLD SPRINGS SUBDIVISION-LOT NO'S 29-35-36-38-39-40-42-43-44-45 46-47-48-49-53-54 ACTUAL ACREAGE 10.641	No Easement Required on any Cold Springs Lot's.	LC-1	
17 APS	HUGH A. WHITESELL	235	429	10-30-54	0.14							NO	9	COLD SPRINGS SUBDIVISION LOT 1-50		LC-1	
17 BPS	EVA W. McMILLAN	303	173	8-25-60	0.28							NO	9	SAME LOT 2-53-54		LC-1	
17 CPS	CARL TAYLOR AND RUTH ZIMMERMAN	166	475	6-26-46	0.14							NO	9	SAME LOT 3-52		LC-1	
17 DPS	MARY LEMON	277	406	5-27-58	0.14							NO	9	SAME LOT 5-51		LC-1	
17 EPS	MARJORIE RIDENOR	217	305	1-15-53	0.21							NO	9	SAME LOT 6-50		LC-1	
17 FPS	CHARLES D. POULOS	353	514	7-18-54	0.14							NO	9	SAME LOT 7-49		LC-1	
17 GPS	EVELYN HERRIS	312	593	6-27-61	0.09							NO	9	SAME LOT 10-51		LC-1	
17 HPS	KELLY HALE	140	258	4-15-41	0.05							NO	9	SAME LOT 11		LC-1	
17 IPS	FRED C. BATY AND ZELMA F. BATY	364 188 315	600-601 88 509	6-28-65 7-16-49 9-1-61	0.14							NO	9	SAME LOT 12-14-15-16-17-18		LC-1	
17 JPS	BETTY C. HEADWORTH	365	91	7-3-65	0.08							NO	9	SAME LOT 16-51-52		LC-1	
17 KPS	HOWARD A. HIATT AND BETTY P. HIATT	299	463	5-11-60	0.05							NO	9	SAME LOT 17		LC-1	
UTILITIES		CENTERLINE-REFERENCE-MONUMENTS				SYMBOLS				TYPE 47 FENCE QUANTITIES			GENERAL NOTES			COMPLETION DATE 11-30-66	
COLD SPRING AND HUBERT TERRY & BETTY TERRY SUBDIVISIONS DELETED OHIO CENTRAL TELEPHONE CO., 110 MULBERRY ST., LEBANON, OHIO						(L) DESIGNATED MONUMENT AND * IDENTIFIED AND MARKED PS. EPOCHES FOR THIS FENCE AND EPOCHES FOR MONUMENTS SHOWN ON THIS PLAN LOCATED AT THE CORNERS OF THE LOT AND FENCE ES. EPOCHES FOR FENCE				3 5 15 9,426 TOTAL FENCE REMOVED FOR STORAGE = 1375 LIN. FT.			There are no easements required.			DATE REVISION DESCRIPTION	
																7-14-69 T.M. DELETED PAR. 1 P.S.	
																6-7-72 T.M. DELETED PAR. 10 P.S.	
																7-19-72 DELETED 8 P.S. & ADDED 8 WS	
																10 Dec 72 Delete Par 10 P.S.	
																4	
																12	

SUMMARY OF ADDITIONAL RIGHT OF WAY REQUIRED

14.21 15.00 LSI-71-1(II)
14.82 LSI-71-1(I)

WAR-71-(14.21-15.00)(14.82)
R/W PLANS
LIMITED ACCESS

FED. RD DIVISION	STATE	PROJECT	
2	OHIO		

83
4-A
12

TOTAL NO. OWNERS- 16 TOTAL NO. COMPLETE TAKES- TOTAL PARCELS WITH STRUCTURES INVOLVED- 2

PARCEL NO.	OWNER	DEED RECORD			RECORD AREA	TOTAL PRO	TOTAL TAKE	PRO IN TAKE	NET TAKE	NET RES. LT.	NET RES. RT.	BLDG'S TO BE ACQ'D	SHEET NO.	REMARKS	OTHER DESIGNATED EASEMENTS	TYPE FUND			
		BOOK	PAGE	DATE															
17 L	HAROLD C. CAREY AND HELEN J. CAREY	264	501	4-30-57	0.05							NO	9	COLD SPRINGS SUE DIVISION LOT NO. 18	No Easements Required	LS-I			
17 M	MAXINE MINER	317	113	10-10-61	0.06							NO	9	SAME LOT NO 19		LS-I			
17 N	EDWARD M. TAYLOR	337	300	4-30-63	0.09							NO	9	SAME LOT NO. 20-21		LS-I			
17 O	ALBERT J. YARGER	189 191	9 446	9-30-49 1-21-50	0.17							NO	9	SAME LOT NO. 22-23-34		LS-I			
17 F	A. R. COLLEY AND CLARA A. COLLEY	338	242	6-8-63	0.06							NO	9	SAME LOT NO. 24, PT 26		LS-I			
17 Q	LEONARD L. BARR AND ALTA BARR	273	202	1-11-58	0.10							NO	9	SAME LOT NO. 25-27-57, PT 26		LS-I			
17 R	WILLIAM H. HUNT AND OLGA HUNT	310	251	4-17-61	0.05							NO	9	SAME LOT NO. 28		LS-I			
17 U	URSULA DOGTERON	304	71	9-17-60	0.06							NO	9	SAME LOT NO. 37		LS-I			
17 V	REGINALD DUNN AND ELSIE DUNN	138	467	7-5-40	0.06							NO	9	SAME LOT NO. 41		LS-I			
17 W	WILLIAM D. DORFMEIER	281	203	9-26-58	0.14							NO	9	SAME LOT NO. 50	LS-I				
18	FAIRY SEXTON	303	354	9-2-60	2.90							NO	9	NO EASEMENT REQUIRED					
19	ELSIE PALMER ET AL	352 352 352	329 330 333	6-16-64 6-16-64 6-16-64	2.85							NO		" " "		LS-I			
20 WS	LUTHER WELCH JR	353	259	7-10-64	79.29(Deed) 84.183(Calc.)	0.380	75.852	0	75.852	83.803 Incl. W.S. Area	0	NO	10	Used Calculated Area		LS-I			
21	DELLA MAE SNIDER	121 126	268 204	4-20-29 8-17-31	102.43							NO	9	NO EASEMENT REQUIRED					
22	VIRGIL L AND CARRIE ROBINSON	196	411	8-11-50										NO EASEMENT REQUIRED					
23 23 APS	LITTLE MIAMI RAILROAD, OPERATED BY THE PITTSBURGH, CINCINNATI CHICAGO AND ST. LOUIS RAILWAY COMPANY											NO	10	DELETED		LS-I			
24 PS 24 APS	NOLIE POWELL AND GRACE POWELL	353 333 342	262 266 363	7-10-64 1-14-63 9-7-63	97.491 86.937	2.924 1.327	95.359 15.965	1.924 0.000	83.435 15.965	94.567 Incl. P.S. Areas 85.610		NO NO	10 10						
25	DEPARTMENT OF NATURAL RESOURCES, STATE OF OHIO															LS-I			
26 PS	MARVIN E. YOUNG AND MERYL B. GRAY	338 353	635 268	6-8-63 6-10-64	60.792	0.048	59.586	0.000	59.586	60.744 Incl. P.S. Area	0	NO	10			LS-I			
27 PS 27 APS 27 EPS 27 CPS	SALVATION ARMY	260 262 272 294 345 362	132 63 542 453 96.498 520	11-1-56 1-18-57 12-28-57	154.232	1.177	3.233 39.082 0.177 0.052	0 0 0 0	3.233 39.082 0.177 0.052	3.233 0.177 0.052	149.593	NO	10			LS-I			
38 38 A 38 B	CINCINNATI GAS AND ELECTRIC CO. DAYTON POWER AND LIGHT CO. COLUMBUS AND SOUTHERN OHIO ELEC CO.	359	246				1.250 7.104 13.273		1.250 7.104 13.273			NO	12 12 12			LS-I			
IPS	HUBERT TERRY AND BETTY TERRY						0.869		0.869			NO	5-6						
UTILITIES		CENTERLINE-REFERENCE-MONUMENTS				SYMBOLS				TYPE 47 FENCE QUANTITIES				GENERAL NOTES			COMPLETION DATE 11-30-66		
																	DATE	REVISION	DESCRIPTION
																	8 Aug 68	Deleted Par 27AX	N
																	3 July 69	Deleted Par 23 & 23ARS	N/M
																	7-14-69	DELETED PAR. 27PS, BPS, CRS.	T.M.
																	6-7-72	DELETED PAR. 24 P.S., A-PS, 26 P.S.	T.M.
														4-2-73			Changed Par 20 PS & 20 WS	H.J	
																		4-A	
																		12	

Scenic Drive "A"
Curve Data
P.I. ~ 431+00.00
 $\Delta \sim 30^{\circ} 20' Lt$
 $D \sim 9^{\circ} 00'$
 $R \sim 636.62'$
 $T \sim 172.57'$
 $L \sim 337.04'$ TURT

Cont. 2.878 AC
PRO 0.476

Total 3.354 AC.

Cont. 0.784 Ac
PRD. 0.079

Total 0.863 Ac.

Cont. 7.548
P.R.O. 0.000

S. 84° 58' 11" W.
675.54'

State of Ohio
(Acquired by Warranty Deed)

Existing R/W Acquired
on WAR-1-9.75-1962-63

Cont. 0.085 AC.
PRO 0.023
Total 0.108 AC.

Proposed Trailer Parking

5 Const Limits

Cont.	0.869
P.R.O.	0.000
<u>Total</u>	<u>0.869</u>

Cont. 4.258 Ac.
P.R.O. 0.000

Total 4.258 Ac.

Oakley Roy Williams
and
Phyllis Irene Williams

$M \sim 51 + 30.46$
 $\Delta \sim 0^{\circ} 46' LT$
 $D \sim 0^{\circ} 16'$
 $R \sim 21, 485.92'$
 $T \sim 143.75$
 $L \sim 287.50$
 $P.C. 36 + 06.71$
 $P.T. S_0 \sim 38 + 94.21$

4 Cont. 0.391 Ac.
P.R.O 0.130
Total 0.521 Ac.

TYPE "47" FENCE 6044	Lin. Ft.
E.P.A.	0
C.P.A.	2
I.A.P.A.	10

TYPE FUND
LS-1

R/W Plan Sta. 902+00 to Sta. 932+00

14.21-15.00 LSI-71-1(11)
14.82 LSI-71-1(1)

FED. RD. DIVISION	STATE	PROJECT
2	OHIO	

WAR-71-(14.21-15.00)(14.82)
R/W PLANS
LIMITED ACCESS

88

7
12

Scenic Drive "A" - Curve Data

Curve "A"	Curve "B"	Curve "C"	Curve "D"
PI-441+53.00 Δ-23°00' Rt D-57°17'45" R-100.00' T-20.35' L-40.14' PC-411+32.66 PT-411+72.80	PI-443+65.44 Δ-65°45' Lt D-59°40'59" R-96.00' T-62.05' L-110.17' PC-443+03.39 PCC-444+13.56 PT-444+52.41	PI-444+33.30 Δ-42°00' Lt D-108°06'13" R-53.00' T-20.35' L-38.85' PC-444+13.56 PCC-444+52.41	PI-445+61.23 Δ-36°30' Lt D-17°21'44" R-330.00' T-108.82' L-210.23' PCC-444+52.41 PCC-446+62.64
Curve "E"	Curve "F"	Curve "G"	
PI-446+89.19 Δ-55°00' Lt D-112°20'41" R-51.00' T-26.55' L-48.96' PCC-446+62.64 PCC-447+11.60	PI-447+91.71 Δ-61°00' Lt D-42°07'45" R-136.00' T-80.11' L-144.79' PCC-447+11.60 PT-448+56.39	PI-450+42.65 Δ-57°15' Rt D-57°17'45" R-100.00' T-54.58' L-99.92' PC-449+88.07 PT-450+87.99	

Dept. of Natural Resources
State of Ohio
Turtle Creek Township
T5E
SECTION 5
R3N

Cont. 10.675 Ac.
P.R.O. 0.000
Total 10.675

Cont. 4.045
P.R.O. 0.082
Total 4.127

TURTLE CREEK TOWNSHIP
T5E
SECTION 5
R3N

Albert A Motre
V.131-P460
9-17-36

Cont. 3.623 Ac.
P.R.O. 0.139
Total 3.762

Cont. 16.153 Ac.
P.R.O. 0.000
Total 16.153 Ac.

Cont. 5.711 Ac.
P.R.O. 0.000
Total 5.711 Ac.

Cont. 17.579 Ac.
P.R.O. 0.188
Total 17.767 Ac.

Scenic Drive "C" - Curve Data

PI-229+92.00 Δ-90°00' Rt D-56°10'20" R-102.00' T-160.22' L-102.00' PC-228+90.00 PCC-230+50.22 PI-231+52.22 Δ-90°00' Rt D-56°10'20" R-102.00' T-160.22' L-102.00' PT-232+10.44

Curve Data

PI-921+34.81 Δ-18°37'36" Lt D-0°28' T-2013.48' L-3991.43' R-12,277.67'

TYPE "47" FENCE 1616 Lin. Ft.
E.P.A. 1
C.P.A. 1
I.A.P.A. 3

TYPE FUND
LS-1

COMPLETION DATE 11-30-66

Date	Revision	Description
4/1/67	1	Changed bearings & distances. Permits, STA 957+10
12/24/67	2	Rev location of structures & added structures. RS 13 NM
7-19-72	3	DELETED 8 PS & ADDED WS
		JTC.
		7
		12

R/W Plan Sta. 932+00 to Sta. 960+00

LINE	BEARING	DISTANCE
A-B	N 5° 02' 31" E	161.739'
B-C	N 41° 56' 48" E	475.687'
C-D	N 89° 20' 08" E	23.652'
D-E	N 75° 03' 37" E	303.79'
E-F	S 1° 55' 33" E	123.01'
F-G	S 5° 26' 06" W	513.23'
G-A	N 85° 36' 55" W	606.08'
E-O	N 75° 03' 37" E	91.96'
R-I	S 5° 26' 05" W	611.05'
I-J	S 51° 31' 08" W	95.49'
J-K	S 4° 05' 44" W	111.80'
K-L	S 84° 23' 50" E	170.00'
L-M	N 23° 05' 52" E	357.11'
M-N	N 44° 54' 38" E	260.00'
N-R	N 51° 51' 50" W	436.15'
N-Q	N 62° 46' 00" E	120.42'
Q-P	N 47° 00' 12" E	101.44'
P-O	N 56° 20' 32" W	625.84'
F-R	S 5° 26' 05" W	79.21'

MAP OF SCENIC EASEMENTS TO BE ACQUIRED BY THE OHIO DEPT. OF HIGHWAYS

14.21-15.00 LSI-71-I(II)
14.82 LSI-71-I(II)

FED. RD. DIVISION	STATE	PROJECT
2	OHIO	

WAR-71-(14.21-15.00)(14.82)
R/W PLANS
LIMITED ACCESS

COLD SPRINGS SUBDIVISION (Unrecorded)


Not to Scale

Suggest
of Pro
Power
13

50

Parcel	Owner	Lot No.	Acres
17	Cold Springs Sub.	29-35-36-38-39-40-42-43-44-45-46-47-48-53-54-49	12.70 AC
17A	Hugh A. Whitesell	1-53	0.14 AC
17B	Eva W. McMillan	2-3-53-54	0.28 AC
17C	Carl Taylor & Ruth Zimmerman	4-52	0.14 AC
17D	Mary Lemon	5-51	0.14 AC
17E	Marjorie Ridenor	6-7-56	0.21 AC
17F	Charles D. Poulos	8-9	0.14 AC
17G	Evelyn Herres	10-11	0.09 AC
17H	Kelly Hale	12	0.05 AC
17I	Fred C. & Zelma F. Boty	13-14-Pl.15	0.14 AC
17J	Betty C. Headworth	16-Pl.13	0.08 AC
17K	Howard A. & Betty R. Hiatt	17	0.05 AC
17L	Harold C. & Helen J. Carey	18	0.05 AC
17M	Maxine Miner	19	0.06 AC
17N	Edward M. Taylor	20-21	0.09 AC
17O	Albert J. Varger	22-23-34	0.17 AC
17P	A.R. & Clara A. Colley	24-Pl.26	0.06 AC
17Q	Lenard L. & Alta Barr	Pl.25-27-57	0.10 AC
17R	William H. & Ida Alta Hunt	28	0.05 AC
17U	Ursula Dogterom	37	0.06 AC
17V	Reginald & Elsie Dunn	41	0.06 AC
17W	William D. Dorfmeier	50	0.14 AC

POINT	STATION	OFFSET
A	947+64.28	3534.92' Lt.
B	948+38.99	3678.37' Lt.
C	952+68.04	3883.78' Lt.
D	952+90.0	3876.0' Lt.
E	955+91.17	3835.19' Lt.
F	955+48.0	3720.0' Lt.
G	953+05.0	3261.14' Lt.
R	955+10.93	3650.00' Lt.
I	952+24.86	3110.00' Lt.
J	951+30.0	3100.0' Lt.
K	950+80.0	3000.0' Lt.
L	952+90.0	2920.0' Lt.
M	954+85.0	3180.0' Lt.
N	957+25.0	3270.0' Lt.
O	955+91.17	3835.19' Lt.
P	959+40.0	3315.57' Lt.
Q	958+45.0	3280.0' Lt.

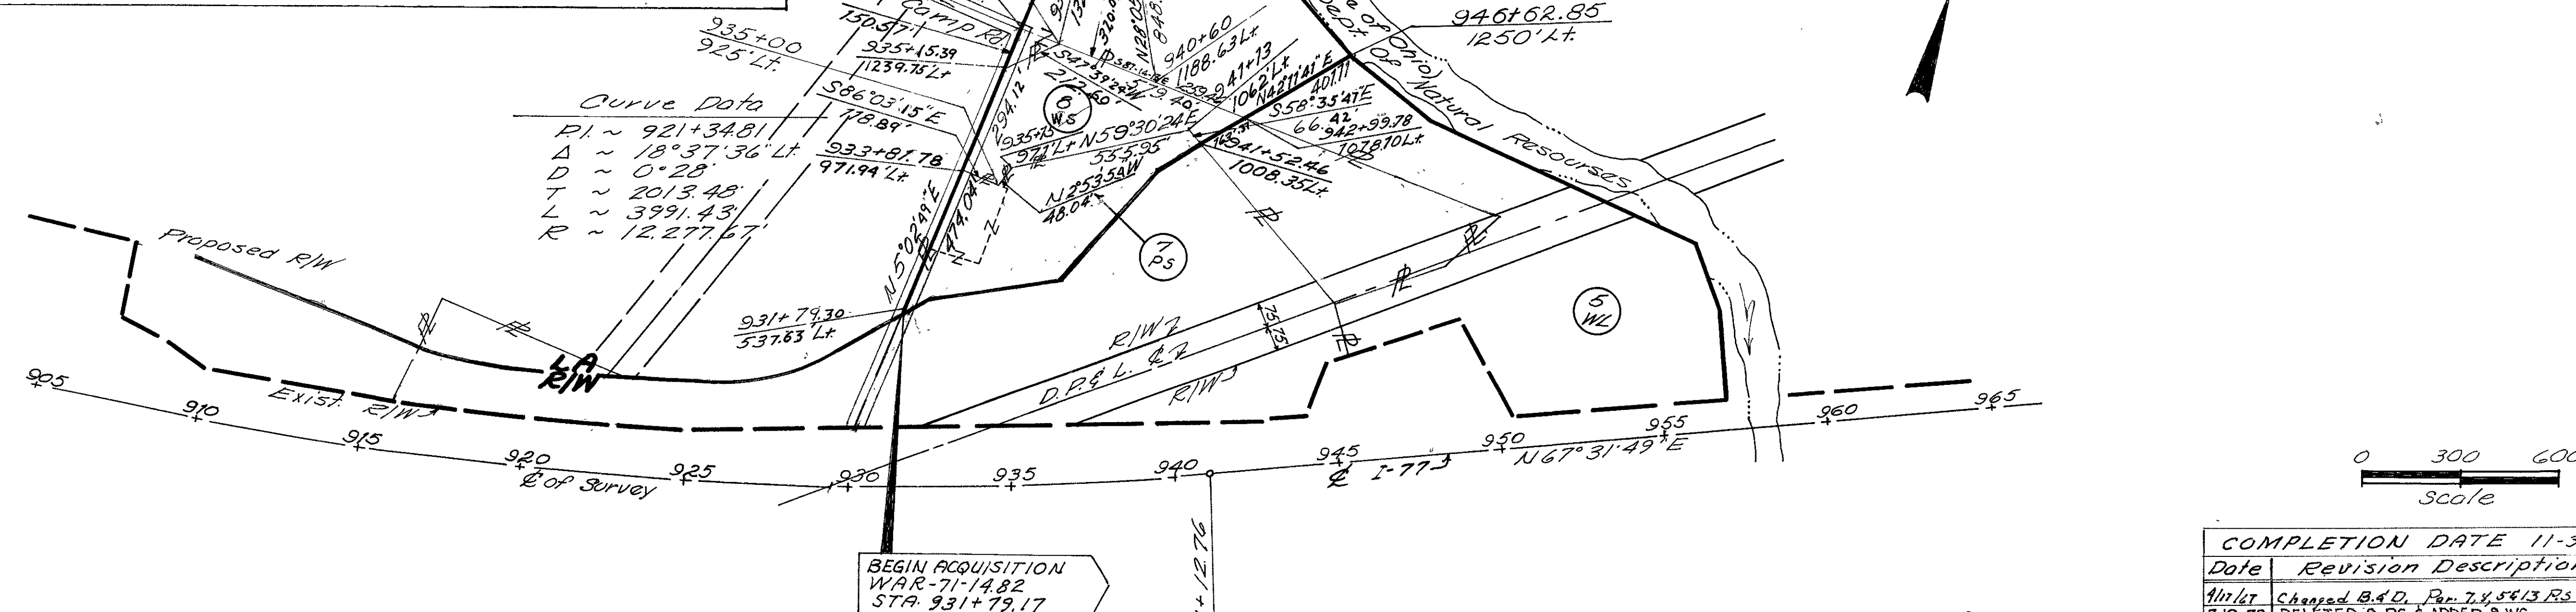

TO BE ACQUIRED		TOTAL TAKE	RECORD AREA
5	PS Albert A. Matra	10.675	43.732
7	PS Robert & Irene Jenkins	5.053	22.82
8	PS Myrtle Collett	3.762	9.473
12	William D. Dorfmeier		
13	PS Alta May Danbury	4.127	20.89
14	PS Edward C. & Elizabeth Shaw		
15	PS Clarence Stegemoller		
16	PS Salos O. & Eva M. Thomas		
17	Cold Springs Subd.		
18	Fairy Sexton		
19	Elsie Palmer		
21	Della Mae Snider		
25	State of Ohio (Dept. of Natural Resources)		

T.B.A. 4

COMPLETION DATE 11-30-66	
Date	Revision Description
7-19-72	Checked B.A.D. Per 7-14-73 Rs. Deleted 8 PS. & Added 8 WS
	JTC.

TYPE FUND
LS-1

Scenic Easements

Parcel No.	Owner	Total Take	Record Area
9 PS	Ohio State Archaeological & Historical Society	75.852 Ac.	84.183 Ac.
20 WS	Virgil L. & Carrie Robinson	0.437 Ac.	
23A-PS	Little Miami Railroad	85.359 Ac.	97.491
24 PS	Nolie & Grace Powell	15.965 Ac.	86.937
24A-PS	..	59.586 Ac.	60.792 Ac.
26 PS	Marvin E. Young & Meryl B. Gray	3.233 Ac.	
27 PS	Salvation Army	39.082 Ac.	
27A-PS	..	0.177 Ac.	
27B-PS	..	0.032 Ac.	
27C-PS	..	0.085 Ac.	
27A-S	..	0.085 Ac.	

MAP OF SCENIC EASEMENTS TO BE ACQUIRED BY THE OHIO DEPT. OF HIGHWAYS

14.21 15.00 LSI-71-I(II)
14.82 LSI-71-I(II)

FED. RD. DIVISION	STATE	PROJECT
2	OHIO	

WAR-71-(14.21-15.00)(14.82)
R/W PLANS
LIMITED ACCESS

Note: The Little Miami Railroad is operated by the Pittsburgh, Cincinnati, Chicago, and St. Louis Railway Co.

CURVE DATA
PI ~ 921+34.81
D ~ 18°37'36" LT
T ~ 0°28'00"
L ~ 2013.48'
R ~ 12477.67'

WASHINGTON TWP.
V.M.S. 737, 1505

DETAIL C

Scale in Feet
DETAIL B

Scale in Feet
DETAIL A

0 300 600
Scale

Date	Revision Description	T.M.
7-31-68	added Parcel 27A-S	T.M.
8-Aug-68	Deleted Parcel 27A-X & 23A-PS	N.M.
7-6-72	DELETED PAR. 24 PS. & A-PS.	T.M.
4-2-73	Changed Parcel 20PS to 20WS	H.J.

TYPE FUND
LS-1

Scenic Easement

MAP OF SCENIC EASEMENTS
TO BE ACQUIRED BY THE
DEPARTMENT OF HIGHWAYS

14.21 15.00 LSI-71-1(11)
14.82 LSI-71-1(1)

FED. RD. DIVISION	STATE	PROJECT
2	OHIO	

92



WAR-71-(14.21-15.00)(14.82)

11
12

R/W PLANS
LIMITED ACCESS

CURVE DATA

PI ~ 921+34.81
Δ ~ 18°37'36" Lt
D ~ 0°28'
T ~ 2013.48'
L ~ 3991.43'
R ~ 12,277.67'

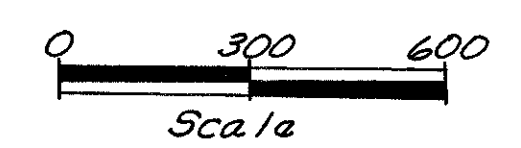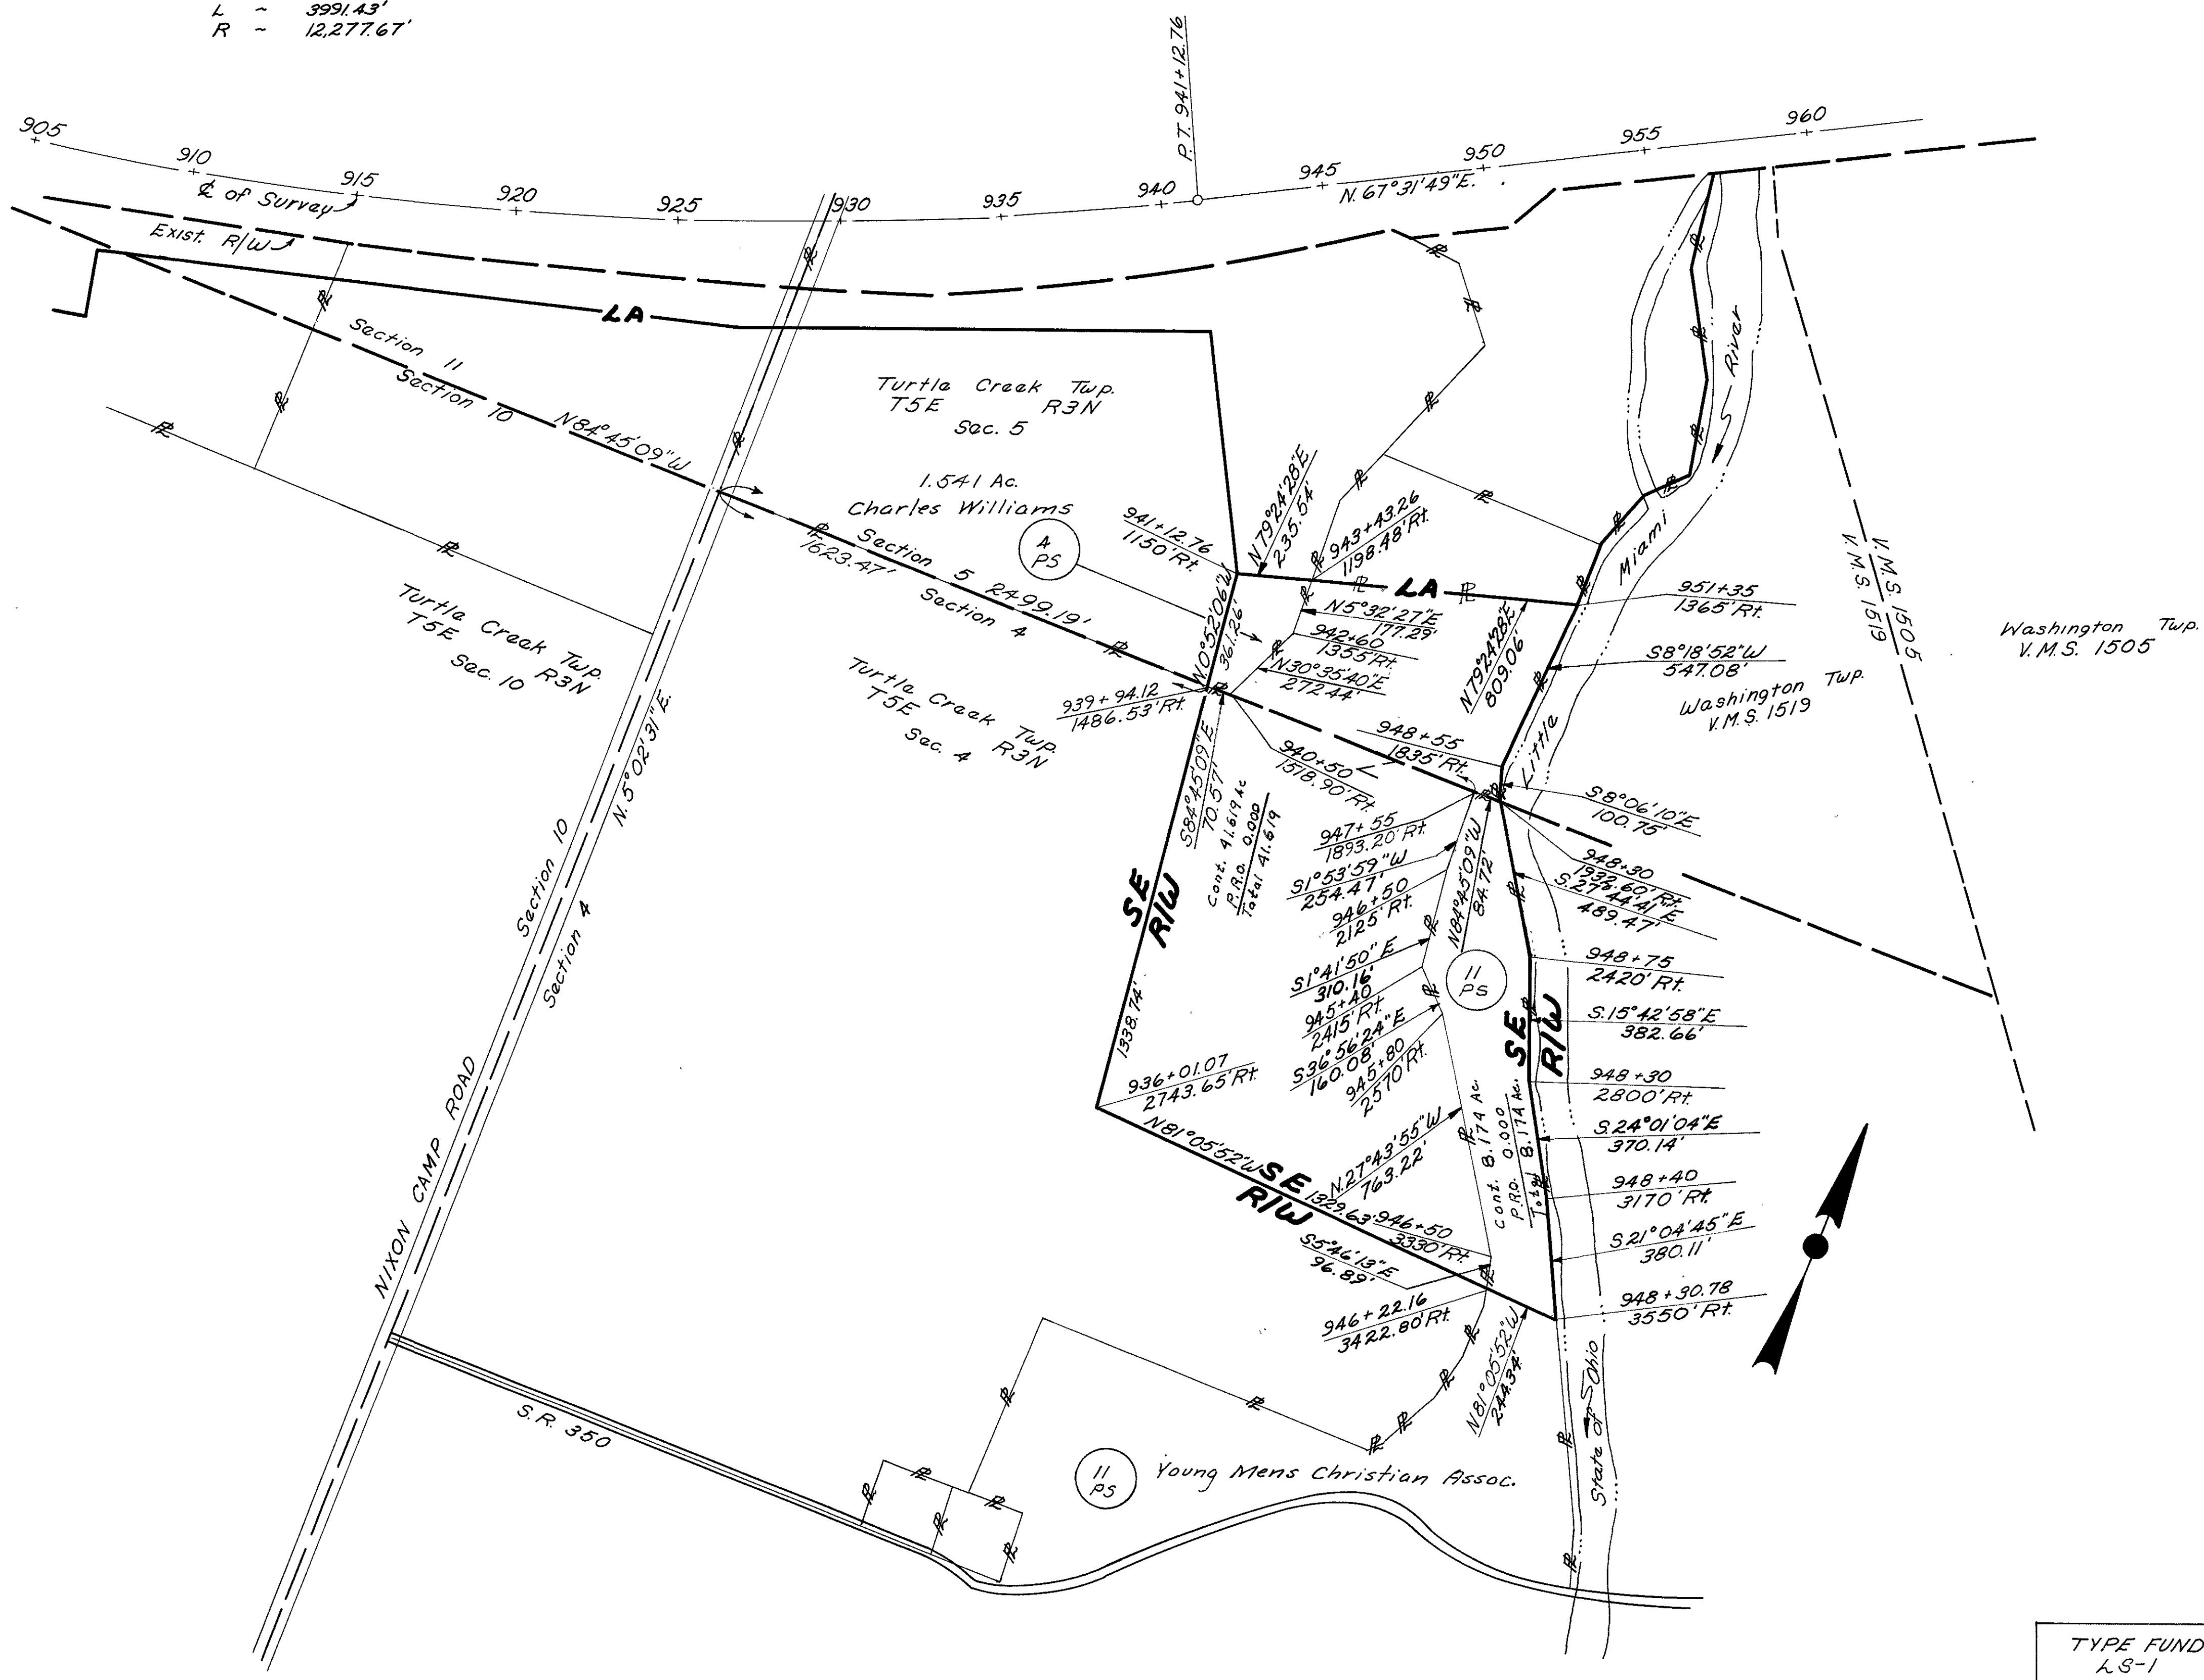

COMPLETION DATE -11-30-66		
Date	Revision	Description
7-6-72	DELETED PAR. 10 PS.	T.M.
18 Dec 72	Delete Par 10 B	N.M.

TYPE FUND	LS-1	11
		12

DAYTON POWER & LIGHT CO.	
Parcel No.	Area
38	1.250 AC.
38-A	7.104 AC.
38-B	13.273 AC.

PLAT SHOWING PROPERTY TO BE ACQUIRED FROM THE DAYTON POWER & LIGHT CO.


0 200 400 600 800

14.21-15.00 LSI-71-1(11)
14.82 LSI-71-1(1)

FED. RD. DIVISION	STATE	PROJECT
2	OHIO	

WAR-71-(14.21-15.00)(14.82)
R/W PLAN
LIMITED ACCESS

93
12
12

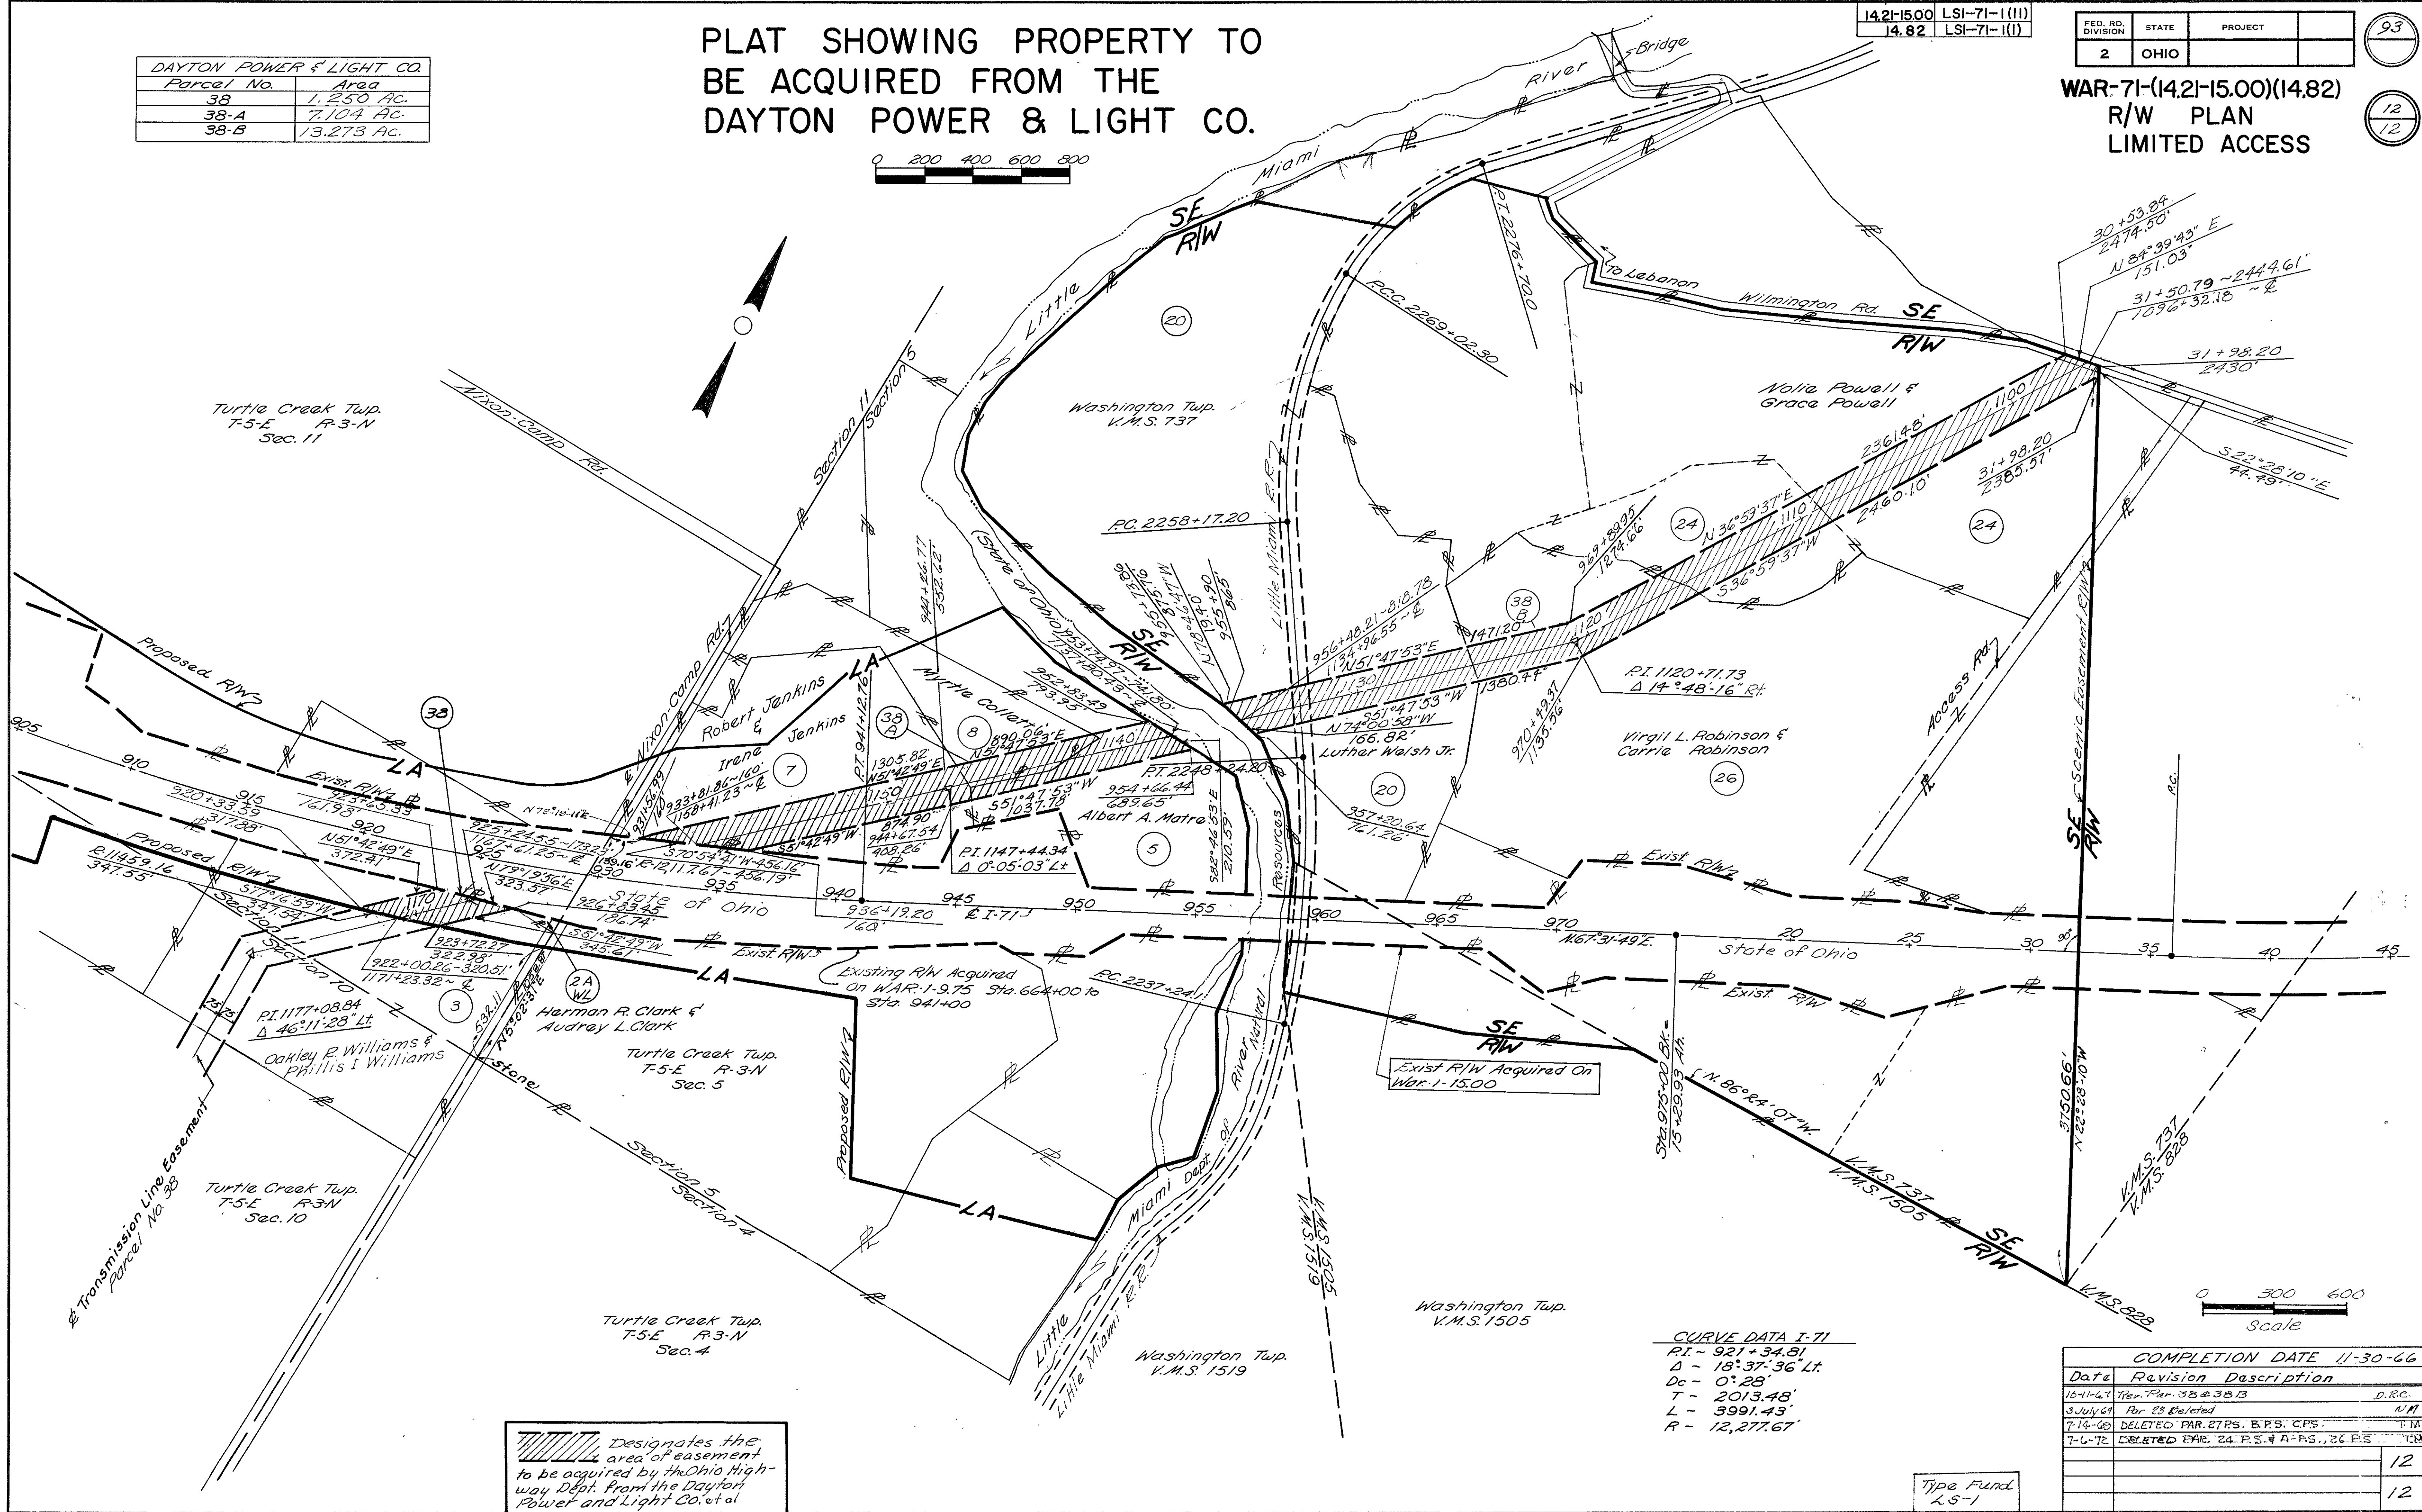

CURVE DATA I-71
P.I. - 921+34.81
Δ - 18°37'36" Lt.
Dc - 0°28'
T - 2013.48'
L - 3991.43'
R - 12,277.67'

COMPLETION DATE 11-30-66		
Date	Revision	Description
10-1-67	Per. Par. 33 & 35.13	D.R.C.
3-1-67	Per. 23 Deleted	N.M.
7-14-66	DELETED PAR. 27PS. BPS. CPS.	T.M.
7-6-72	DELETED PAR. 24 P.S. & A-PS., 26 P.S.	T.M.
		12
		12

Type Fund
LS-1