

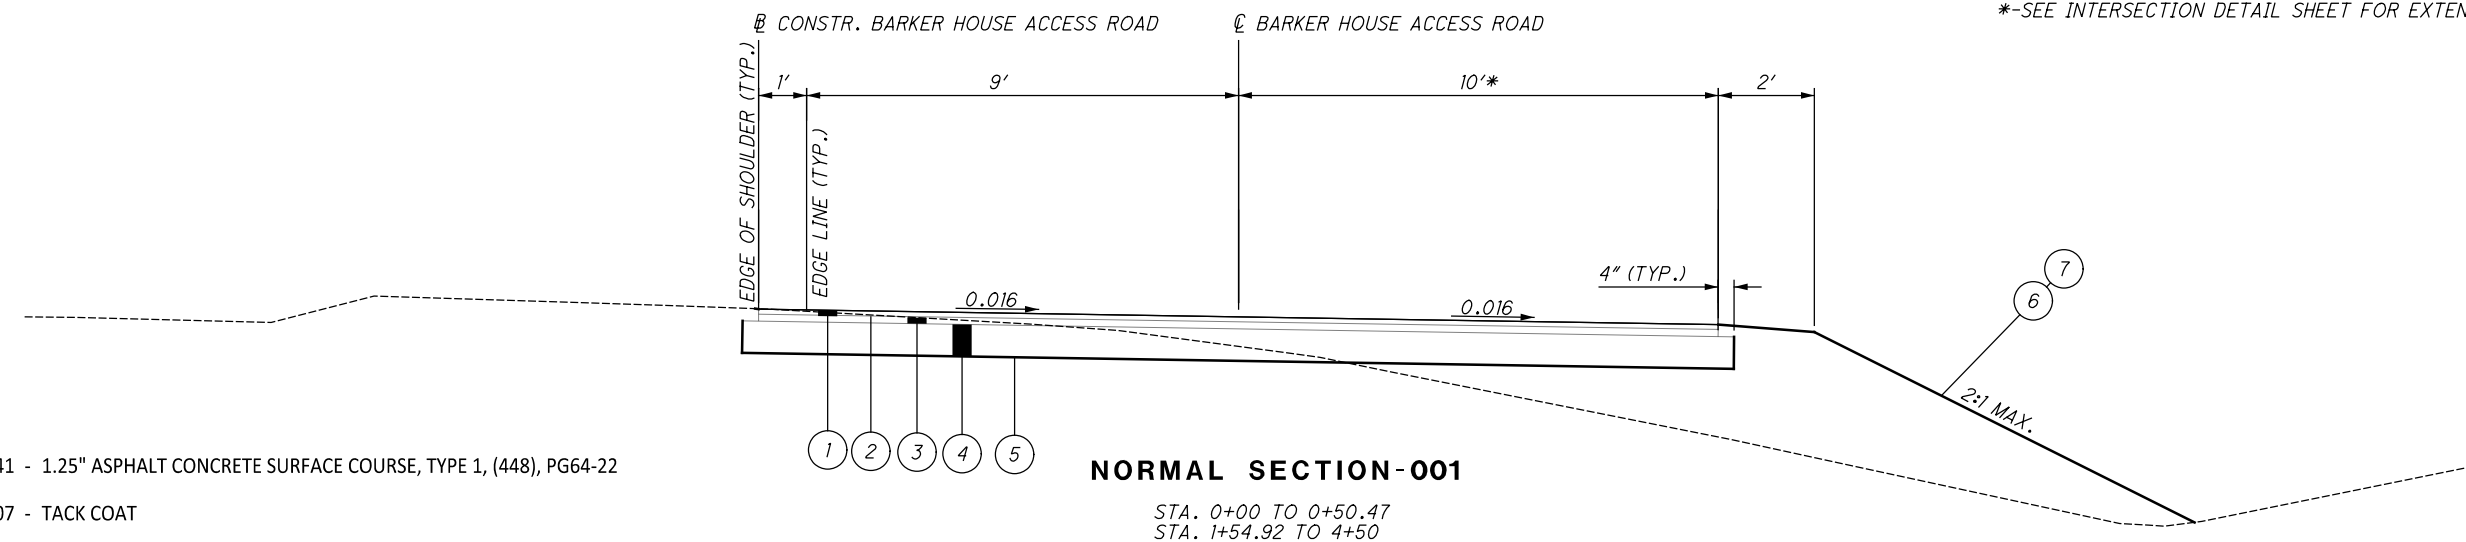


\*-SEE INTERSECTION DETAIL SHEET FOR EXTENDED PAVEMENT DETAILS

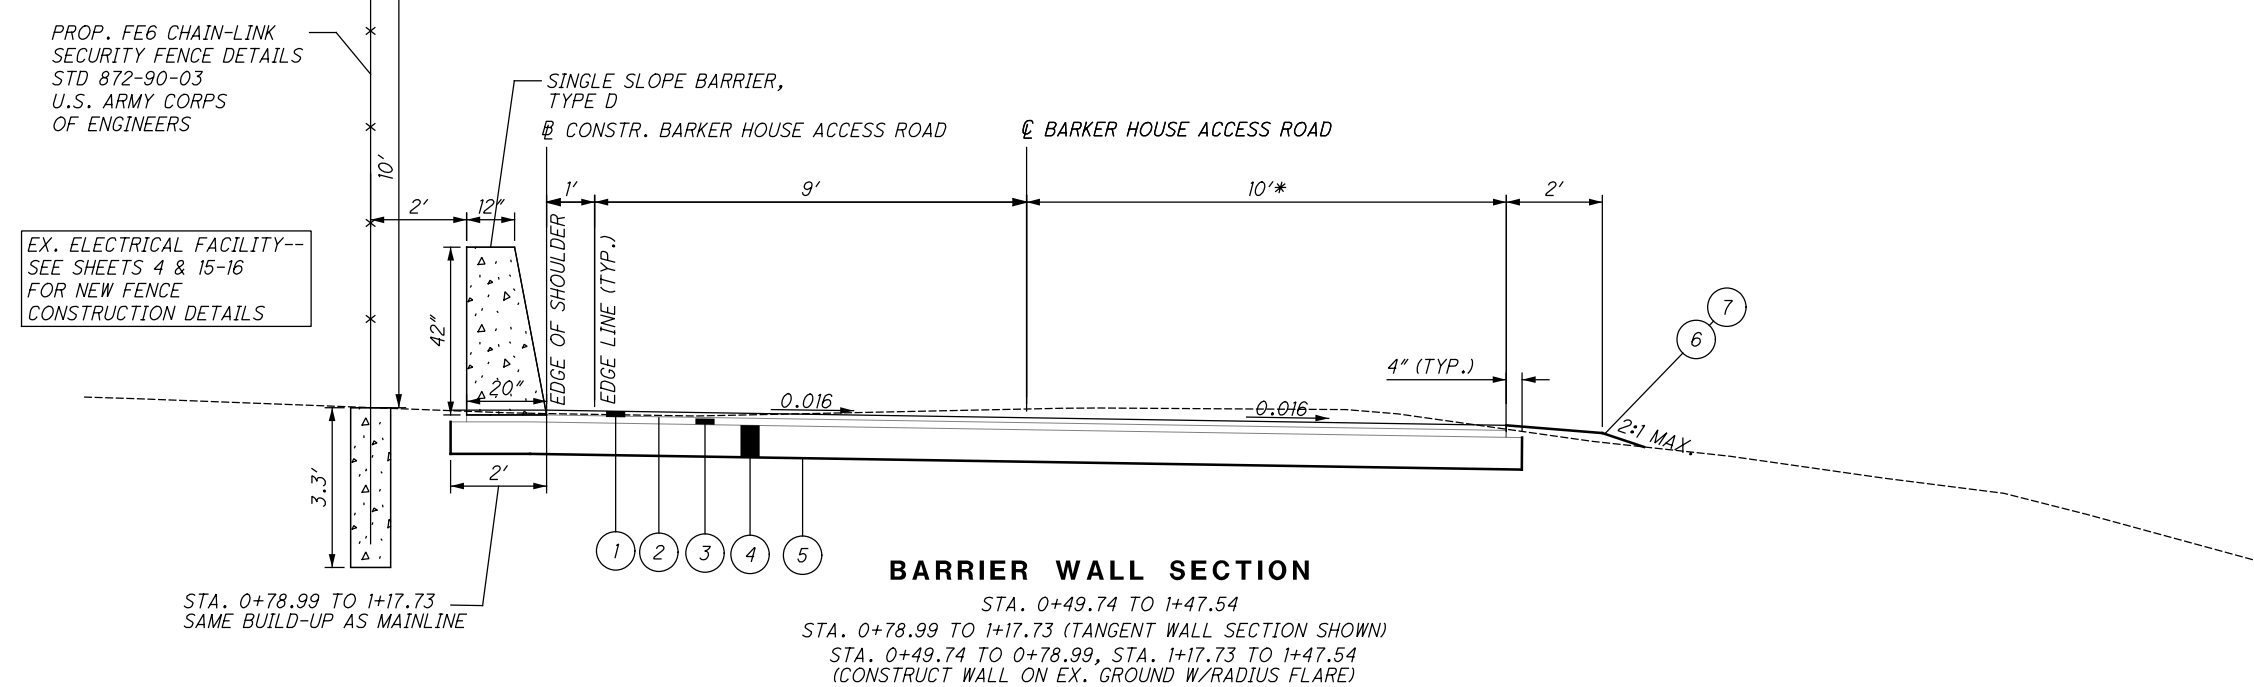

- ① ITEM 441 - 1.25" ASPHALT CONCRETE SURFACE COURSE, TYPE 1, (448), PG64-22
- ② ITEM 407 - TACK COAT
- ③ ITEM 441 - 1.75" ASPHALT CONCRETE INTERMEDIATE COURSE, TYPE 2, (448)
- ④ ITEM 304 - AGGREGATE BASE (8")
- ⑤ ITEM 204 - SUBGRADE COMPACTION
- ⑥ ITEM 203 - EMBANKMENT
- ⑦ ITEM 659 - SEEDING AND MULCHING

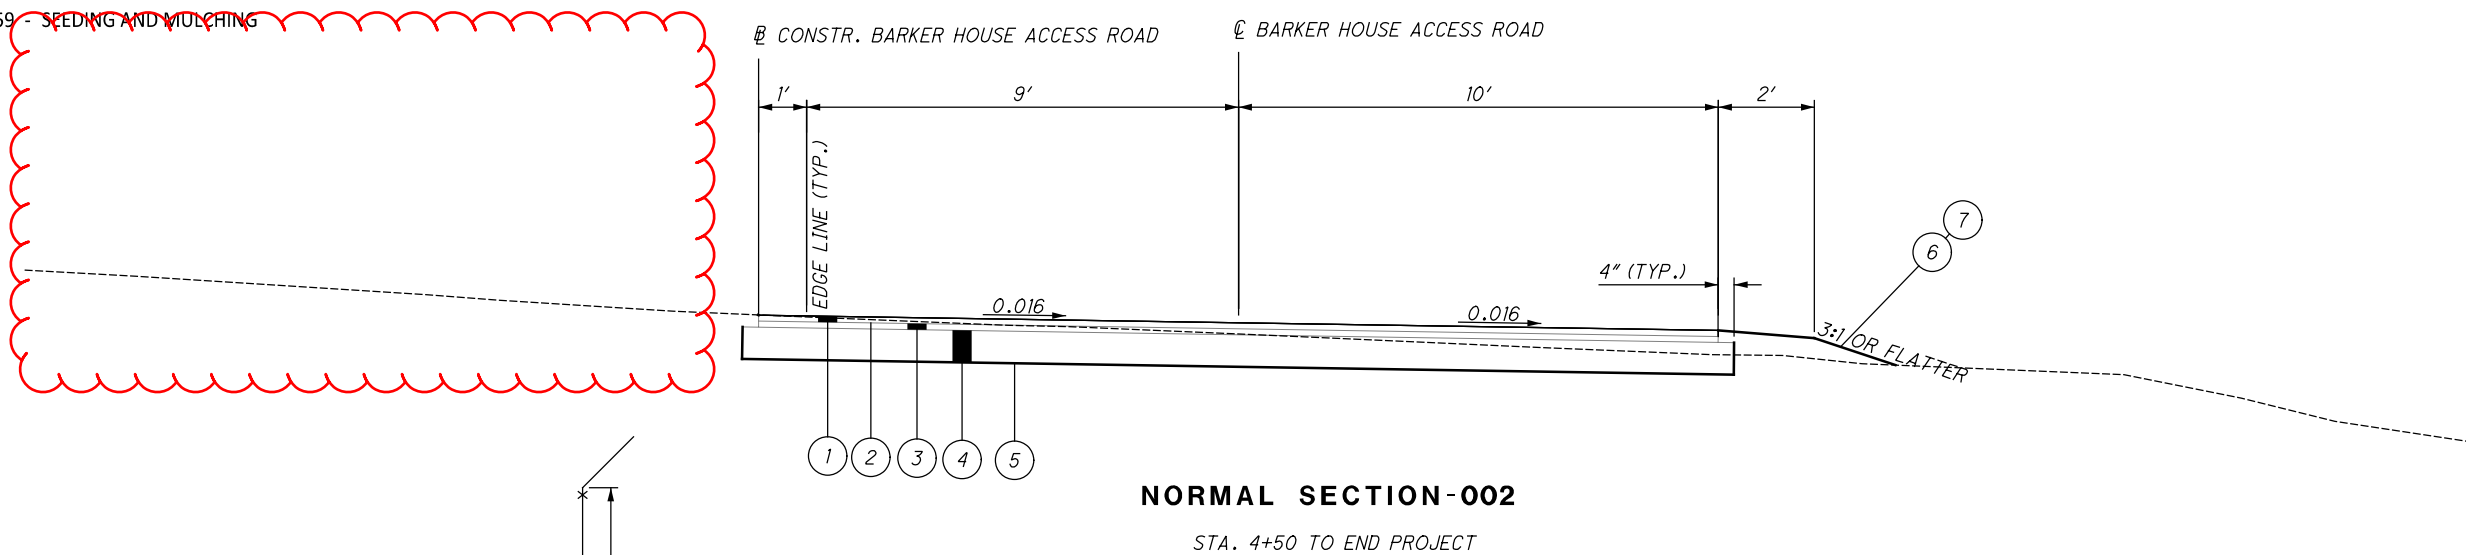

I:\ProjectData\WAS-7-32.39\Design\Roadway\Sheets\13399\_GY002.dgn Sheet 7/14/2021 8:45:33 AM ereed

TYPICAL SECTIONS

WAS-7-32.15

I:\ProjectData\WAS-7-32\39\Design\Roadway\Sheets\13399\_GG001.dgn\_Sheet 7/15/2021 3:54 PM er eead

SHEET NUM.										PART.			ITEM	ITEM	GRAND	UNIT	DESCRIPTION	SEE SHEET NO.
5	6	7	9	14						01/NHS/PV			EXT	TOTAL				
																	<b>ROADWAY</b>	
LUMP										LUMP			201	11000	LS	CLEARING AND GRUBBING		
				22						22			202	23000	22	SY	PAVEMENT REMOVED	
				99						99			202	35100	99	FT	PIPE REMOVED, 24" AND UNDER	
				102						102			202	75001	102	FT	FENCE REMOVED, AS PER PLAN	5
			657							657			203	10000	657	CY	EXCAVATION	
			454							454			203	20000	454	CY	EMBANKMENT	
			3,781							3,781			204	10000	3,781	SY	SUBGRADE COMPACTION	
56										56			204	13000	56	CY	EXCAVATION OF SUBGRADE	
56										56			204	20000	56	CY	EMBANKMENT	
2										2			204	45000	2	HOUR	PROOF ROLLING	
				56						56			607	98000	56	FT	FENCE, MISC.:USACE TYPE FE6 CHAIN LINK FENCE (6'-0" FABRIC WIDTH)	5
				31						31			607	98000	31	FT	FENCE, MISC.:USACE TYPE FE6 CHAIN LINK FENCE (10'-0" FABRIC WIDTH)	5
				1						1			607	50901	1	EACH	GATE, TYPE CL, AS PER PLAN	5
				70						70			622	10160	70	FT	CONCRETE BARRIER, SINGLE SLOPE, TYPE D	
				2						2			622	25000	2	EACH	CONCRETE BARRIER END SECTION, TYPE D	
				1						1			SPECIAL	69050350	1	EACH	MAILBOX REMOVED AND RESET	4
																	<b>EROSION CONTROL</b>	
65										65			659	00300	65	CY	TOPSOIL	
1,105										1,105			659	10000	1,105	SY	SEEDING AND MULCHING	
221										221			659	14000	221	SY	REPAIR SEEDING AND MULCHING	
0.1										0.1			659	20000	0.1	TON	COMMERCIAL FERTILIZER	
0.23										0.23			659	31000	0.23	ACRE	LIME	
2										2			659	35000	2	MGAL	WATER	
583										583			670	00500	583	SY	SLOPE EROSION PROTECTION	
																	<b>DRAINAGE</b>	
				0.5						0.5			602	20000	0.5	CY	CONCRETE MASONRY	
				62						62			611	10200	62	FT	24" CONDUIT, TYPE A	
				87						87			611	00101	87	FT	4" CONDUIT, TYPE B, AS PER PLAN	5
				1						1			611	99551	1	EACH	MANHOLE, NO. 1, AS PER PLAN	5
																	<b>PAVEMENT</b>	
				84						84			252	01500	84	FT	FULL DEPTH PAVEMENT SAWING	
				315						315			254	01000	315	SY	PAVEMENT PLANING, ASPHALT CONCRETE (1.25" DEPTH)	
			803							803			304	20000	803	CY	AGGREGATE BASE	
			209							209			407	10000	209	GAL	TACK COAT	
			132							132			441	50000	132	CY	ASPHALT CONCRETE SURFACE COURSE, TYPE 1, (448), PG64-22	
			185							185			441	50300	185	CY	ASPHALT CONCRETE INTERMEDIATE COURSE, TYPE 2, (448)	
																	<b>TRAFFIC CONTROL</b>	
				9						9			630	80100	9	SF	SIGN, FLAT SHEET	
				1						1			630	08600	1	EACH	SIGN POST REFLECTOR	
				12						12			630	03100	12	FT	GROUND MOUNTED SUPPORT, NO. 3 POST	
				50						50			642	00500	50	FT	STOP LINE, TYPE 1	
				0.29						0.29			642	00300	0.29	MILE	CENTER LINE, TYPE 1	
				0.58						0.58			642	00100	0.58	MILE	EDGE LINE, 4", TYPE 1	
																	<b>MAINTENANCE OF TRAFFIC</b>	
			0.02							0.02			614	21000	0.02	MILE	WORK ZONE CENTER LINE, CLASS I	
			0.26							0.26			614	22000	0.26	MILE	WORK ZONE EDGE LINE, CLASS I, 4"	
			35							35			615	20000	35	SY	PAVEMENT FOR MAINTAINING TRAFFIC, CLASS A	
5										5			616	10000	5	MGAL	WATER	
																	<b>INCIDENTALS</b>	
LUMP										LUMP			614	11000	LS		MAINTAINING TRAFFIC	
										LUMP			623	10000	LS		CONSTRUCTION LAYOUT STAKES AND SURVEYING	
										LUMP			624	10000	LS		MOBILIZATION	

**GENERAL SUMMARY**

**WAS-7-32.15**

CALCULATED  
EPR  
CHECKED  
XXX