


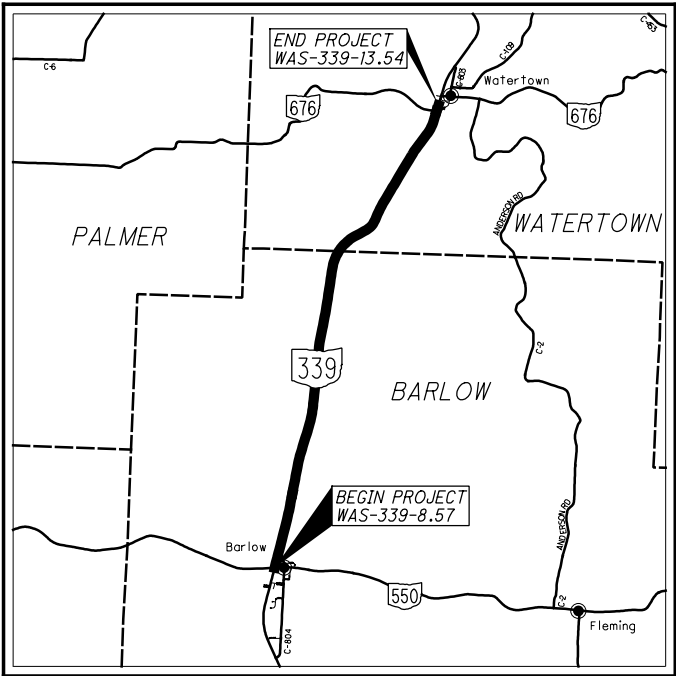

LOCATION MAP

LATITUDE: 39°26'19" LONGITUDE: -81°39'22"

PORTION TO BE IMPROVED	
INTERSTATE HIGHWAY	
FEDERAL ROUTES	
STATE ROUTES	
COUNTY & TOWNSHIP ROADS	
OTHER ROADS	

DESIGN DESIGNATION

CURRENT ADT (2025)	3600
DESIGN YEAR ADT (2037)	4000
DESIGN HOURLY VOLUME (2037)	550
DIRECTIONAL DISTRIBUTION	78.4%
TRUCKS (24 HOUR B&C)	13%
DESIGN SPEED	55
LEGAL SPEED	55
DESIGN FUNCTIONAL CLASSIFICATION:	
MINOR ARTERIAL	
NHS PROJECT	NO

DESIGN EXCEPTIONS

NONE REQUIRED

ADA DESIGN WAIVERS

NONE REQUIRED

UNDERGROUND UTILITIES
Contact Two Working Days
Before You Dig

OHIO811.org
Before You Dig

OHIO811, 8-1-1, or 1-800-362-2764
(Non members must be called directly)

PLAN PREPARED BY:
OHIO DEPARTMENT OF TRANSPORTATION
DISTRICT 10 - PLANNING AND ENGINEERING
MARIETTA, OHIO

STATE OF OHIO
DEPARTMENT OF TRANSPORTATION

WAS-339-8.57

BARLOW & WATERTOWN TOWNSHIPS

WASHINGTON COUNTY

INDEX OF SHEETS:

TITLE SHEET	1
TYPICAL SECTIONS	2
GENERAL NOTES	3
GENERAL SUMMARY	4
PAVEMENT SUBSUMMARY	5
SIDEROAD SUBSUMMARY	6
TRAFFIC CONTROL SUBSUMMARY	7
TRAFFIC DEPARTMENT PARKING LOT DETAIL	8

FEDERAL PROJECT NUMBER

E250605

RAILROAD INVOLVEMENT

NONE

PROJECT DESCRIPTION

TWO-LANE RESURFACING PROJECT USING
FINE GRADED POLYMER OVERLAY .
WAS 339 8.57 TO 13.54

EARTH DISTURBED AREAS

PROJECT EARTH DISTURBED AREA:	0 ACRES
ESTIMATED CONTRACTOR EARTH DISTURBED AREA:	0 ACRES
NOTICE OF INTENT EARTH DISTURBED AREA:	N/A (NOI NOT REQUIRED)

2023 SPECIFICATIONS

THE STANDARD SPECIFICATIONS OF THE STATE OF OHIO, DEPARTMENT OF
TRANSPORTATION, INCLUDING SUPPLEMENTAL SPECIFICATIONS LISTED IN
THE PLANS, CHANGES LISTED IN THE PROPOSAL, AND THE SUPPLEMENTAL
SPECIFICATION 800 VERSION INDICATED ON THE PROPOSAL SHALL GOVERN
THIS IMPROVEMENT.

I HEREBY APPROVE THESE PLANS AND DECLARE THAT THE
MAKING OF THIS IMPROVEMENT WILL NOT REQUIRE THE
CLOSING TO TRAFFIC OF THE HIGHWAY AND THAT
PROVISIONS FOR THE MAINTENANCE AND SAFETY OF
TRAFFIC WILL BE AS SET FORTH ON THE PLANS AND
ESTIMATES.



Rich Oster
District 10 Deputy Director

Pamela Boratyn
Director, Department of Transportation

STANDARD CONSTRUCTION DRAWINGS					SUPPLEMENTAL SPECIFICATIONS	SPECIAL PROVISIONS	ENGINEERS SEAL PAVEMENT ENGINEER
BP-3.1	1/19/24				800-2023 1/17/25		
					832 7/19/24		
					874 4/17/20		
					897 1/16/15		
MT-97.10	4/19/19						SIGNED: _____
MT-97.12	1/20/17						
MT-99.20	4/19/19						
MT-101.90	7/17/20						
MT-105.10	1/17/20						
TC-64.10	7/21/23						
TC-65.10	1/17/14						
TC-65.11	1/17/25						
TC-71.10	4/21/23						



GENERAL SUMMARY	
	
DESIGNER BAC	
REVIEWER KWK 04-30-25	
PROJECT ID 120931	
SHEET 4	TOTAL 8

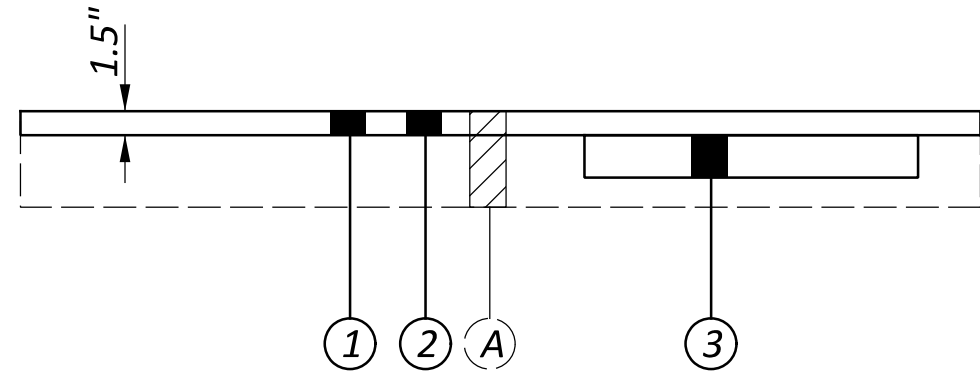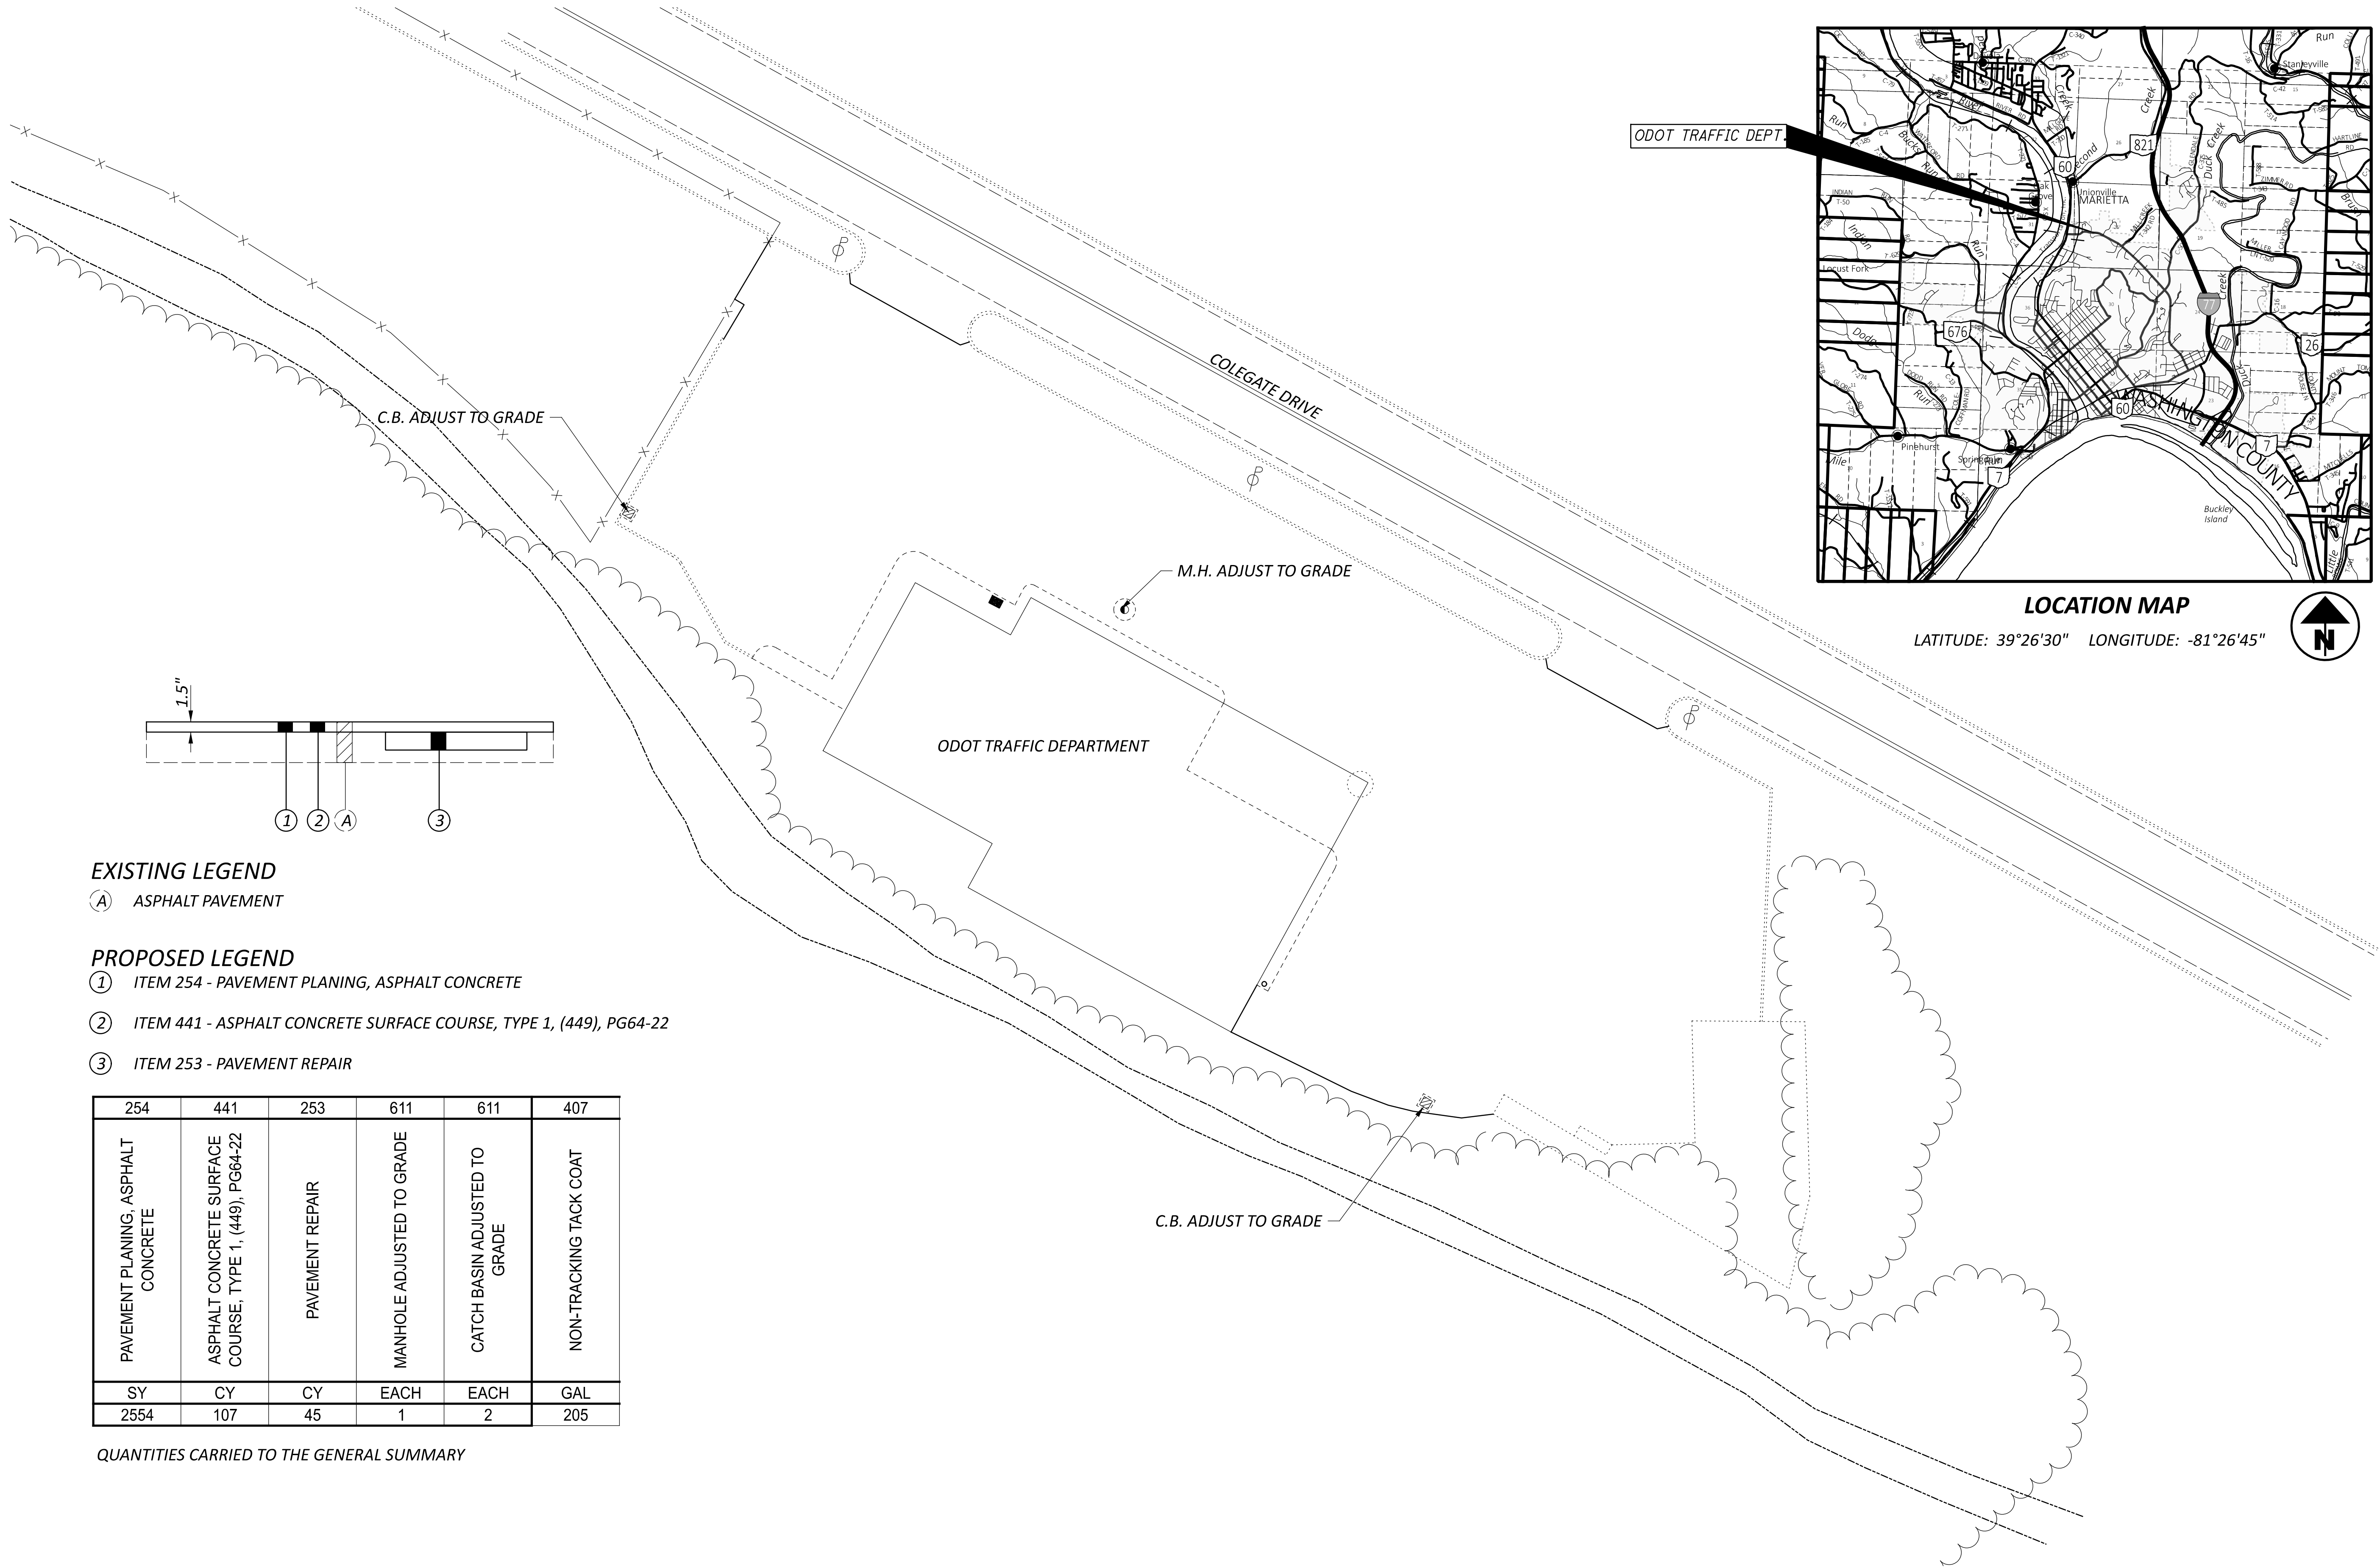

EXISTING LEGEND

- (A) ASPHALT PAVEMENT

PROPOSED LEGEND

- (1) ITEM 254 - PAVEMENT PLANING, ASPHALT CONCRETE
- (2) ITEM 441 - ASPHALT CONCRETE SURFACE COURSE, TYPE 1, (449), PG64-22
- (3) ITEM 253 - PAVEMENT REPAIR

254	441	253	611	611	407
PAVEMENT PLANING, ASPHALT CONCRETE	ASPHALT CONCRETE SURFACE COURSE, TYPE 1, (449), PG64-22	PAVEMENT REPAIR	MANHOLE ADJUSTED TO GRADE	CATCH BASIN ADJUSTED TO GRADE	NON-TRACKING TACK COAT
SY	CY	CY	EACH	EACH	GAL
2554	107	45	1	2	205

QUANTITIES CARRIED TO THE GENERAL SUMMARY



LOCATION MAP

LATITUDE: 39°26'30" LONGITUDE: -81°26'45"



TRAFFIC DEPARTMENT
PARKING LOT DETAIL

DESIGN AGENCY



DESIGNER

BAC

REVIEWER

KWK 07/17/25

PROJECT ID

120931

SHEET

8

TOTAL

8

HORIZONTAL
SCALE IN FEET

