

CROSS SECTIONS - US-30
 STA. 1023+50 TO STA. 1024+50

DESIGN AGENCY
Mead & Hunt




CLIENT
 DESIGNER
CJL


REVIEWER
 SJS 10/09/20

PROJECT ID
 110876




Sheet Totals			TOTAL	
Seeding	Cut	Fill	P.34	65
165	170	6		

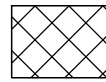

UNSTABLE MATERIAL

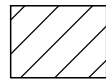

UNSUITABLE MATERIAL

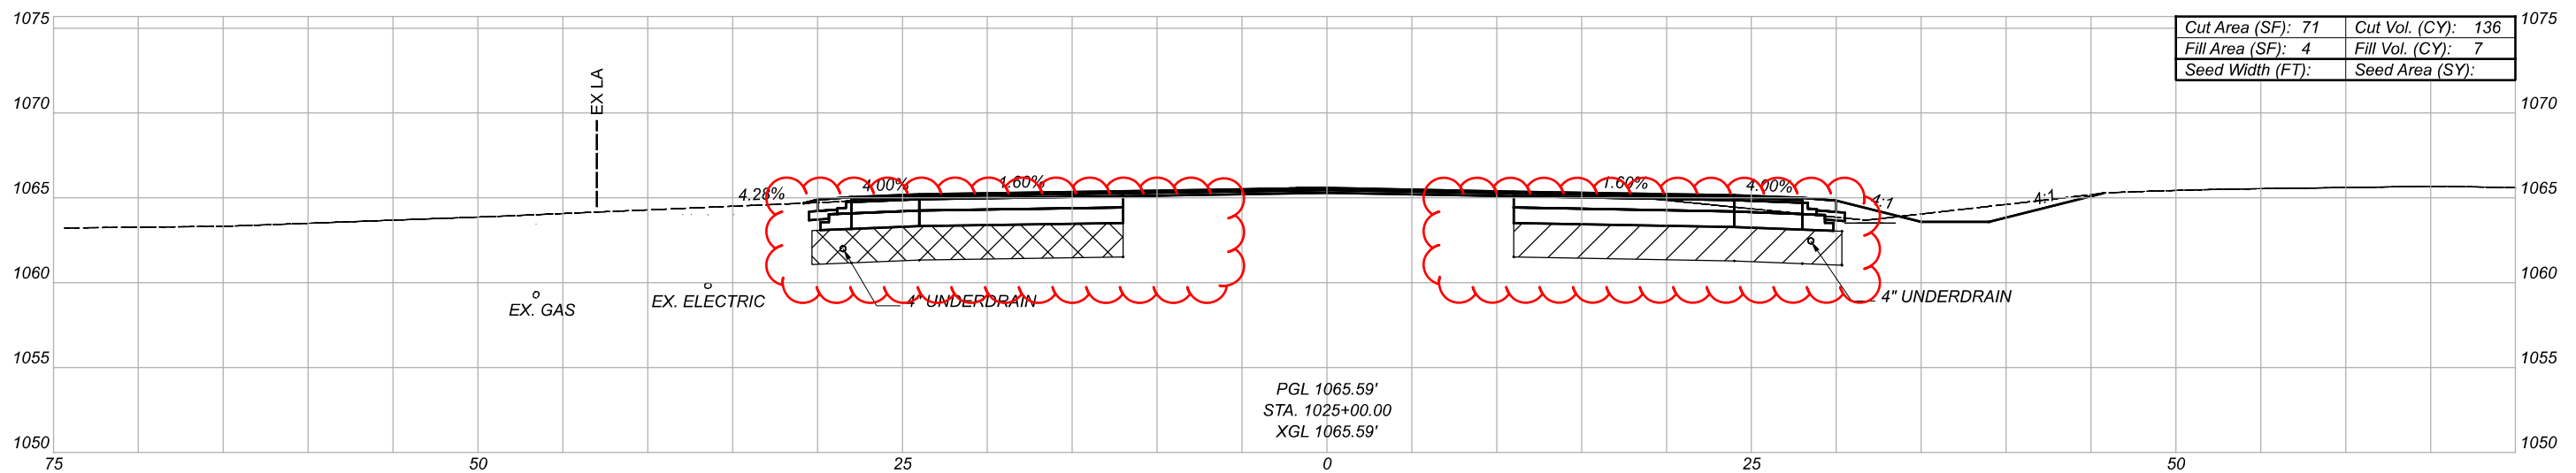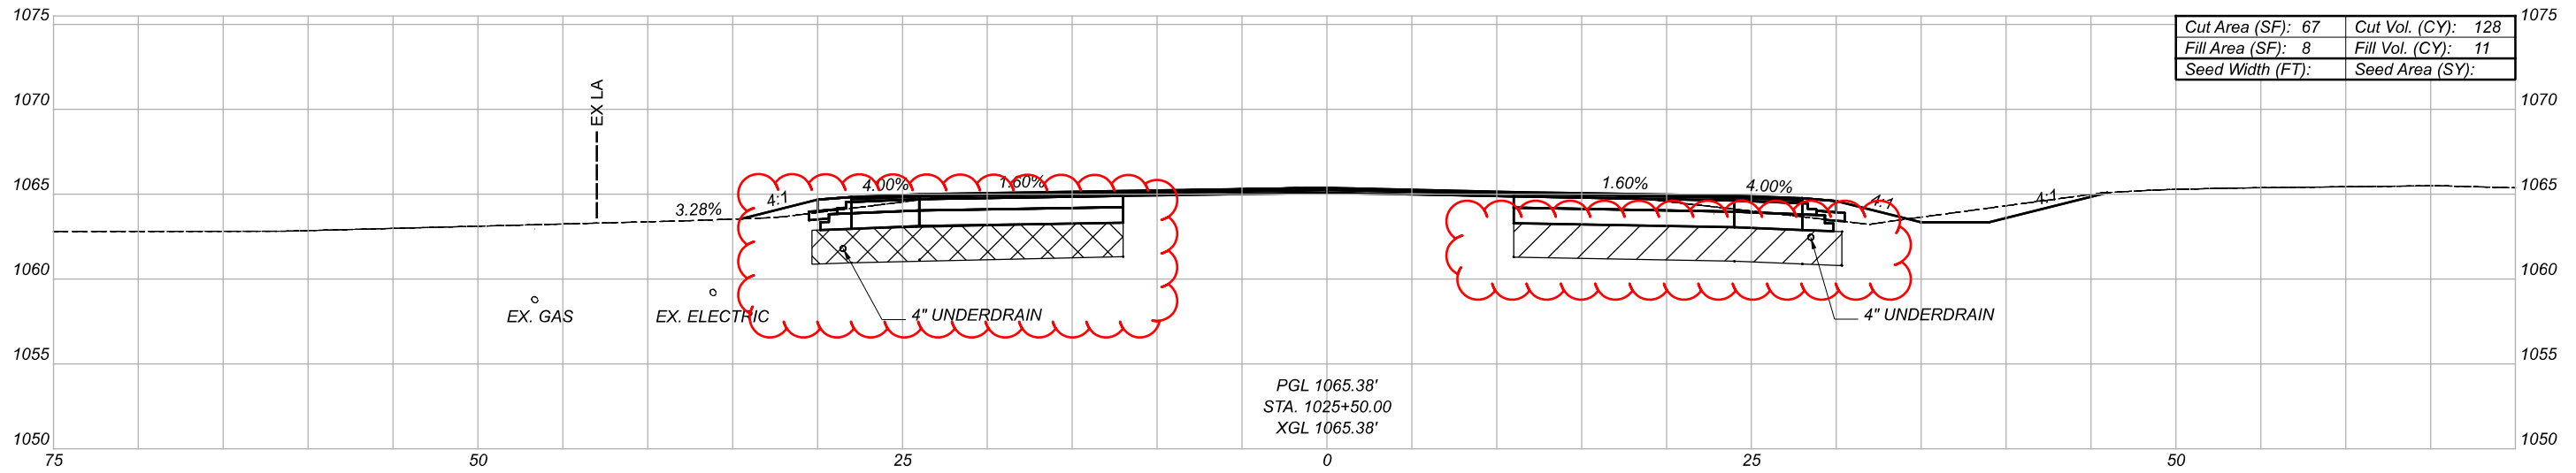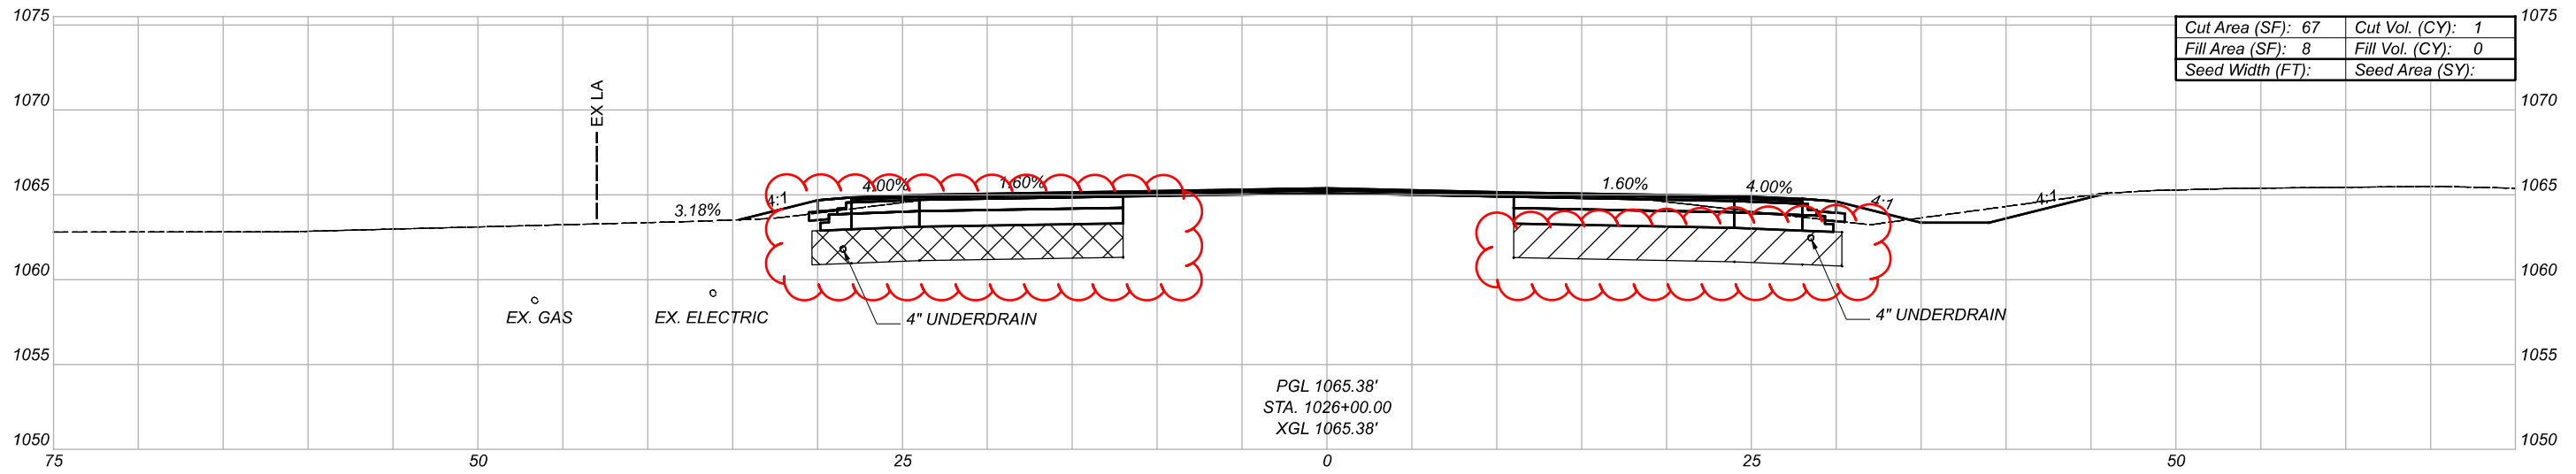

Sheet Totals			110876	
Seeding	Cut	Fill	SHEET	TOTAL
246	265	18	P.35	65

CROSS SECTIONS - US-30
 STA. 1025+00 TO STA. A1026+00


DESIGN AGENCY
Mead & Hunt



CLIENT
 DESIGNER
CJL

REVIEWER
 SJS 10/09/20



PROJECT ID
 110876

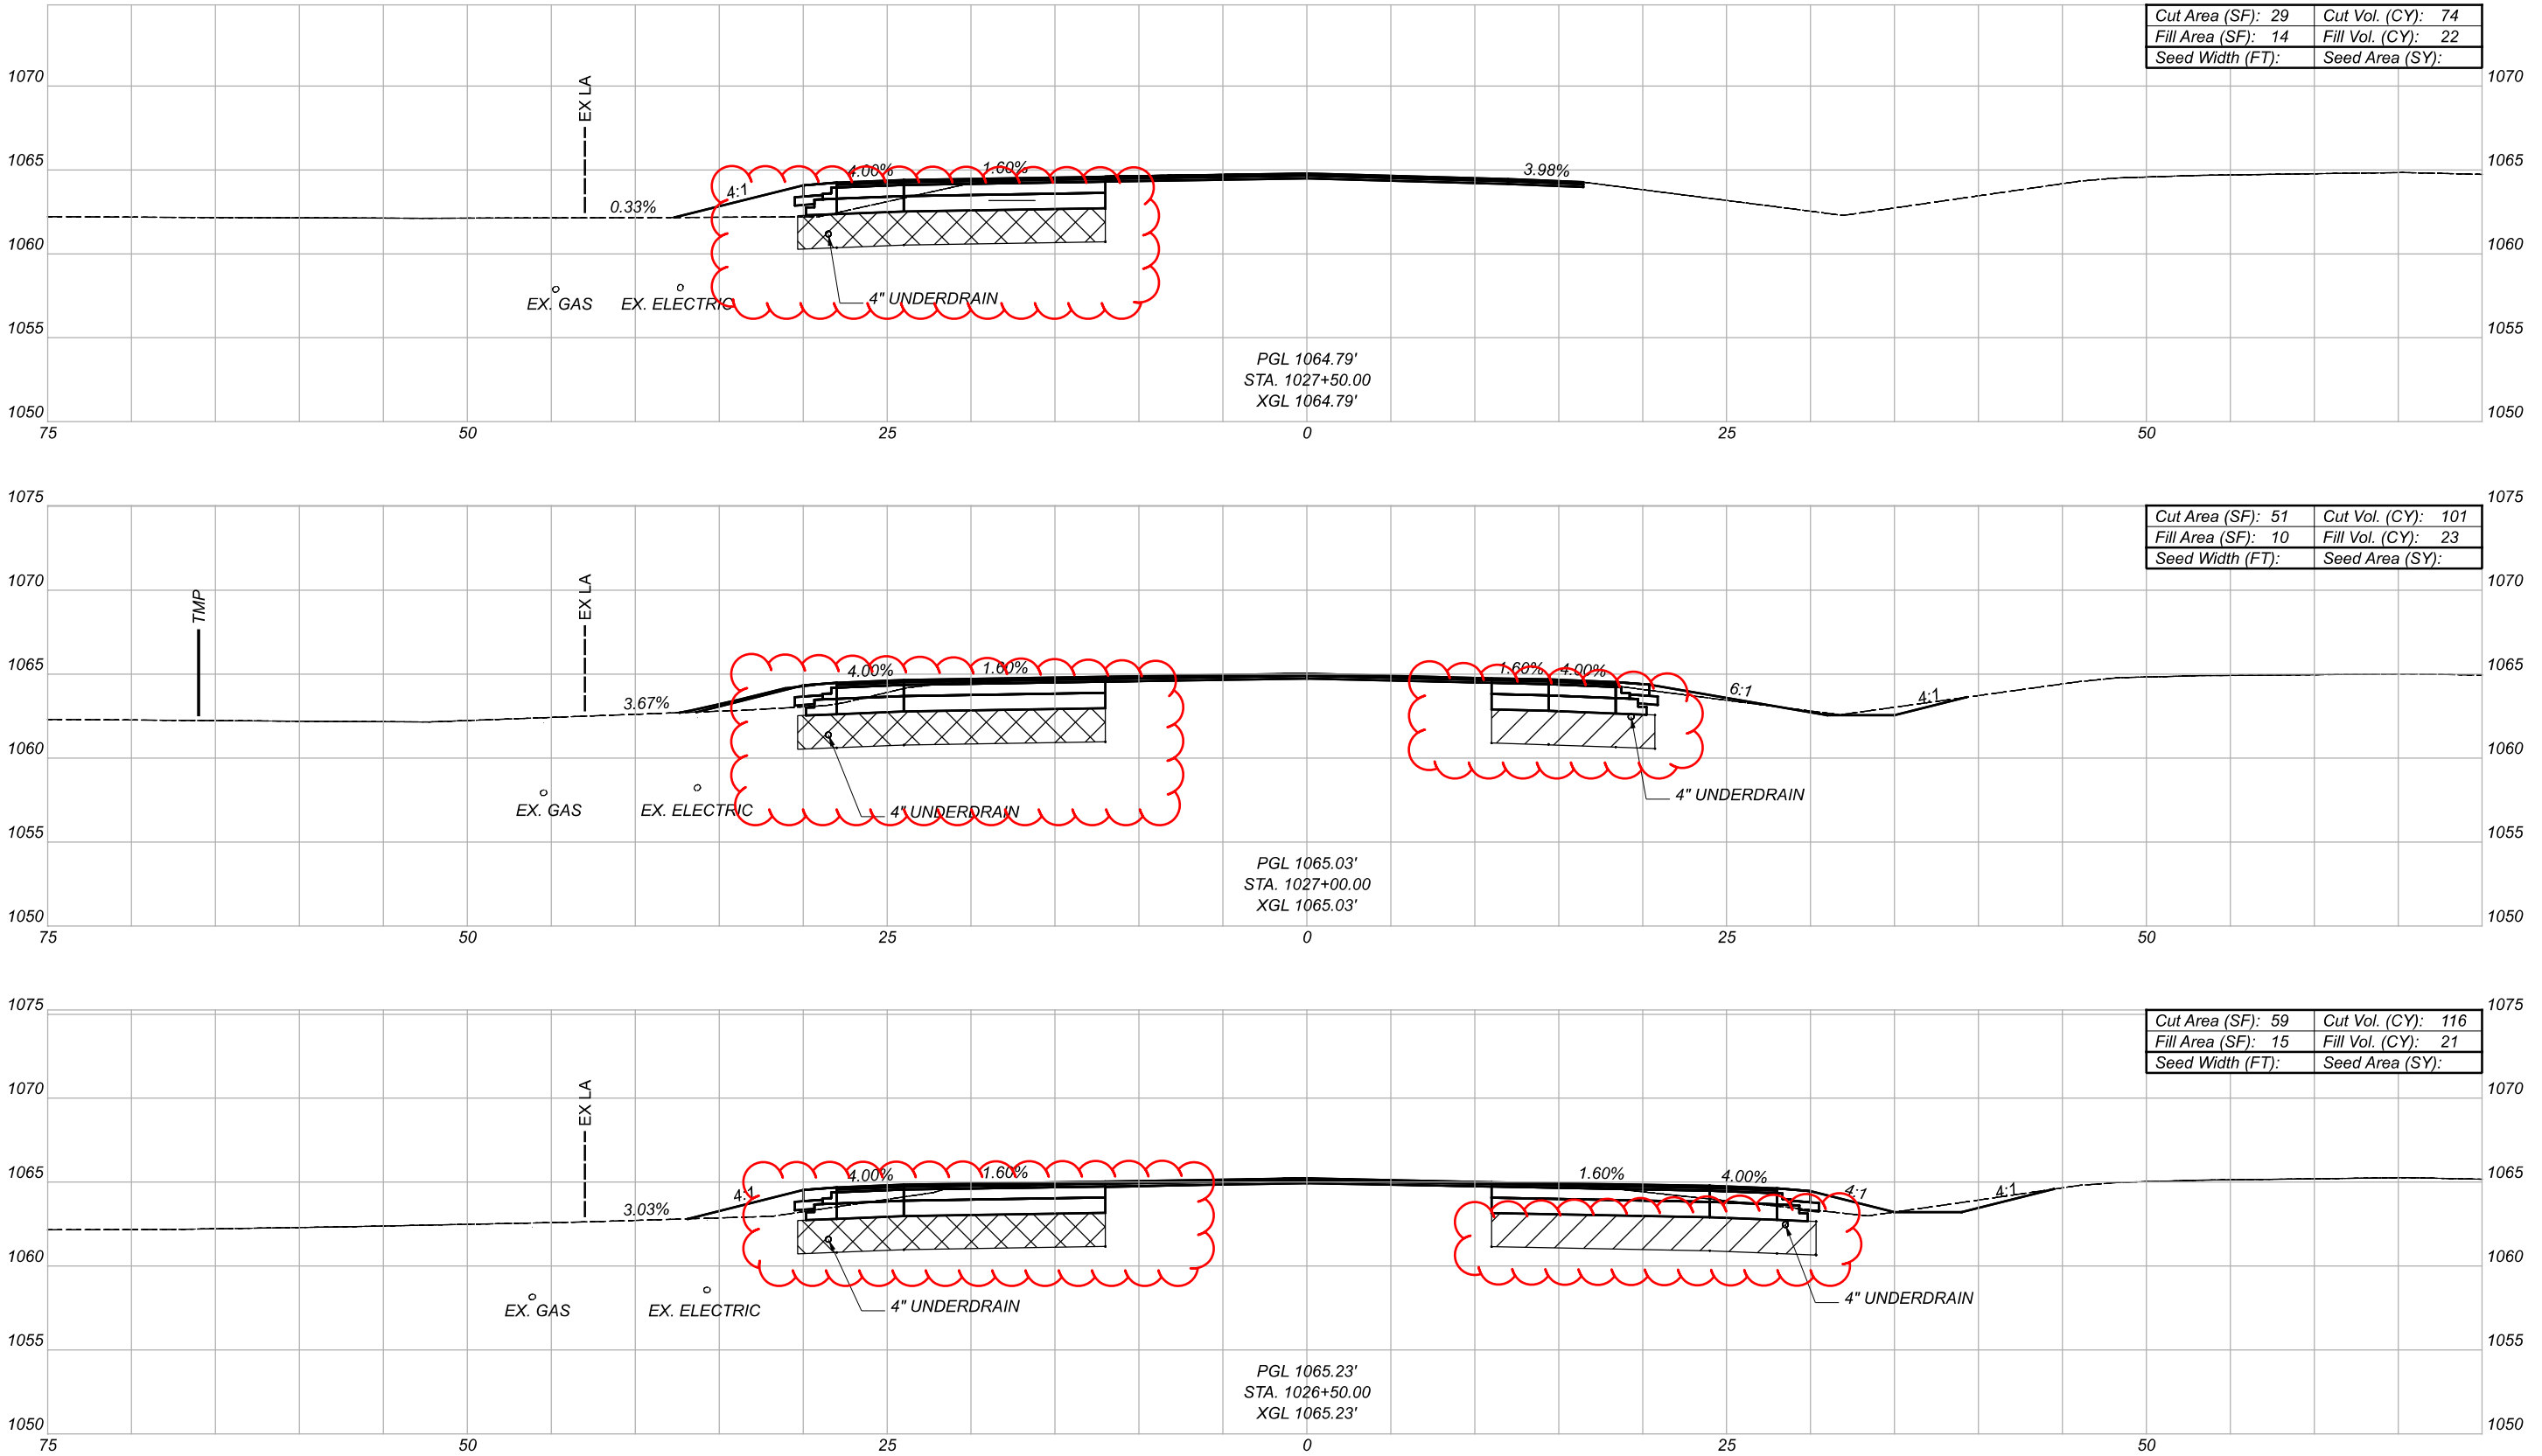


CROSS SECTIONS - US-30
 STA. A1026+50 TO STA. A1027+50

DESIGN AGENCY
Mead & Hunt
 CLIENT
 DESIGNER
 C.J.L.
 REVIEWER
 SJS 10/09/20
 PROJECT ID

Sheet Totals			110876
Seeding	Cut	Fill	SHEET TOTAL
415	291	66	P.36 65

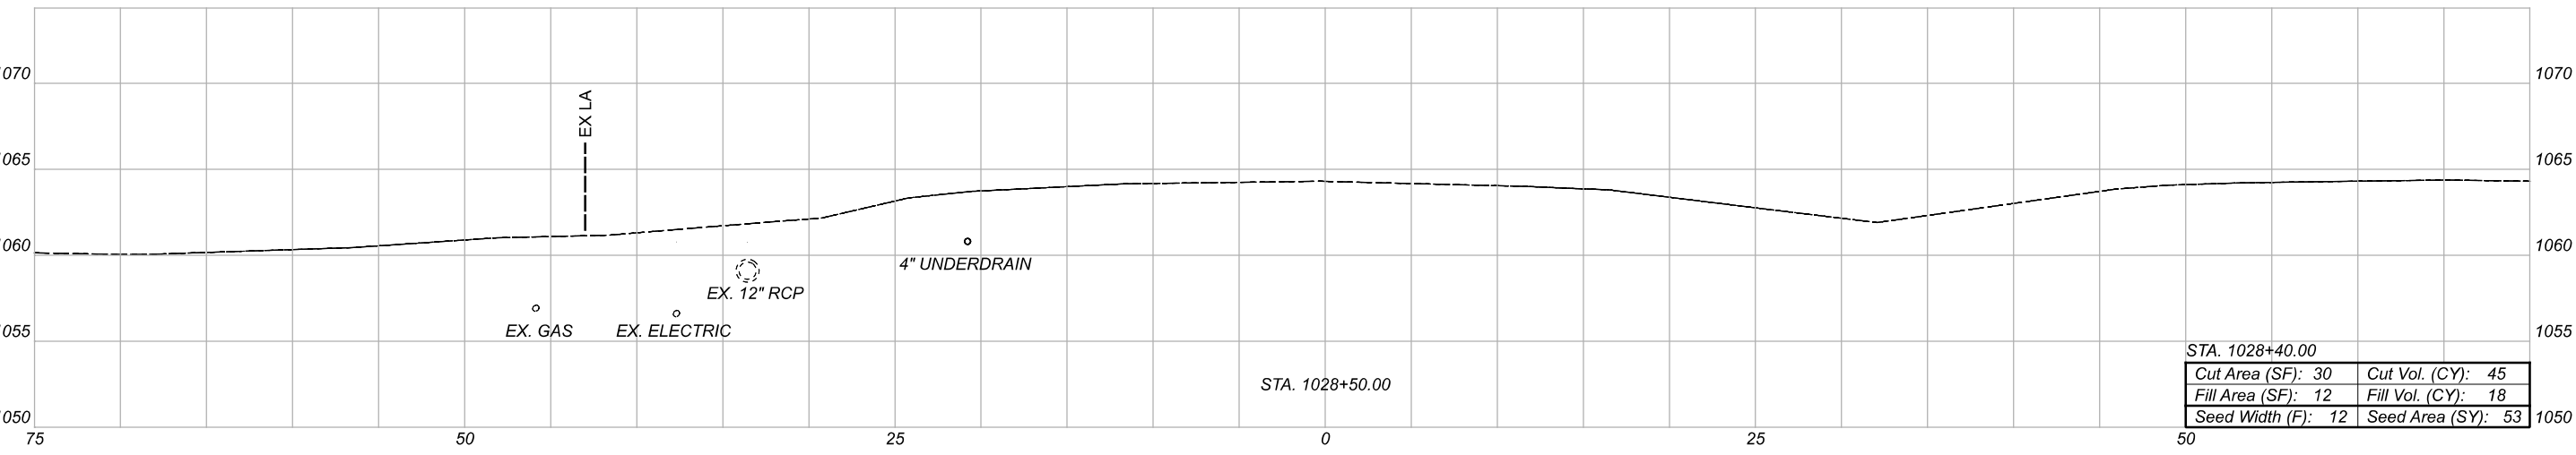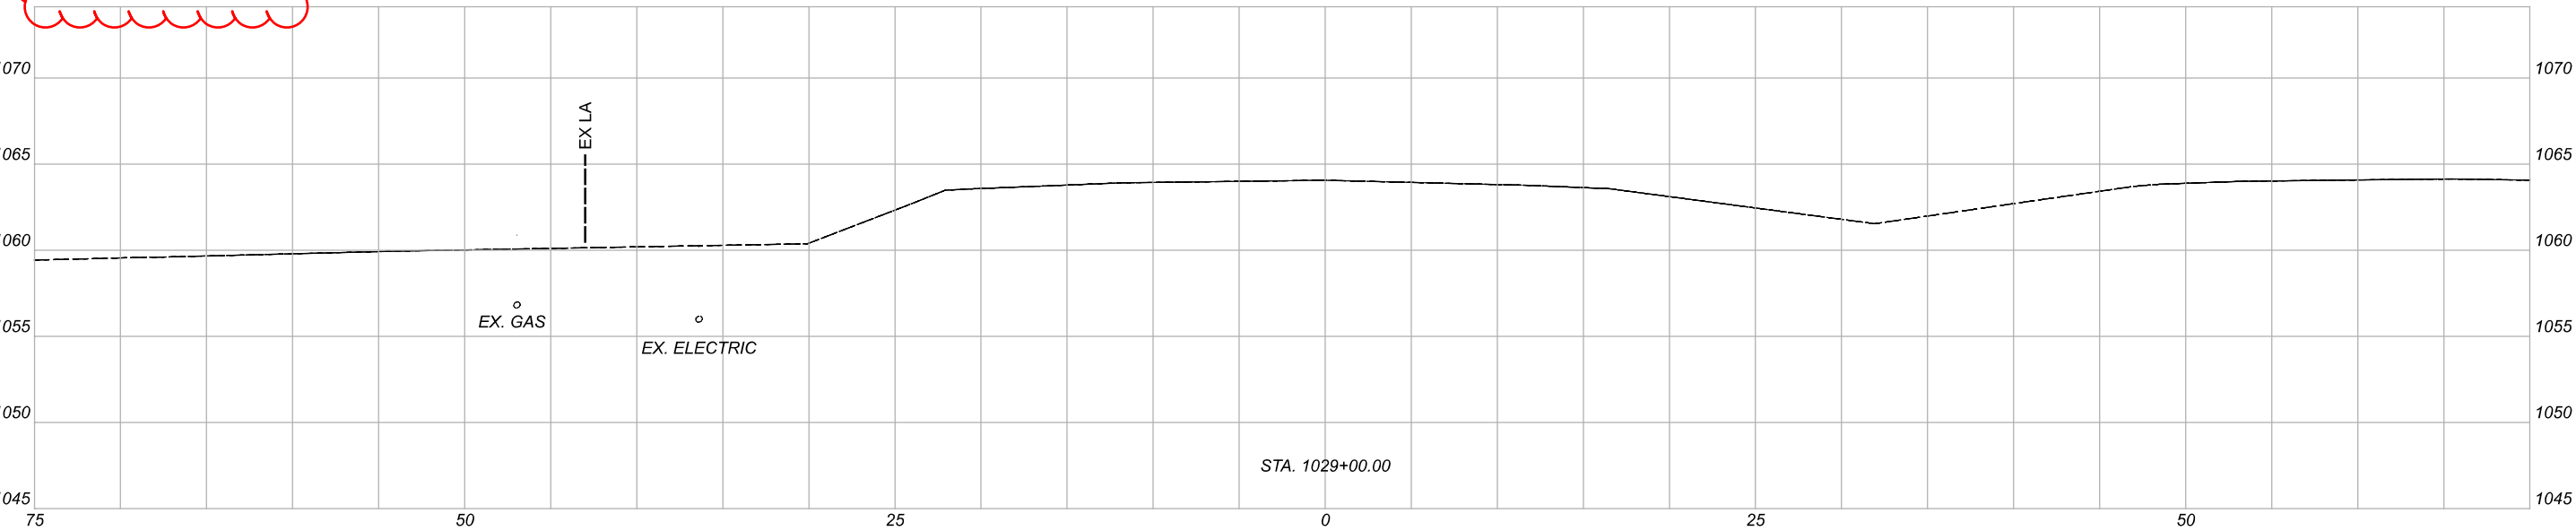


STA. 1028+40.00	
Cut Area (SF): 30	Cut Vol. (CY): 45
Fill Area (SF): 12	Fill Vol. (CY): 18
Seed Width (F): 12	Seed Area (SY): 53

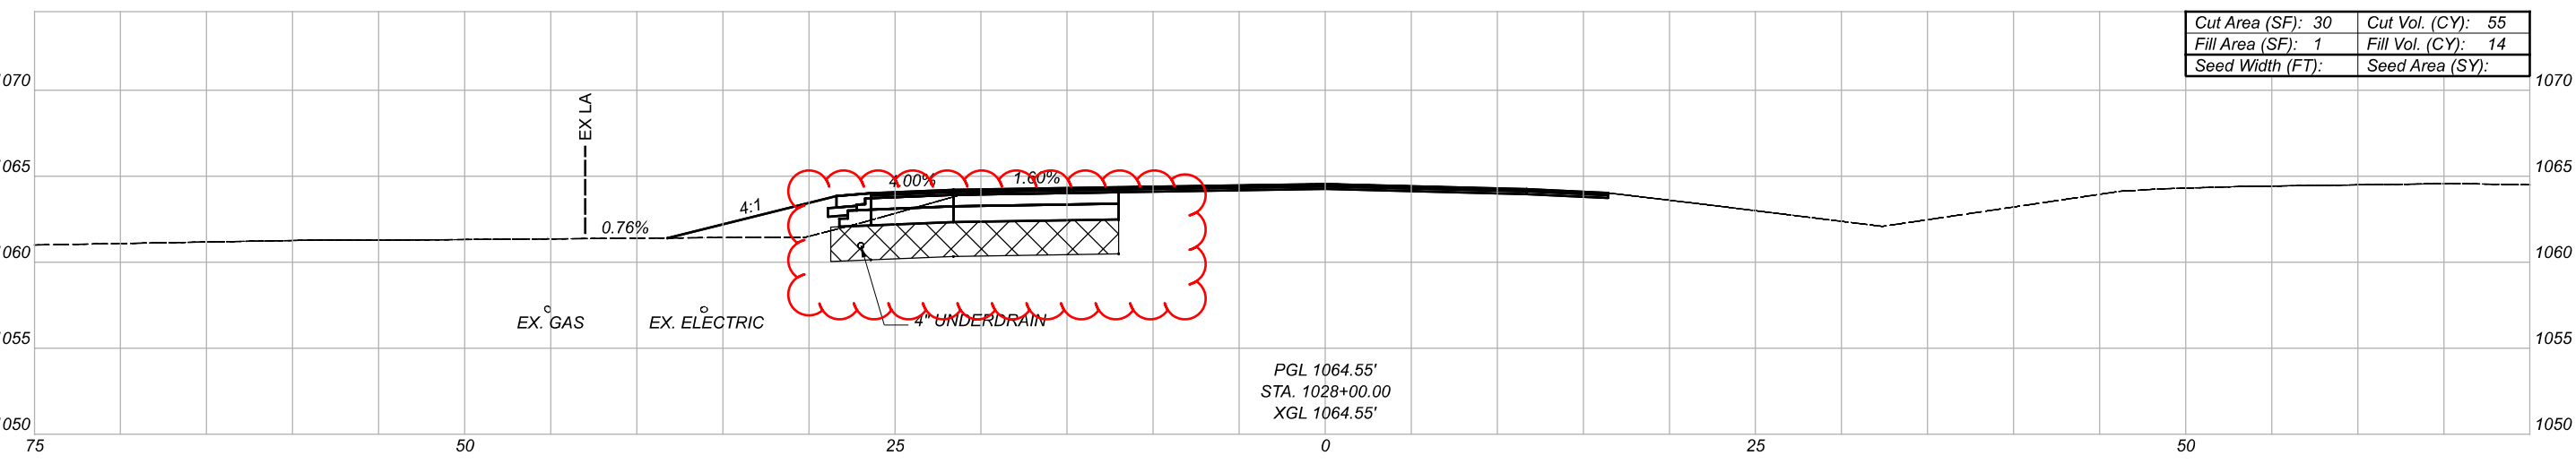

Cut Area (SF): 30	Cut Vol. (CY): 55
Fill Area (SF): 1	Fill Vol. (CY): 14
Seed Width (FT):	Seed Area (SY):

PGL 1064.55'
 STA. 1028+00.00
 XGL 1064.55'

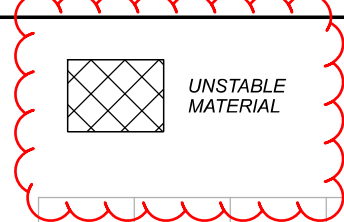

CROSS SECTIONS - US-30
 STA. 1028+00 TO STA. A1029+00



DESIGN AGENCY
Mead & Hunt
 CLIENT
 DESIGNER
 C.J.L.
 REVIEWER
 SJS 10/09/20
 PROJECT ID
 110876

Sheet Totals			110876
Seeding	Cut	Fill	SHEET TOTAL
115	100	42	P.37 65

NOTE:

THE EXISTING GROUND DEPICTED ALONG SR 57 IS THAT BEING CONSTRUCTED WITH THE DEVELOPER'S WIDENING OF SR 57. THE INTENT IS THAT THE DEVELOPER'S PROJECT WILL WIDEN THE PAVEMENT TO THREE LANES AND CONSTRUCT THE NECESSARY DITCHES.

THIS CONTRACT (PID 110876) WILL CONSTRUCT THE PAVEMENT FOR THE SOUTHBOUND RIGHT TURN LANE (4TH LANE) AND THE ADJACENT SHOULDER.

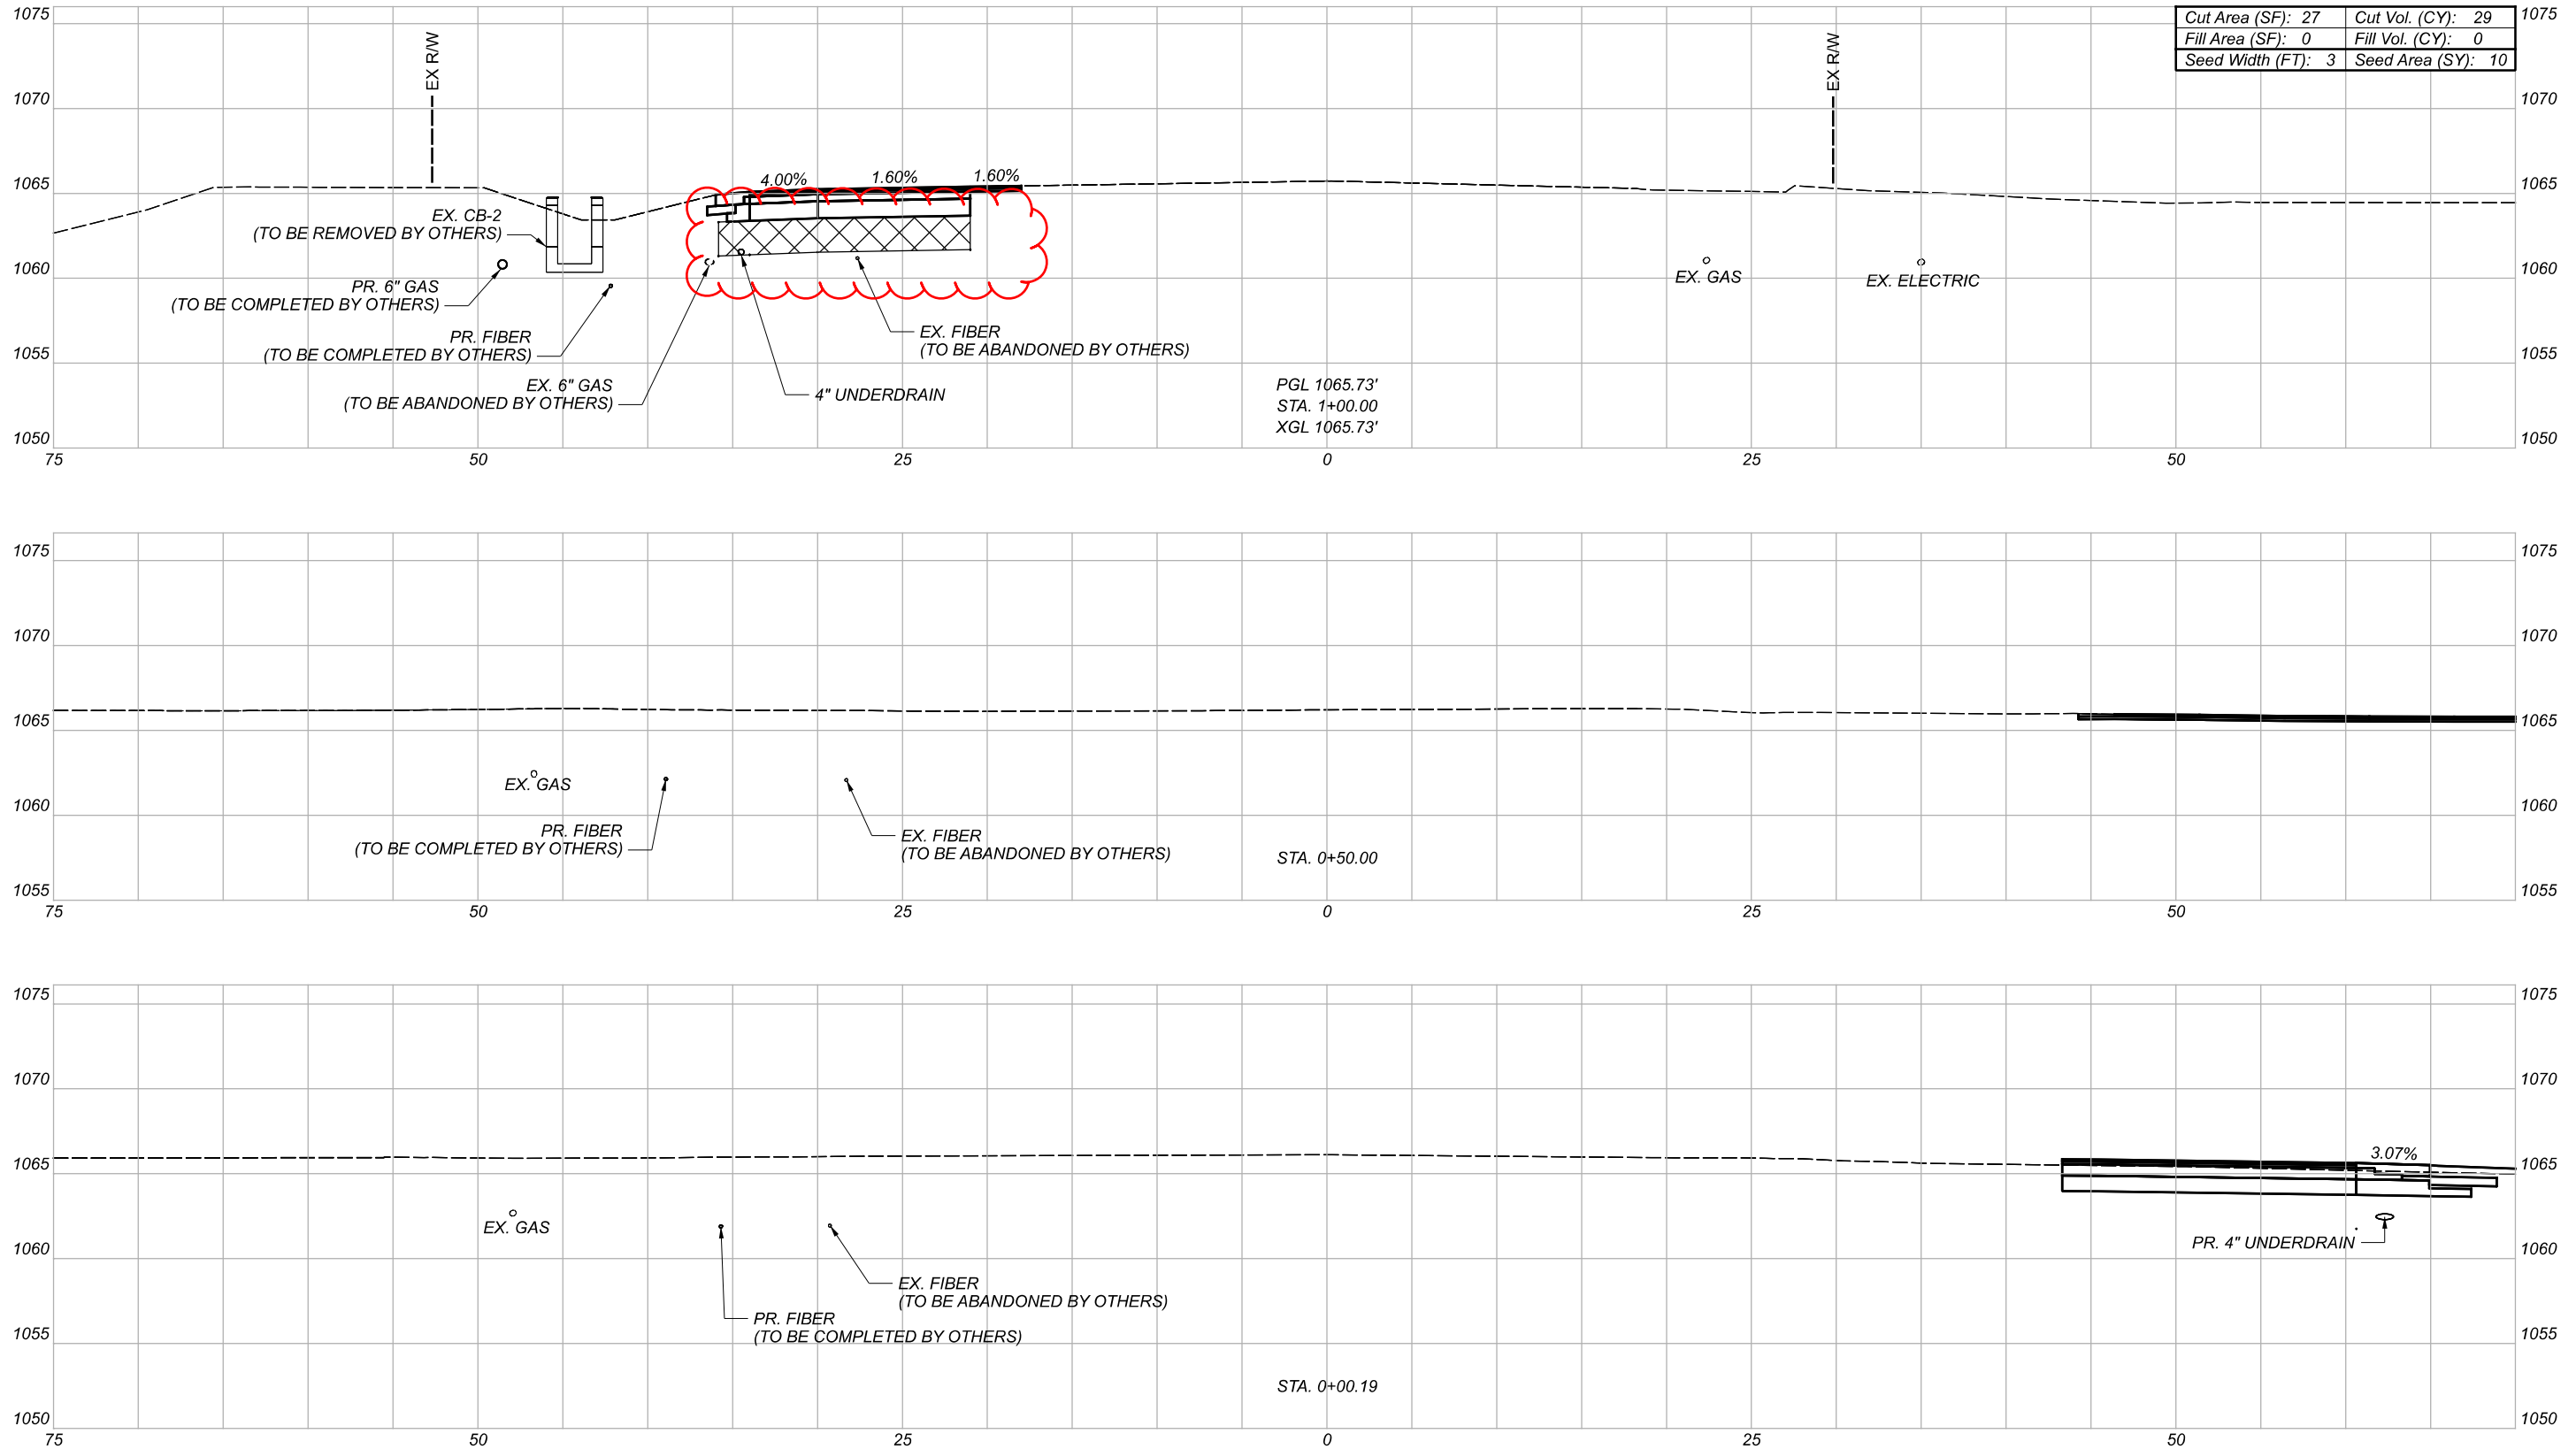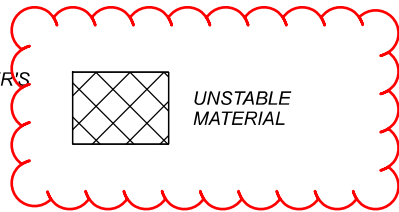

Cut Area (SF): 27	Cut Vol. (CY): 29
Fill Area (SF): 0	Fill Vol. (CY): 0
Seed Width (FT): 3	Seed Area (SY): 10

WAY-30-20.15

MODEL: 0+00.09 [Sheet1] PAPER SIZE: 11x17 (in.) DATE: 5/6/2021 TIME: 2:23:03 PM USER: 1598anm
 X:\402500\191370\110202_Safety_Design_2019-2_Sub to Carpenter_Marty\110876_WAY-30-20.15_400-Engineer\ng\Roadway\Sheet\110876_X5002.dgn




CROSS SECTIONS - SR-57
 STA. 0+00.19 TO STA 1+00.00

DESIGN AGENCY
Mead & Hunt
 CLIENT
 DESIGNER
 C.JL
 REVIEWER
 SJS 10/09/20
 PROJECT ID
 110876

Sheet Totals			TOTAL	
Seeding	Cut	Fill	SHEET	TOTAL
10	29	0	P.38	65





UNSTABLE MATERIAL

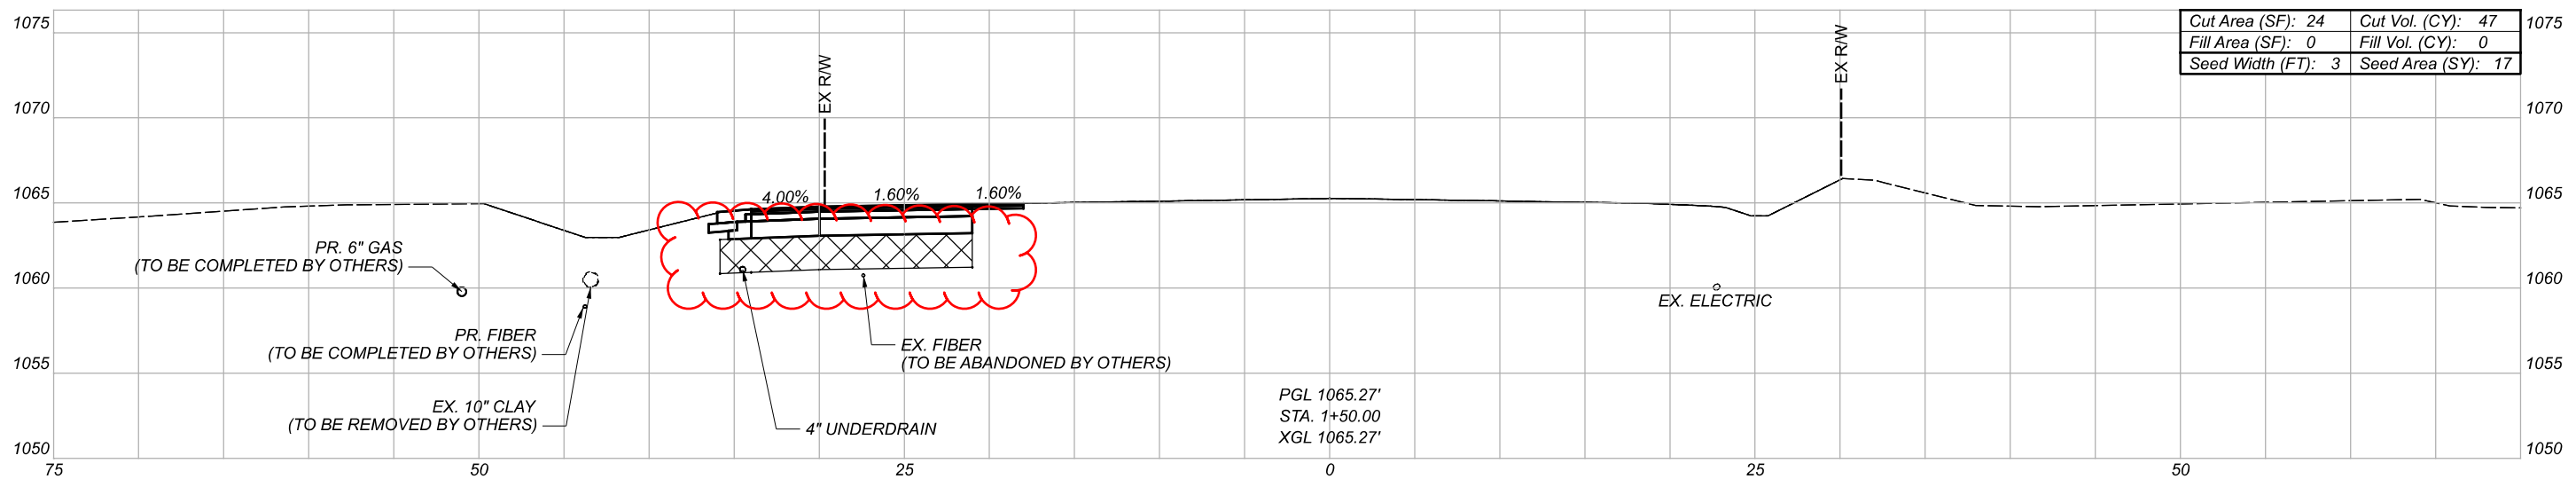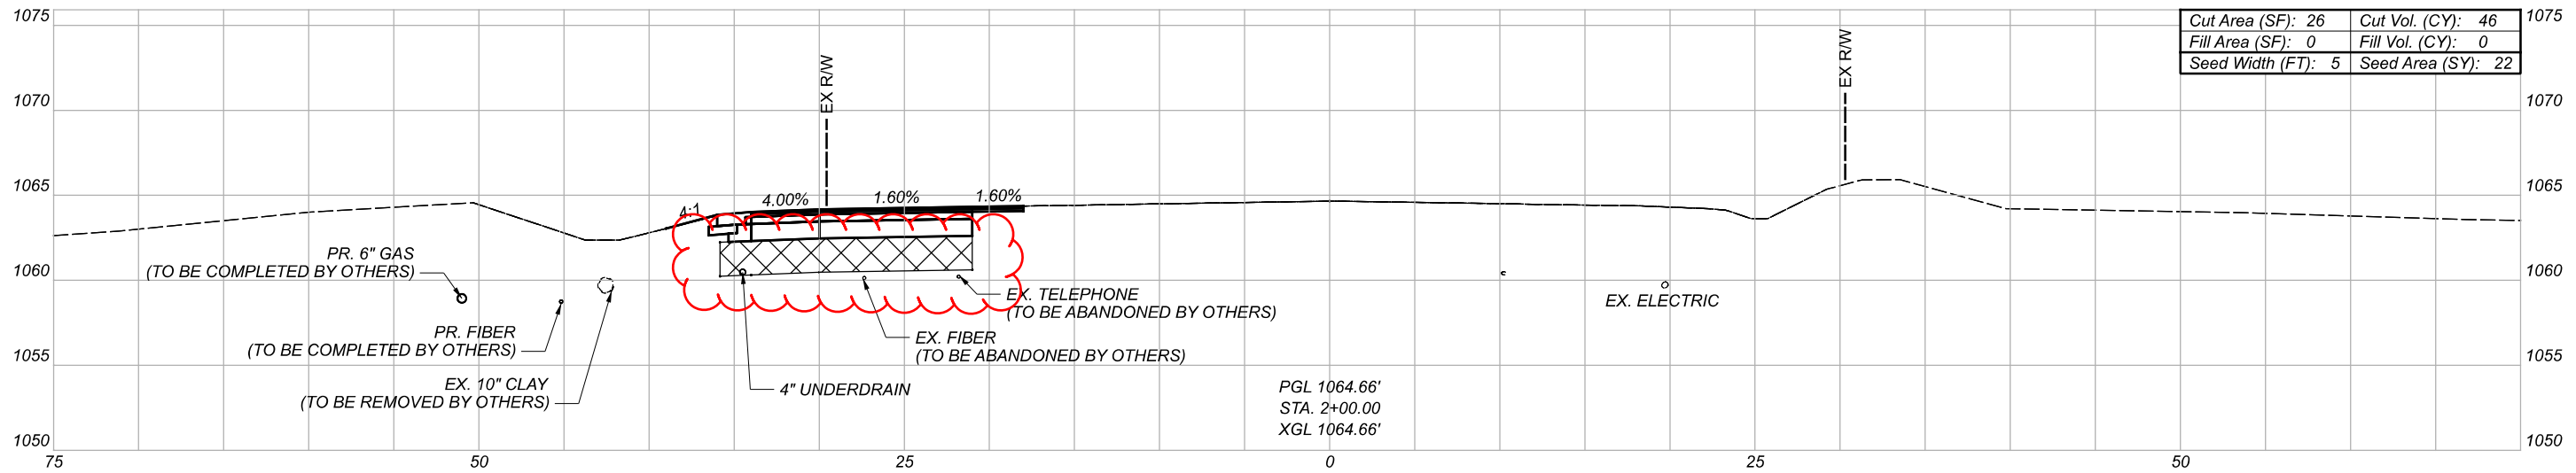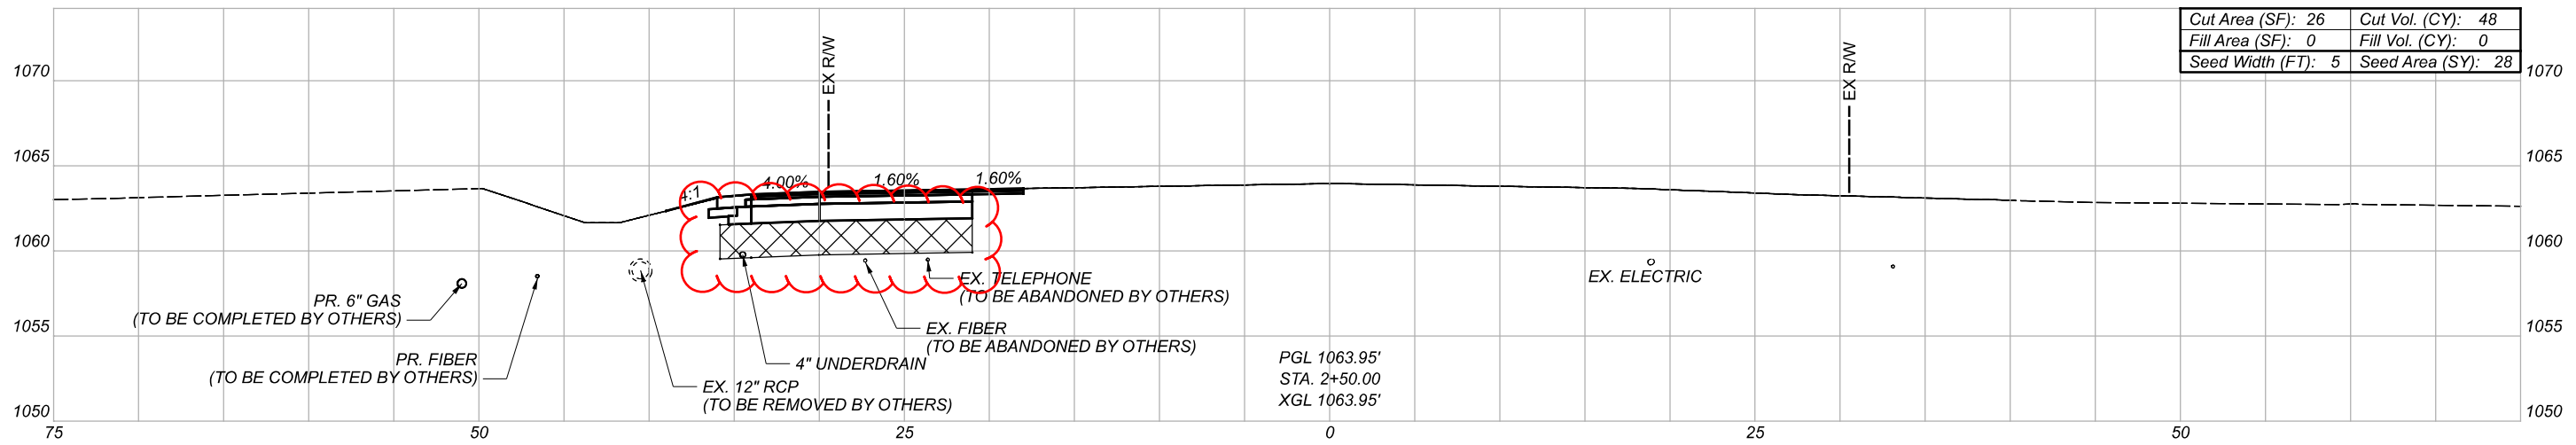

CROSS SECTIONS - SR-57
 STA. 1+50 TO STA. 2+50

DESIGN AGENCY
Mead & Hunt
 CLIENT
 DESIGNER
 C.JL
 REVIEWER
 SJS 10/09/20
 PROJECT ID
 110876

Sheet Totals			110876	
Seeding	Cut	Fill	SHEET	TOTAL
67	141	0	P.39	65

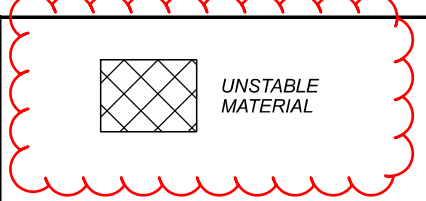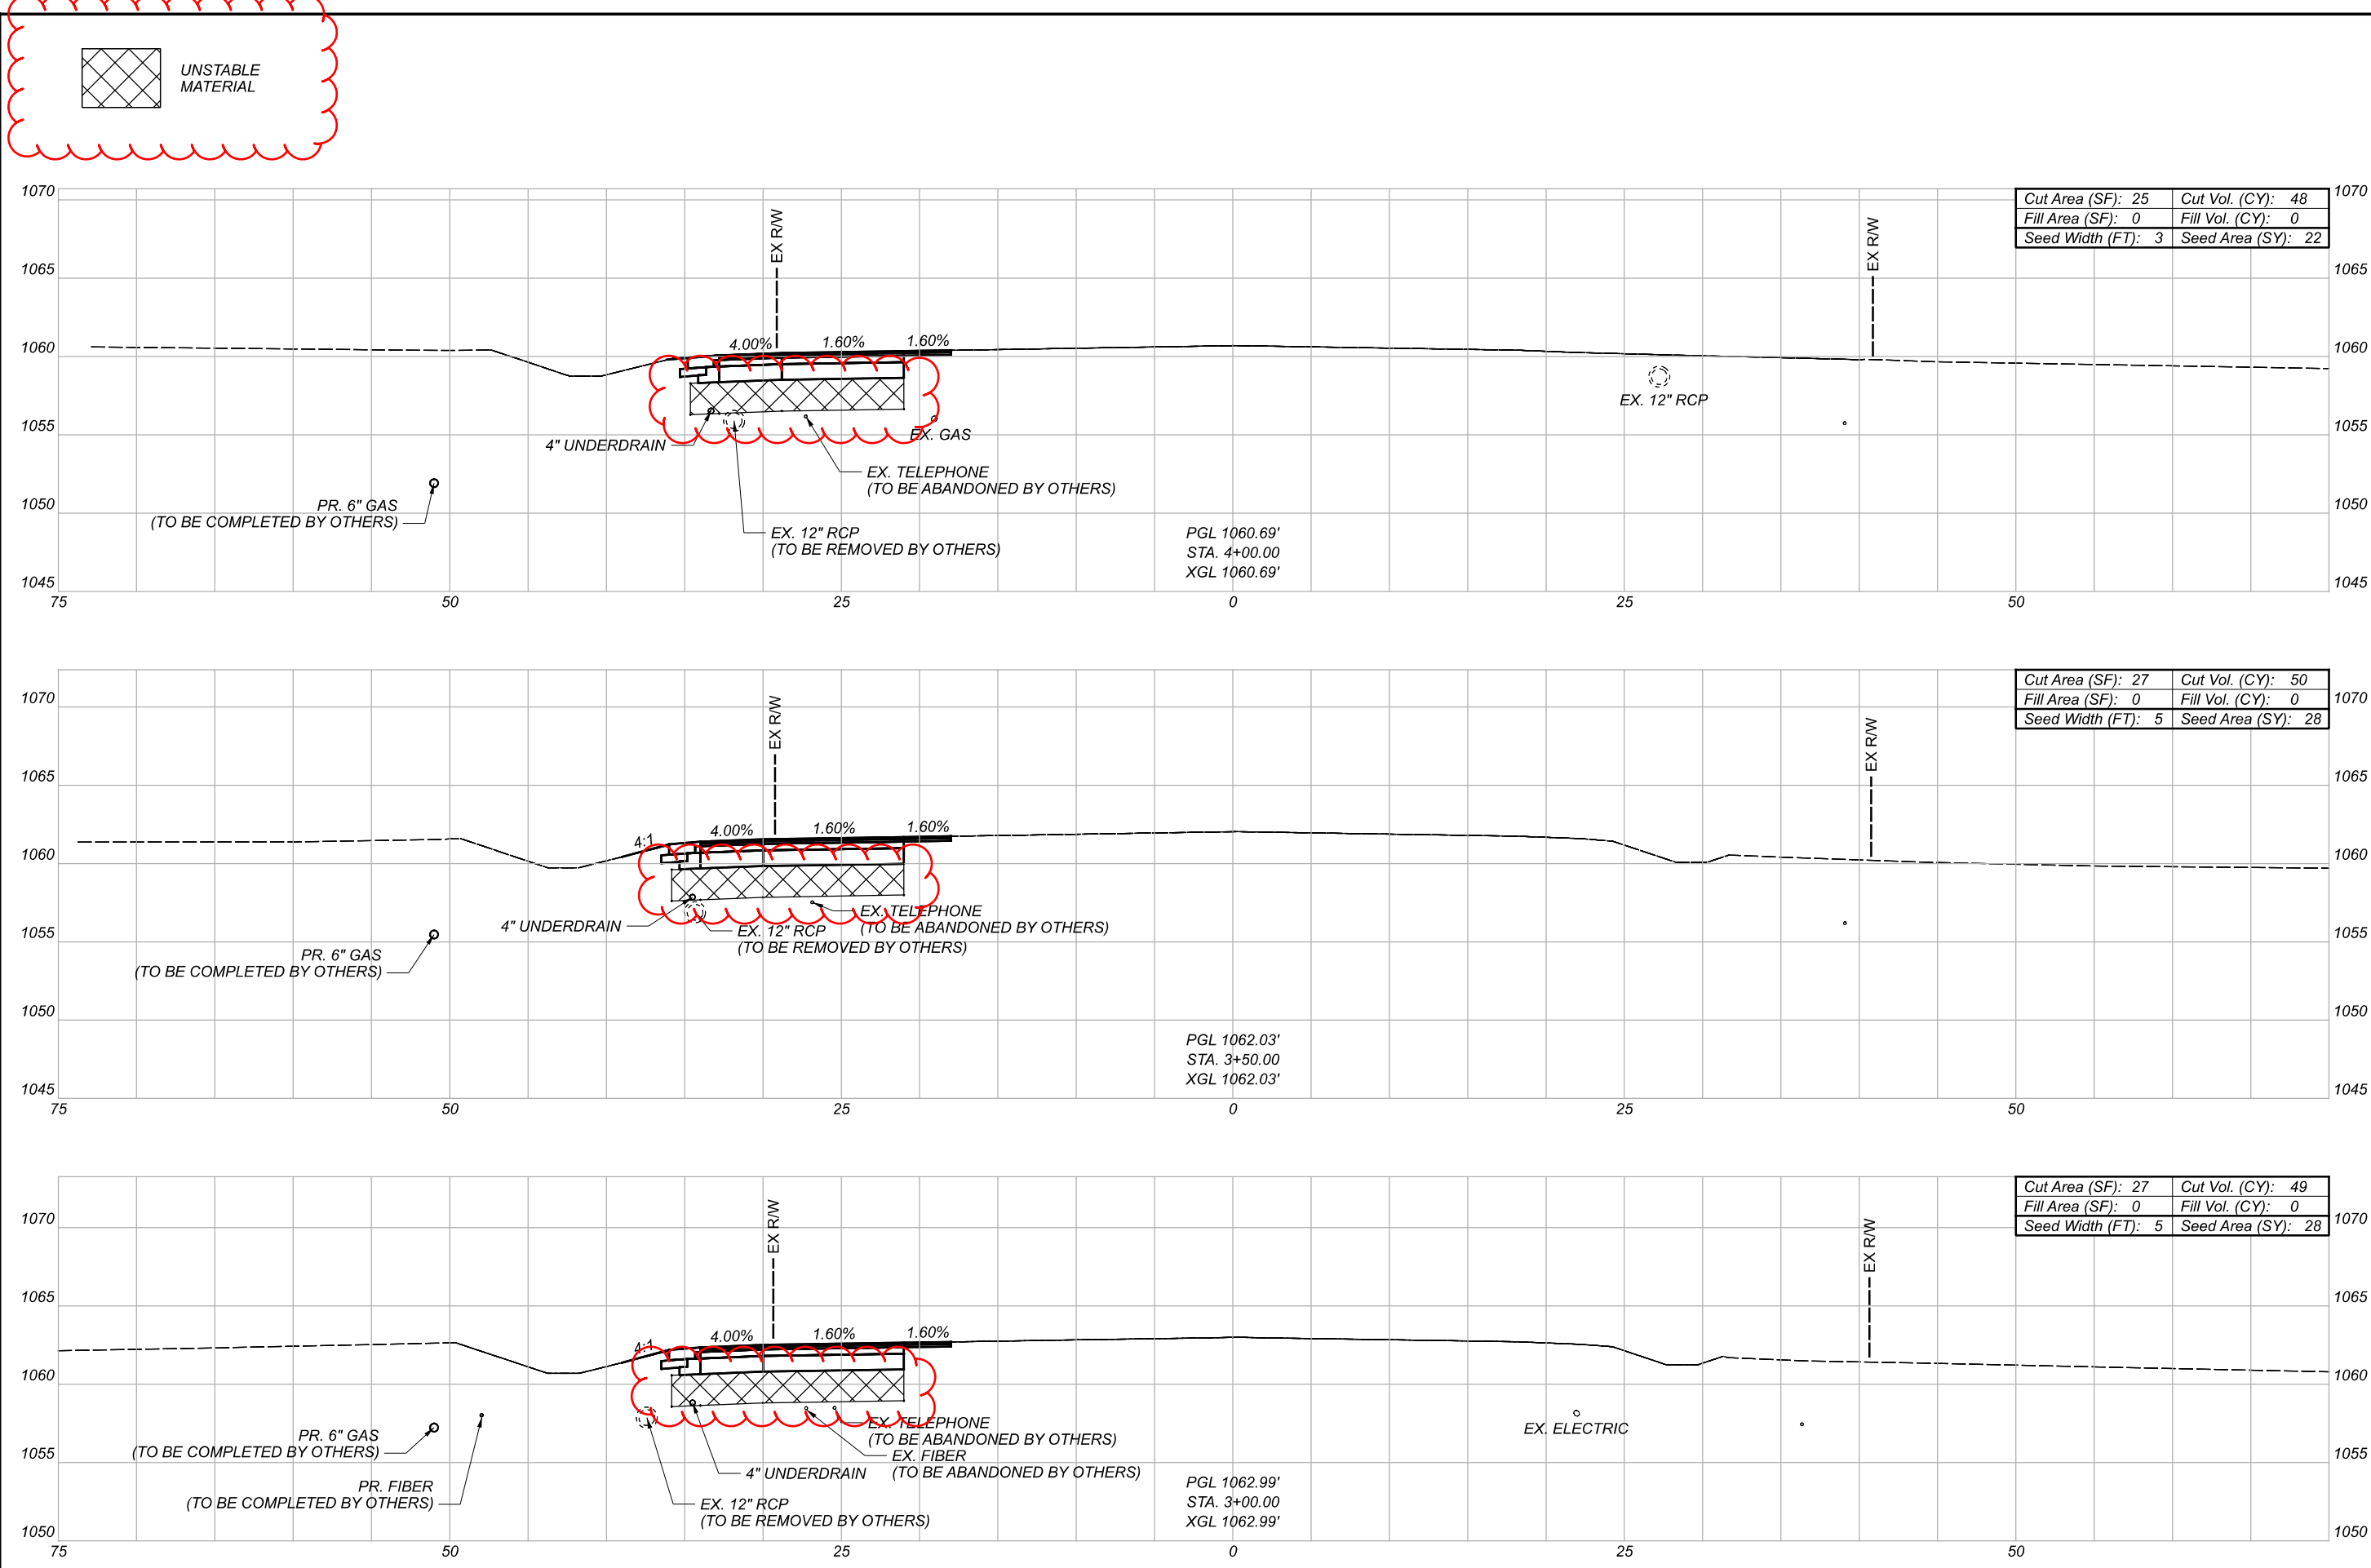

Cut Area (SF): 25	Cut Vol. (CY): 48
Fill Area (SF): 0	Fill Vol. (CY): 0
Seed Width (FT): 3	Seed Area (SY): 22

Cut Area (SF): 27	Cut Vol. (CY): 50
Fill Area (SF): 0	Fill Vol. (CY): 0
Seed Width (FT): 5	Seed Area (SY): 28

Cut Area (SF): 27	Cut Vol. (CY): 49
Fill Area (SF): 0	Fill Vol. (CY): 0
Seed Width (FT): 5	Seed Area (SY): 28

CROSS SECTIONS - SR-57
 STA. 3+00 TO STA. 4+00

DESIGN AGENCY
Mead & Hunt
 CLIENT
 DESIGNER
 C.JL
 REVIEWER
 SJS 10/09/20
 PROJECT ID
 110876

Sheet Totals			110876	
Seeding	Cut	Fill	SHEET	TOTAL
78	147	0	P.40	65