


HORIZONTAL
SCALE IN FEET



0 10 20 30 40

DESIGN AGENCY




DESIGNER

SEA

REVIEWER
RJL 05/16/25

PROJECT ID	114748
------------	--------

SUBSET	TOTAL
RW.5	RW.5

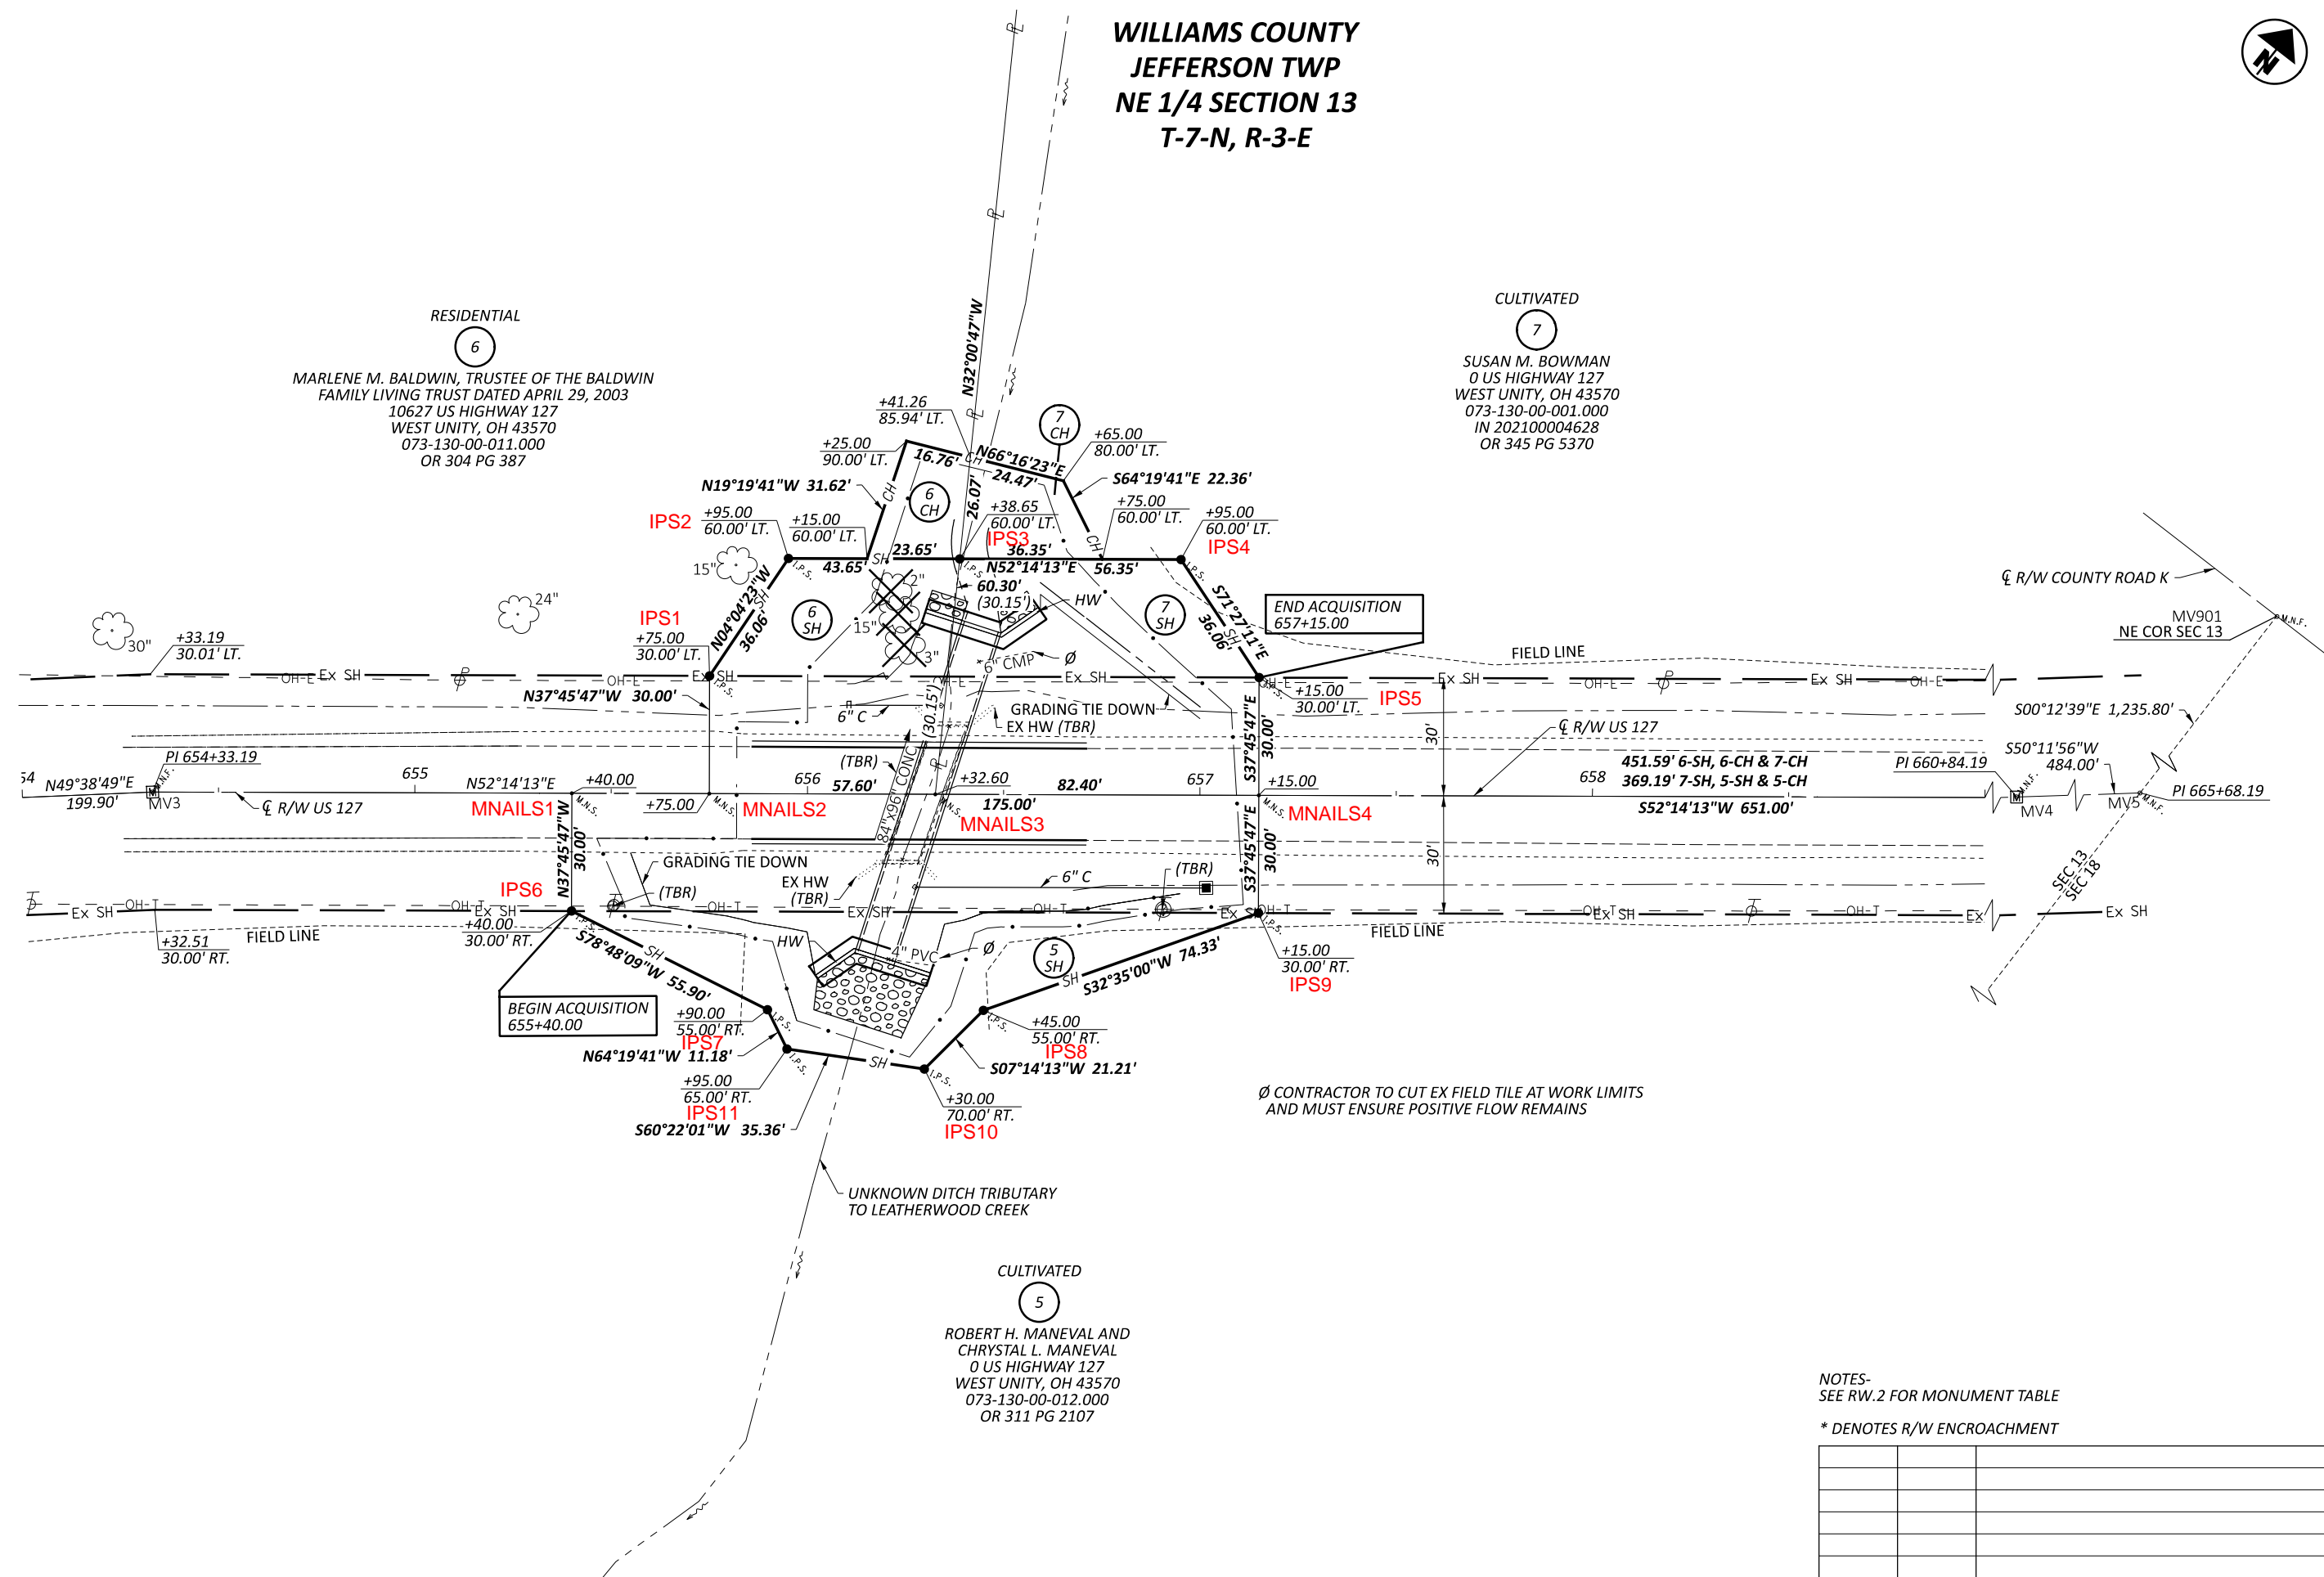

NOTES-
SEE RW.2 FOR MONUMENT TABLE

* DENOTES R/W ENCROACHMENT

REV. BY	DATE	DESCRIPTION
DATE COMPLETED		05/21/2025