

Village of West Unity

[Home](#) [Administration](#) [Departments](#) [Community Services](#) [Village Information](#) [Contact Us](#) Wednesday, June 19, 2024

Thank you for visiting our website!
Please use the information below to contact us...

Village of West Unity

P.O. Box 207

224 West Jackson St.

West Unity, OH 43570

Phone: 419.924.2215

Fax: 419.924.2894

westunityadmin@roadrunner.com

Village of West Unity

P.O. Box 207

224 West Jackson St.

West Unity, OH 43570




Phone: 419.924.2215


Fax: 419.924.2894

westunityadmin@roadrunner.com

The green pvc pipe at top, is the pipe north in question. Definately appears to be sanitary



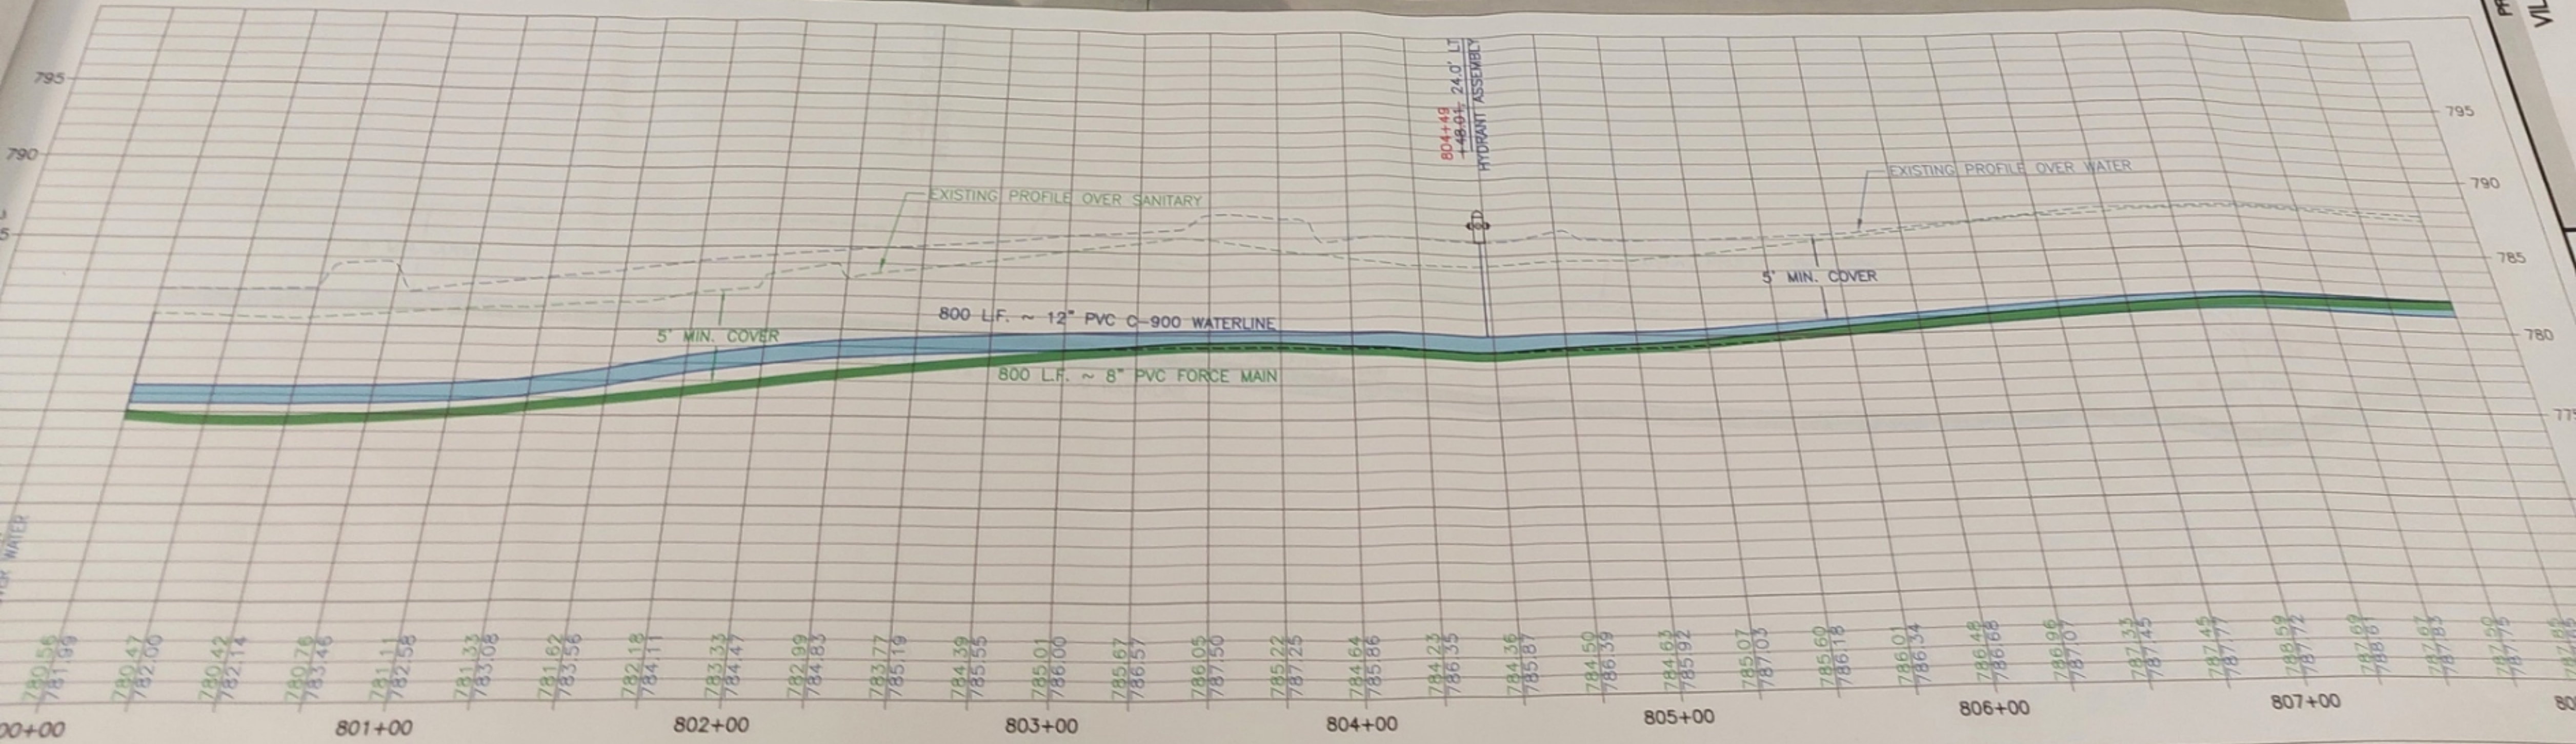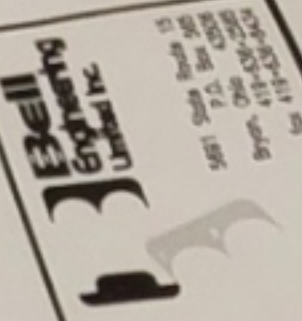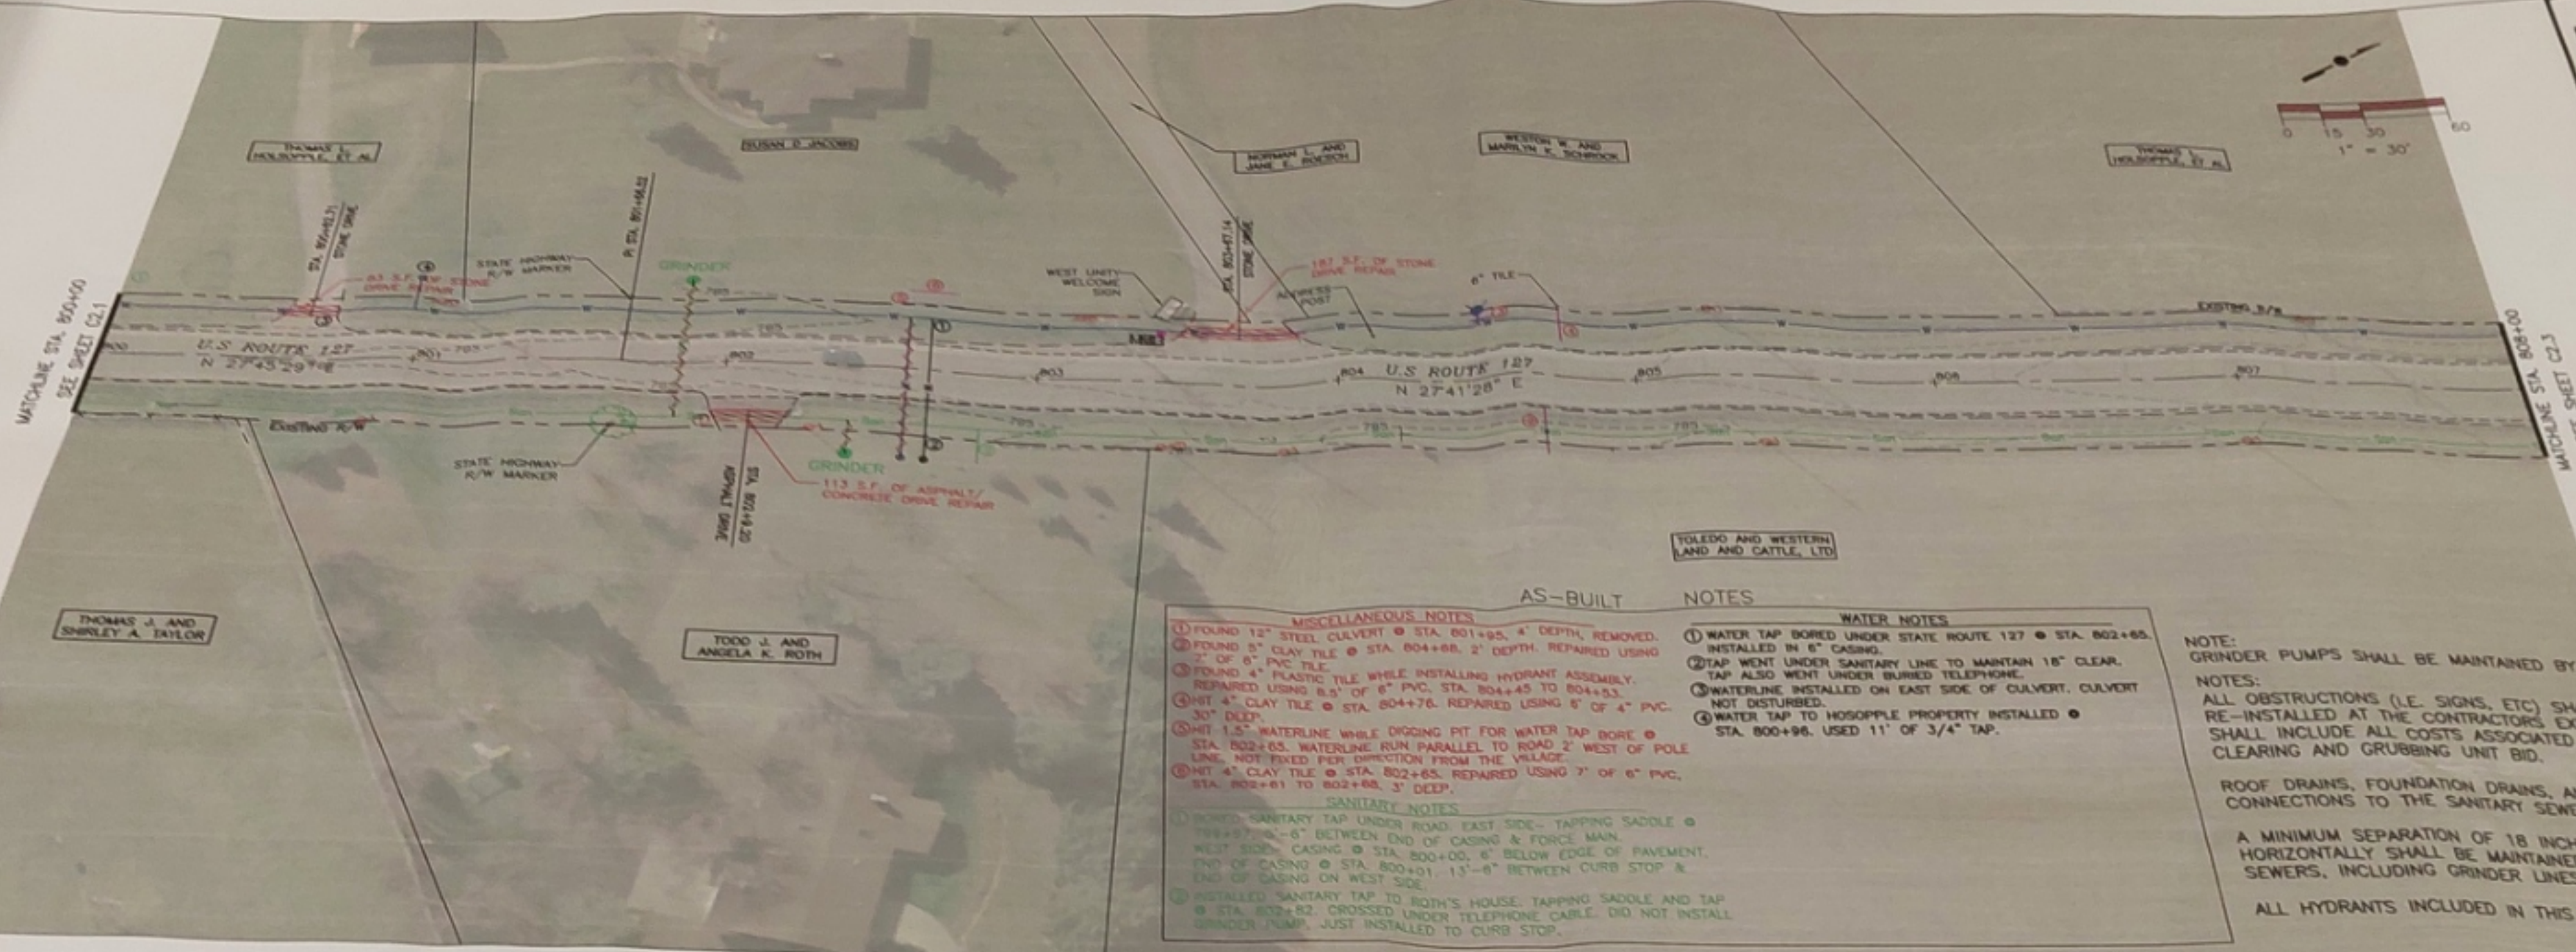


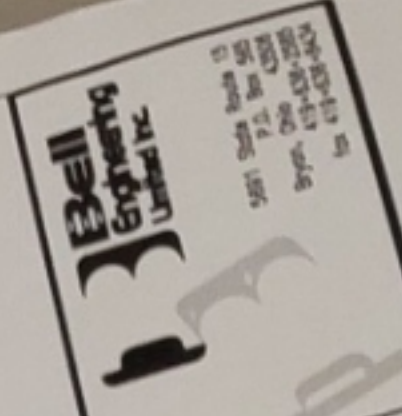

1581 Oak Ridge Rd.
P.O. Box 100
Bryn Mawr, PA 19005
Tel: 610-353-4400
Fax: 610-353-4404

PROPOSED UTILITIES EXTENSION TO
VILLAGE OF WEST UNITY
WEST UNITY, OHIO
PLAN AND PROFILE
AS-BUILTS

Job No
07-013
ISSUE DATES
01-04-08 BID 5
01-14-10 AS-BUILT

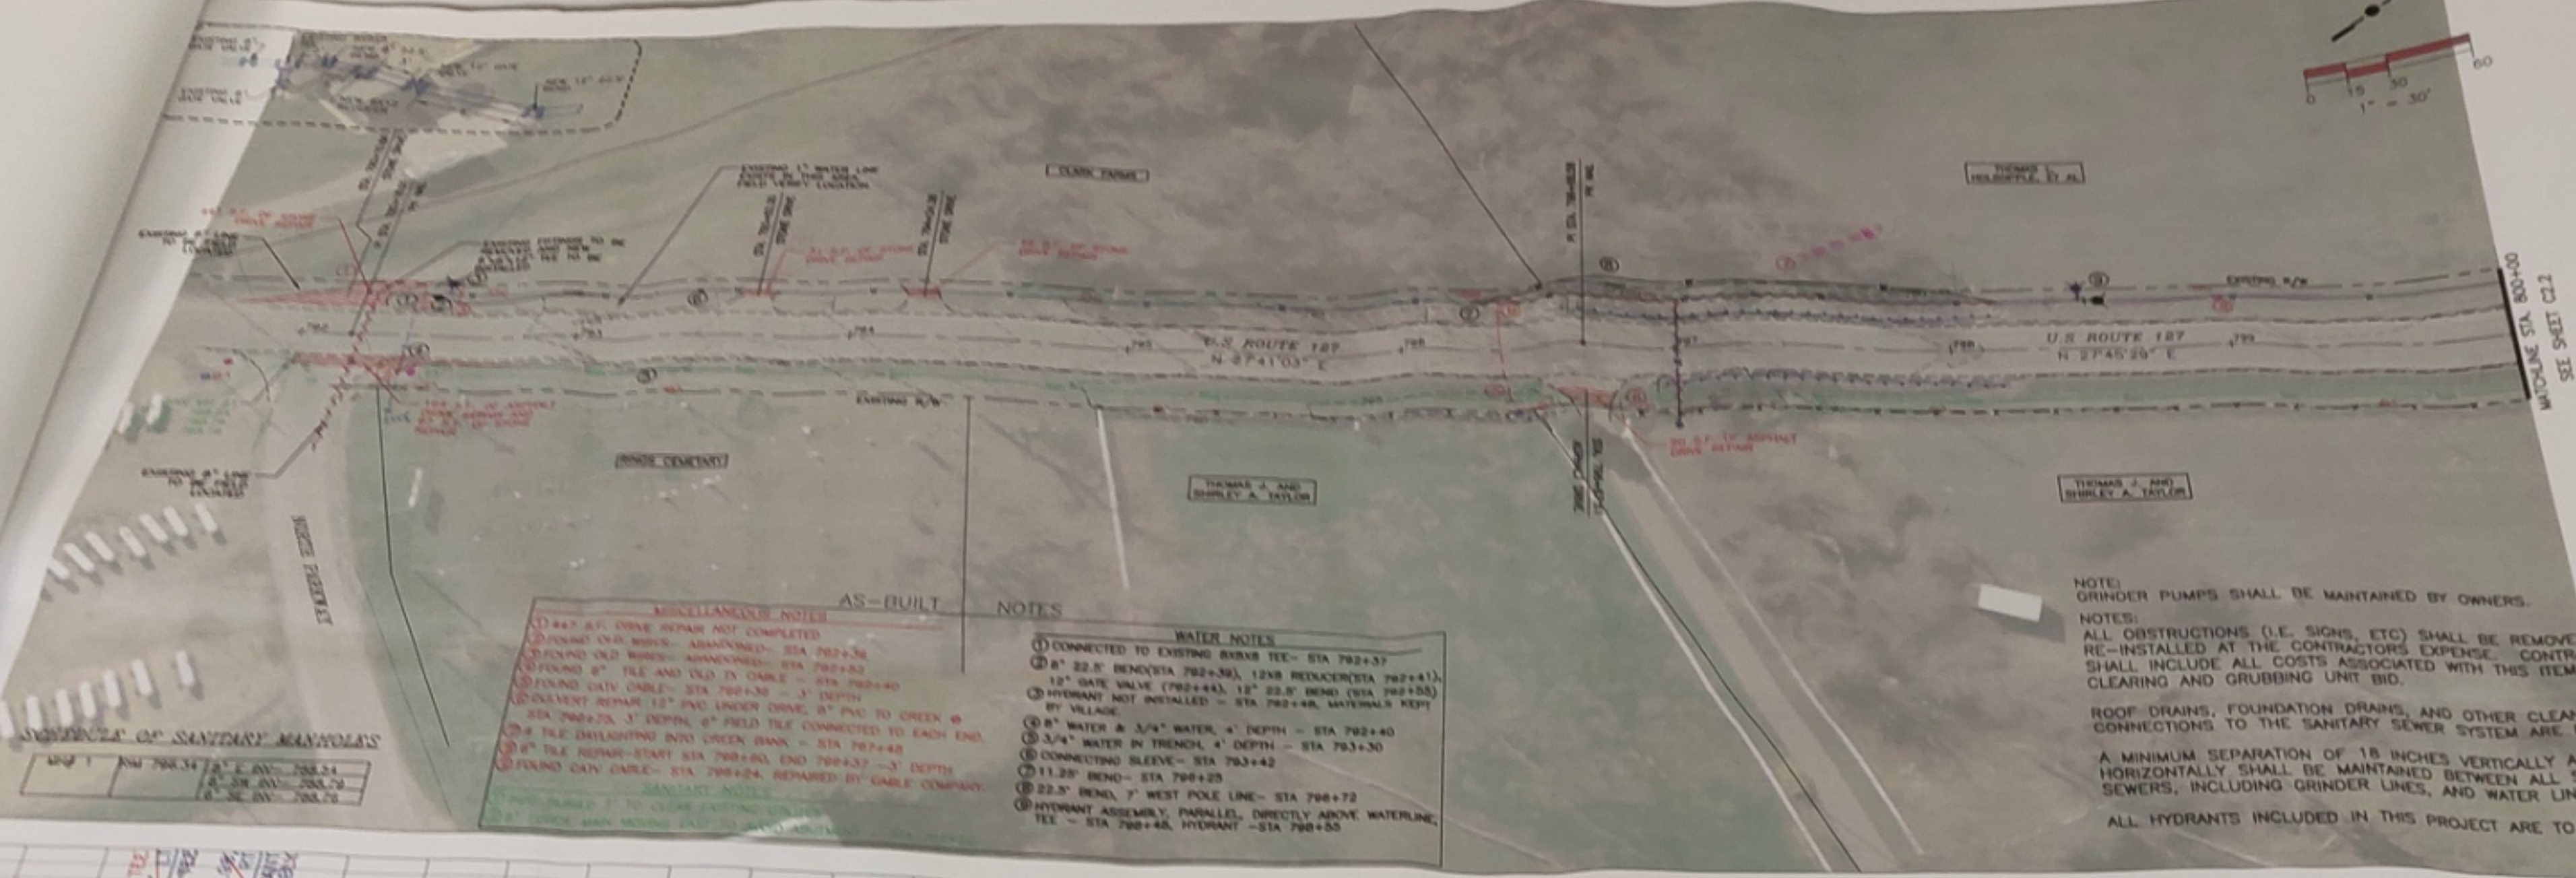

- MISCELLANEOUS NOTES**
- 1) 44' R.F. DRIVE REPAIR NOT COMPLETED
 - 2) FOUND OLD MANHOLE - ABANDONED - STA 792+38
 - 3) FOUND OLD MANHOLE - ABANDONED - STA 792+82
 - 4) FOUND 8" TILE AND OLD 12" CABLE - STA 792+40
 - 5) FOUND 6" CABLE - STA 792+30 - 3' DEPTH
 - 6) EXISTING 12" PVC UNDER DRIVE, 8" PVC TO CREEK @ STA 792+25, 3' DEPTH, 8" FIELD TILE CONNECTED TO EACH END
 - 7) 8" TILE ENLIGHTENING INTO CREEK BANK - STA 792+48
 - 8) 8" TILE REPAIR - START STA 792+80, END 792+37 - 3' DEPTH
 - 9) FOUND 6" CABLE - STA 792+24, REPAIRED BY CABLE COMPANY
- WATER NOTES**
- 1) CONNECTED TO EXISTING EXHIBIT TEE - STA 792+37
 - 2) 8" 22.5' BEND (STA 792+38), 12" REINFORCED (STA 792+41), 12" GATE VALVE (792+44), 12" 22.5' BEND (STA 792+55)
 - 3) HYDRANT NOT INSTALLED - STA 792+48, MATERIALS KEPT BY VILLAGE
 - 4) 8" WATER & 3/4" WATER, 4" DEPTH - STA 792+40
 - 5) 3/4" WATER IN TRENCH, 4" DEPTH - STA 793+30
 - 6) CONNECTING SLEEVE - STA 793+42
 - 7) 11.25' BEND - STA 796+25
 - 8) 22.5' BEND, 7" WEST POLE LINE - STA 796+72
 - 9) HYDRANT ASSEMBLY, PARALLEL, DIRECTLY ABOVE WATERLINE, TEE - STA 796+48, HYDRANT - STA 796+55

NOTE: GRINDER PUMPS SHALL BE MAINTAINED BY OWNERS.

NOTES:
ALL OBSTRUCTIONS (I.E. SIGNS, ETC) SHALL BE REMOVED AND RE-INSTALLED AT THE CONTRACTOR'S EXPENSE. CONTRACTOR SHALL INCLUDE ALL COSTS ASSOCIATED WITH THIS ITEM IN THE CLEARING AND GRUBBING UNIT BID.

ROOF DRAINS, FOUNDATION DRAINS, AND OTHER CLEAN WATER CONNECTIONS TO THE SANITARY SEWER SYSTEM ARE PROHIBITED.

A MINIMUM SEPARATION OF 18 INCHES VERTICALLY AND 10 FEET HORIZONTALLY SHALL BE MAINTAINED BETWEEN ALL SANITARY SEWERS, INCLUDING GRINDER LINES, AND WATER LINES.

ALL HYDRANTS INCLUDED IN THIS PROJECT ARE TO BE PLUGGED.

