


WILLIAMS COUNTY

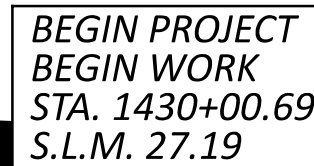

DESIGN DESIGNATION

CURRENT ADT (2026)	3,000
DESIGN YEAR ADT (2046)	3,600
DESIGN HOURLY VOLUME (2046)	450
DIRECTIONAL DISTRIBUTION	0.57
TRUCKS (24 HOUR B&C)	0.09
DESIGN SPEED	60
LEGAL SPEED	55
DESIGN FUNCTIONAL CLASSIFICATION:	
MAJOR COLLECTOR	
NHS PROJECT	NO

DESIGN EXCEPTIONS

NONE REQUIRED

ADA DESIGN WAIVERS

NONE REQUIRED

UNDERGROUND UTILITIES Contact Two Working Days Before You Dig
 OHIO811.org Before You Dig
OHIO811, 8-1-1, or 1-800-362-2764 (Non members must be called directly)

PLAN PREPARED BY:
OHIO DEPARTMENT OF TRANSPORTATION
DISTRICT 2
BOWLING GREEN, OHIO

INDEX OF SHEETS:

TITLE SHEET	1
TYPICAL SECTION	2
GENERAL NOTES	3
MAINTENANCE OF TRAFFIC	4
GENERAL SUMMARY	5
SUBSUMMARY	6
PLAN AND PROFILE	7
STRUCTURE (OVER 20' SPAN)	8-13
WIL-34-2722	

[illegible]**FEDERAL PROJECT NUMBER**

E250781

RAILROAD INVOLVEMENT

NONE

PROJECT DESCRIPTION

PROJECT CONSISTS OF REHABILITATION OF ONE BRIDGE,
WIL-34-27.22 OVER BRUSH CREEK; PERFORM NECESSARY
RELATED WORK.

EARTH DISTURBED AREAS

PROJECT EARTH DISTURBED AREA: 0.26 ACRES
ESTIMATED CONTRACTOR EARTH DISTURBED AREA: 0.0 ACRES
NOTICE OF INTENT EARTH DISTURBED AREA: N/A (NOI NOT REQUIRED)


2023 SPECIFICATIONS

THE STANDARD SPECIFICATIONS OF THE STATE OF OHIO, DEPARTMENT OF
TRANSPORTATION, INCLUDING SUPPLEMENTAL SPECIFICATIONS LISTED IN
THE PLANS, CHANGES LISTED IN THE PROPOSAL, AND THE SUPPLEMENTAL
SPECIFICATION 800 VERSION INDICATED ON THE PROPOSAL SHALL GOVERN
THIS IMPROVEMENT.


Pat McColley, P.E., S.I.
District 02 Deputy Director


Pamela Boratyn
Director, Department of Transportation

ENGINEER'S SEAL

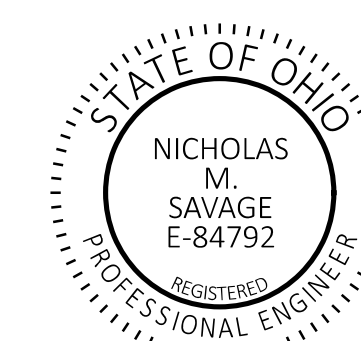

TITLE SHEET

DESIGN AGENCY



DESIGNER	
NMS	
REVIEWER	
RC	10/27/2013
PROJECT ID	
121332	
SHEET	TOTAL
1	13

WIL-34-27.22

Model: Steel PAPER SIZE: 34x22 (in.) DATE: 1/16/2026 TIME: 12:16:07 PM PLT DRV: OHDOT PDF: pdfcgit PEN TBL: OHDOT_Pen.tbl USER: Nicholas.Savage@dot.dhio.gov WORKSPACE: OHDOTCEv02 WORKSET: 121332 PRODUCT: OpenRoads Designer 24.00.00.205
 www.lvhohdot-pw.bentley.com:ohdot-pw-02\Documents\01 Active Projects\District 02\Williams\121332\400-Engineering\Roadway\Sheets\121332 GG001.dgn

[illegible]

GENERAL SUMMARY

DESIGN AGENCY



DESIGNER

NMS

REVIEWER

JRC 10/27/25


PROJECT ID

121332


SHEET

TOTAL	13
-------	----



[illegible]

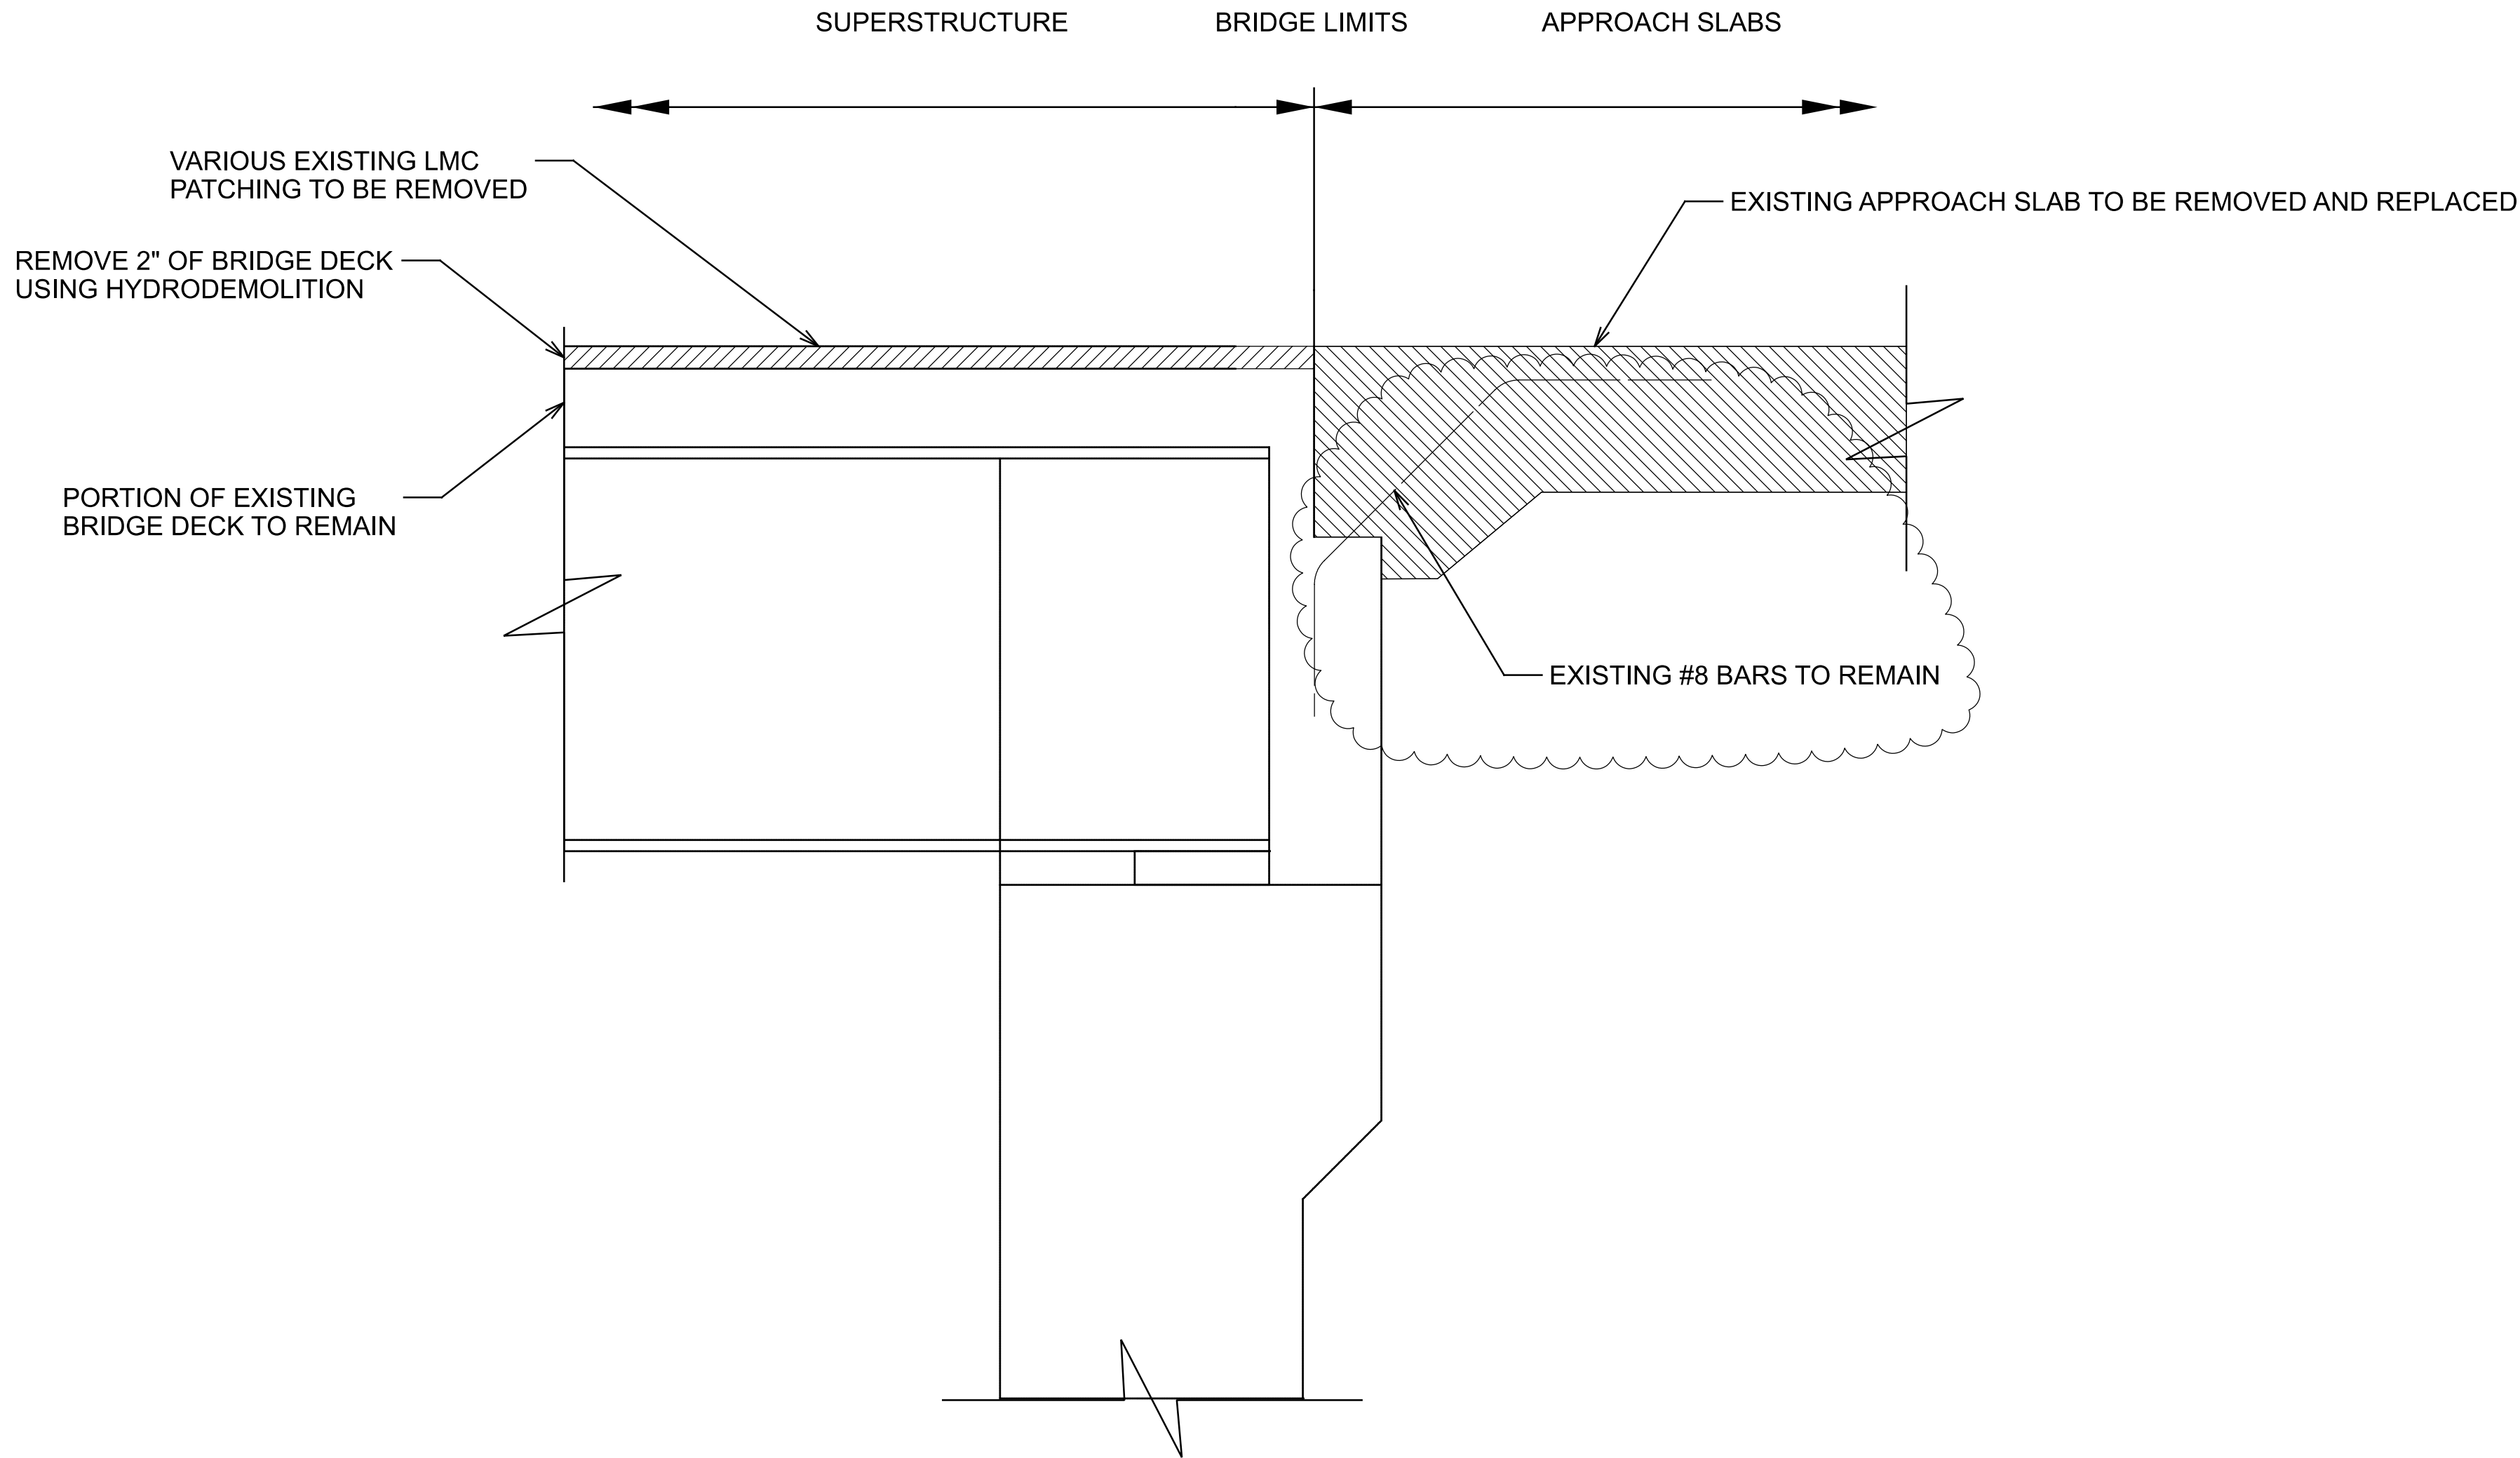

REMOVAL DETAIL

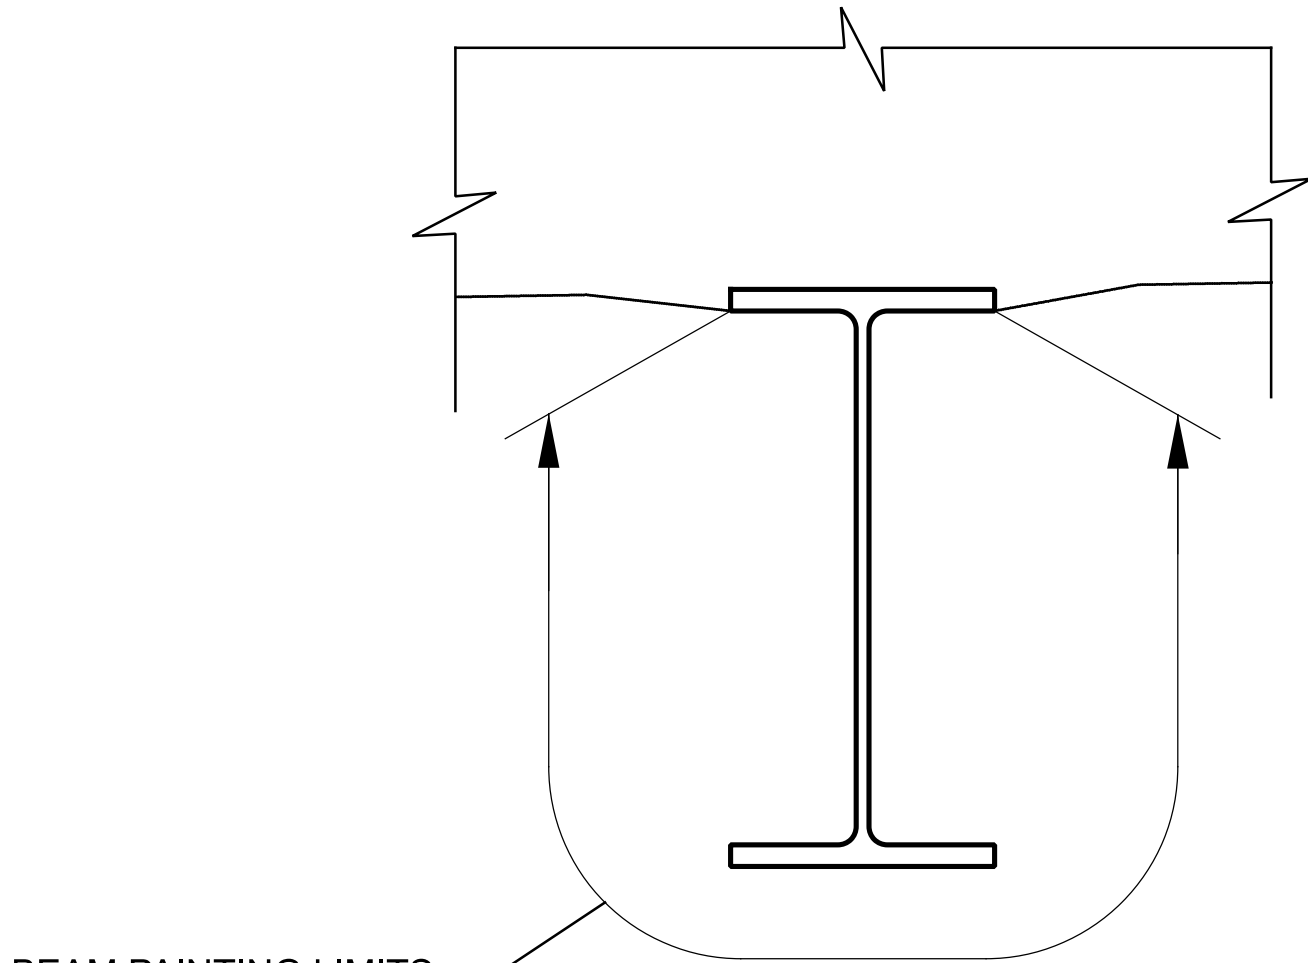

BEAM PAINTING DETAIL

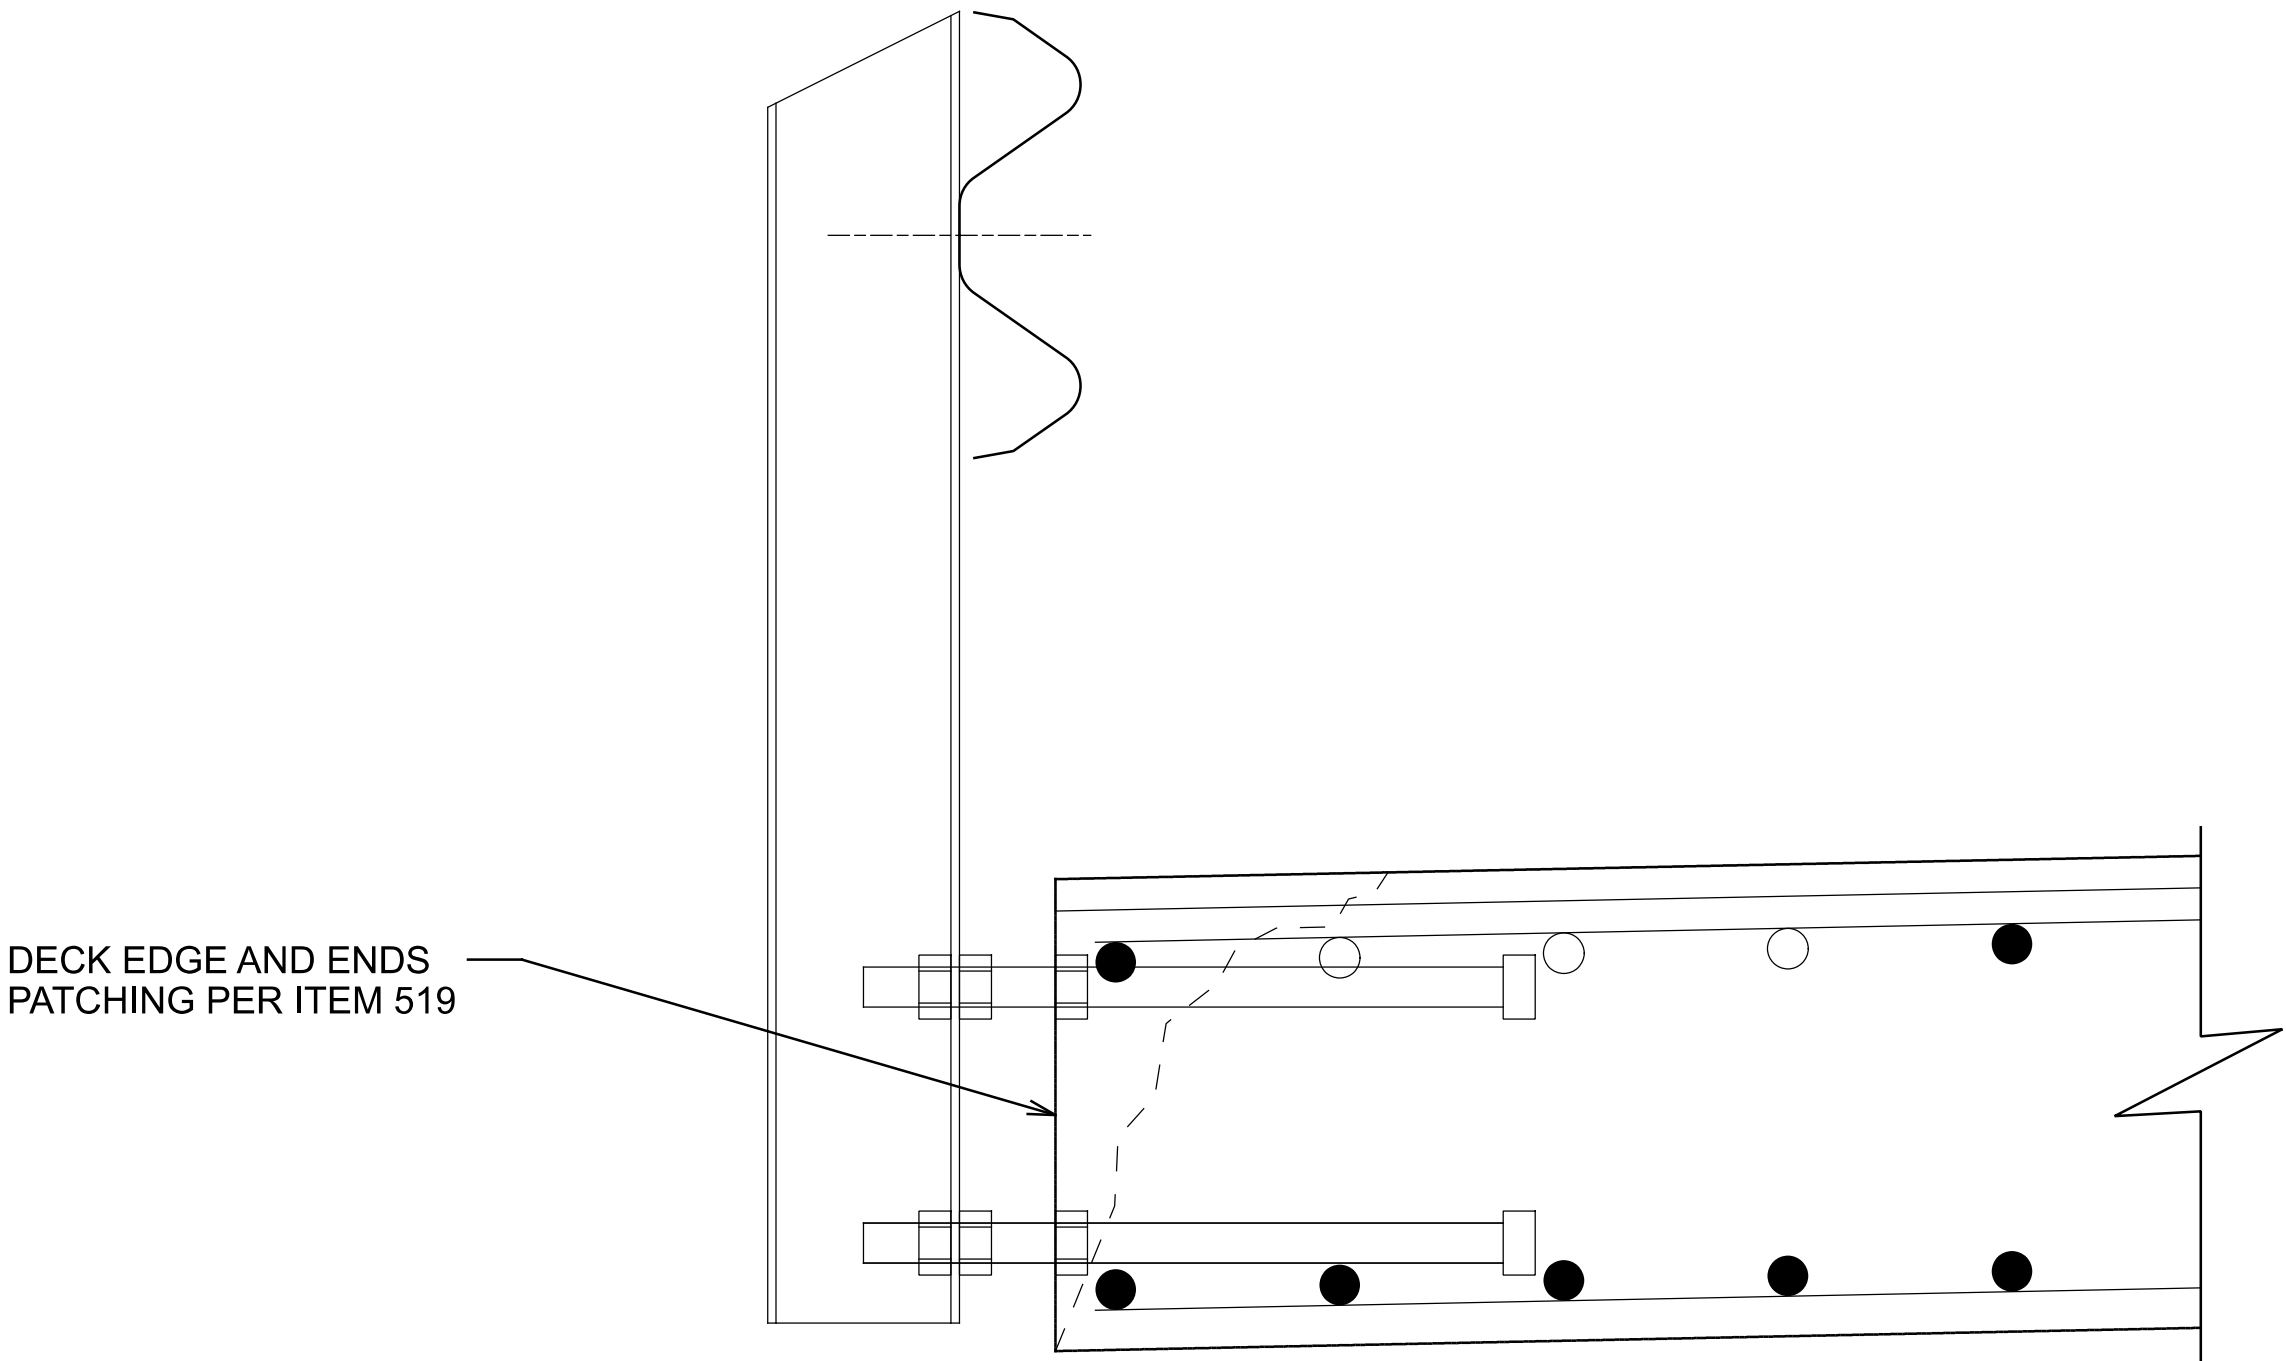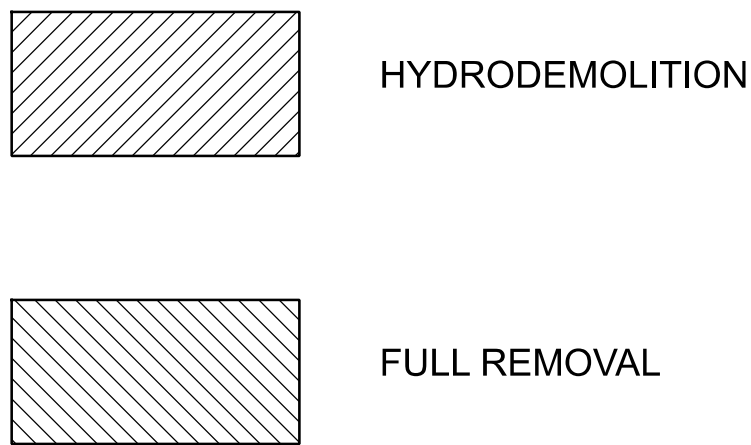

PATCHING DETAIL