



TYPICAL SECTION "A"

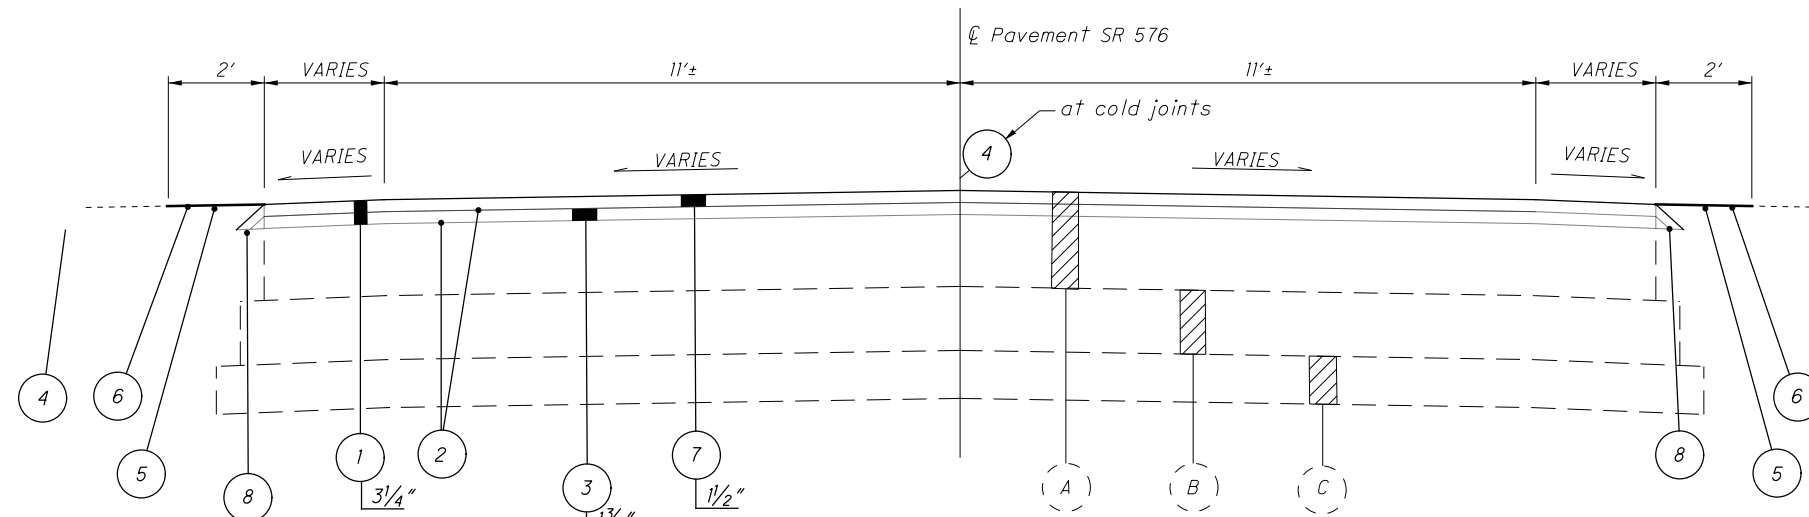

Typical Section Applies: Sta. 874+00 to Sta. 936+17 = 6,217 Ft.
 Sta. 938+39 to Sta. 1035+00 = 9,661 Ft.
 Sta. 1041+50 to Sta. 1062+50 = 2,100 Ft.
 Sta. 1063+31 to Sta. 1083+27 = 1,996 Ft.
 = 19,974 Ft.

TYPICAL SECTION "B"

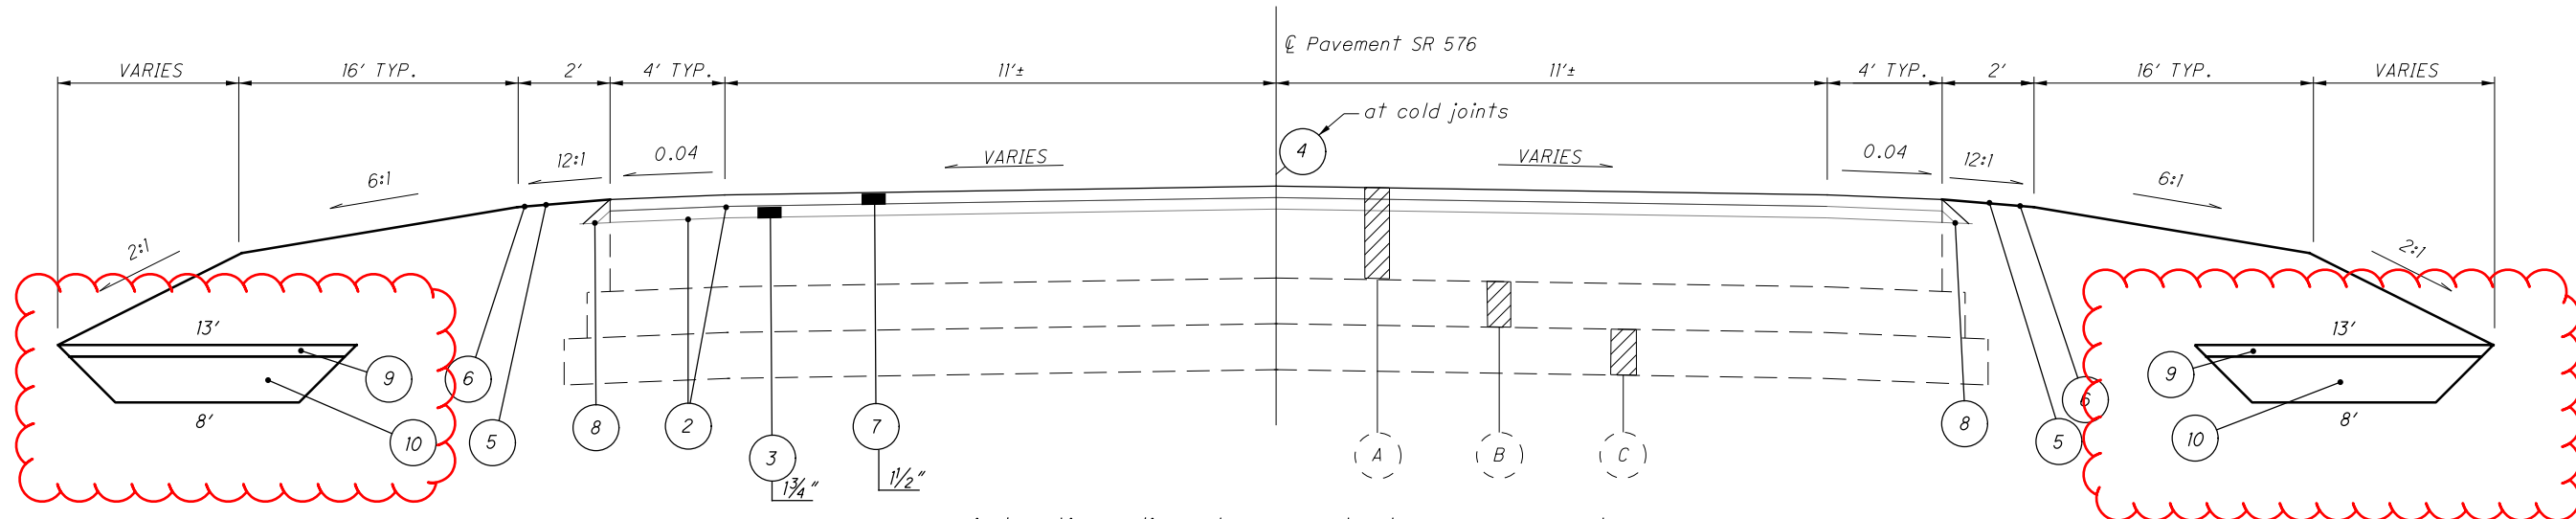


Typical Section Applies: Sta. 1035+00 to Sta. 1038+40 = 340 Ft.
 Sta. 1039+20 to Sta. 1041+50 = 230 Ft.
 = 570 Ft.

LEGEND

- (1) Item 254 - Pavement Planing, Asphalt Concrete (Thickness as Shown)
- (2) Item 407 - Non Tracking Tack Coat
- (3) Item 441- Asphalt Concrete Intermediate Course, Type 2, (448) (Thickness as Shown)
- (4) Item 875 - Longitudinal Joint Adhesive
- (5) Item 617 - Compacted Aggregate
- (6) Item 209 - Linear Grading
- (7) Item 441 - Asphalt Concrete Surface Course, Type 1, (446), PG64-22 (Thickness as Shown)

- (8) Item 209 - Preparing Subgrade for Shoulder Paving
Item 441 - Asphalt Concrete - Safety Edge (See General Notes)
- (9) Item 204- Granular Material, Type B (6" Thickness)
- (10) Item 204 - Granular Material, Type D (24" Thickness)
- (A) Existing Asphalt - 10"±
- (B) Aggregate Base
- (C) Subbase

TYPICAL SECTION "C"

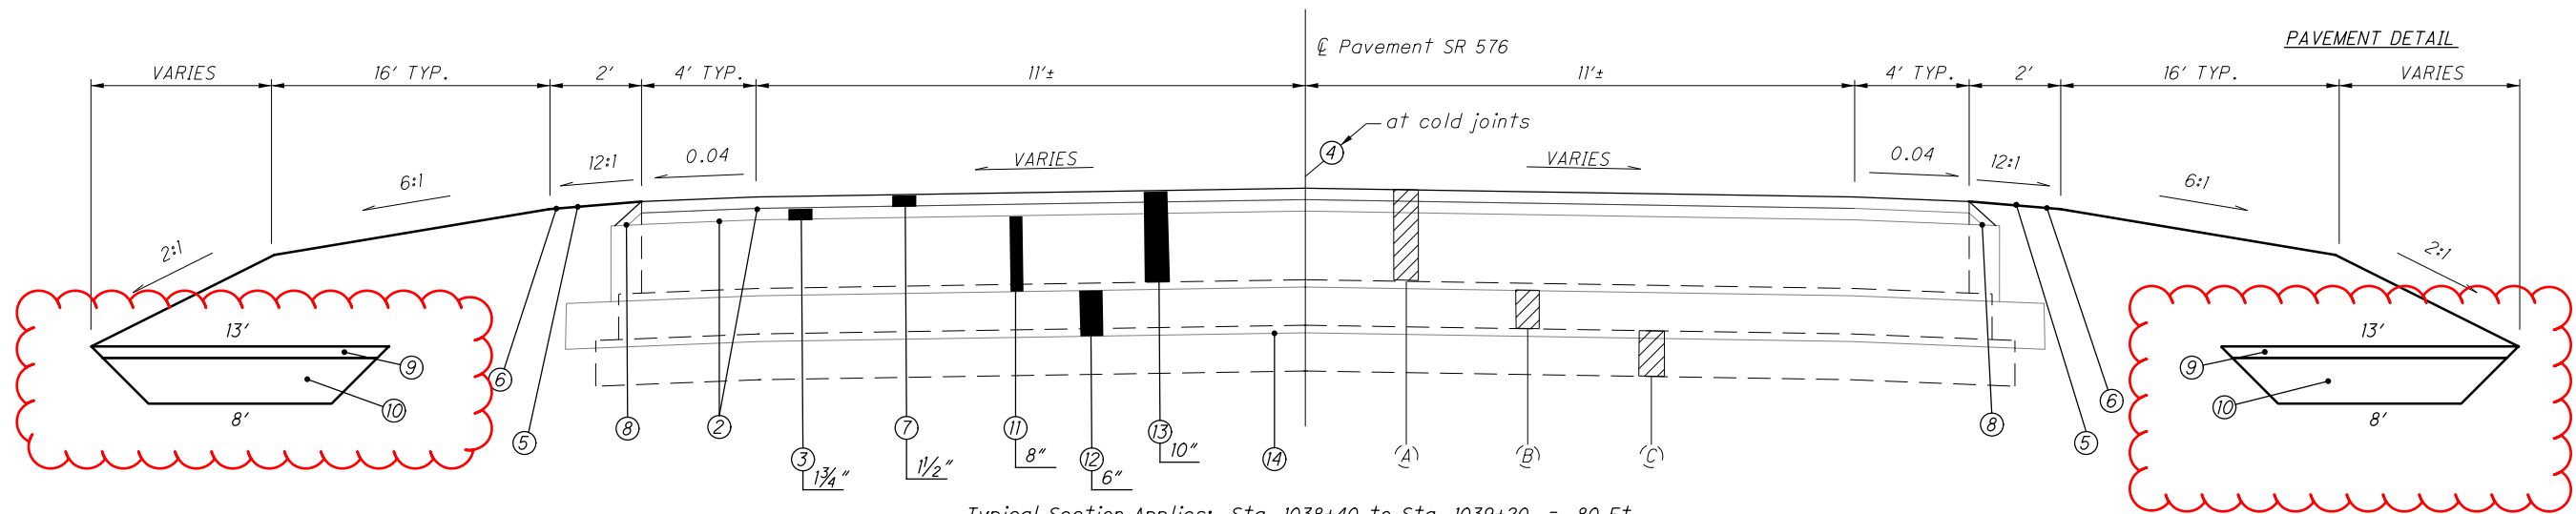

Typical Section Applies: Sta. 1038+40 to Sta. 1039+20 = 80 Ft.

LEGEND

- | | |
|---|-----------------------------|
| ① Item 254 - Pavement Planing, Asphalt Concrete (Thickness as Shown) | (A) Existing Asphalt - 10"± |
| ② Item 407 - Non Tracking Tack Coat | (B) Aggregate Base |
| ③ Item 441- Asphalt Concrete Intermediate Course, Type 2, (448) (Thickness as Shown) | (C) Subbase |
| ④ Item 875 - Longitudinal Joint Adhesive | |
| ⑤ Item 617 - Compacted Aggregate | |
| ⑥ Item 209 - Linear Grading | |
| ⑦ Item 441 - Asphalt Concrete Surface Course, Type 1, (446), PG64-22 (Thickness as Shown) | |
| ⑧ Item 209 - Preparing Subgrade for Shoulder Paving
Item 441 - Asphalt Concrete Safety Edge (See General Notes) | |
| ⑨ Item 204- Granular Material, Type B (6" Thickness) | |
| ⑩ Item 204 - Granular Material, Type D (24" Thickness) | |
| ⑪ Item 301 - Asphalt Concrete Base PG64-22 (Thickness as Shown) | |
| ⑫ Item 304 - Aggregate Base (Thickness as Shown) | |
| ⑬ Item 202 - Pavement Removed, Asphalt | |
| ⑭ Item 204 - Subgrade Compaction | |

UTILITIES

LISTED BELOW ARE ALL THE UTILITIES LOCATED WITHIN THE PROJECT CONSTRUCTION LIMITS TOGETHER WITH THEIR RESPECTIVE OWNERS:

FRONTIER NORTH WESTERN ELECTRIC
 300 WEST GYPSY LANE RD P.O. BOX 391
 BOWLING GREEN, OH 43402 BRYAN, OH 43506
 PH: (419) 354-9452 PH: (419) 636-5051

WILLIAMS COUNTY ENGINEER'S
 12953 COUNTY RD "G"
 BRYAN, OHIO 43506
 PH: (419) 636-2454

THE LOCATION OF THE UNDERGROUND UTILITIES SHOWN ON THE PLANS ARE OBTAINED FROM THE OWNERS AS REQUIRED BY SECTION 153.64 O.R.C.

SURVEYING PARAMETERS

USE THE FOLLOWING VERTICAL POSITIONING AND HORIZONTAL POSITIONING PARAMETERS FOR ALL SURVEYING:

VERTICAL POSITIONING

ORTHOMETRIC HEIGHT DATUM: NAVD88 (ODOT VRS DERIVED)
 GEOID: 2012A

HORIZONTAL POSITIONING

REFERENCE FRAME: NAD83 (2011)
 ELLIPSOID: GRS80
 MAP PROJECTION: LAMBERT CONFORMAL CONIC
 COORDINATE SYSTEM: OHIO STATE PLANE NORTH
 COMBINED SCALE FACTOR: GRID=1.0000000

UNITS ARE IN U.S. SURVEY FEET. USE THE FOLLOWING CONVERSION FACTOR: 1 METER = 3.280833333 U.S. SURVEY

ROUNDING

THE ROUNDING AT SLOPE BREAKPOINTS SHOWN ON THE TYPICAL SECTIONS APPLIES TO ALL CROSS-SECTIONS EVEN THOUGH OTHERWISE SHOWN.

WORK LIMITS

THE WORK LIMITS SHOWN ON THESE PLANS ARE FOR PHYSICAL CONSTRUCTION ONLY. PROVIDE THE INSTALLATION AND OPERATION OF ALL WORK ZONE TRAFFIC CONTROL AND WORK ZONE TRAFFIC CONTROL DEVICES REQUIRED BY THESE PLANS WHETHER INSIDE OR OUTSIDE THESE WORK LIMITS.

PROFILE AND ALIGNMENT

THE WORK PROPOSED BY THIS PROJECT IS FOR THE RESURFACING OF THE EXISTING PAVEMENT. THE ALIGNMENT OF THE EXISTING PAVEMENT WILL NOT BE CHANGED AND THE PROFILE OF THE PROPOSED SURFACE WILL BE SIMILAR TO THAT OF THE EXISTING PAVEMENT.

PLANED SURFACES


NO PLANED SURFACES SHALL BE OPEN TO THE PUBLIC FOR MORE THAN 7 DAYS. IF THE PLANED SURFACE IS OPEN FOR MORE THAN 7 DAYS, IT SHALL BE THE CONTRACTOR'S RESPONSIBILITY TO REPAIR THE PAVEMENT FAILURES THAT OCCURRED AFTER THE 7 DAY LIMIT.

PAVEMENT REPAIRS

THE FOLLOWING ESTIMATED QUANTITIES ARE TO BE USED FOR PAVEMENT REPAIR ON US 6 AND AS DIRECTED BY THE ENGINEER AND ARE BASED ON THE PERCENTAGES SHOWN:

SR 576 SLM 16.55 - 20.52 @ 10%
 STA. 874+00 TO STA. 1083+27 = 20,927*22'*0.5=230,197CF
 230,197CF/27=8,526CY @ 10% = 853CY

ITEM 253 - PAVEMENT REPAIR 6" 853 CY

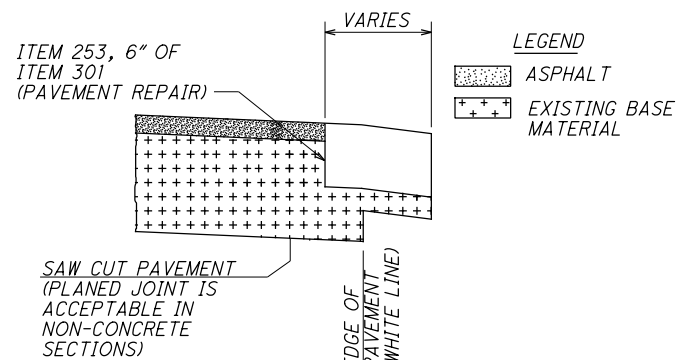

NOTE: THE ENGINEER SHALL FIELD VERIFY ALL LOCATIONS PRIOR TO THE BEGINNING OF WORK. ANY ADJUSTMENTS NECESSARY SHALL BE AS DIRECTED BY THE ENGINEER.

THE PAVEMENT REPAIRS SHALL BE DONE AFTER PAVEMENT PLANING.

ASPHALT CONCRETE - SAFETY EDGE

THE FOLLOWING ESTIMATED QUANTITIES ARE TO BE USED FOR THE CONSTRUCTION OF THE SAFETY EDGE. SEE SCD BP-3.2.

WIL SR 576 (16.55-20.52) STA. 874+00 TO STA. 1083+27 (MINUS LOCATIONS FOR GUARDRAIL)

ITEM 209 - PREPARING SUBGRADE FOR SHOULDER PAVING

8 MILE

ITEM 441 - ASPHALT CONCRETE SURFACE COURSE, TYPE 1, (448), PG64-22

71 CY

ITEM 441 - ASPHALT CONCRETE INTERMEDIATE COURSE, TYPE 2, (448)

29 CY

QUANTITIES TO BE USED FOR THE SAFETY EDGE HAVE BEEN CARRIED TO THE GENERAL SUMMARY.

TRAFFIC CONTROL QUANTITIES

PAVEMENT MARKINGS

THE CONTRACTOR WILL BE PROVIDED THE "NO PASSING ZONE LOG" FOR THE CENTER LINE PAVEMENT MARKING UPON REQUEST.

THE FOLLOWING ARE FOR INFORMATION ONLY:

YELLOW CENTER LINE			
	DASHED SOLID	2 MILE	
	DOUBLE SOLID	2 MILE	
RAISED PAVEMENT MARKERS			
	TWO WAY YELLOW/YELLOW	293 EACH	

ITEM	QTY	UNIT	DESCRIPTION
621	293	EACH	RPM
621	293	EACH	RAISED PAVEMENT MARKER REMOVED
642	7.94	MILE	EDGE LINE, 6"
642	3.97	MILE	CENTER LINE
644	30	FT	STOP LINE

ALL TRAFFIC CONTROL QUANTITIES ARE CARRIED TO THE GENERAL SUMMARY.

CROSSINGS AND CONNECTIONS TO EXISTING PIPES AND UTILITIES

WHERE PLANS PROVIDE FOR A PROPOSED CONDUIT TO BE CONNECTED TO, OR CROSS OVER OR UNDER AN EXISTING SEWER OR UNDERGROUND UTILITY, THE CONTRACTOR SHALL LOCATE THE EXISTING PIPES OR UTILITIES BOTH AS TO LINE AND GRADE BEFORE STARTING TO LAY THE PROPOSED CONDUIT.

IF IT IS DETERMINED THAT THE ELEVATION OF THE EXISTING CONDUIT, OR EXISTING APPURTENANCE TO BE CONNECTED, DIFFERS FROM THE PLAN ELEVATION OR RESULTS IN A CHANGE IN THE PLAN CONDUIT SLOPE, THE ENGINEER SHALL BE NOTIFIED BEFORE STARTING CONSTRUCTION OF ANY PORTION OF THE PROPOSED CONDUIT WHICH WILL BE AFFECTED BY THE VARIANCE IN THE EXISTING ELEVATIONS.

IF IT IS DETERMINED THAT THE PROPOSED CONDUIT WILL INTERSECT AN EXISTING SEWER OR UNDERGROUND UTILITY IF CONSTRUCTED AS SHOWN ON THE PLAN, THE ENGINEER SHALL BE NOTIFIED BEFORE STARTING CONSTRUCTION OF ANY PORTION OF THE PROPOSED CONDUIT WHICH WOULD BE AFFECTED BY THE INTERFERENCE WITH AN EXISTING FACILITY.

PAYMENT FOR ALL THE OPERATIONS DESCRIBED ABOVE SHALL BE INCLUDED IN THE CONTRACT PRICE FOR THE PERTINENT 611 CONDUIT ITEM.

REVIEW OF DRAINAGE FACILITIES

BEFORE ANY WORK IS STARTED ON THE PROJECT AND AGAIN BEFORE FINAL ACCEPTANCE BY THE STATE, REPRESENTATIVES OF THE STATE AND THE CONTRACTOR, ALONG WITH LOCAL REPRESENTATIVES, SHALL MAKE AN INSPECTION OF ALL EXISTING SEWERS WHICH ARE TO REMAIN IN SERVICE AND WHICH MAY BE AFFECTED BY THE WORK. THE CONDITION OF THE EXISTING CONDUITS AND THEIR APPURTENANCE SHALL BE DETERMINED FROM FIELD OBSERVATIONS. RECORDS OF THE INSPECTION SHALL BE KEPT IN WRITING BY THE STATE.

ALL NEW CONDUITS, INLETS, CATCH BASINS, AND MANHOLES CONSTRUCTED AS A PART OF THE PROJECT SHALL BE FREE OF ALL FOREIGN MATTER AND IN A CLEAN CONDITION BEFORE THE PROJECT WILL BE ACCEPTED BY THE STATE.

ALL EXISTING SEWERS INSPECTED INITIALLY BY THE ABOVE MENTIONED PARTIES SHALL BE MAINTAINED AND LEFT IN A CONDITION REASONABLY COMPARABLE TO THAT DETERMINED BY THE ORIGINAL INSPECTION. ANY CHANGE IN THE CONDITION RESULTING FROM THE CONTRACTOR'S OPERATIONS SHALL BE CORRECTED BY THE CONTRACTOR TO THE SATISFACTION OF THE ENGINEER.

PAYMENT FOR ALL OPERATIONS DESCRIBED ABOVE SHALL BE INCLUDED IN THE CONTRACT PRICE FOR THE PERTINENT 611 CONDUIT ITEMS.

MISCELLANEOUS ITEMS FOR GUARDRAIL

THE FOLLOWING ITEMS ARE TO BE USED AS DIRECTED BY THE ENGINEER. THE ESTIMATED QUANTITIES ARE CARRIED TO THE GENERAL SUMMARY AND ARE TO BE USED FOR PROPOSED GUARDRAIL RUNS:

ITEM 203	10	CY	EMBANKMENT
ITEM 601	5	CY	CRUSHED AGGREGATE
ITEM 659	195	SY	SLOPE PROTECTION
ITEM 659	0.03	TON	SEEDING AND MULCHING
ITEM 659	1	MGAL	FERTILIZER
			WATER

EMBANKMENT SHALL BE USED TO OBTAIN A GRADED SLOPE OF 10:1 OR FLATTER THROUGHOUT THE GUARDRAIL RUN UP TO FACE OF GUARDRAIL.

CRUSHED AGGREGATE SLOPE PROTECTION SHALL BE USED IN AREAS OF OBVIOUS EROSION TO GRADED SHOULDER.

ITEM 606 - ANCHOR ASSEMBLY, MGS TYPE E

THIS ITEM SHALL CONSIST OF FURNISHING AND INSTALLING ANY OF THE GUARDRAIL END TERMINALS FOR TYPE MGS GUARDRAIL AS LISTED ON ROADWAY ENGINEERING'S WEB PAGE UNDER ROADSIDE SAFETY DEVICES FOR APPROVED GUARDRAIL END TREATMENTS. INSTALLATION SHALL BE AT THE LOCATIONS SPECIFIED IN THE PLANS, IN ACCORDANCE WITH THE MANUFACTURER'S SPECIFICATIONS.

THE FACE OF THE TYPE E IMPACT HEAD SHALL BE COVERED WITH A SHEET OF TYPE G REFLECTIVE SHEETING, PER CMS 730.19.

REFER TO THE MANUFACTURER'S INSTRUCTIONS REGARDING THE INSTALLATION OF, AND THE GRADING AROUND THE FOUNDATION TUBES AND GROUND STRUT. THE TOP OF ANY FOUNDATION TUBE SHOULD BE LESS THAN 4 INCHES ABOVE THE GROUND. THE PLACEMENT OF THE FOUNDATION TUBES SHOULD BE AN APPROPRIATE DEPTH BELOW THE LEVEL LINE IN ORDER TO MAINTAIN THE FINISHED GUARDRAIL HEIGHT OF 31 INCHES FROM THE EDGE OF THE SHOULDER.

ON-SITE GRADING IS REQUIRED IF THE TOP OF THE FOUNDATION TUBES OR TOP OF THE GROUND STRUT DOES PROJECT MORE THAN 4 INCHES ABOVE THE GROUND LINE.

PAYMENT FOR THE ABOVE WORK SHALL BE MADE AT THE UNIT PRICE BID FOR ITEM 606, ANCHOR ASSEMBLY, MGS TYPE E, EACH, AND SHALL INCLUDE ALL LABOR, TOOLS, EQUIPMENT AND MATERIALS NECESSARY TO CONSTRUCT A COMPLETE AND FUNCTIONAL ANCHOR ASSEMBLY SYSTEM, INCLUDING ALL RELATED TRANSITIONS, REFLECTIVE SHEETING, HARDWARE, GRADING, EMBANKMENT AND EXCAVATION NOT SEPARATELY SPECIFIED, AS REQUIRED BY THE MANUFACTURER.

ITEM 606 GUARDRAIL, TYPE MGS WITH LONG POSTS, AS PER PLAN

THIS ITEM 606 SHALL INCLUDE ALL LABOR, MATERIALS AND EQUIPMENT NECESSARY TO REPLACE EXISTING GUARDRAIL USING STEEL POSTS, AS DIRECTED BY THE ENGINEER. THE GUARDRAIL POSTS SHALL CONFORM TO ITEM 606 AND 710.15 OF THE CMS.

PAVEMENT RESTORATION FOR CONCRETE CROSSOVER REMOVALS

THE FOLLOWING QUANTITY HAS BEEN PROVIDED FOR PAVEMENT RESTORATION FOLLOWING REMOVAL OF CONCRETE PAVEMENT OVER NEWLY INSTALLED CROSSOVER PIPES.

ITEM 301 ASPHALT CONCRETE BASE, PG64-22 10 CU. YDS.

THE ABOVE QUANTITY IS BASED ON A 301 THICKNESS OF 10 INCHES AND A PAVEMENT RESTORATION WIDTH OF FIVE FEET AT EACH CONCRETE PAVEMENT AREA.

ITEM 203 EXCAVATION, AS PER PLAN

THIS ITEM SHALL INCLUDE ALL LABOR, MATERIALS AND EQUIPMENT NECESSARY TO REMOVE OR DRIVE BELOW SUBGRADE ANY EXISTING GUARDRAIL POSTS SAWED OFF AT GROUND LEVEL THAT CONFLICTS WITH THE PROPOSED SHOULDER WIDENING. THE DECISION TO REMOVE OR DRIVE BELOW SUBGRADE SHALL BE AT THE DISCRETION OF THE PROJECT ENGINEER.

CALCULATED
 MJF
 CHECKED
 DAR

GENERAL NOTES

WIL - 576 - 16.55

I:\ProjectData\WIL\99575\WIL_576_16.55\Design\Roadway\Sheets\99575_GN001.dgn 13-APR-2021 3:42PM mferkas

I:\ProjectData\WIL_99575_WIL_576_16.55_Design\Roadway\Sheets\99575_GG001.dgn 13-APR-2021 4:01PM mFarikas

SHEET NUM.						PART.			ALT (X)	ITEM	ITEM EXT	GRAND TOTAL	UNIT	DESCRIPTION
4	6	8	14	15	34	01/STR/PV	02/STR/BR	03/STR/CV						
					OFFICE CALCS								ROADWAY	
				LS	LS			LS	201	11000	LS		CLEARING AND GRUBBING	
				LS				LS	202	11000	LS		STRUCTURE REMOVED	
		209						209	202	23000	209	SY	PAVEMENT REMOVED	
		450		1200		1200			202	38000	1,200	FT	GUARDRAIL REMOVED	
								450	203	10001	450	CY	EXCAVATION, AS PER PLAN	
10		450			5236	10		5686	203	20000	5,696	CY	EMBANKMENT	
		209						209	204	10000	209	SY	SUBGRADE COMPACTION	
					200			200	204	30010	200	CY	GRANULAR MATERIAL, TYPE B	
					667			667	204	30030	667	CY	GRANULAR MATERIAL, TYPE D	
		8				8			209	60500	8	MILE	LINEAR GRADING	
8						8			209	72050	8	MILE	PREPARING SUBGRADE FOR SHOULDER PAVING	
													EROSION CONTROL	
					437			437	659	00300	437	CY	TOPSOIL	
195					1800	195		7800	659	10000	7,995	SY	SEEDING AND MULCHING	
0.03					0.2	0.03		0.2	659	20000	0.23	TON	COMMERCIAL FERTILIZER	
1					2	1		2	659	35000	3	MGAL	WATER	
								LS	832	15000	LS	EACH	STORM WATER POLLUTION PLAN	
								LS	832	15002	LS	EACH	STORM WATER POLLUTION PREVENTION INSPECTIONS	
								LS	832	15010	LS	EACH	STORM WATER POLLUTION PREVENTION INSPECTION SOFTWARE	
								5000	832	30000	5,000	EACH	EROSION CONTROL	
													DRAINAGE	
			18					18	602	20000	18	CY	CONCRETE MASONRY	
			84					84	611	20900	84	FT	48" CONDUIT, TYPE B, RCP	
													PAVEMENT	
853						853			253	02000	853	CY	PAVEMENT REPAIR	
		56472				56472			254	01000	56,472	SY	PAVEMENT PLANING, ASPHALT CONCRETE, 3 1/4" THICKNESS	
		47						47	301	46000	47	CY	ASPHALT CONCRETE BASE, PG64-22	
		35						35	304	20000	35	CY	AGGREGATE BASE	
		4773	11			4773		11	407	20000	4,784	GAL	NON-TRACKING TACK COAT, INTERMEDIATE COURSE	
		3089	7			3089		7	407	20000	3,096	GAL	NON-TRACKING TACK COAT, SURFACE COURSE	
71						71			441	10000	71	CY	ASPHALT CONCRETE SURFACE COURSE, TYPE 1, (446), PG64-22	
		2340	5			2340		5	441	10000	2,345	CY	ASPHALT CONCRETE SURFACE COURSE, TYPE 1, (446), PG64-22, 1 1/2" THICKNESS	
29						29			441	50300	29	CY	ASPHALT CONCRETE INTERMEDIATE COURSE, TYPE 2, (448)	
		2730	6			2730		6	441	50300	2,736	CY	ASPHALT CONCRETE INTERMEDIATE COURSE, TYPE 2, (448), 1 3/4" THICKNESS	
		826	1			826		1	617	10100	827	CY	COMPACTED AGGREGATE	
		5624				5624			875	10000	5,624	LB	LONGITUDINAL JOINT ADHESIVE	
													TRAFFIC CONTROL	
293						293			621	00100	293	EACH	RPM	
293						293			621	54000	293	EACH	RAISED PAVEMENT MARKER REMOVED	
7.94						7.94			642	00104	7.94	MILE	EDGE LINE, 6", TYPE 1	
3.97						3.97			642	00300	3.97	MILE	CENTER LINE, TYPE 1	
30						30			644	00500	30	FT	STOP LINE	
													STRUCTURE REPAIR (WIL-576-1772)	
					716			716	512	73501	716	SY	TREATING CONCRETE BRIDGE DECKS WITH GRAVITY FED RESIN, AS PER PLAN	
					67			67	516	31000	67	FT	JOINT SEALER	
													MAINTENANCE OF TRAFFIC	
	10					10			614	12460	10	EACH	WORK ZONE MARKING SIGN	
	5					5			614	12500	5	EACH	REPLACEMENT SIGN	
	5					5			614	12600	5	EACH	REPLACEMENT DRUM	
	15					15			614	21550	15	MILE	WORK ZONE CENTER LINE, CLASS III, 642 PAINT	
													INCIDENTALS	
						LS			614	11000	LS		MAINTAINING TRAFFIC	
						LS			623	10000	LS		CONSTRUCTION LAYOUT STAKES AND SURVEYING	
						LS			624	10000	LS		MOBILIZATION	


CALCULATED MJF CHECKED DAR
GENERAL SUMMARY
WIL - 576 - 16 .55
 7
 40

I:\ProjectData\WIL_99575_WIL_576_16.55_Design\Roadway\Sheets\99575_XS004.dgn 01-APR-2021 11:44AM mforakas

SEEDING

END WIDTH	SO. YDS.

END AREA		VOLUME		CALCULATED	CHECKED
CUT	FILL	CUT	FILL	MJF	DAR

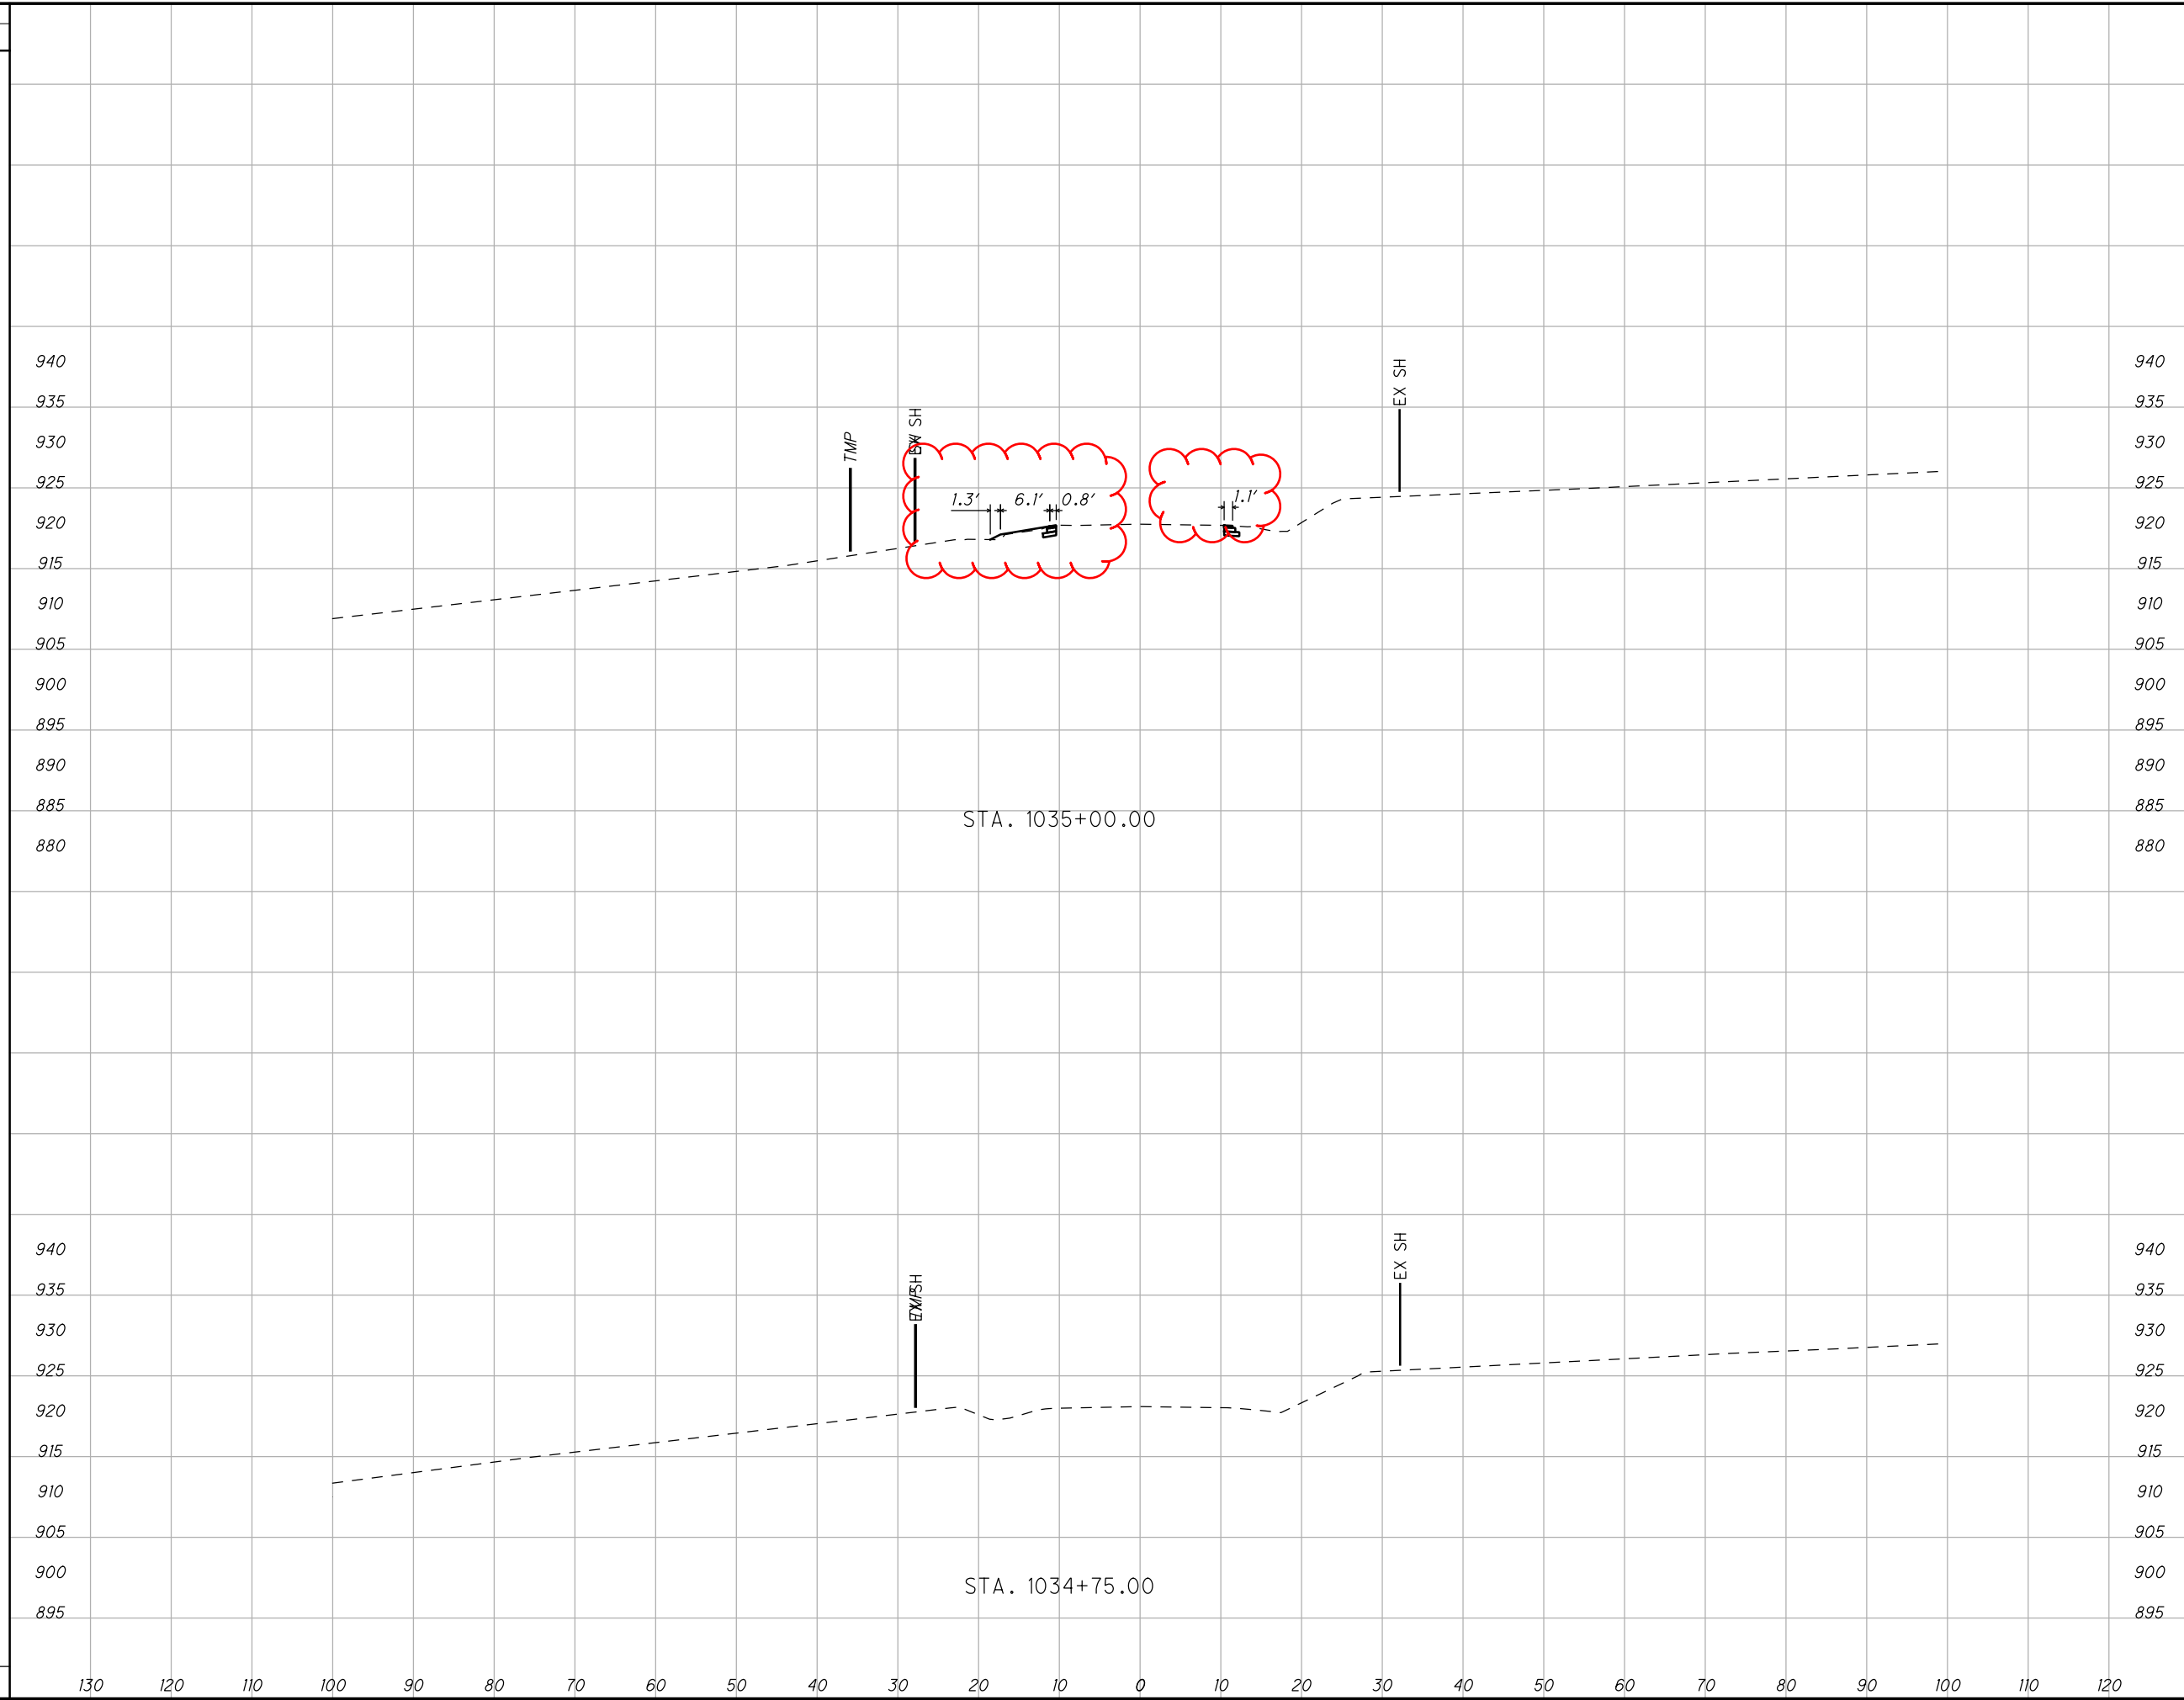


CROSS SECTIONS S.R. 576					
STA. 1034+75.00 TO STA. 1035+00.00					
WIL-576-16.55					
18 40					

I:\ProjectData\WIL\99575_WIL_576_16.55\Design\Roadway\Sheets\99575_XS005.dgn 01-APR-2021 11:44AM mforakas

SEEDING


END WIDTH	SO. YDS.

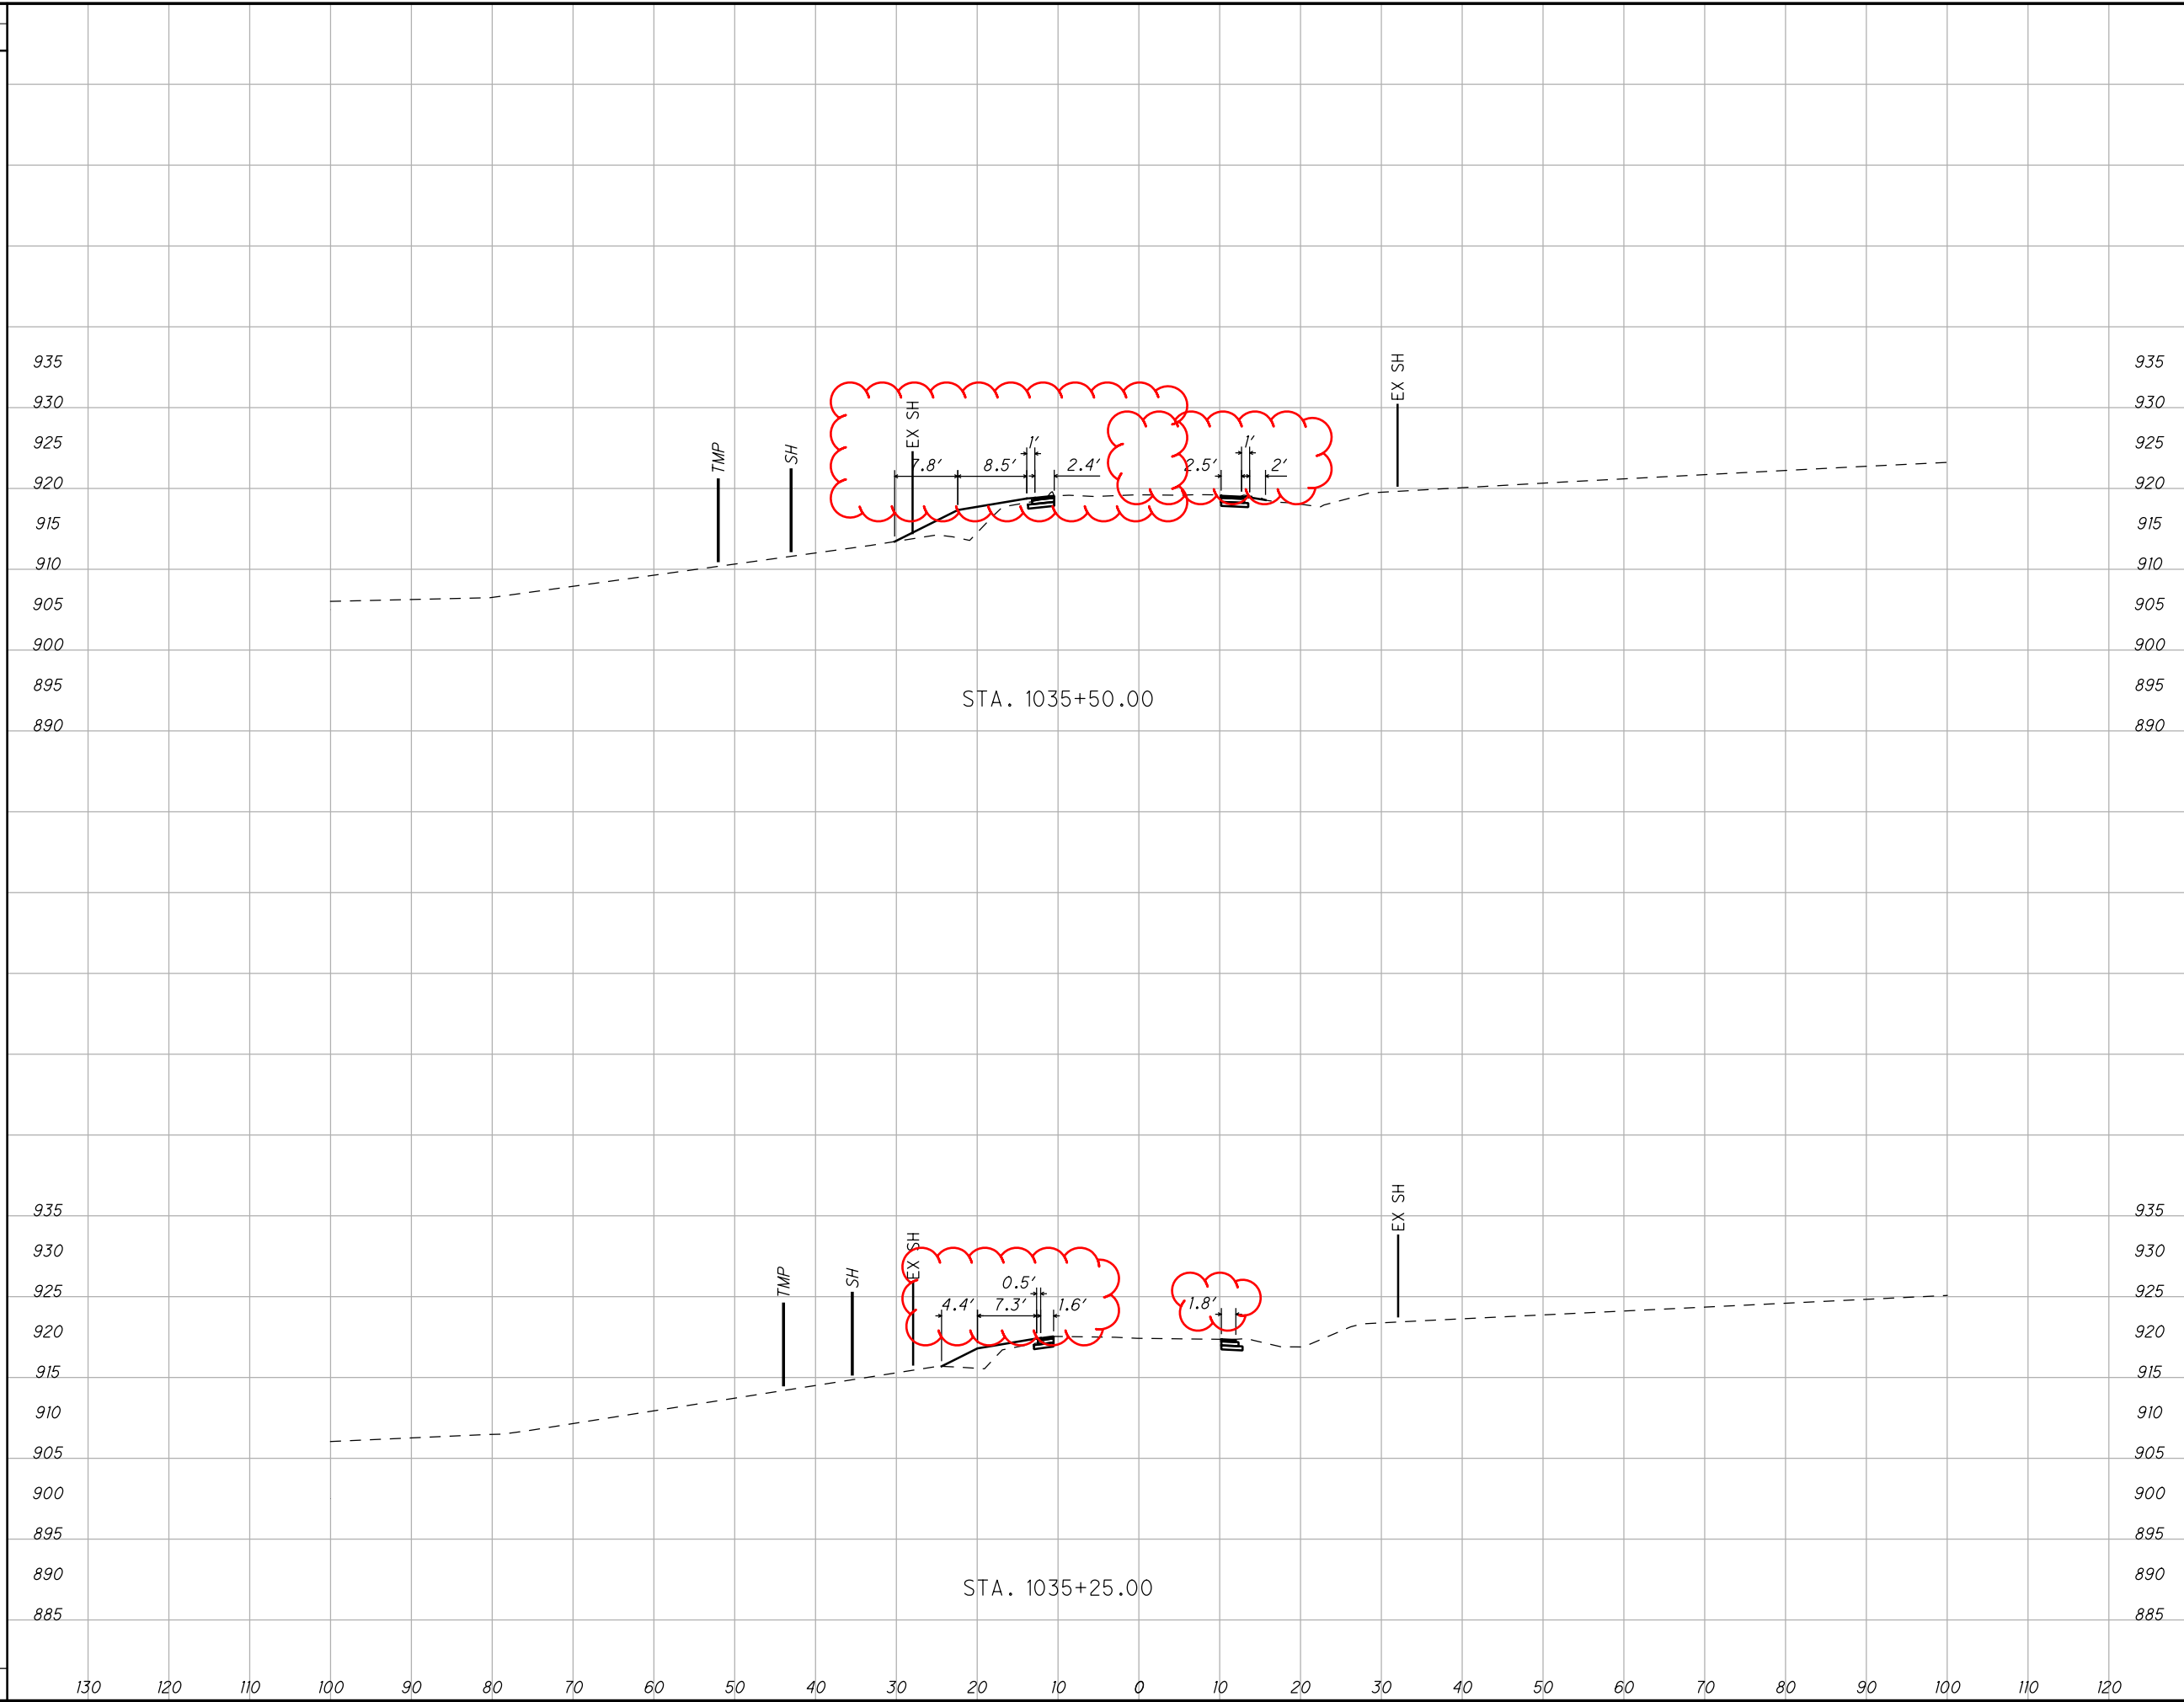

END AREA		VOLUME		CALCULATED	CHECKED
CUT	FILL	CUT	FILL		
		42	26		
		14	7	19	40
		28	19	WIL - 576 - 16.55 CROSS SECTIONS S.R. 576 STA. 1035+25.00 TO STA. 1035+50.00	

SEEDING


END WIDTH	SO. YDS.
130	
120	
110	
10	
20	
30	
40	
50	
60	
70	
80	
90	
100	
110	
120	

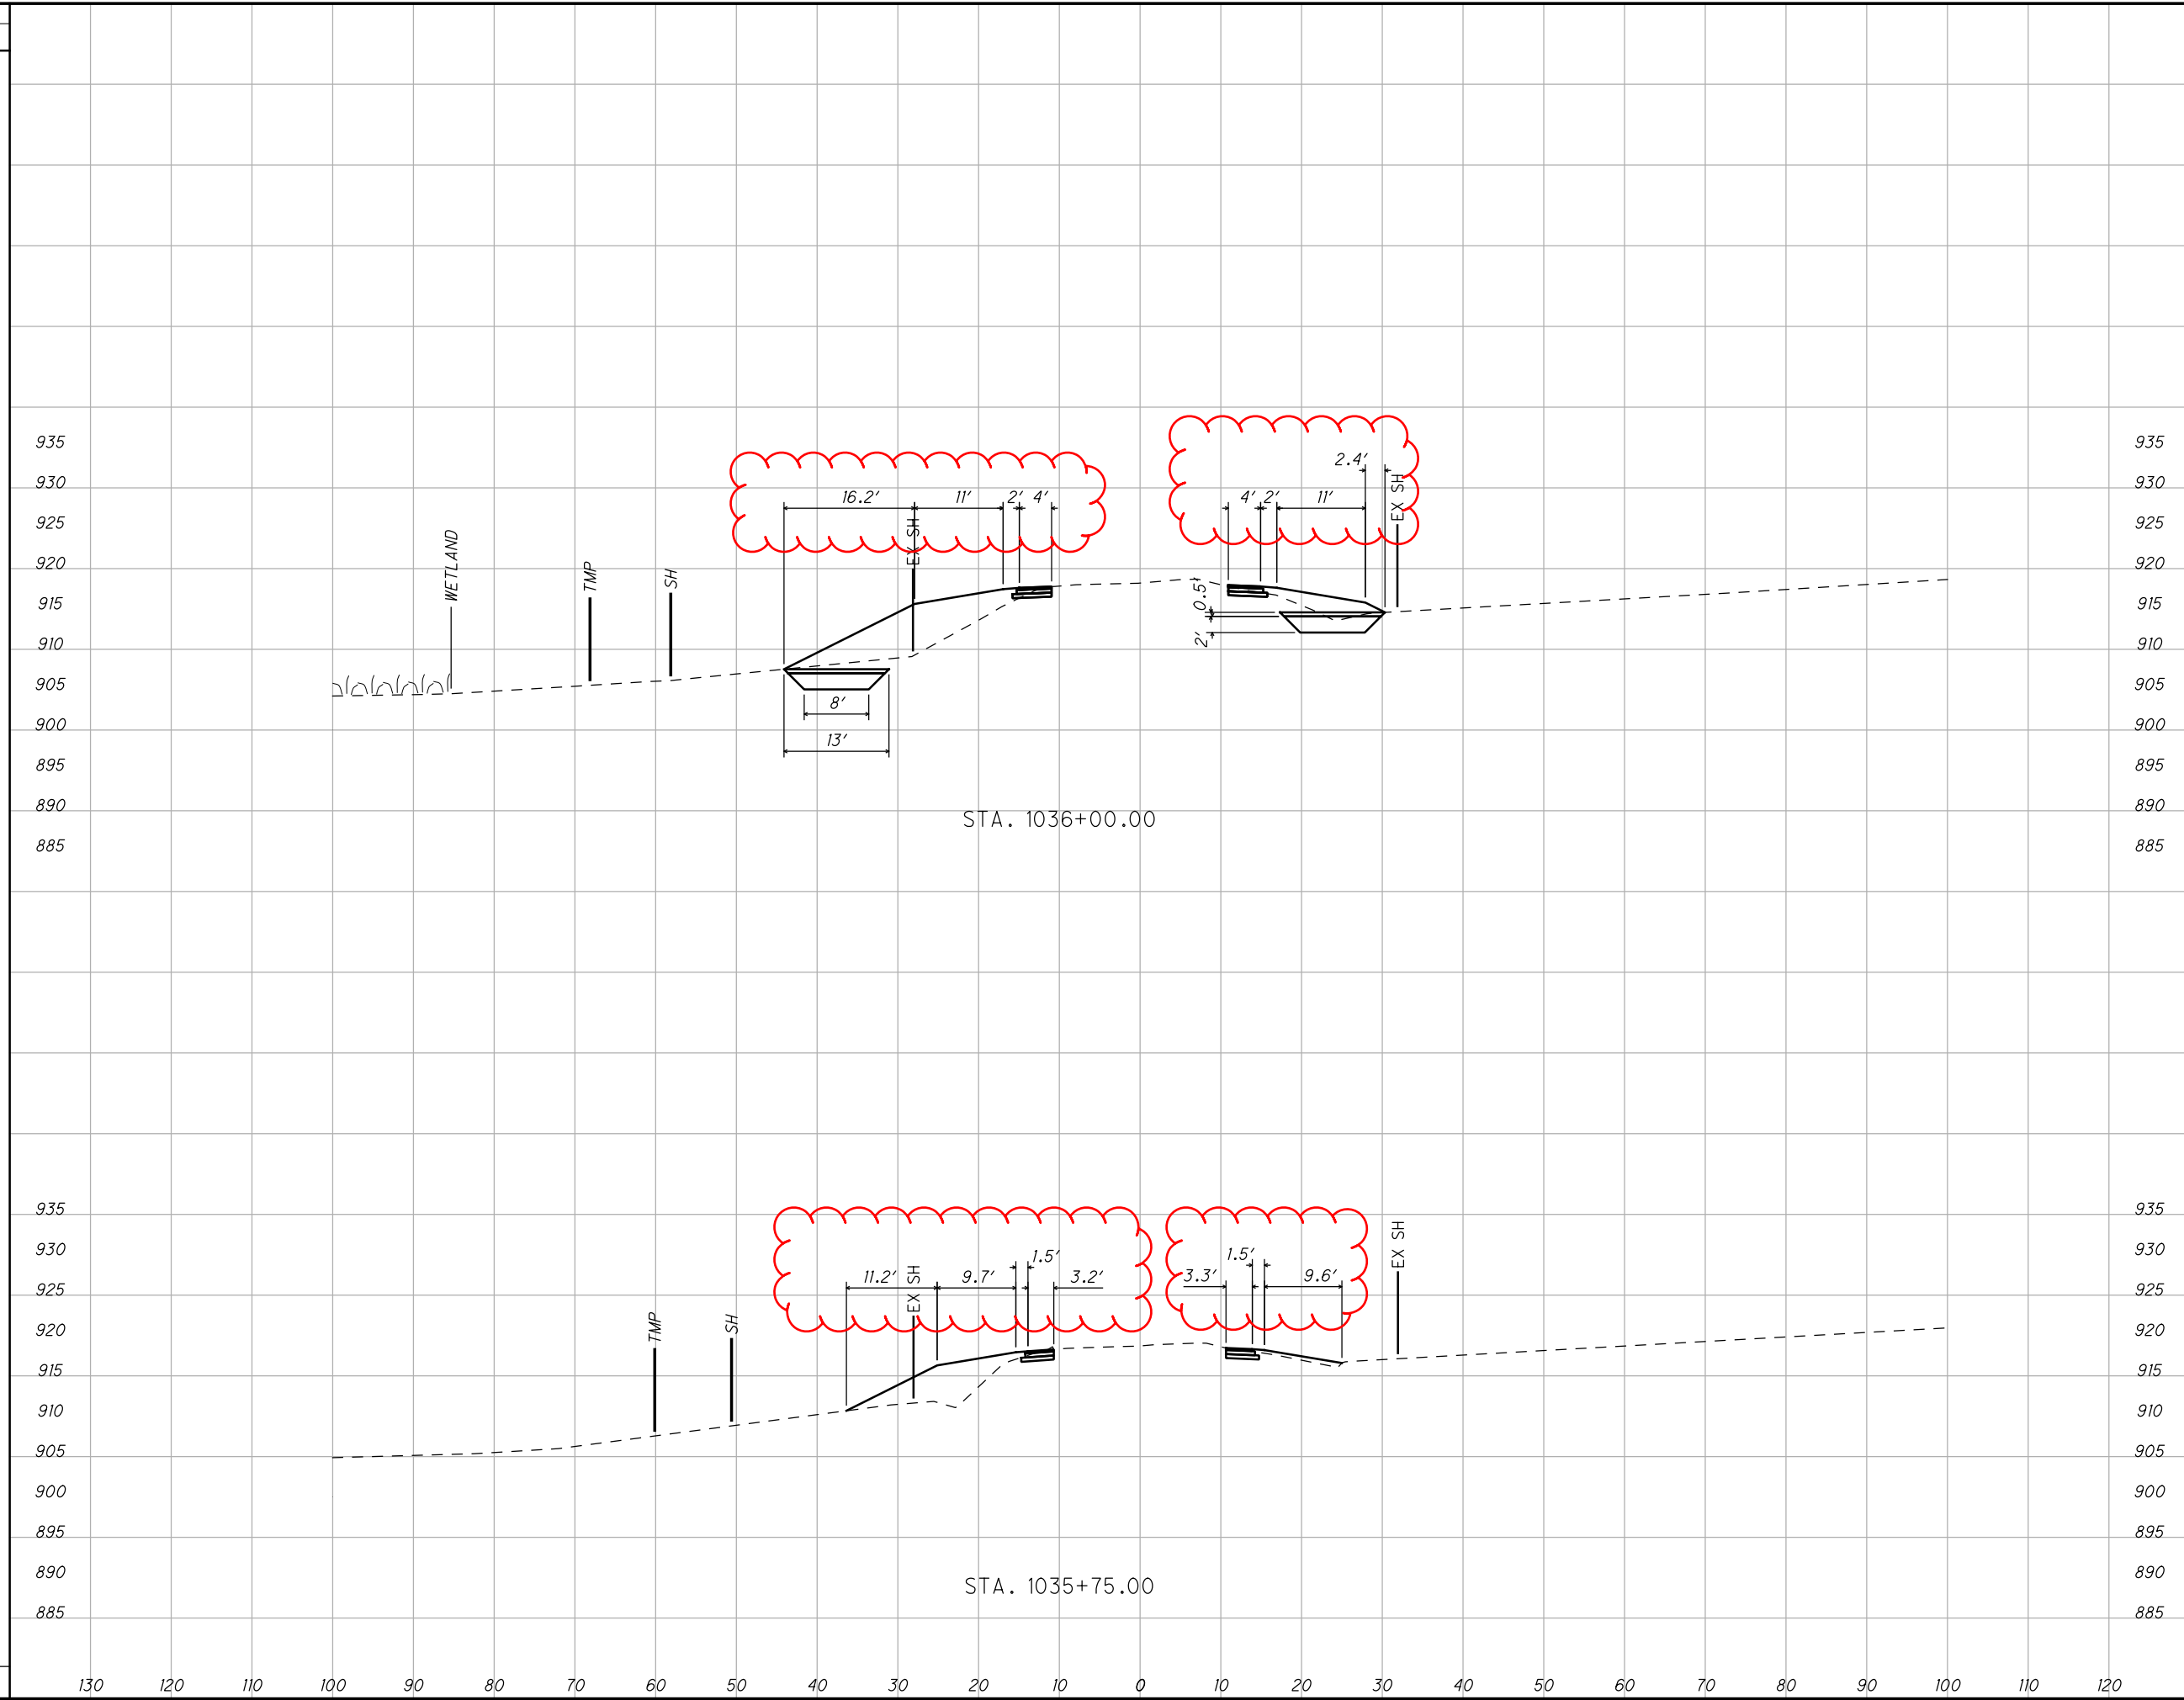

END AREA		VOLUME		CALCULATED MJF	CHECKED DAR		
CUT	FILL	CUT	FILL				
187		130					
	123		87				
	64		43				
CROSS SECTIONS S.R. 576							
STA. 1035+75.00 TO STA. 1036+00.00							
WIL-576-16.55							
<table border="1" style="margin: auto;"> <tr> <td style="width: 20px; height: 20px; text-align: center;">20</td> </tr> <tr> <td style="width: 20px; height: 20px; text-align: center;">40</td> </tr> </table>						20	40
20							
40							

I:\ProjectData\WIL\99575_WIL_576_16.55_Design\Roadway\Sheets\99575_XS007.dgn 01-APR-2021:11:55AM mfarakas

SEEDING	
END WIDTH	SO. YDS.

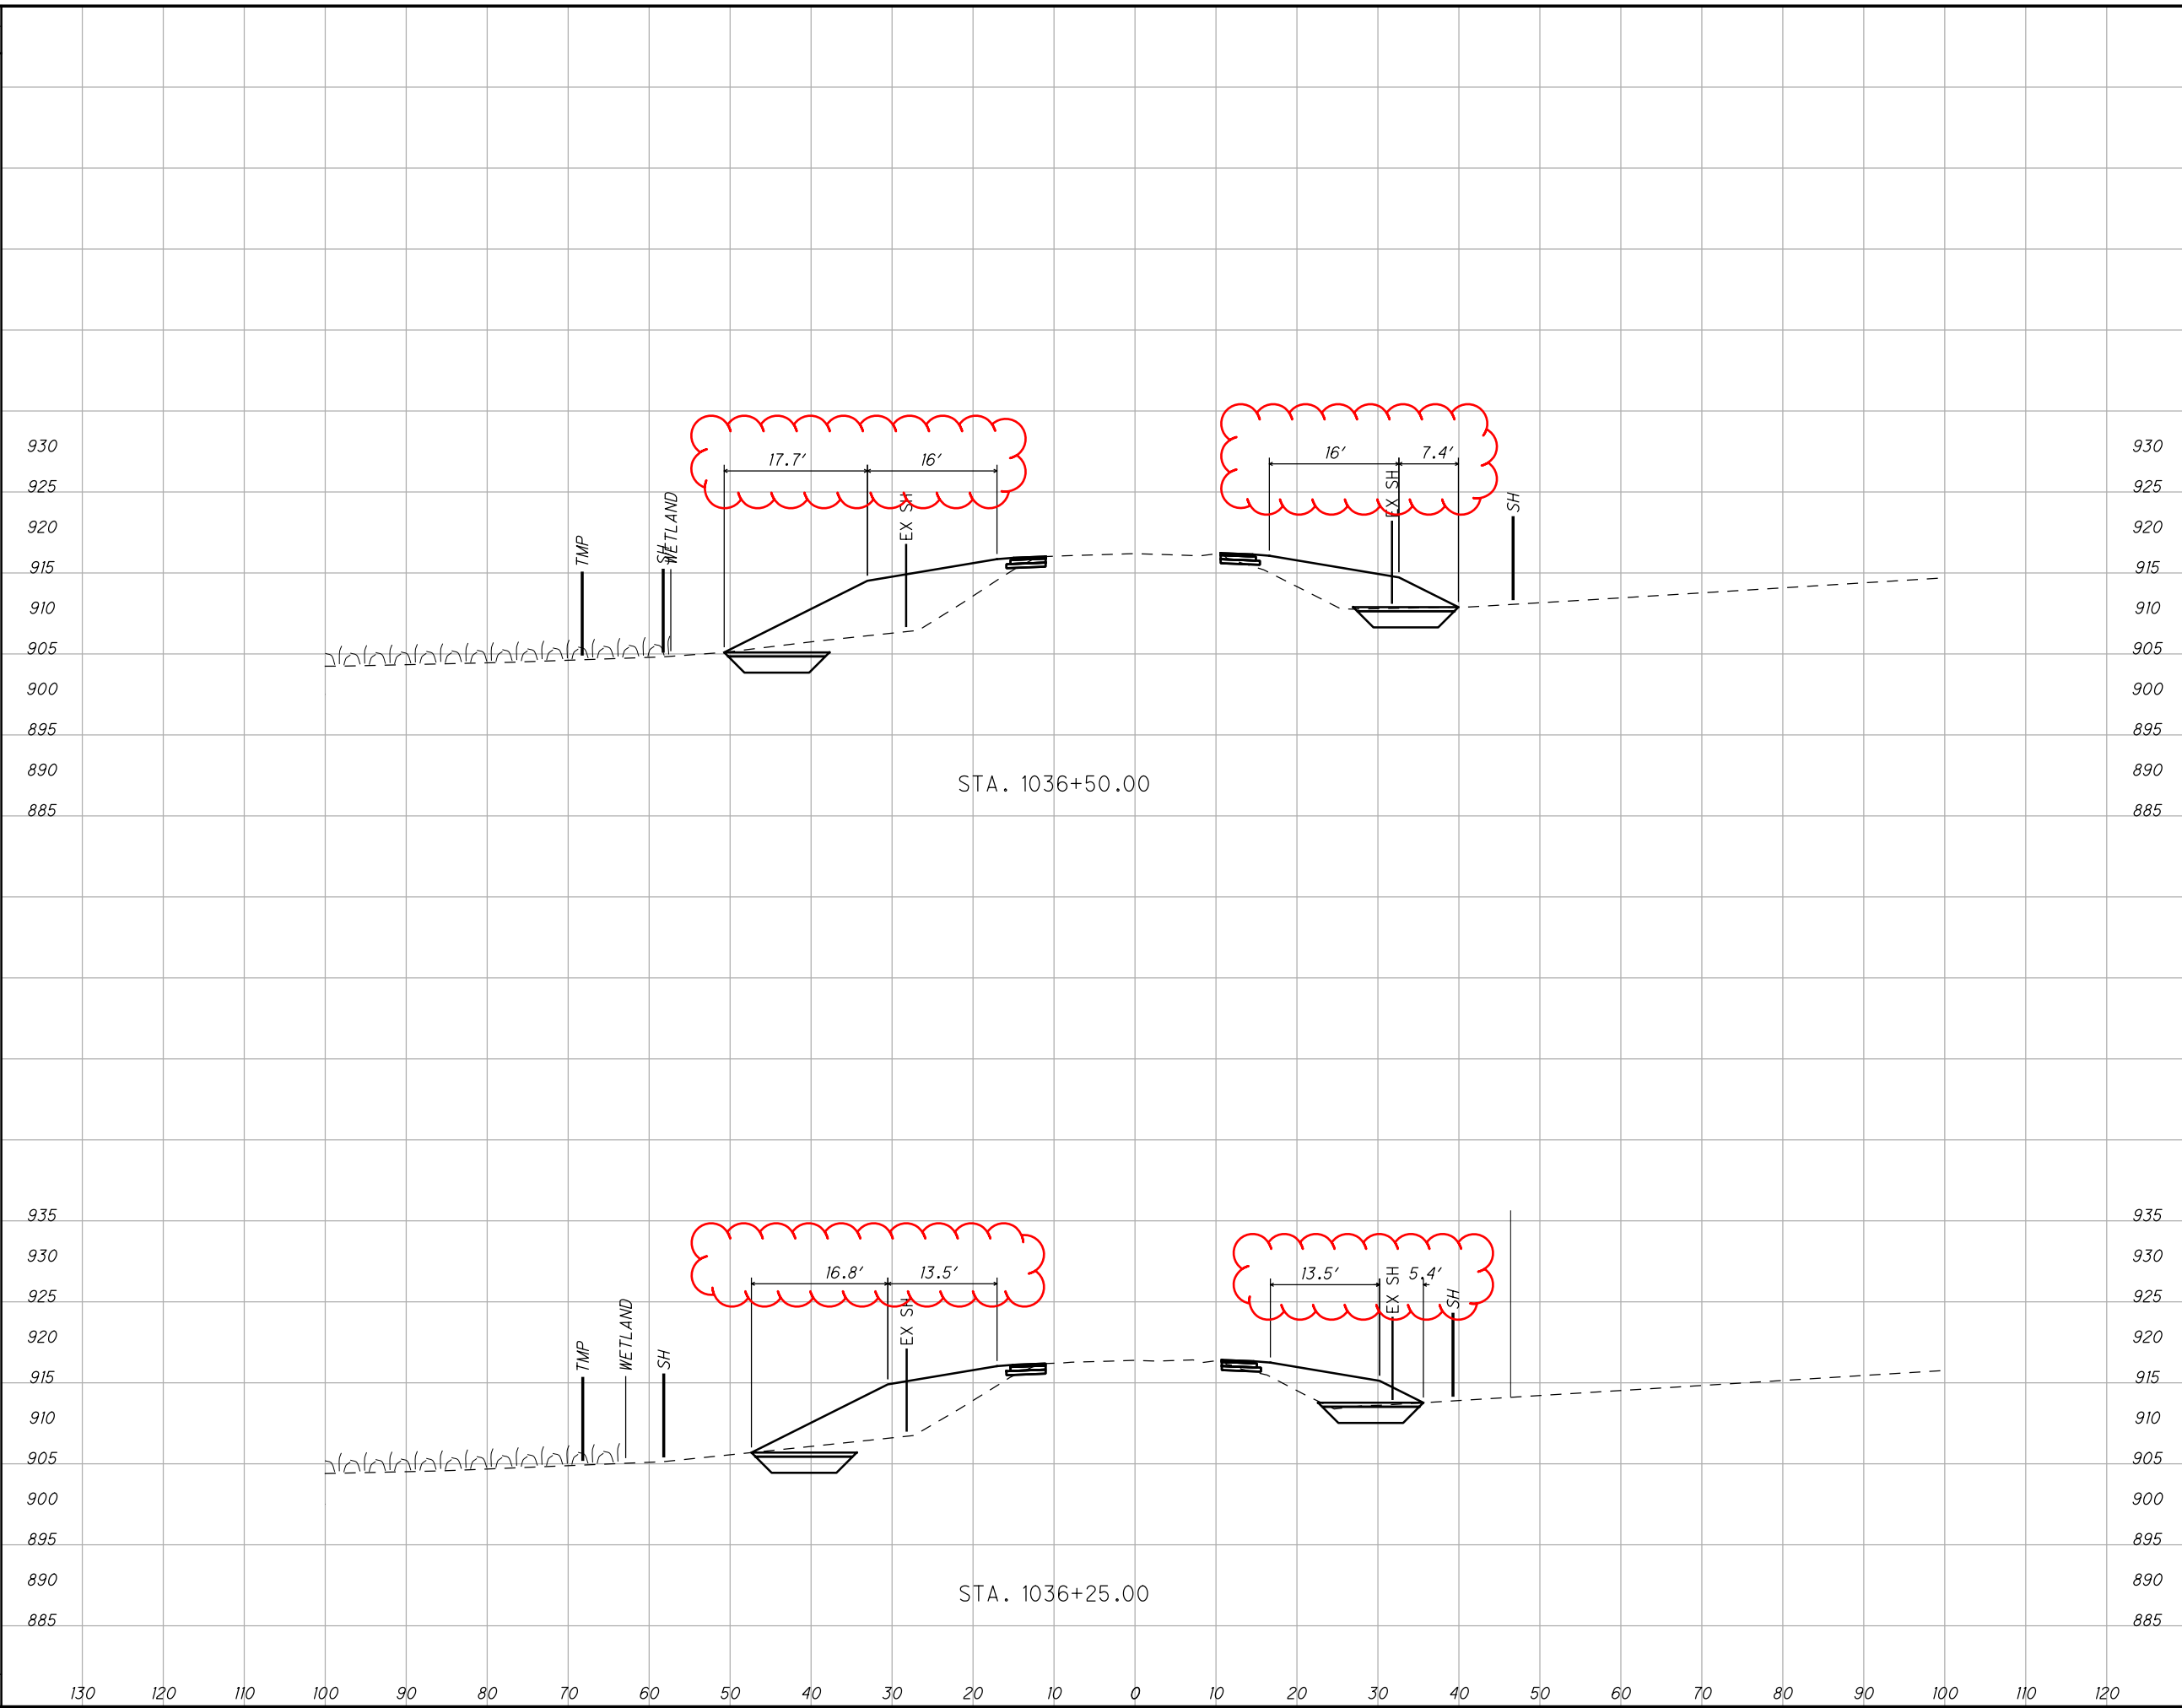

END AREA		VOLUME	
CUT	FILL	CUT	FILL
415	234	333	192

WIL-576-16.55

CROSS SECTIONS S.R. 576

STA. 1036+25.00 TO STA. 1036+50.00


CALCULATED MJF
CHECKED DAR

21 / 40

I:\ProjectData\WIL_99575_WIL_576_16.55_Design\Roadway\Sheets\99575_XS008.dgn 01-APR-2021 11:16AM mforakas

SEEDING

END WIDTH	SO. YDS.

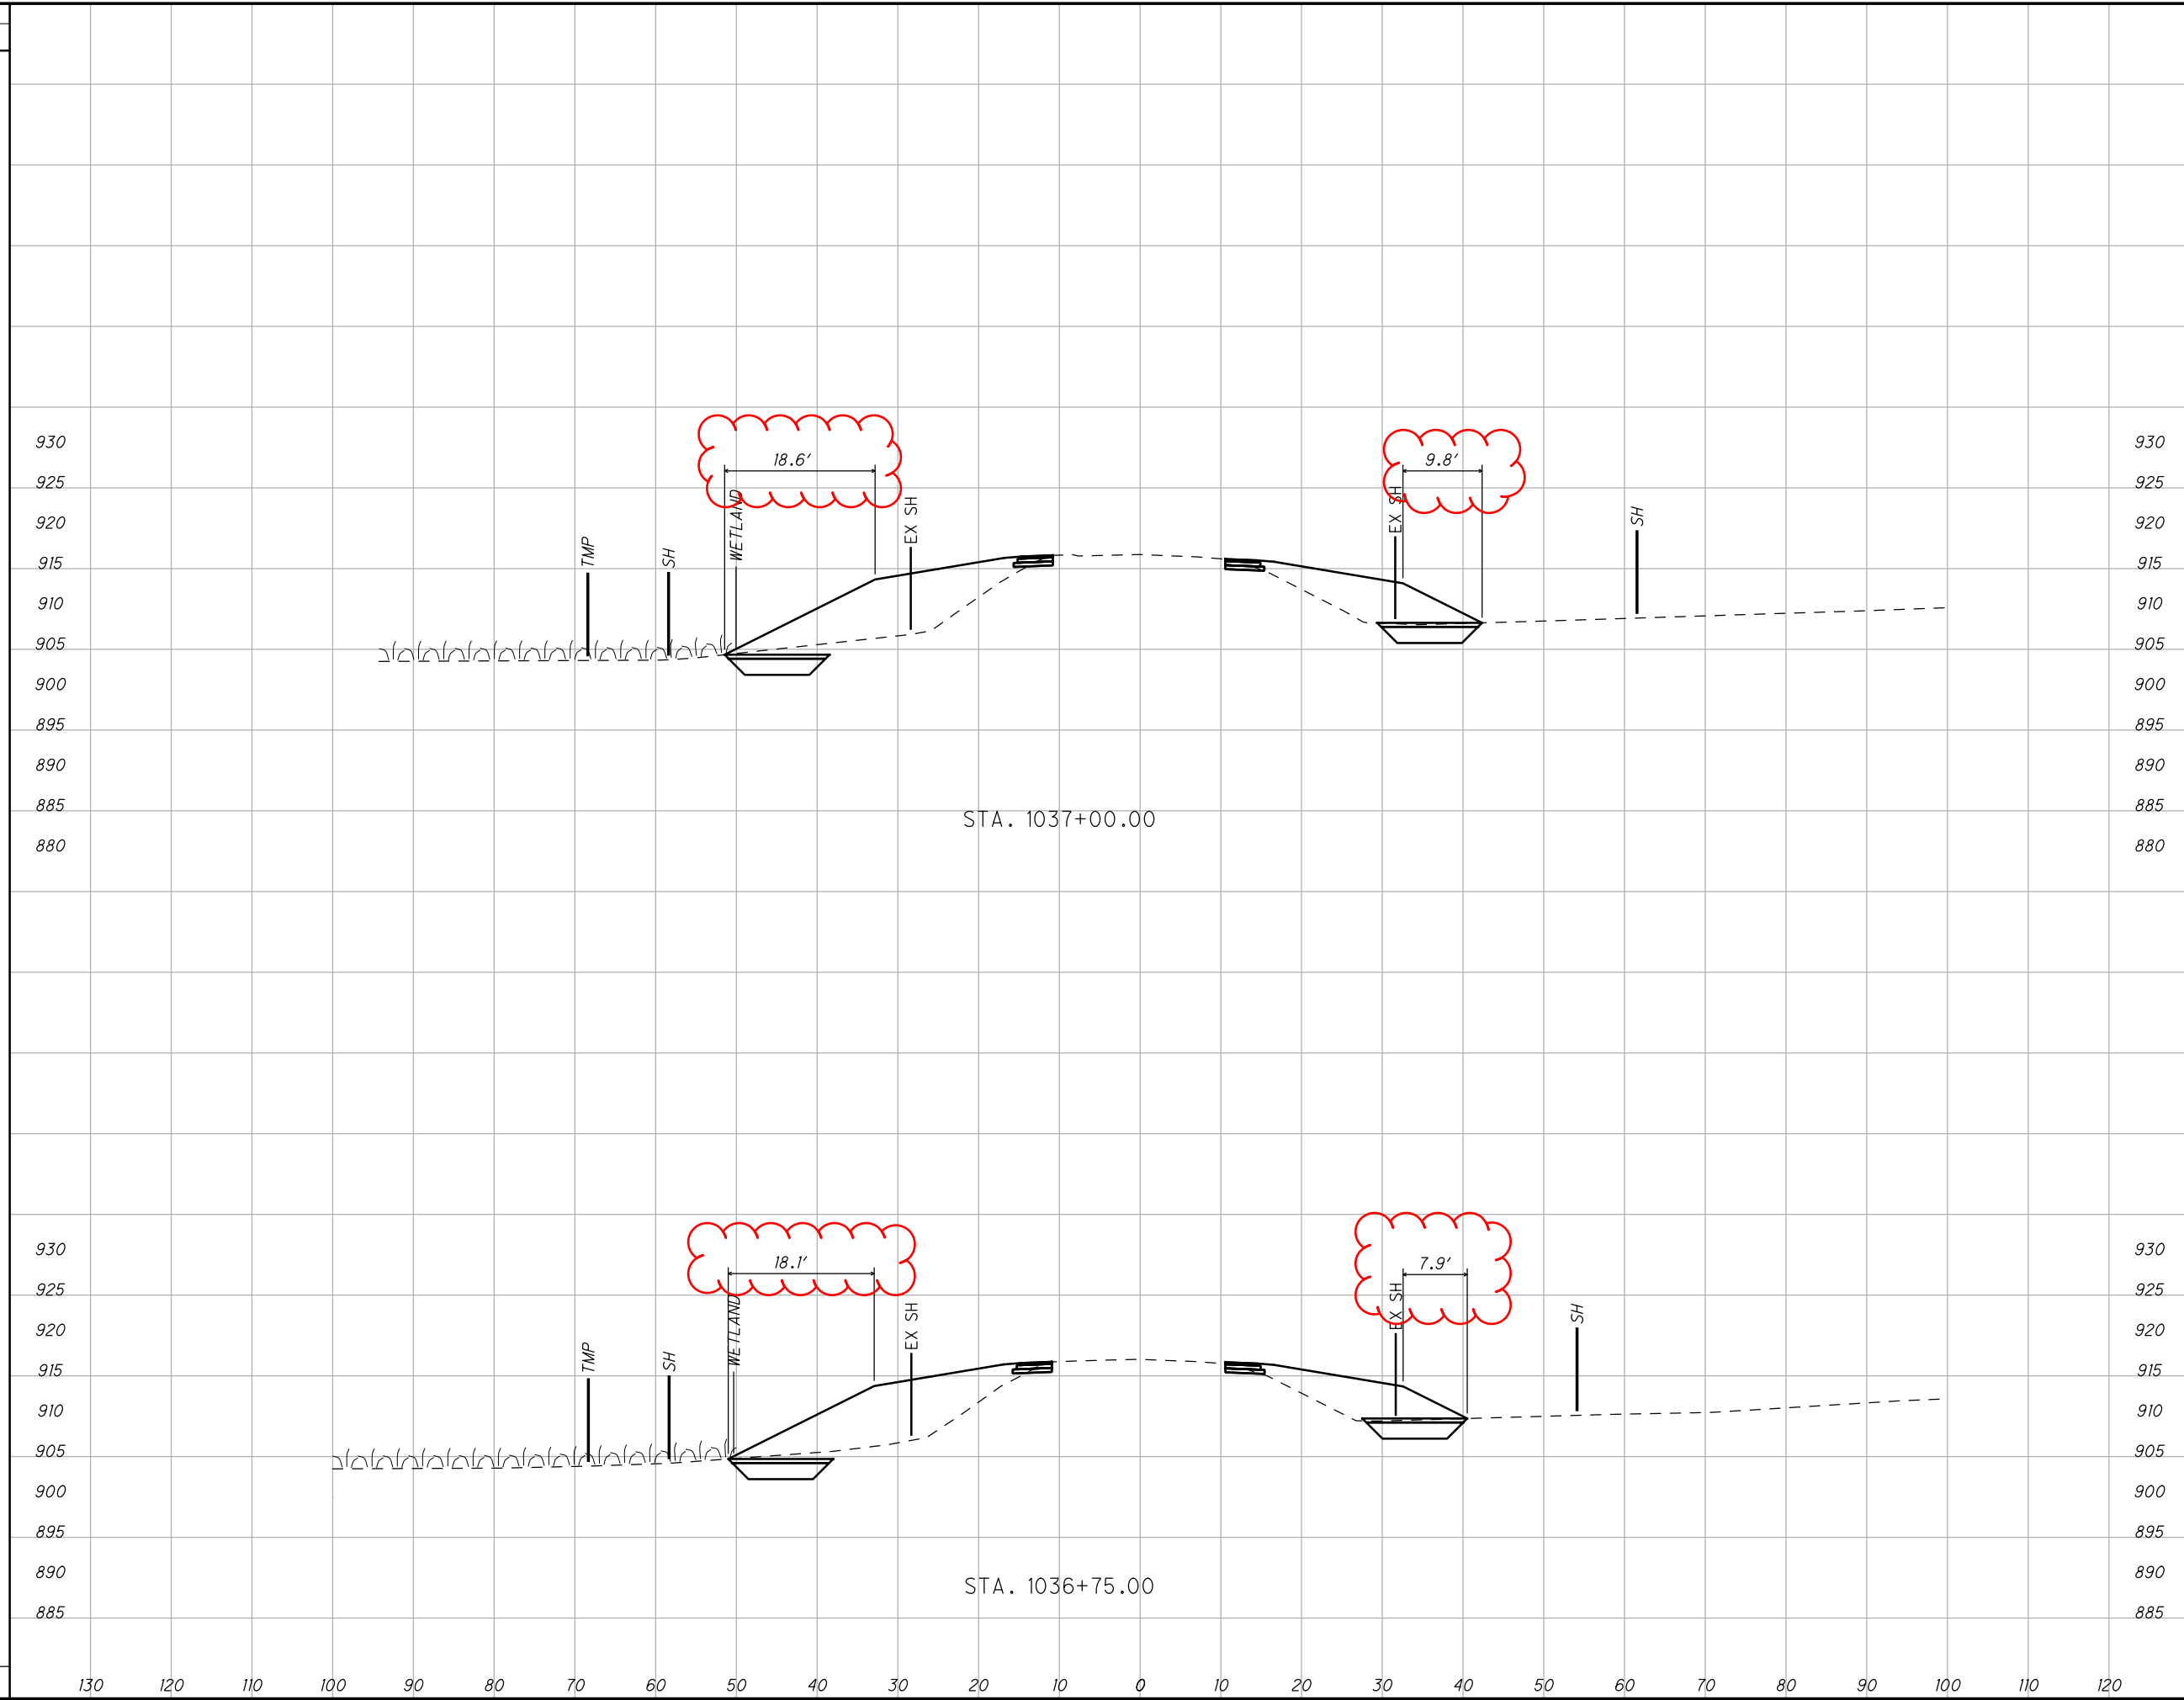

END AREA		VOLUME		CALCULATED	CHECKED		
CUT	FILL	CUT	FILL				
512		461					
	262		237				
	250		224				
WIL - 576 - 16.55 CROSS SECTIONS S.R. 576 STA. 1036+75.00 TO STA. 1037+00.00							
<table border="1" style="margin: auto;"> <tr> <td style="width: 20px; height: 20px; border: 1px solid black; border-radius: 50%; text-align: center;">22</td> </tr> <tr> <td style="width: 20px; height: 20px; border: 1px solid black; border-radius: 50%; text-align: center;">40</td> </tr> </table>						22	40
22							
40							

I:\ProjectData\WIL\99575_WIL_576_16.55_Design\Roadway\Sheets\99575_XS009.dgn 01-APR-2021 11:16AM mforkas

SEEDING



END SO.
WIDTH YDS.

END AREA
CUT FILL

VOLUME
CUT FILL

CALCULATED
MJF

CHECKED
DAR

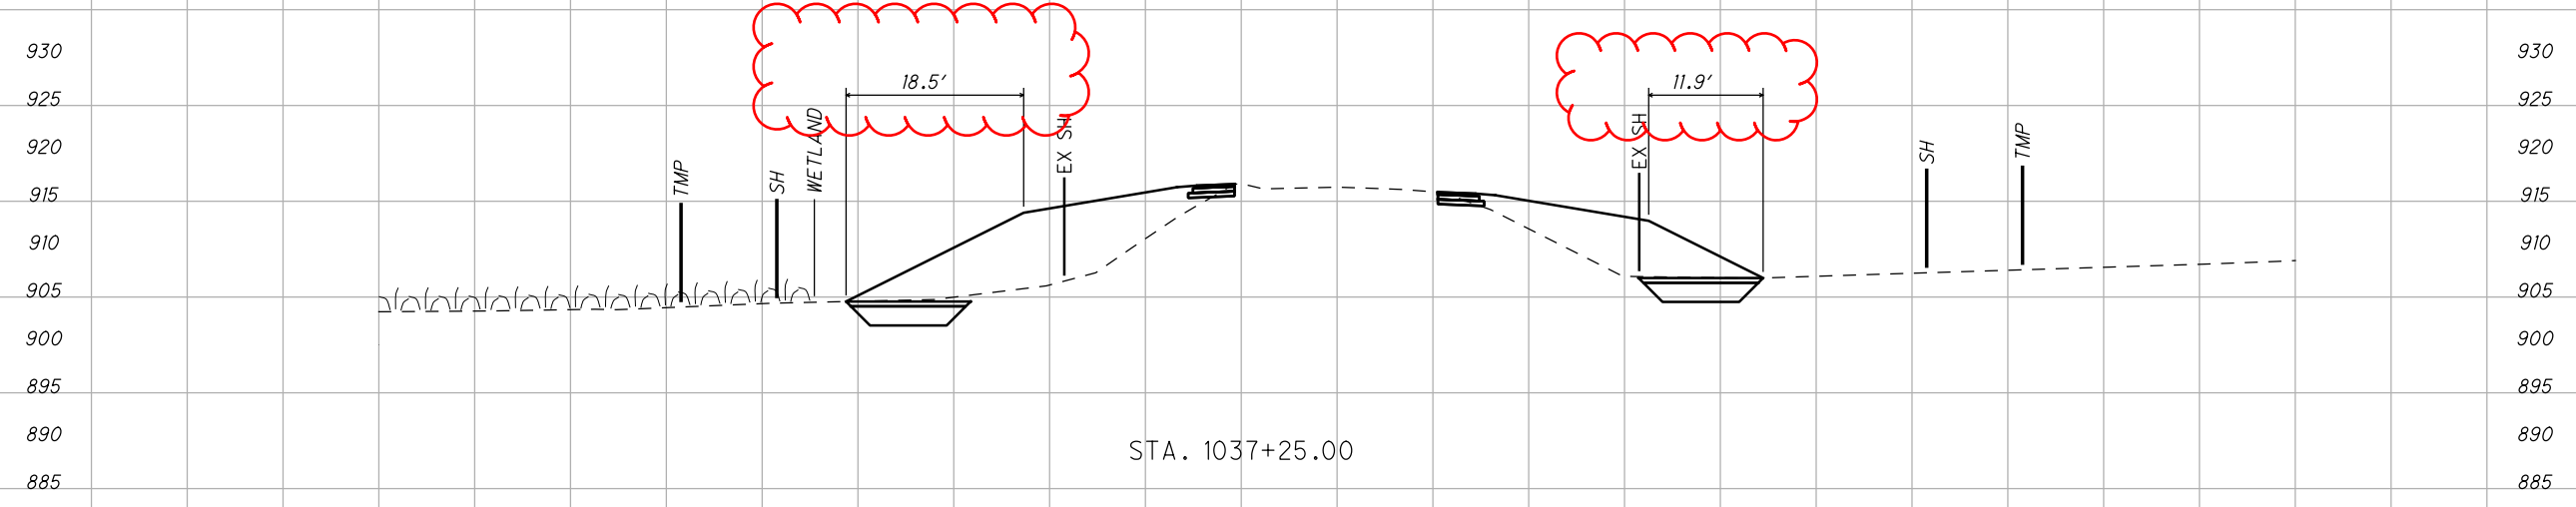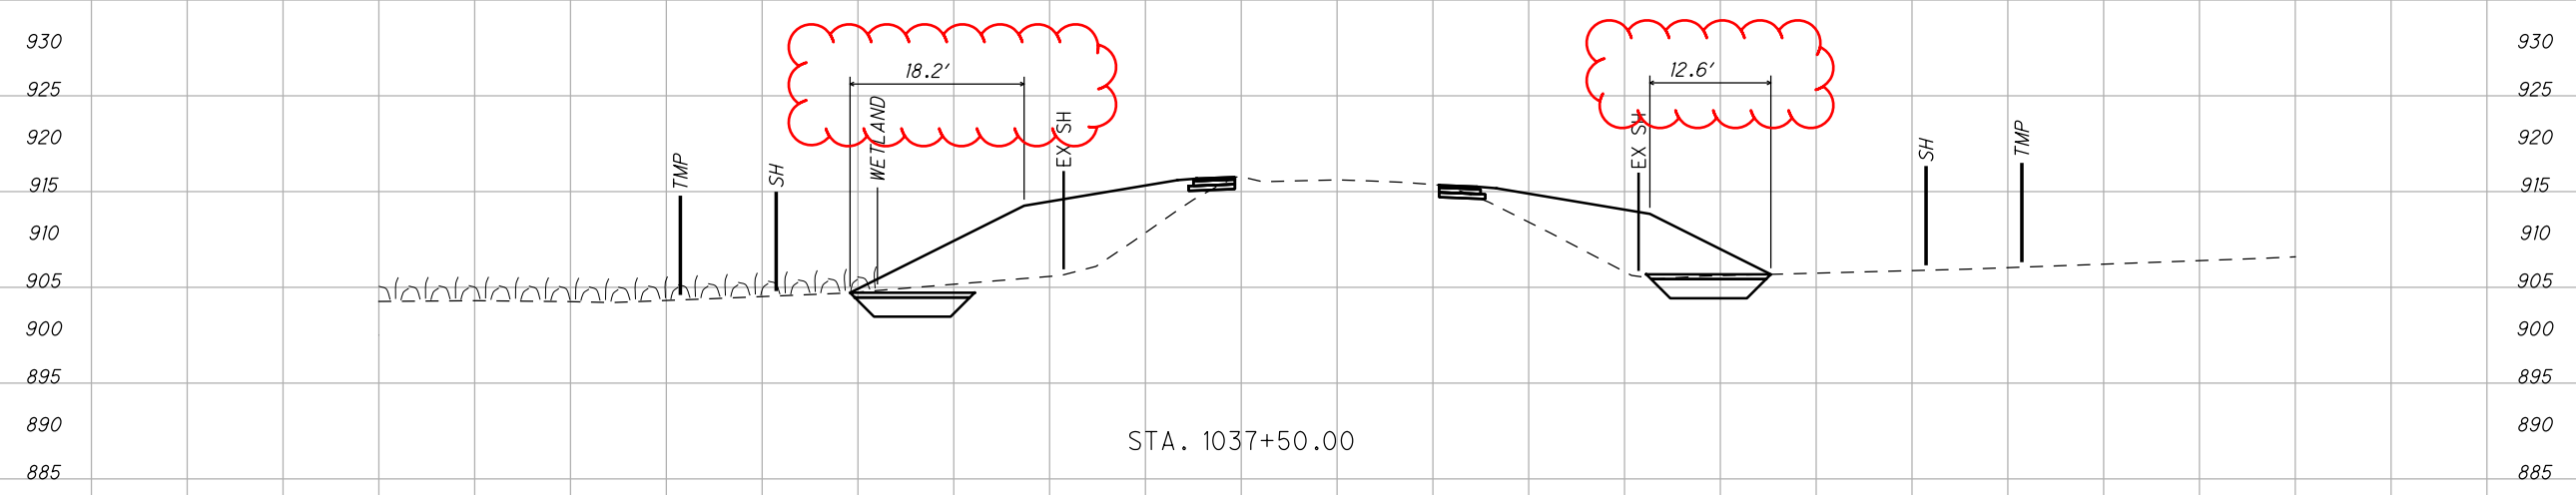

293

294

272

257

587

529

CROSS SECTIONS S.R. 576
STA. 1037+25.00 TO STA. 1037+50.00

WIL-576-16.55


23
40

I:\ProjectData\WIL\99575_WIL_576_16.55_Design\Roadway\Sheets\99575_XS010.dgn 01-APR-2021 11:17AM mfarakas

SEEDING

END WIDTH	SO. YDS.
-----------	----------

END AREA		VOLUME		CALCULATED	CHECKED
CUT	FILL	CUT	FILL	MJF	DAR

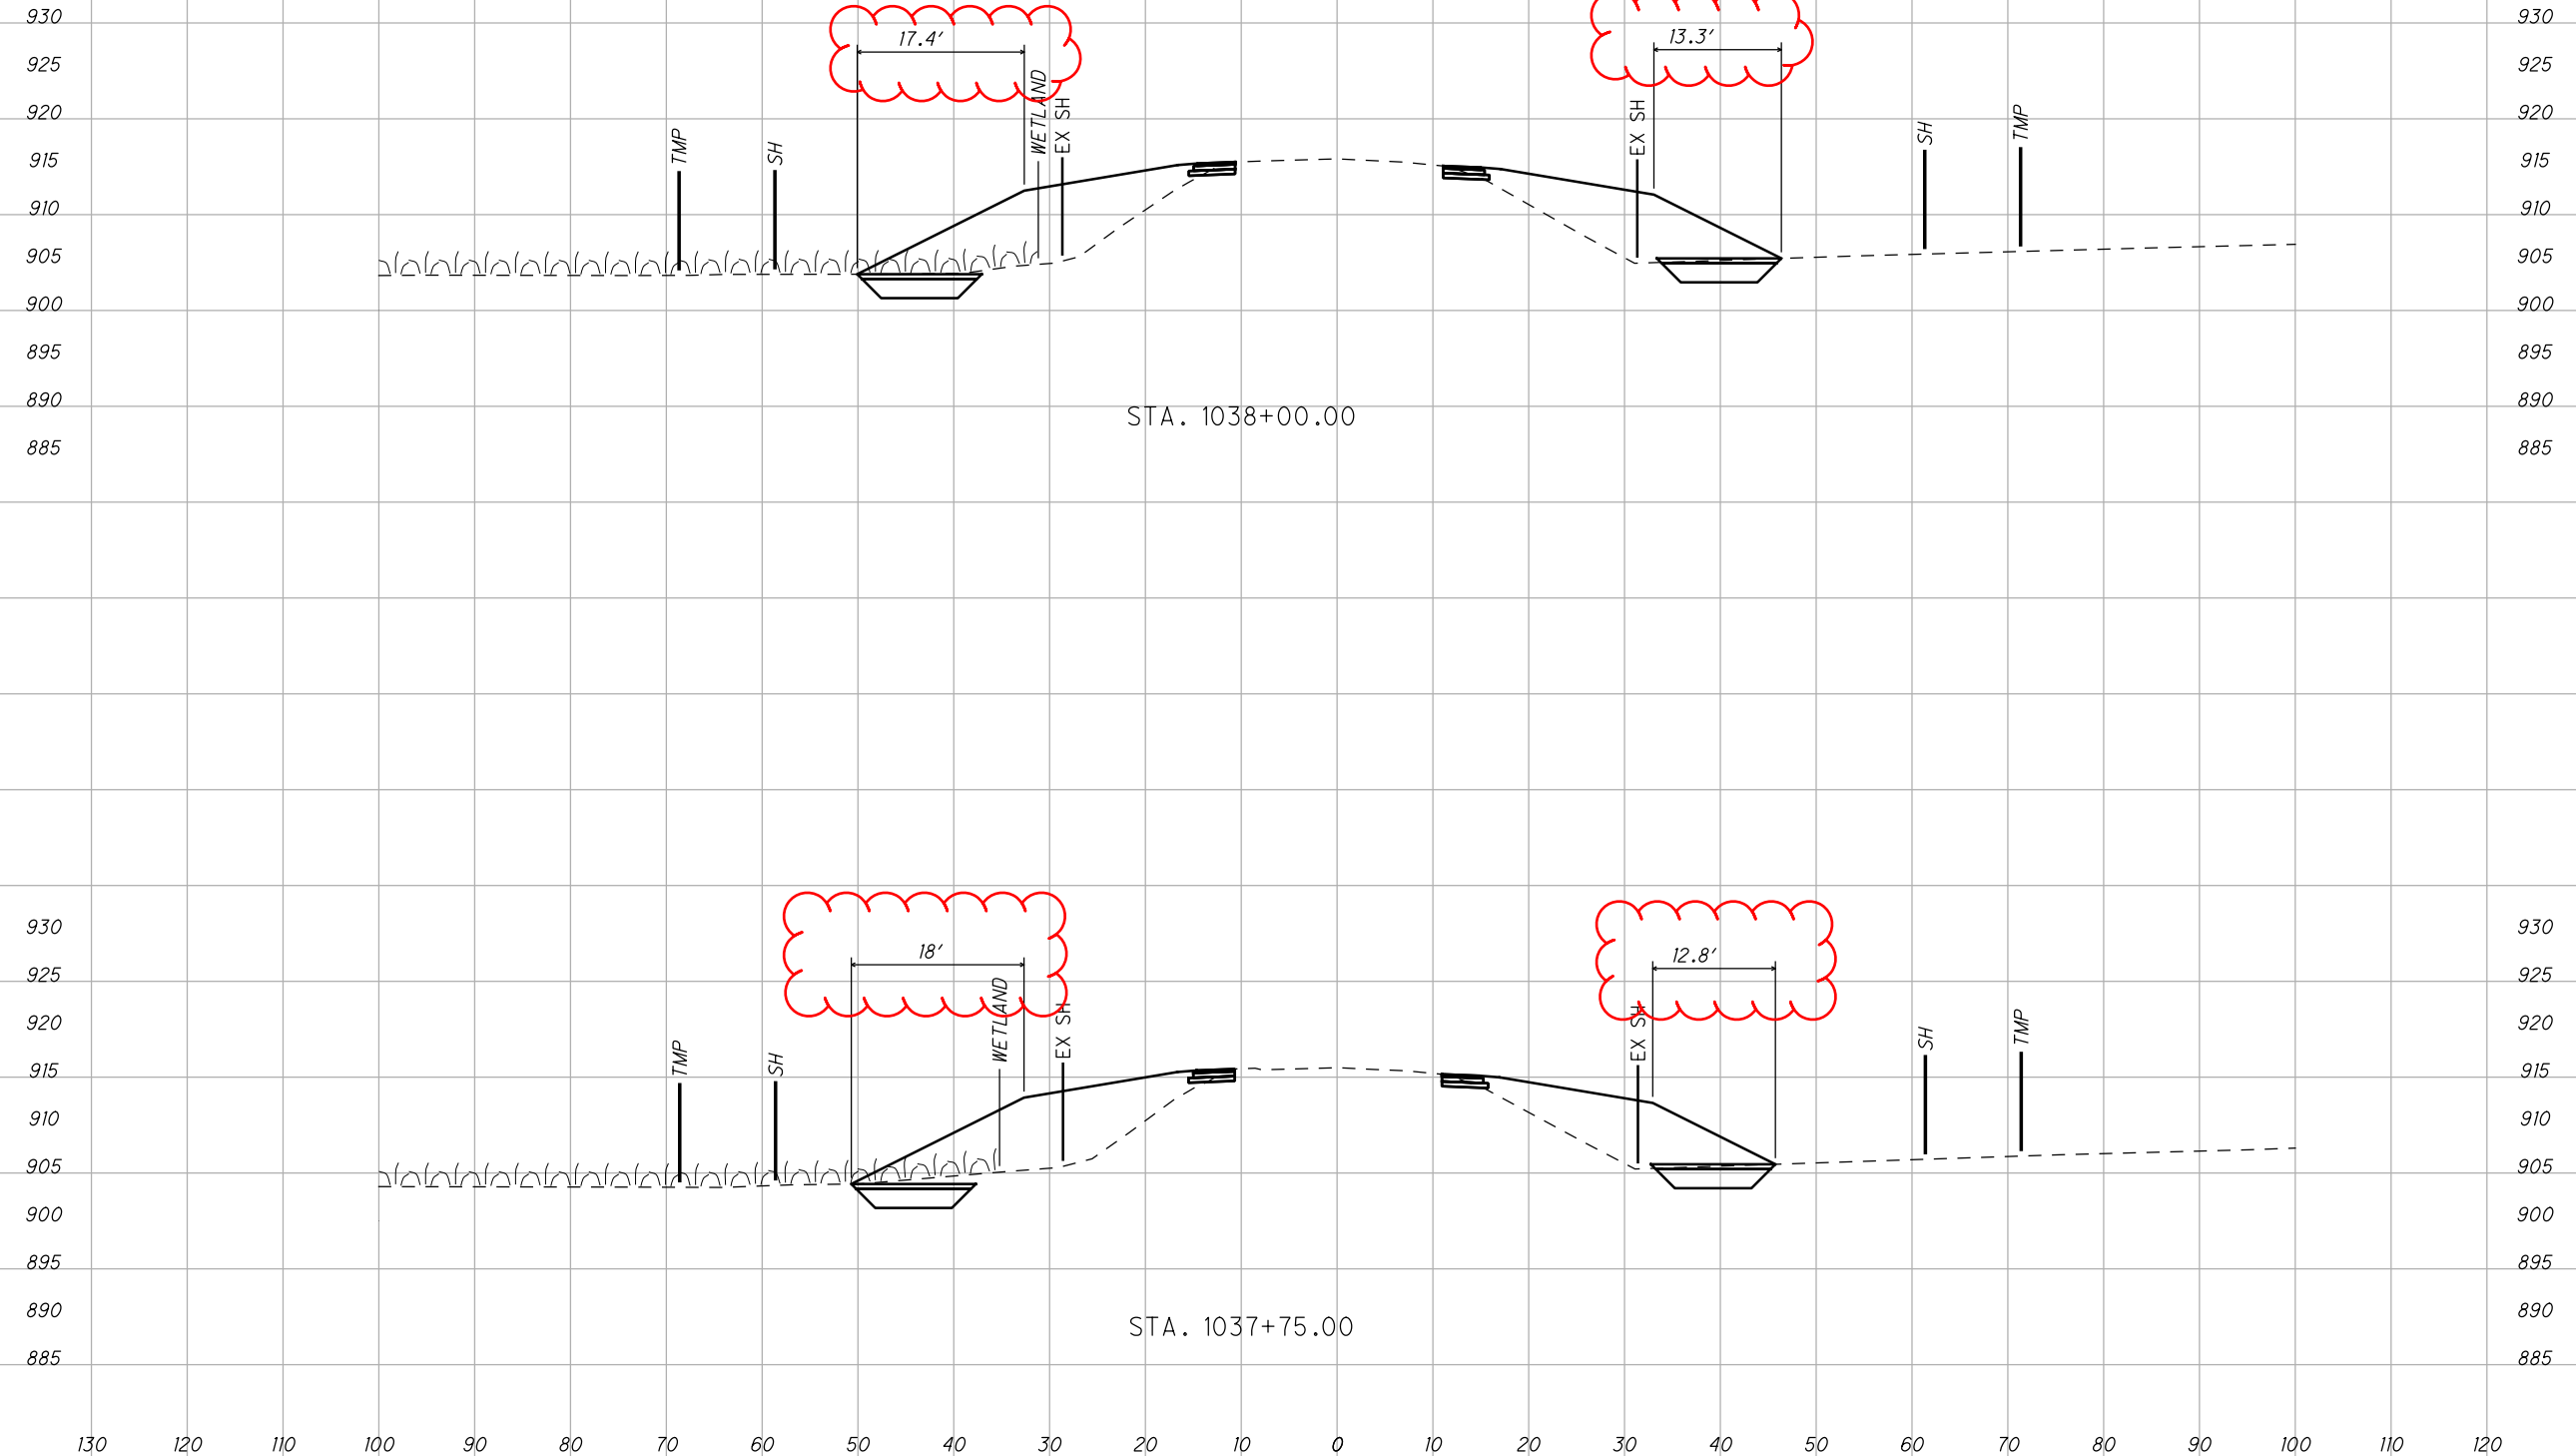

302

296

277

273

CROSS SECTIONS S.R. 576
STA. 1037+75.00 TO STA. 1038+00.00

WIL-576-16.55


24
40

598	550
-----	-----

I:\ProjectData\WIL\99575_WIL_576_16.55_Design\Roadway\Sheets\99575_XS01.dgn 01-APR-2021 11:17AM mforkas

SEEDING

END WIDTH	SO. YDS.
130	
120	
110	
10	
20	
30	
40	
50	
60	
70	
80	
90	
100	
110	
120	

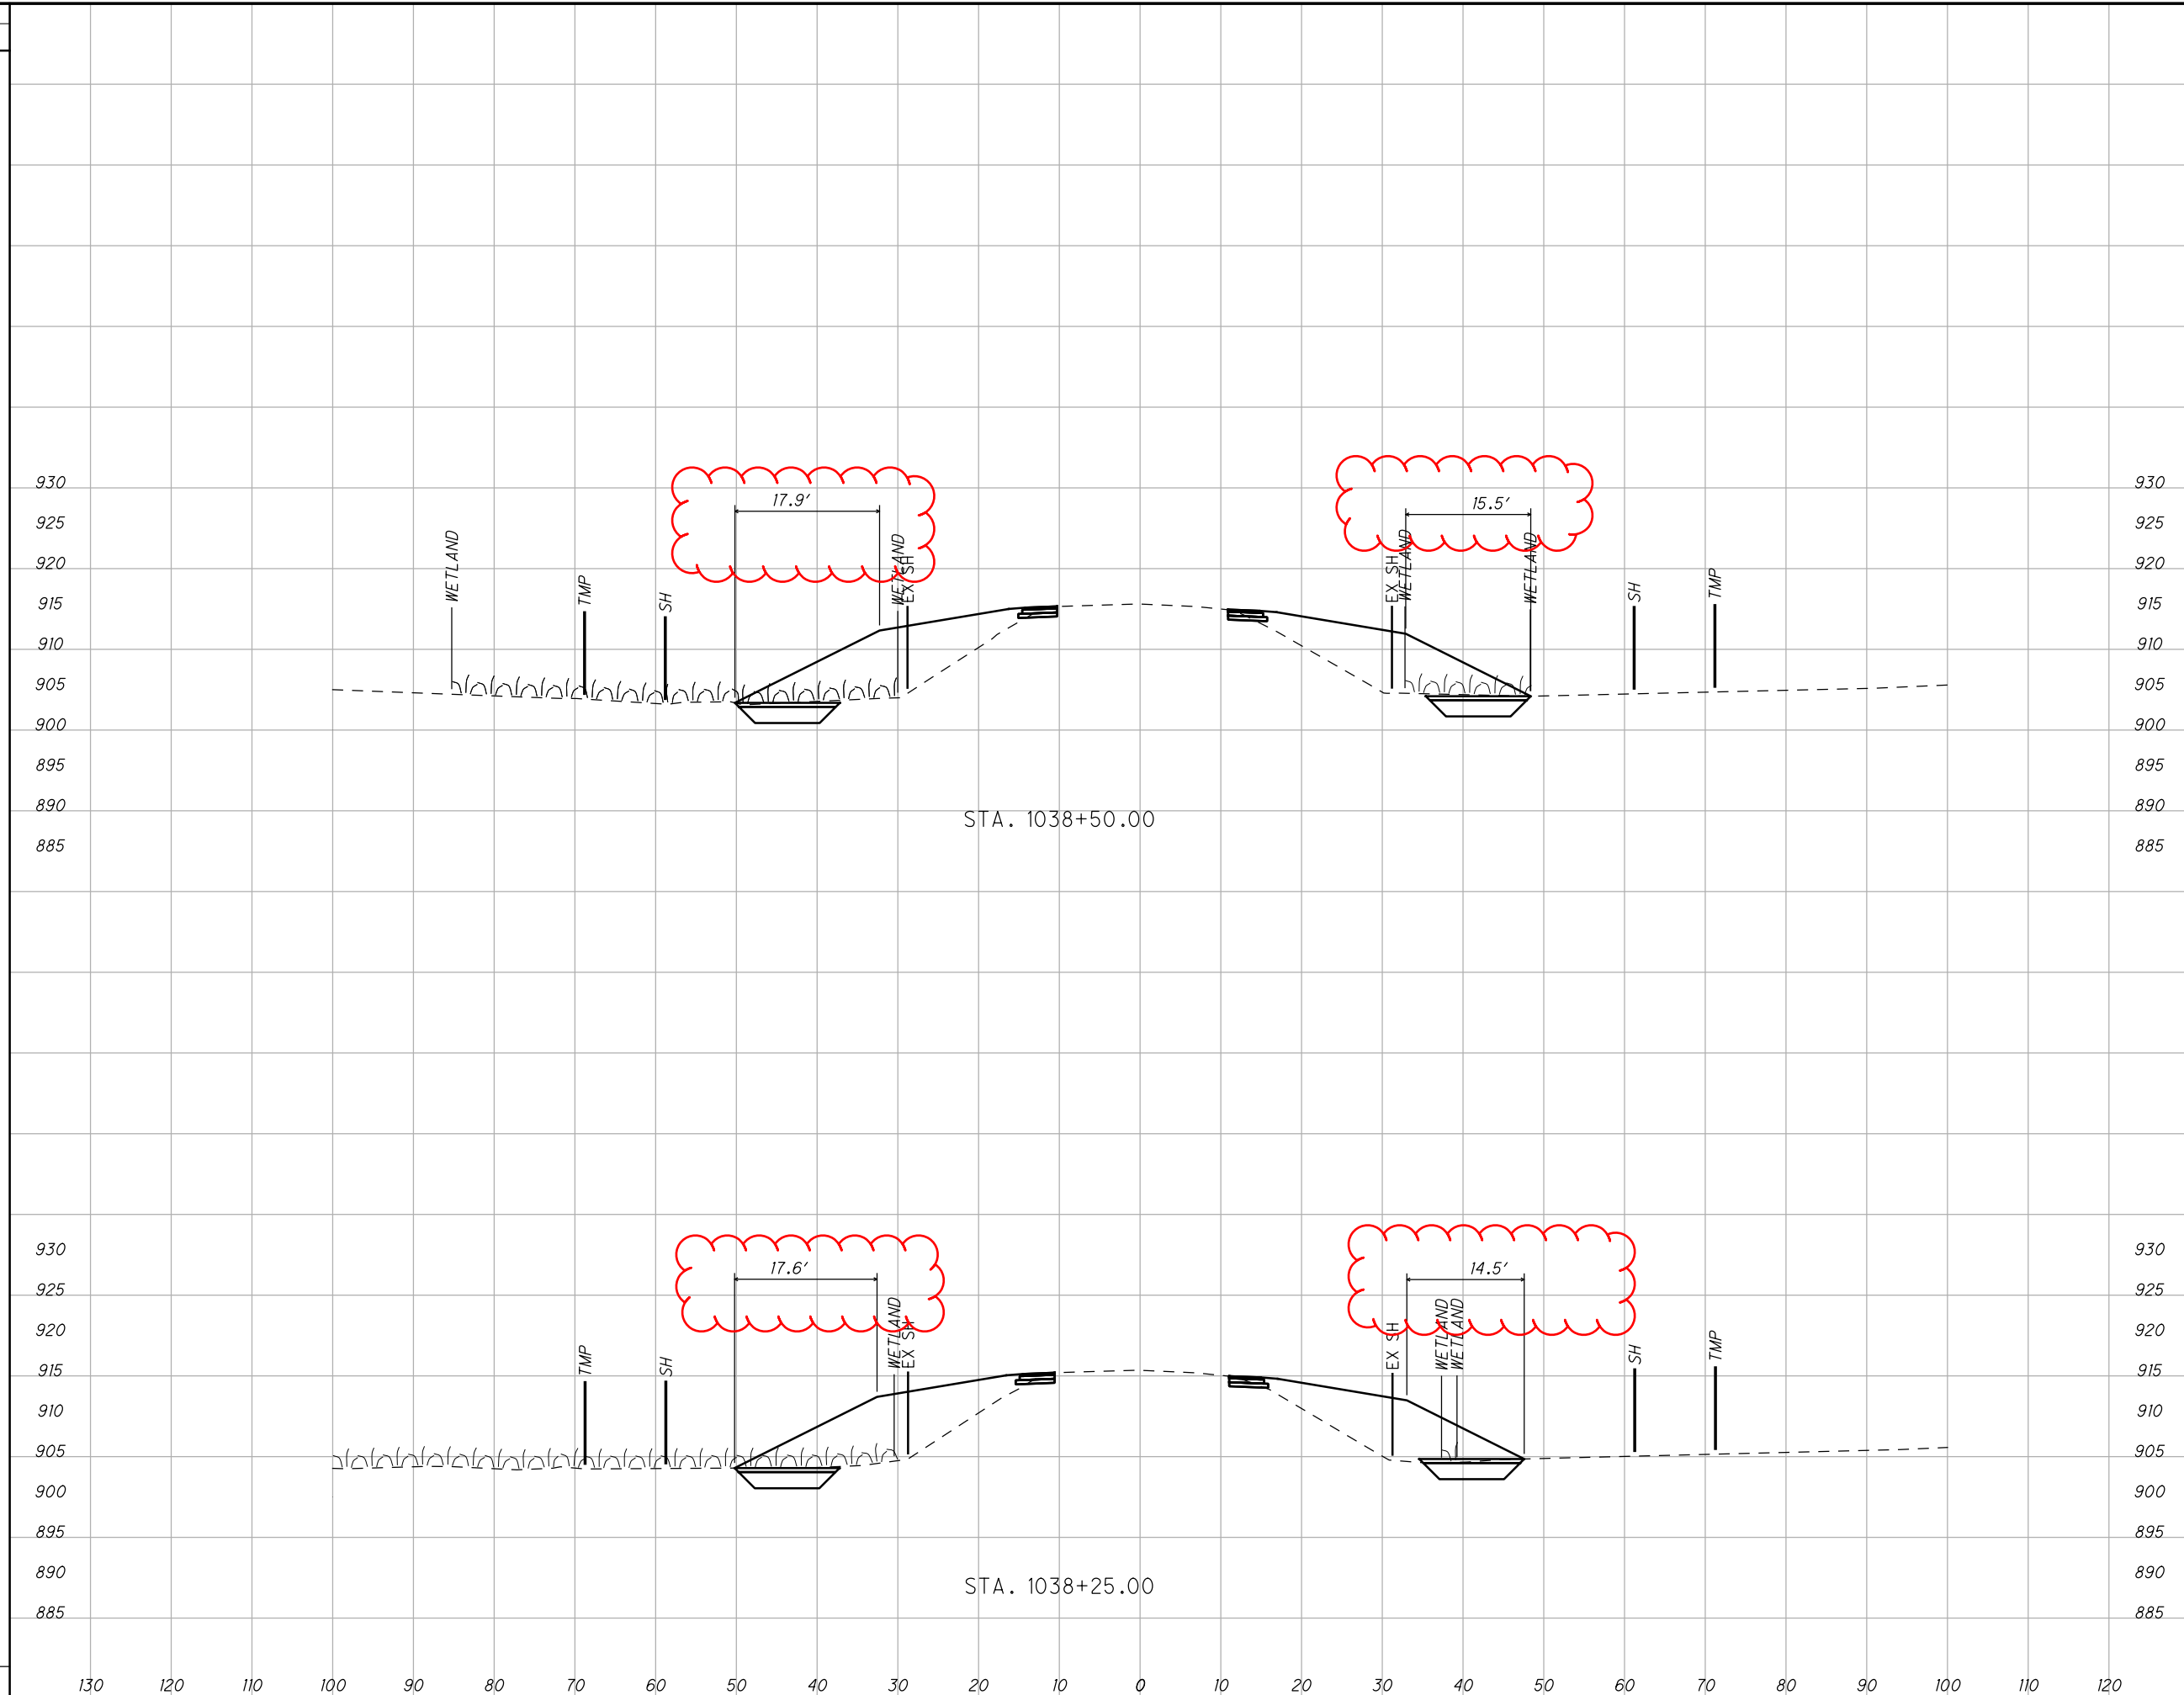

END AREA	VOLUME	CALCULATED	CHECKED	DAR
323				
316				
639	296			
582	286			

CROSS SECTIONS S.R. 576
STA. 1038+25.00 TO STA. 1038+50.00



WIL-576-16.55

25
40

I:\ProjectData\WIL\99575_WIL_576_16.55_Design\Roadway\Sheets\99575_XS02.dgn 01-APR-2021 11:18AM mfar-kas

SEEDING
END SO.
WIDTH YDS.

END AREA VOLUME
CUT FILL CUT FILL
CALCULATED
MJJF
CHECKED
DAR

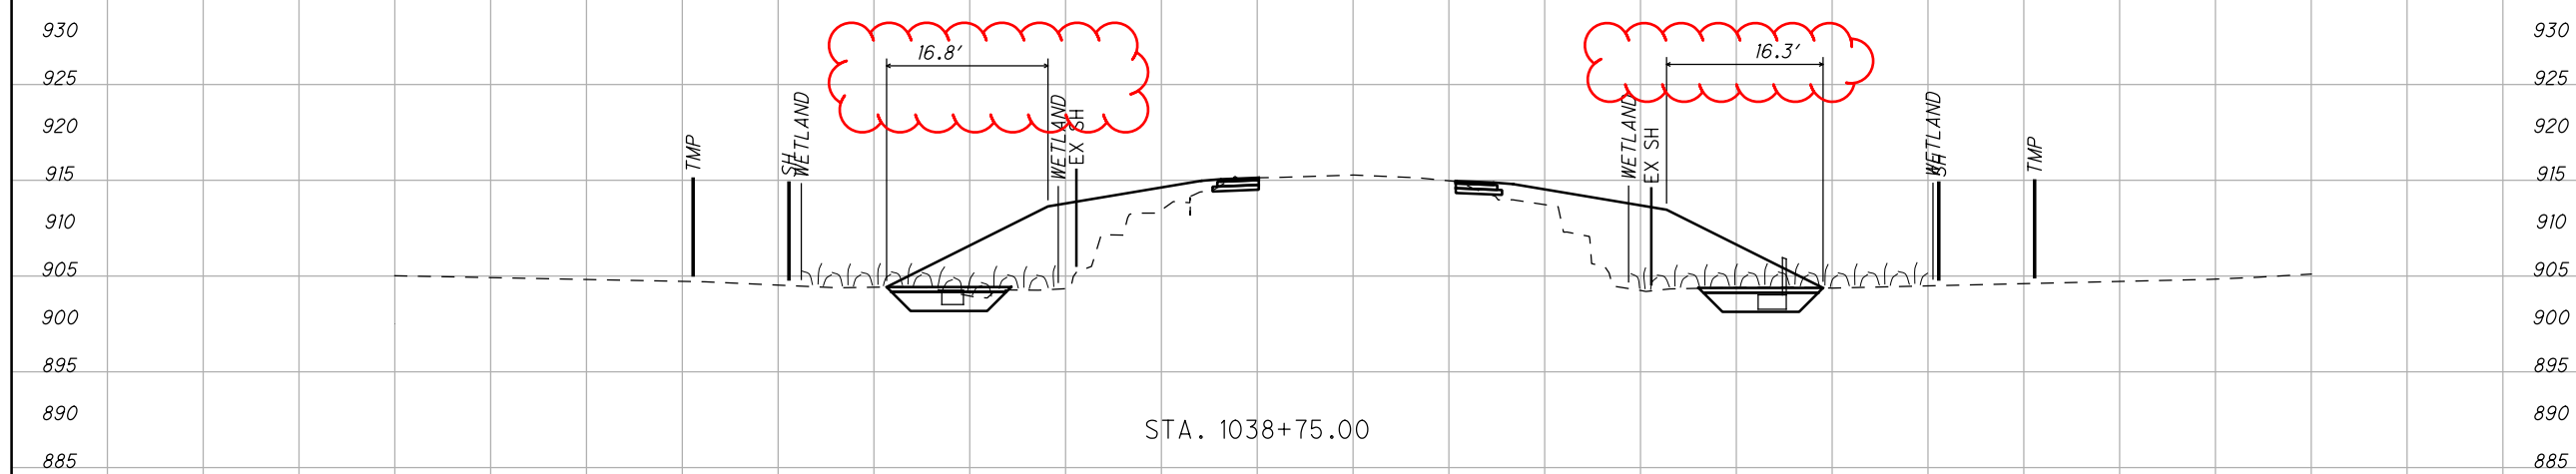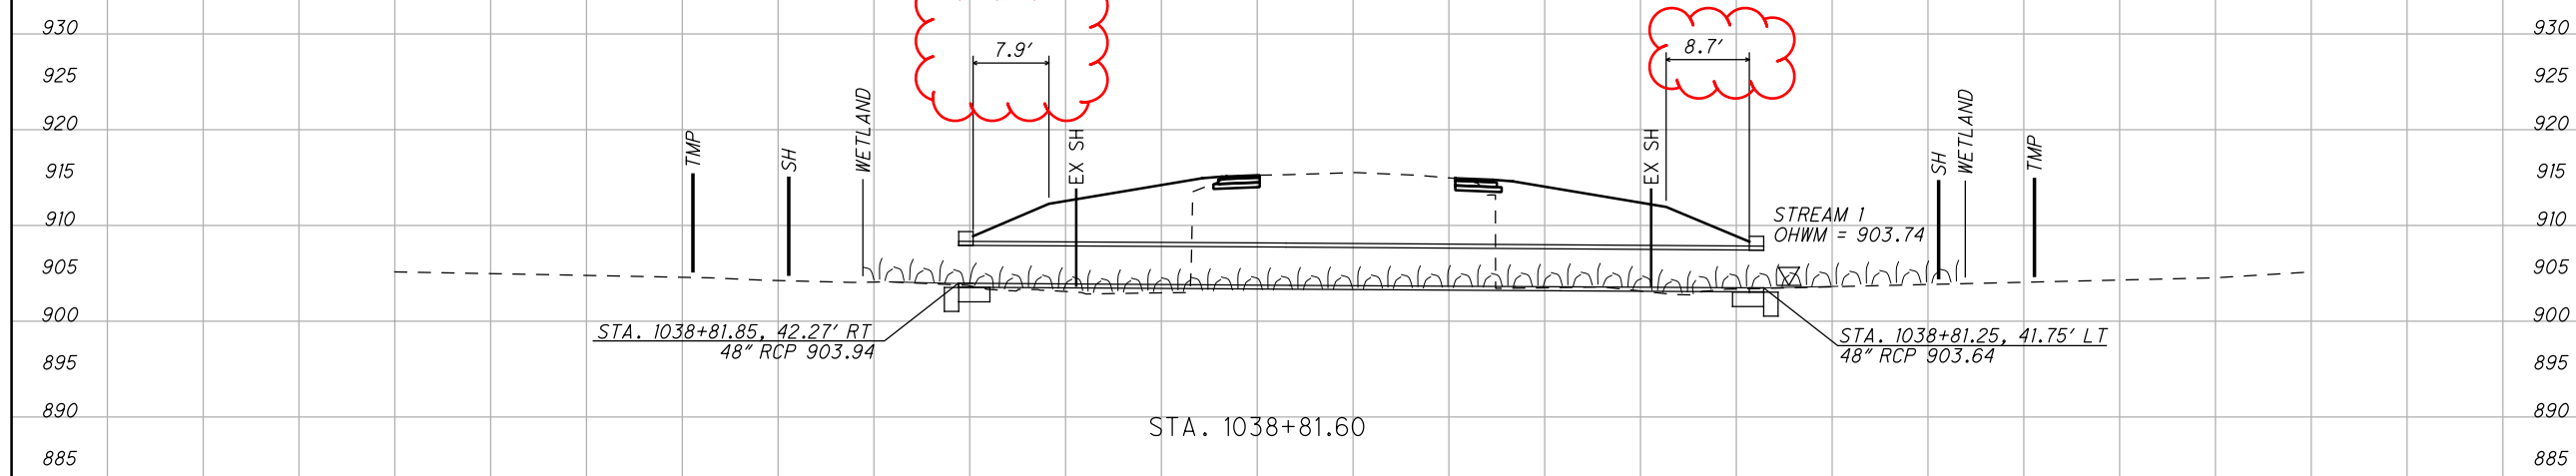

216

238

298

288

**CROSS SECTIONS S.R. 576
STA. 1038+75.00 TO STA. 1038+81.60**

WIL-576-16.55



26
40

514

526

SEEDING	
END WIDTH	SO. YDS.

END AREA		VOLUME		CALCULATED	
CUT	FILL	CUT	FILL	MJF	DAR

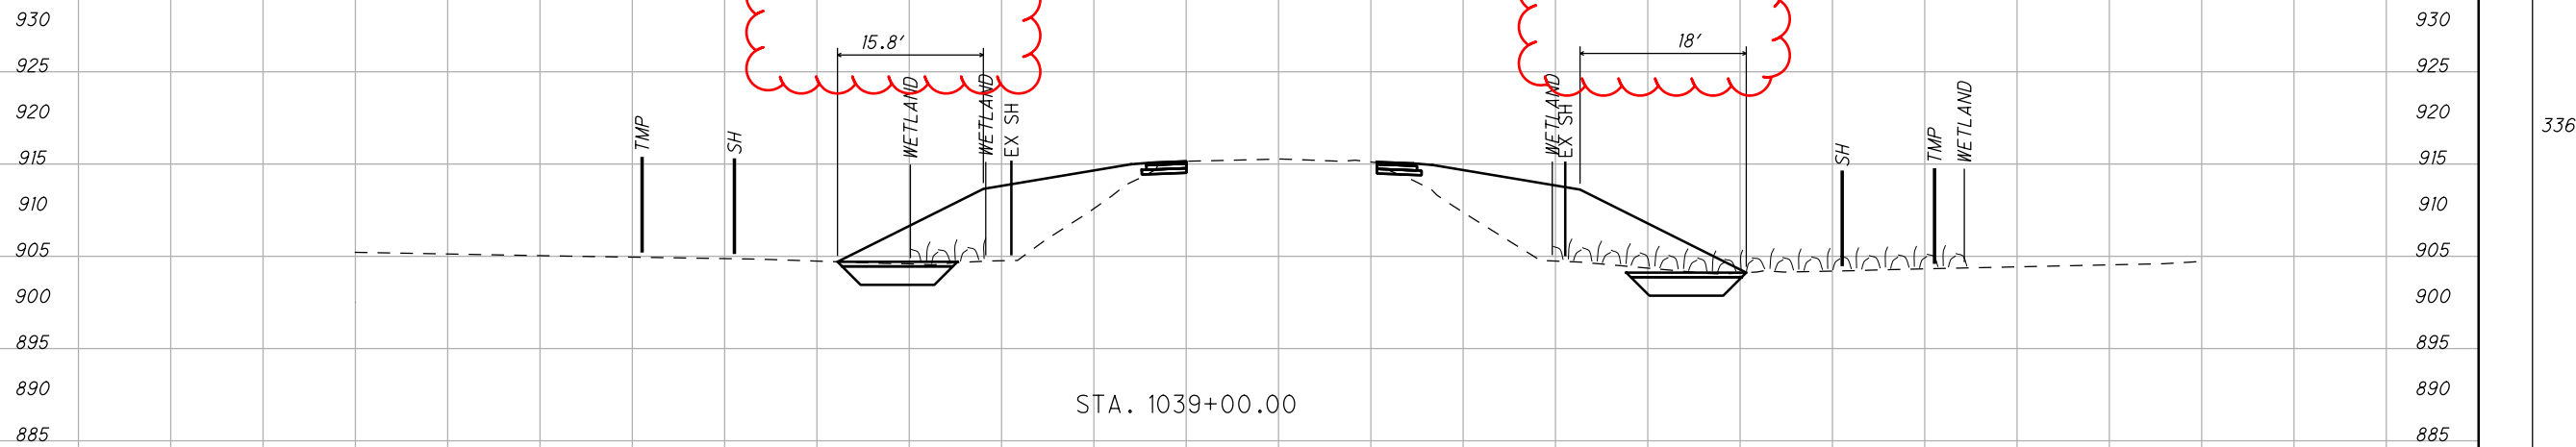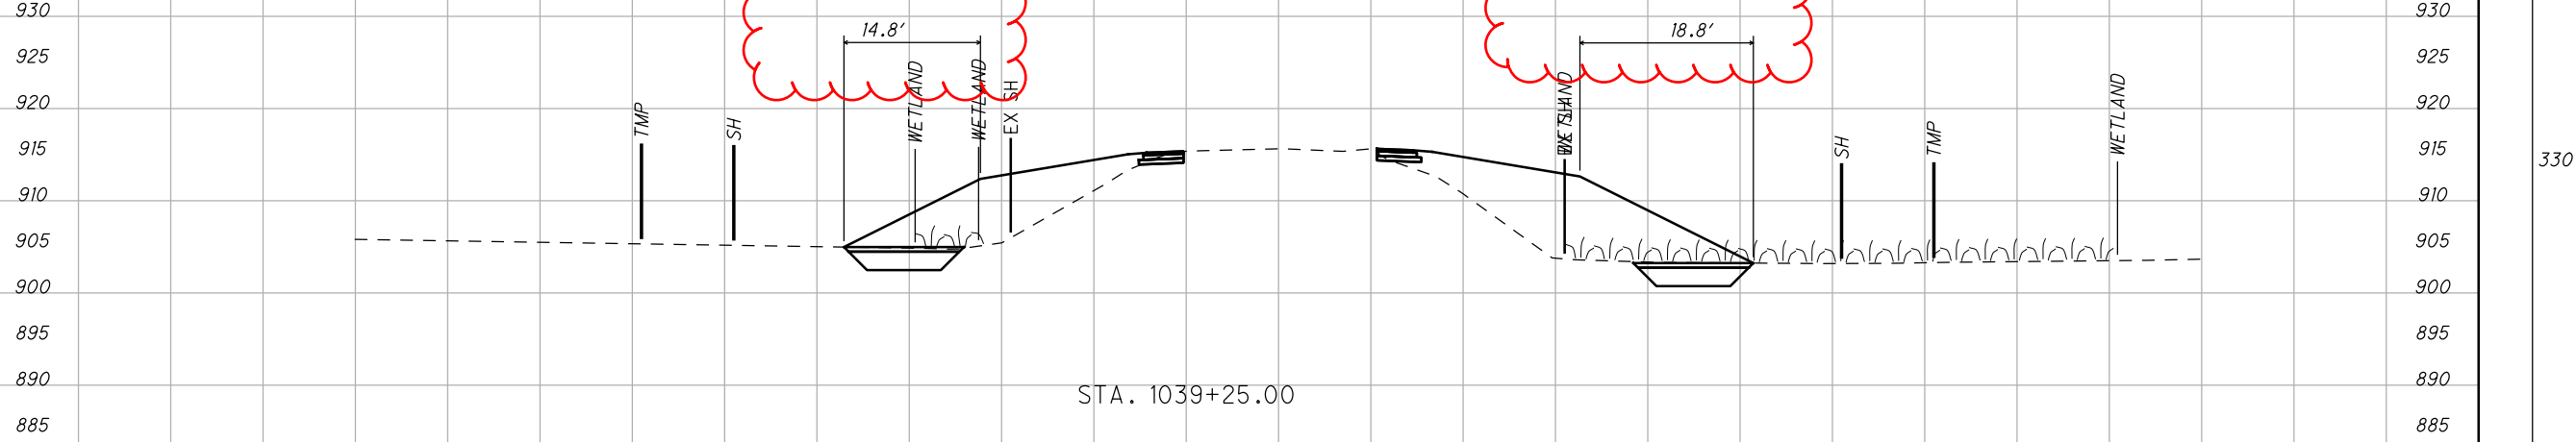

330

336

308

256

666

564

I:\ProjectData\WIL\99575_WIL_576_16.55_Design\Roadway\Sheets\99575_XS03.dgn 01-APR-2021 11:18AM mfar-kas

CROSS SECTIONS S.R. 576
STA. 1039+00.00 TO STA. 1039+25.00



WIL-576-16.55

27
40

I:\ProjectData\WIL\99575_WIL_576_16.55\Design\Roadway\Sheets\99575_XS04.dgn 01-APR-2021 10:19AM mfar-kas

SEEDING	
END WIDTH	SO. YDS.

END AREA		VOLUME		CALCULATED	CHECKED
CUT	FILL	CUT	FILL	MJF	DAR

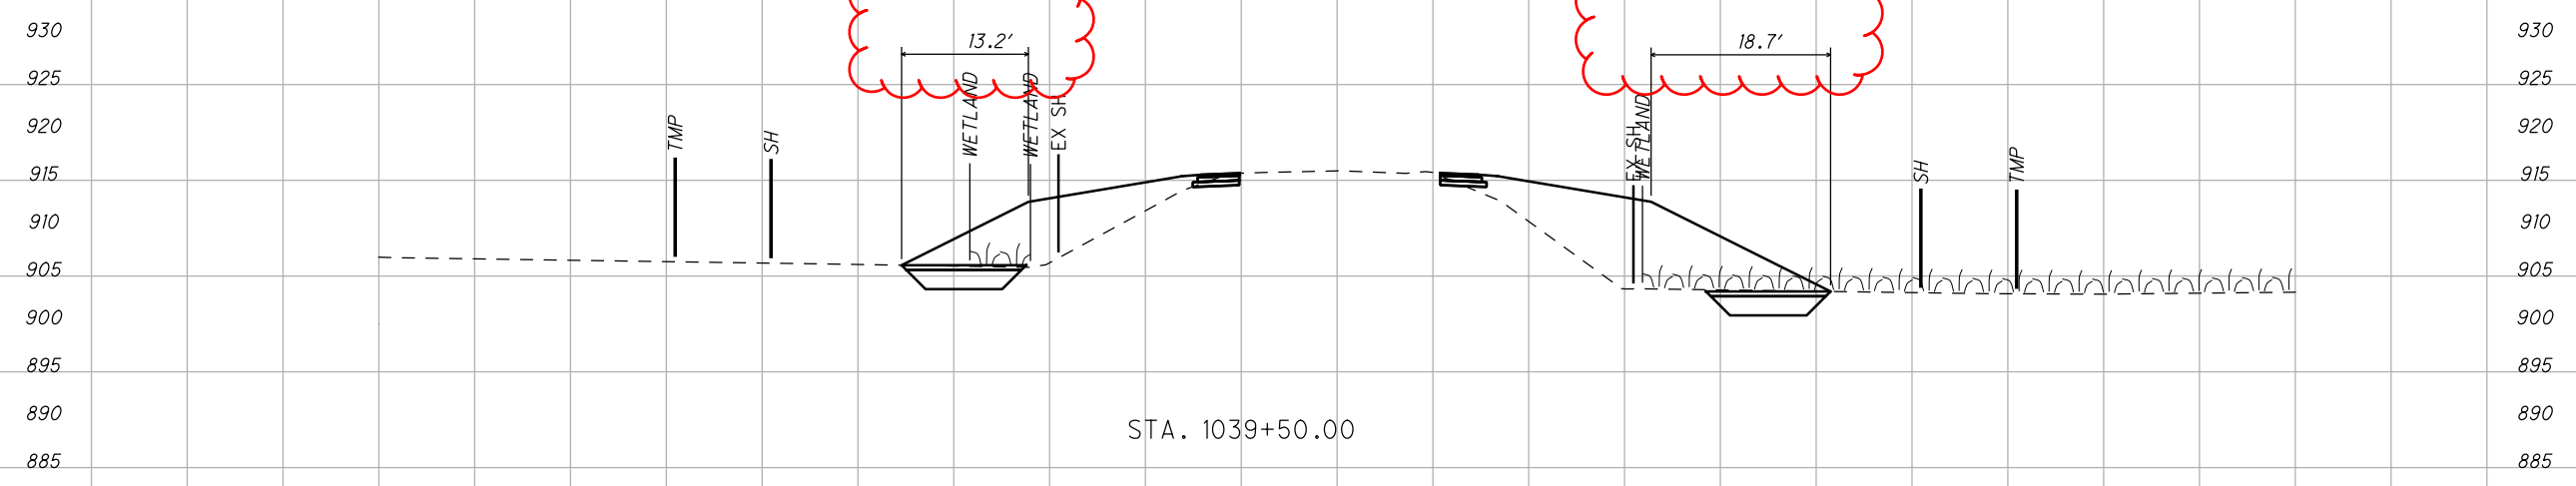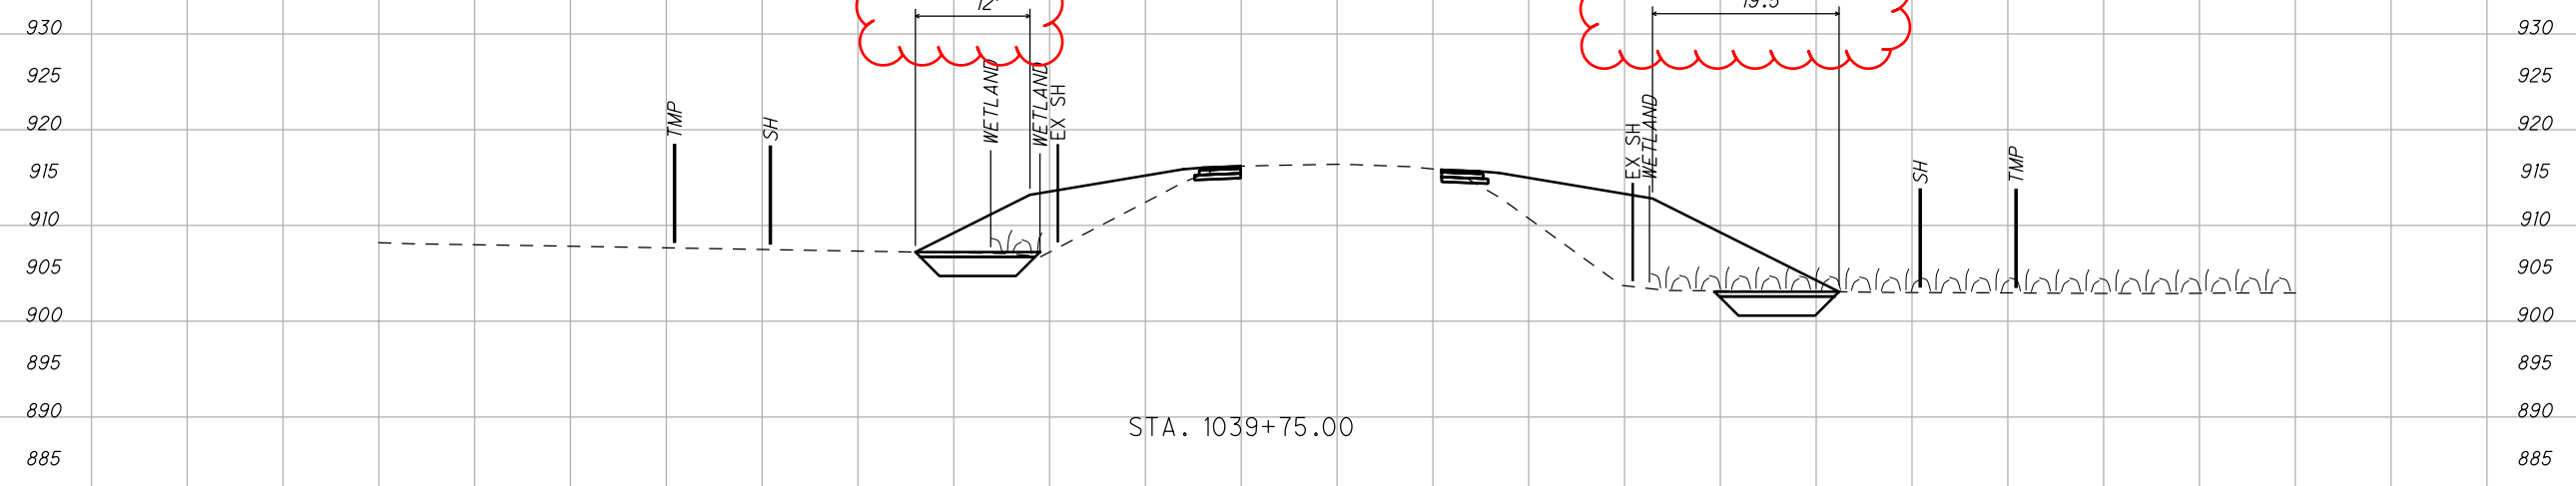

END AREA		VOLUME		CALCULATED	CHECKED
CUT	FILL	CUT	FILL	MJF	DAR
		309			
		288			
314					
		298			
623		586			

WIL-576-16.55

CROSS SECTIONS S.R. 576
STA. 1039+50.00 TO STA. 1039+75.00



28
40

130 120 110 100 90 80 70 60 50 40 30 20 10 0 10 20 30 40 50 60 70 80 90 100 110 120

I:\ProjectData\WIL_576_16.55\Design\Roadway\Sheets\99575_XS015.dgn 01-APR-2021 11:19AM mfar-kas

SEEDING
END SO.
WIDTH YDS.

END AREA		VOLUME		CALCULATED MJF	CHECKED DAR
CUT	FILL	CUT	FILL		

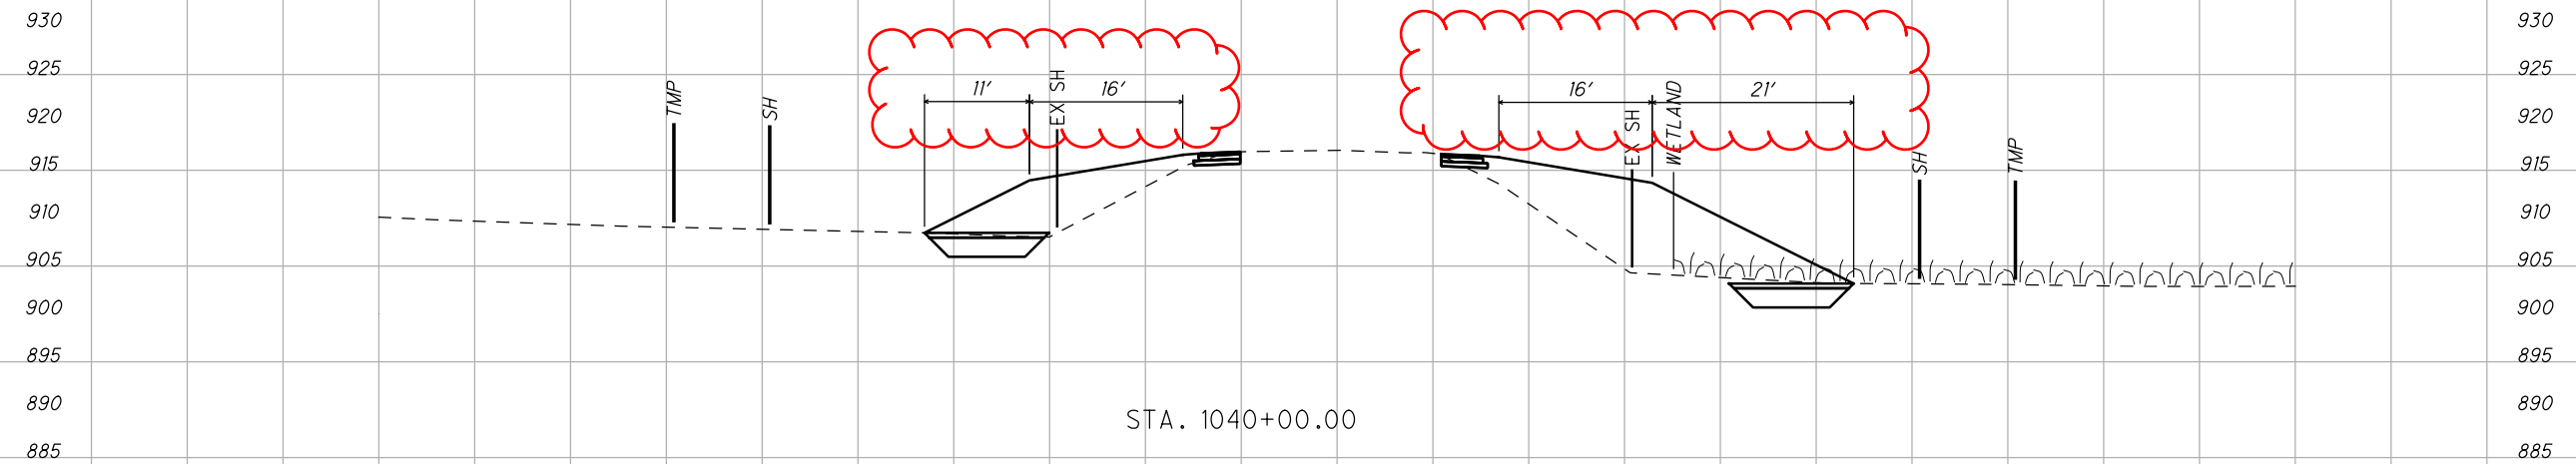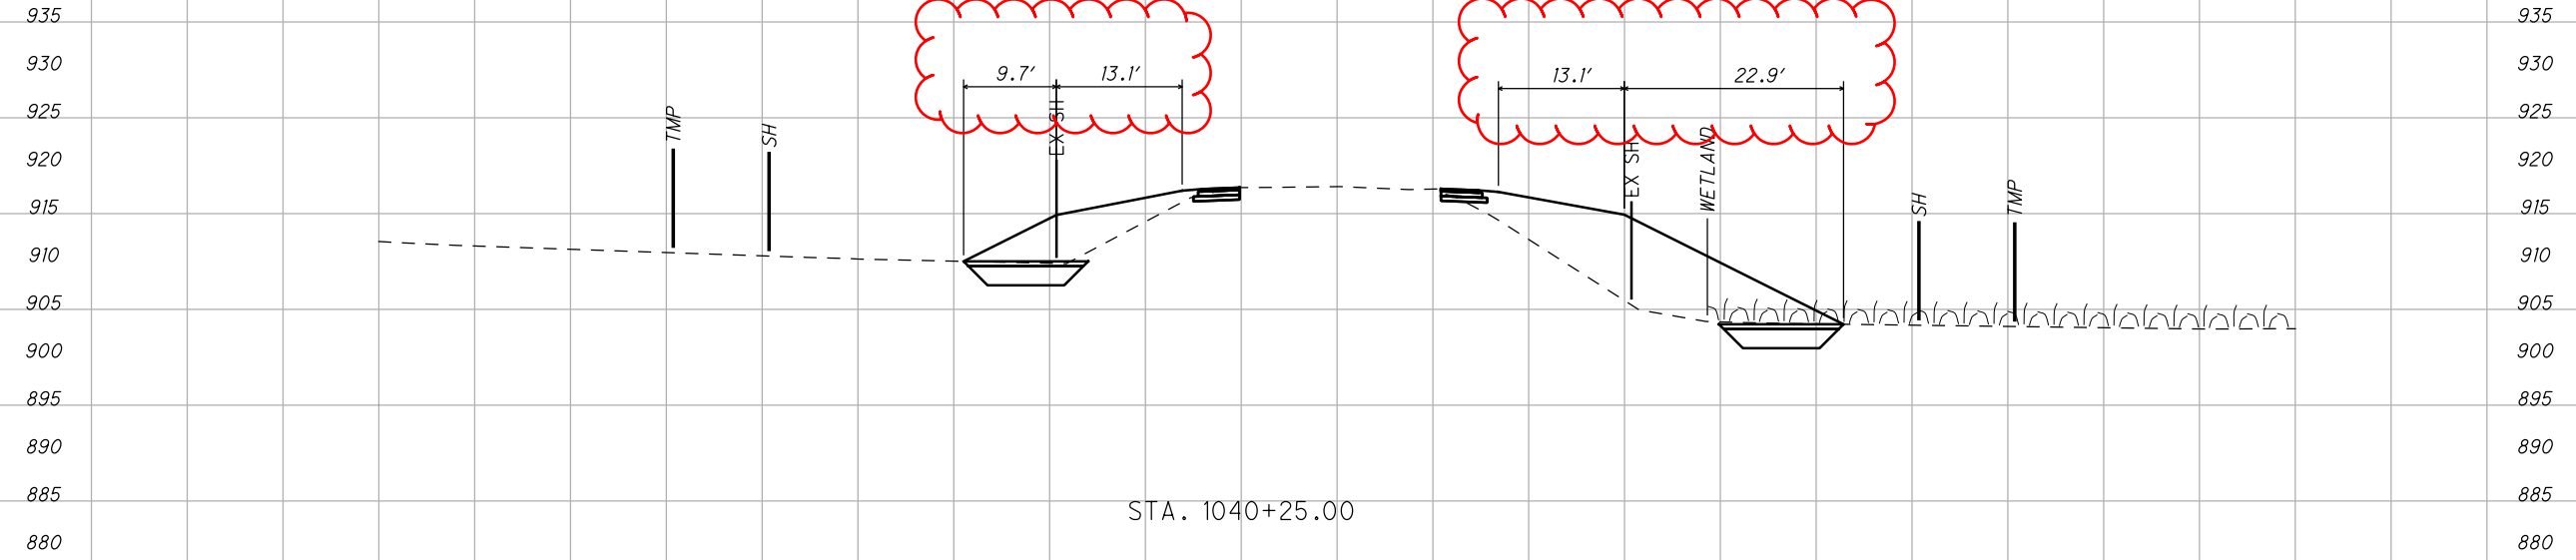

272

310

269

287

**CROSS SECTIONS S.R. 576
STA. 1040+00.00 TO STA. 1040+25.00**

WIL-576-16.55

29
40

582	556
-----	-----

I:\ProjectData\WIL_576_16.55\Design\Roadway\Sheets\99575_XS016.dgn 01-APR-2021 11:20AM mforikos

SEEDING

END SO.
WIDTH YDS.

935
930
925
920
915
910
905
900
895
890
885
880



END AREA		VOLUME	
CUT	FILL	CUT	FILL
259	81	120	178
328	208		

WIL - 576 - 16.55

CROSS SECTIONS S.R. 576
STA. 1040+50.00 TO STA. 1040+75.00



CALCULATED MJF
CHECKED DAR

30
40

I:\ProjectData\WIL_576_16.55\Design\Roadway\Sheets\99575_XS017.dgn 01-APR-2021 11:20AM mfarakas

SEEDING	
END WIDTH	SO. YDS.

END AREA		VOLUME		CALCULATED	CHECKED
CUT	FILL	CUT	FILL	MJF	DAR

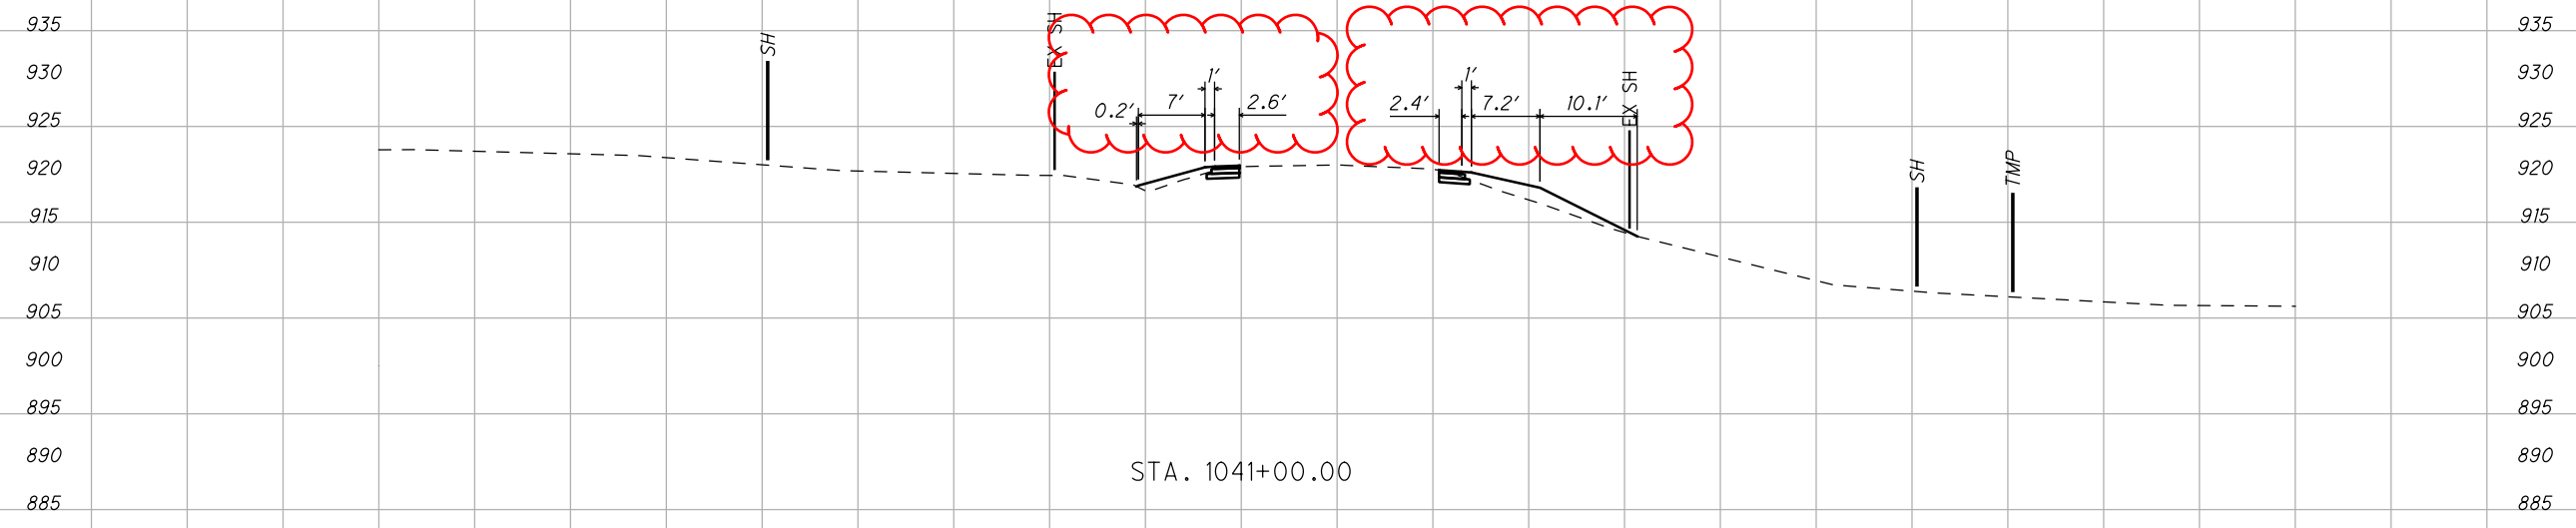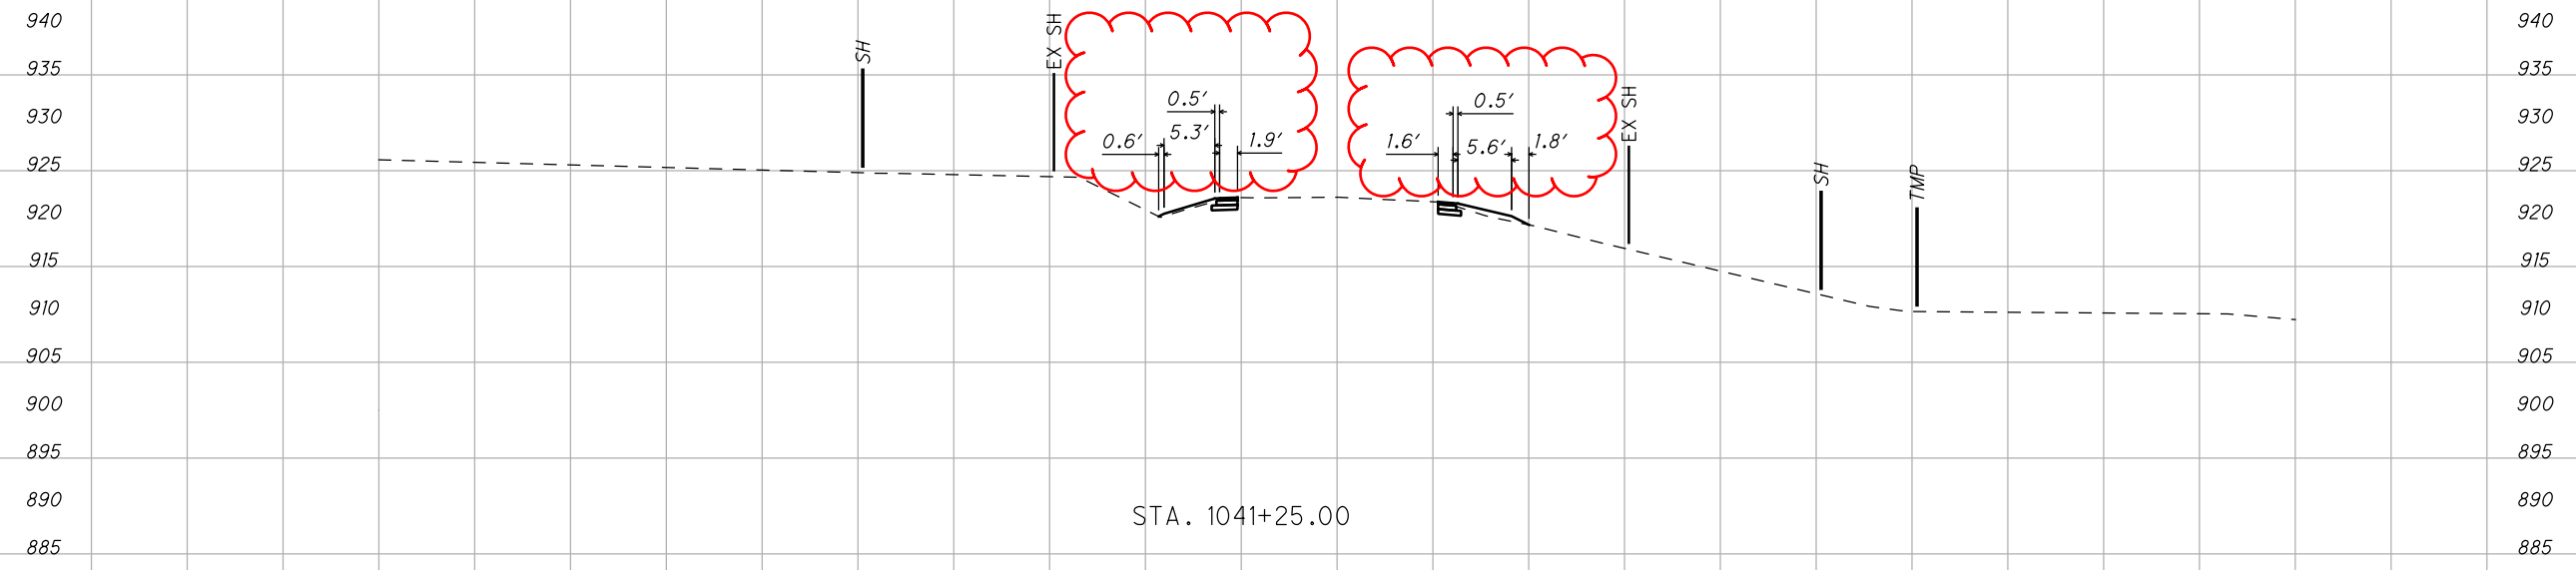

5

24

13

49

149

62

CROSS SECTIONS S.R. 576
STA. 1041+00.00 TO STA. 1041+25.00

WIL-576-16.55

31
40