



**TYPICAL SECTION "A"**

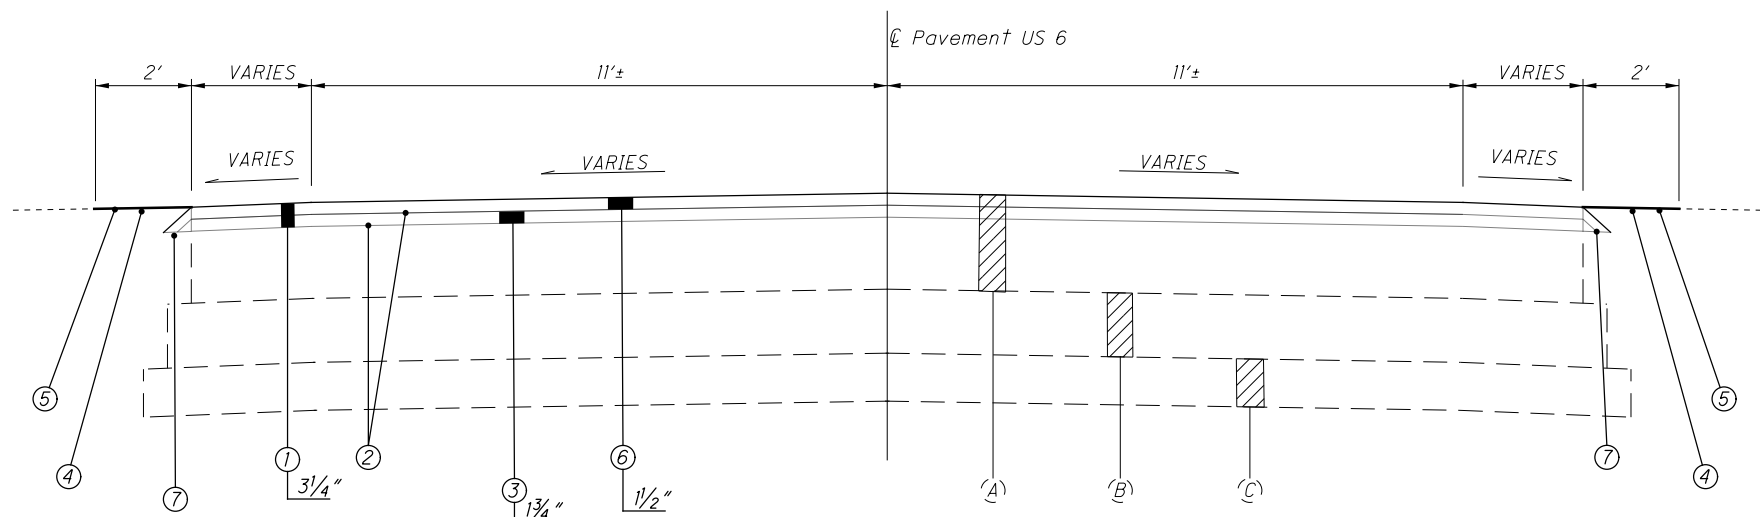


Typical Section Applies: Sta. 1110+11 to Sta. 1171+50 = 6,139 Ft.  
 Sta. 1173+00 to Sta. 1274+86 = 10,186 Ft.  
 Sta. 1275+14 to Sta. 1339+00 = 6,386 Ft.  
 = 22,711 Ft.

**TYPICAL SECTION "B"**

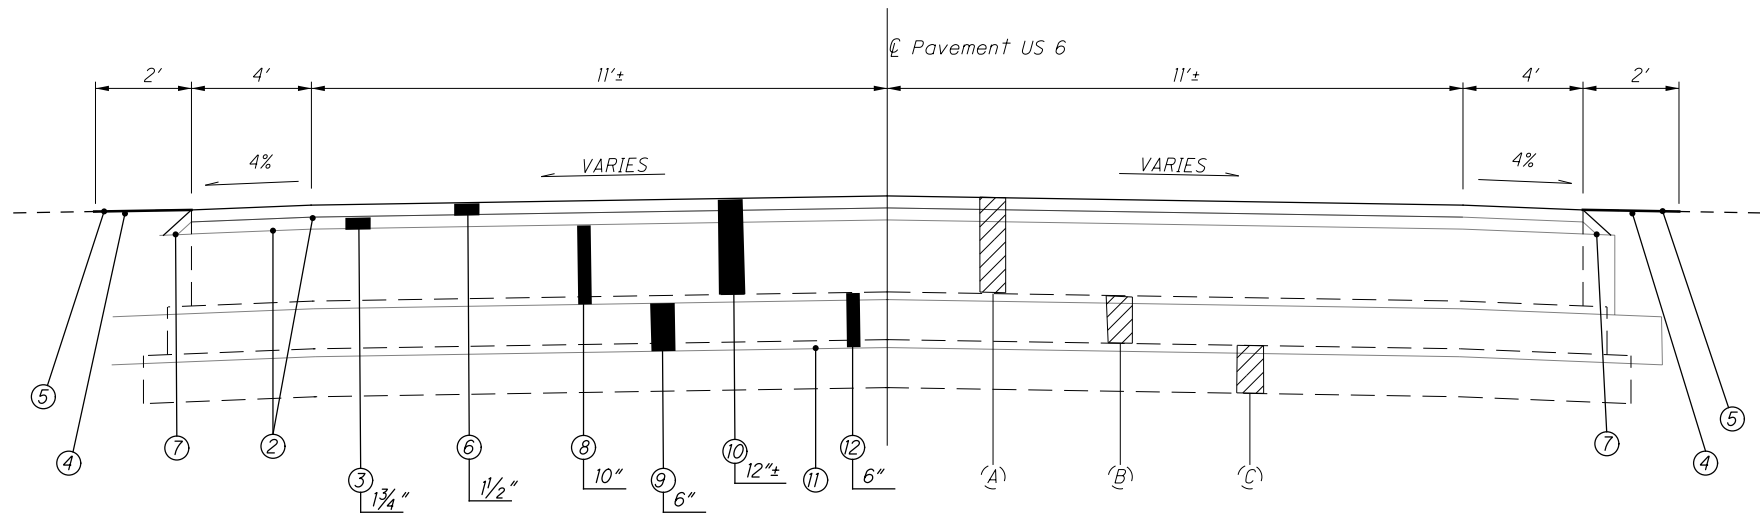

Typical Section Applies: Sta. 1171+50 to Sta. 1173+00 = 150 Ft.

**TYPICAL SECTION "WAYNE ROAD"**

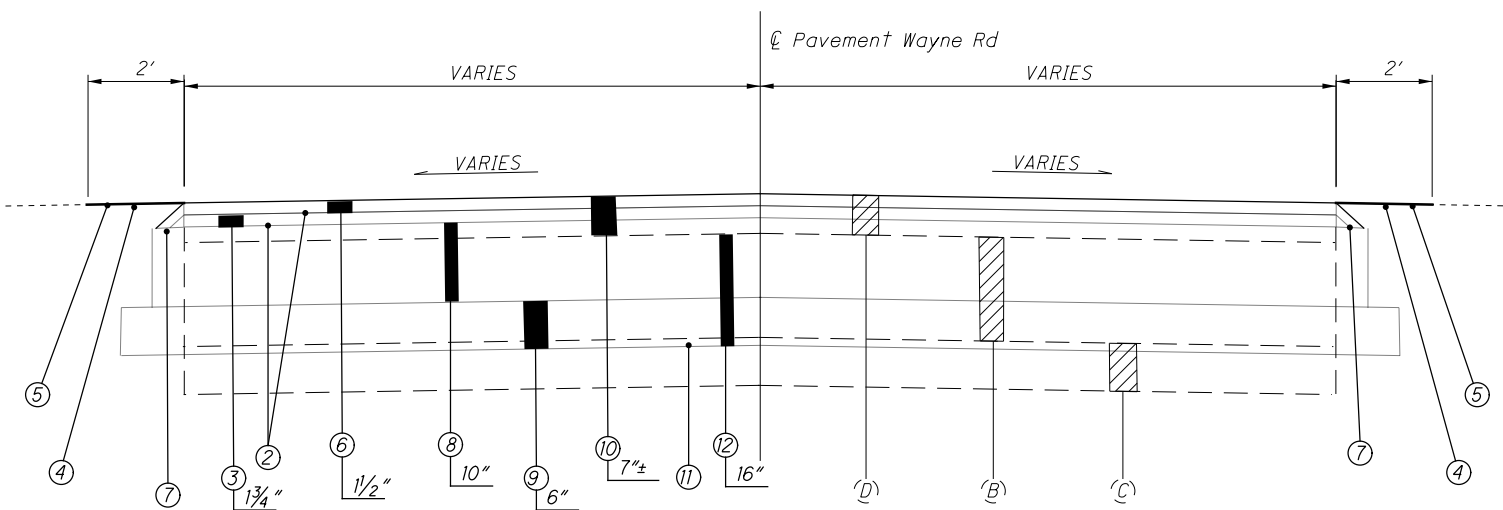


Typical Section Applies: North of Wayne Rd = 66 Ft.  
 South of Wayne Rd = 68 Ft.  
 = 134 Ft.

**LEGEND**

- ① Item 254 - Pavement Planing, Asphalt Concrete (Thickness as Shown)
- ② Item 407 - Non Tracking Tack Coat
- ③ Item 442- Asphalt Concrete Intermediate Course, 19MM, Type A, (446) (Thickness as Shown)
- ④ Item 617 - Compacted Aggregate
- ⑤ Item 209 - Linear Grading
- ⑥ Item 442 - Asphalt Concrete Surface Course, 12.5MM, Type A, (446)
- ⑦ Item 209 - Preparing Subgrade for Shoulder Paving  
Item 441 - Asphalt Concrete - Safety Edge (See General Notes)
- ⑧ Item 301 - Asphalt Concrete Base PG64-22 (Thickness as Shown)
- ⑨ Item 304 - Aggregate Base (Thickness as Shown)
- ⑩ Item 202 - Pavement Removed, Asphalt
- ⑪ Item 204 - Subgrade Compaction
- ⑫ Item 203 - Excavation

- (A) Existing Asphalt - 12"±
- (B) Aggregate Base
- (C) Subbase
- (D) Existing Asphalt - 7" ±

**PAVEMENT DETAIL**

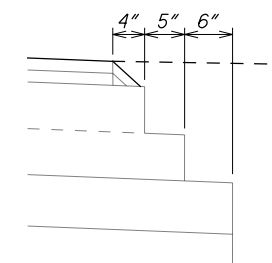

**UTILITIES**

LISTED BELOW ARE ALL THE UTILITIES LOCATED WITHIN THE PROJECT CONSTRUCTION LIMITS TOGETHER WITH THEIR RESPECTIVE OWNERS:

BUCKEYE CABLEVISION FRONTIER  
 2700 OREGON RD. 300 WEST GYPSY LANE RD  
 NORTHWOOD, OHIO 43519 BOWLING GREEN, OH 43402  
 PH: (419) 724-3713 PH: (419) 354-9452

TOLEDO EDISON  
 6099 ANGOLA RD.  
 HOLLAND, OHIO 43528  
 PH: (419) 249-5218

THE LOCATION OF THE UNDERGROUND UTILITIES SHOWN ON THE PLANS ARE OBTAINED FROM THE OWNERS AS REQUIRED BY SECTION 153.64 O.R.C.

**SURVEYING PARAMETERS**

USE THE FOLLOWING VERTICAL POSITIONING AND HORIZONTAL POSITIONING PARAMETERS FOR ALL SURVEYING:

VERTICAL POSITIONING

ORTHOMETRIC HEIGHT DATUM: NAVD88 (ODOT VRS DERIVED)  
 GEOID: 2012A

HORIZONTAL POSITIONING

REFERENCE FRAME: NAD83 (2011)  
 ELLIPSOID: GRS80  
 MAP PROJECTION: LAMBERT CONFORMAL CONIC  
 COORDINATE SYSTEM: OHIO STATE PLANE NORTH  
 COMBINED SCALE FACTOR: GRID=1.0000000

UNITS ARE IN U.S. SURVEY FEET. USE THE FOLLOWING CONVERSION FACTOR: 1 METER = 3.280833333 U.S. SURVEY FEET.

**ROUNDING**

THE ROUNDING AT SLOPE BREAKPOINTS SHOWN ON THE TYPICAL SECTIONS APPLIES TO ALL CROSS-SECTIONS EVEN THOUGH OTHERWISE SHOWN.

**WORK LIMITS**

THE WORK LIMITS SHOWN ON THESE PLANS ARE FOR PHYSICAL CONSTRUCTION ONLY. PROVIDE THE INSTALLATION AND OPERATION OF ALL WORK ZONE TRAFFIC CONTROL AND WORK ZONE TRAFFIC CONTROL DEVICES REQUIRED BY THESE PLANS WHETHER INSIDE OR OUTSIDE THESE WORK LIMITS.

**PROFILE AND ALIGNMENT**

THE WORK PROPOSED BY THIS PROJECT IS FOR THE RESURFACING OF THE EXISTING PAVEMENT. THE ALIGNMENT OF THE EXISTING PAVEMENT WILL NOT BE CHANGED AND THE PROFILE OF THE PROPOSED SURFACE WILL BE SIMILAR TO THAT OF THE EXISTING PAVEMENT.

**PLANED SURFACES**

NO PLANED SURFACES SHALL BE OPEN TO THE PUBLIC FOR MORE THAN 7 DAYS. IF THE PLANED SURFACE IS OPEN FOR MORE THAN 7 DAYS, IT SHALL BE THE CONTRACTOR'S RESPONSIBILITY TO REPAIR THE PAVEMENT FAILURES THAT OCCURRED AFTER THE 7 DAY LIMIT.


**ITEM 442 - ASPHALT CONCRETE SURFACE COURSE, 12.5MM, TYPE A (446), AS PER PLAN**

JOINT CORING IN ACCORDANCE WITH 446.04 IS NOT REQUIRED FOR COLD LONGITUDINAL JOINTS PLACED OVER VOID REDUCING ASPHALT MEMBRANE (VRAM). CONSTRUCT COLD LONGITUDINAL JOINTS OVER VRAM USING THE SAME TECHNIQUES, EQUIPMENT, AND ROLLER PATTERNS USED FOR THE REST OF THE MAT. OBTAIN 10 MAT CORES FOR EACH LOT OF MATERIAL IN ACCORDANCE WITH 446.04. PAY FACTORS FOR EACH LOT OF MATERIAL WILL BE DETERMINED ACCORDING TO TABLE 446.04-2.

**PAVEMENT REPAIRS**

THE FOLLOWING ESTIMATED QUANTITIES ARE TO BE USED FOR PAVEMENT REPAIR ON US 6 AND AS DIRECTED BY THE ENGINEER AND ARE BASED ON THE PERCENTAGES SHOWN:

US 6 SLM 21.02 - 25.36 @ 8%  
 STA. 1110+11 TO STA. 1339+00 = 22,889' \* 32' \* 0.5 = 366,224CF  
 366,224CF / 27 = 13,564CY @ 8% = 1,085CY  
 ITEM 253 - PAVEMENT REPAIR 6" 1,085 CY

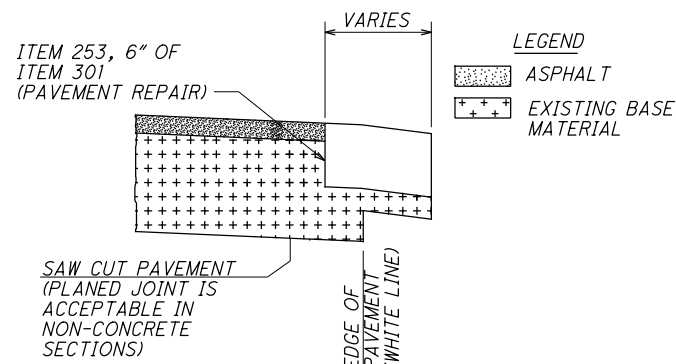

NOTE: THE ENGINEER SHALL FIELD VERIFY ALL LOCATIONS PRIOR TO THE BEGINNING OF WORK. ANY ADJUSTMENTS NECESSARY SHALL BE AS DIRECTED BY THE ENGINEER.

THE PAVEMENT REPAIRS SHALL BE DONE AFTER PAVEMENT PLANING.

**ASPHALT CONCRETE - SAFETY EDGE**

THE FOLLOWING ESTIMATED QUANTITIES ARE TO BE USED FOR THE CONSTRUCTION OF THE SAFETY EDGE. SEE SCD BP-3.2.

WOO US 6 (21.02-25.36) STA. 1110+11 TO STA. 1339+00

- ITEM 209 - PREPARING SUBGRADE FOR SHOULDER PAVING 10 MILE
- ITEM 442 - ASPHALT CONCRETE SURFACE COURSE, 12.5MM, TYPE A, (446) 77 CY
- ITEM 442 - ASPHALT CONCRETE INTERMEDIATE COURSE, 19MM, TYPE A, (446) 32 CY

QUANTITIES TO BE USED FOR THE SAFETY EDGE HAVE BEEN CARRIED TO THE GENERAL SUMMARY.

**TRAFFIC CONTROL QUANTITIES**

PAVEMENT MARKINGS  
 THE CONTRACTOR WILL BE PROVIDED THE "NO PASSING ZONE LOG" FOR THE CENTER LINE PAVEMENT MARKING UPON REQUEST.

**THE FOLLOWING ARE FOR INFORMATION ONLY:**

YELLOW CENTER LINE  
 DASHED 2.97 MILE  
 DASHED SOLID 0.89 MILE  
 DOUBLE SOLID 0.48 MILE

RAISED PAVEMENT MARKERS  
 TWO WAY YELLOW/YELLOW 286 EACH  
 ONE WAY WHITE 16\* EACH  
 (\*REPLACE TO US-23 IF NECESSARY; 7 IN PROJECT LIMITS)

ITEM	QTY	UNIT	DESCRIPTION
621	302	EACH	RPM
621	63	EACH	RAISED PAVEMENT MARKER REMOVED
642	8.68	MILE	EDGE LINE, 6", TYPE 1
642	8.68	MILE	CENTER LINE, TYPE 1
644	77	FT	STOP LINE

ALL TRAFFIC CONTROL QUANTITIES ARE CARRIED TO THE GENERAL SUMMARY.

**CROSSINGS AND CONNECTIONS TO EXISTING PIPES AND UTILITIES**

WHERE PLANS PROVIDE FOR A PROPOSED CONDUIT TO BE CONNECTED TO, OR CROSS OVER OR UNDER AN EXISTING SEWER OR UNDERGROUND UTILITY, THE CONTRACTOR SHALL LOCATE THE EXISTING PIPES OR UTILITIES BOTH AS TO LINE AND GRADE BEFORE STARTING TO LAY THE PROPOSED CONDUIT.

IF IT IS DETERMINED THAT THE ELEVATION OF THE EXISTING CONDUIT, OR EXISTING APPURTENANCE TO BE CONNECTED, DIFFERS FROM THE PLAN ELEVATION OR RESULTS IN A CHANGE IN THE PLAN CONDUIT SLOPE, THE ENGINEER SHALL BE NOTIFIED BEFORE STARTING CONSTRUCTION OF ANY PORTION OF THE PROPOSED CONDUIT WHICH WILL BE AFFECTED BY THE VARIANCE IN THE EXISTING ELEVATIONS.

IF IT IS DETERMINED THAT THE PROPOSED CONDUIT WILL INTERSECT AN EXISTING SEWER OR UNDERGROUND UTILITY IF CONSTRUCTED AS SHOWN ON THE PLAN, THE ENGINEER SHALL BE NOTIFIED BEFORE STARTING CONSTRUCTION OF ANY PORTION OF THE PROPOSED CONDUIT WHICH WOULD BE AFFECTED BY THE INTERFERENCE WITH AN EXISTING FACILITY.

PAYMENT FOR ALL THE OPERATIONS DESCRIBED ABOVE SHALL BE INCLUDED IN THE CONTRACT PRICE FOR THE PERTINENT 611 CONDUIT ITEM.

**REVIEW OF DRAINAGE FACILITIES**

BEFORE ANY WORK IS STARTED ON THE PROJECT AND AGAIN BEFORE FINAL ACCEPTANCE BY THE STATE, REPRESENTATIVES OF THE STATE AND THE CONTRACTOR, ALONG WITH LOCAL REPRESENTATIVES, SHALL MAKE AN INSPECTION OF ALL EXISTING SEWERS WHICH ARE TO REMAIN IN SERVICE AND WHICH MAY BE AFFECTED BY THE WORK. THE CONDITION OF THE EXISTING CONDUITS AND THEIR APPURTENANCE SHALL BE DETERMINED FROM FIELD OBSERVATIONS. RECORDS OF THE INSPECTION SHALL BE KEPT IN WRITING BY THE STATE.

ALL NEW CONDUITS, INLETS, CATCH BASINS, AND MANHOLES CONSTRUCTED AS A PART OF THE PROJECT SHALL BE FREE OF ALL FOREIGN MATTER AND IN A CLEAN CONDITION BEFORE THE PROJECT WILL BE ACCEPTED BY THE STATE.

ALL EXISTING SEWERS INSPECTED INITIALLY BY THE ABOVE MENTIONED PARTIES SHALL BE MAINTAINED AND LEFT IN A CONDITION REASONABLY COMPARABLE TO THAT DETERMINED BY THE ORIGINAL INSPECTION. ANY CHANGE IN THE CONDITION RESULTING FROM THE CONTRACTOR'S OPERATIONS SHALL BE CORRECTED BY THE CONTRACTOR TO THE SATISFACTION OF THE ENGINEER.

PAYMENT FOR ALL OPERATIONS DESCRIBED ABOVE SHALL BE INCLUDED IN THE CONTRACT PRICE FOR THE PERTINENT 611 CONDUIT ITEMS.

CALCULATED  
 MJF  
 CHECKED  
 DAR

GENERAL NOTES

W00-6-21.02

I:\ProjectData\W00\10242\_W00-6-21.04\Design\Roadway\Sheets\10242\_GN001.dgn 16-MAR-2020 3:51PM mfarakas

**ITEM 614, MAINTAINING TRAFFIC**

A MINIMUM OF ONE LANE OF TRAFFIC SHALL BE MAINTAINED AT ALL TIMES, EXCEPT FOR A PERIOD NOT TO EXCEED 30 CONSECUTIVE CALENDAR DAYS TO CONSTRUCT THE WOO-6-2225 STRUCTURE. THE 30 DAY CLOSURE SHALL BEGIN NO SOONER THAN 6/15/20 AND SHALL BE COMPLETE NO LATER THAN 7/30/20. THIS CLOSURE IS SET UP TO OCCUR DURING THE SAME TIMEFRAME AS A CLOSURE ON AN ADJACENT PROJECT ON US 6 (PID 107690 WOO-6-14.83). THE DETOUR FOR PID 107690 WILL UTILIZE SR 25 AND SR 281.

DAMAGES IN THE AMOUNT OF \$2,500 PER DAY SHALL BE ASSESSED FOR EACH CALENDAR DAY THE ROADWAY REMAINS CLOSED TO TRAFFIC BEYOND THE SPECIFIED TIMEFRAMES.

LENGTH AND DURATION OF LANE CLOSURES AND RESTRICTIONS SHALL BE AT THE APPROVAL OF THE ENGINEER. BRIDGE RESTRICTIONS AND CLOSURES CAN BE FOUND UNDER BRIDGE MAINTENANCE OF TRAFFIC NOTE. IT IS THE INTENT TO MINIMIZE THE IMPACT TO THE TRAVELING PUBLIC. LANE CLOSURES OR RESTRICTIONS OVER SEGMENTS OF THE PROJECT IN WHICH NO WORK IS ANTICIPATED WITHIN A REASONABLE TIME FRAME, AS DETERMINED BY THE ENGINEER, SHALL NOT BE PERMITTED. THE LEVEL OF UTILIZATION OF MAINTENANCE OF TRAFFIC DEVICES SHALL BE COMMENSURATE WITH THE WORK IN PROGRESS.

ALL WORK AND TRAFFIC CONTROL DEVICES SHALL BE IN ACCORDANCE WITH CMS 614 AND OTHER APPLICABLE PORTIONS OF THE SPECIFICATIONS, AS WELL AS THE OHIO MANUAL OF UNIFORM TRAFFIC CONTROL DEVICES. PAYMENT FOR ALL LABOR, EQUIPMENT AND MATERIALS SHALL BE INCLUDED IN THE SUMP SUM CONTRACT PRICE FOR ITEM 614, MAINTAINING TRAFFIC UNLESS SEPARATELY ITEMIZED IN THE PLAN.

**PLACEMENT OF ASPHALT CONCRETE**

TWO-WAY TRAFFIC SHALL BE MAINTAINED AT ALL TIMES EXCEPT THAT ONE-WAY TRAFFIC WILL BE PERMITTED FOR MINIMUM PERIODS OF TIME CONSISTENT WITH THE REQUIREMENTS OF THE SPECIFICATIONS FOR PROTECTION OF COMPLETED ASPHALT CONCRETE COURSES.

**WORK ZONE MARKINGS AND SIGNS**

THE FOLLOWING ESTIMATED QUANTITIES HAVE BEEN CARRIED TO THE GENERAL SUMMARY FOR USE AT LOCATIONS IDENTIFIED BY THE ENGINEER FOR WORK ZONE PAVEMENT MARKINGS AND SIGNS PER THE REQUIREMENTS OF CMS 614.04 AND 614.11

ITEM 614 - WORK ZONE MARKING SIGN 28 EACH  
 ITEM 614 - WORK ZONE CENTER LINE, CLASS I 15 MILE

**ITEM 614, REPLACEMENT SIGN**

FLATSHEET SIGNS FURNISHED BY THE CONTRACTOR IN ACCORDANCE WITH THE REQUIREMENTS OF THE PLANS, SPECIFICATIONS AND PROPOSAL WHICH BECOME DAMAGED BY TRAFFIC FOR REASONS BEYOND THE CONTROL OF THE CONTRACTOR SHALL BE REPLACED IN KIND WHEN ORDERED BY THE ENGINEER. REPLACEMENT SIGNS SHALL BE NEW. OTHER MATERIALS MAY BE IN USED, BUT GOOD, CONDITION SUBJECT TO APPROVAL BY THE ENGINEER.

PAYMENT FOR THE NEW SIGNS SHALL BE MADE AT THE CONTRACT PRICE PER EACH FOR ITEM 614, REPLACEMENT SIGN, AND SHALL INCLUDE THE COST OF REMOVING AND DISPOSING OF DAMAGED SIGNS, HARDWARE AND SUPPORTS, AND PROVIDING THE NECESSARY REPLACEMENT HARDWARE, SUPPORTS, ETC.

AN ESTIMATED QUANTITY OF 5 EACH HAS BEEN PROVIDED IN THE GENERAL SUMMARY.

**ITEM 614, REPLACEMENT DRUM**

DRUMS FURNISHED BY THE CONTRACTOR IN ACCORDANCE WITH THE REQUIREMENTS OF THE PLANS, SPECIFICATIONS AND PROPOSAL WHICH BECOME DAMAGED BY TRAFFIC FOR REASONS BEYOND THE CONTROL OF THE CONTRACTOR SHALL BE REPLACED IN KIND WHEN ORDERED BY THE ENGINEER. REPLACEMENT DRUMS SHALL BE NEW.

PAYMENT FOR THE NEW DRUMS SHALL BE MADE AT THE CONTRACT PRICE PER EACH FOR ITEM 614, REPLACEMENT DRUM, AND SHALL INCLUDE THE COST OF REMOVING AND DISPOSING OF THE DAMAGED DRUM, AND PROVIDING AND MAINTAINING THE REPLACEMENT DRUM IN ACCORDANCE WITH THE CONTRACT REQUIREMENTS FOR THE ORIGINAL DRUM.

AN ESTIMATED QUANTITY OF 5 EACH HAS BEEN PROVIDED IN THE GENERAL SUMMARY.

**NOTIFICATION OF TRAFFIC RESTRICTIONS**

THROUGHOUT THE DURATION OF THE PROJECT, THE CONTRACTOR SHALL NOTIFY THE PROJECT ENGINEER IN WRITING OF ALL TRAFFIC RESTRICTIONS AND UPCOMING MAINTENANCE OF TRAFFIC CHANGES. THE CONTRACTOR SHALL ENSURE THE WRITTEN NOTIFICATION IS SUBMITTED IN A TIMELY MANNER TO ALLOW THE PROJECT ENGINEER TO MEET THE REQUIRED TIME FRAMES SET FORTH IN THE TABLE BELOW TO INFORM THE SPECIAL HAULING PERMITS SECTION (HAULING.PERMITS@DOT.OHIO.GOV) AND THE DISTRICT PUBLIC INFORMATION OFFICE (PIO). THIS NOTIFICATION SHALL BE RECEIVED BY THE PROJECT ENGINEER PRIOR TO THE PHYSICAL SETUP OF ANY APPLICABLE SIGNS OR MESSAGE BOARDS.

INFORMATION SHOULD INCLUDE, BUT IS NOT LIMITED TO, ALL CONSTRUCTION ACTIVITIES THAT IMPACT OR INTERFERE WITH TRAFFIC AND SHALL LIST THE SPECIFIC LOCATION, TYPE OF WORK, ROAD STATUS, DATE AND TIME OF RESTRICTION, DURATION OF RESTRICTION, NUMBER OF LANES MAINTAINED, NUMBER OF LANES CLOSED, MINIMUM VERTICAL CLEARANCE, MINIMUM WIDTH OF DRIVABLE PAVEMENT, DETOUR ROUTES, IF APPLICABLE, AND ANY OTHER INFORMATION REQUESTED BY THE PROJECT ENGINEER.

NOTIFICATION TIME TABLE		
ITEM	DURATION OF CLOSURE	NOTICE DUE TO PERMITS & PIO
RAMP AND ROAD CLOSURES	>= 2 WEEKS	21 CALENDAR DAYS PRIOR TO CLOSURE
	> 12 HOURS & < 2 WEEKS	14 CALENDAR DAYS PRIOR TO CLOSURE
	<= 12 HOURS	4 BUSINESS DAYS PRIOR TO CLOSURE
LANE CLOSURES AND RESTRICTIONS	>= 2 WEEKS	14 CALENDAR DAYS PRIOR TO CLOSURE
	< 2 WEEKS	5 BUSINESS DAYS PRIOR TO CLOSURE
START OF CONSTRUCTION AND TRAFFIC PATTERN CHANGES		14 CALENDAR DAYS PRIOR TO IMPLEMENTATION

ANY UNFORESEEN CONDITIONS NOT SPECIFIED IN THE PLANS REQUIRING TRAFFIC RESTRICTIONS SHALL ALSO BE REPORTED TO THE PROJECT ENGINEER USING THE NOTIFICATION TIME TABLE.

**ODOT NOTIFICATION CONTACT INFORMATION**

THE ODOT PROJECT ENGINEER SHALL FORWARD THE CONSTRUCTION NOTIFICATION INFORMATION TO THE FOLLOWING DEPARTMENTS WITHIN THE TIMELINE OUTLINED IN TEM PART 642-58 TO ENSURE COMPLIANCE WITH FEDERAL NOTIFICATION REQUIREMENTS:

DISTRICT PUBLIC INFORMATION OFFICER (PIO) BY PHONE AT: (419) 373-4428 OR EMAIL AT: D02.pio@dot.ohio.gov

DISTRICT PERMIT SECTION BY PHONE AT: (419) 373-4301 OR EMAIL AT: D02.permits@dot.ohio.gov

**ITEM 614, MAINTAINING TRAFFIC (NOTICE OF CLOSURE SIGN)**

NOTICE OF CLOSURE SIGNS (W20-H13) SHALL BE ERECTED BY THE CONTRACTOR PRIOR TO THE SCHEDULED ROAD OR RAMP CLOSURE IN ACCORDANCE WITH THE NOTICE OF CLOSURE TIME TABLE BELOW. [AT THE APPROVAL OF THE ENGINEER, PORTABLE CHANGEABLE MESSAGE SIGNS MAY BE USED IN LIEU OF THE STANDARD FLATSHEET SIGN FOR CLOSURE DURATIONS OF LESS THAN 1 WEEK.]

THE SIGNS SHALL BE ERECTED ON THE RIGHT-HAND SIDE OF THE ROAD/RAMP FACING TRAFFIC. THEY SHALL BE PLACED SO AS NOT TO INTERFERE WITH THE VISIBILITY OF ANY OTHER TRAFFIC CONTROL SIGNS. ON ROADWAYS, THEY SHOULD BE ERECTED AT OR NEAR THE POINT OF CLOSURE. THE SIGNS MAY BE ERECTED ANYWHERE ON RAMPS AS LONG AS THEY ARE VISIBLE TO THE MOTORISTS USING THE RAMP. ON ENTRANCE RAMPS, THE SIGN SHALL BE ERECTED WELL IN ADVANCE OF THE MERGE AREA TO AVOID DISTRACTING MOTORISTS.

**NOTICE OF CLOSURE SIGN TIME TABLE**

ITEM	DURATION OF CLOSURE	SIGN DISPLAYED TO PUBLIC
RAMP &	>=2 WEEKS	14 CALENDAR DAYS PRIOR TO CLOSURE
ROAD	> 12 HOURS & < 2 WEEKS	7 CALENDAR DAYS PRIOR TO CLOSURE
CLOSURES < 12 HOURS		2 BUSINESS DAYS PRIOR TO CLOSURE

THE SIGN SHALL DISPLAY THE DATE OF THE CLOSURE IN MMM-DD FORMAT AND THE NUMBER OF DAYS OF THE CLOSURE. THE LAST LINE OF THE W20-H13 SIGN LISTS A PHONE NUMBER WHICH A MOTORIST MAY CALL FOR ADDITIONAL INFORMATION. THIS IS TO BE A SPECIFIC OFFICE WITHIN THE DISTRICT RATHER THAN THE GENERAL SWITCHBOARD NUMBER.

**DETOUR FOR ROAD CLOSURE**

BEFORE DETOURING TRAFFIC, THE CONTRACTOR SHALL NOTIFY, IN WRITING, THE PROJECT ENGINEER, HIGHWAY MANAGEMENT ADMINISTRATOR AT THE OHIO DEPARTMENT OF TRANSPORTATION, DISTRICT 2, AND WOOD COUNTY ENGINEER TWENTY-ONE (21) WORKING DAYS IN ADVANCE PRIOR TO THE CLOSING TO NOTIFY THE PUBLIC AND ERECT DETOUR SIGNING.

DETOUR ROUTE FOR SOUTHBOUND WAYNE RD/ EASTBOUND US-6

1. EASTBOUND ON S. RIVER RD TO PEMBERVILLE RD
2. SOUTHBOUND ON PEMBERVILLE RD TO US-6

DETOUR ROUTE FOR SOUTHBOUND WAYNE RD/ WESTBOUND US-6

1. WESTBOUND ON S. RIVER RD TO ROCHESTER RD
2. SOUTHBOUND ON ROCHESTER RD TO US-6

DETOUR ROUTE FOR NORTHBOUND WAYNE RD/ EASTBOUND US-6

1. EASTBOUND ON HOLCOMB RD TO PEMBERVILLE RD
2. NORTHBOUND ON PEMBERVILLE RD TO US-6

DETOUR ROUTE FOR NORTHBOUND WAYNE RD/ WESTBOUND US-6

1. WESTBOUND ON HOLCOMB RD TO SR-199
2. NORTHBOUND ON SR-199 TO US-6

I:\ProjectData\W00\10242\W00-6-2\04\Design\Roadway\Sheets\10242\_MN001.dgn 16-MAR-2020 3:49PM mForkas

CALCULATED  
 MJF  
 CHECKED  
 DAR

MAINTENANCE OF TRAFFIC GENERAL NOTES

WOO-6-21.02

SHEET NUM.										PART.		ALT (X)	ITEM	ITEM EXT	GRAND TOTAL	UNIT	DESCRIPTION	SEE SHEET NO.
6	8	10	12	15	21	01/NHS/PV	02/NHS/BR											
<b>ROADWAY</b>																		
		50				50		202	23000	50	SY	PAVEMENT REMOVED						
		1012					1012	202	23010	1,012	SY	PAVEMENT REMOVED, ASPHALT						
			220				220	202	38000	220	FT	GUARDRAIL REMOVED						
			3				3	202	42000	3	EACH	ANCHOR ASSEMBLY REMOVED, TYPE A						
			1				1	202	42040	1	EACH	ANCHOR ASSEMBLY REMOVED, TYPE T						
		283					283	203	10000	283	CY	EXCAVATION						
		930					930	204	10000	930	SY	SUBGRADE COMPACTION						
							490	204	20000	490	CY	EMBANKMENT						
		9				9		209	60500	9	MILE	LINEAR GRADING						
<b>EROSION CONTROL</b>																		
							14	659	00300	14	CY	TOPSOIL						
							1000	659	10000	1,000	SY	SEEDING AND MULCHING						
							0.2	659	20000	0.2	TON	COMMERCIAL FERTILIZER						
							8	659	35000	8	MGAL	WATER						
							1000	832	30000	1,000	EACH	EROSION CONTROL						
<b>DRAINAGE</b>																		
					194		194	611	04400	194	FT	12" CONDUIT, TYPE B						
					147		147	611	05900	147	FT	15" CONDUIT, TYPE B						
					72		72	611	07400	72	FT	18" CONDUIT, TYPE B						
					65		65	611	10400	65	FT	24" CONDUIT, TYPE B						
					5		5	611	98510	5	EACH	CATCH BASIN, NO. 2-3						
<b>PAVEMENT</b>																		
1085						1085		253	01000	1,085	SY	PAVEMENT REPAIR						
		81635				81635		254	01000	81,635	SY	PAVEMENT PLANING, ASPHALT CONCRETE						
		296				296		301	46000	296	CY	ASPHALT CONCRETE BASE, PG64-22						
		183				183		304	20000	183	CY	AGGREGATE BASE						
		11431				11431		407	20000	11,431	GAL	NON-TRACKING TACK COAT						
		3407				3407		442	10000	3,407	CY	ASPHALT CONCRETE SURFACE COURSE, 12.5 MM, TYPE A (446)						
		3970				3970		442	10100	3,970	CY	ASPHALT CONCRETE INTERMEDIATE COURSE, 19 MM, TYPE A (446)						
		916				916		617	10100	916	CY	COMPACTED AGGREGATE						
						8.68		618	41000	8.68	MILE	RUMBLE STRIPES, EDGE LINE (ASPHALT CONCRETE)						
						4.34		618	43000	4.34	MILE	RUMBLE STRIPES, CENTER LINE (ASPHALT CONCRETE)						
						22861		874	20000	22,861	FT	LONGITUDINAL JOINT PREPARATION						
<b>TRAFFIC CONTROL</b>																		
302						302		621	00100	302	EACH	RPM						
63						63		621	54000	63	EACH	RAISED PAVEMENT MARKER REMOVED						
8.68						8.68		642	00104	8.68	MILE	EDGE LINE, 6", TYPE 1						
8.68						8.68		642	00300	8.68	MILE	CENTER LINE, TYPE 1						
77						77		644	00500	77	FT	STOP LINE						
				2		2		644	01000	2	EACH	RAILROAD SYMBOL MARKING						
<b>STRUCTURE 20 FOOT SPAN AND UNDER (WOO-6-2225)</b>																		
							LS	202	11000	LS		STRUCTURE REMOVED						
							LS	208	14001	LS		VIBRATION CONTROL AND MONITORING, AS PER PLAN						
							LS	503	11100	LS		COFFERDAMS AND EXCAVATION BRACING						
							LS	503	21300	LS		UNCLASSIFIED EXCAVATION						
					13354		13354	509	10000	13,354	LB	EPOXY COATED REINFORCING STEEL						
					128		128	511	46210	128	CY	CLASS QC1 CONCRETE, RETAINING/WINGWALL INCLUDING FOOTING						
					108		108	512	10050	108	SY	SEALING OF CONCRETE SURFACES (NON-EPOXY)						
					312		312	512	33000	312	SY	TYPE 2 WATERPROOFING						
					48		48	516	13600	48	SF	1" PREFORMED EXPANSION JOINT FILLER						
							LS	518	21230	LS		POROUS BACKFILL WITH GEOTEXTILE FABRIC						
					88		88	611	96200	88	FT	12' X 10' CONDUIT, TYPE A, 706.05						
<b>MAINTENANCE OF TRAFFIC</b>																		
	28					28		614	12460	28	EACH	WORK ZONE MARKING SIGN						
	5					5		614	12500	5	EACH	REPLACEMENT SIGN						
	5					5		614	12600	5	EACH	REPLACEMENT DRUM						
	15					15		614	21000	15	MILE	WORK ZONE CENTER LINE, CLASS I						
<b>INCIDENTALS</b>																		
							LS	614	11000	LS		MAINTAINING TRAFFIC						
							LS	623	10000	LS		CONSTRUCTION LAYOUT STAKES AND SURVEYING						
							LS	624	10000	LS		MOBILIZATION						

GENERAL SUMMARY

WOO-6-21.02

I:\Project\0242\WOO-6-21.04\Design\Roadway\Sheets\0242\_G000.dgn 16-MAR-2020 4:39PM mfarakas

I:\ProjectData\W00\10242\_W00-6-21.04\_Design\Roadway\Sheets\10242\_G5001.dgn 16-MAR-2020 3:08PM mFarKas

STATION RANGE	DISTANCE (D)	AVERAGE WIDTH (W)	CADD GENERATED AREA	254	407	407	442	442	617	209	204	301	304	202	203	203		
				PAVEMENT PLANING, ASPHALT CONCRETE, 3 1/4" THICKNESS	NON-TRACKING TACK COAT, FOR INTERMEDIATE COURSE (0.085 GAL/SQ YD)	NON-TRACKING TACK COAT, FOR SURFACE COURSE (0.055 GAL/SQ YD)	ASPHALT CONCRETE INTERMEDIATE COURSE, 19 MM, TYPE A (446)	ASPHALT CONCRETE SURFACE COURSE, 12.5 MM, TYPE A (446)	COMPACTED AGGREGATE	LINEAR GRADING	SUBGRADE COMPACTION	ASPHALT CONCRETE BASE, PG64-22	AGGREGATE BASE	PAVEMENT REMOVED, ASPHALT	EXCAVATION	EMBANKMENT		
	FT	FT	SY	SY	GAL	GAL	CY	CY	CY	MILE	SY	CY	CY	SY	CY	CY		
<b>US-6 MAINLINE</b>																		
1110+11.00		1171+50.00	6139.00	31.76	21661.00	21661.00	1841.19	1191.36	1052.97	902.54	246.32	2.33						
1173+00.00		1274+52.00	10152.00	31.74	35807.00	35807.00	3043.60	1969.39	1740.62	1491.96	407.33	3.85						
1275+22.00		1339+00.00	6378.00	32.00	22679.00	22679.00	1927.72	1247.35	1102.45	944.96	255.91	2.42						
<b>STRUCTURE NO. WOO-6-2225</b>																		
1171+50.00		1173+00.00	150.00	60.72	1012.00	1012.00	86.02	55.66	49.19	42.17	6.02	0.06	930.00	281.11	168.67	1012.00	283.00	490.00
<b>SUBTOTALS</b>				81159.00	6898.52	4463.75	3945.23	3381.63	915.58	8.64	930.00	281.11	168.67	1012.00	283.00	490.00		
<b>TOTALS CARRIED TO GENERAL SUMMARY</b>				81159	6899	4464	3946	3382	916	9	930	282	169	1012	283.00	490		
<b>INTERSECTIONS</b>																		
WAYNE RD (SEE STRUCTURE)																		
BECK RD	130.00	13.64	197.00	197.00	16.75	10.84	9.58	8.21										
PEMBERVILLE RD	86.00	20.30	194.00	194.00	16.49	10.67	9.43	8.08										
BRADNER RD / SR281	180.00	4.25	85.00	85.00	7.23	4.68	4.13	3.54										
DRIVEWAY STATION 1170+40	28.00	26.36	82.00					5.00				12.00	14.00	50.00	20.00			
<b>SUBTOTALS</b>				476.00	40.46	26.18	23.14	24.83				12.00	14.00	50.00	20.00			
<b>TOTALS CARRIED TO GENERAL SUMMARY</b>				476	41	27	24	25				12	14	50	20			