
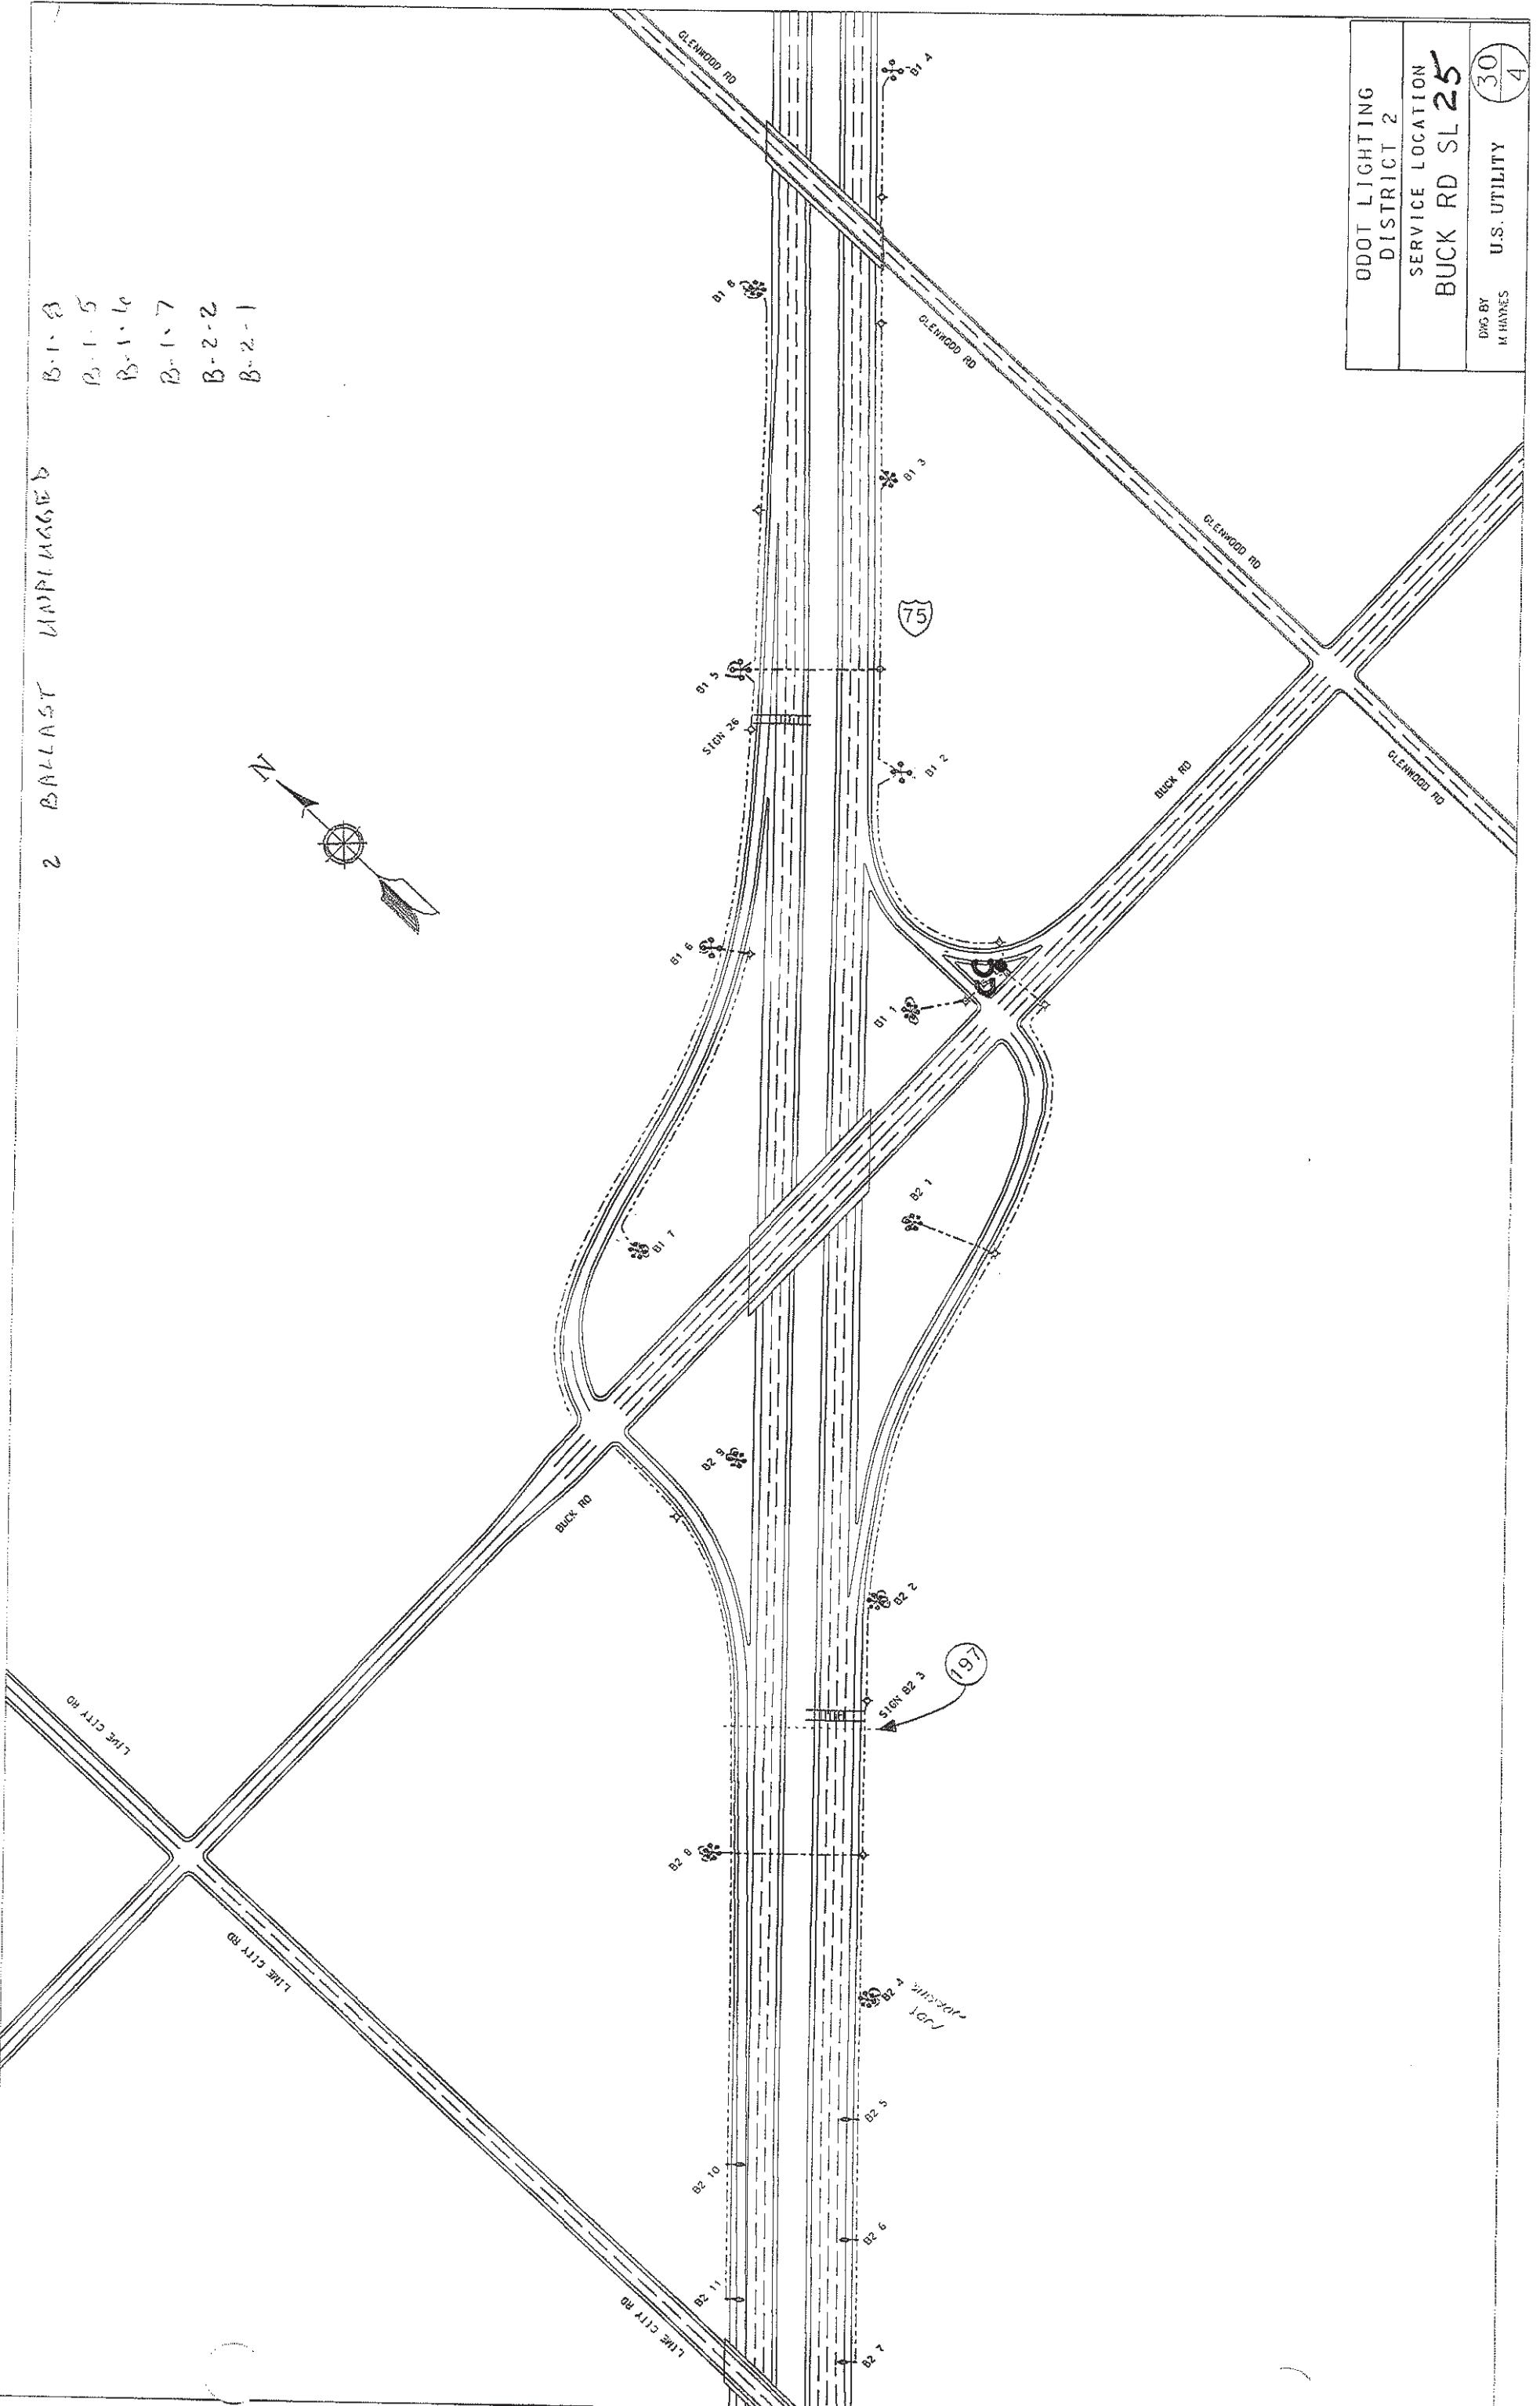



2 BALLAST UNPLUGGED

- B-1-8
- B-1-5
- B-1-6
- B-1-7
- B-2-2
- B-2-1

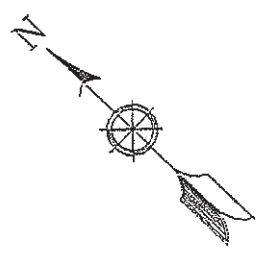

ODOT LIGHTING DISTRICT 2	30 4
SERVICE LOCATION BUCK RD SL 25	
DES BY M. HAYNES	U.S. UTILITY


207
364


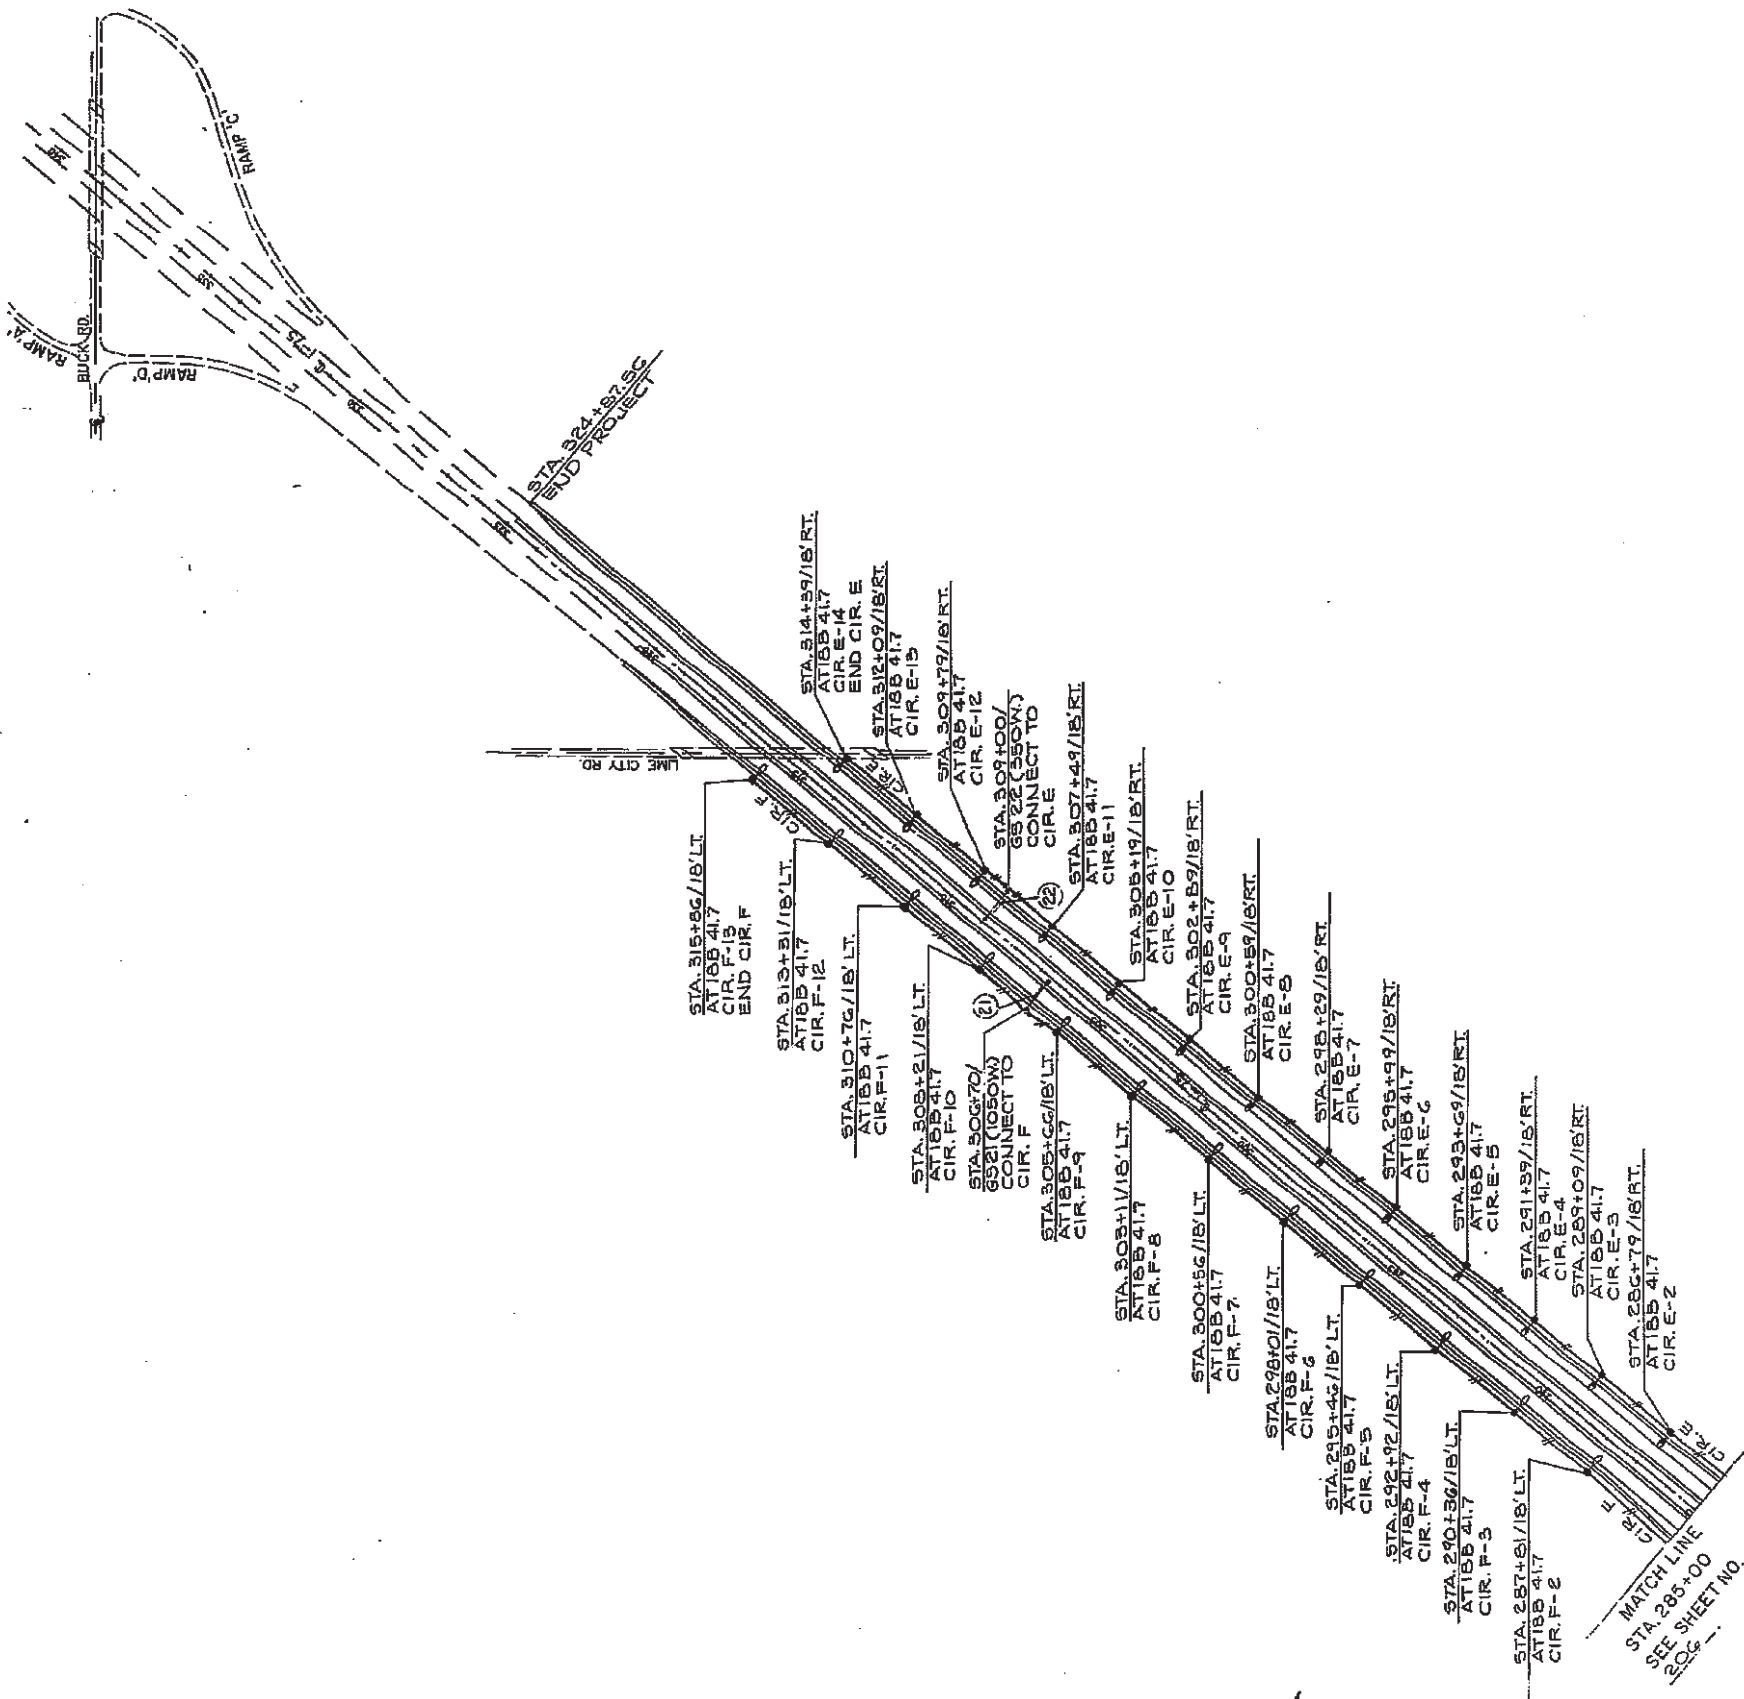


LEGEND PHASE II
 ○— LUMINAIRE, STYLE C, 310W. H.P.S. TYPE II, 41.7' M.H.
 ○— LUMINAIRE, STYLE C, 310W H.P.S. TYPE III, 41.7' M.H.



URS	
OHIO TURNPIKE COMMISSION	
LIGHTING SCHEMATIC PLAN	
5626	
DATE: 2/90	SCALE: AS SHOWN
CIP: 55-90-03	SHEET 207 OF 364

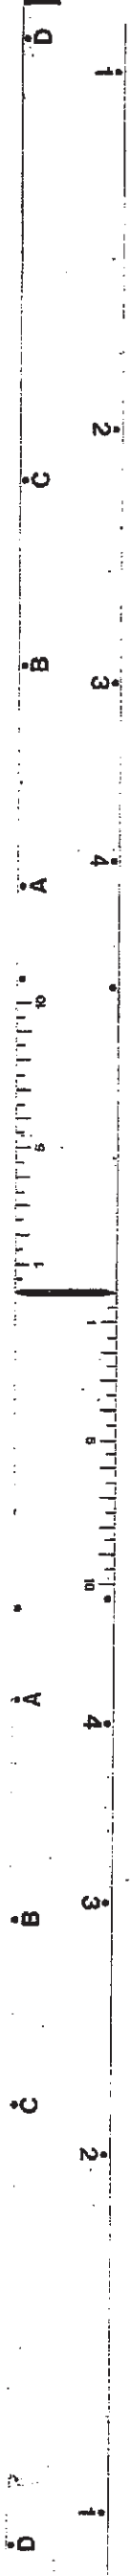

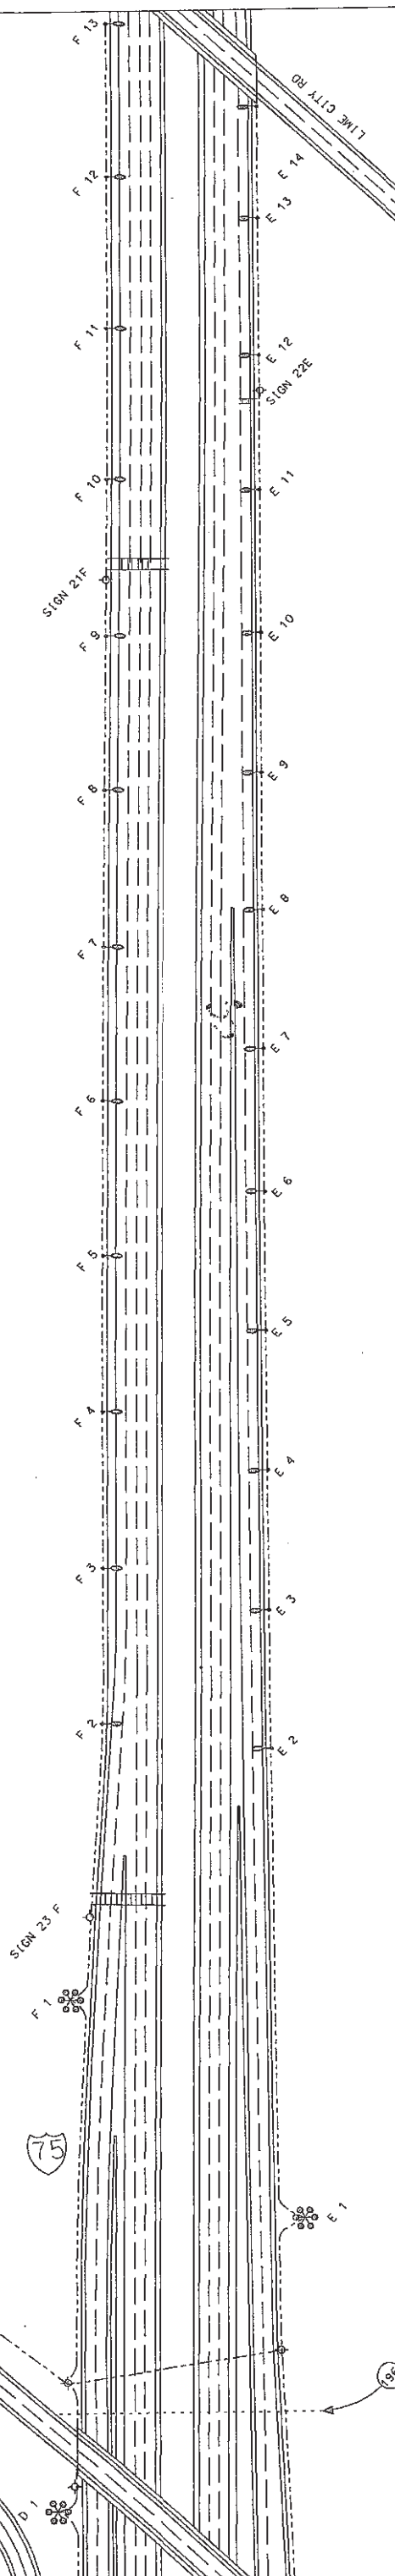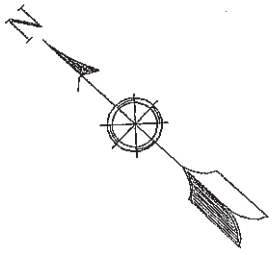

NORTH

DDOT LIGHTING DISTRICT 2
SERVICE LOCATION BATES RD SL 26
DWG BY M HAYNES
U.S. UTILITY
31 1



BATES RD

MANDELL RD

MANDELL RD

156