

STATE OF OHIO
DEPARTMENT OF TRANSPORTATION
EAST WYANDOT AVENUE
CITY OF UPPER SANDUSKY
WYANDOT COUNTY, OHIO

PROJECT DESCRIPTION

RESURFACING OF 0.75 MILES ON EAST WYANDOT AVENUE FROM DEGRADATION.


MAINTENANCE: CONSTRUCTION
PROJECT EARTH DISTURBED AREA: 0 ACRES
ESTIMATING CONTRACTOR EDA: 0 ACRES
NOTICE OF INTENT EDA: 0 ACRES

2023 SPECIFICATIONS

THE STANDARD SPECIFICATIONS OF THE STATE OF OHIO, DEPARTMENT OF TRANSPORTATION, INCLUDING CHANGES AND SUPPLEMENTAL SPECIFICATIONS LISTED IN THE PROPOSAL SHALL GOVERN THIS IMPROVEMENT.

MAINTENANCE OF TRAFFIC ENDORSEMENT

I HEREBY APPROVE THESE PLANS AND DECLARE THAT THE MAKING OF THIS IMPROVEMENT WILL NOT REQUIRE THE CLOSING TO TRAFFIC OF THE HIGHWAY AND THAT PROVISION FOR THE MAINTENANCE AND SAFETY OF TRAFFIC WILL BE AS SET FORTH ON THE PLANS AND ESTIMATES.

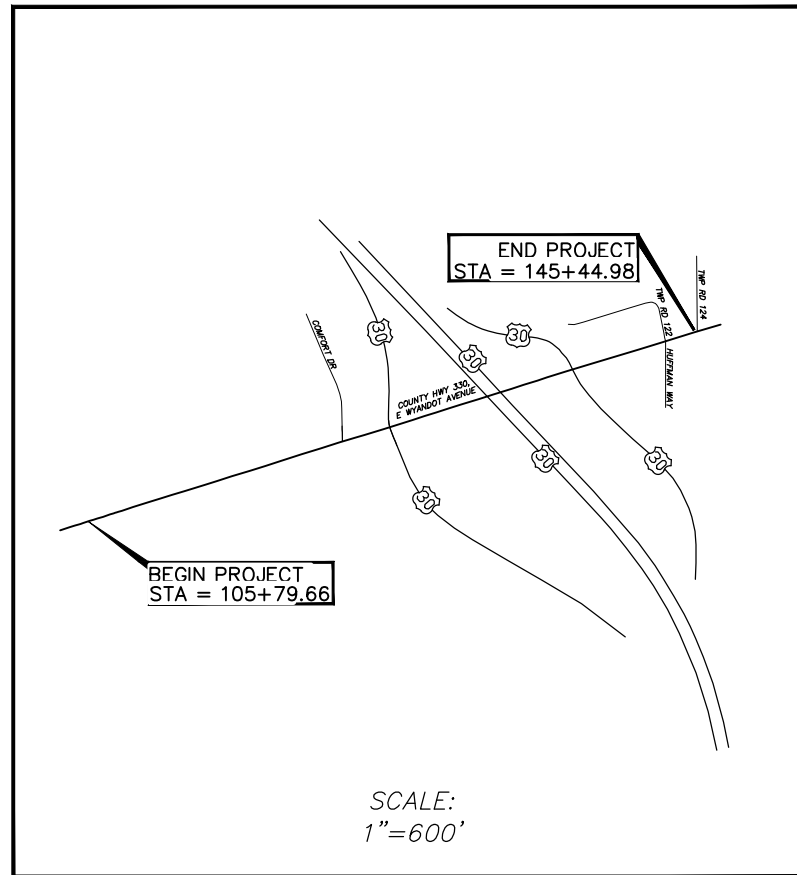

SCALE:
1"=600'

LOCATION MAP

LATITUDE 40° 49' 48" LONGITUDE -83° 15' 00"



PORTION TO BE IMPROVED
STATE & FEDERAL ROUTES
OTHER ROADS

DESIGN DESIGNATION

CURRENT ADT (2025) 9300
DESIGN YEAR ADT (2045) 10200
DESIGN HOURLY VOLUME (2045) 1200
DIRECTIONAL DISTRIBUTION 53%
TRUCKS (24 HOUR B&C) 14%
DESIGN SPEED 50 MPH WEST OF US 30
55 MPH EAST OF US 30
LEGAL SPEED 45 MPH WEST OF US 30
50 MPH EAST OF US 30

DESIGN FUNCTIONAL CLASSIFICATION - MINOR ARTERIAL/MAJOR COLLECTOR

DESIGN EXCEPTIONS: NONE REQUIRED

RAILROAD INVOLVEMENT: NONE

UNDERGROUND UTILITIES
CONTACT BOTH SERVICES
CALL TWO WORKING DAYS
BEFORE YOU DIG

CALL
1-800-362-2764
(TOLL FREE)

OHIO UTILITIES PROTECTION SERVICE
NON-MEMBERS
MUST BE CALLED DIRECTLY

OIL & GAS PRODUCERS PROTECTIVE
SERVICE CALL: 1-800-925-0988

ENGINEER'S SEAL



SIGNED: *[Signature]*
DATE: 11-25-2024

PLAN PREPARED BY:
BRANDSTETTER CARROLL, INC.
308 EAST EIGHTH STREET
CINCINNATI, OHIO 45202
BCI - PROJECT # 22071

INDEX OF SHEETS

TITLE SHEET 1
SCHEMATIC PLAN 2
TYPICAL SECTION 3
GENERAL NOTES 4
MAINTENANCE OF TRAFFIC NOTES 5
MAINTENANCE OF TRAFFIC PLANS 6-11
GENERAL SUMMARY 12-13
ROADWAY SUBSUMMARY 14
PLAN SHEETS 15-19
SIGNING SUB SUMMARY 20
PAVEMENT MARKINGS SUB SUMMARIES 21-22
SIGNING & MARKING PLANS 23-26

I HEREBY APPROVE THESE PLANS AND DECLARE THAT THE MAKING OF THIS IMPROVEMENT WILL NOT REQUIRE THE CLOSING TO TRAFFIC OF THE HIGHWAY AND THAT PROVISIONS FOR THE MAINTENANCE AND SAFETY OF TRAFFIC WILL BE SET FORTH ON THE PLANS AND ESTIMATES.

[Signature]

CHRISTOPHER A. HUGHES, P.E.
DISTRICT 01 DEPUTY DIRECTOR

[Signature]

PAMELA BORATYN
DIRECTOR, DEPARTMENT OF
TRANSPORTATION

STANDARD CONSTRUCTION DRAWINGS

TC-41.20	10-18-2013	TC-65.11	01-19-2024
TC-41.30	04-21-2023	TC-71.10	04-21-2023
TC-41.40	10-18-2013	MT-95.31	07-19-2019
TC-42.20	10-18-2013	MT-95.32	04-19-2019
TC-52.10	10-18-2013	MT-95.60	04-19-2019
TC-52.20	01-15-2021	MT-95.61	04-19-2019
TC-64.10	07-21-2023	MT-97.12	01-20-2017
TC-65.10	01-17-2014	BP-05.10	07-15-2022

SUPPLEMENTAL SPECIFICATIONS

SS-800-2023	07-19-2024
SS-832-2023	07-19-2024

E220008

115788

CITY OF UPPER SANDUSKY,
WYANDOT COUNTY, OHIO

EAST WYANDOT AVENUE

1
26