



CUY-90-14.90

PID 77332/85531

APPENDIX EX-86

**BH-FY2006 Misc. Repairs 2/VAR
(Reference Document)**

State of Ohio
Department of Transportation
Jolene M. Molitoris, Director

**Innerbelt Bridge
Construction Contract Group 1 (CCG1)**


D12 - BH-FY2006 Misc. Repairs 2/Vario
 060205 PID - 78926
 Dist 12 4/19/2006

**D12 BH FY2006
 MISC REPAIRS 2**

**STATE OF OHIO
 DEPARTMENT OF TRANSPORTATION**

PROJECT DESCRIPTION

REPAIRS: BACKWALL,
 SIDEWALK, SLOPE, RAIL,
 OVERLAY REPLACEMENT,
 AND DECK PATCHING

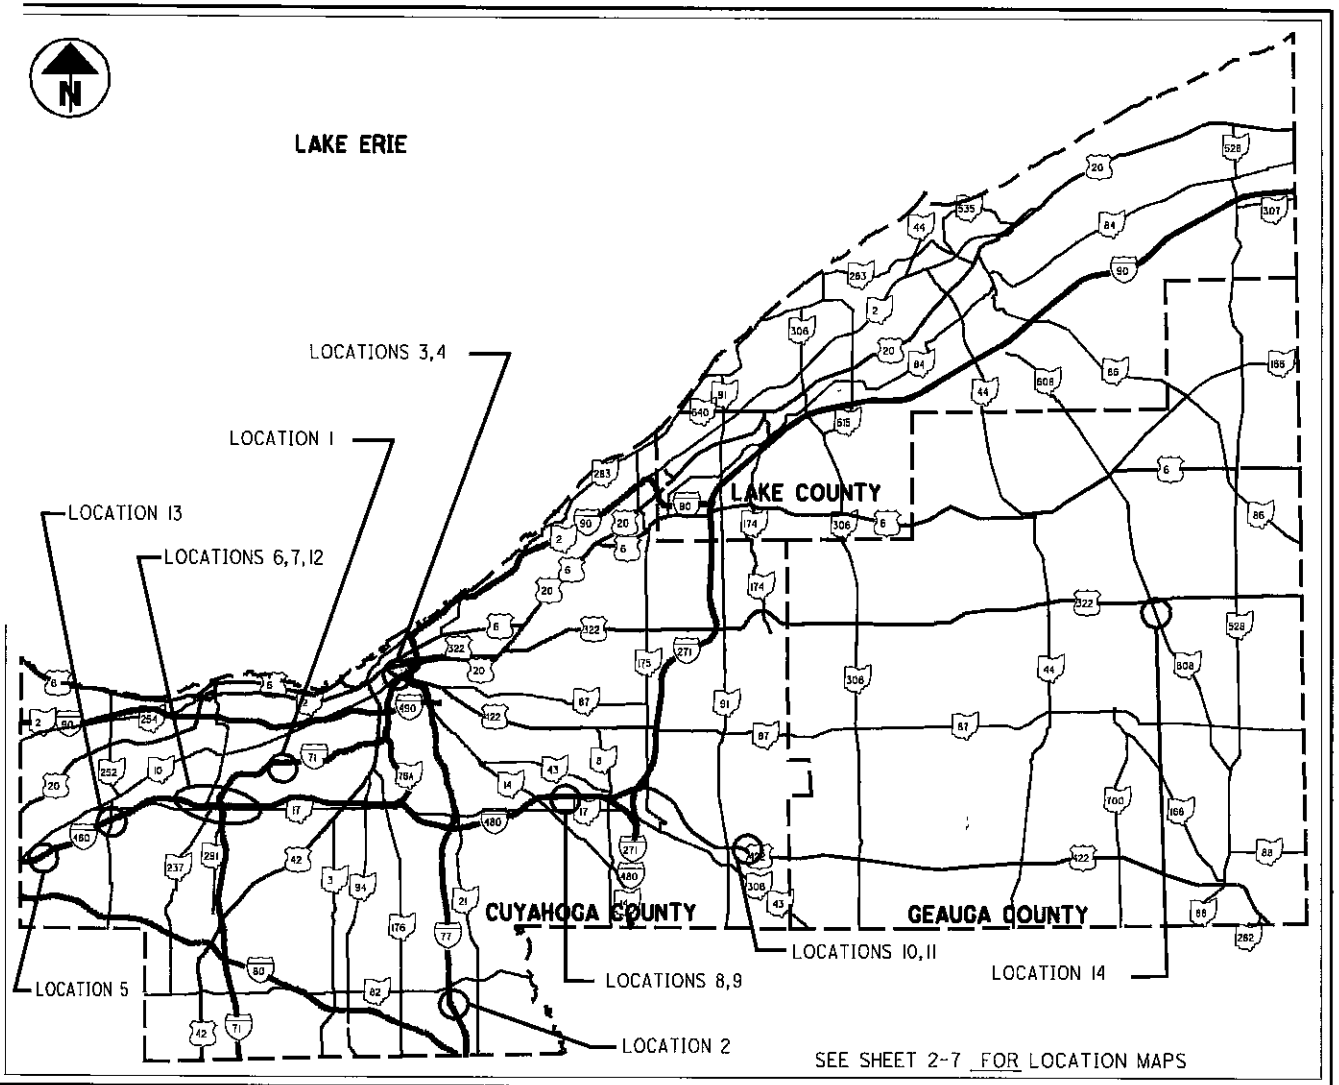

LOCATION	BRIDGE NUMBER	STRUCTURAL FILE NUMBER	CITY, TOWNSHIP, OR VILLAGE
1	CUY 71 1390	1805134	LINDALE VILL
2	CUY 77 0233	1805762	BRECKSVILLE CITY
3	CUY 90 1628R	1807714	CLEVELAND CITY
4	CUY 90 1651L	1807900	CLEVELAND
5	CUY 480 0074	1814001	NORTH OLMSTED CITY
6	CUY 480 0727	1814184	CLEVELAND
7	CUY 480 1075	1812912	CLEVELAND
8	CUY 422 2241	1813404	CLEVELAND
9	CUY 480 2344	1813625	WARRENSVILLE HTS CITY
10	CUY 422 1911L	1815172	OLON CITY
11	CUY 422 1911R	1815180	OLON
12	CUY 237 0695	1810286	BROOKPARK CITY
13	CUY 252 0434	1810405	NORTH OLMSTED
14	GEA 608 0710	2802252	CLARIDON TWP.

INDEX OF SHEETS

TITLE	1
LOCATION MAP	2-8
GENERAL NOTES	9-10
GENERAL SUMMARY	11-12
STRUCTURES	13-29
MAINTENANCE OF TRAFFIC	30-31

2005 SPECIFICATIONS

The standard specifications of the State of Ohio, Department of Transportation, including changes and supplemental specifications listed in the proposal shall govern this improvement

I hereby approve these plans and declare that the making of this improvement will not require the closing to traffic of the highway and that provisions for the maintenance and safety of traffic will be as set forth on plans and estimates

LOCATION 1 LATITUDE: N 4 26 44 LONGITUDE: W 81 45 58

THIS IS A MAINTENANCE PROJECT

PROJECT EARTH DISTURBED AREA = N/A (MAINT PROJECT)
 ESTIMATED CONTRACTOR EARTH DISTURBED AREA = N/A (MAINT PROJECT)
 NOTICE OF INTENT EARTH DISTURBED AREA = N/A (MAINT PROJECT)

UNDERGROUND UTILITIES
 TWO WORKING DAYS
BEFORE YOU DIG
 CALL 1-800-362-2764 (TOLL FREE)
 OHIO UTILITIES PROTECTION SERVICE
 NON-MEMBERS
 MUST BE CALLED DIRECTLY

PLAN PREPARED BY:
 ODOT - DISTRICT TWELVE
 PRODUCTION DEPARTMENT
 5500 TRANSPORTATION BLVD.
 GARFIELD HTS., OHIO 44125


P. E. STAMP	STANDARD CONSTRUCTION DRAWINGS				SUPPLEMENTAL SPECIFICATIONS	
	 SIGNED <i>James R. Calanni</i> DATE <i>1-20-06</i>	MT-35 10	04/20/01	DM-2.1	07/20/01	800
			EXJ-2-81	07/19/02	832	04/17/04
MT-95.30		07/16/04			833	02/12/03
MT-97.10		04/19/02	MT-96.10	04/19/02		
			MT-96.21	04/19/02		
MT-98 12		04/19/02	MT-96 25	04/20/01		
MT-98 13		04/19/02				
MT-98 14		04/19/02	BP-3 1	07/16/04		
MT-98.15		07/16/04				
MT-98 16		04/19/02				

Approved *[Signature]*
 Date *2-15-06* Dept. Director of Transportation


Approved *[Signature]*
 Date *2-15-06* Director, Department of Transportation

FEDERAL PROJECT NO: NONE
 CONSTRUCTION PROJECT NO: 78926
 RAILROAD INVOLVEMENT: NONE
 D12 BH FY2006 MISC. REPAIRS 2
 31

PROJECTS&P:78926@DGNBTL_78926.dgn 20-JAN-2006 10:59AM c:\p11\ts1

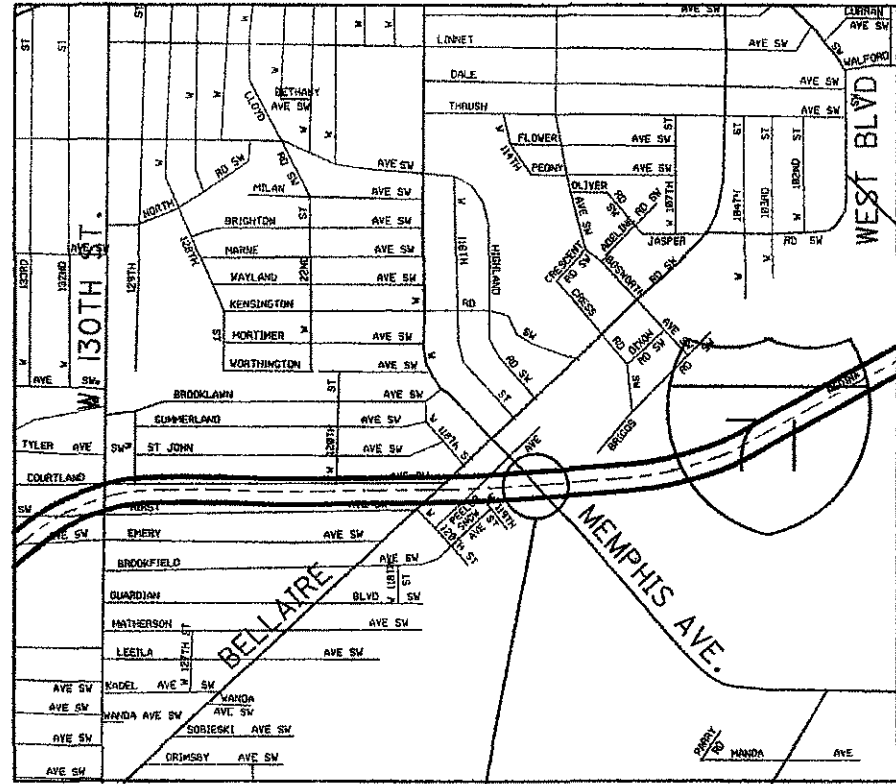

LOCATION 1
 CUY71-1390
 SFN: 1805134

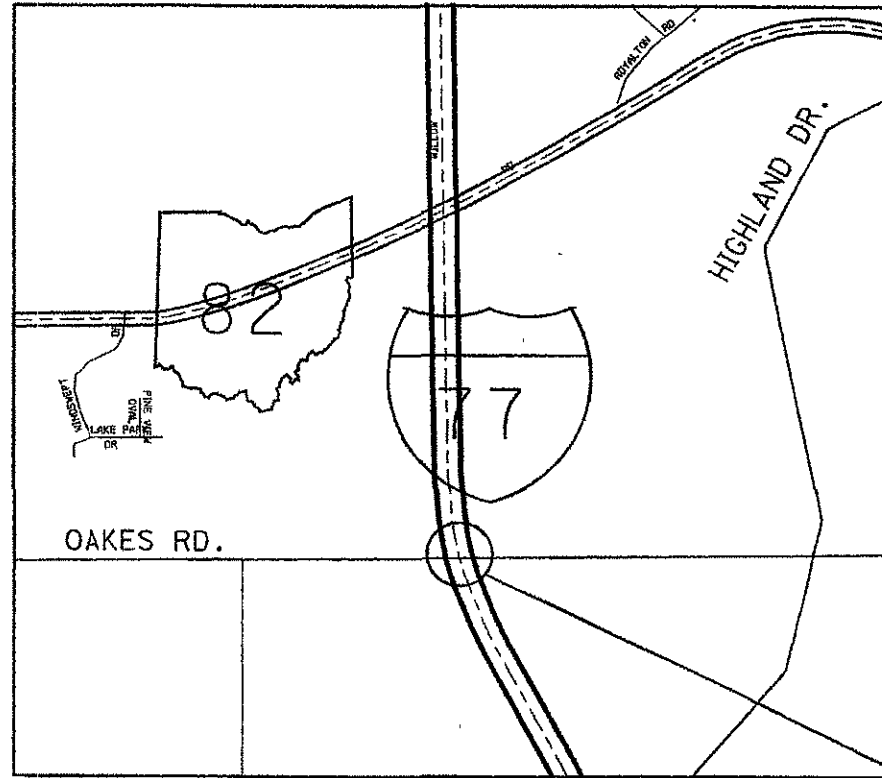

LOCATION 2
 CUY77-0223
 SFN: 1805762




HORIZONTAL
 SCALE IN FEET

CALCULATED
 CHECKED

LOCATION MAPS


D12 BH FY2006
 MISC. REPAIRS 2

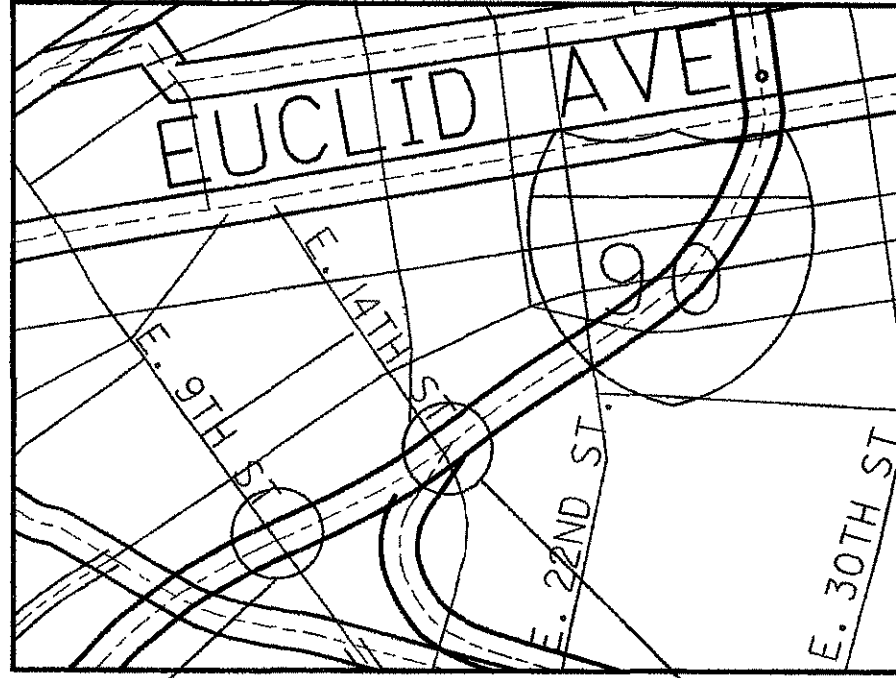

LOCATION 3
CUY90-1628R
SFN: 1807714


LOCATION 4
CUY90-1651L
SFN: 1807900



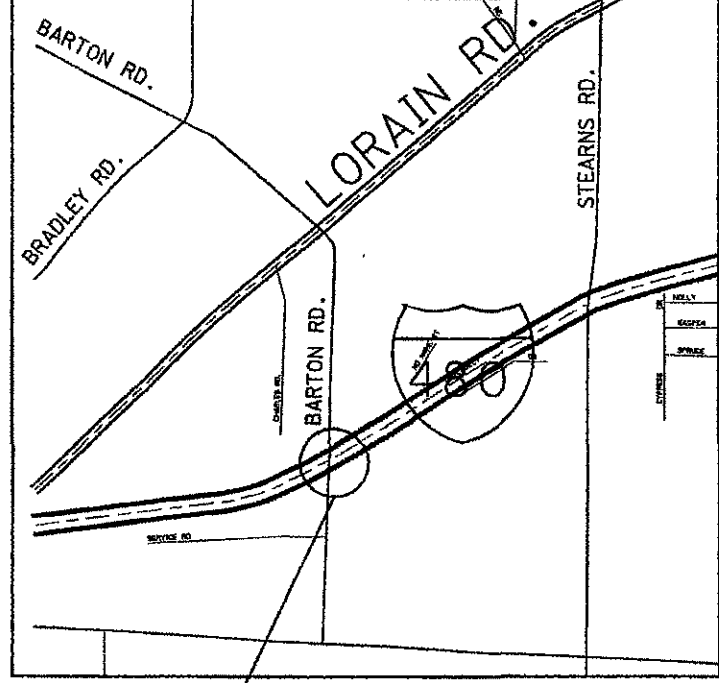

LOCATION 5
CUY480-0074
SFN: 1814001

LOCATION 13
CUY252-0434
SFN: 1810405

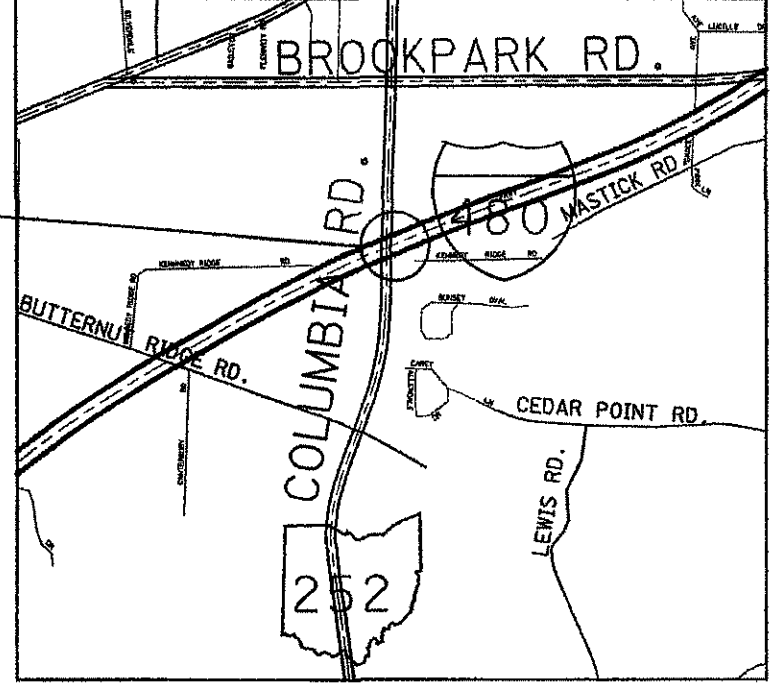


HORIZONTAL
SCALE IN FEET

CHECKED
DATE


LOCATION MAPS

D12 BH FY2006
MISC. REPAIRS 2


I:\PROJECTS\PI178926\DCN\Location Maps\CUY480\GRAYTON-CUY480.CSX-CUY237.SNOW.dgn 20-JAN-2006 2:04PM jthreac

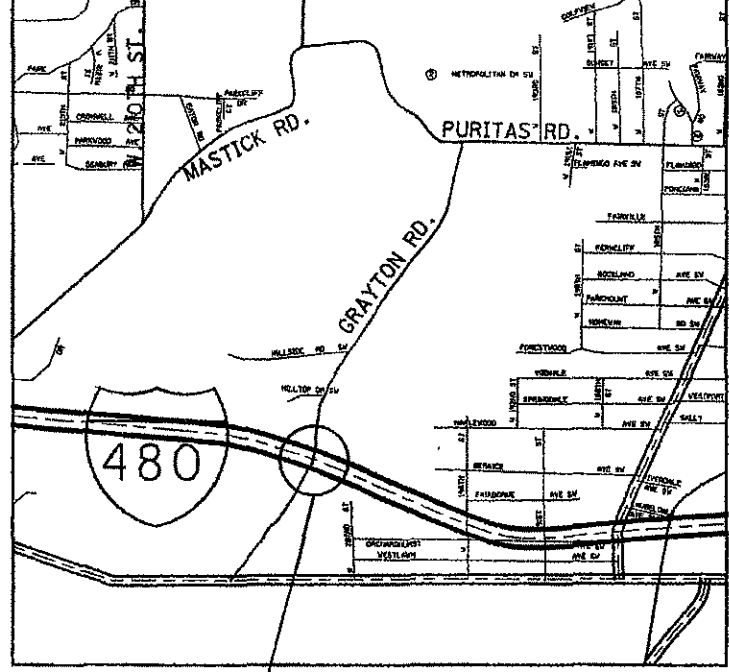

LOCATION 6
CUI480-0727
SFN: 1814184

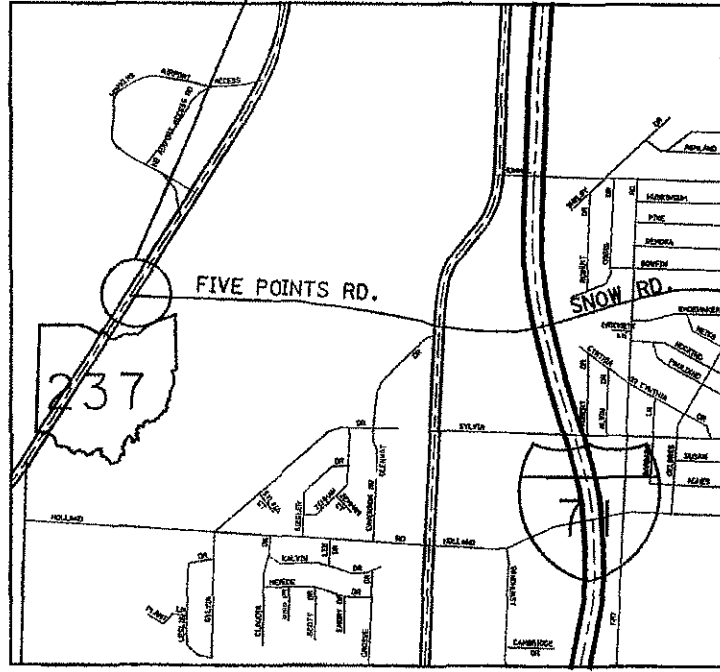

LOCATION 12
CUI237-0695
SFN: 1810286

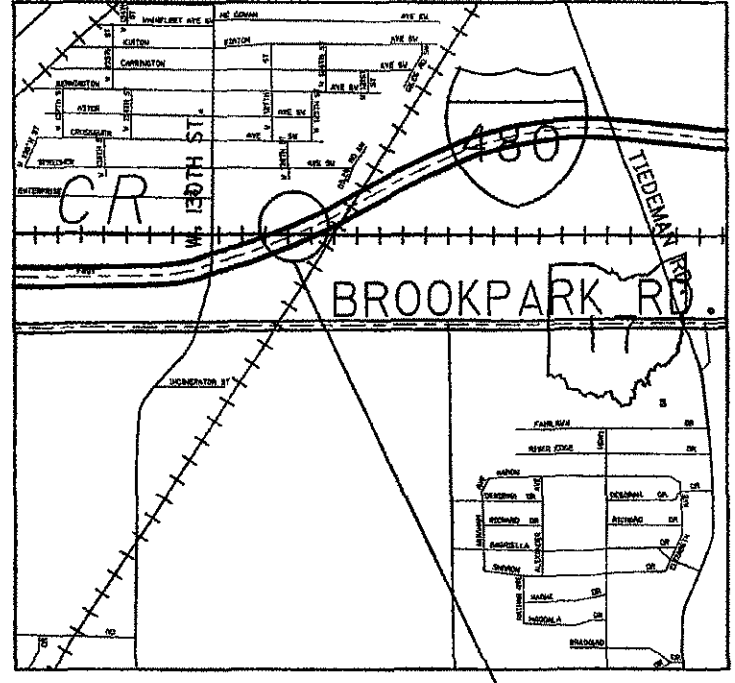

LOCATION 7
CUI480-1075
SFN: 1812912




HORIZONTAL
SCALE IN FEET

CALCULATED
CREATED


LOCATION MAPS


D12 BH FY2006
MISC. REPAIRS 2

LOCATION 8
CUY480-2241
SFN: 1813404

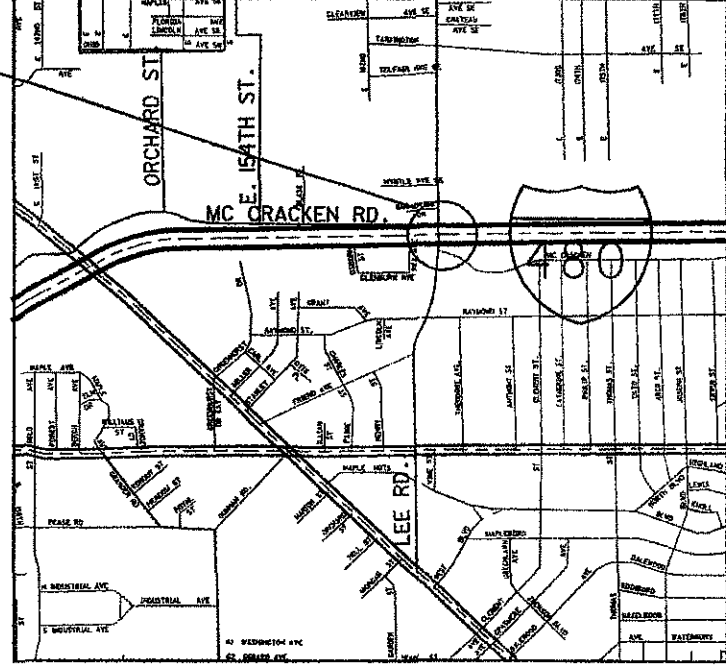

LOCATION 9
CUY480-2344
SFN: 1813625

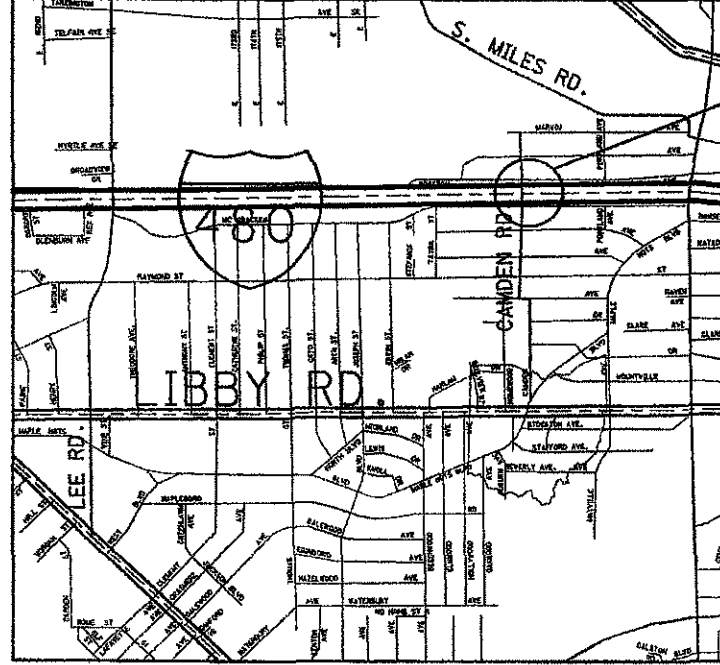

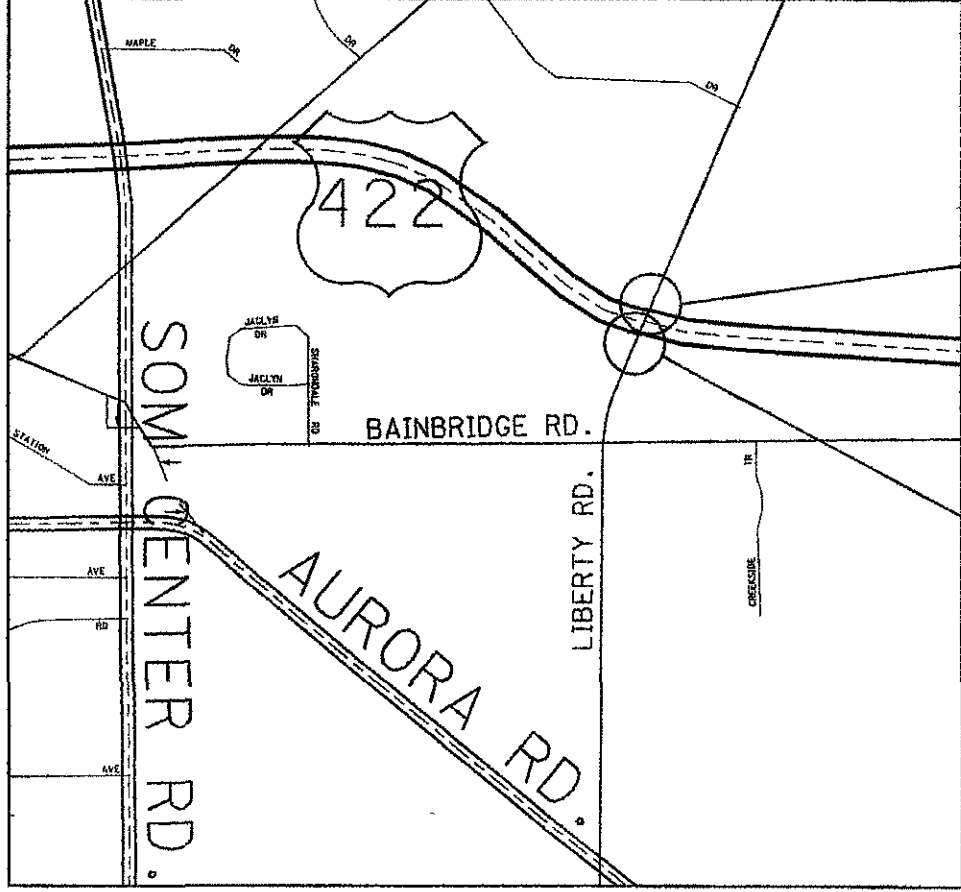

LOCATION 10
CUY422-1911L
SFN: 1815172

LOCATION 11
CUY422-1911R
SFN: 1815180




CALCULATED
CHECKED
HORIZONTAL
SCALE IN FEET

LOCATION MAP

D12 BH FY2006
MISC.REPAIRS 2

LOCATION 14
GEA608-0710
SFN: 2802252

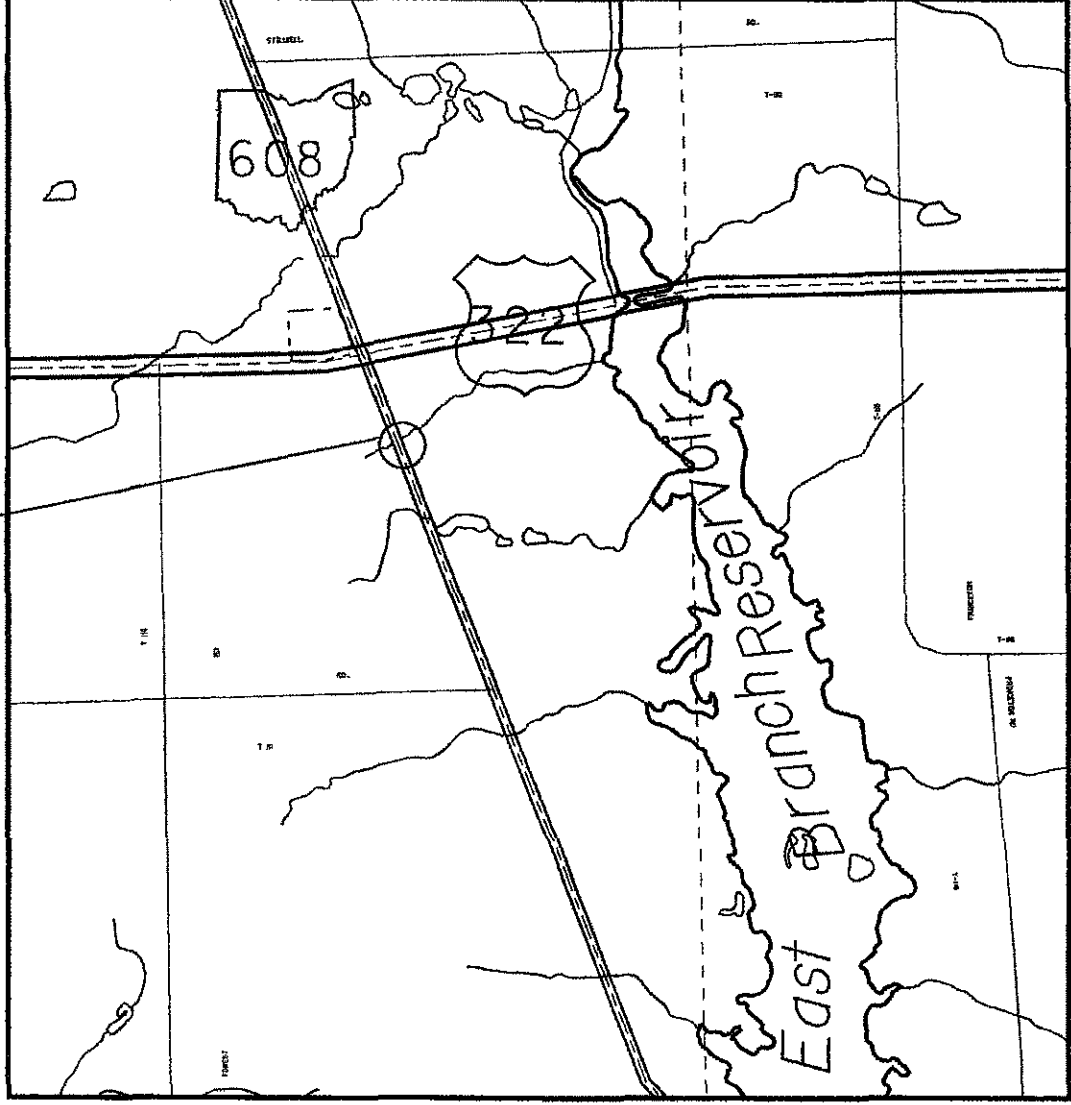

REFERENCE SHALL BE MADE TO STANDARD DRAWINGS:
LISTED ON THE TITLE SHEET

AND TO PROPOSAL NOTE
STEEL PRICE ADJUSTMENT
PATCHING CONCRETE BRIDGE DECKS- TYPE B

AND TO SUPPLEMENTAL SPECIFICATIONS:
LISTED ON THE TITLE SHEET.

EXISTING STRUCTURE VERIFICATION

DETAILS AND DIMENSIONS SHOWN ON THESE PLANS PERTAINING TO THE EXISTING STRUCTURE AND FROM PLANS OF THE EXISTING STRUCTURE AND FROM FIELD OBSERVATIONS AND MEASUREMENTS. CONSEQUENTLY, THEY ARE INDICATIVE OF THE EXISTING STRUCTURE AND THE PROPOSED WORK BUT THEY SHALL BE CONSIDERED TENTATIVE AND APPROXIMATE. THE CONTRACTOR IS REFERRED TO C.M.S. SECTIONS 102.05 AND 105.02. THE ORIGINAL CONSTRUCTION PLANS OF THE EXISTING BRIDGE ARE AVAILABLE UPON REQUEST AT THE DISTRICT 12 OFFICE OF THE OHIO DEPARTMENT OF TRANSPORTATION, GARFIELD HEIGHTS, OHIO. CONTRACT BID PRICES SHALL BE BASED UPON A RECOGNITION OF THE UNCERTAINTIES DESCRIBED ABOVE AND UPON A PRE-BID EXAMINATION OF THE EXISTING STRUCTURE BY THE CONTRACTOR. HOWEVER, ALL PROJECT WORK SHALL BE BASED ON ACTUAL DETAILS AND DIMENSIONS WHICH HAVE BEEN VERIFIED BY THE CONTRACTOR IN THE FIELD.

DESIGN SPECIFICATIONS:

THIS STRUCTURE CONFORMS TO "STANDARD SPECIFICATIONS FOR HIGHWAY BRIDGES" ADOPTED BY THE AMERICAN ASSOCIATION OF STATE HIGHWAY AND TRANSPORTATION OFFICIALS, 2002, AND THE ODOT BRIDGE DESIGN MANUAL.

LIMITATIONS OF OPERATIONS

SEE M.O.T. RESTRICTIONS

COOPERATION BETWEEN CONTRACTORS

THE CONTRACTOR SHALL COOPERATE AND COORDINATE HIS OPERATIONS WITH THE CONTRACTORS ON OTHER PROJECTS THAT MAY BE IN FORCE DURING THE LIFE OF THE CONTRACT. NO WAIVER OF ANY PROVISIONS OF 105.08 OF THE CONSTRUCTION AND MATERIALS SPECIFICATIONS IS INTENDED.

RIGHT OF WAY

ALL WORK WILL BE PERFORMED WITHIN THE EXISTING RIGHT OF WAY.

CONTINGENCY QUANTITIES

THE CONTRACTOR SHALL NOT ORDER MATERIALS OR PERFORM WORK FOR PLAN ITEMS SET UP TO BE USED "AS DIRECTED BY THE ENGINEER" UNLESS AUTHORIZED BY THE ENGINEER.

UTILITIES

THERE ARE KNOWN UTILITIES SHOWN IN THIS PLAN. THE UTILITIES ARE IN THE SIDEWALK OF LOCATIONS 1,2 6, AND 9. THE NATURE OF THE WORK REQUIRED BY THIS PROJECT WILL NOT AFFECT ANY KNOWN UTILITIES IN THIS PROJECT; HOWEVER IT IS NECESSARY THAT THE CONTRACTOR IS AWARE OF AND REMAINS WATCHFUL OF THE SIDEWALK PATCHING WORK.

RAILROAD CROSSING

CROSSING OF THE RAILROAD TRACKS IS PROHIBITED WITHOUT THE CONSENT OF THE CSX AUTHORITIES. ACCESS TO BOTH AND EITHER ABUTMENT BACKWALL SHALL OCCUR VIA EITHER ABUTMENT SIDE OF THE STRUCTURE ONLY.

DESCRIPTION OF WORK

1. PATCHING OF SIDEWALKS, BACKWALLS, CURBS, AND BRIDGE RAILINGS.
2. BRIDGE OVERLAY AND APPROACH SLAB PATCHING.
3. REPAIR OF STRUCTURAL STEEL EXPANSION JOINTS.
4. REPAIR OF COMPRESSION SEAL EXPANSION JOINTS.

ITEM 202 CONCRETE SLOPE PROTECTION REMOVED (LOCATION 8 BOTH ABUTMENTS)

THE CONTRACTOR SHALL REMOVE DETERIORATED PORTIONS OF CONCRETE SLOPE PROTECTION AS DIRECTED BY THE ENGINEER.

ITEM 202 FENCE REMOVED FOR REUSE (LOCATION 8 BOTH ABUTMENTS)

THE CONTRACTOR SHALL REMOVE AND REUSE PORTIONS OF CHAIN LINK FENCE AS NECESSARY TO EXECUTE SLOPE PROTECTION WORK UNDER BOTH THE EAST AND WEST ABUTMENTS.

ITEM 253 PAVEMENT REPAIR, AS PER PLAN (2") (LOCATION 1)

THIS ITEM SHALL BE USED TO REPAIR ASPHALT CONCRETE OVERLAYS ON APPROACH SLABS ONLY THAT HAVE POTHOLES AND OTHER PAVEMENT DISTRESSES AS DIRECTED BY THE ENGINEER. THE PAVEMENT REPAIR METHOD SHALL UTILIZE THE FOLLOWING ITEMS AND SHALL BE PAID FOR UNDER ITEM 253- PAVEMENT REPAIR 2", AS PER PLAN:

ITEM 254 - PAVEMENT PLANING, ASPHALT CONCRETE
ITEM 407 - TACK COAT
ITEM 448 - ASPHALT CONCRETE SURFACE COURSE, TYPE 1, PG64-22

THE EDGES OF THE REPAIR AREA SHALL BE SEALED WITH THE CRACK SEALING MATERIAL, TYPE II OR TYPE III CHOSEN FOR THIS PROJECT.

THE DEPTH OF PAVEMENT REPAIR SHALL BE 2" OR AS DIRECTED BY THE ENGINEER.

THE REPAIRS SHALL BE COMPLETED IN ONE DAY (I.E. NO OLD ASPHALT SHALL BE MILLED OR REMOVED AND OPENED TO TRAFFIC WITHOUT THE PROPOSED ASPHALT IN PLACE).

ALL ITEMS REFERENCED UNDER THIS PAY ITEM SHALL BE PAID FOR UNDER:

ITEM 253 - PAVEMENT REPAIR 2", AS PER PLAN.....20 SQ YD

ITEM 407 TACK COAT (LOCATION 14)

THE TACK COAT APPLICATION RATE IS .05 GAL PER SQUARE YARD AT THE INTERMEDIATE COAT/WATERPROOFING MATERIAL INTERFACE AND .10 GAL PER SQUARE YARD AT THE SURFACE COURSE/INTERMEDIATE COURSE INTERFACE.

ITEM 423 CRACK SEALING MISC.: TYPE II OR TYPE III (LOCATION 1)

THE CONTRACTOR HAS THE OPTION OF USING EITHER TYPE II OR TYPE III CRACK SEAL. THE CONTRACTOR SHALL SEAL ALL VISIBLE CRACKS OR AS DIRECTED BY THE ENGINEER.

PAYMENT WILL BE MADE AT THE CONTRACT UNIT BID PRICE PER SQUARE YARD INSTEAD OF THE UNIT BID PRICE PER POUND AS SHOWN IN CMS 423.

ITEM 512 PATCHING CONCRETE BRIDGE DECKS- TYPE B (LOCATION 13)

THE CONTRACTOR SHALL PATCH EXISTING DETERIORATED SECTIONS OF THE BRIDGE DECK AS DIRECTED BY THE ENGINEER.

ITEM 516 STRUCTURAL STEEL EXPANSION JOINT, AS PER PLAN (LOCATION 2)

THE CONTRACTOR SHALL REPLACE BOTH THE SEAL GLAND AND RETAINERS ON THE FOLLOWING STRUCTURE ON ALL ABUTMENTS: CUY-77-0223.

I:\PROJECTS\p1d78926\DCM\Location Maps\GNT8925.dgn 20-JAN-2006 2:27PM jhr:sof

CALCULATED
CHECKED

GENERAL NOTES

D12 BH FY2006
MISC. REPAIRS 2

9
31

EXPANSION JOINT GAP TABLES ARE PROVIDED ONLY FOR INFORMATION PURPOSES. THE VALUES LISTED ARE ANTICIPATED BASED ON THE AVAILABLE RECORD DATA. THE ACTUAL GAP SHALL BE FIELD MEASURED AT THE ACTUAL TEMPERATURE PRIOR TO THE MANUFACTURE OF JOINT COMPONENTS. IF THE MEASURED VALUES PRACTICALLY COMPARE TO THE GIVEN VALUES, THE RETAINERS AND STRIP SEAL SIZE AS GIVEN IN THE PLANS CAN BE USED. OTHERWISE, THESE SIZES SHALL BE ADJUSTED AS RECOMMENDED BY THE MANUFACTURER AND APPROVED BY THE ENGINEER. NO SEPARATE PAYMENT SHALL BE MADE FOR MEASUREMENT, ADJUSTMENT, WELDING, AND STEEL COMPONENTS, INCLUDING PLATES AND RETAINERS.

THE CONTRACTOR IS RESPONSIBLE FOR REPAIRING ANY CONCRETE OR ASPHALT THAT IS DAMAGED WHILE PERFORMING THIS ITEM. THE CONTRACTOR SHALL RESTORE THE DAMAGED CONCRETE AREAS AROUND THE EXPANSION JOINT WITH CMS 499.05 MS CONCRETE. THIS PORTION OF THE WORK WILL BE PAID FOR UNDER ITEM 519 PATCHING CONCRETE STRUCTURES, AS PER PLAN. THE CONTRACTOR SHALL RESTORE THE DAMAGED ASPHALT AREAS AROUND THE EXPANSION JOINT WITH MATERIAL APPROVED BY THE ENGINEER. BOTH THE CONCRETE AND ASPHALT REPAIRS SHALL BE AS DIRECTED BY THE ENGINEER.

THE CONTRACTOR SHALL SUBMIT TO THE PROJECT ENGINEER AS-BUILT DRAWINGS THAT SPECIFY THE SEAL GLAND MANUFACTURER, MODEL NUMBER, AND SIZE, AND RETAINER DIMENSIONS THAT WERE INSTALLED UNDER THIS ITEM.

ALL EQUIPMENT, MATERIAL, AND LABOR REQUIRED TO PERFORM THE WORK SPECIFIED IN THIS NOTE, EXCEPT CONCRETE REPAIR, AND IN THE CORRESPONDING PLAN SHEETS SHALL BE PAID FOR UNDER ITEM 516 STRUCTURAL STEEL EXPANSION JOINT, AS PER PLAN.

ITEM 516 ELASTOMERIC COMPRESSION SEAL (LOCATIONS 10,11, AND 12)

THE CONTRACTOR SHALL REPLACE THE COMPRESSION SEALS ON THE FOLLOWING STRUCTURES; CUY-237-0695 (S ABUT ONLY) CUY-422-1911L (BOTH ABUT); CUY-422-1911R (BOTH ABUT). SEE DETAIL ON SHEET NOS. 24 AND 26 FOR ADDITIONAL INFORMATION.

EXPANSION JOINT GAP TABLES ARE PROVIDED ONLY FOR INFORMATION PURPOSES. THE VALUES LISTED ARE ANTICIPATED BASED ON THE AVAILABLE RECORD DATA. THE ACTUAL GAP SHALL BE FIELD MEASURED AT THE ACTUAL TEMPERATURE PRIOR TO THE MANUFACTURE OF JOINT COMPONENTS. IF THE MEASURED VALUES PRACTICALLY COMPARE TO THE GIVEN VALUES, THE COMPRESSION SEAL SIZE AS GIVEN IN THE PLANS CAN BE USED. OTHERWISE, THESE SIZES SHALL BE ADJUSTED AS RECOMMENDED BY THE MANUFACTURER AND APPROVED BY THE ENGINEER. NO SEPARATE PAYMENT SHALL BE MADE FOR MEASUREMENT OR ADJUSTMENT.

ALL EQUIPMENT, MATERIAL, AND LABOR REQUIRED TO PERFORM THE WORK SPECIFIED IN THIS NOTE AND IN THE CORRESPONDING PLAN SHEETS SHALL BE PAID FOR UNDER ITEM 516 ELASTOMERIC COMPRESSION SEAL.

ITEM 519 PATCHING CONCRETE STRUCTURE (LOCATIONS 1,2,3,4,5,6,7, AND 9)

THIS ITEM SHALL BE PERFORMED AS DIRECTED BY THE ENGINEER. ALL RAILING PATCHING SHALL OCCUR ON SIDEWALK SIDE (VERTICAL FACE) OF THE STRUCTURE.

ITEM 519 PATCHING CONCRETE STRUCTURE, AS PER PLAN

THE CONTRACTOR SHALL USE CMS 499.05 MS CONCRETE FOR ALL CONCRETE REPAIRS ASSOCIATED WITH EXPANSION JOINT WORK INCLUDING ROADWAY REPAIR ON THE BRIDGE SURFACE AND BACKWALL REPAIR. PAYMENT WILL BE UNDER ITEM 519 PATCHING CONCRETE STRUCTURES, AS PER PLAN.

ITEM 601 CONCRETE SLOPE PROTECTION

THE CONTRACTOR SHALL SUPPLY NEW SLOPE PROTECTION IN LOCATIONS WHERE EXISTING DETERIORATED SLOPE PROTECTION WAS REMOVED AND DISPOSED, AS DIRECTED BY THE ENGINEER.

ITEM 610 PAVED GUTTER, TYPE 1-2

THE CONTRACTOR SHALL REPLACE THE REMOVED GUTTER. THE LOCATION IS AT THE FOOT OF THE WEST ABUTMENT CONCRETE SLOPE. SEE STANDARD CONSTRUCTION DRAWING DM-2.1. THIS ITEM SHALL BE PERFORMED AS DIRECTED BY THE ENGINEER.

I:\PROJECTS\PI\78926\06N\Location Maps\ONT8925.dgn 20-JAN-2006 2:27PM lthreac



CALCULATED
CHECKED

GENERAL NOTES

D12 BH FY2006
MISC. REPAIRS 2

10

I:\PROJECTS\PIG178926\DM\Cuy 711390 Memphis\CUY-TI-1390-SITEP.LANDGN 20-JAN-2006 2:43PM jthre:eat

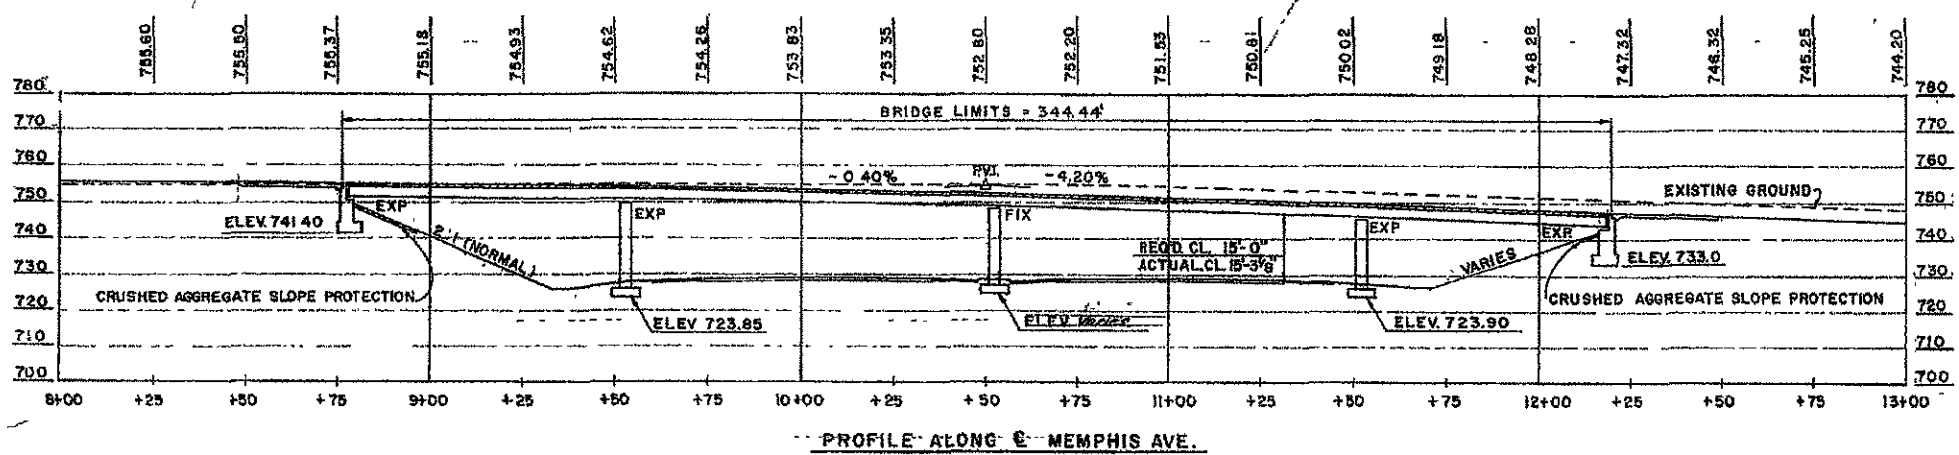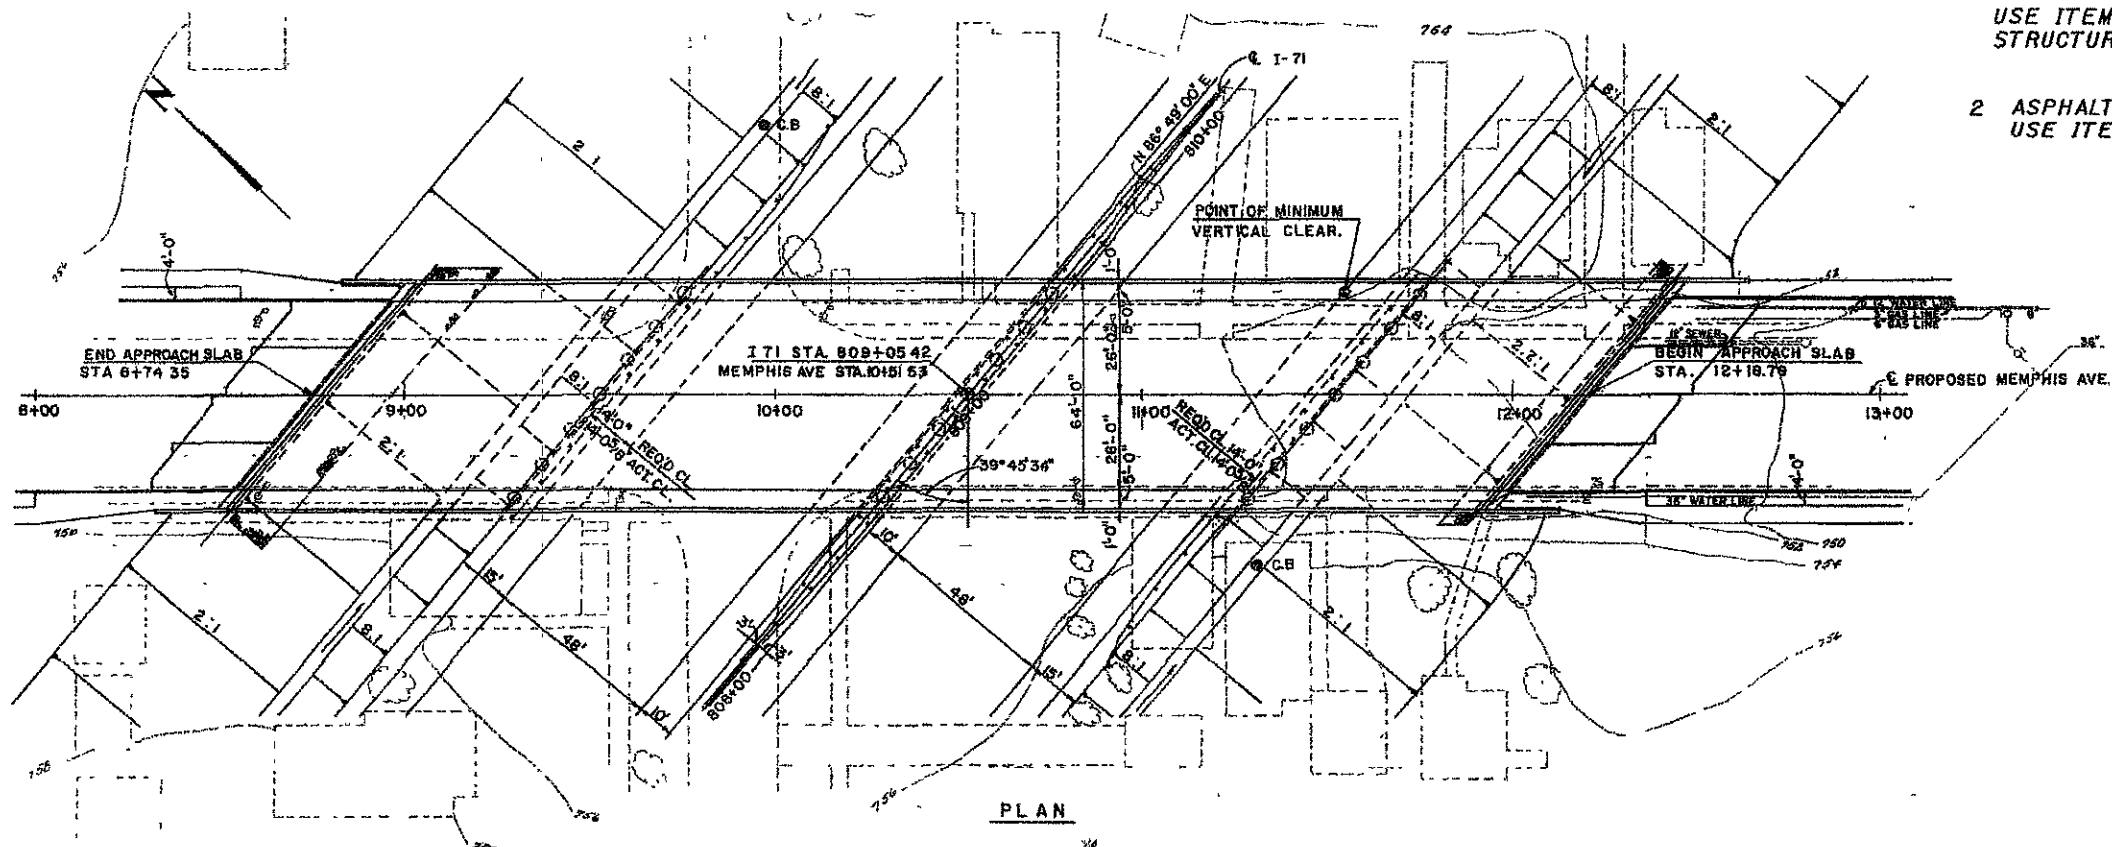

- PROPOSED WORK**
- 1 PATCHING: BACKWALL, RAILING, SIDEWALK, CURB
USE ITEM 519 PATCHING CONCRETE
STRUCTURE
 - 2 ASPHALT PATCHING ON OVERLAY
USE ITEMS 253, 423

EXISTING STRUCTURE

TYPE: Continuous welded steel girder with reinforced concrete deck and substructure.

SPANS 74'-8", 99'-7", 99'-7" and 64'-9" center to center of bearings.

ROADWAY .52'-0" face to face of 5'-0" sidewalk.

LOAD FREQUENCY: C.F = 400 (57)

SKIEW: 39°45'34" L.R.

WEARING SURFACE: 1" monolithic concrete

APPROACH SLABS: AS-1-54, 25' long

ALIGNMENT: Tangent

RACKOFF ASSOCIATES
ENGINEERS COLUMBUS, OHIO

SITE PLAN


BRIDGE NO. CUY-I71-1372
171 UNDER MEMPHIS AVE

CUYAHOGA COUNTY STA. 809+05.42

Designed	Drawn	Checked	Reviewed	Date	Revised
H. H. EA		V. K.	<i>[Signature]</i>	8-26-05	3-26-06
				64	

DESIGN AGENCY: DISTRICT TWELVE PRODUCTION DEPARTMENT
 REVIEWED DATE: JRC 01/20/06
 STRUCTURE FILE NUMBER: 1805134
 DRAWN: JMT
 CHECKED: JMT
 STA. 8+74.35
 STA. 12+18.79
 SITE PLAN
 CUY-71-1390 MEMPHIS RD
 LOCATION 1
 D12 BH FY2006
 MISC. REPAIRS 2

PLAN AND PROFILE VIEWS ARE TAKEN FROM ORIGINAL PLANS AND SHOULD BE USED FOR INFORMATIONAL PURPOSES. ALL DIMENSIONS ARE IN FEET.

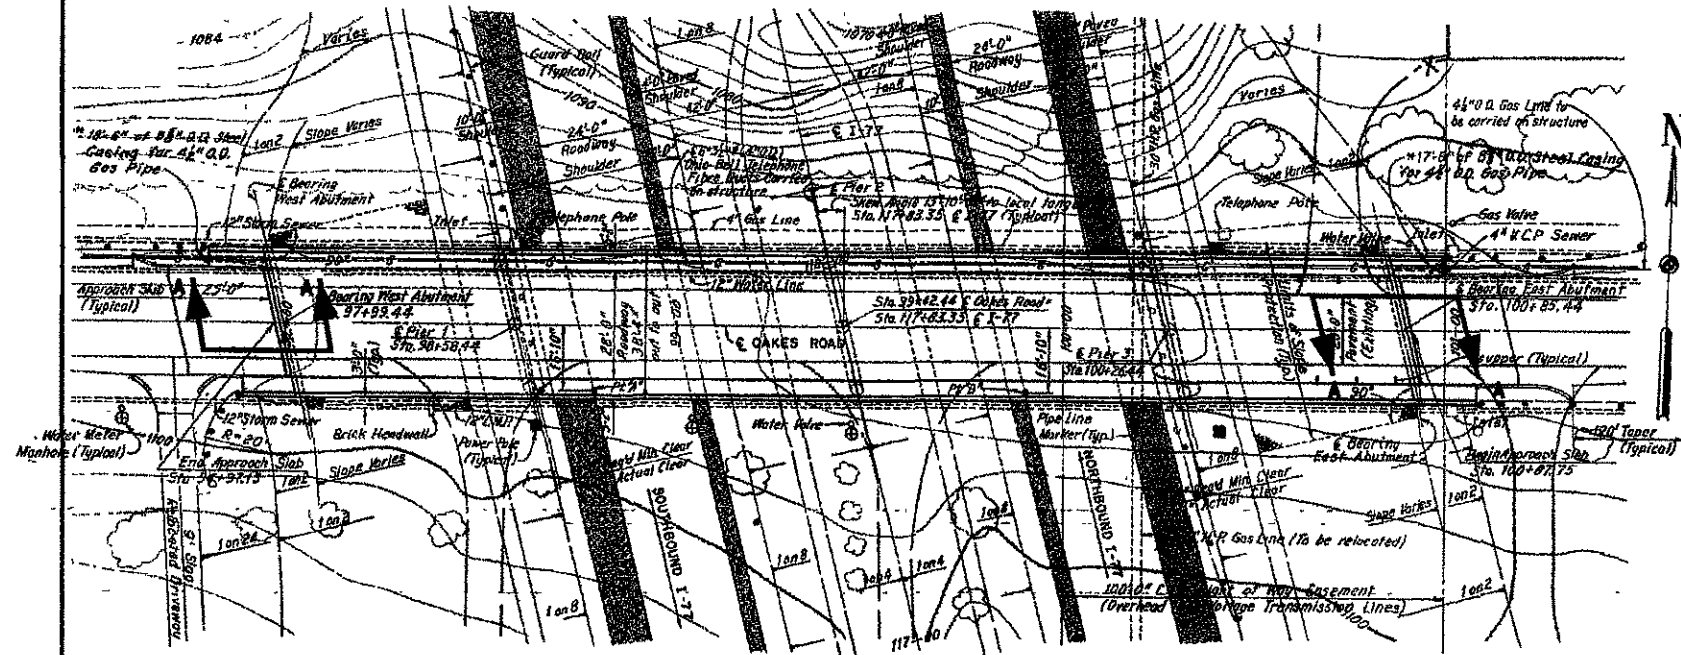


PLAN
Scale: 1"=20'-0"

EXISTING STRUCTURE	
TYPE: Continuous steel beam with reinforced concrete deck and substructure.	
SPANS: 59'-0", 84'-0", 84'-0" and 59'-0"	
ROADWAY: 28'-0" curb/curb with two 4'-0" sidewalks	
LOAD FREQUENCY: CF400(57)	
SKEW: 13°10'11" Right Forward	
WEARING SURFACE: 3" Manilla Concrete	
APPROACH SLABS: AS-1-54 (25' Long)	
ALIGNMENT: Tangent	

PROPOSED WORK

- 1 PATCHING: BACKWALL, RAILING, SIDEWALK
USE ITEM 519 PATCHING CONCRETE STRUCTURE
- 2 REPLACE SEAL GLAND AND RETAINER

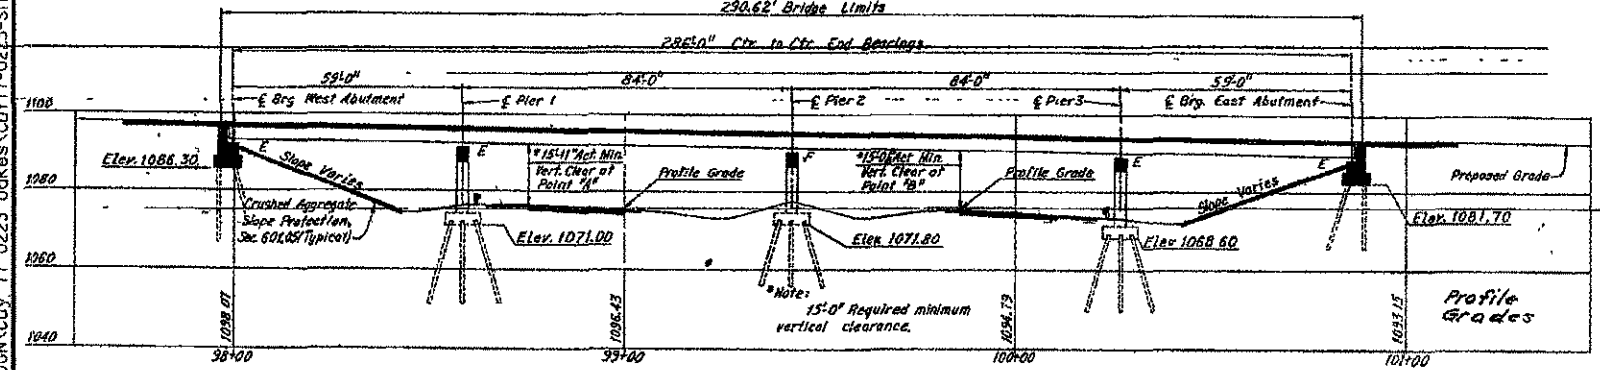



ELEVATION

PLAN AND PROFILE VIEWS
ARE TAKEN FROM ORIGINAL
PLANS AND SHOULD BE
USED FOR INFORMATIONAL
PURPOSES.
ALL DIMENSIONS ARE "+/-"

I:\PROJECTS\PID78926\DCM\DUY.77.0223-SITE\PLAN.DGN 20-JAN-2006 2:43PM jfhrrect

DESIGN AGENCY: DISTRICT TWELVE
 PRODUCTION DEPARTMENT
 DATE: 01/20/06
 REVISED: JRC
 STRUCTURE FILE NUMBER: 1805762
 DRAWN: JMT
 REVISED:
 DESIGNED: JMT
 CHECKED:
 STA. 97+87.13
 STA. 100+87.75
 SITE PLAN
 CUY-77-0223 OAKES RD
 LOCATION 2
 D12 BH FY2006
 MISC. REPAIRS 2
 14
 31

I:\PROJECTS\PIGT8926\DON\Cuy 77 0223 0.dwg 20-JAN-2006 2:48PM JHirect

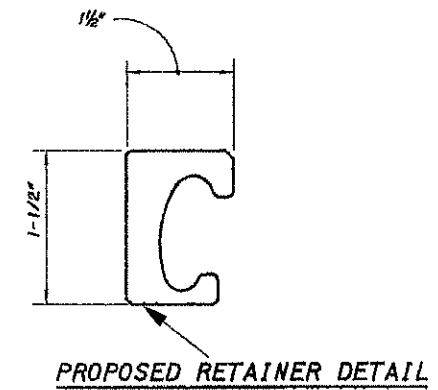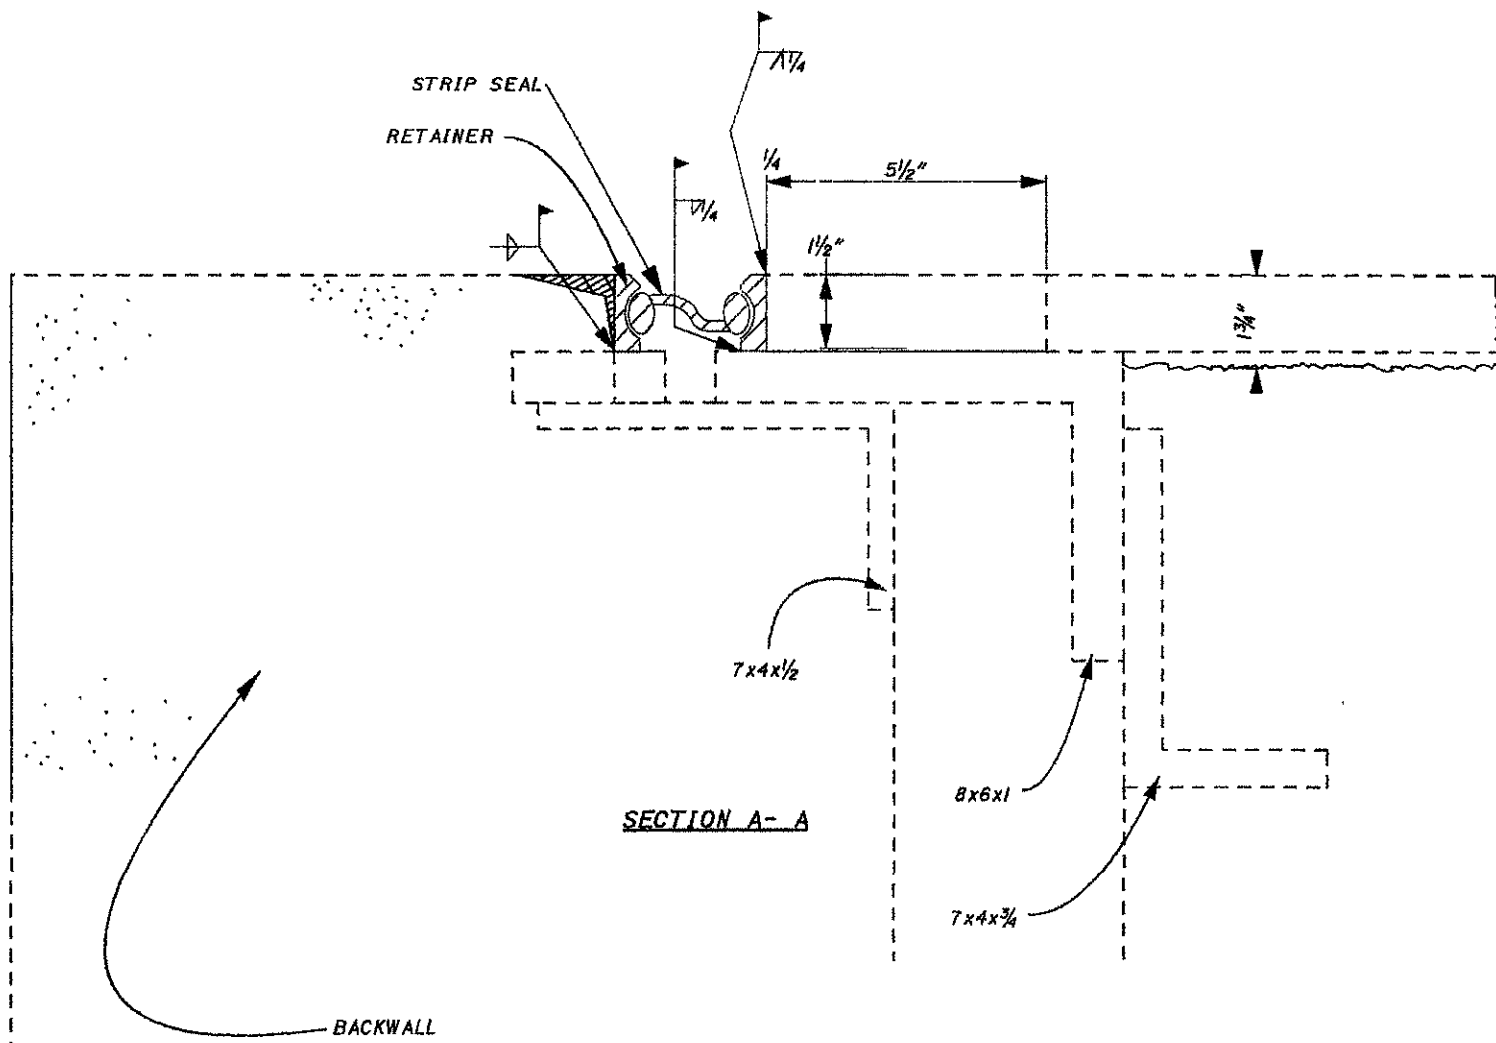

GUY-77-0223

JOINT OPENINGS AT SELECTED TEMPERATURES °F FOR LOCATION 3 GLAND SIZE-5"

TEMPERATURE	95	85	75	65	55	45
EAST ABUT.	1.46	1.55	1.64	1.73	1.82	1.91
WEST ABUT.	1.96	2.05	2.14	2.23	2.32	2.41

PROPOSED WORK FOR CUY-77-0223 BOTH ABUTMENTS

- 1) REMOVE EXISTING RETAINER AND NEOPRENE GLAND
- 2) THOROUGHLY CLEAN OUT THE AREA EXPOSED AS A RESULT OF REMOVAL
- 3) REPLACE WITH THE PROPER SIZE RETAINER AND GLAND (SEE TABLE THIS DRAWING).
- 4) WELD THE RETAINER AS SHOWN IN THIS DRAWING

NOTES

- 1) PREPARE AN AS-BUILT DRAWING FOR EACH LOCATION TO ILLUSTRATE THE SIZE OF THE REPLACEMENT RETAINER AND SEAL.
- 2) MATERIALS SHALL MEET THE REQUIREMENTS OF EXJ-4-87.

- REMOVE AND REPLACE

- AREA TO BE PATCHED

D12 BH FY2006
MISC. REPAIRS 2

EXPANSION JOINT DETAIL

OAKES RD
LOCATION 2

DESIGNED
JWC
CHECKED





DRAWN
JWC
REVISED

APPROVED
JRC
STRUCTURE FILE NUMBER
1805762

DESIGN AGENCY
DISTRICT TWELVE
PRODUCTION DEPARTMENT

PROPOSED WORK

PATCHING BACKWALL
USE ITEM 519 PATCHING CONCRETE STRUCTURE

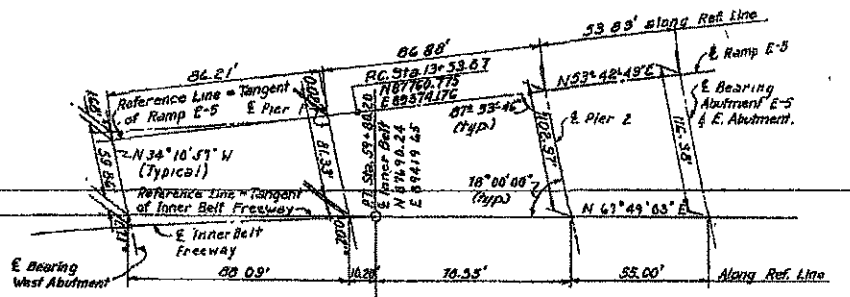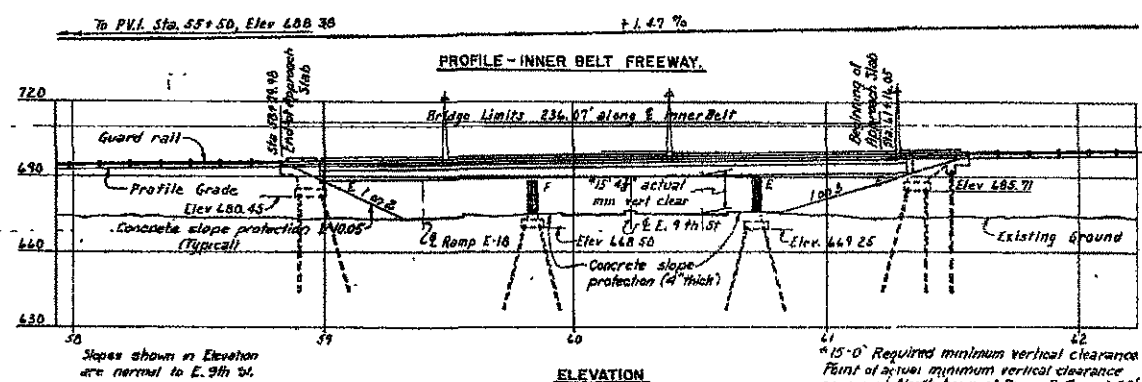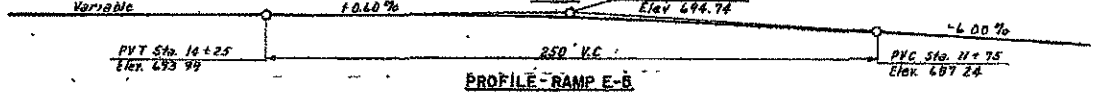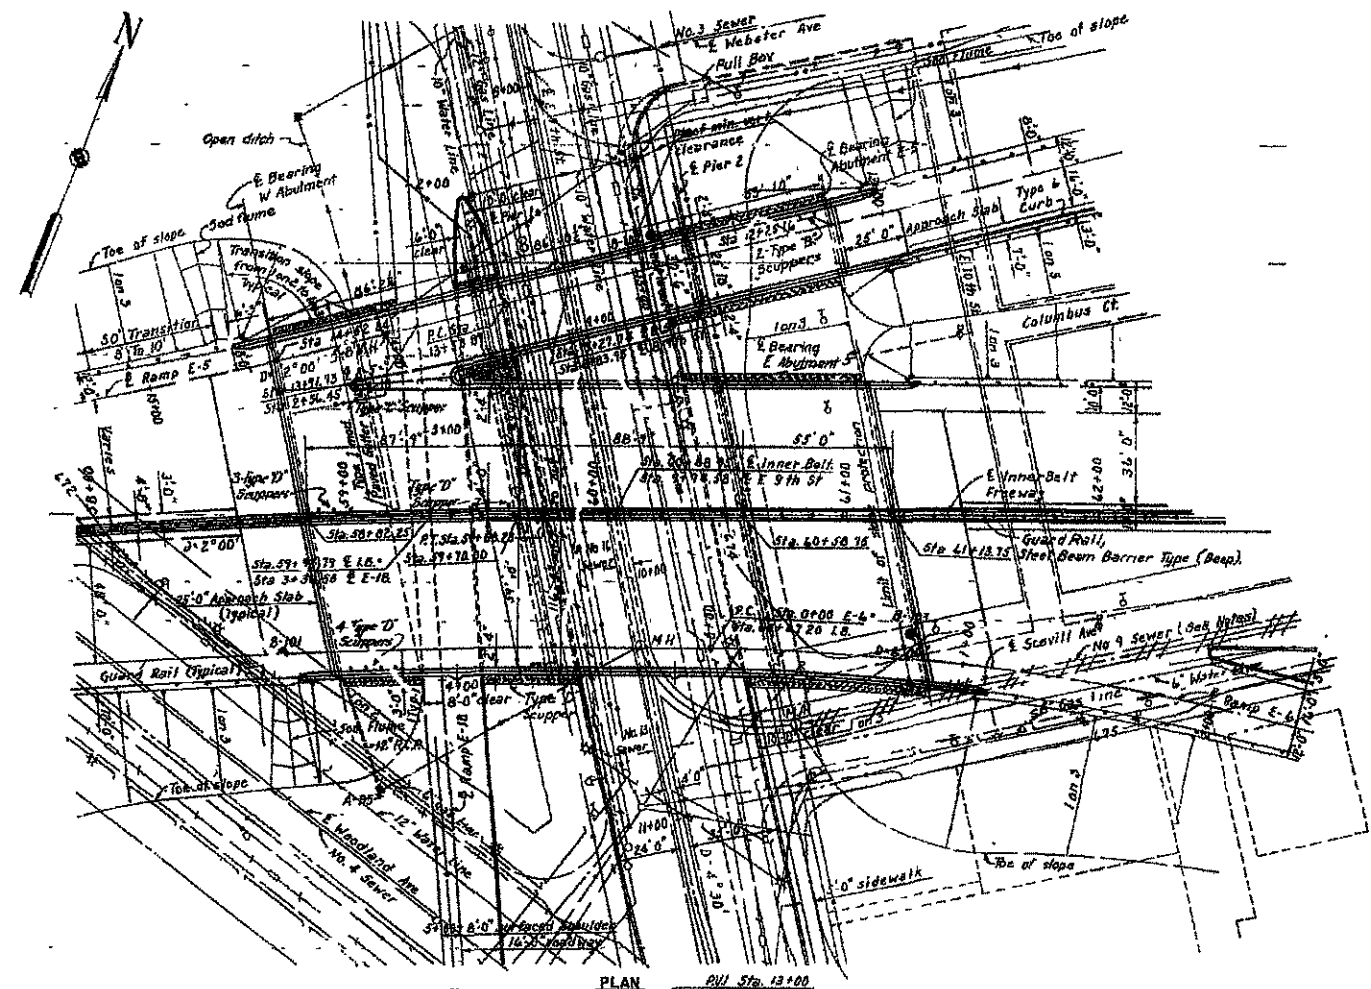



PLAN AND PROFILE VIEWS ARE TAKEN FROM ORIGINAL PLANS AND SHOULD BE USED FOR INFORMATIONAL PURPOSES. ALL DIMENSIONS ARE "+/-"

EXISTING STRUCTURE
 Type: Continuous rolled beam with reinforced concrete deck and substructure
 Spans: 87'-1.85'-4" (35'-0" along E Inner Belt Freeway) 114'-0" (summit) 49' parapets
 Loading: CF 2000-Adequate for AASHTO alternate loading
 Surface Course: 1" Monolithic Concrete
 Alignment: 2'-00" R/L Tangent
 Approach Slabs: 45'-1.54' (25' long)
 Super-elevation: Varies
 Skew: Varies

I:\PROJECTS\PIG78926\DCM\CUY 90 1628 L.R. E9TH 51\CUY90-1628-SITEPLAN.dgn 20-JAN-2006 2:44PM jthreac

<p>DISTRICT TWELVE PRODUCTION DEPARTMENT</p>	<p>DESIGN AGENCY</p>	<p>DATE</p>	<p>REVIEWED</p>	<p>DATE</p>
<p>STA. 58+79.98 STA. 61+16.05</p>	<p>JRC</p>	<p>01/20/06</p>	<p>JRC</p>	<p>01/20/06</p>
<p>LOCATION 3</p>	<p>JWT</p>	<p>JWT</p>	<p>JWT</p>	<p>JWT</p>
<p>CUY-90-1628R E. 9TH ST.</p>	<p>JWT</p>	<p>JWT</p>	<p>JWT</p>	<p>JWT</p>
<p>SITE PLAN</p>	<p>CHECKED</p>	<p>CHECKED</p>	<p>CHECKED</p>	<p>CHECKED</p>
<p>MISC. REPAIRS 2</p>	<p>NO. 16</p>			

I:\PROJECTS\178925\1651-SITEPLAN.dgn 20-JAN-2006 2:44PM jthrect

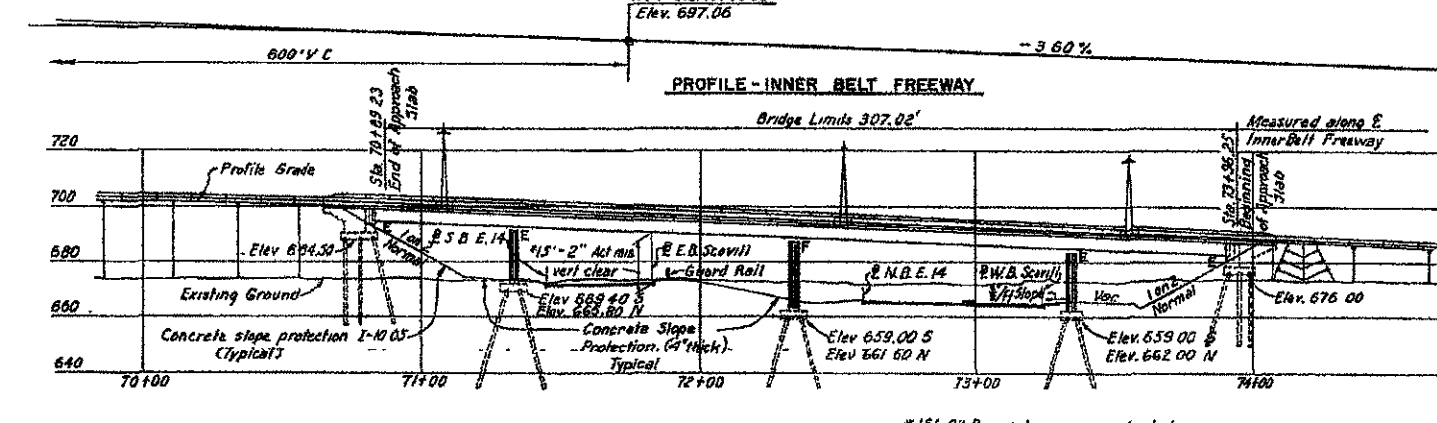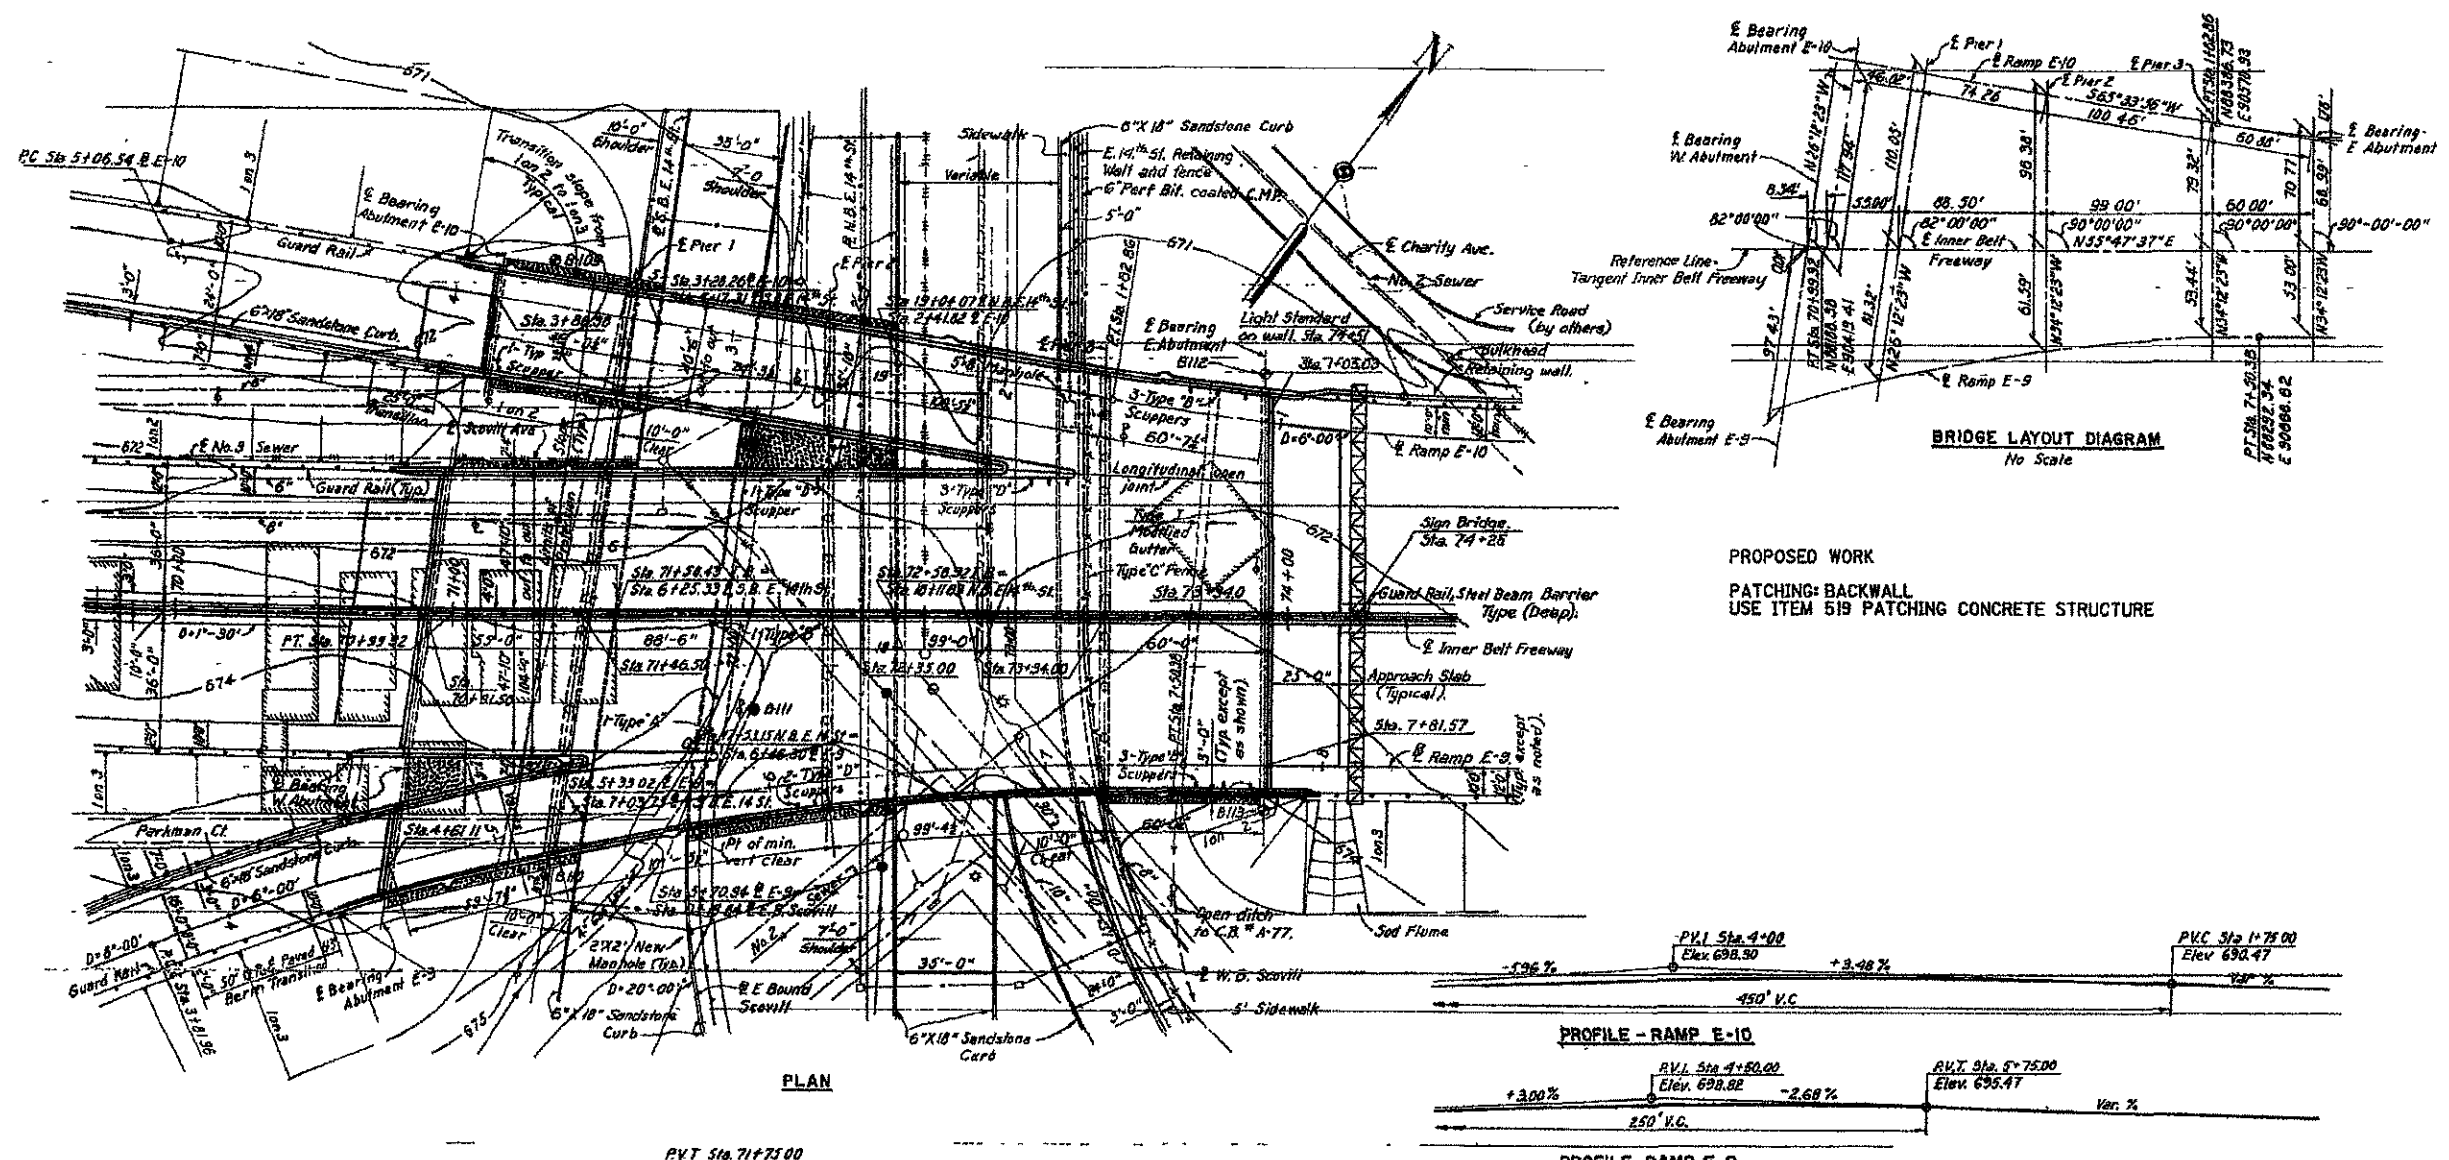


EXISTING STRUCTURE	
TYPE	Continuous welded steel girder with reinforced concrete deck and substructure
SPANS	35'-0", 88'-6", 99'-0", 60'-0" along E I B
ROADWAY	Varies
LOADING	CF-2000 - Adequate for A.A.S.H.O. alternate loading.
SKEW	Varies
SURFACE COURSE	1" Monolithic Concrete
ALIGNMENT	1°30' Lt. Tangent
APPROACH SLABS	A5-1-34 (25' long)
SUPERELEVATION	Varies


PLAN AND PROFILE VIEWS ARE TAKEN FROM ORIGINAL PLANS AND SHOULD BE USED FOR INFORMATIONAL PURPOSES.
ALL DIMENSIONS ARE "+/-"

DISTRICT TWELVE
PRODUCTION DEPARTMENT
 DATE 01/20/06
 STRUCTURE FILE NUMBER 1807900
 CHECKED JMT
 REVISIONS JMT
 STA. 70+89.23
 STA. 73+96.25
SITE PLAN
 CUY-90-1851 E. 14TH ST.
 LOCATION 4
D12 BH FY2006
MISC. REPAIRS 2
 17
 31

I:\PROJECTS\PIG78926.DGN\Cuy 480 0074 Barton\CUY480-0074-SITEPLAN.DGN 20-JAN-2006 2:40PM jthreac

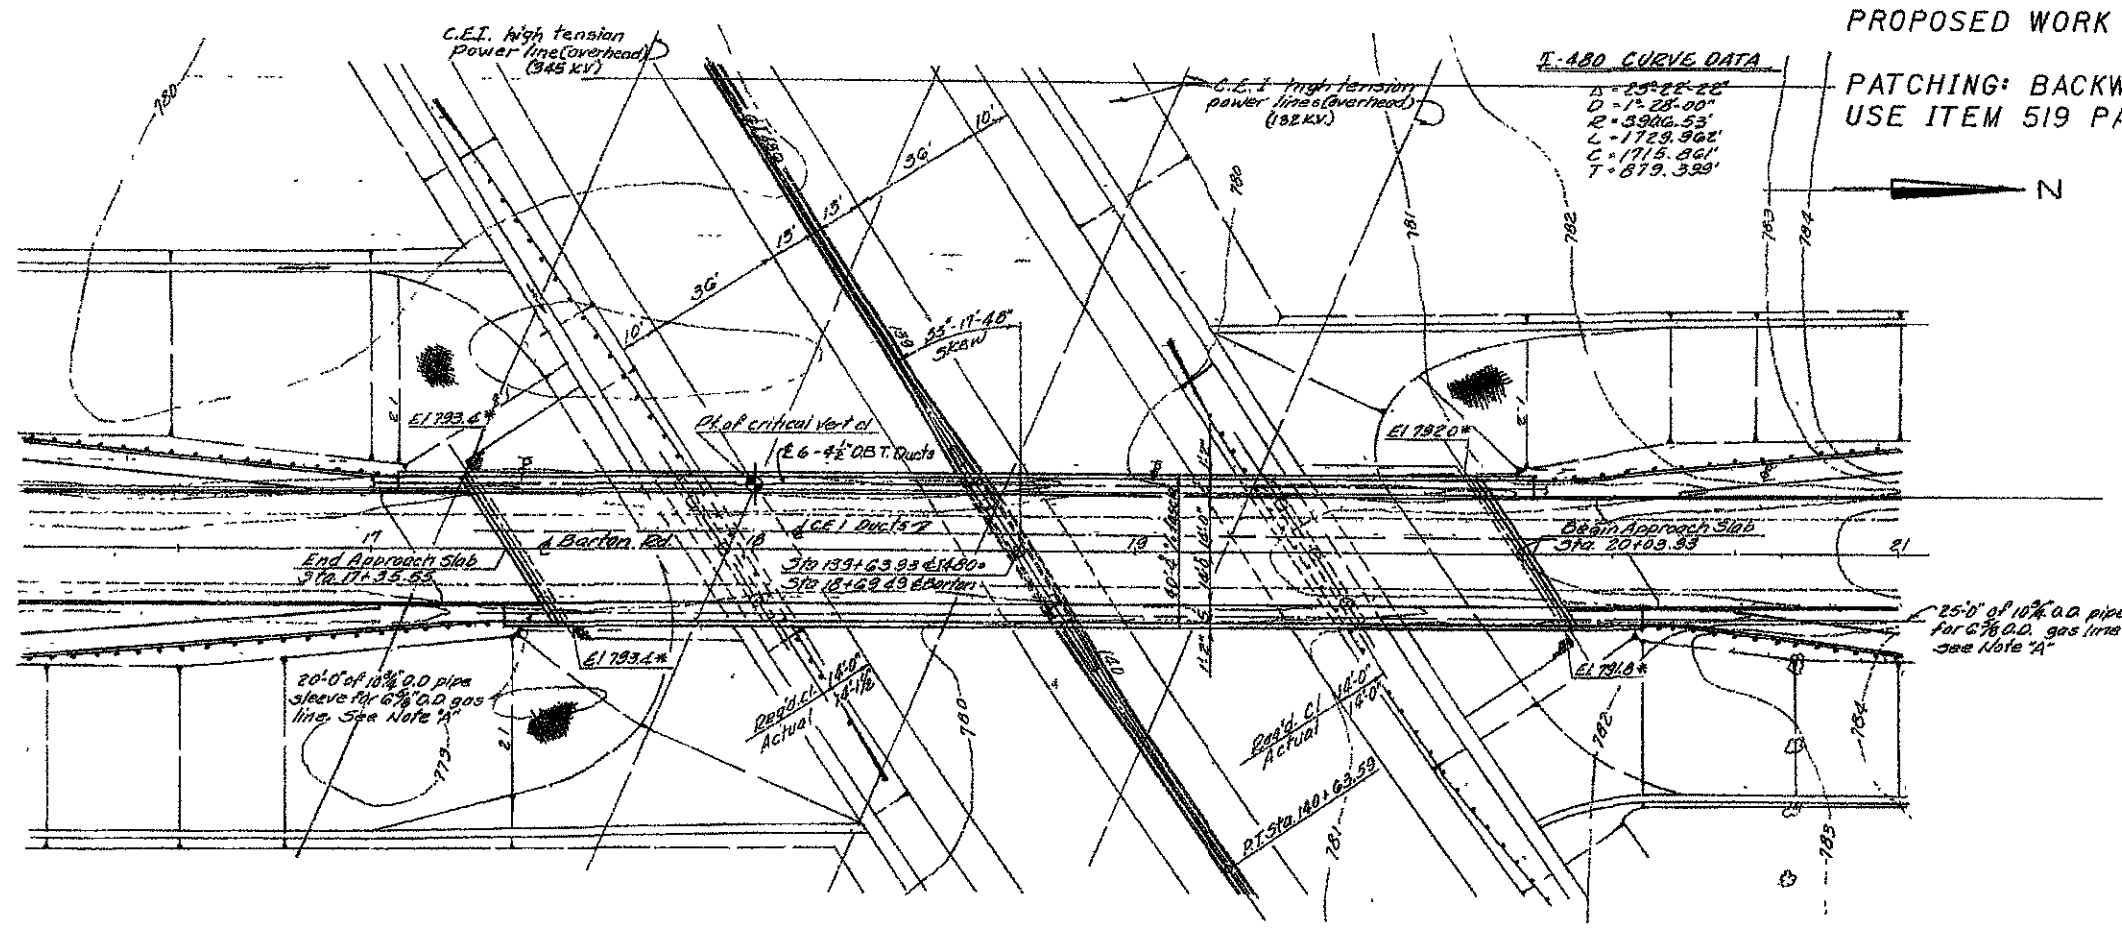


PLAN

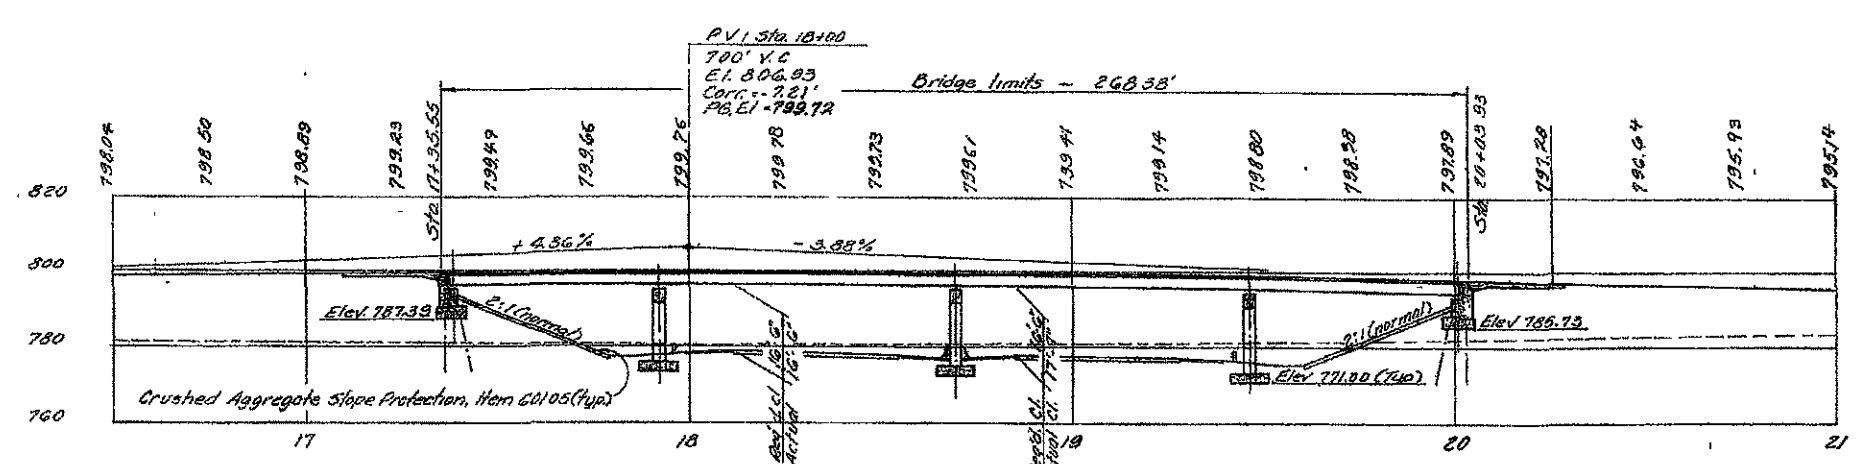

PLAN AND PROFILE VIEWS
 ARE TAKEN FROM ORIGINAL
 PLANS AND SHOULD BE
 USED FOR INFORMATIONAL
 PURPOSES.
 ALL DIMENSIONS ARE "+/-"

DESIGNED JWJ CHECKED	DRAWN JWJ REVISED	REVIEWED JRC	DATE 01/20/06	DESIGN AGENCY DISTRICT TWELVE PRODUCTION DEPARTMENT
		STRUCTURE FILE NUMBER 1814001		
STA. 17+35.55	STA. 20+03.93			
SITE PLAN CUY-480-0074 BARTON RD LOCATION 5				
D12 BH FY2006 MISC. REPAIRS 2				
		18 31		

L:\PROJECTS\PI\78926\DGN\Cuy 480_0727 Gr-dy\Tom\CUY480-0727-SITEPLAN.dgn 20-JAN-2006 2:41PM jthreot

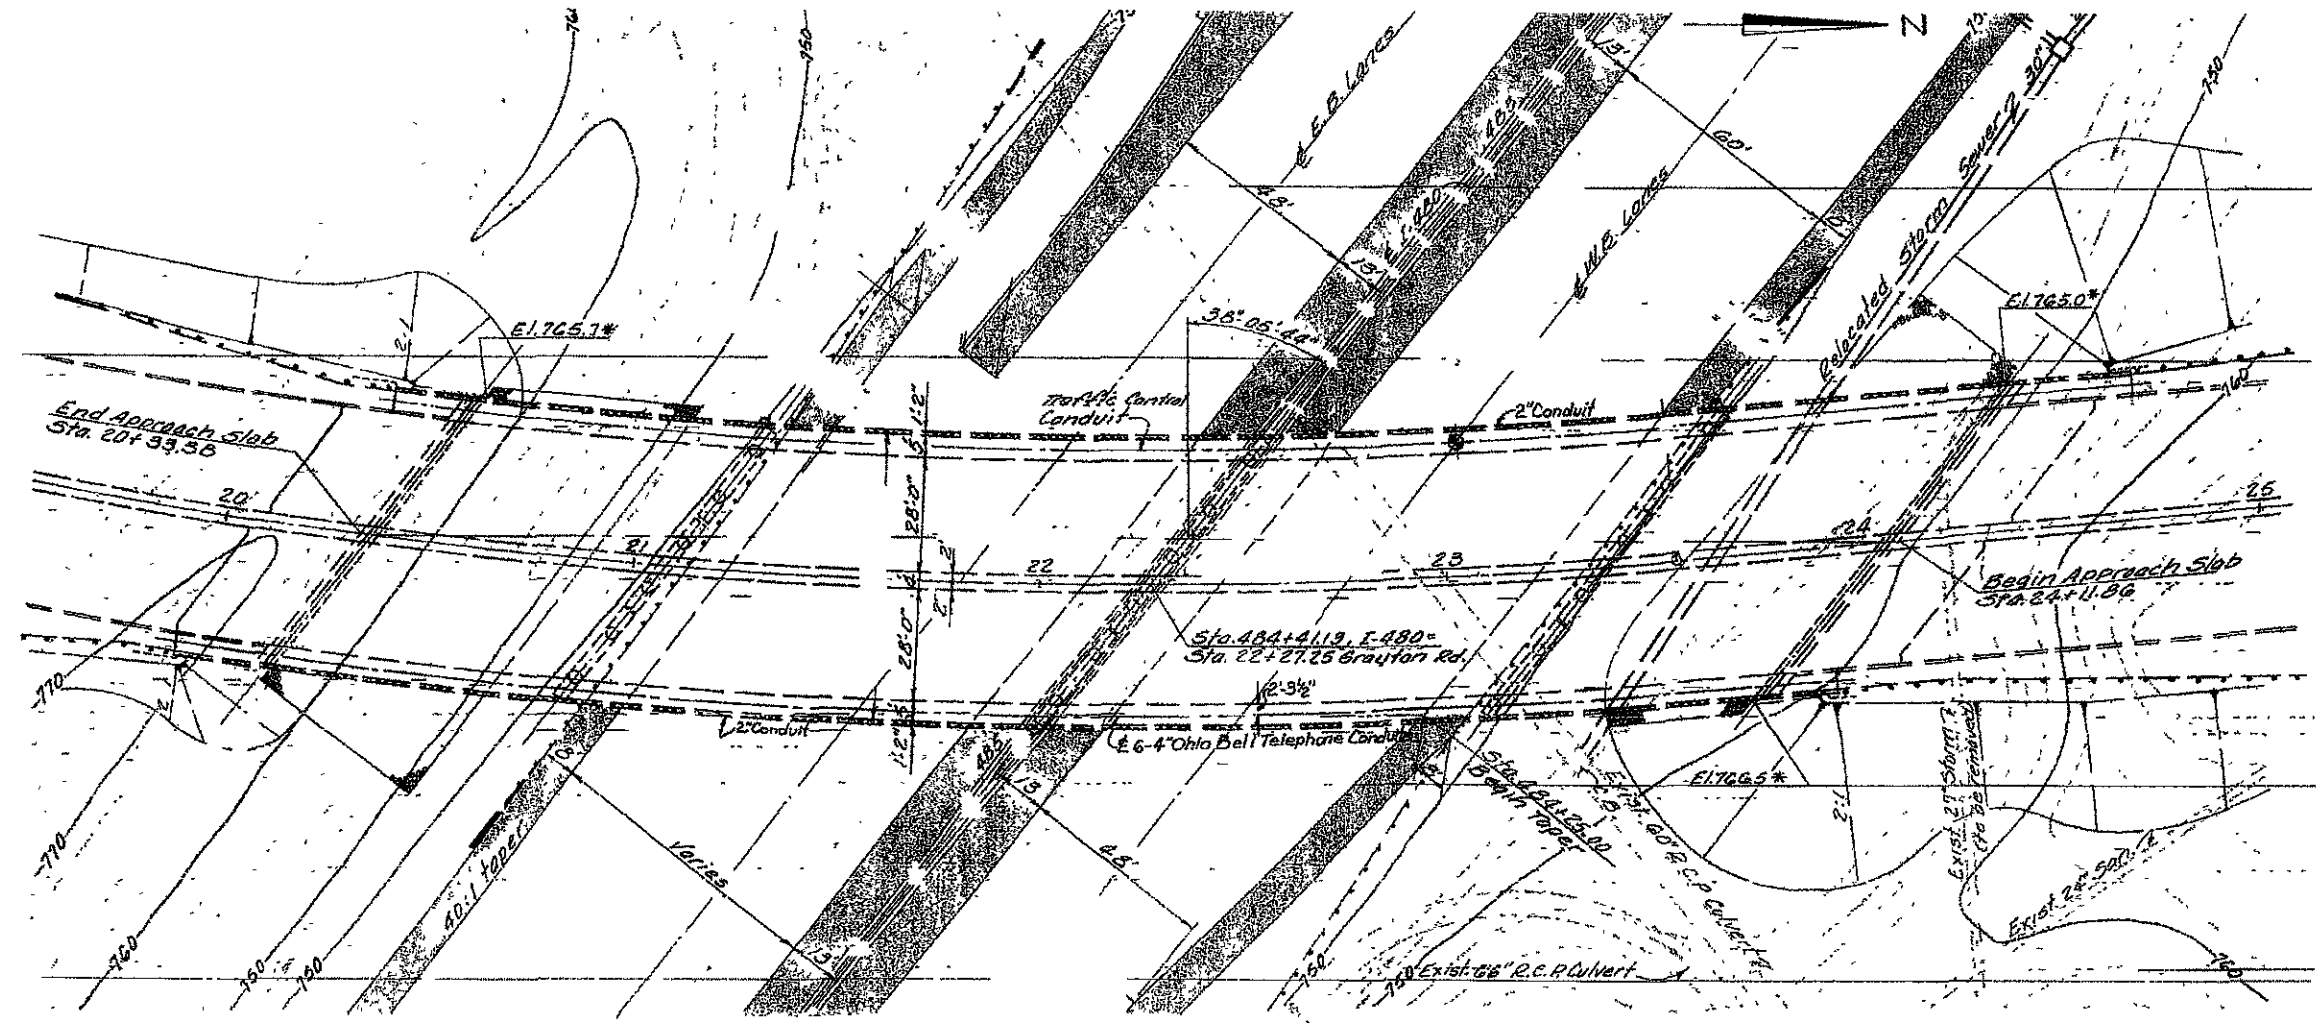

PLAN

PROPOSED WORK
 PATCHING: RAILING, CURB, SIDEWALK
 USE ITEM 519 PATCHING CONCRETE STRUCTURE


EXISTING

PLAN AND PROFILE VIEWS
 ARE TAKEN FROM ORIGINAL
 PLANS AND SHOULD BE
 USED FOR INFORMATIONAL
 PURPOSES.
 ALL DIMENSIONS ARE "+/-"

D12 BH FY2006 MISC. REPAIRS 2	SITE PLAN		STA. 20+33.38	DESIGNED	DRAWN	REVISED	DATE	DESIGN AGENCY
	CUY-480-0727 GRAYTON RD LOCATION 6		STA. 24+11.86	JWT CHECKED	JWT REVISED	JWC STRUCTURE FILE NUMBER	01/20/06	DISTRICT TWELVE PRODUCTION DEPARTMENT
							1814184	


I:\PROJECTS\PI678926\CONRAIL\480-1075-SITEPLAN.DGN 20-JAN-2006 2:41PM jthreac

PROPOSED WORK
PATCHING: BACKWALL
USE ITEM 519 PATCHING CONCRETE STRUCTURE

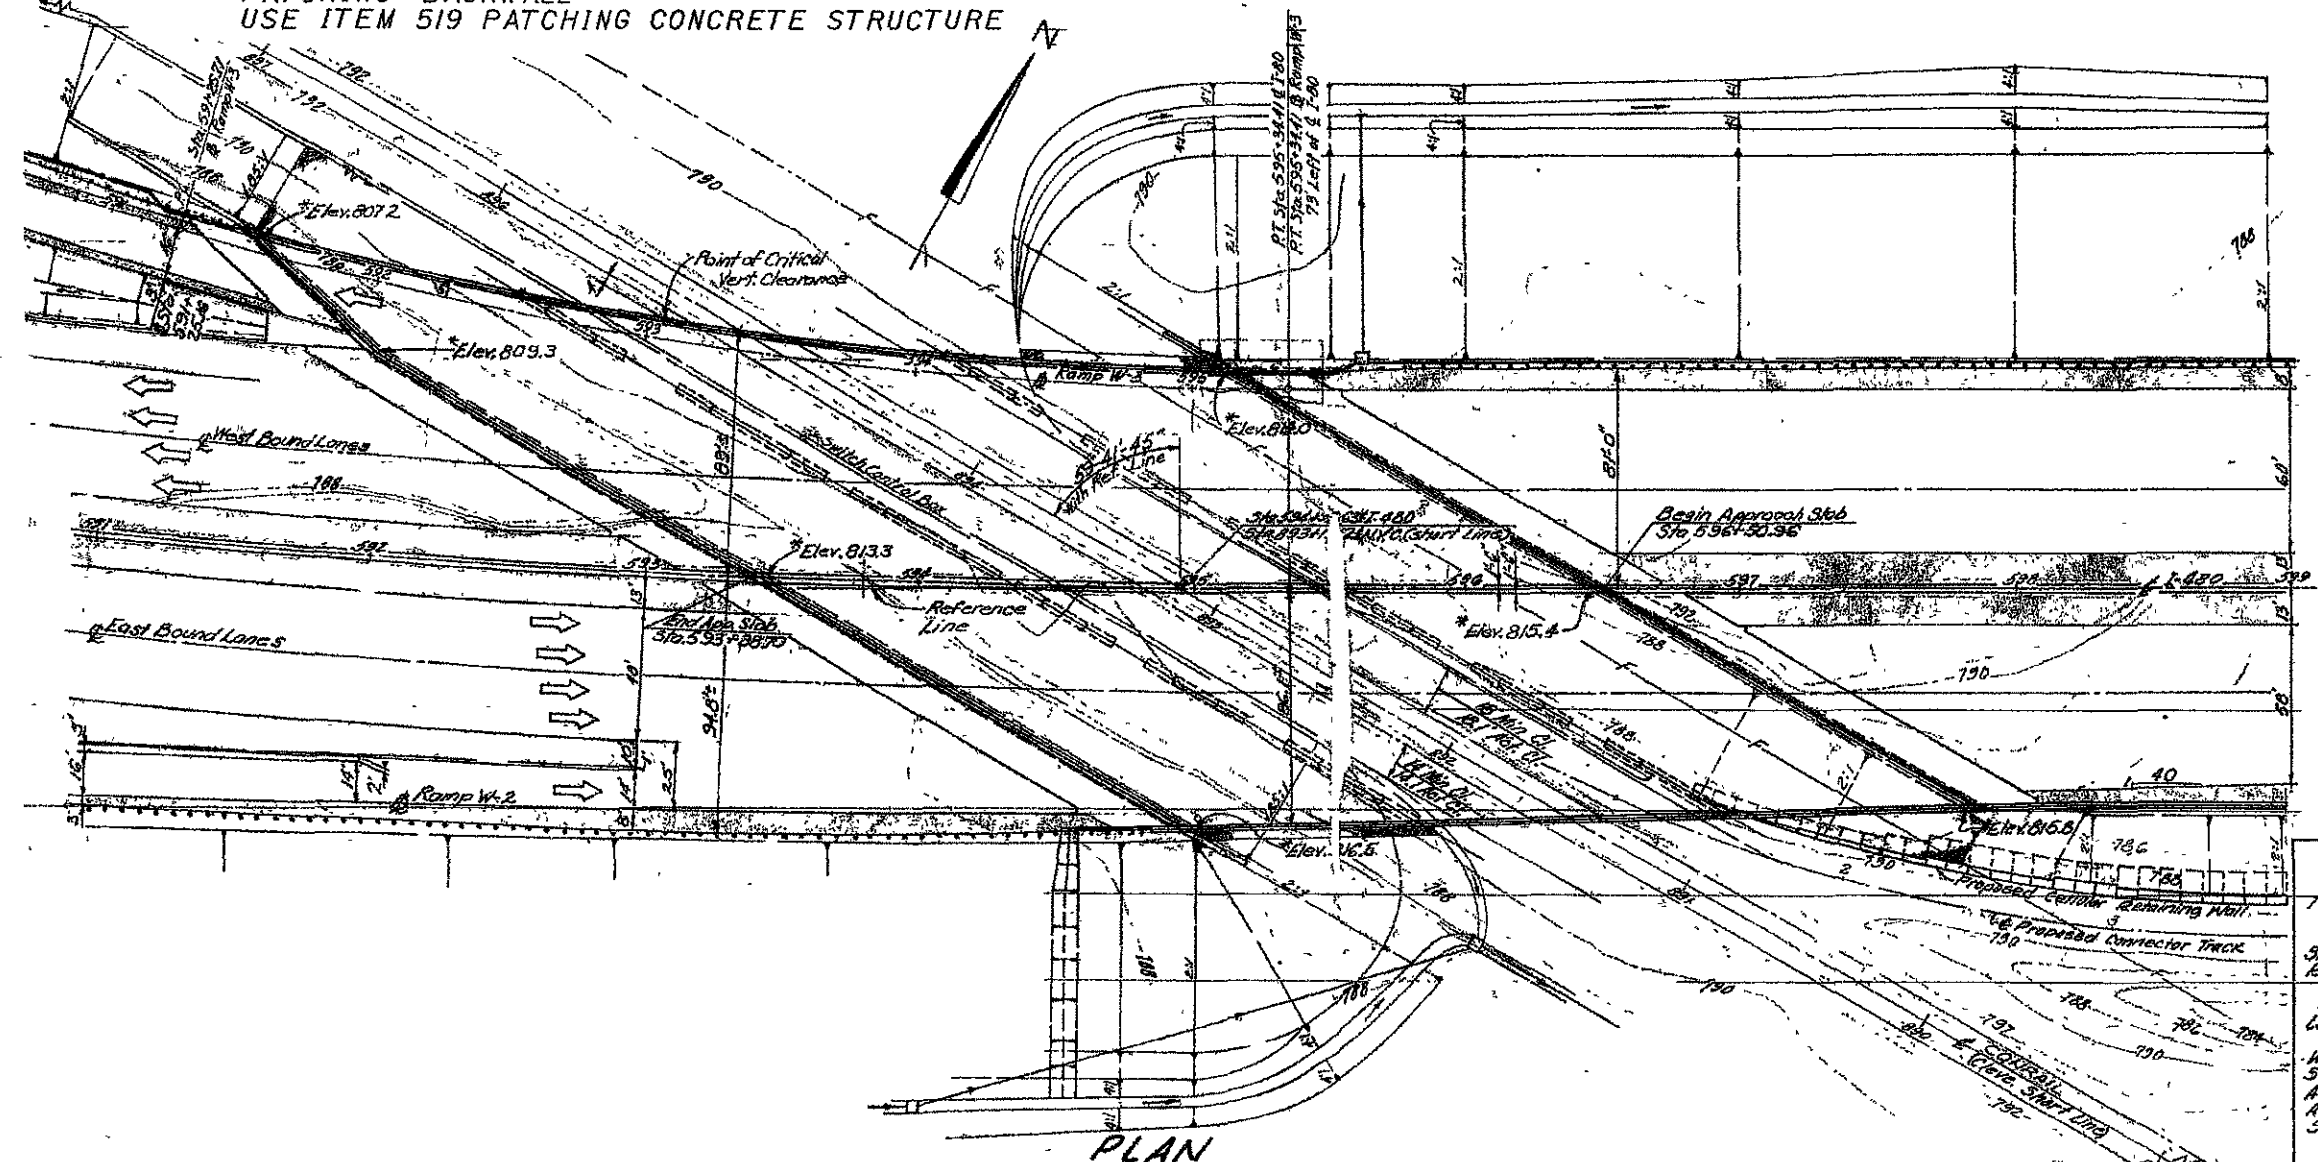

PLAN

EXISTING STRUCTURE
 TYPE: Continuous steel girder with reinforced concrete deck and reinforced concrete substructure.
 SPANS: 91'-0" - 121'-0" - 91'-0" Brgs. on 6 I-980
 ROADWAY WIDTH: varies w/ concrete parapets. Avg. width 120'-0". Bridge roadway B.R.-I. Ballast and concrete barrier median. LOADING: HS 20-44, Case I and the alternate Military Loading.
 WEARING SURFACE: 1 1/2" (min) Med. Bed. Concrete SKENS 53'-41'-45" Right hand with respect to Ref. Line ALIGNMENT: 1°-15'-00" curve and tangent. APPROACH SLOPES: A.S.-1-21 (2.5' long) (MIN) SUPERELEVATION: varies (0.03% per ft. max.)

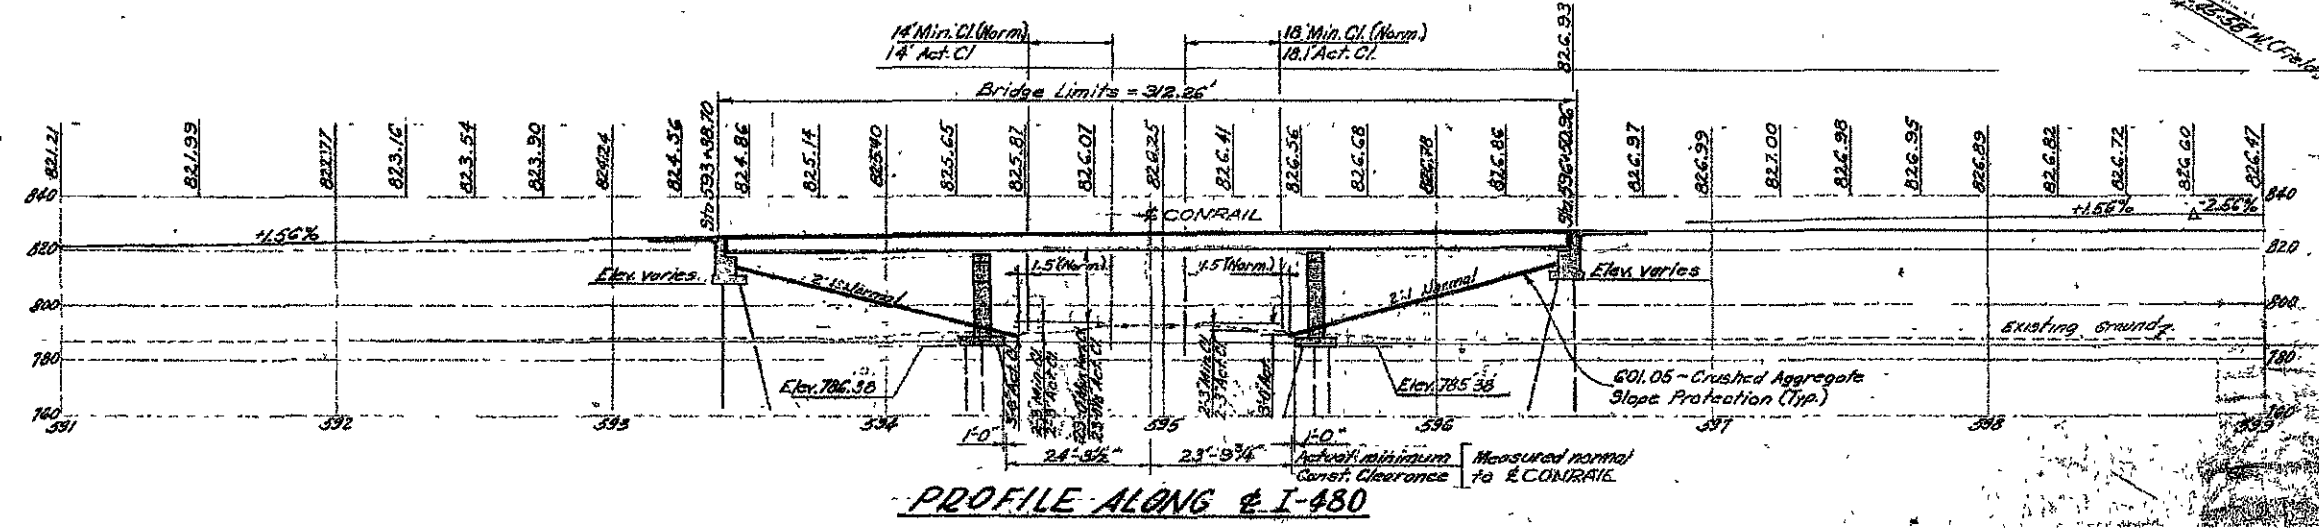


PROFILE ALONG I-480

PLAN AND PROFILE VIEWS ARE TAKEN FROM ORIGINAL PLANS AND SHOULD BE USED FOR INFORMATIONAL PURPOSES. ALL DIMENSIONS ARE "+/-"


DISTRICT TWELVE PRODUCTION DEPARTMENT	DATE: 01/20/06 REVISED: JRC STRUCTURE FILE NUMBER: 1812912
	DRAWN: JMT CHECKED: JMT
STA. 593+38.70 STA. 596+50.96	LOCATION 7
D12 BH FY2006 MISC. REPAIRS 2	SITE PLAN CUY-480-1075 CONRAIL

I:\PROJECTS\PI\78926.DGN\Cuy 480 224Lee Rd\CUY480-224I-SITEPLAN.DGN 20-JAN-2006 2:42PM jhrbat

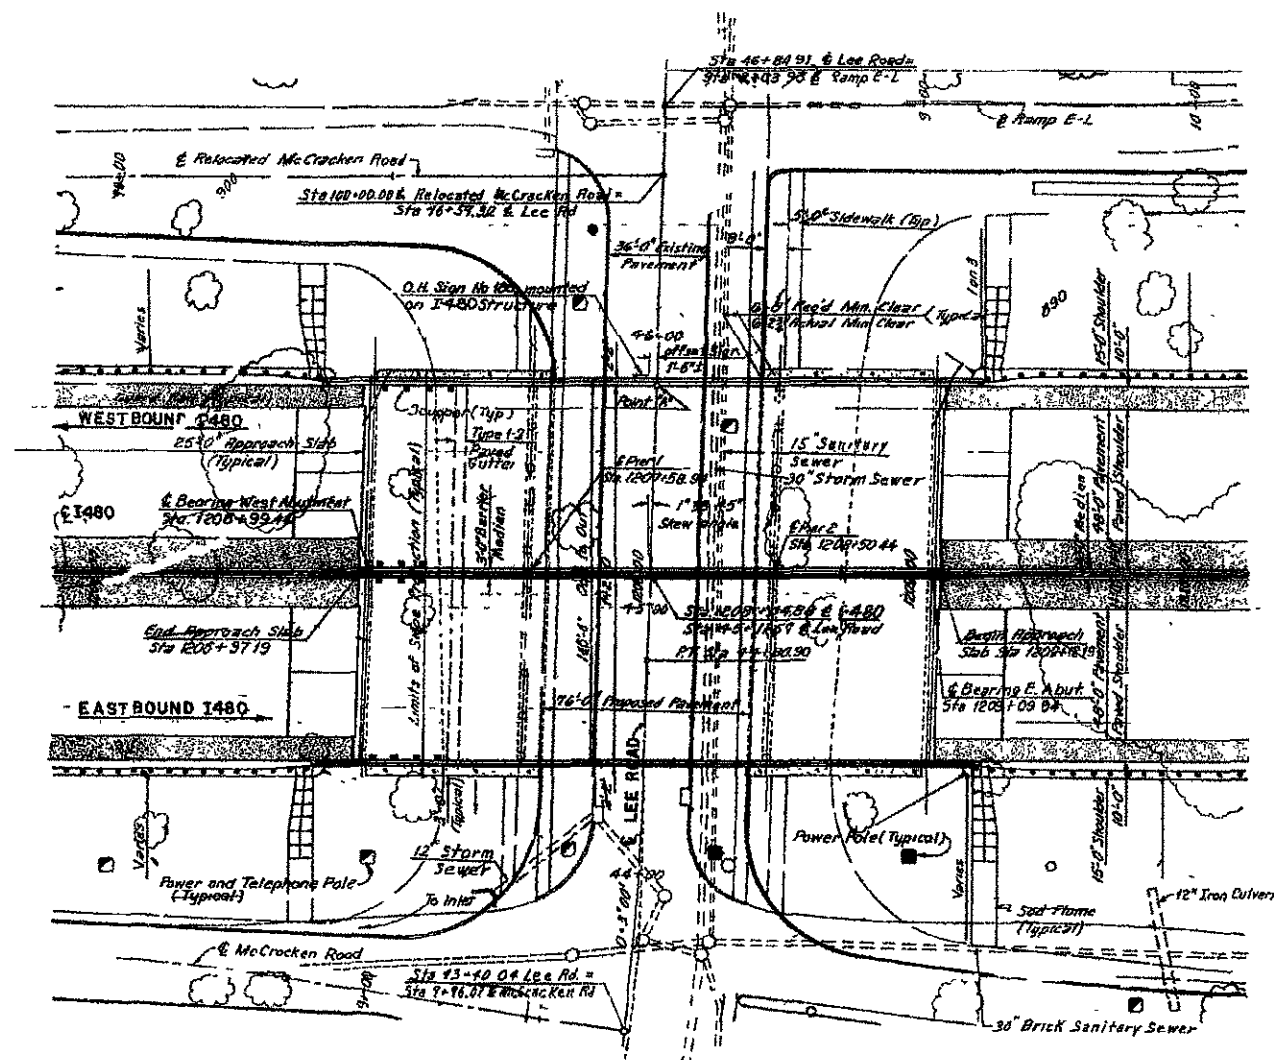

PLAN Scale 1"=30'

Notes:
Type 1-2 paved gutter is included for payment with roadway quantities.

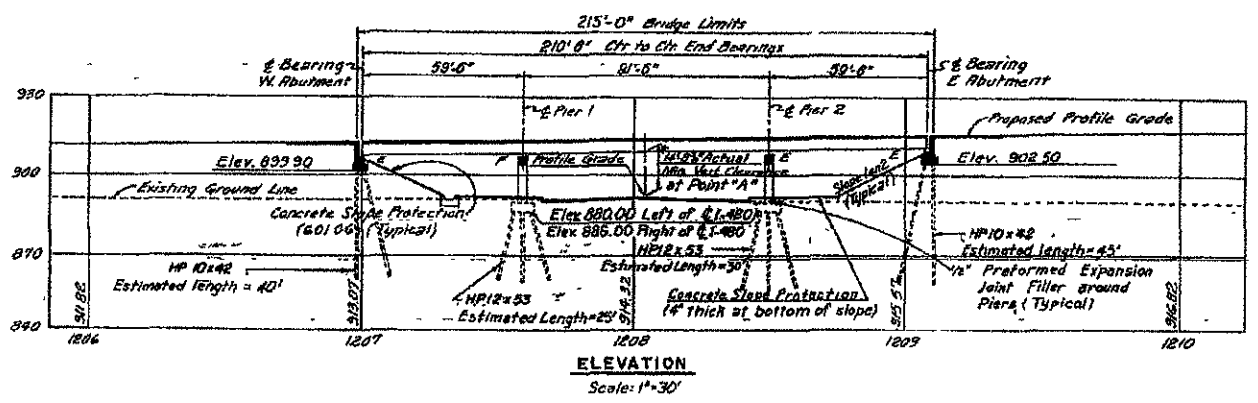

ELEVATION Scale: 1"=30'

- PROPOSED WORK
- 1 CONCRETE SLOPE REPAIR
 - 2 GUTTER REPAIR

EXISTING STRUCTURE

TYPE: Continuous welded steel girder with reinforced concrete deck and substructure.

SPANS: 59'-6", 91'-6" and 59'-6"

ROADWAY: 144'-0" face to face parapets, 3'-0" barrier median

LOAD FREQUENCY: CF 2000 (57) adequate for A.A.S.H.O. Alternate loading

SKEW: 1°33'45" Left forward

WEARING SURFACE: 1" Monolithic Concrete

APPROACH SLABS: AS-1-67 (25' long)

ALIGNMENT: Tangent


SUPERELEVATION: Normal Crown

PLAN AND PROFILE VIEWS ARE TAKEN FROM ORIGINAL PLANS AND SHOULD BE USED FOR INFORMATIONAL PURPOSES.

ALL DIMENSIONS ARE "+/-"


DESIGN AGENCY: DISTRICT TWELVE PRODUCTION DEPARTMENT
 DATE: 01/20/06
 REVIEWED: JRC
 DRAWN: JMT
 CHECKED: JMT
 FILE NUMBER: 1813404
 STA. 1206+97.1
 STA. 1209+12.1
 LOCATION 8
 CUY-480-2241 LEE RD
 MISC. REPAIRS 2
 2/31

I:\PROJECTS\Plan\18926\DCN\Cuy 480 2344 Camden Rd\CUY480-2344-SITEPLAN.DGN 20-JAN-2006 2:42PM jthreac

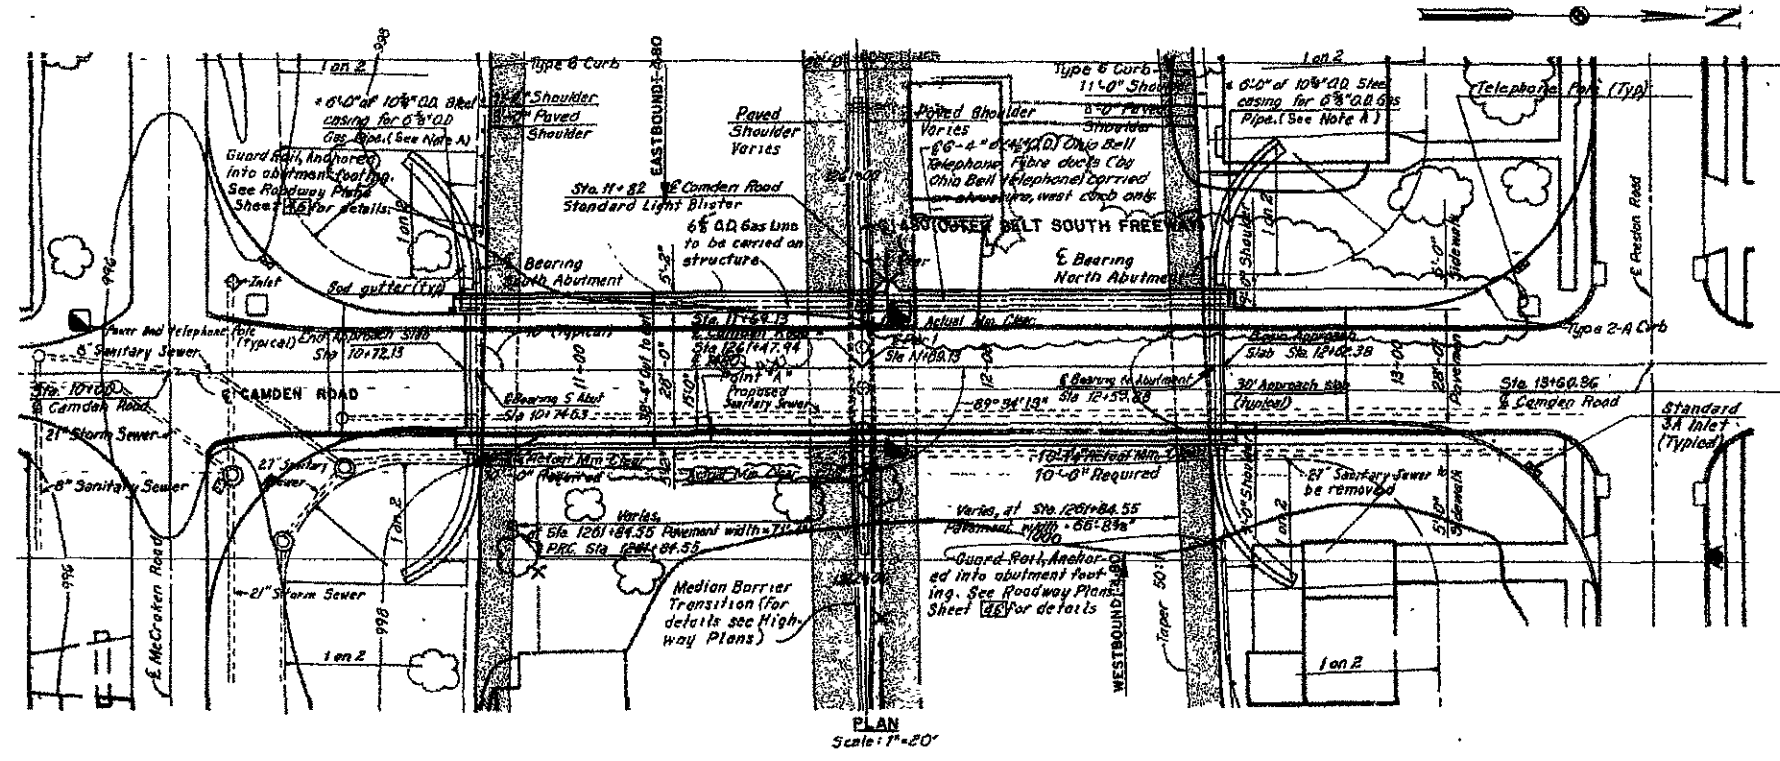

EXISTING STRUCTURE	
TYPE:	Continuous welded steel girder with reinforced concrete deck and sub-structure.
SPANS:	94'-6" and 90'-9"
ROADWAY:	28'-0" Curb to curb with two 4'-0" sidewalks.
LOAD FREQUENCY:	CFI30 (57)
SKEW:	None
WEARINGS-SURFACE:	1" Mono-11th-Conecrete
APPROACH SLABS:	AS-1-67 (30' long)
ALIGNMENT:	Tangent
SUPERELEVATION:	Normal Crown



PROPOSED WORK
 PATCHING: CURB, SIDEWALK
 USE ITEM 519 PATCHING CONCRETE STRUCTURE

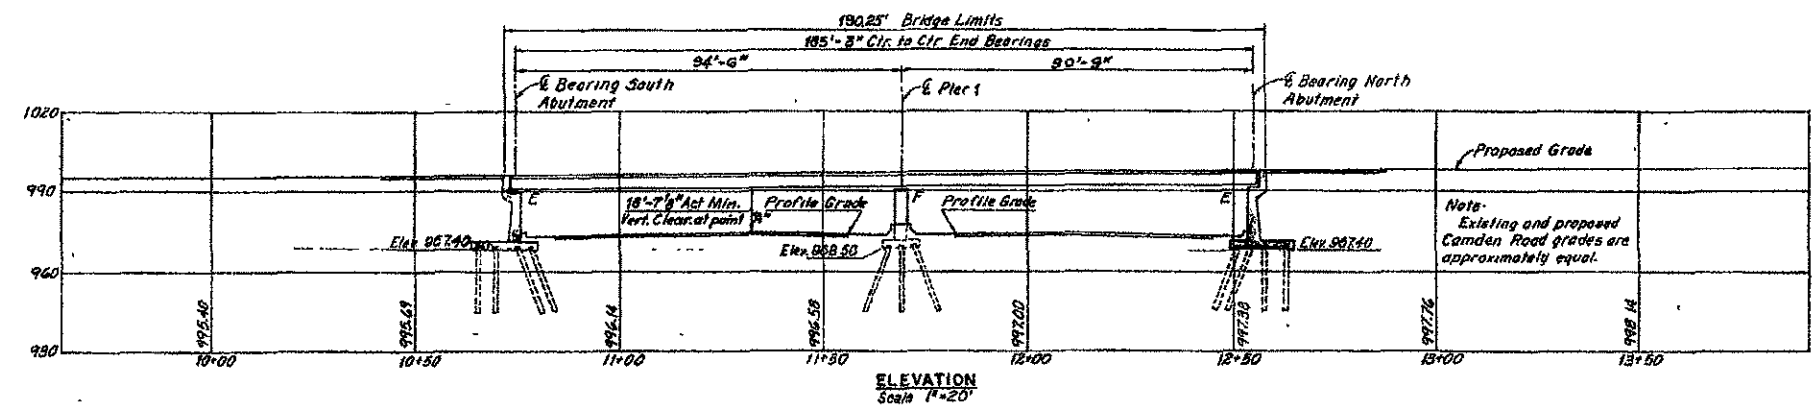

PLAN AND PROFILE VIEWS ARE TAKEN FROM ORIGINAL PLANS AND SHOULD BE USED FOR INFORMATIONAL PURPOSES.
 ALL DIMENSIONS ARE "+/-"

DESIGN AGENCY: DISTRICT TWELVE
PRODUCTION DEPARTMENT: PRODUCTION DEPARTMENT
DATE: 01/20/06
REVIEWED: JRC
STRUCTURE FILE NUMBER: 1813625
DESIGNED: JMT
CHECKED: []
STA.: 10+72.13
STA.: 12+62.38
SITE PLAN: CUY-480-2344 CAMDEN RD
LOCATION 9
D12 BH FY2006 MISC. REPAIRS 2
22/31

PROPOSED WORK
REPLACE COMPRESSION SEALS

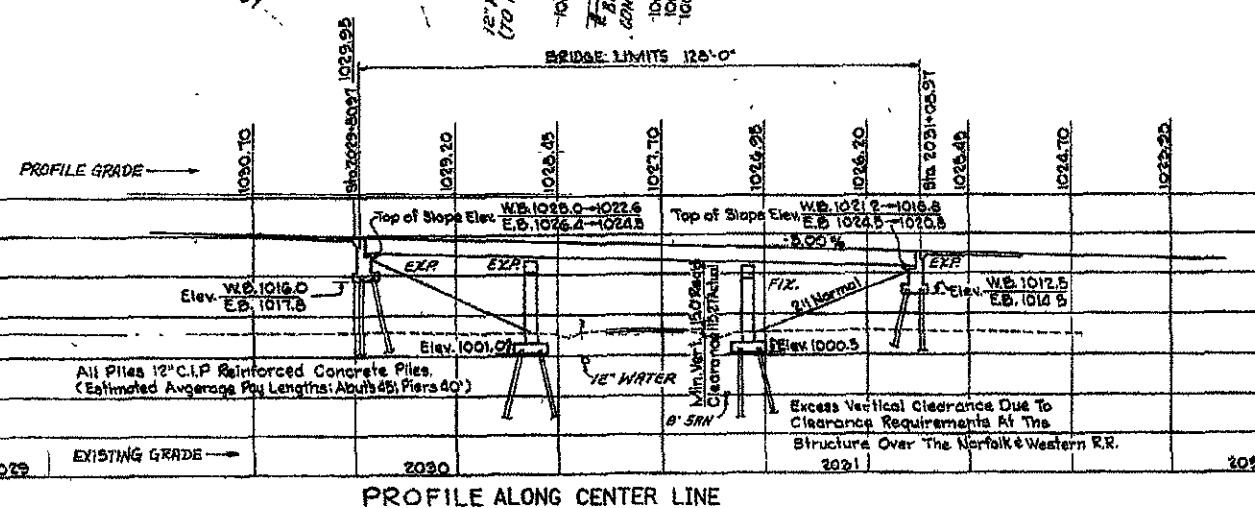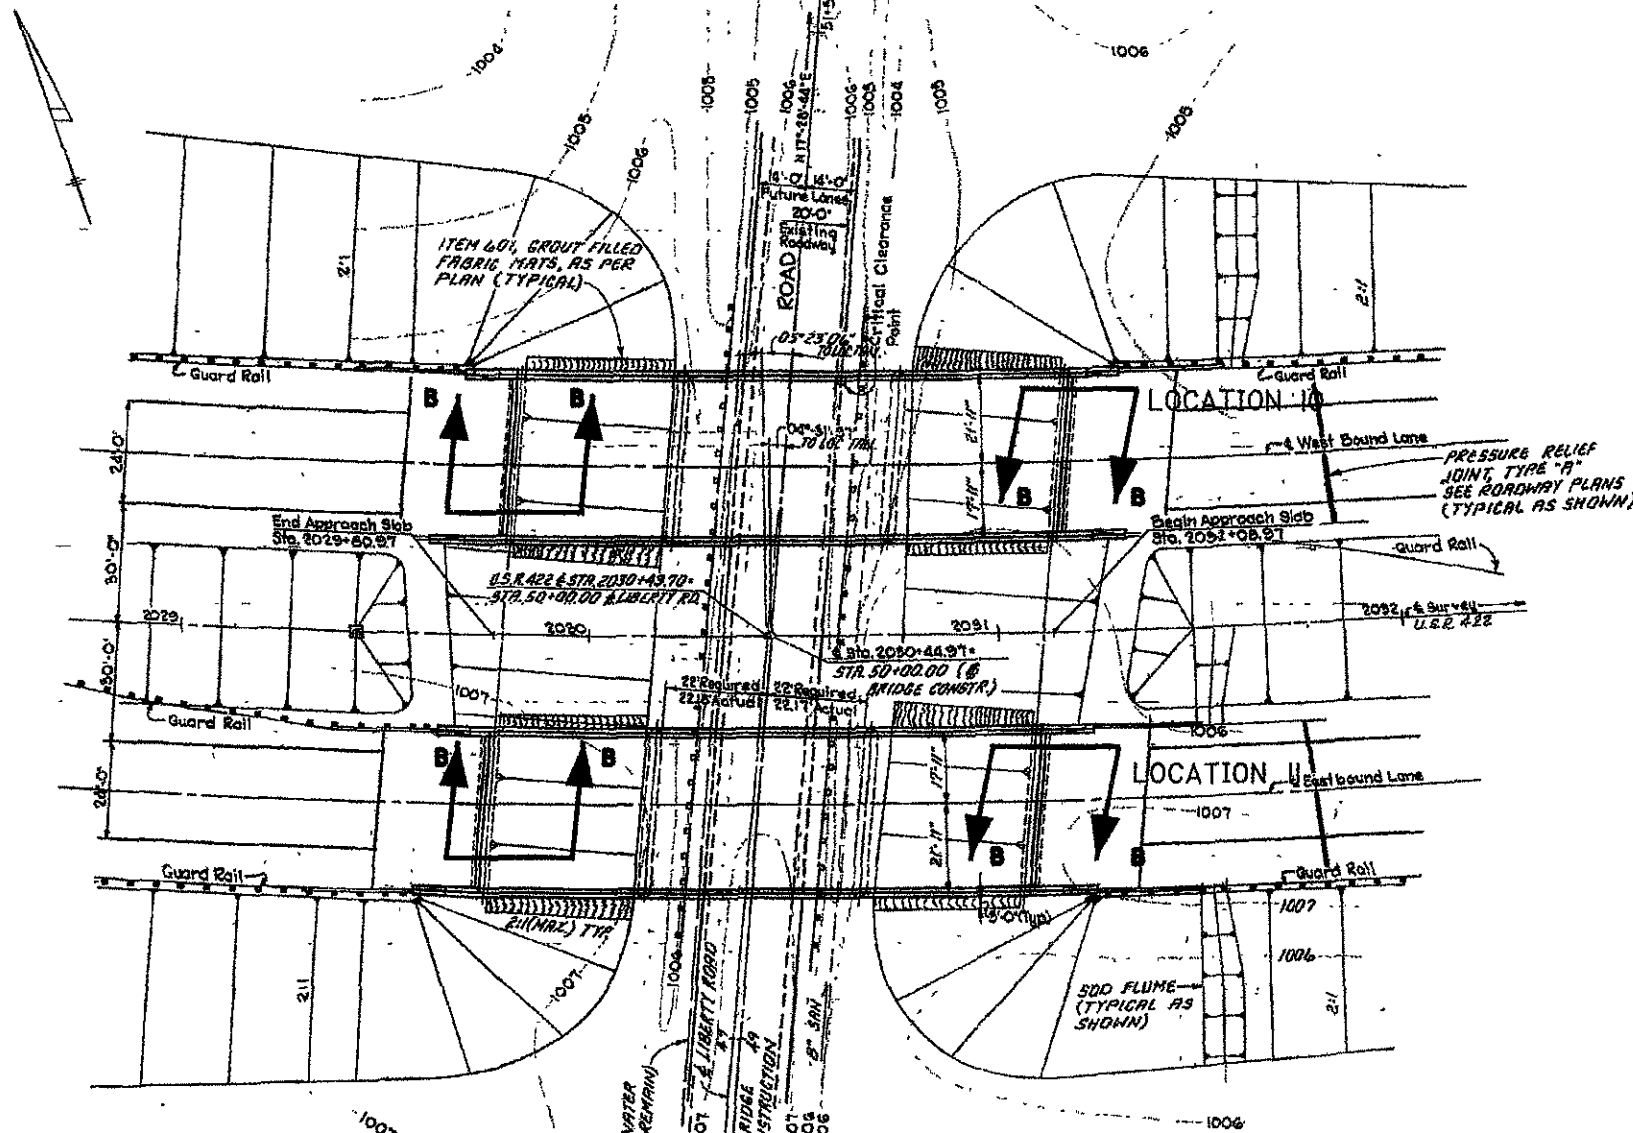

PROFILE ALONG CENTER LINE


EXISTING STRUCTURE
 TYPE: Continuous Steel Beam With Reinforced Concrete Deck And Substructure.
 SPANS: 58'-0", 47'-6", 25'-0" 96 Brgs.
 ROADWAY: 2 @ 37'-10" Parapets, 41'-8" OUT/ORT-SUBS
 LADING: 1320-44 (CASE II) AND THE ALTERNATE MILITARY LADING
 WEARING SURFACE: Manalittle Concrete
 APPROACH SLABS: 25'-7" 21' (25' LONG)
 ALIGNMENT: 2'-00" Curve Left
 SUPERELEVATION: 0.065%
 SLOPE PROTECTION: GROUT FILLED FABRIC MATS

PLAN AND PROFILE VIEWS
 ARE TAKEN FROM ORIGINAL
 PLANS AND SHOULD BE
 USED FOR INFORMATIONAL
 PURPOSES
 ALL DIMENSIONS ARE "+/-"

I:\PROJECTS\PI\18926\DCN\Cuy 422 1911 L.R. Liberty Rd\CUY422-1911-SITEPLAN.dgn 20-JAN-2006 2:40PM jthreot

DISTRICT TWELVE PRODUCTION DEPARTMENT	DATE: 01/20/06 REVISED: JRC STRUCTURE FILE NUMBER: TITLE S	STA. 2029+80 STA. 2031+08	SITE PLAN CUY-422-1911 L.R. LIBERTY R LOCATIONS 10,11
D12 BH FY2006 MISC. REPAIRS 2		23 31	

I:\PROJECTS\PI\078926\00N\Cuy_422_1911.R Liberty Rd\SCCUY422-1911.dgn 20-JAN-2006 2:49PM jthreat

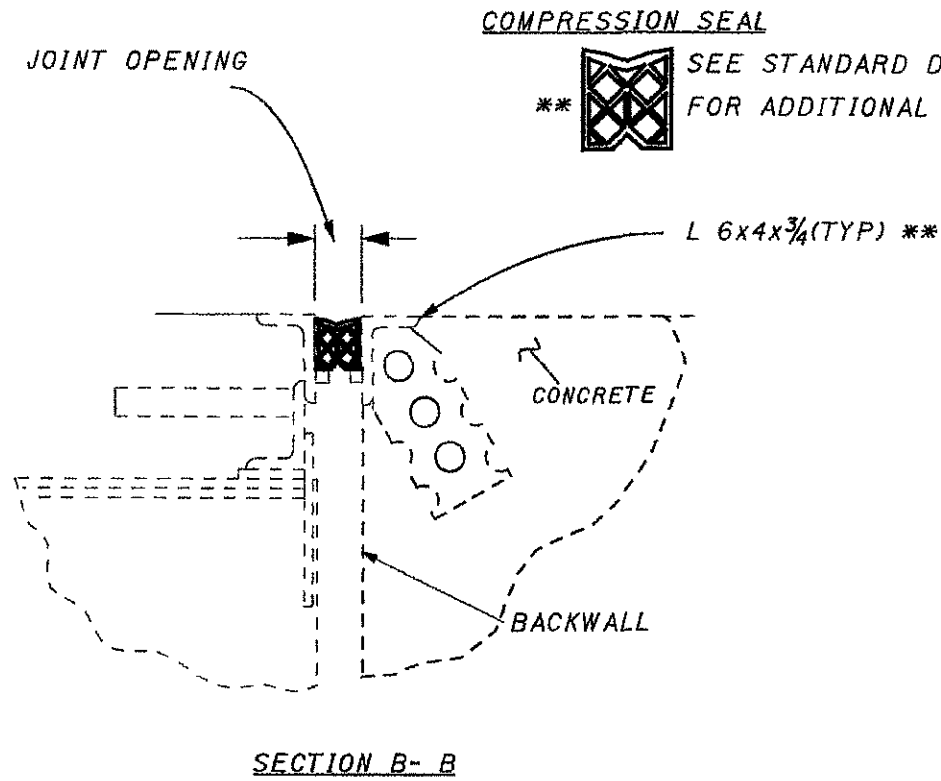

COMPRESSION SEAL



SEE STANDARD DRAWING EXJ-2-81
FOR ADDITIONAL INFORMATION

L 6x4x3/4(TYP) **

JOINT OPENING

CONCRETE

BACKWALL

SECTION B- B

CUY-422-1911L

JOINT OPENINGS AT SELECTED TEMPERATURES °F FOR LOCATION 10 GLAND SIZE 4"

TEMPERATURE	95	85	75	65	55	45
EAST ABUT.	2.845	2.901	2.957	3.013	3.069	3.125
WEST ABUT.	3.375	3.40	3.425	3.45	3.475	3.50

CUY-422-1911R

JOINT OPENINGS AT SELECTED TEMPERATURES °F FOR LOCATION 11 GLAND SIZE 4"

TEMPERATURE	95	85	75	65	55	45
EAST ABUT.	2.220	2.276	2.332	2.388	2.444	2.50
WEST ABUT.	1.250	1.275	1.30	1.325	1.35	1.375

PORPOSED WORK FOR CUY-422-1911L & R

- 1) REMOVE EXISTING COMPRESSION SEAL
- 2) THOROUGHLY CLEAN OUT AREA EXPOSED AS A RESULT OF REMOVAL
- 3) REPLACE WITH THE PROPER SIZE SEAL (SEE TABLE THIS DRAWING).

NOTES

- 1) INDICATE BY WAY OF AN AS-BUILT DRAWING THE TYPE OF REPLACEMENT SEAL USED.
- 2) COMPRESSION SEAL SHALL MEET THE REQUIREMENTS OF CMS 705.II.

EXPANSION JOINT DETAIL

TWO STRUCTURES
LOCATIONS 10, 11

D12 BH FY2006
MISC. REPAIRS 2

DESIGN AGENCY
DISTRICT TWELVE
PRODUCTION DEPARTMENT


DATE
01/20/06
STRUCTURE FILE NUMBER
SEE TITLE SHEET

DRAWN
JWC
CHECKED
JWC


DESIGNED
JWC
CHECKED
JWC

I:\PROJECTS\18926\DCN\CUY 237 0695 Relocated Snow Rd\CUY237-0695-SITEPLAN.sgn 20-JAN-2006 2:38PM jthreac

PROPOSED WORK
 REPLACE COMPRESSION SEAL

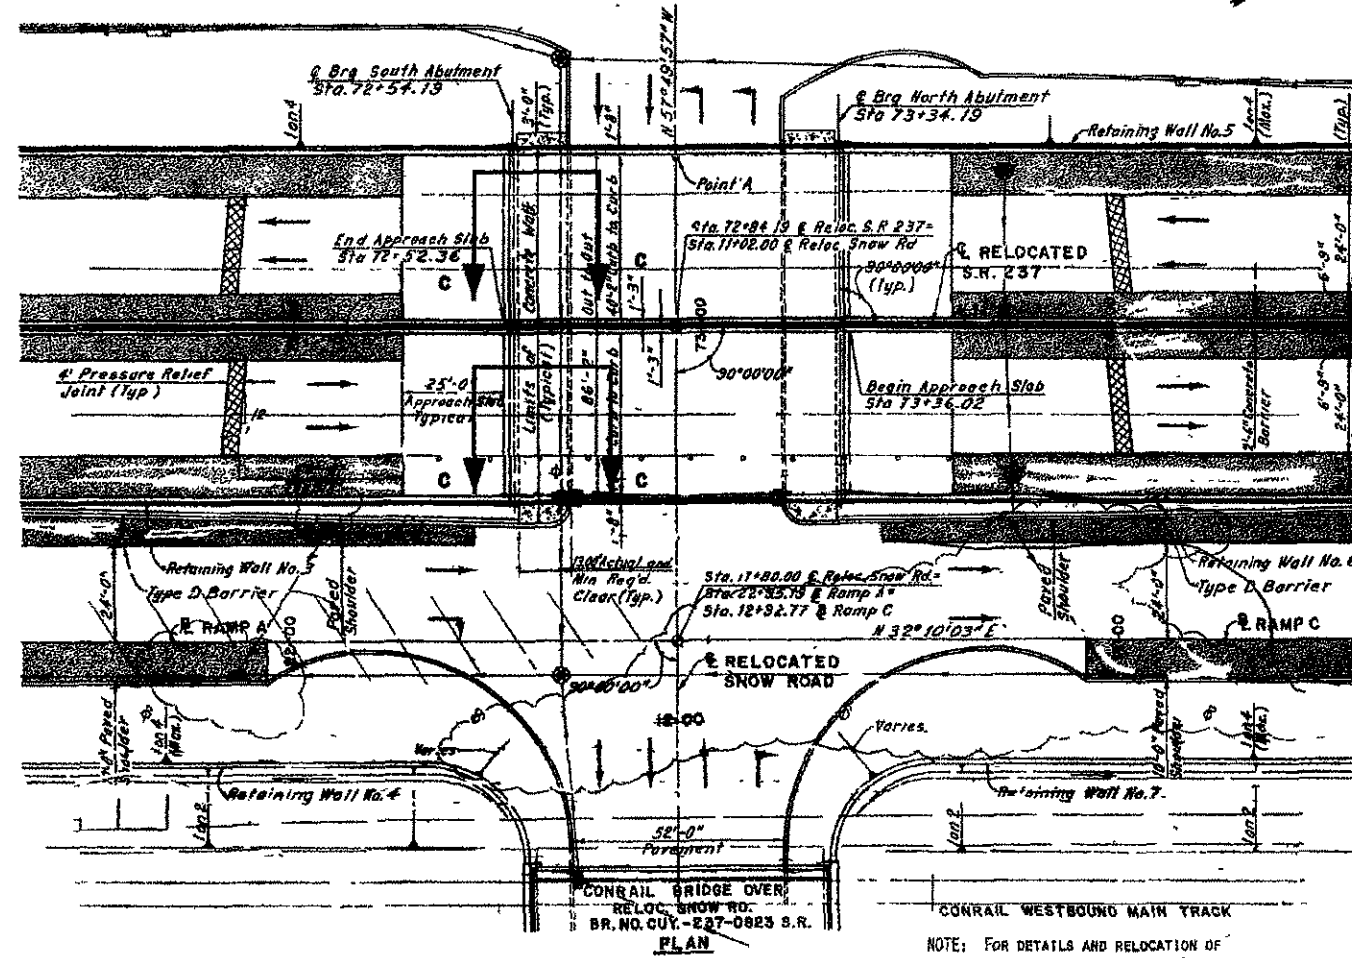

NOTE: FOR DETAILS AND RELOCATION OF
 EXISTING UTILITIES SEE ROADWAY PLANS.

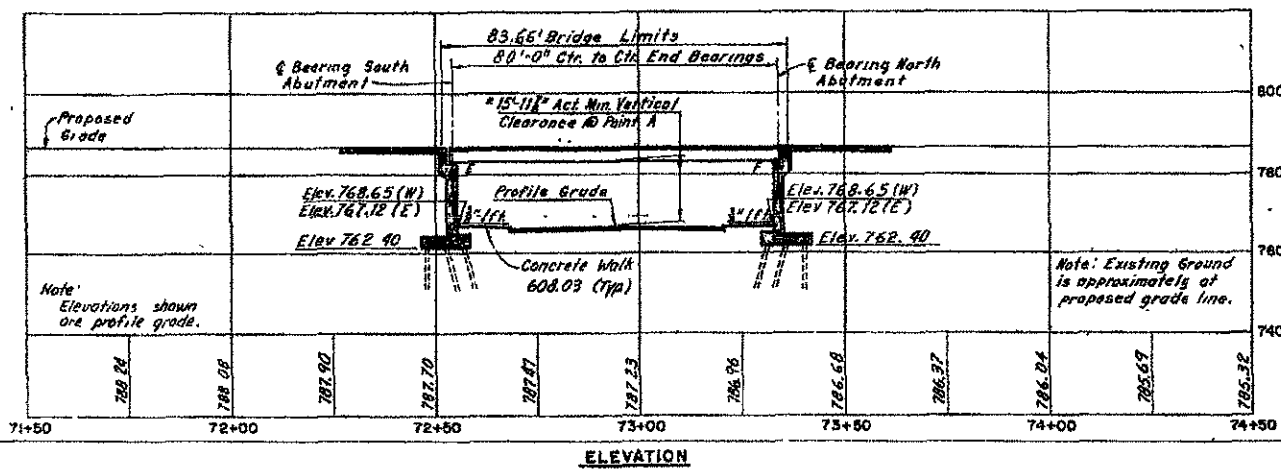


EXISTING STRUCTURE	
TYPE:	SIMPLE SPAN PRESTRESSED NON-COMPOSITE BOX BEAMS WITH REINFORCED CONCRETE SUBSTRUCTURE.
SPAN:	80'-0"
ROADWAY:	34'-0" FACE TO FACE OF PARAPETS WITH CONCRETE BARRIER MEDIAN.
LOADING:	HS 20-44 AND ALTERNATE MILITARY LOADING
SKEN:	NONE
WEARING SURFACE:	ASPHALT CONCRETE
APPROACH SLABS:	AS-1-72 (25'-0" LONG)
ALIGNMENT:	TANGENT
SUPERELEVATION:	NORMAL 0.0156 FT. PER FT.

DESIGN AGENCY: DISTRICT TWELVE
 PRODUCTION DEPARTMENT
 DATE: 01/20/06
 STRUCTURE FILE NUMBER:
 REVIEWED: JRC
 DRAWN: JMT
 CHECKED: JMT
 STA. 72+52.36
 STA. 73+36.02
 SITE PLAN
 CUY-237-0695 SNOW RD
 LOCATION 12
 D12 BH FY2006
 MISC. REPAIRS 2
 25/31

PLAN AND PROFILE VIEWS
 ARE TAKEN FROM ORIGINAL
 PLANS AND SHOULD BE
 USED FOR INFORMATIONAL
 PURPOSES
 ALL DIMENSIONS ARE "+/-"

I:\PROJECTS\178926\DMN\Cuy 237 0695 Relocated Snow Rd\SCCUY237-0695.dgn 20-JAN-2006 2:50PM jthreag

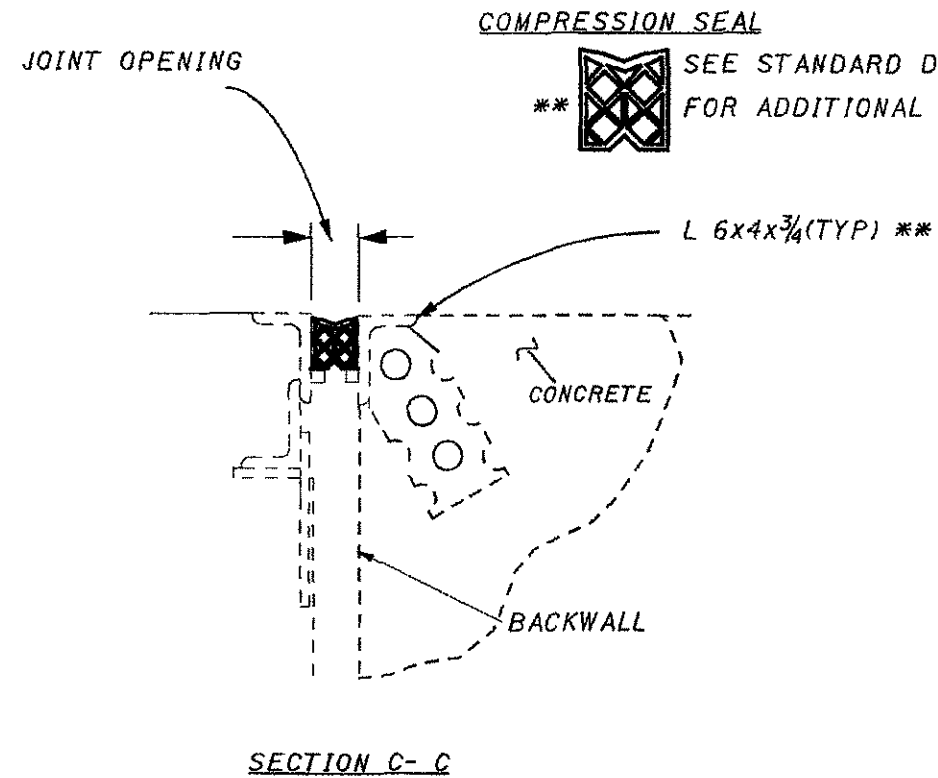

COMPRESSION SEAL



SEE STANDARD DRAWING EXJ-2-81
FOR ADDITIONAL INFORMATION

L 6x4x3/4(TYP) **

CONCRETE

BACKWALL

SECTION C-C

JOINT OPENINGS AT SELECTED TEMPERATURES °F FOR LOCATION 12 GLAND SIZE-2 1/2"

TEMPERATURE	95	85	75	65	55	45
SOUTH ABUT.	0.475	0.525	0.575	0.625	0.675	.075

PORPOSED WORK FOR CUY-237-0695

- 1) REMOVE EXISTING COMPRESSION SEAL
- 2) THOROUGHLY CLEAN OUT AREA EXPOSED AS A RESULT OF REMOVAL
- 3) REPLACE WITH THE PROPER SIZE SEAL (SEE TABLE THIS DRAWING).

NOTES

- 1) INDICATE BY WAY OF AN AS-BUILT DRAWING THE TYPE OF REPLACEMENT SEAL USED.
- 2) COMPRESSION SEAL SHALL MEET THE REQUIREMENTS OF CMS 705.II.

EXPANSION JOINT DETAIL
ONE STRUCTURE
LOCATIONS 12

D12 BH FY2006
MISC. REPAIRS 2

DISTRICT TWELVE
PRODUCTION DEPARTMENT


DATE 01/20/06
STRUCTURE FILE NUMBER 1810286

DESIGNED JRC
DRAWN JWC


CHECKED JWC

26
31

I:\PROJECTS\178925\DCM\Geo_608_0710_Unnamed_Creek\GEA608-0710-SITEPLAN.DGN 20-JAN-2006 2:45PM jthreac

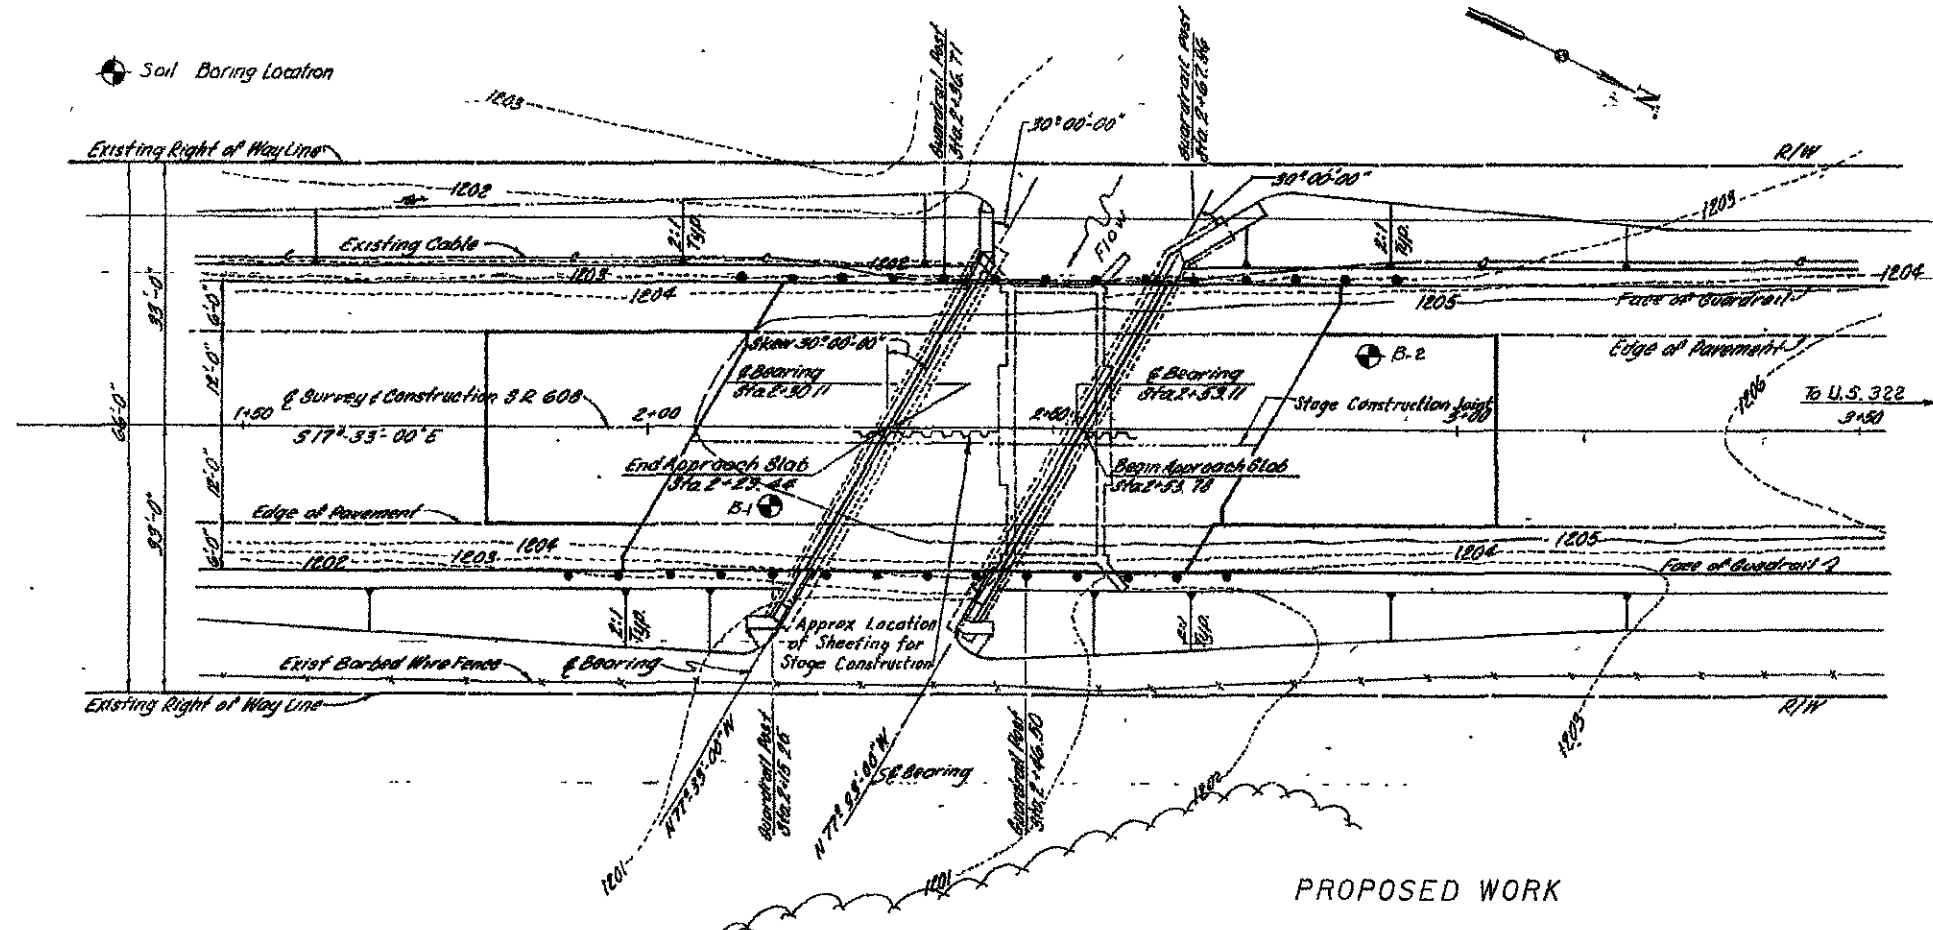


PROPOSED WORK
 1 REPLACE EXISTING OVERLAY WITH NEW OVERLAY
 2 REPLACE DRIP STRIP
 REPLACE EXISTING WATERPROOFING WITH TYPE D WATERPROOFING

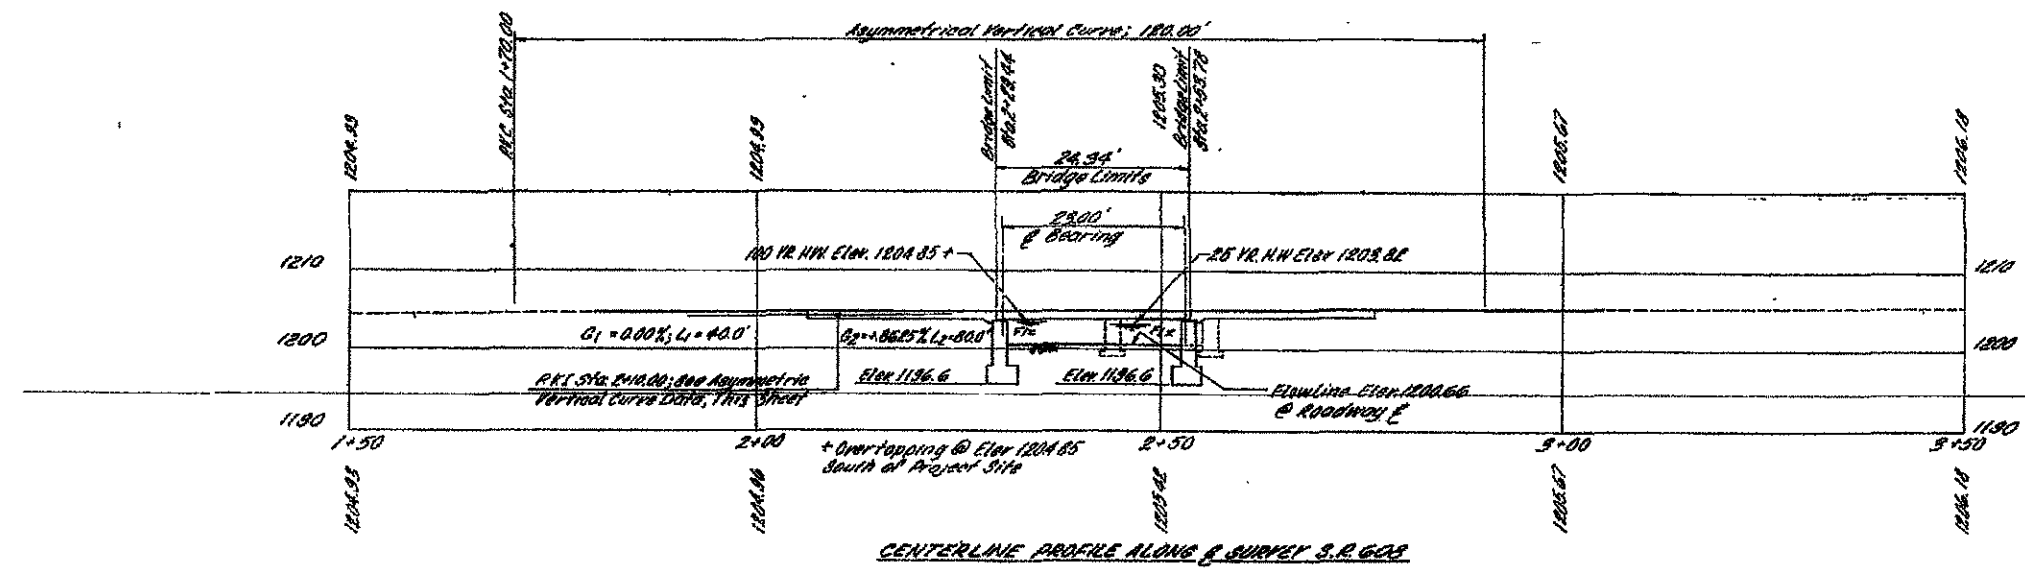

EXISTING STRUCTURE
 Type: Single Span Prestressed Concrete Box Beam
 Span: 23'-0" Center of Bearings
 Roadway Width: 36'-0" F.F. of Railings
 Design Loading: HS-20-44 And The Alternate Military
 Skew: 30°-00'-00" Left Forward
 Bearing Surface: 8" Asphalt Concrete
 Approach Slabs: 18'-1'-8", 20'-0"
 Alignment: Tangent
 Crown: 4" in 1' R

PLAN AND PROFILE VIEWS ARE TAKEN FROM ORIGINAL PLANS AND SHOULD BE USED FOR INFORMATIONAL PURPOSES.
 ALL DIMENSIONS ARE "+/-"

DESIGN AGENCY DISTRICT TWELVE PRODUCTION DEPARTMENT	DATE 01/20/06
	REVIEWED JRC
	STRUCTURE FILE NUMBER 2802252
	BRNRY JMT
DESIGNED JMT	CHECKED
STA.: 2+29.44 STA.: 2+53.78	LOCATION 14
SITE PLAN GEA-608-0710 UNNAMED CREEK LOCATTION 14	
D12 BH FY2006 MISC. REPAIRS 2	
28 31	

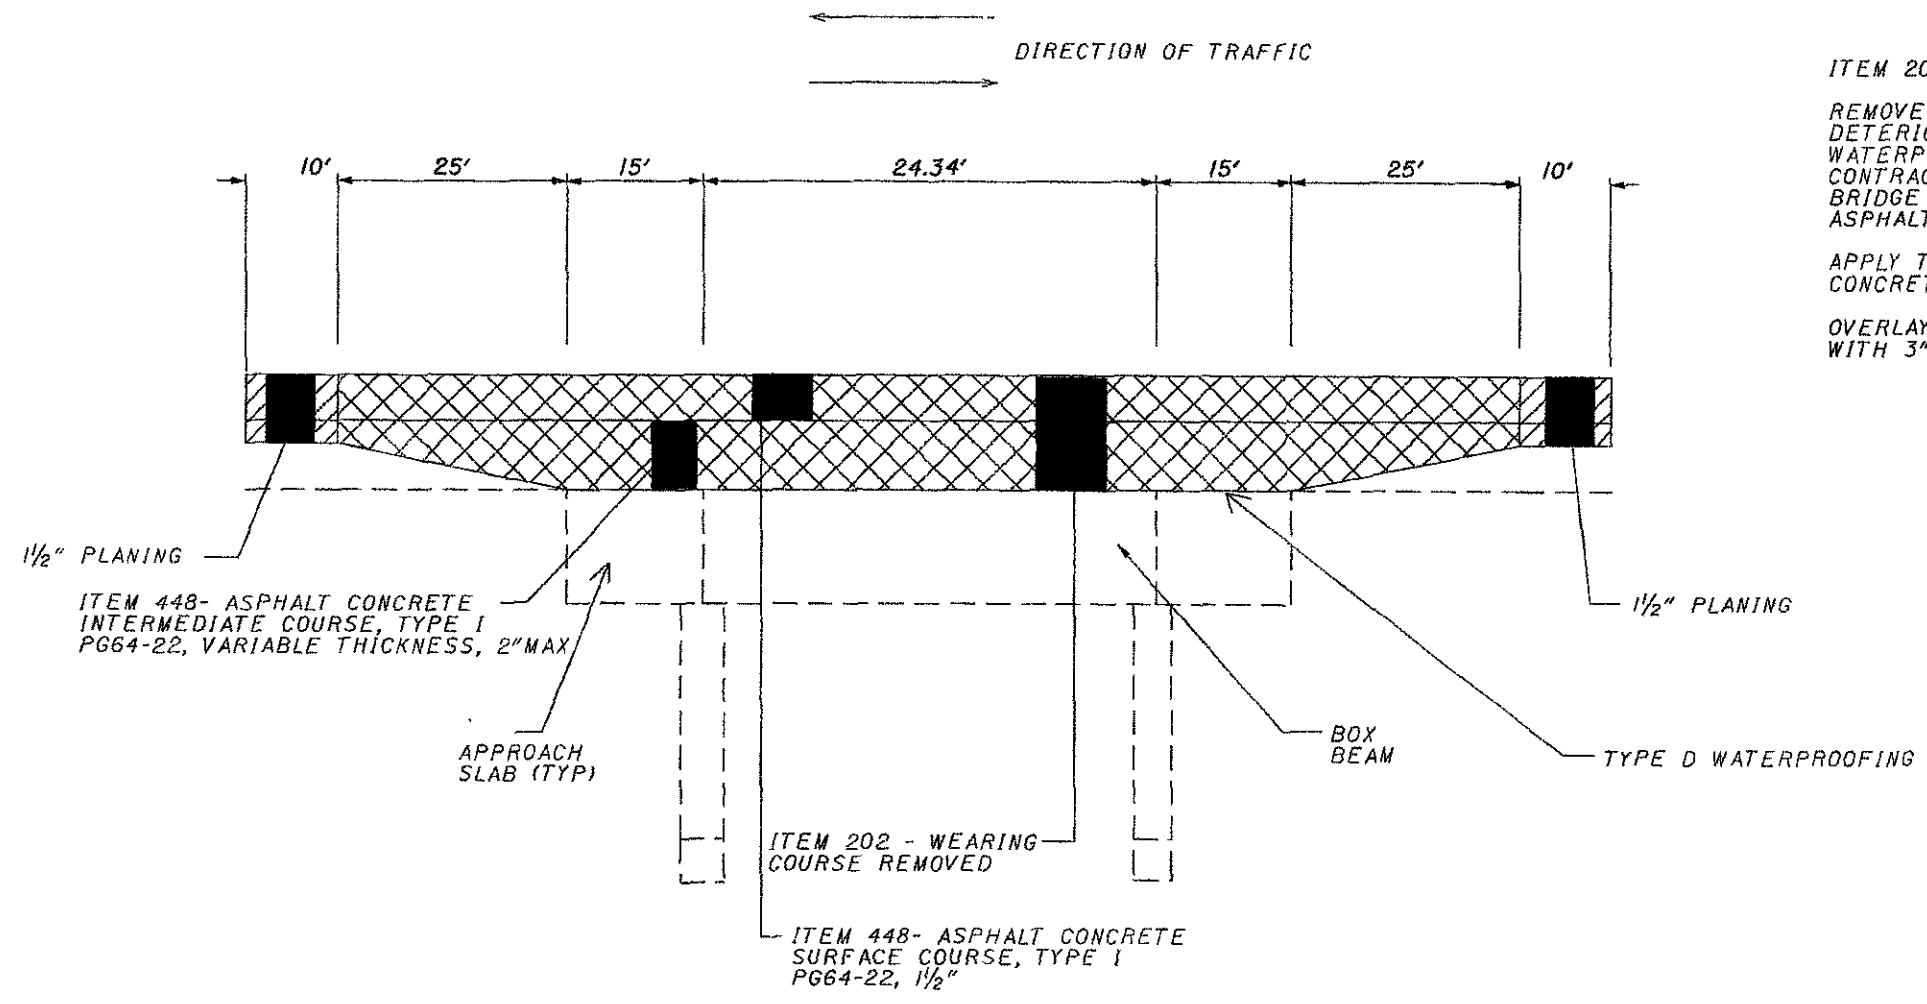

ITEM 202-WEARING COURSE REMOVED:
 REMOVE EXISTING ASPHALT WEARING SURFACE AND DETERIORATED PORTIONS OF EXISTING WATERPROOFING MEMBRANE FROM BRIDGE DECK. CONTRACTOR SHALL USE CAUTION WHEN PLANING ON BRIDGE DECK SO AS NOT TO DAMAGE EXISTING BOX BEAMS. ASPHALT OVERLAY ON BRIDGE DECK IS VARIABLE, REFER TO DETAIL 2

APPLY TYPE D WATERPROOFING TO TOP OF CONCRETE BOX BEAMS AND APPROACH SLABS.

OVERLAY THE BRIDGE DECK AND APPROACH SLABS WITH 3" OF ASPHALT.

1/2" PLANING

ITEM 448- ASPHALT CONCRETE INTERMEDIATE COURSE, TYPE 1 PG64-22, VARIABLE THICKNESS, 2" MAX

APPROACH SLAB (TYP)


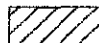
BOX BEAM


TYPE D WATERPROOFING

ITEM 202 - WEARING COURSE REMOVED

ITEM 448- ASPHALT CONCRETE SURFACE COURSE, TYPE 1 PG64-22, 1 1/2"


DETAIL 1

-  ITEM 202 WEARING COURSE REMOVED
-  ITEM 254 PAVEMENT PLANING (1 1/2")

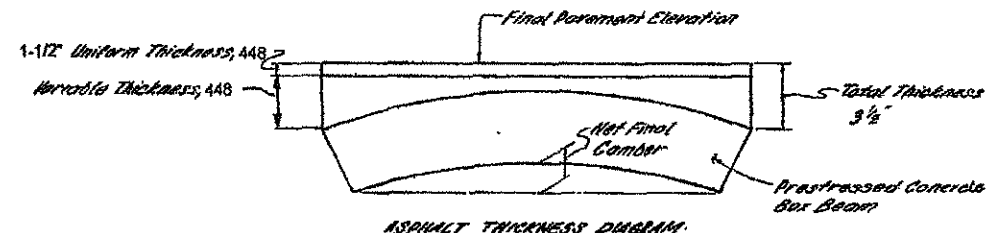

DETAIL 2

NOT TO SCALE

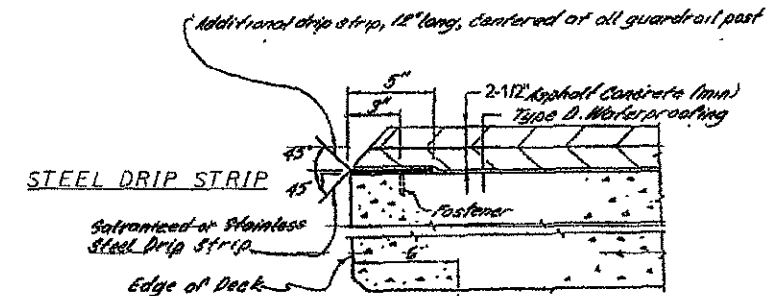

ITEM 518 SPECIAL-STEEL DRIP STRIP, AS PER PLAN
 STEEL DRIP STRIP-PRIOR TO APPLYING DECK TYPE D WATERPROOFING, A BENT DRIP STRIP SHALL BE INSTALLED ALONG THE EDGES OF THE DECK AS SHOWN. THE STRIPS SHALL BE FASTENED AT 1'-6" C/C MAXIMUM WITH 1-1/4" X 3/32" X 1/4" FLAT HEAD DRIVE PIN AND WASHER (LENGTH X SHANK DIA. X HEAD DIA.) OR #10 GALVANIZED SCREWS AND EXPANSION ANCHORS, SUBJECT TO THE APPROVAL OF THE ENGINEER. THE STRIPS SHALL BE PLACED THE FULL LENGTH OF THE DECK, ENDING AT THE FACE OF THE ABUTMENT WINGWALL. WHERE SPLICES ARE REQUIRED A 3" (MIN) LAP SHALL BE USED WITH A FASTENER THROUGH THE LAP. STEEL FOR GALVANIZED STRIPS SHALL BE 8" X 0.105" AND SHALL MEET THE REQUIREMENTS OF ASTM 568. GALVANIZING SHALL BE IN ACCORDANCE WITH 711.02. STAINLESS STEEL SHALL BE 20 GAUGE ASTM A167, TYPE 304, MILL FINISH. PAYMENT SHALL BE AT THE CONTRACT PRICE BID FOR ITEM SPECIAL, 50 FT, STEEL DRIP STRIP, WHICH SHALL INCLUDE ALL MATERIALS, LABOR, TOOLS, AND INCIDENTALS NECESSARY TO COMPLETE THE ITEM.

I:\PROJECTS\178926\DCM\78926 For Gen508.dgn 20-JAN-2006 2:52PM jtr

ITEM 614 - MAINTAINING TRAFFIC:

GENERAL

GENERALLY THE CONTRACTOR SHALL CONDUCT HIS OPERATIONS AS TO MAKE THE PROPOSED REPAIR WITH A MINIMUM OF HAZARD, DELAY AND INCONVENIENCE TO THE MOTORISTS USING THE HIGHWAY. FURTHERMORE, IN ADDITION TO THE CONSTRUCTION AND MATERIAL SPECIFICATIONS, THE FOLLOWING SPECIFIC PROVISIONS ARE MANDATORY.

NOTIFICATION

SINCE FUNCTIONAL TRAFFIC CONTROL IS A MAJOR CONCERN ON THIS PROJECT, IT IS ESSENTIAL THAT THE MOTORING PUBLIC BE ADEQUATELY FOREWARNED OF FUTURE LANE CLOSURES AND TRAFFIC CONSTRICTIONS. THEREFORE, THE CONTRACTOR SHALL SUBMIT A SCHEDULE TO THE OHIO DEPARTMENT OF TRANSPORTATION INDICATING THE LOCATIONS AND DATES OF THE LANE CLOSURES AT LEAST THREE (3) DAYS PRIOR TO THE IMPLEMENTATION OF ANY SUCH CLOSURES. ADDITIONALLY, THE CONTRACTOR SHALL MAKE A SKETCH OF EACH SITE (LOCATION) AND APPLICABLE TRAFFIC CONTROL INCLUDING DETOURS IF NEEDED AND SUBMIT THIS TO THE PROJECT ENGINEER DURING THE PRE CONSTRUCTION CONFERENCE. THE CONTRACTOR SHALL ALSO NOTIFY THE LOCAL LAW ENFORCEMENT AGENCIES OF LANE CLOSURES AT LEAST THREE (3) DAYS PRIOR TO IMPLEMENTATION.

RESTRICTIONS (FOR LOCATIONS 1,2,3,4,5,6,7,8,9,10,11, AND 12)

LANE CLOSURES MAY ONLY BE IMPLEMENTED AT THE TIMES PERMITTED BY THE "DISTRICT 12, PERMITTED LANE CLOSURE TIMES" LIST, WHICH IS LOCATED ON THE ODOT WEB SITE:

www.dot.state.oh.us/dist12/workzone/laneolo.htm

THE LATEST REVISION, AT 14 DAYS PRIOR TO THE BID DATE, SHALL BE IN EFFECT FOR THIS PROJECT.

ANY ROADWAY NOT LISTED IN THE "DISTRICT 12 PERMITTED LANE CLOSURE TIMES" SHALL NOT HAVE ANY CLOSURES WEEKDAYS FROM 6am-9:30am AND 3:30pm-6pm.

NO LANE OR SHOULDER CLOSURES SHALL BE IN PLACE WHEN NO WORK IS BEING PERFORMED.

UNLESS OTHERWISE NOTED EXIT AND ENTRANCE RAMPS LANES SHALL REMAIN OPEN AT ALL TIMES AND EXHIBIT A MINIMUM WIDTH OF TEN (10) FEET.

ANY AND ALL EXCEPTIONS ARE NOTED BELOW ACCORDING TO EACH LOCATION

LOCATION 13

WEEKEND OVERLAY FOR BIG PATCHES
1 LANE EACH DIRECTION MAY BE CLOSED FROM
FRIDAY 7PM TO 6AM MONDAY. FOR TWO WEEKENDS

LOCATIONS 1,2,6, AND 9

- 1 ONLY 1 SIDEWALK CAN BE CLOSED AT A TIME
- 2 CONTRACTOR MUST SHOW SKETCH FOR SIDEWALK CLOSURE, FOR ACCEPTANCE BY PROJECT ENGINEER. MUST SHOW SIGNING FOR SIDEWALK CLOSURE.

LOCATION 14

CONTRACTOR MUST EMPLOY SIGNALIZED CLOSURE

MAINTENANCE OF TRAFFIC SCHEME

APPLICABLE FOR ALL LOCATIONS

THE CONTRACTOR SHALL HAVE THE WORKSITE TRAFFIC SUPERVISOR TURN INTO THE PROJECT ENGINEER A HAND SKETCH, TRAFFIC CONTROL PLAN, 3 DAYS BEFORE THE ZONE IS TO BE SET UP. THE TRAFFIC CONTROL PLAN SHALL SHOW THE LOCATIONS OF THE WORK ZONE SIGNS, TAPER LENGTHS, DELINEATION DEVICES, ARROW BOARDS AND ALL WORK ZONE TRAFFIC CONTROL ITEMS. STANDARD DRAWINGS, PLAN SHEETS AND THE OHIO MANUAL OF UNIFORM TRAFFIC CONTROL DEVICES SHALL BE USED AS A REFERENCE.

ALL WORK SHALL BE CONDUCTED FROM WITHIN A ONE OR TWO LANE CLOSURE USING DRUMS ACCORDING TO THE RESTRICTIONS AND THE CONCEPTS PRESENTED IN MT-95.30 AND ASSOCIATED STANDARD CONSTRUCTION DRAWINGS MT-98.12 THRU MT-98.16 (SEE TITLE SHEET), AND THESE PLANS.

APPLICABLE FOR LOCATIONS: 13,14

THE CONTRACTOR SHALL DEVISE A SIMPLE MAINTENANCE OF TRAFFIC SCHEME, WHICH SHALL BE STAMPED BY A PROFESSIONAL ENGINEER (SCHEME MAY BE A HAND SKETCH) AND PRESENTED TO THE DISTRICT WORKZONE TRAFFIC CONTROL ENGINEER AND PROJECT ENGINEER FOR ACCEPTANCE AT LEAST TWO WEEKS PRIOR TO IMPLEMENTATION. THE MAINTENANCE OF TRAFFIC SCHEME SHALL PRESENT, IN GENERAL, THE METHODS FOR MAINTAINING TRAFFIC THAT THE CONTRACTOR PROPOSES TO USE FOR CONDUCTING THE REQUIRED WORK IN A SAFE AND EFFICIENT MANNER, SUPPORTED BY HAND SKETCHES AS NECESSARY. THE MAINTENANCE OF TRAFFIC SCHEME SHALL BE IN CONFORMANCE WITH THE OHIO MANUAL OF UNIFORM TRAFFIC CONTROL DEVICES, LATEST REVISION, THE REFERENCED STANDARD CONSTRUCTION DRAWINGS, THE ATTACHED MAINTENANCE OF TRAFFIC SHEETS, AND THE SPECIFICATIONS. THE CONTRACTOR SHALL NOT COMMENCE WORK UNTIL THE MAINTENANCE OF TRAFFIC SCHEME HAS BEEN APPROVED.

APPLICABLE FOR ALL LOCATIONS

IF DURING THE PROJECT, THE ENGINEER DETERMINES THAT THE MAINTENANCE OF TRAFFIC PLAN IS NOT PERFORMING AS DESIRED, THE WORK SHALL BE SUSPENDED UNTIL THE PROBLEM IS RESOLVED TO THE SATISFACTION OF THE ENGINEER AND THE MAINTENANCE OF TRAFFIC PLAN IS REVISED ACCORDINGLY. ANY COSTS OR DELAYS INCURRED AS A RESULT OF THE FAILURE OF THE SATISFACTION OF THE ENGINEER SHALL BE THE FULL RESPONSIBILITY OF THE CONTRACTOR.

DURING NON-WORKING HOURS, ALL LANES SHALL BE IN FULL OPERATION WITH ALL TRAFFIC CONTROL SIGNS, EXCEPT 0W-124 (ROAD CONSTRUCTION AHEAD) SIGNS, REMOVED OR COVERED AND ALL CHANNELIZING DEVICES REMOVED FROM THE PAVEMENT SURFACES. CHANNELIZING DEVICES MAY BE STORED OR DEPLOYED TEMPORARILY ADJACENT TO THE SHOULDER TO MINIMIZE THE NIGHTLY TRAFFIC CONTROL SET-UP TIME.

CONSTRUCTION EQUIPMENT, PRIVATE VEHICLES AND MATERIALS SHALL NOT BE PARKED OR STORED ON THE ROADWAY ADJACENT TO THE ROADWAY WITHIN THE 30 FOOT CLEAR ZONE OF THE TRAVELED LANES.

IF IN THE OPINION OF THE ENGINEER, THE CONTRACTOR FAILS TO COMPLY WITH THESE REQUIREMENTS OR THE PROVISIONS OF THE APPROVED MAINTENANCE OF TRAFFIC PLAN, THE ENGINEER SHALL SUSPEND WORK UNTIL ALL REQUIREMENTS ARE COMPLIED WITH. ANY COSTS OR DELAYS INCURRED AS A RESULT OF THE FAILURE SHALL BE THE FULL RESPONSIBILITY OF THE CONTRACTOR.

NOTWITHSTANDING THE ABOVE, NO LANE OR SHOULDER CLOSURES SHALL OCCUR DURING THE PERIOD BEGINNING AT 12:00 NOON ON THE DAY PRECEDING AND CONTINUING UNTIL NOON ON THE DAY FOLLOWING LEGAL HOLIDAYS AND HOLIDAY WEEKENDS SUCH AS MEMORIAL DAY, FOURTH OF JULY, AND LABOR DAY OR WHEN THE ENGINEER DEEMS THE CLIMATOLOGICAL CONDITIONS TOO HAZARDOUS.

PAYMENT FOR ALL THE ITEMS REQUIRED TO MAINTAIN TRAFFIC IN ACCORDANCE WITH THESE REQUIREMENTS SHALL BE INCLUDED IN THE LUMP SUM PRICE BID FOR ITEM 614 - MAINTAINING TRAFFIC.

FURTHERMORE, NO LANE CLOSURES SHALL BE IMPLEMENTED OR IN PLACE DURING INCREASED TRAFFIC VOLUMES CAUSED BY SPECIAL EVENTS WITH A SEATING CAPACITY OVER 20,000 (IN LIEU OF NOTE 1 IN THE "DISTRICT 12, PERMITTED LANE CLOSURE TIMES" LIST), OR WHEN THE ENGINEER DEEMS THE CLIMATOLOGICAL CONDITIONS TOO HAZARDOUS.

ITEM 614 - PORTABLE CHANGEABLE MESSAGE SIGN, AS PER PLAN

THE CONTRACTOR SHALL FURNISH, INSTALL, MAINTAIN, AND REMOVE WHEN NO LONGER NEEDED A PORTABLE CHANGEABLE MESSAGE SIGN (S). THE PCMS SHALL BE OF THE TYPE SHOWN ON THE LIST OF APPROVED PCMS MAINTAINED BY THE DIRECTOR. THE PCMS SHALL BE A CLASS I OR II TYPE UNIT. NO FLIP DISK ALLOWED.

THE PORTABLE CHANGEABLE MESSAGE SIGN SHALL BE MOUNTED ON A TRAILER. THE LOCATION OF THE PCMS SHALL BE AS DIRECTED BY THE ENGINEER. THE ENGINEER SHALL BE PROVIDED ACCESS TO EACH SIGN UNIT AND SHALL BE PROVIDED WITH APPROPRIATE TRAINING AND OPERATION INSTRUCTIONS.

THE PCMS SHALL BE EQUIPPED WITH A MYRIAD SAFETY BEAM OR AN APPROVED EQUAL AS DETERMINED BY THE ENGINEER. THE MYRIAD SAFETY BEAM SENDS OUT A SIGNAL THAT ACTIVATES RADAR DETECTORS. THE BEAM IS APPROVED BY THE F.C.C. THE MYRIAD SAFETY BEAM SHALL USE THE SAME POWER SUPPLY AS THE PCMS. THE MYRIAD SAFETY BEAM SHALL BE ABLE TO BE ACTIVATED WITH THE PCMS RUNNING OR NOT. THE MYRIAD SAFETY BEAM IS DISTRIBUTED BY THE TRIPLEX GROUP, INC., P.O. BOX 428, NEW HOPE, PA. 18938. PHONE (215) 862-5077.

THE PCMS SHALL CONTAIN A CELLULAR TELEPHONE LINK WHICH WILL ALLOW REMOTE SIGN ACTIVATION, DEACTIVATION, MESSAGE CHANGES, MESSAGE ADDITIONS AND REVISIONS TO TIME OF DAY PROGRAMS. THE SYSTEM SHALL ALSO PERMIT VERIFICATION OF CURRENT AND PROGRAMMED MESSAGES.

THE CONTRACTOR SHALL PROVIDE TO THE ENGINEER THE SOFTWARE NECESSARY TO CONTROL THE PCMS REMOTELY.

AT THE DIRECTION OF THE ENGINEER THE PCMS MAY BE REMOVED FOR PERIODS OR TIMES WHEN NOT IN USE. NO PAYMENT WILL BE MADE FOR THESE TIMES (EX. WINTER MONTHS).

THERE SHALL BE ONE CLASS I OR II CHANGEABLE MESSAGE SIGN

ITEM 614 - PORTABLE CHANGEABLE MESSAGE SIGN,
AS PER PLAN 1 EACH

I:\PROJECTS\178926\DCN\MN78926.dgn 20-JAN-2006 2:32PM jthreac

MAINTENANCE OF TRAFFIC NOTES

D12 BH FY2006
MISC. REPAIRS 2

MAINTENANCE OF TRAFFIC SYSTEMS

A. WHEN REQUIRED

WHENEVER ANY PART OF THE TRAVELED SURFACE IS BEING WORKED UPON OR IS OTHERWISE NOT SUITABLE FOR SAFE AND CONVENIENT USE BY VEHICLES, TRAFFIC CONTROL DEVICES SUFFICIENT TO PROTECT SUCH AREAS TO ASSURE THE SAFE AND CONVENIENT PASSAGE OF VEHICULAR TRAFFIC SHALL BE INSTALLED AND MAINTAINED. SUCH TRAFFIC CONTROL DEVICES AND THE MANNER IN WHICH THEY ARE USED SHALL BE CONSISTENT WITH THESE PLANS AND THE OHIO MANUAL OF UNIFORM TRAFFIC CONTROL DEVICES FOR STREETS AND HIGHWAYS (HEREINAFTER REFERRED TO AS THE "MANUAL"). THE TRAFFIC CONTROL DEVICE SYSTEM SHALL CONSTITUTE THE MINIMUM PROVISIONS FOR TRAFFIC CONTROL FOR EACH PARTICULAR SITUATION. WHENEVER THE ENGINEER DEEMS IT NECESSARY ESPECIALLY WHERE A GRADE, CURVE, OR MERGE CONDITIONS EXIST, HE MAY DIRECT THAT ADDITIONAL OR ALTERNATIVE DEVICES BE USED.

B. CONDITIONS

DURING ALL PARTS OF THIS PROJECT, SIGNING, BARRICADES, FLASHING ARROWS, ETC. SHALL BE LOCATED AS INDICATED IN THE MANUAL OR AS SHOWN ON THE REFERENCED STANDARD CONSTRUCTION DRAWINGS.

C. ADVANCE WARNING SIGNS

ALL ADVANCE WARNING SIGNS FOR ANY CONDITION WHICH RESTRICTS TRAFFIC SHALL BE ERECTED BEFORE ANY SUCH RESTRICTION IS PUT INTO EFFECT. ALL SUCH SIGNS SHALL BE COVERED OR REMOVED FROM THE VIEW OF TRAFFIC WHENEVER THEY ARE NOT APPLICABLE.

D. FLASHING ARROW REQUIREMENT

FLASHING ARROWS SHALL BE FURNISHED AS SHOWN ON THE REFERENCED STANDARD CONSTRUCTION DRAWINGS.

E. PROTECTION OF PUBLIC

WHENEVER ANY WORK IS BEING DONE OVER A TRAVELED LANE OR SHOULDER, THE CONTRACTOR SHALL SUPPLY SUFFICIENT SAFETY EQUIPMENT AS APPROVED BY THE DIRECTOR TO PROTECT THE TRAVELING PUBLIC FROM ANY CONSTRUCTION DEBRIS. IF TRAVELED LANES UNDER STRUCTURES ARE TO BE CLOSED FOR REASONS OF SAFETY, METHOD AND TIME OF CLOSURE MUST BE APPROVED PRIOR TO IMPLEMENTATION. PERSONAL CARS SHALL NOT BE PARKED WITHIN THE L/A.

F. FLAGGERS

FLAGGERS SHALL BE IN ACCORDANCE WITH MT-97.10. THE MAINTENANCE OF TRAFFIC PLANS REQUIRE THE USE OF TWO (2) FLAGGERS. ADDITIONAL FLAGGERS SHALL BE USED AS DIRECTED BY THE ENGINEER.

G. LAW ENFORCEMENT OFFICER WITH PATROL CAR

THE CONTRACTOR SHALL PROVIDE AND PAY ALL COST FOR THE SERVICES OF LAW ENFORCEMENT OFFICER WITH PATROL CAR FOR THE EXCLUSIVE PURPOSE OF CONTROLLING TRAFFIC AS DETERMINED BY THE ENGINEER. THE NUMBER OF OFFICERS AND CARS REQUIRED FOR THIS PURPOSE SHALL BE DETERMINED BY THE CONTRACTOR AND APPROVED BY THE ENGINEER. THE OFFICERS SHALL MOVE THEIR PATROL CARS AS NECESSARY TO INSURE THEIR CONSTANT PRESENCE AT THE POINT(S) OF SLOWDOWN, STOPPAGE OR BACK-UP. IT SHALL BE THE RESPONSIBILITY OF THE CONTRACTOR TO MAKE ARRANGEMENTS FOR SCHEDULING AND PAYMENT OF LAW ENFORCEMENT OFFICER WITH PATROL CAR.

PAYMENT FOR ALL OF THE ABOVE SHALL BE INCLUDED IN THE MAN HOUR PRICE BID FOR ITEM 614 - LAW ENFORCEMENT OFFICER WITH PATROL CAR.

H. WORKSITE TRAFFIC SUPERVISOR

THE CONTRACTOR SHALL EMPLOY (OTHER THAN THE SUPERINTENDENT) AND SUBJECT TO THE APPROVAL OF THE ENGINEER, A CERTIFIED WORKSITE TRAFFIC SUPERVISOR (WTS). THE WTS MAY BE CERTIFIED FROM ONE OF THE FOLLOWING ORGANIZATIONS:

- 1) AMERICAN TRAFFIC SAFETY SERVICE ASSOCIATION A.T.S.S.A. PHONE NUMBER 1-800-272-8772) CERTIFIED WORKSITE TRAFFIC SUPERVISOR (WTS)
- 2) THE NATIONAL SAFETY COUNCIL, TRAFFIC CONTROL ZONES SUPERVISORS COURSE, PHONE NO. 1-800-441-5103
- 3) NATIONAL HIGHWAY INSTITUTE, DESIGN AND OPERATION OF WORK ZONE TRAFFIC CONTROL, PHONE NO. 1-703-235-0528

THE WTS POSITION IS ESTABLISHED FOR THE PURPOSE OF MONITORING AND CORRECTING ANY TRAFFIC CONTROL DEFICIENCIES IN THE WORK ZONE. THE WTS SHALL OVERSEE ALL OPERATIONS THAT AFFECT THE MOVEMENT OF VEHICULAR AND PEDESTRIAN TRAFFIC THROUGH THE WORK ZONE.

THE WTS SHALL BE PRESENT WHEN THE CONTRACTOR OR SUBCONTRACTOR INSTALLS A TRAFFIC RESTRICTION, LANE CLOSURE, ETC. IN LIEU OF THE WTS BEING PRESENT WHEN A SUBCONTRACTOR HAS A WORKZONE IN PLACE, THE CONTRACTOR MAY USE HIS OWN PERSONNEL THAT IS A CERTIFIED WTS. THE CONTRACTOR OR SUBCONTRACTOR MUST PRESENT A COPY OF HIS WTS CERTIFICATE TO THE PROJECT ENGINEER. A WTS MUST BE PRESENT WHEN THE WORK ZONE IS BEING SET UP. HE MUST APPROVE THE WORK ZONE BEFORE HE LEAVES OR PERFORMS OTHER DUTIES.

THE RESTRICTIONS ARE SHORT TERM, THE WTS SHALL MONITOR THE ZONE FOR COMPLIANCE EVERY HOUR THEY ARE UP. DURING THE LANE CLOSURE HE SHALL MAKE SURE ALL TRAFFIC CONTROL ITEMS ARE FUNCTIONING PROPERLY. TRAFFIC CONTROL WILL BE THE WTS' MAIN DUTY DURING IMPLEMENTATION OF ZONES OR SHORT TERM ZONES. THE WTS SHALL HAVE THE AUTHORITY TO HAVE DEFICIENCIES CORRECTED AS SOON AS POSSIBLE. THE WTS SHALL PROVIDE THE PROJECT ENGINEER A SKETCH OF THE TRAFFIC CONTROL PLAN (TCP) EVERYDAY THERE IS TO BE A SHORT TERM TRAFFIC RESTRICTION, LANE CLOSURE, ETC. THIS TCP SHALL SHOW HOW THE WORK ZONES ARE TO BE IMPLEMENTED.

THE WTS SHALL BE AVAILABLE ON A 24-HOUR BASIS TO REPAIR AND/OR REPLACE DAMAGED OR MISSING TRAFFIC CONTROL DEVICES. A 24-HOUR PHONE NUMBER SHALL BE MADE AVAILABLE TO THE PROJECT ENGINEER IN ORDER TO CONTACT THE WTS. THE WTS SHALL HAVE A PAGER AND THE PHONE NUMBER PROVIDED TO THE PROJECT ENGINEER.

FAILURE OF THE CONTRACTOR TO COMPLY WITH ANY OF THE ABOVE, SHALL CONSTITUTE CAUSE FOR THE PROJECT ENGINEER TO DEDUCT \$500.00 PER DAY FROM MONEY DUE TO THE CONTRACTOR NOT AS A PENALTY, BUT AS A LIQUIDATED DAMAGE.

PAYMENT FOR THE WTS SHALL BE INCLUDED UNDER THE LUMP SUM ITEM 614 - MAINTAINING TRAFFIC.

I. FAILURE TO COMPLY

IF THERE IS ANY FAILURE TO COMPLY WITH PROVISION FOR TRAFFIC CONTROL SET OUT IN THESE PLANS AND NOTES, OR WITH THE PROVISIONS OF THE "MANUAL", THE HIGHWAY IN THE VICINITY OF THE WORK AREA SHALL NOT BE CONSIDERED IN A CONDITION FOR THE SAFE AND CONVENIENT USE BY THE TRAVELING PUBLIC. ANY FAILURE TO KEEP THE HIGHWAY, IN THE VICINITY OF THE WORK AREA, IN A CONDITION FOR THE SAFE AND CONVENIENT USE BY THE TRAVELING PUBLIC SHALL BE CONSIDERED A BREACH OF THIS CONTRACT. WORK SHALL BE SUSPENDED UNTIL THE CONTRACTOR COMPLIES WITH THE PROVISION OF THE AFOREMENTIONED ITEMS.

MAINTENANCE OF TRAFFIC CONTROL MATERIAL

A. SIGNS

SIGN DIMENSIONS AND SPECIFICATIONS, INCLUDING LETTER SIZES SHALL BE AS PROVIDED IN THE "MANUAL", OR IN DESIGN DRAWINGS PROVIDED BY THE DEPARTMENT OF TRANSPORTATION. THE SIGNS SHALL BE SUBJECT TO APPROVAL OF THE ENGINEER PRIOR TO THE START OF THIS PROJECT.

WORK ZONE MARKING SIGNS

WORK ZONE MARKING SIGNS SHALL BE ERECTED PER LATEST STANDARD OF THE OMUTCD AND ITEM 614 OF THE CMS.

B. SIGN SUPPORTS

SIGN SUPPORTS SHALL BE AS SHOWN ON STANDARD DRAWINGS MT-105.10 AND MT-105.11.

C. FLASHING ARROWS

THE ELECTRIC FLASHING ARROW SHALL BE AS SHOWN ON STANDARD CONSTRUCTION DRAWING MT-35.10.

D. CONES

CONES SHALL BE LOCATED AS SHOWN IN THE "MANUAL" AND THE TRAFFIC CONTROL PLANS.

E. DRUMS

DRUMS SHALL BE LOCATED AS SHOWN ON THE TRAFFIC CONTROL PLANS AND ARE REQUIRED FOR NIGHTTIME CLOSURES.

F. FLOODLIGHTING

FLOODLIGHTING OF THE WORK SITE FOR OPERATIONS CONDUCTED DURING NIGHT TIME PERIODS SHALL BE ACCOMPLISHED SO THAT THE LIGHTS DO NOT CAUSE GLARE TO THE DRIVERS ON THE ROADWAY. TO ENSURE ADEQUACY OF THE FLOODLIGHT PLACEMENT, THE CONTRACTOR AND ENGINEER SHALL DRIVE THROUGH THE WORK SITE EACH NIGHT WHEN THE LIGHTING IS IN PLACE AND OPERATIVE PRIOR TO COMMENCING ANY WORK. IF GLARE IS DETECTED THE LIGHT PLACEMENT AND SHIELDING SHALL BE ADJUSTED TO THE SATISFACTION OF THE ENGINEER BEFORE WORK PROCEEDS.

PAYMENT FOR ALL LABOR, EQUIPMENT AND MATERIALS SHALL BE INCLUDED IN THE LUMP SUM CONTRACT PRICE FOR MAINTAINING TRAFFIC.

G. WORK VEHICLES

ALL WORK VEHICLES LICENSED TO OPERATE ON THE HIGHWAY, INCLUDING TRUCKS, SHALL BE EQUIPPED WITH A FLASHING, ROTATING OR OSCILLATING AMBER LIGHT VISIBLE TO ALL DIRECTIONS OF TRAFFIC FOR A MINIMUM OF ONE-QUARTER MILE IN BRIGHT SUNLIGHT AND SHALL BE OPERATED WITH LIGHTED HEAD AND TAIL LAMPS. THE AMBER LIGHT SHALL BE IN OPERATION AT ALL TIMES WITHIN THE WORK ZONE AND WHILE TRAVELING TO AND FROM THE WORK ZONE WHENEVER THE VEHICLE SPEED IS BELOW 55 MPH. VEHICLE HAZARD LAMPS DO NOT SATISFY THIS REQUIREMENT. ALL OTHER EQUIPMENT SHALL BE EQUIPPED WITH A FLASHING, ROTATING OR OSCILLATING AMBER LIGHT VISIBLE IN ALL DIRECTIONS OF TRAFFIC FOR A MINIMUM OF ONE-QUARTER MILE IN BRIGHT SUNLIGHT. THE AMBER LIGHT SHALL BE IN OPERATION WHILE THE EQUIPMENT IS WITHIN THE WORK ZONE.

PAYMENT

PAYMENT FOR PROVIDING, ERECTING, MAINTAINING AND REMOVING TEMPORARY MAINTENANCE OF TRAFFIC CONTROL DEVICES, INCLUDING WORK ZONE MARKING SIGNS, SHALL BE MADE UNDER THE LUMP SUM PRICE BID FOR ITEM 614 - MAINTAINING TRAFFIC.

I:\PROJECTS\PI\178926\06\178926.dgn 20-JAN-2006 2:52PM jthreot

MAINTENANCE OF TRAFFIC NOTES

D12 BH FY2006 MISC. REPAIRS 2