



CUY-90-14.90


PID 77332/85531

APPENDIX EX-65

**Carnegie Bridge Plans
(Reference Document)**

State of Ohio
Department of Transportation
Jolene M. Molitoris, Director

**Innerbelt Bridge
Construction Contract Group 1 (CCG1)**

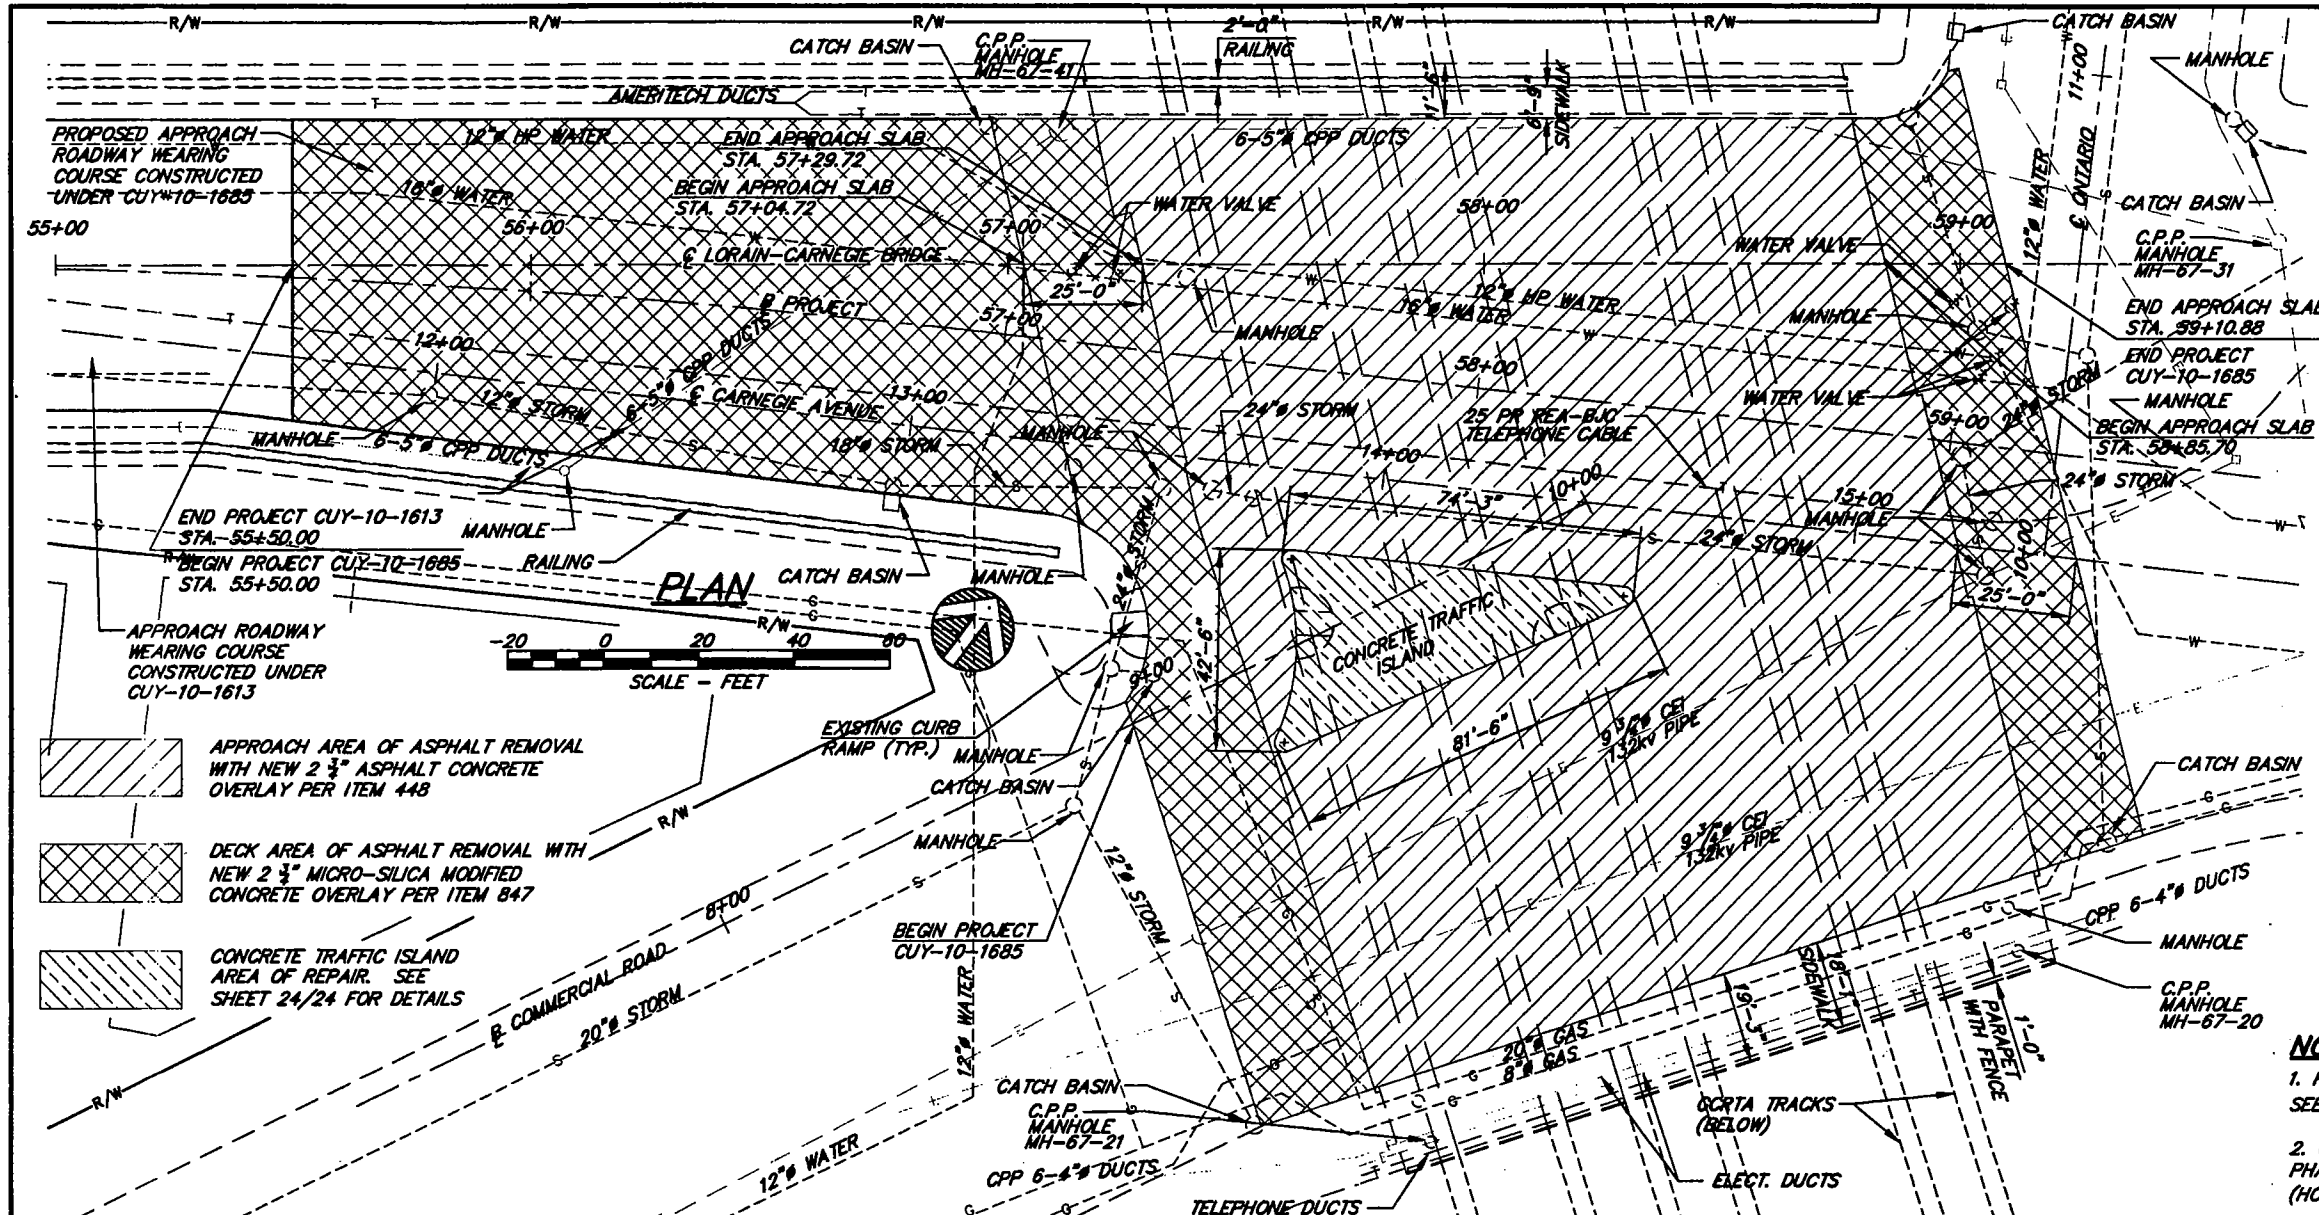


LORAIN-CARNEGIE BRIDGE
 CUY-10-1685 COUNTY BRIDGE No. 148

EXISTING STRUCTURE:
 TYPE: REINFORCED CONCRETE GIRDER, DECK, AND SUBSTRUCTURE
 SPAN: SEE PLAN
 ROADWAY: VARIES
 NORTH SIDEWALK 6'-9"
 SOUTH SIDEWALK 18'-1"
 LOADING: HS-20-44 CASE II AND THE ALTERNATE MILITARY LOADING
 SKEW: VARIES
 WEARING SURFACE: 2 1/2" ASPHALT CONCRETE
 APPROACH SLABS: WEST APP. SLAB 25'-0" ALIGNED WITH E LORAIN-CARNEGIE BRIDGE
 EAST APP. SLAB 25'-0" ALIGNED WITH E CARNEGIE AVENUE
 ALIGNMENT: TANGENT
 SUPERELEVATION: VARIES
 DATE BUILT: 1932, 1982
 STR. FILE No.: 1801511

PROPOSED WORK:
 ALL DATA IS SAME AS EXISTING STRUCTURE, EXCEPT AS FOLLOWS:
 WEARING SURFACE: 2 3/4" MICRO-SILICA MODIFIED CONCRETE

BENCHMARK LOCATION:
 O.M. 42 SQUARE IRON BOX
 SOUTH WALK OF CARNEGIE AVENUE 250 FEET EAST OF BROADWAY AVENUE CENTERLINE

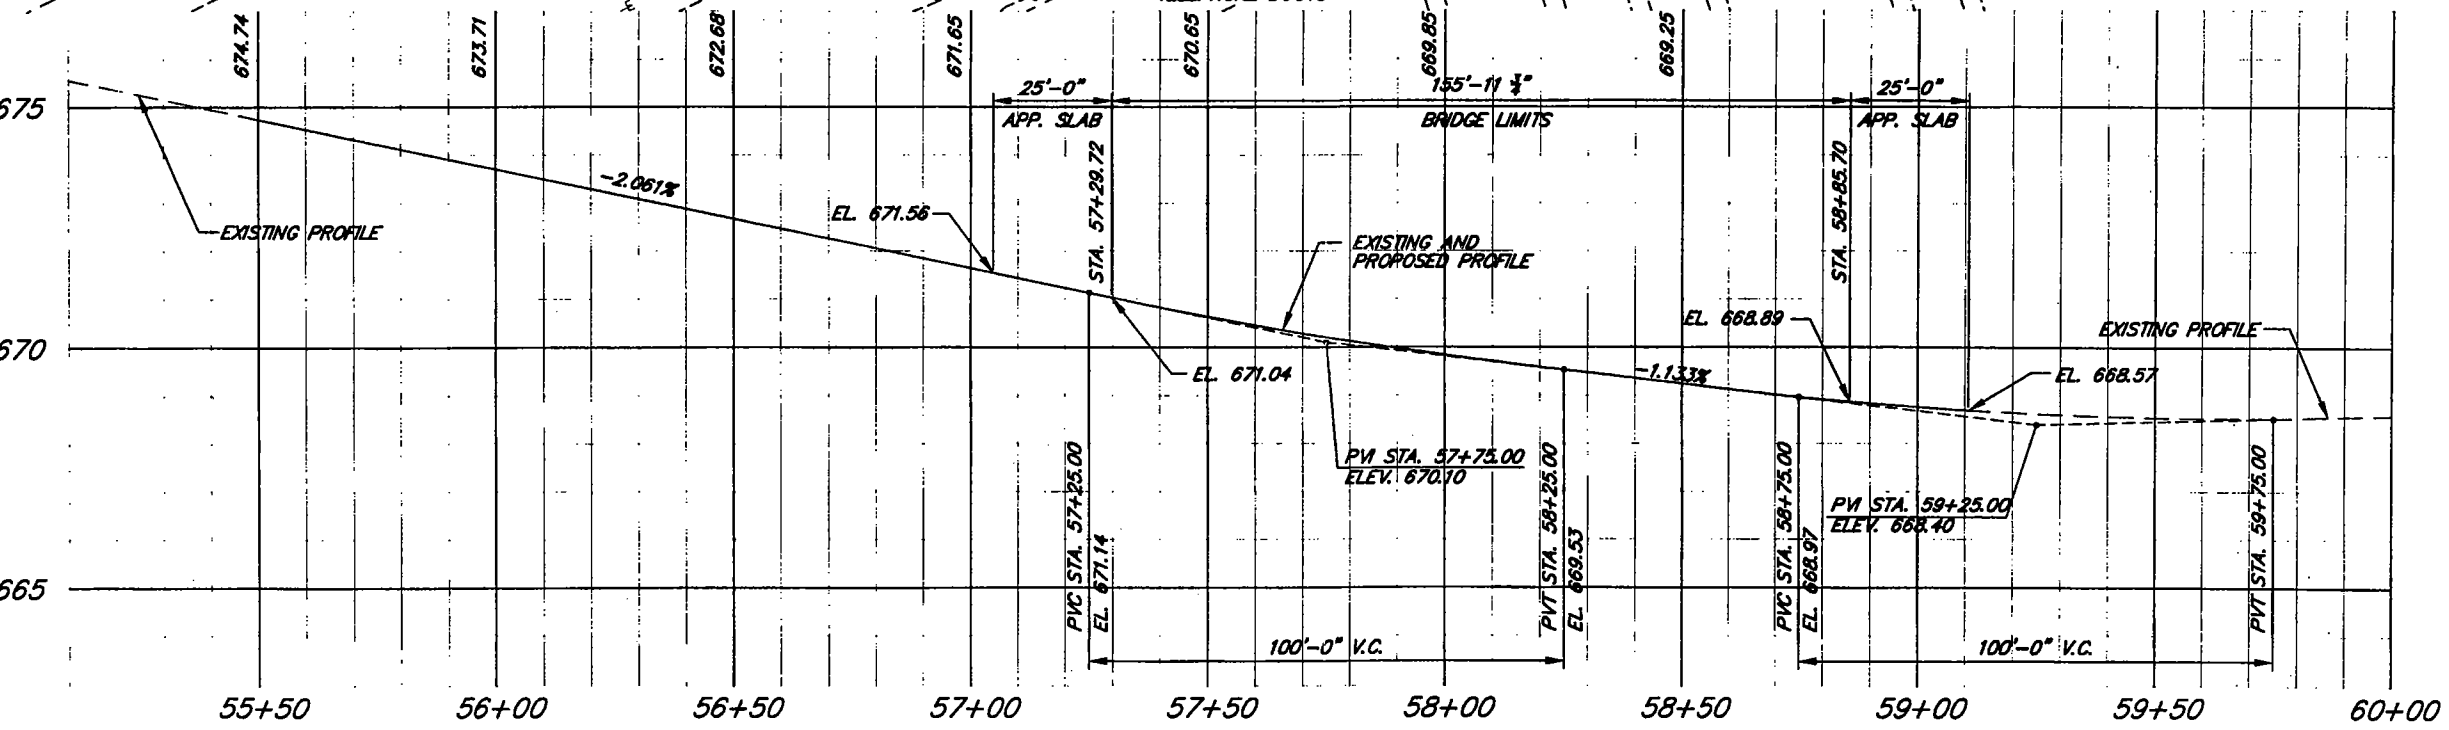


PROFILE ALONG PROJECT B


NOTES:
 1. FOR EXISTING/PROPOSED PAVEMENT ELEVATIONS SEE SHEET 23/24.
 2. COORDINATE MAINTENANCE OF TRAFFIC AND WORK PHASES WITH CONTRACTOR ON PROJECT CUY-10-1613 (HOPE MEMORIAL BRIDGE REHABILITATION).

DRAWING NAME: 8.30JMG
 PLOTTING SCALE: 1:240
 PLOT DATE: 02/24/00


DESIGN AGENCY: CUYAHOGA COUNTY ENGINEER BRIDGE DESIGN DEPARTMENT
 DATE: 2/26/00
 DRAWN: JPK
 CHECKED: BGF
 DESIGNED: BGF
 B-NO. 23
 REPORT NO. 7249
 STR. FILE NO. 1801511
 GENERAL PLAN AND PROFILE
 LORAIN-CARNEGIE BRIDGE No. 148
 OVER GCRTA TRACKS
 CUY-10-1685
 1/5
 20/24

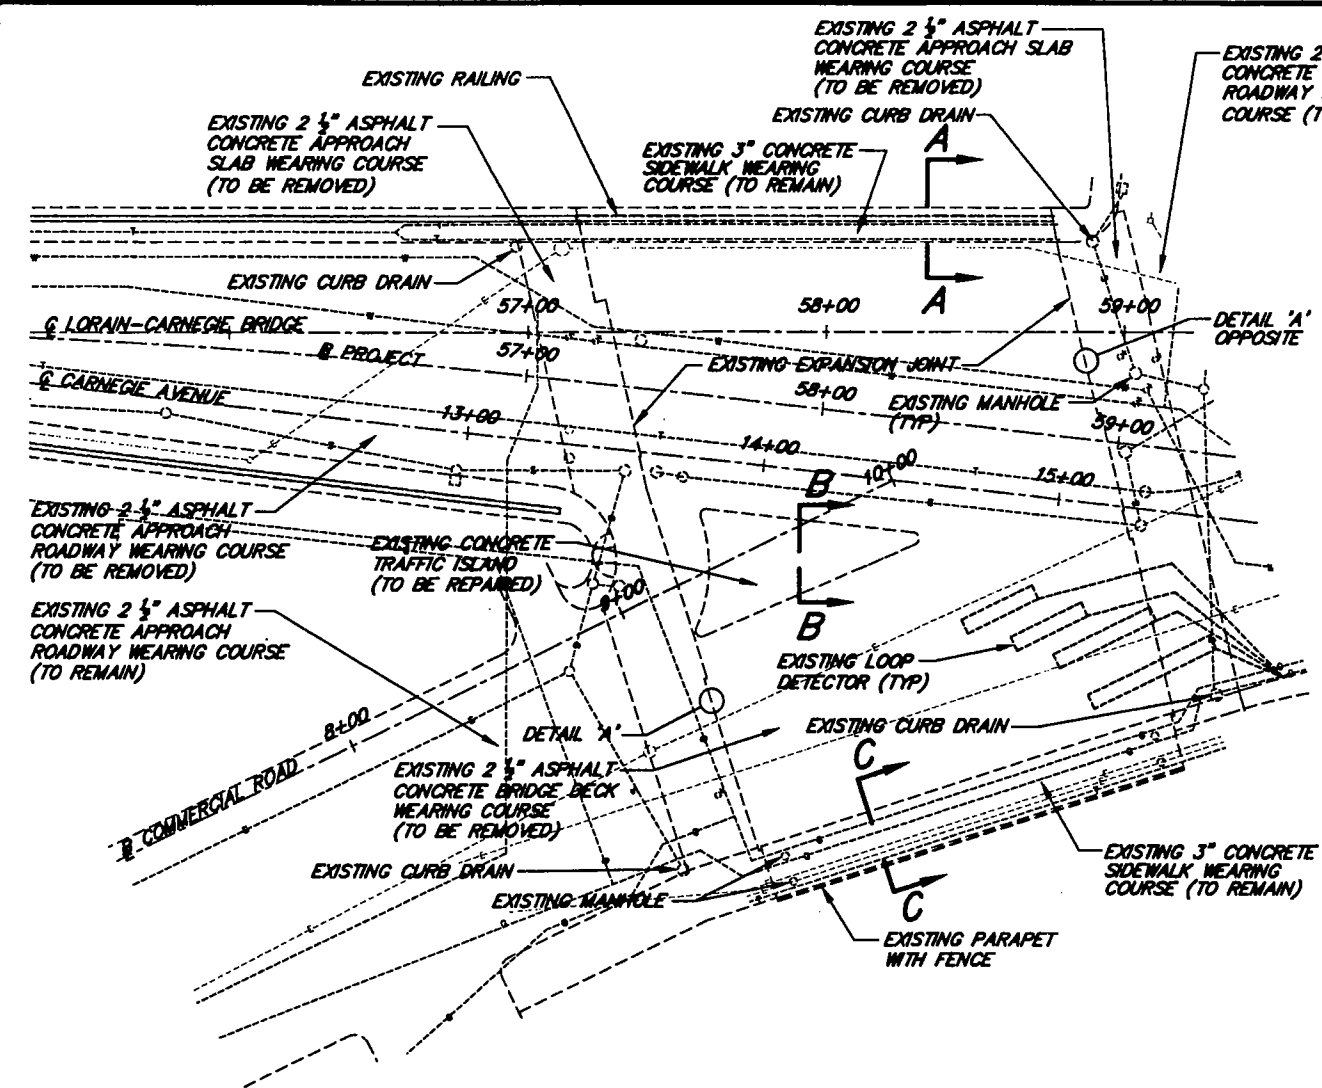


EXISTING PLAN

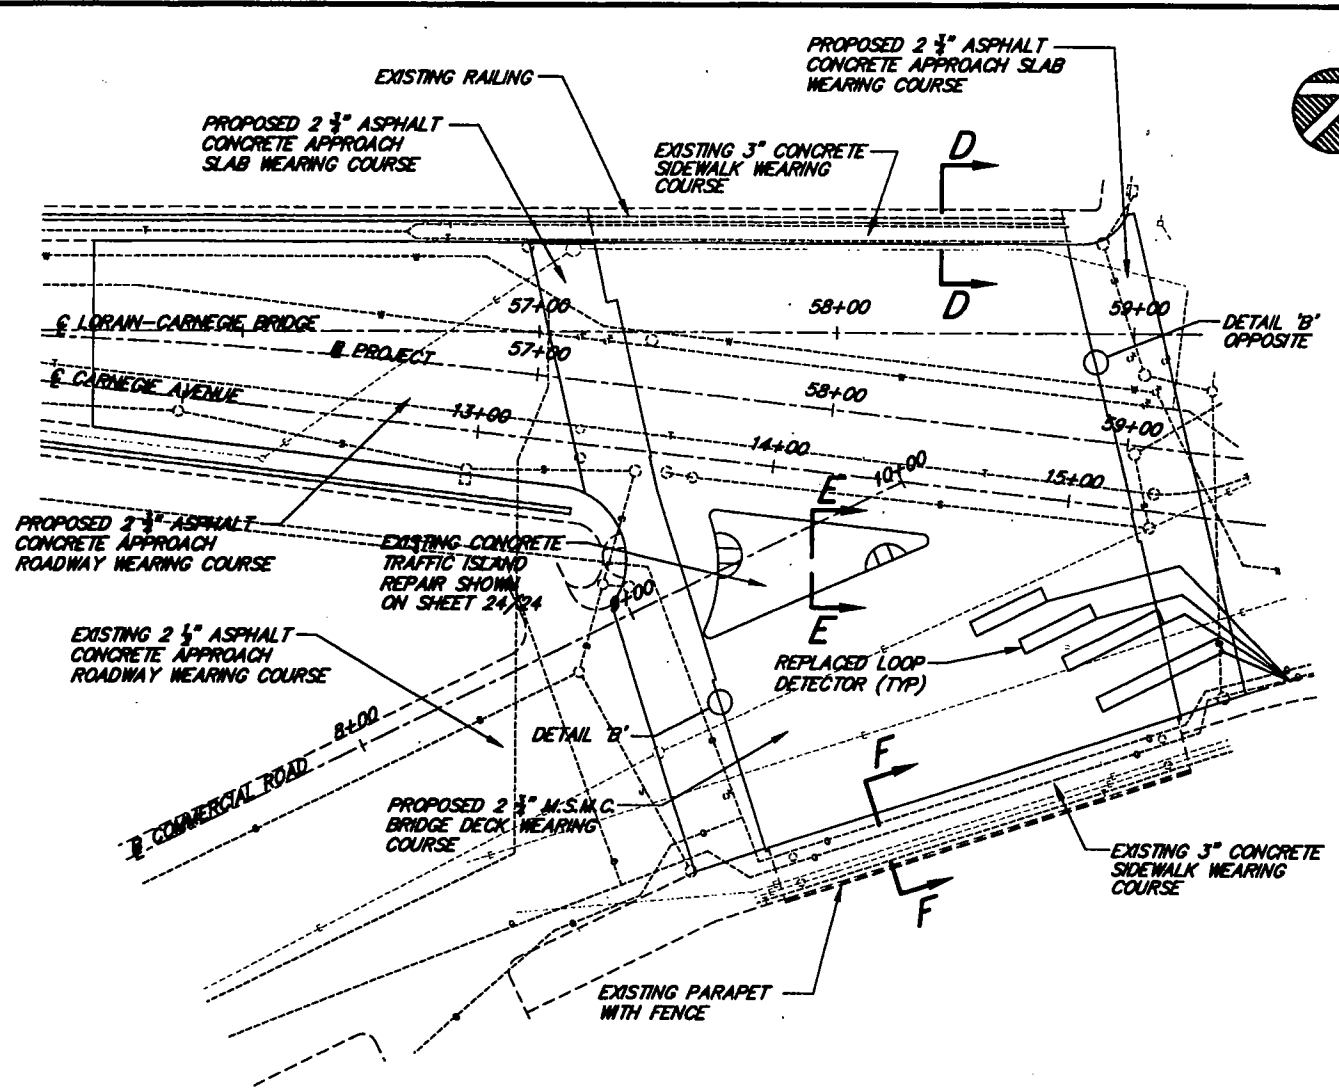


PROPOSED PLAN

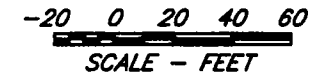


NOTE:
 1. FOR SECTIONS A-A, B-B, C-C, D-D, E-E, AND F-F SEE SHEET 22/24.
 2. FOR CONCRETE TRAFFIC ISLAND REPAIR DETAILS SEE SHEET 24/24.

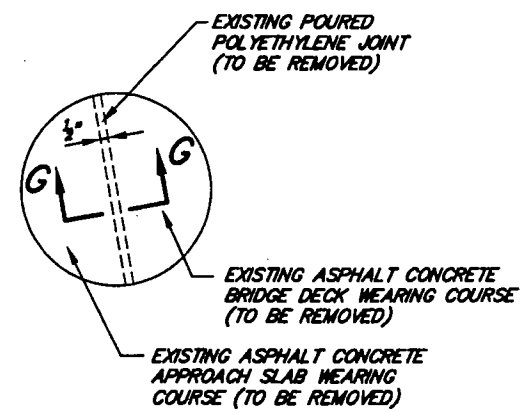


DETAIL 'A'
EXISTING JOINT

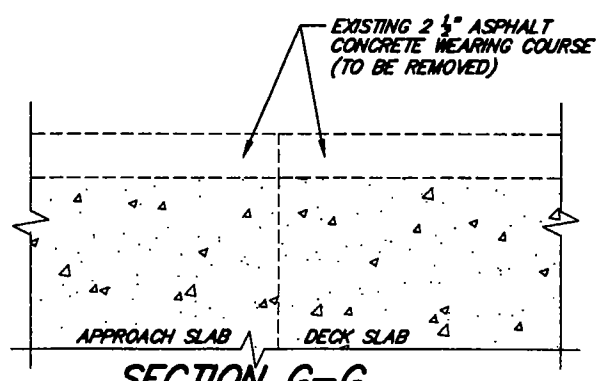

SECTION G-G
EXISTING JOINT DETAIL
WEST APPROACH SLAB SHOWN
EAST APPROACH SLAB OPPOSITE

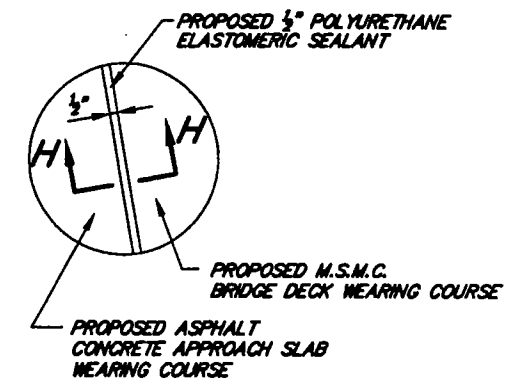


DETAIL 'B'
PROPOSED JOINT SEALER

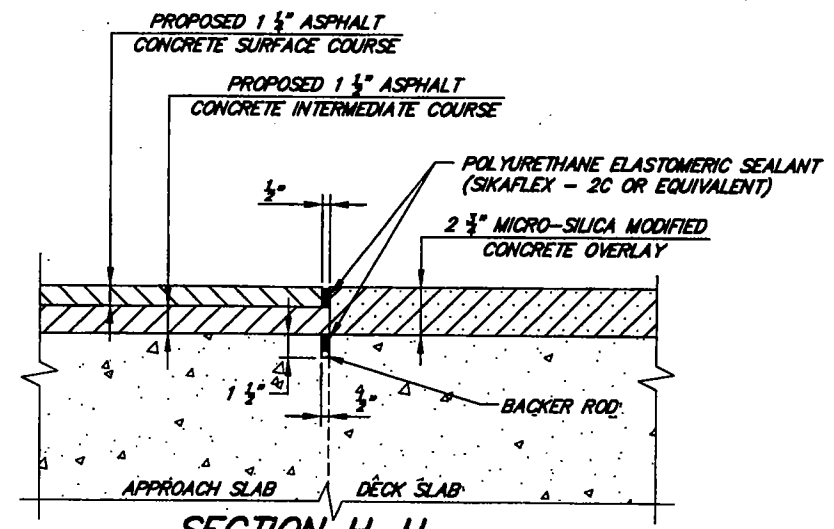

SECTION H-H
PROPOSED JOINT DETAIL
WEST APPROACH SLAB SHOWN
EAST APPROACH SLAB OPPOSITE

DRAWING NAME: 21-089
 PLOTTING SCALE: 1"=40'
 PLOT DATE: 02/24/00

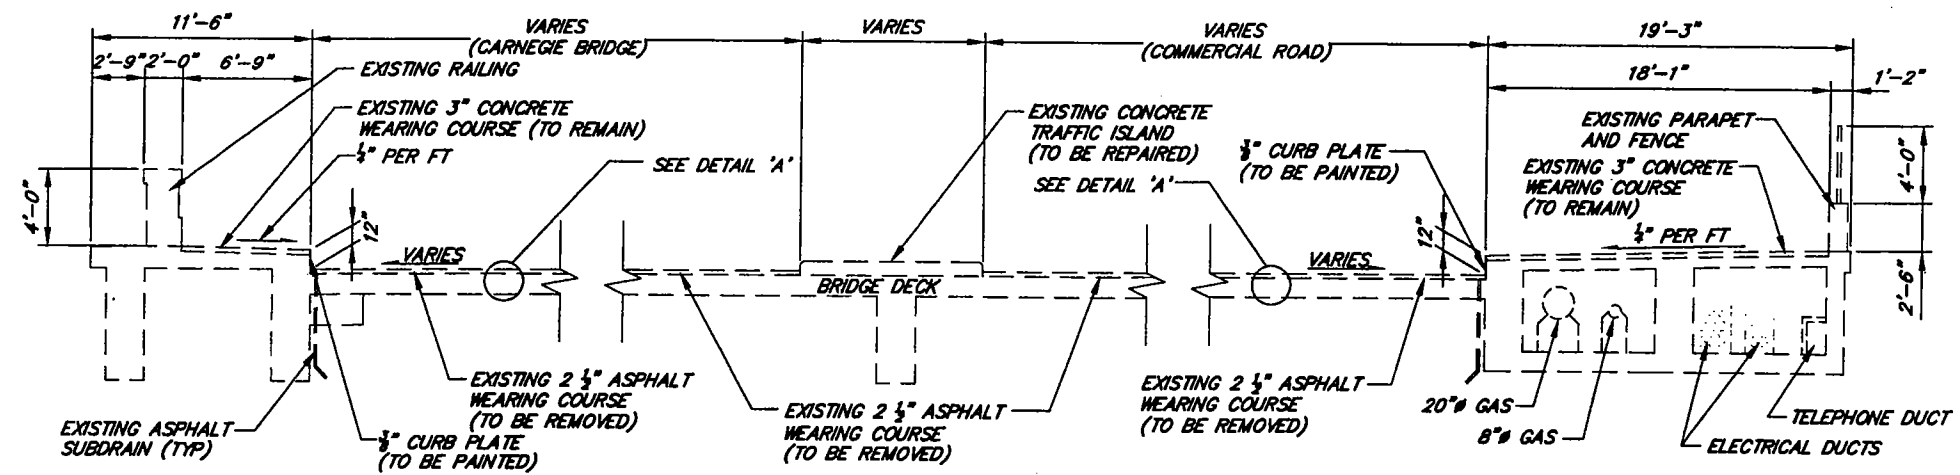

SECTION A-A


EXISTING NORTH SIDEWALK AND CURB DETAIL

SECTION B-B


EXISTING CONCRETE TRAFFIC ISLAND DETAIL

SECTION C-C

EXISTING SOUTH SIDEWALK AND CURB DETAIL

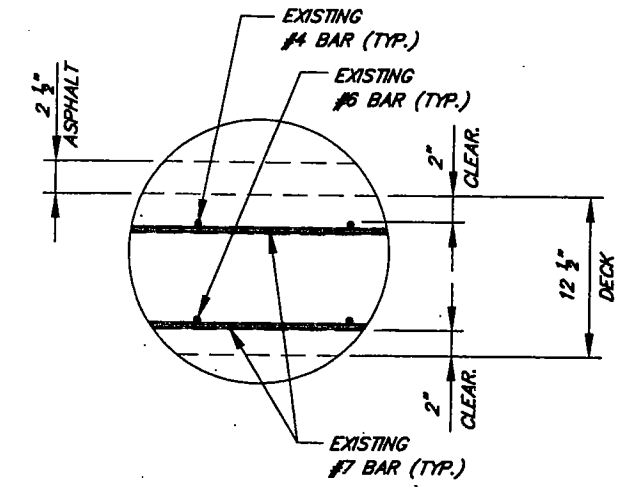

DETAIL 'A'

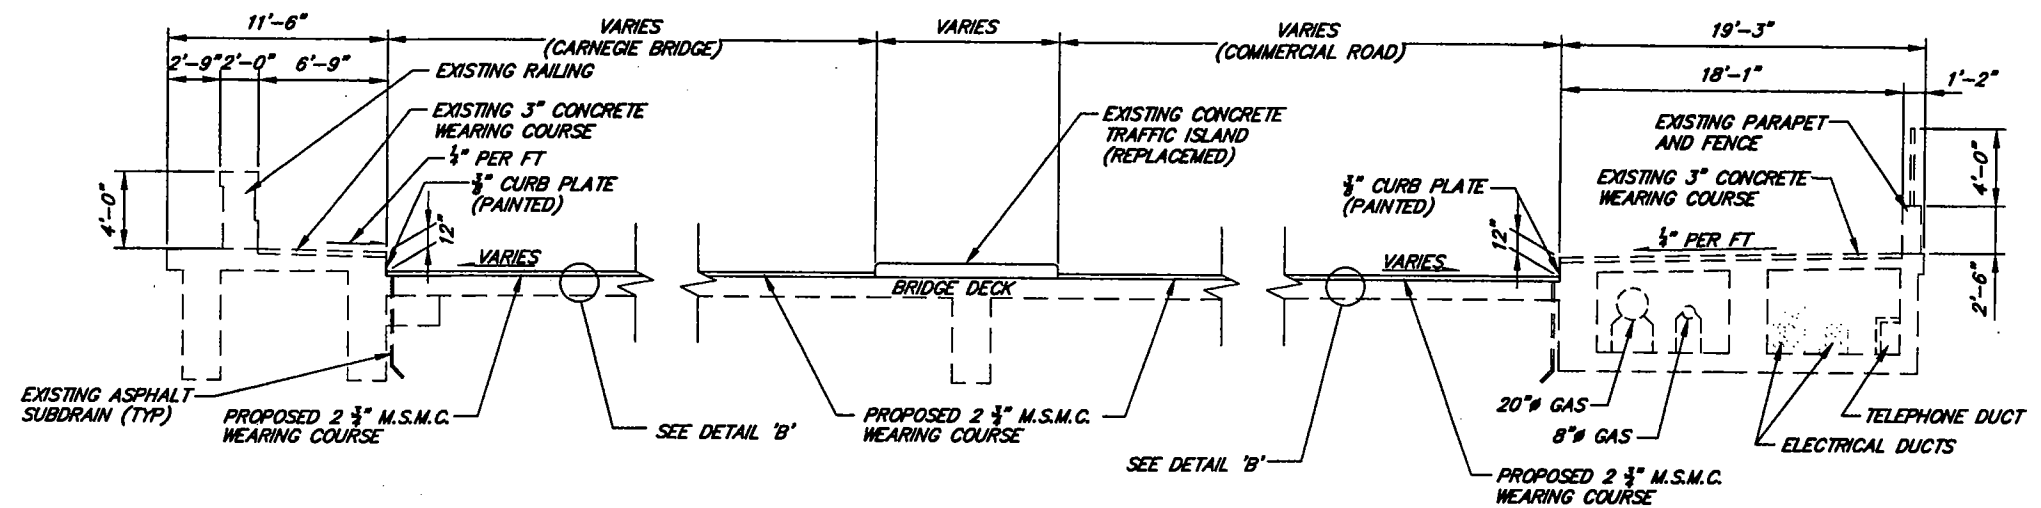

SECTION D-D


PROPOSED NORTH SIDEWALK AND CURB DETAIL

SECTION E-E


PROPOSED CONCRETE TRAFFIC ISLAND DETAIL

SECTION F-F

PROPOSED SOUTH SIDEWALK AND CURB DETAIL

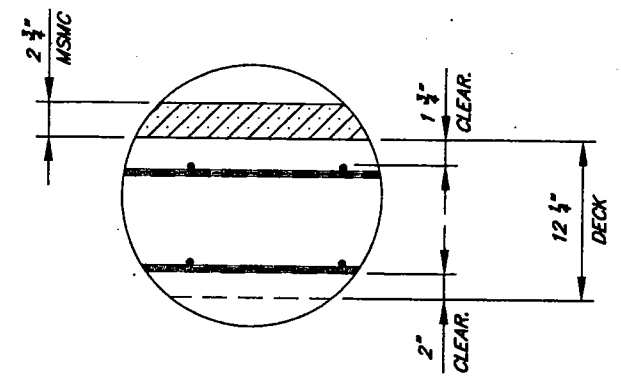


DETAIL 'B'

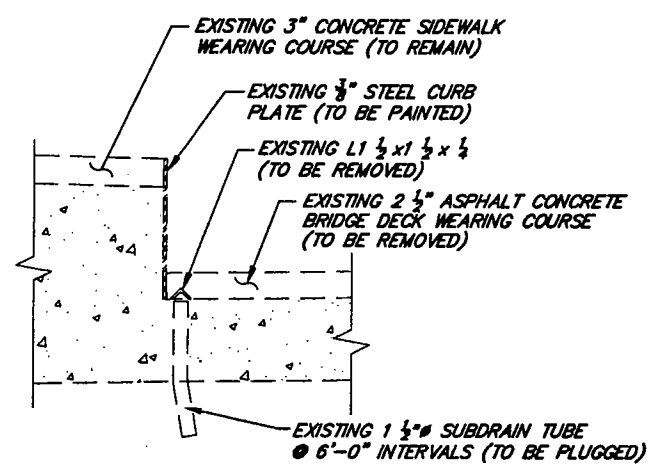

EXISTING SUBDRAIN DETAIL
REINFORCEMENT NOT SHOWN FOR CLARITY

SUBDRAIN PLUGGING PROCEDURE:


1. REMOVE ANGLES OVER SUBDRAIN TUBES. INCLUDE WITH ITEM 847 - WEARING COURSE REMOVED, ASPHALT, AS PER PLAN.
2. THOROUGHLY SANDBLAST OR WIREBRUSH CLEAN UPPER INSIDE OF EACH DRAIN PIPE TO 1" MINIMUM DEPTH.
3. DRIVE RUBBER STOPPER IN EACH DRAIN TUBE TO A MINIMUM DEPTH OF 1".
4. GROUT TUBE WITH GELTITE 42-14 EPOXY GROUT, SIKAGROUT 212, SIKAFLEX 1CSL OR AN EQUIVALENT TO A POINT LEVEL WITH THE DECK.

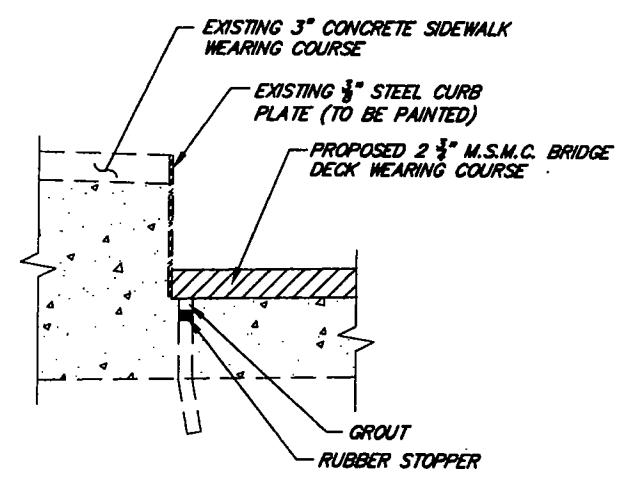


PROPOSED SUBDRAIN PLUGGING DETAIL
REINFORCEMENT NOT SHOWN FOR CLARITY

NOTES:

1. INCLUDE EXISTING L1 1/2 x 1 1/2 x 1/2 REMOVAL WITH ITEM 847 - WEARING COURSE REMOVED, ASPHALT, AS PER PLAN.
2. PAYMENT FOR PLUGGING ASPHALT SUBDRAINS SHALL BE MADE UNDER ITEM 518 - STRUCTURAL DRAINAGE, MISC.: PLUGGING ASPHALT SUBDRAINS.
3. SUBDRAIN PLUGGING ESTIMATE: 27-1 1/2" PLASTIC TUBES ALONG NORTH GUTTER LINE AND 25-1 1/2" PLASTIC TUBES ALONG SOUTH GUTTER LINE FOR BRIDGE No. 148.
4. FOR SECTION LOCATIONS SEE SHEET 21/24.
5. FOR CONCRETE TRAFFIC ISLAND DETAILS SEE SHEET 24/24.

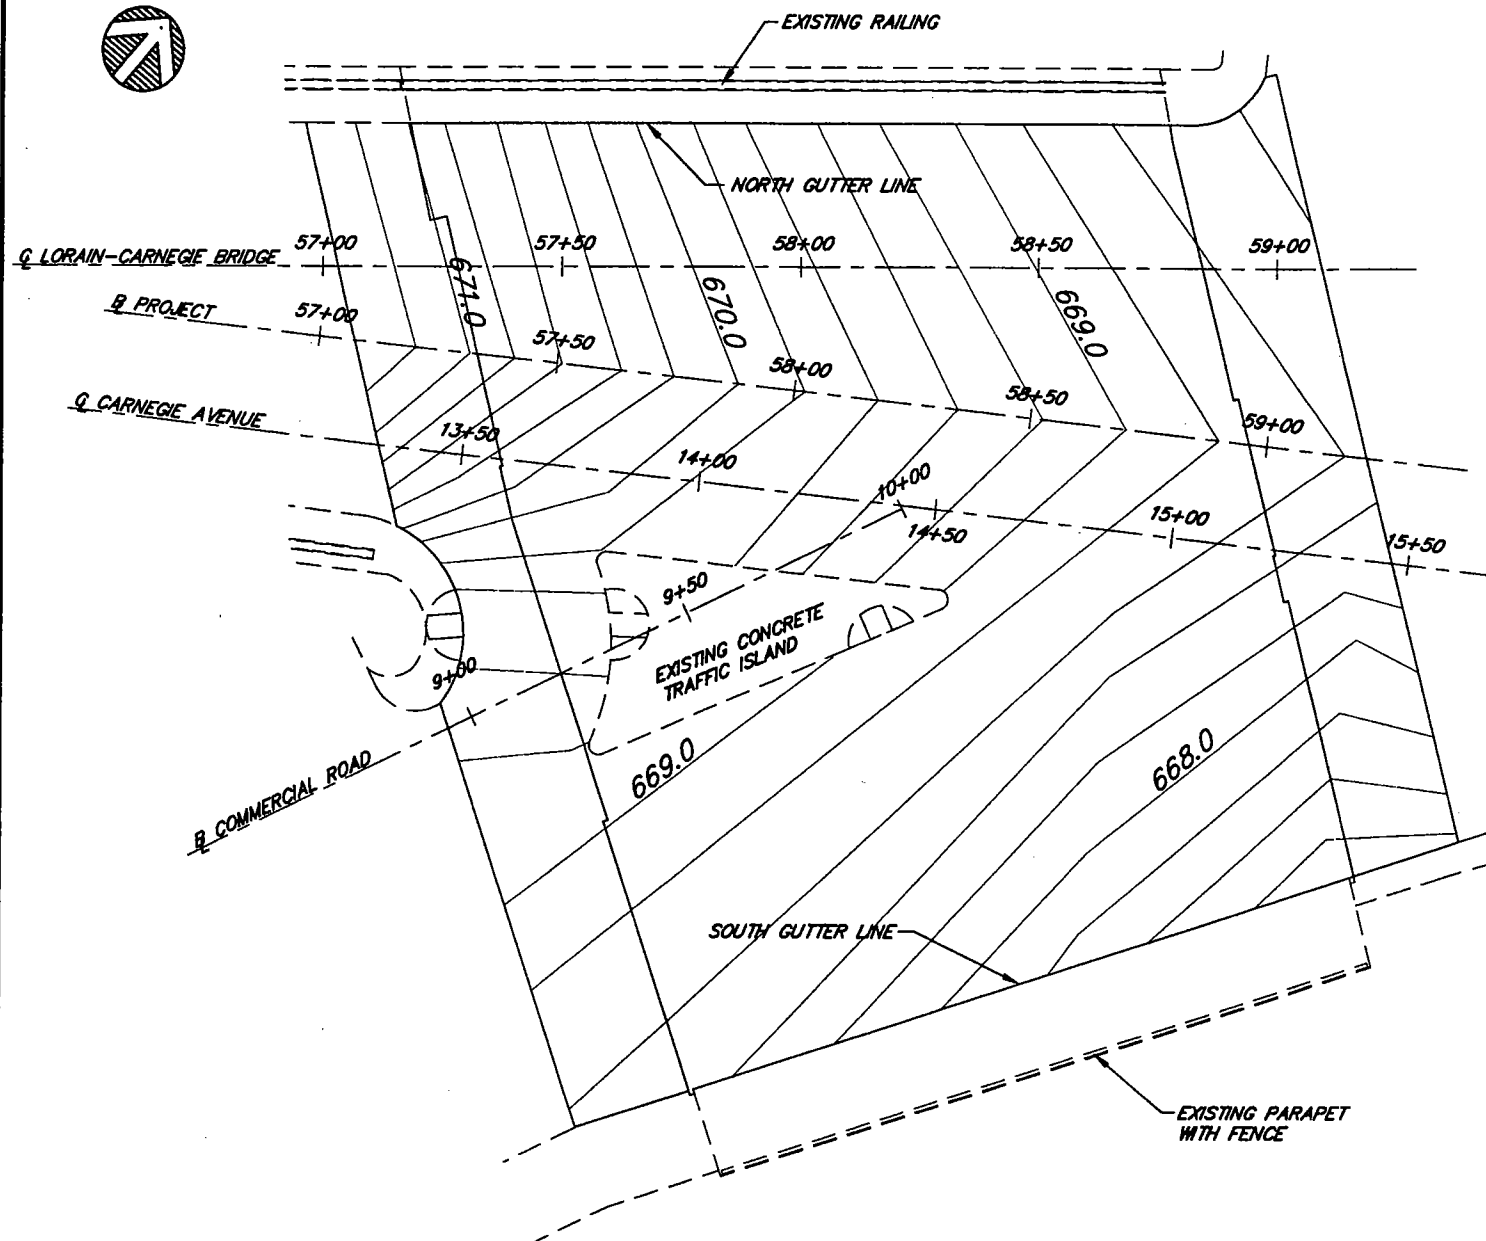


CONTOUR PLAN
 TOP OF M.S.M.C. OVERLAY ON BRIDGE AND
 ASPHALT WEARING COURSES ON APPROACH SLABS

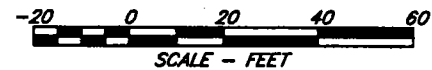


DRAWING NAME: 1-234-9
 PLOTTING SCALE: 1-240
 PLOT DATE: 02/20/00


4/5	23/24	CUY-10-1685	CONTOUR PLAN LORAIN-CARNEGIE BRIDGE No. 148 OVER GORTA TRACKS	B-No. 23 Report No. 7249	DESIGNED CPK CHECKED BGF	DRAWN CPK REVIEWED	REVIEWED DATE 02/20/00	STRUCTURE FILE No. 1801511	DESIGN AGENCY CUYAHOGA COUNTY ENGINEER BRIDGE DESIGN DEPARTMENT
-----	-------	-------------	---	-----------------------------	-----------------------------------	--------------------------	---------------------------	-------------------------------	---

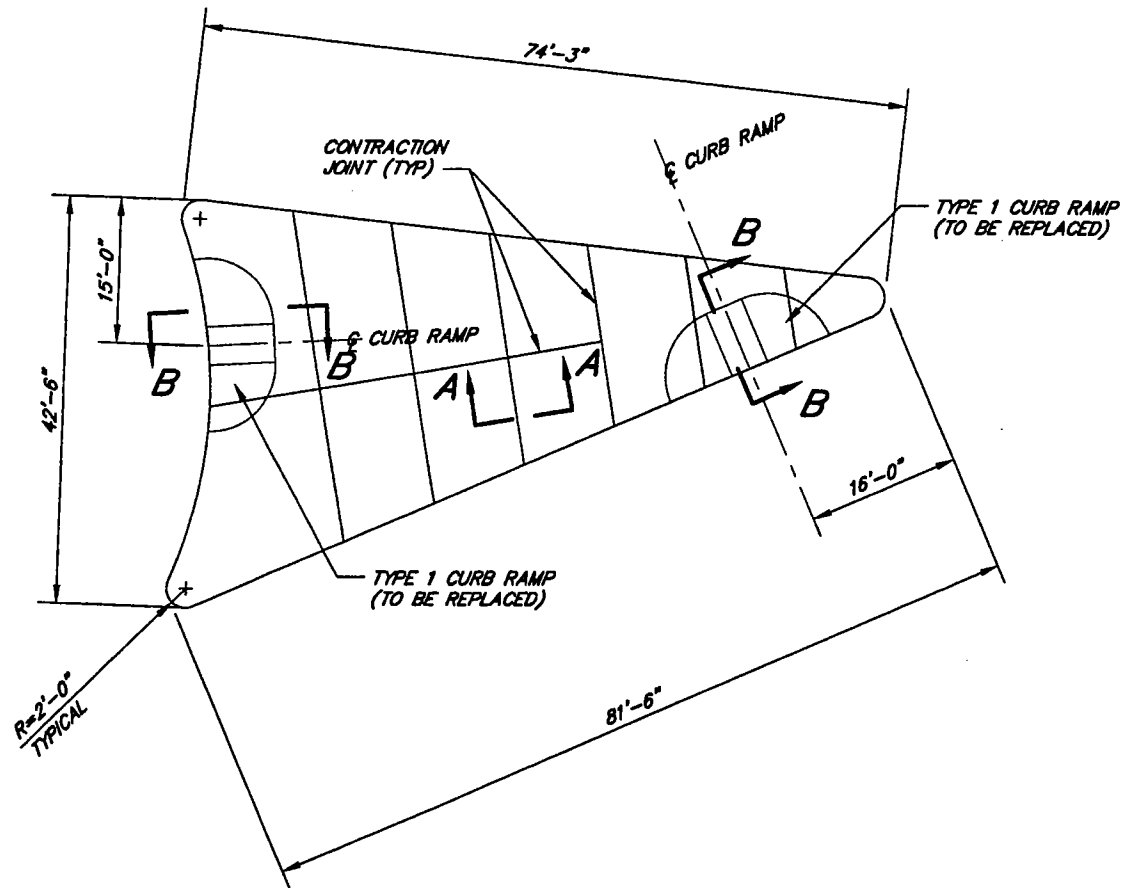


CONCRETE TRAFFIC ISLAND
AREA OF CONCRETE REMOVAL AND REPLACEMENT

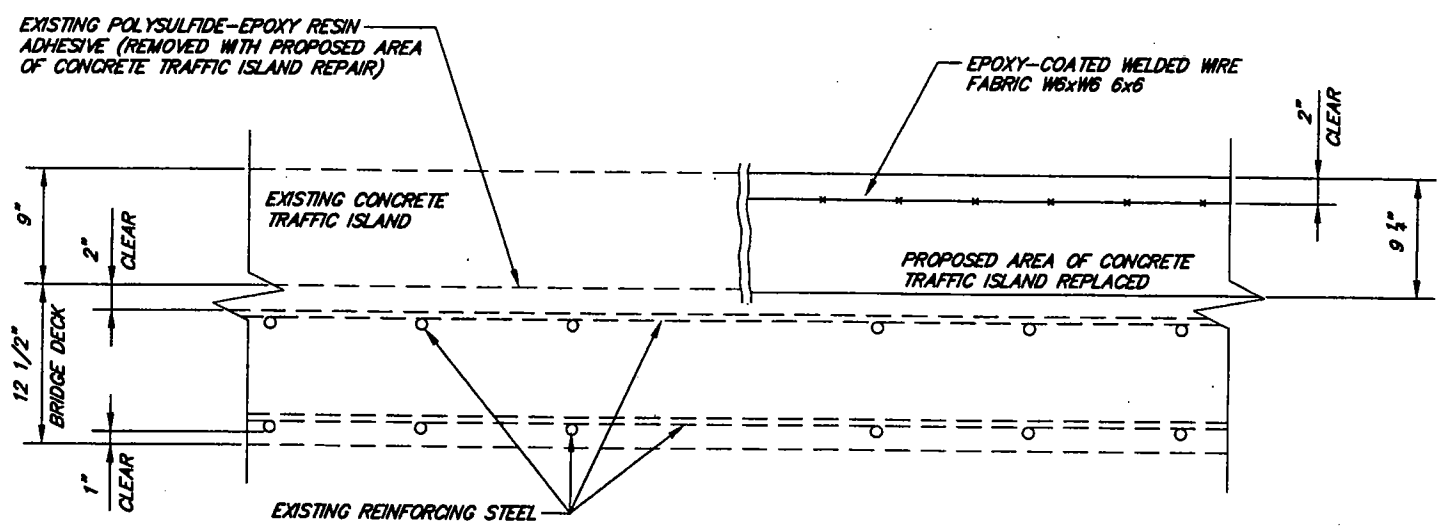

SECTION A-A
CONCRETE TRAFFIC ISLAND DETAIL

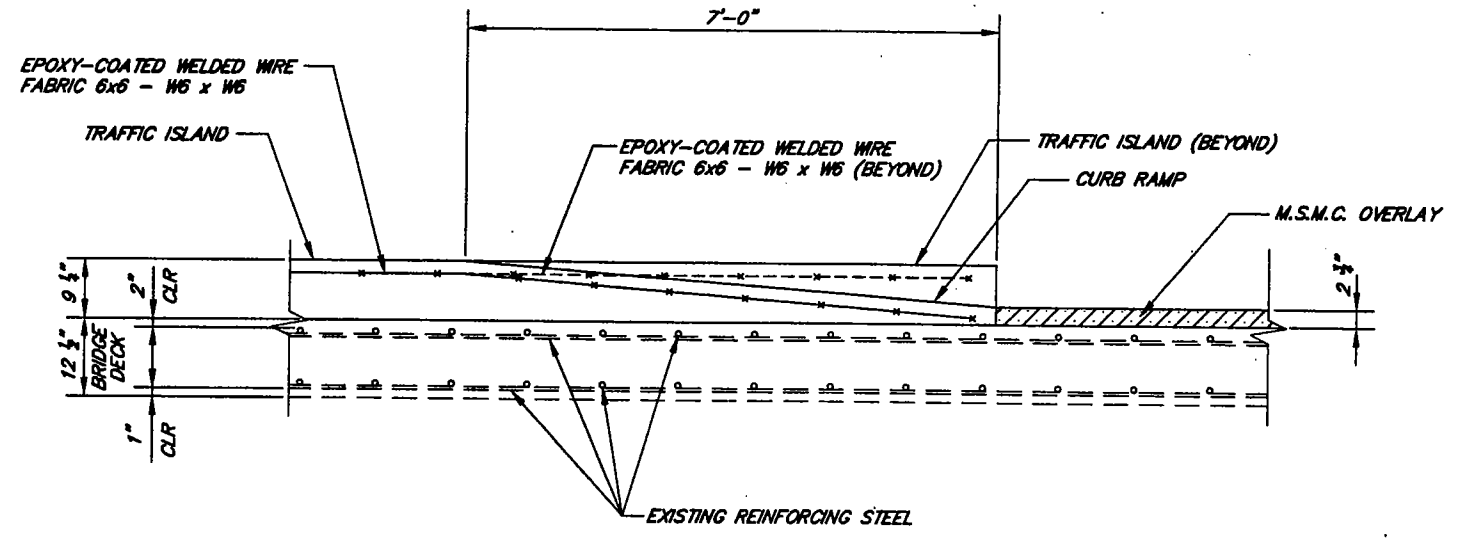

SECTION B-B
CONCRETE TRAFFIC ISLAND DETAIL

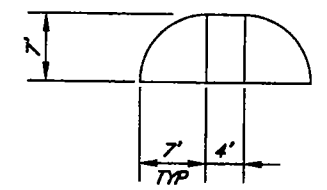


CURB RAMP DETAIL
CONCRETE TRAFFIC ISLAND

- NOTES:**
1. EPOXY-COATED WELDED WIRE FABRIC SHALL BE INCLUDED IN ITEM 842 - CLASS S CONCRETE, MISC.: 9" REINFORCED CONCRETE TRAFFIC ISLAND FOR PAYMENT.
 2. SPACE CONTRACTION JOINTS AT 10'-0" MAXIMUM.

DRAWING NAME: #_24.DWG
PLOT DATE: 02/24/00
PLOT SCALE: 1:120

DESIGNED CLPK	CHECKED BGF	DRAWN CPK	REVISED WHD	DATE 7/29/00	STRUCTURE FILE NO. 1801481/1801511	DESIGN AGENCY CUYAHOGA COUNTY ENGINEER BRIDGE DESIGN DEPARTMENT
B-No. 23		Report No. 7249		CONCRETE TRAFFIC ISLAND DETAIL LORAIN-CARNEGIE BRIDGE No. 148 OVER GORTA TRACKS		
5/5		24/24		CUY-10-1685		

CUYAHOGA COUNTY
CUY-10-16.23

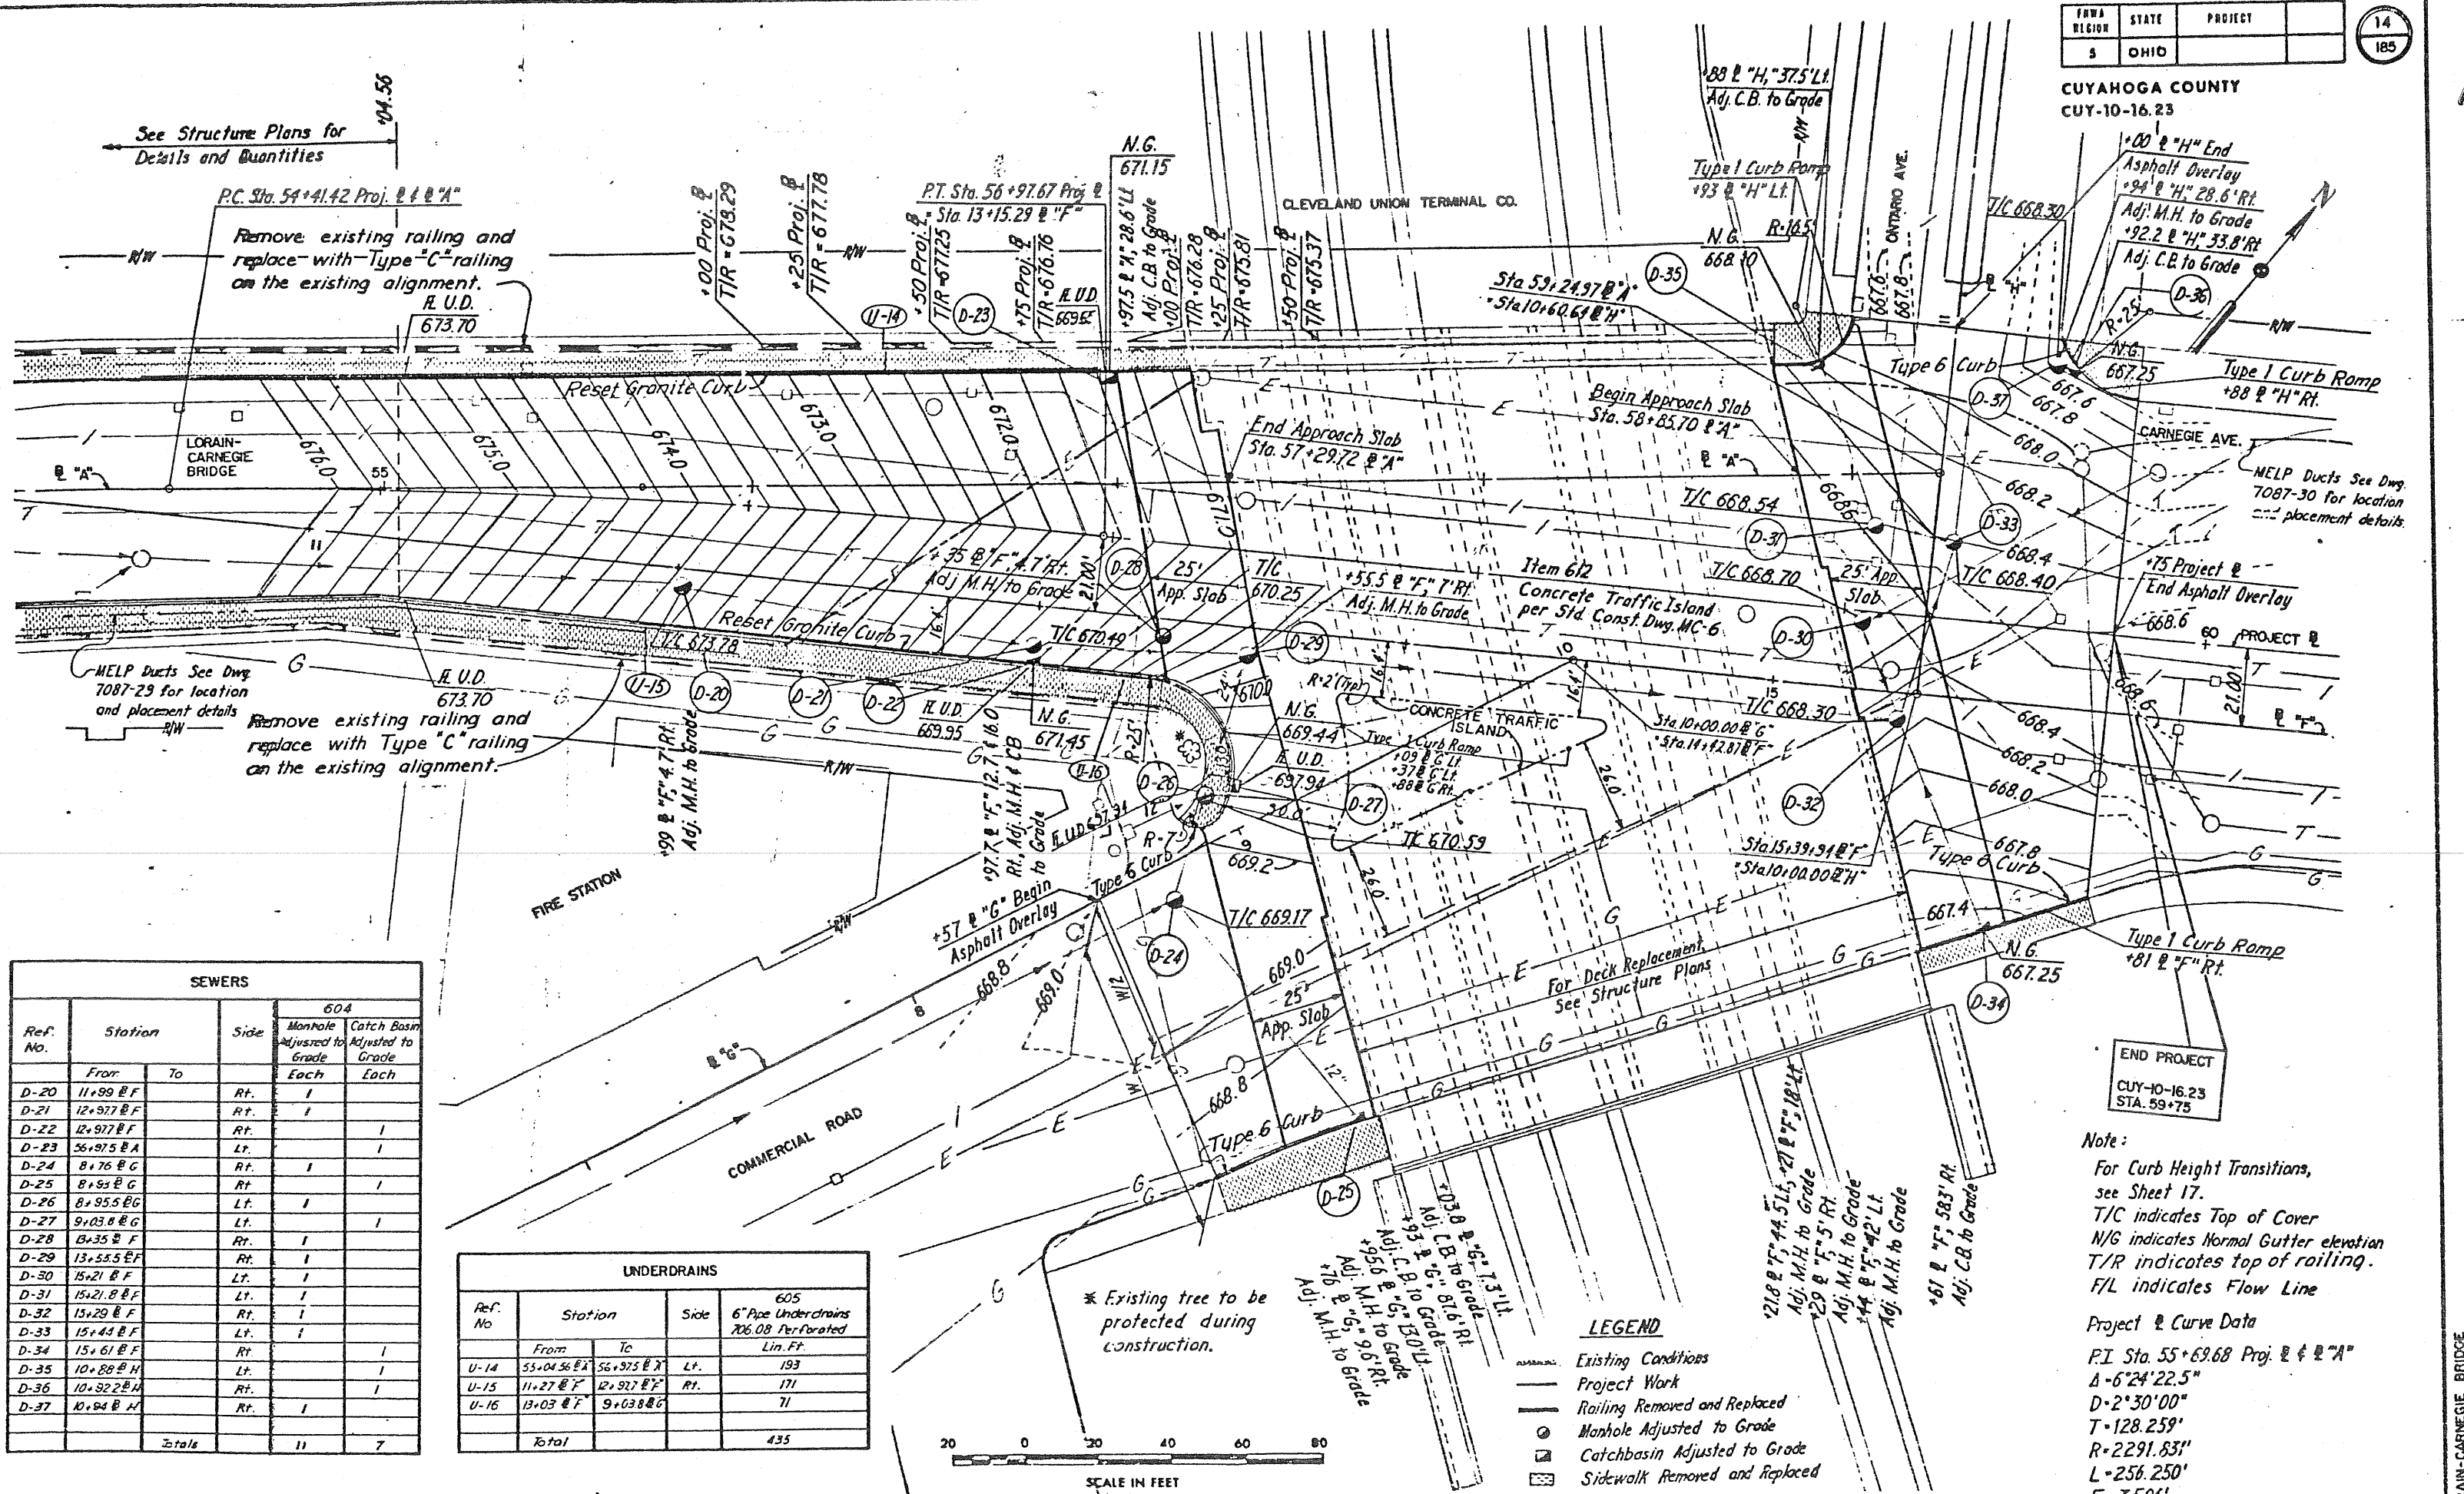

SEWERS					
Ref. No.	Station		Side	604	
	From	To		Manhole Adjusted to Grade Each	Catch Basin Adjusted to Grade Each
D-20	11+99	12+00	Rt.	1	
D-21	12+00	12+07	Rt.	1	
D-22	12+07	12+08	Rt.		1
D-23	12+08	12+09	Lt.		1
D-24	12+09	12+10	Rt.	1	
D-25	12+10	12+11	Rt.		1
D-26	12+11	12+12	Lt.	1	
D-27	12+12	12+13	Lt.		1
D-28	12+13	12+14	Rt.	1	
D-29	12+14	12+15	Rt.	1	
D-30	12+15	12+16	Lt.	1	
D-31	12+16	12+17	Lt.	1	
D-32	12+17	12+18	Rt.	1	
D-33	12+18	12+19	Lt.	1	
D-34	12+19	12+20	Rt.		1
D-35	12+20	12+21	Lt.	1	
D-36	12+21	12+22	Rt.		1
D-37	12+22	12+23	Rt.	1	
Totals			11	7	

UNDERDRAINS				
Ref. No.	Station		Side	605 6" Pipe Underdrains 706.08 Perforated Lin. Ft.
	From	To		
U-14	55+04.56	56+97.5	Lt.	193
U-15	11+27	12+92.7	Rt.	171
U-16	13+03	9+03.8	G	71
Total				435


- LEGEND**
- Existing Conditions
 - Project Work
 - Railing Removed and Replaced
 - Manhole Adjusted to Grade
 - Catchbasin Adjusted to Grade
 - Sidewalk Removed and Replaced

Note:
For Curb Height Transitions, see Sheet 17.
T/C indicates Top of Cover
N/G indicates Normal Gutter elevation
T/R indicates top of railing.
F/L indicates Flow Line


Project & Curve Data
P.I. Sta. 55+69.68 Proj. & Curve "A"
Δ=6°24'22.5"
D=2°30'00"
R=2291.83'
L=256.250'
E=3.586'

LORAIN-CARNEGIE BRIDGE


CUYAHOGA COUNTY
CUY-10-16.23

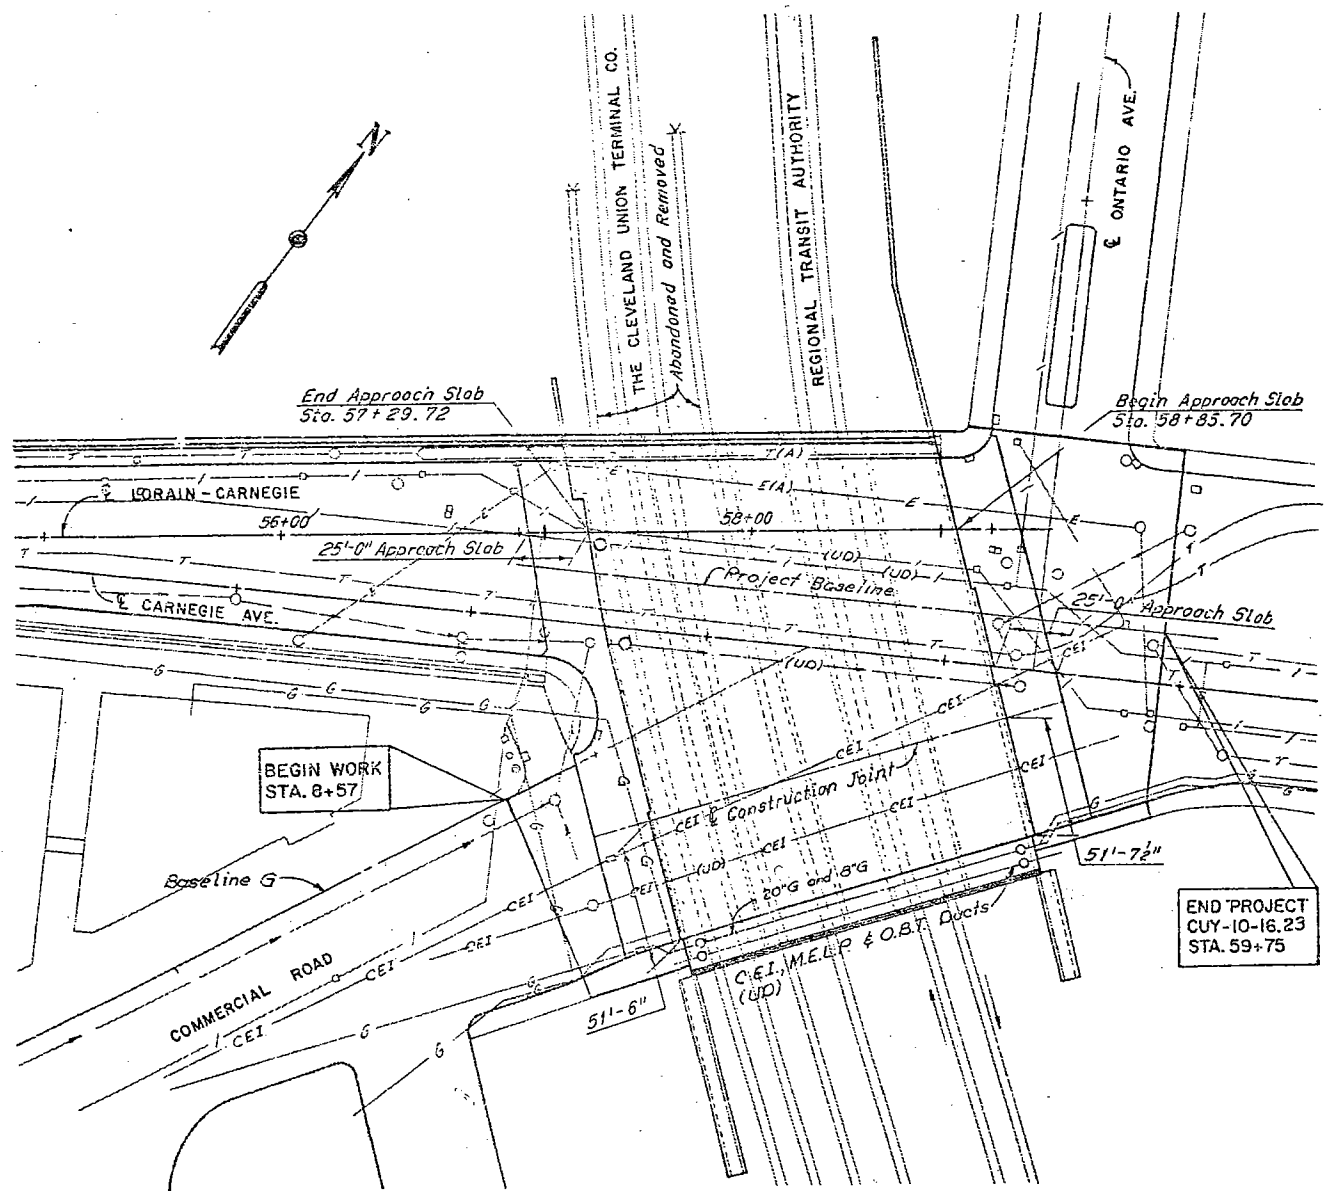

PLAN
(Utilities not shown otherwise are underground utilities)
40 0 40 80 120 160
SCALE IN FEET

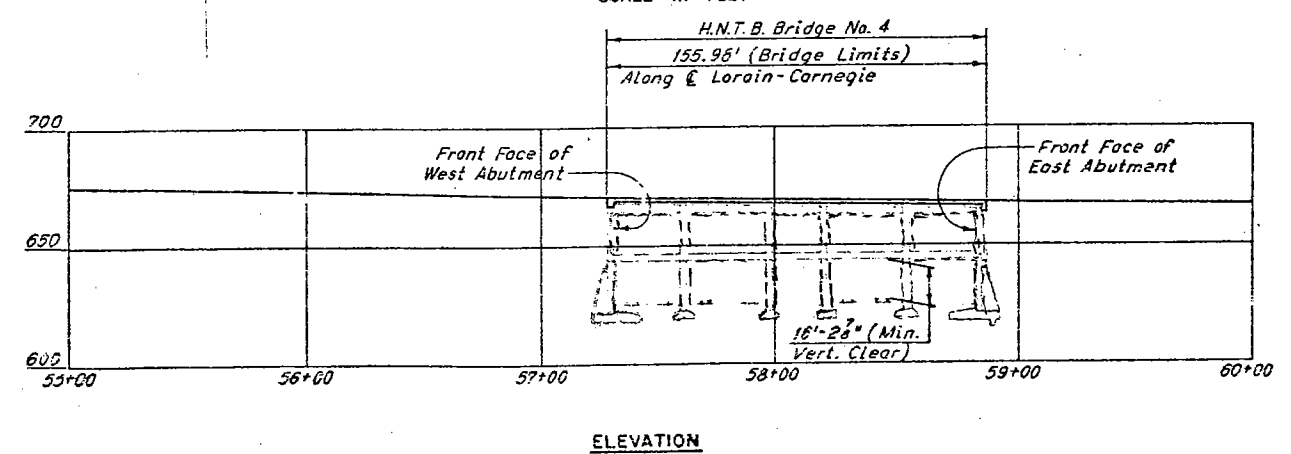

ELEVATION

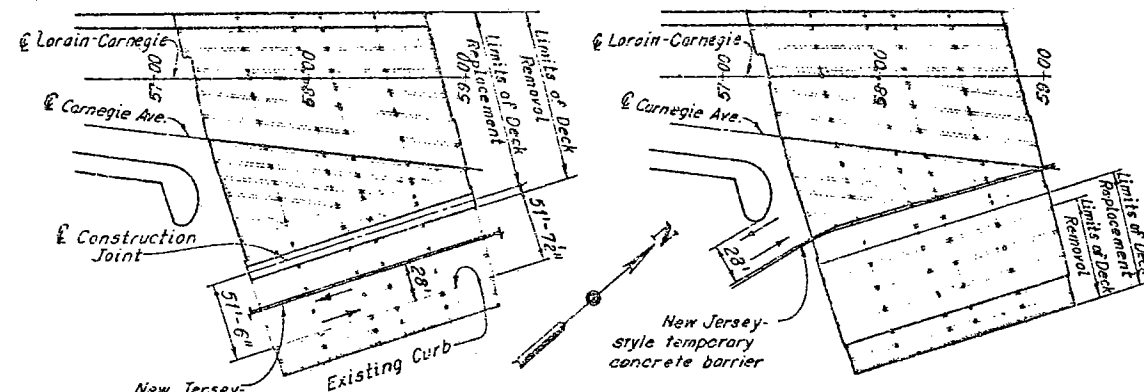

STAGE I
STAGE II
TRAFFIC MAINTENANCE - CARNEGIE AVENUE GRADE SEPARATION STRUCTURE
Scale: 1"=60'

The stage construction applies within the bridge and approach slab limits. All repair work shall be coordinated with the stage construction as shown.


Notes:
Subeased linework indicates existing conditions.
For Project Baseline Data, and Baseline G Data,
See Roadway Plans.

Note:
Underground and underdeck utilities not indicated as being abandoned shall remain. The information shown on this drawing concerning type and location of underground and underdeck utilities is not guaranteed to be accurate or all inclusive. The Contractor is responsible for making his own determination as to the type and location of underground and underdeck utilities as may be necessary to avoid damage thereto. Full expense involved in relocating the affected utility, except where the relocation is covered in these plans, shall be borne by the Owner of the utility. The Contractor and Owner are requested to cooperate by arranging their work in such a manner that inconvenience to either will be held to a minimum.

UTILITY LEGEND


- (A) - Indicates a utility to be abandoned
- (UD) - Indicates an underdeck utility
- E - Indicates Municipal Electric Light and Power line (M.E.L.P.)
- T - Indicates Ohio Bell Telephone Line (O.B.T.)
- I - Indicates water line
- G - Indicates gas line
- - Indicates sewer line
- CEI - Indicates Cleveland Electric Illuminating Company line (C.E.I.)

PROPOSED STRUCTURE DATA ON CONCRETE GIRDERS
BRIDGE NO. CUY-10-1685
TYPE: Reinforced Concrete Girder, Deck and Substructure
SPAN: See Framing Plan, Sheet No. 150.
ROADWAY: Varies
LOADING: HS 20-44 Case II and The Alternate Military Loading
SKEW: Varies
WEARING SURF: 2 3/4" Asphalt Concrete (Rubberized)
ALIGN: Tangent

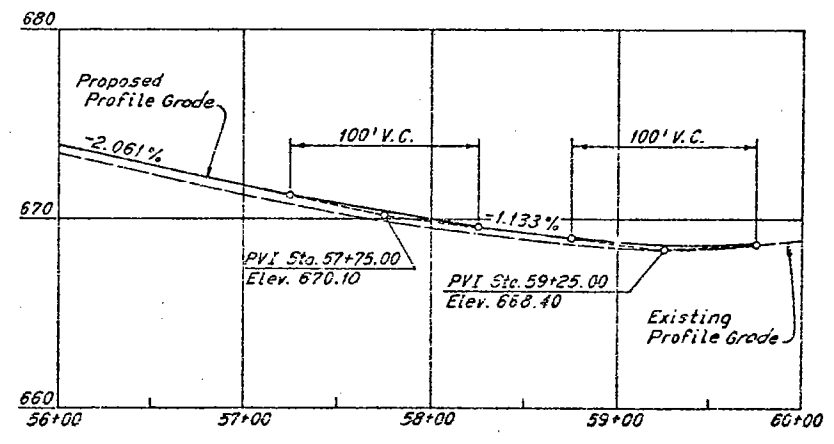


PROFILE GRADE GRADE SEPARATION
ALONG PROJECT BASELINE

HNTB BRIDGE NO. 4		HNTB
HOWARD, NEEDLES, TAMMEN & BERGENDOFF CONSULTING ENGINEERS CLEVELAND		
SITE PLAN		
REHABILITATION OF THE CARNEGIE AVENUE GRADE SEPARATION STRUCTURE (S.R.10 OVER THE CLEVELAND UNION TERMINALS CO. AND THE REGIONAL TRANSIT AUTHORITY) BR. NO. CUY-10-1685 STA. 57+29.72 CUYAHOGA COUNTY OHIO STA. 58+85.70		
DRAWN BY DATE 9-23-75	TRACED BY D.L.B. DATE 9-7-75	CHECKED BY R.A.S. DATE 9-25-75
		REVIEWED BY DATE SHEET 1/31

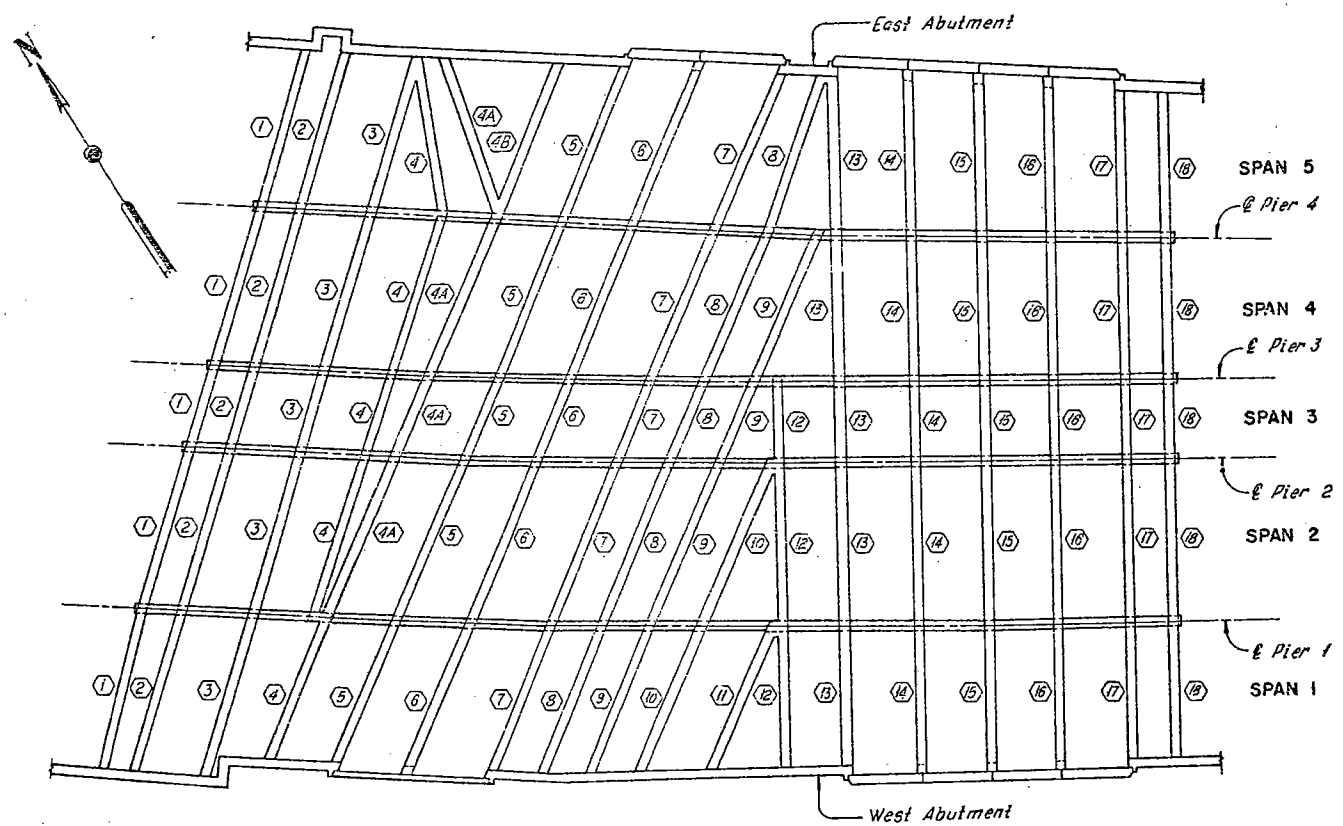

STRUT AND PIER IDENTIFICATION PLAN
(Lower Level Framing)

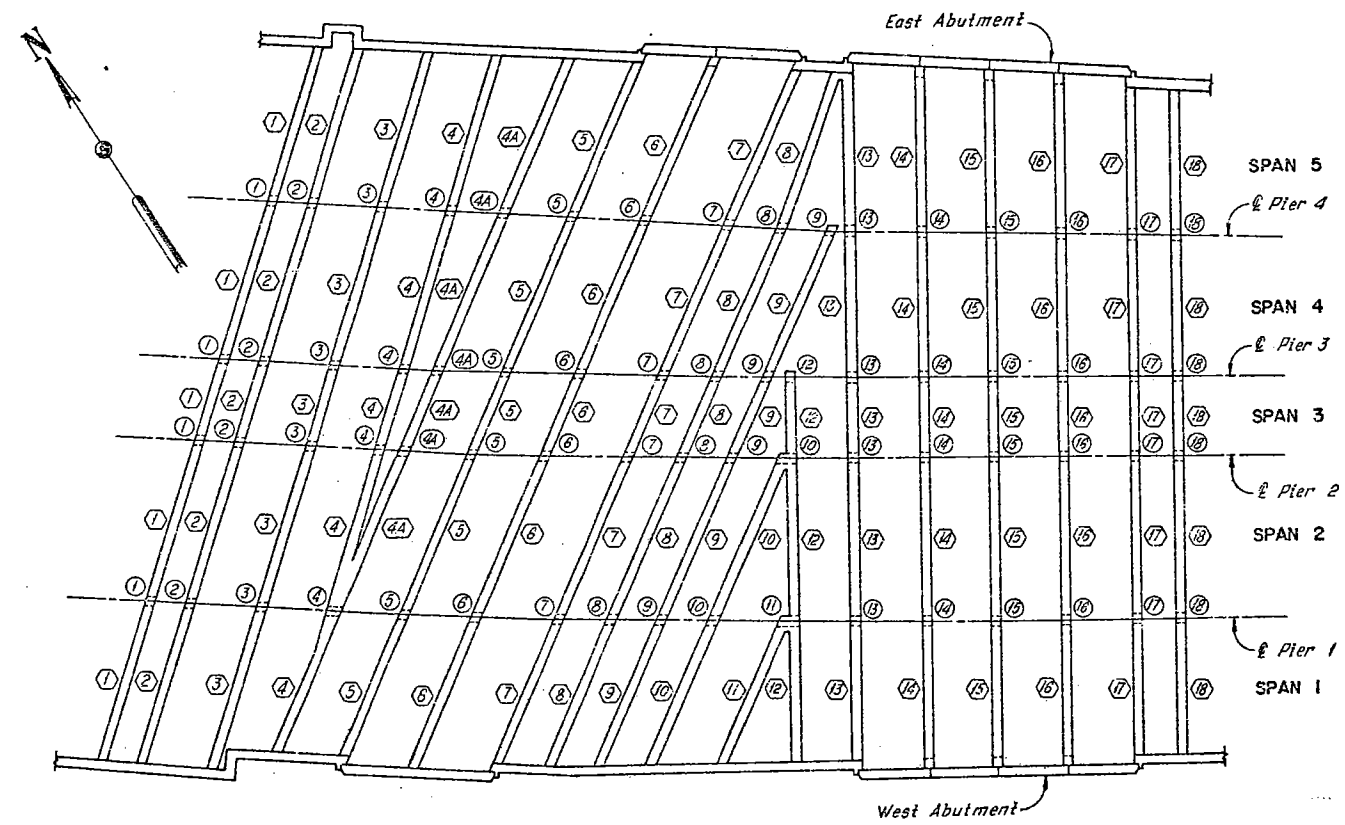


GIRDER AND COLUMN IDENTIFICATION PLAN
(Upper Level Framing)

LEGEND:

- Strut or Girder
- Column

HNTB BRIDGE NO. 4			
HOWARD, NEEDLES, TAMMEN & BERGENDOFF CONSULTING ENGINEERS CLEVELAND			HNTB
MEMBER IDENTIFICATION PLANS			
REHABILITATION OF THE CARNEGIE AVENUE GRADE SEPARATION STRUCTURE (S.R. 10 OVER THE CLEVELAND UNION TERMINALS CO. AND THE REGIONAL TRANSIT AUTHORITY)			
BR. NO. CUY-10-1685		STA. 57+29.72 STA. 58+85.70	
CUYAHOGA COUNTY OHIO			
DRAWN BY	TRACED BY	CHECKED BY	REVIEWED BY
DATE	DATE	DATE	DATE
			SHEET 2 3

Note:
Prior to deck removal over the girders, Girders 2 thru 16 shall be shored. For Girders 2 thru 18 removal, see removal plans, typical section along Pier 3, Sheet 4/31.

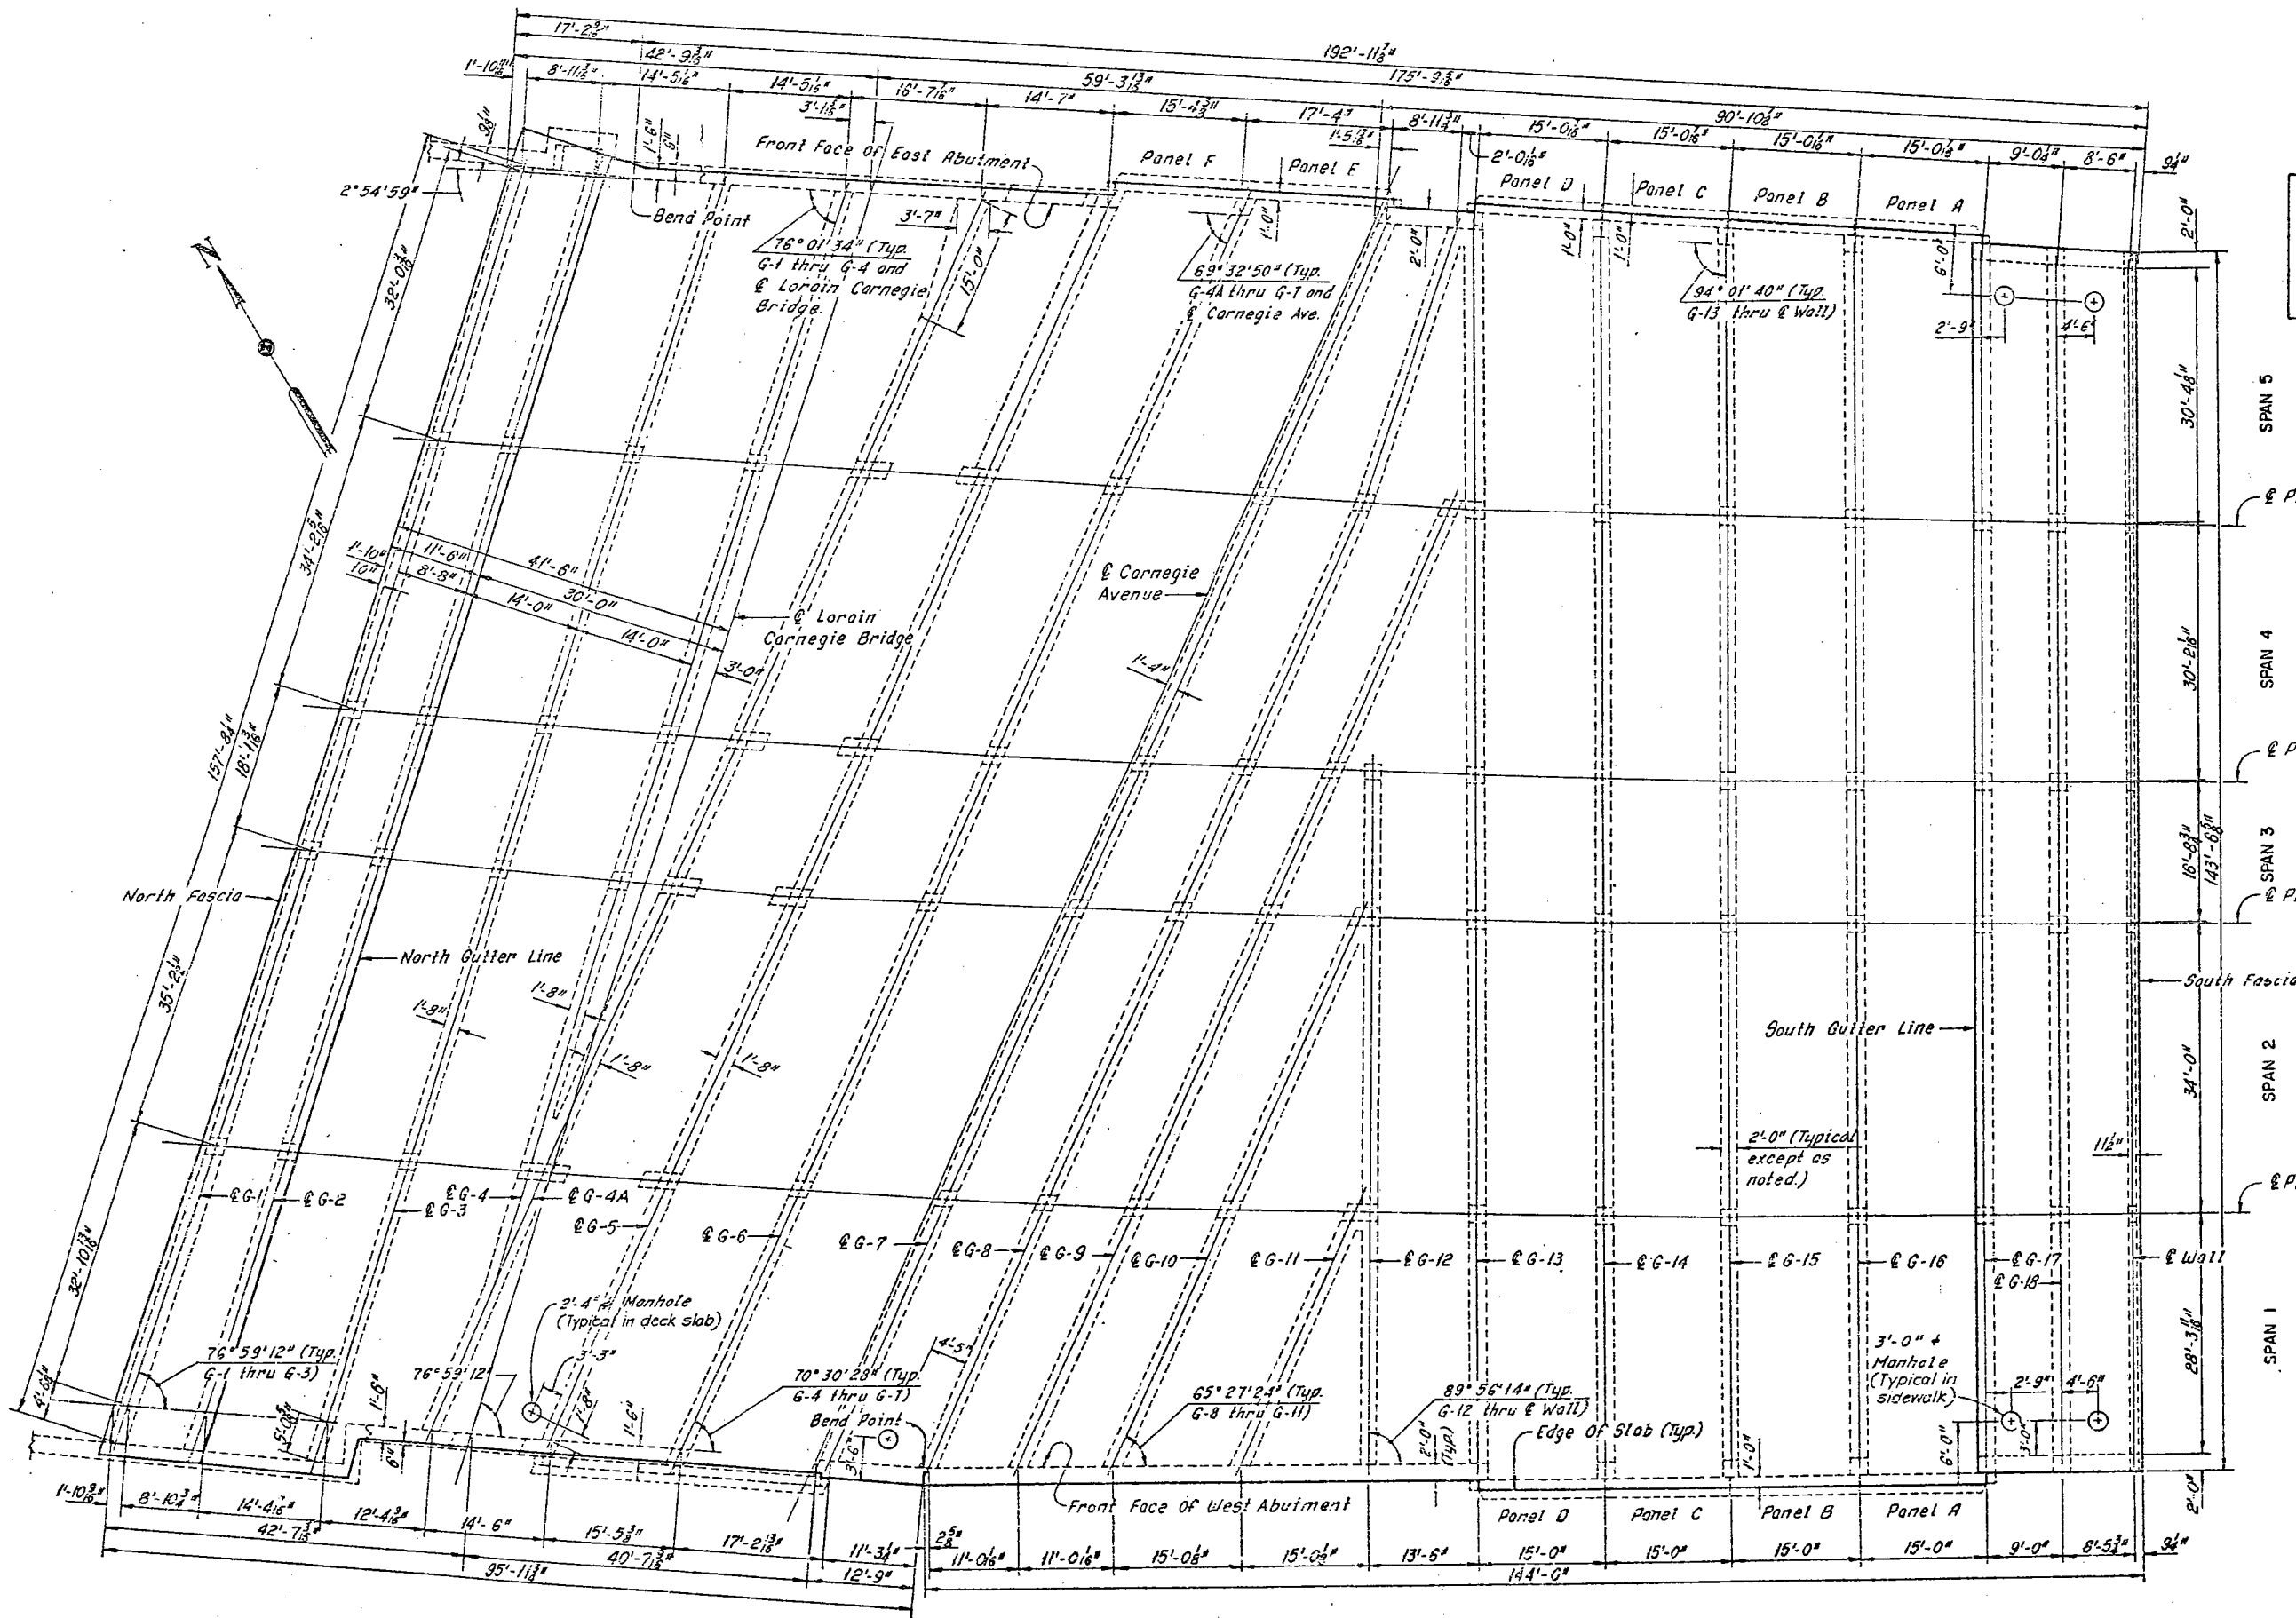

Notes:
For typical deck and girder removal details, see Sheet 4/31.
The existing manholes shall be reconstructed to grade. For details, see Sheets 25/31 and 27/31.
For strut and column removal details, see Sheet 6/31.
For removal plans of the West Abutment, see Sheets 7/31 thru 9/31.
For removal plans of the East Abutment, see Sheets 10/31 thru 12/31.
For removal plans along Pier 3, see Sheets 4/31 and 5/31.
For stage construction, see Sheet 1/31.

DECK PLAN

HNTB BRIDGE NO. 4

HOWARD, NEEDLES TAMMEN & BERGENDOFF
CONSULTING ENGINEERS
CLEVELAND

HNTB

DECK REMOVAL AND FRAMING PLAN

REHABILITATION OF THE
CARNegie AVENUE GRADE SEPARATION STRUCTURE
(S.R.10 OVER THE CLEVELAND UNION TERMINALS CO. AND THE REGIONAL TRANSIT AUTHORITY)

BR. NO. CUY. -10-1685 STA 57+29.72
STA 58+85.70


CUYAHOGA COUNTY OHIO

DRAWN	TRACED	CHECKED	REVIEWED	REVISED
BO	EP	FR		
DATE 20-7-72	DATE 20-7-72	DATE 7-72	DATE	SHEET 3/31


FHWA REGION	STATE	PROJECT
5	OHIO	

151
185

CUYAHOGA COUNTY
CUY-10-16.23

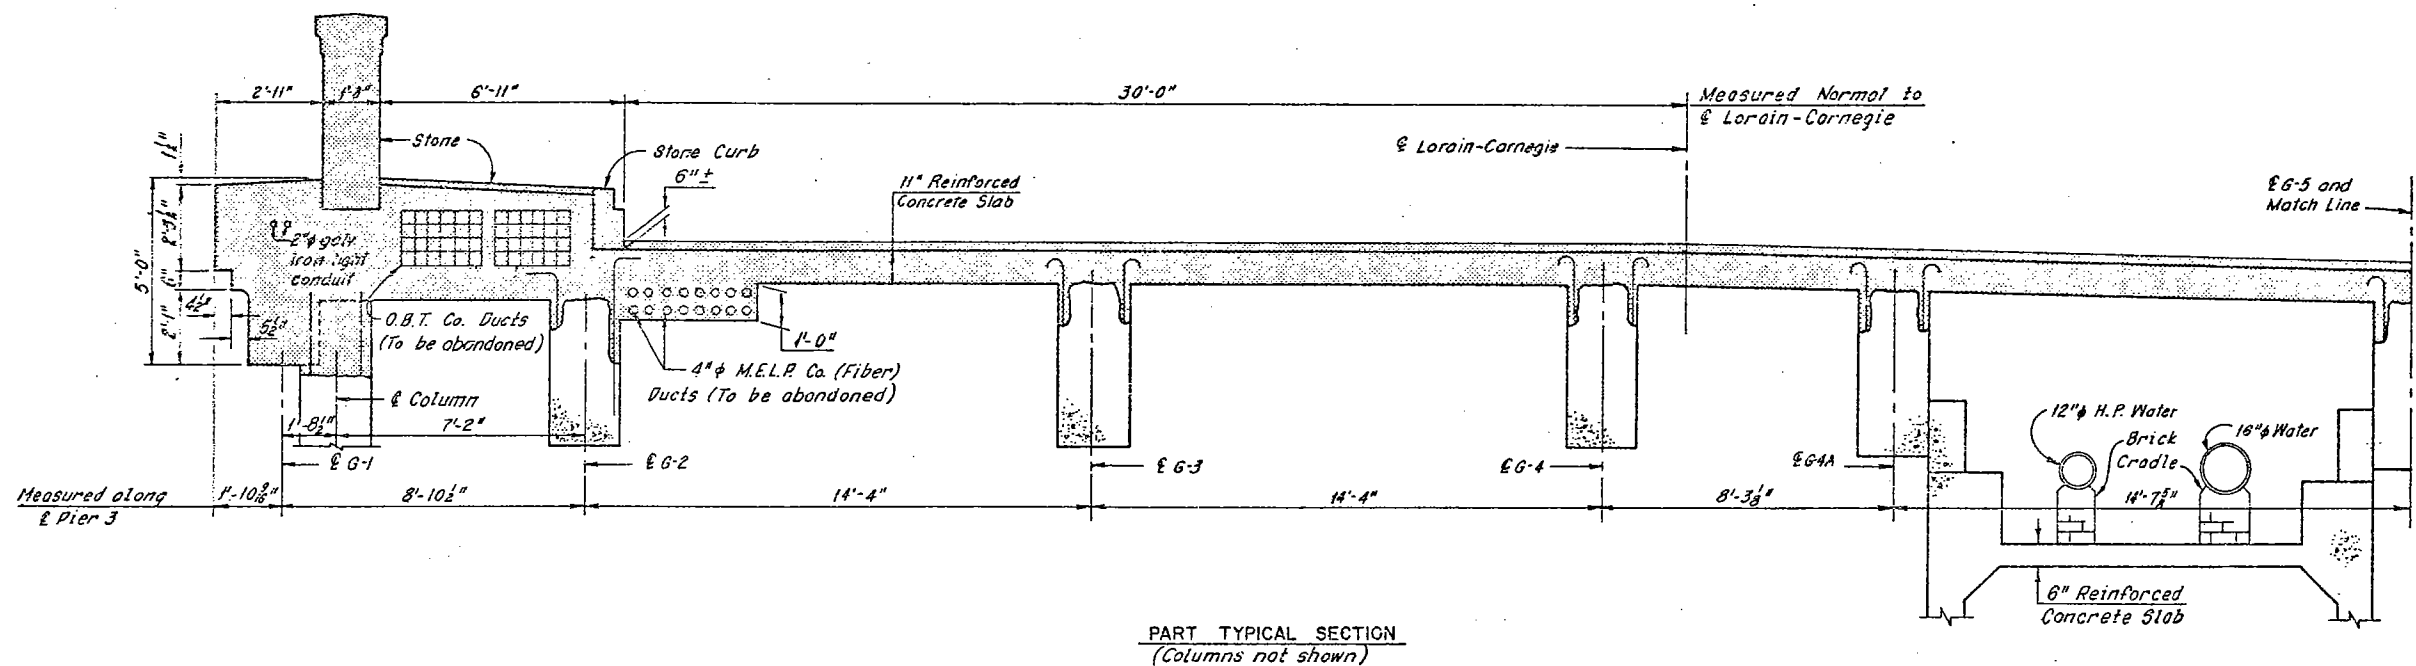

PART TYPICAL SECTION
(Columns not shown)

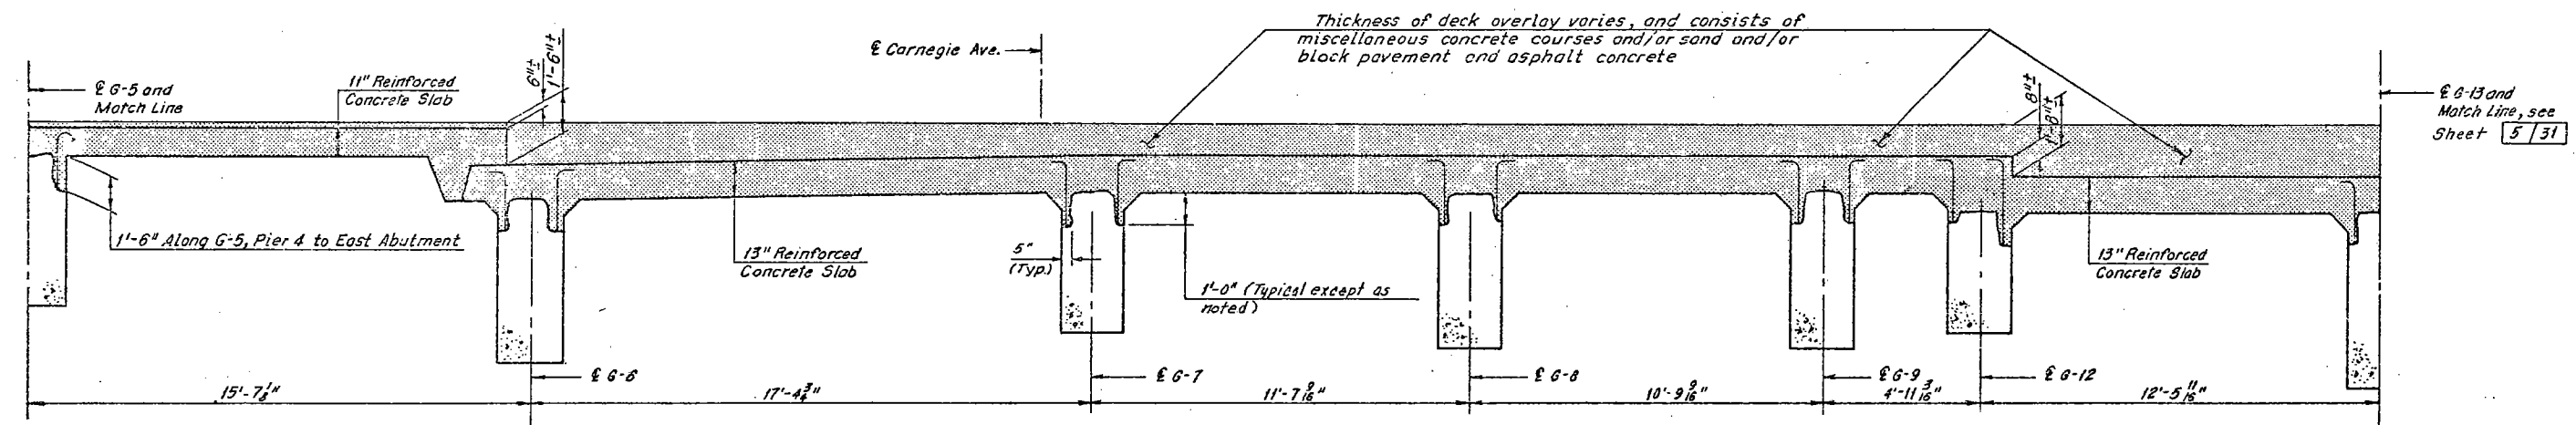

PART TYPICAL SECTION
(Columns not shown)

SPECIAL REQUIREMENTS FOR GIRDER 1 AND DECK REMOVAL

- The girders are under a compressive load from the abutments. Before Girder 1 replacement work begins the Contractor shall temporarily support the abutments at the girder. The supports shall be preloaded to resist a total compressive force of 35 kips at each abutment and shall be retained until the replacement Girder 1 attains its design strength. (For requirements and payment for temporary supports see General Note 9 on Sheet GN-1 and notes on Sheet E-1)
- Suggested deck removal sequence:
 - Laterally support Girders 2 thru 18 at each pier before deck removal operations begin.
 - Remove the deck between girders.
 - Shore girders 2 thru 18 continually throughout their length. Preload the supports with an upward force equal to the weight of the girder and remaining deck (Shoring shall remain in place until the replacement deck attains its design strength).
 - Remove the remaining portion of the deck.
 - An alternate sequence may be submitted to the Director for consideration and approval.

Notes:
 Zip-a-tone indicates portions of the structure to be removed.
 For Removal Details at Girders 2 thru 13, see Detail A, Sheet 5/31.
 For Framing Plan, see Sheet 3/31.
 For Modified Typical Section at Pier 3, see Sheets 22/31 and 23/31.
 The following abbreviations are used:
 Typ. = Typical
 O.B.T. = Ohio Bell Telephone Company
 C.E.I. = Cleveland Electric Illuminating Company
 M.E.L.P. = Municipality Electric Light and Power
 P.H.P. = Plain and, high pressure
 H.P. = High Pressure
 All existing reinforcing shown shall be retained. Other existing reinforcing shall be removed, except as noted in Detail A, Sheet 5/31.
 For Stage Construction, see Sheet 1/31.

HNTB BRIDGE NO. 4

HOWARD, NEEDLES, TAMMEN & BERGENDOFF CONSULTING ENGINEERS CLEVELAND HNTB

REMOVAL PLANS
TYPICAL SECTION ALONG PIER 3
REHABILITATION OF THE
CARNegie AVENUE GRADE SEPARATION STRUCTURE
(S.R.10 OVER THE CLEVELAND UNION TERMINALS CO.
AND THE REGIONAL TRANSIT AUTHORITY)
BR. NO. CUY.-10-1685 STA. 57+29.72
CUYAHOGA COUNTY STA. 58+85.70 OHIO


DRAWN	TRACED	CHECKED	REVIEWED	REVISED
BP	BP	P2		
DATE: 11-78	DATE: 3-78	DATE: 7-78	DATE:	

SHEET 4/31


FHWA REGION	STATE	PROJECT
5	OHIO	

152
185

CUYAHOGA COUNTY
CUY-10-16.23

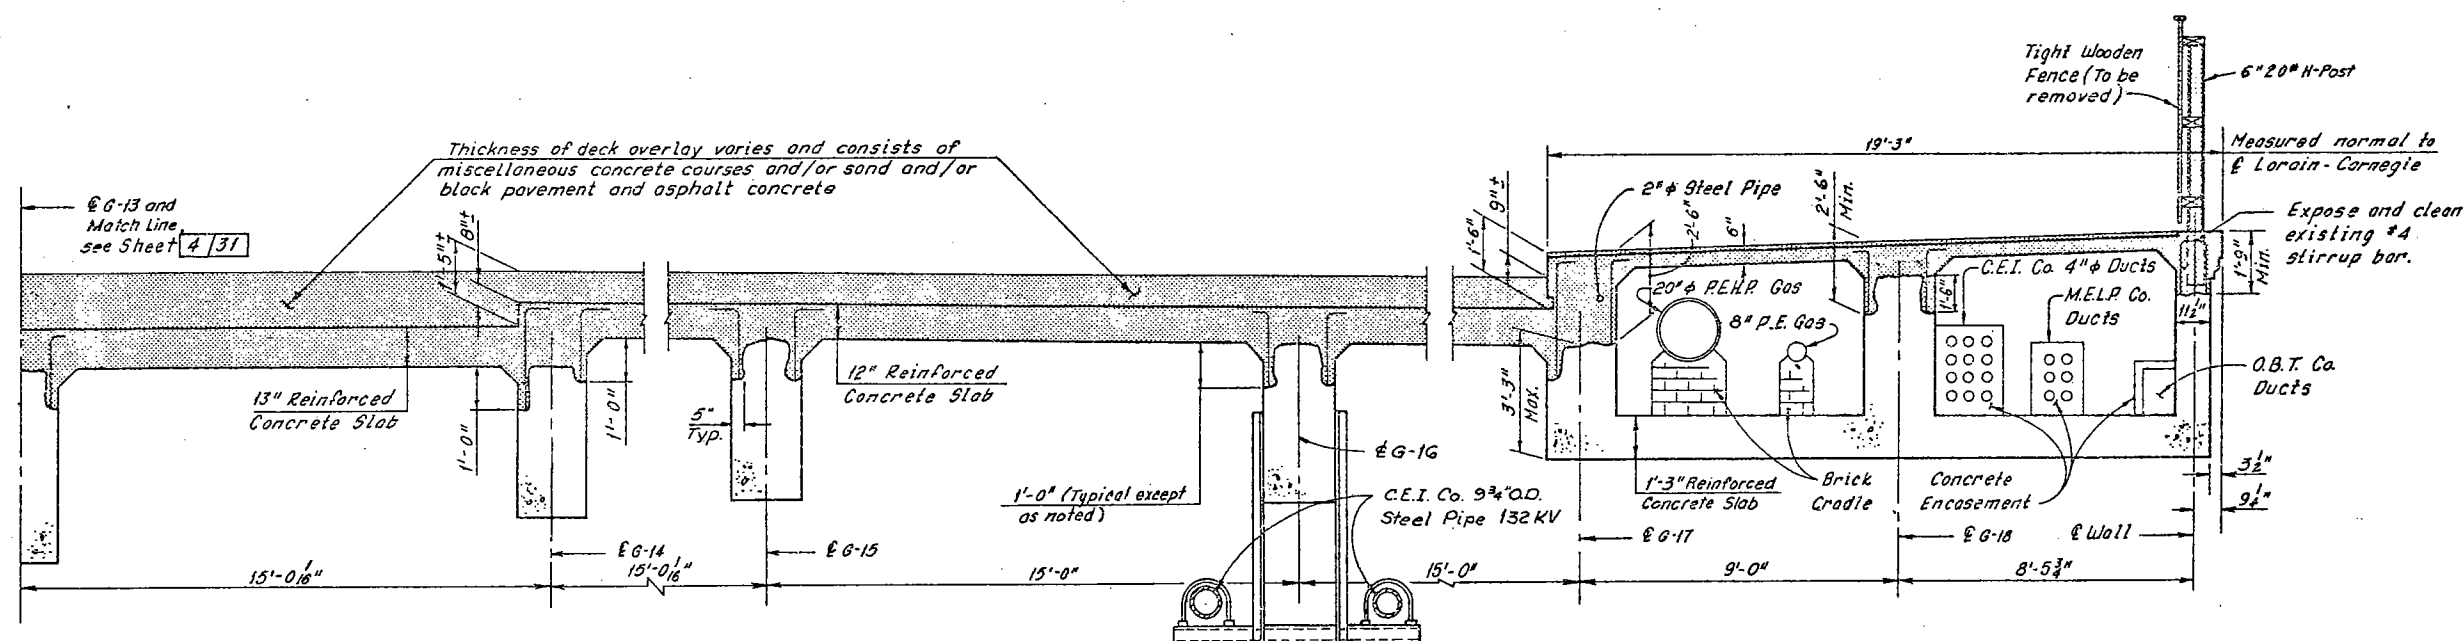

PART TYPICAL SECTION
(Columns and C.E.I. Protection not shown)

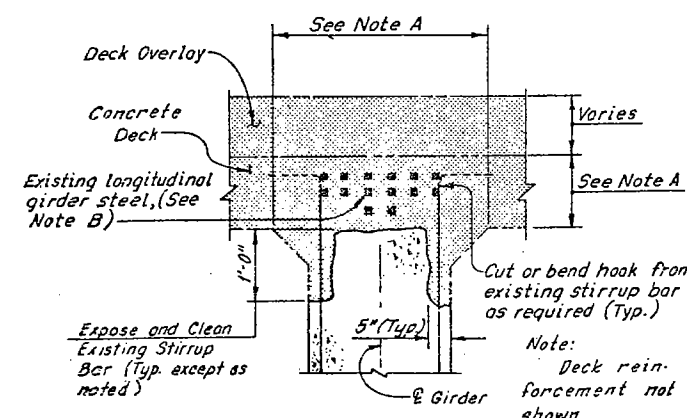

DETAIL A
(Girder 2 Thru Girder 18)

Note A:
Concrete above the girders shall remain in place until the girders have been properly shored. Special requirements for Girder 1 and Deck Removal, see Sheet 4/31.

Note B:
All existing longitudinal girder reinforcement shall be retained except at the option of the Contractor and with the approval of the Engineer new bars may be substituted for the original bars. The new bars may be round or square with a cross-sectional area equal or greater than the original bars. No additional payment will be made for substituting new bars for the original bars.

Notes:
Zip-a-tone indicates portions of the structure to be removed.
For Framing Plan, see Sheet 3/31.
For Modified Typical Section of Pier 3, see Sheets 22/31 and 23/31.
The following abbreviations are used:
Typ. = Typical
O.B.T. = Ohio Bell Telephone Company
C.E.I. = Cleveland Electric Illuminating Company
M.E.L.P. = Municipaly Electric Light and Power
P.E.H.P. = Plain end, high pressure
H.P. = High Pressure
All existing reinforcing shown shall be retained. Other existing reinforcing shall be removed, except as noted in Detail A.
For Stage Construction, see Sheet 1/31.

HNTB BRIDGE NO. 4


HOWARD, NEEDLES, TAMMEN & BERGENDOFF
CONSULTING ENGINEERS
CLEVELAND

HNTB


REMOVAL PLANS
TYPICAL SECTION ALONG PIER 3
REHABILITATION OF THE
CARNEGIE AVENUE GRADE SEPARATION STRUCTURE
(S.R.10 OVER THE CLEVELAND UNION TERMINALS CO.
AND THE REGIONAL TRANSIT AUTHORITY)
BR. NO. CUY.-10-1685 STA. 57+29.72
CUYAHOGA COUNTY STA. 58+85.70 OHIO

DRAWN	TRACED	CHECKED	REVIEWED	REVISED
SP	SP	SP	SP	
DATE 5-17-77	DATE 5-31-77	DATE 7-7-78	DATE	


SHEET 5/31

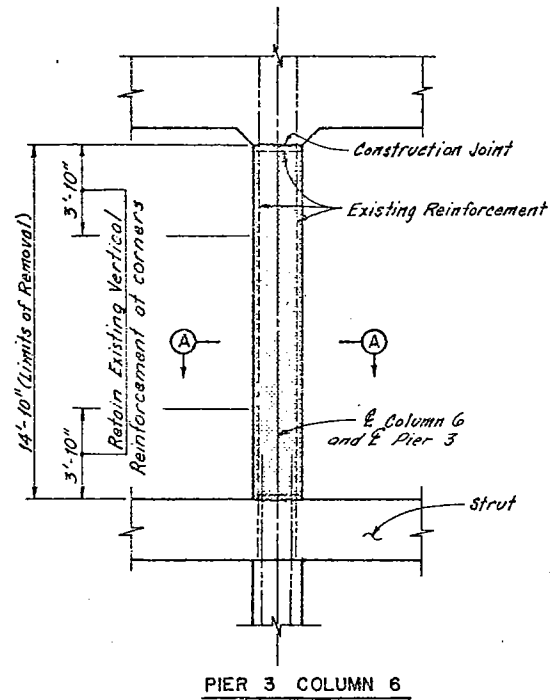


PIER 3 COLUMN 6

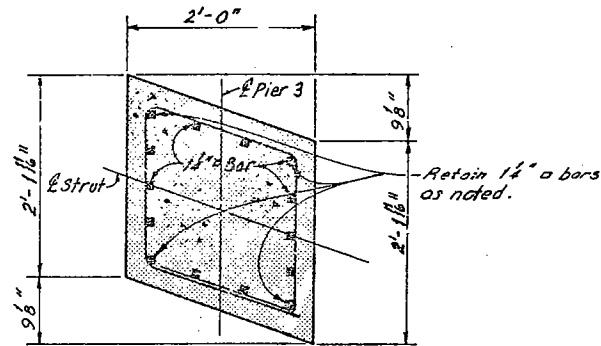


SECTION A-A

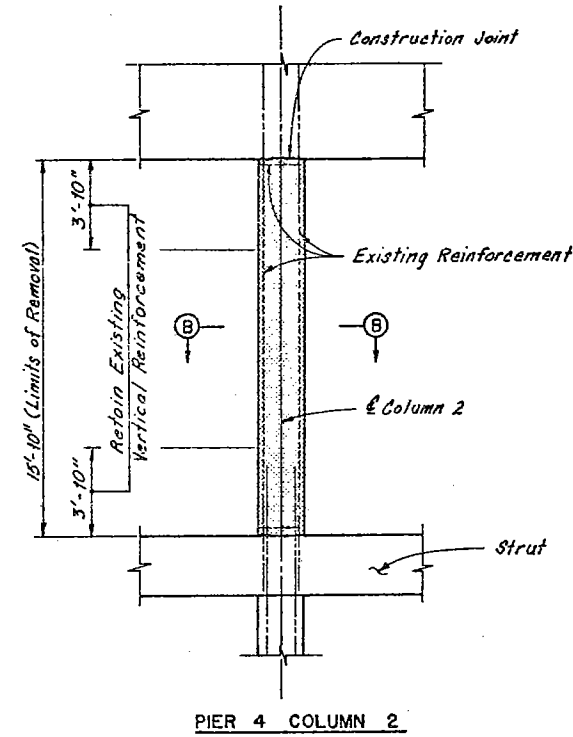


PIER 4 COLUMN 2

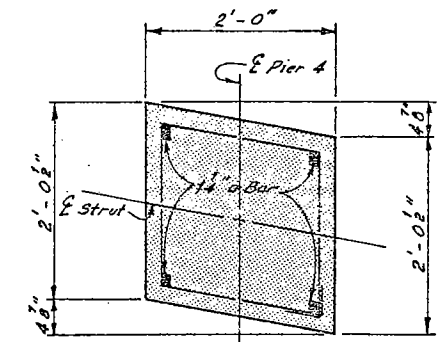

SECTION B-B

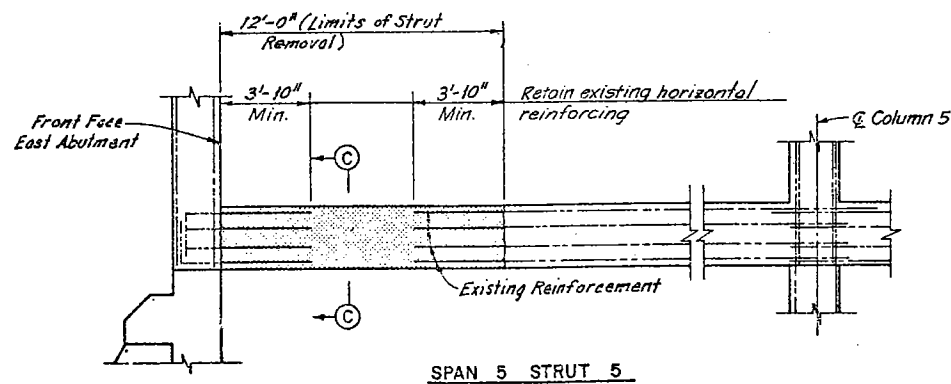

SPAN 5 STRUT 5

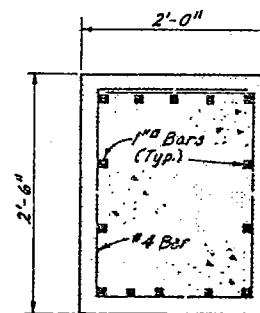

SECTION C-C

Special Requirements for Strut Removal

1. The strut removal and repair shall be accomplished prior to shoring the girders.
2. The strut is under a compressive load from the abutments. Before strut removal work begins, the Contractor shall install temporary supports between Column 5 and the East Abutment as close as possible to the strut top. The supports shall be preloaded with a total load 153.5 kips and this load shall be retained until the replacement strut attains design strength.


Note:
 Zipatone indicates portions of structure to be removed.
 For strut and column repair details, see Sheet 19/31.
 For member identification plans, see Sheet 2/31.

HNTB BRIDGE NO. 4		HOWARD, NEEDLES, TAMMEN & BERGENDOFF CONSULTING ENGINEERS CLEVELAND		HNTB	
STRUT AND COLUMN REMOVAL DETAILS					
REHABILITATION OF THE CARNEGIE AVENUE GRADE SEPARATION STRUCTURE (SR 10 OVER THE CLEVELAND UNION TERMINALS CO. AND THE REGIONAL TRANSIT AUTHORITY)					
BR. NO. CUY-10-1685			STA. 57+29.72		
			STA. 58+85.70		
CUYAHOGA COUNTY OHIO					
DRAWN	TRACED	CHECKED	REVIEWED	REVISED	
AJT	DES	RAJ			
DATE 8-1-78	DATE 8-3-78	DATE 9-6-78	DATE		SHEET 5/31


FHWA REGION	STATE	PROJECT
5	OHIO	

154
185

CUYAHOGA COUNTY
CUI-10-16.23

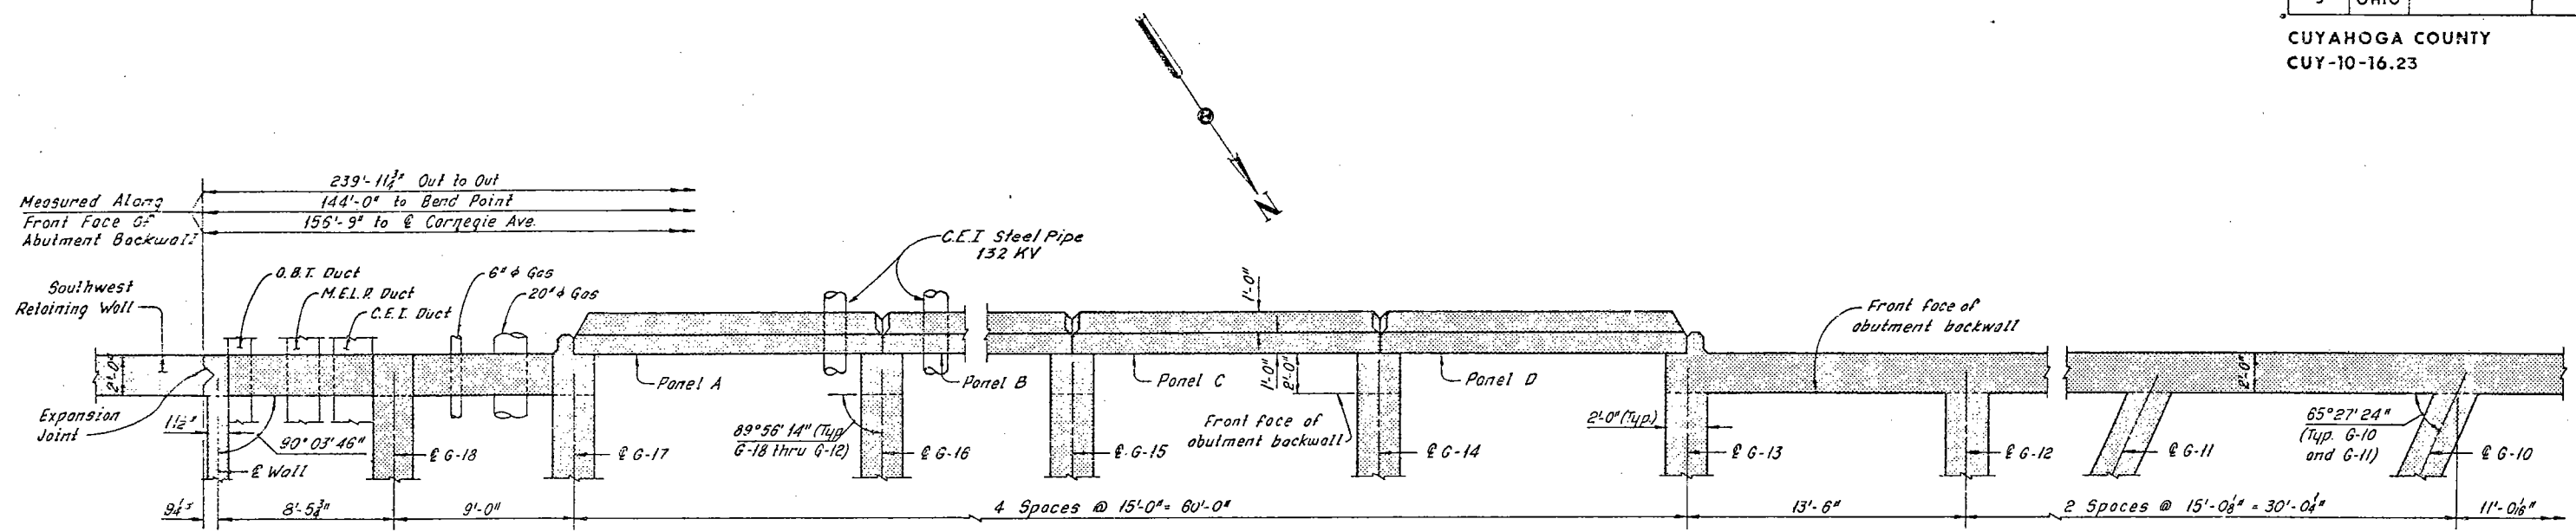

PART PLAN - WEST ABUTMENT
(Slab not shown)

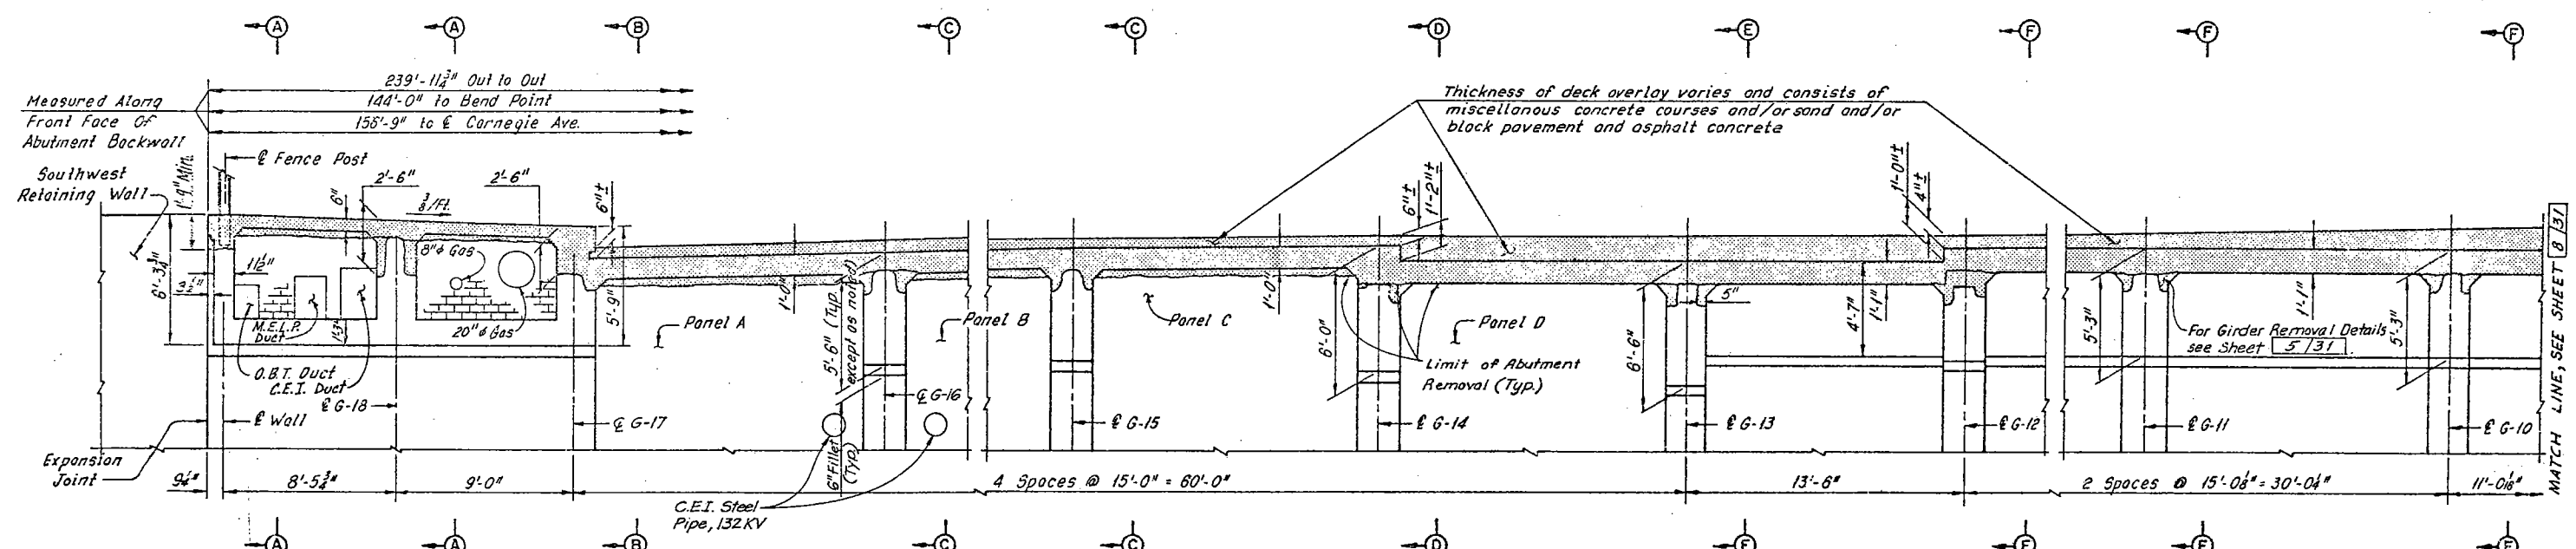


PART ELEVATION - WEST ABUTMENT


Note:
All existing vertical abutment reinforcement and all existing horizontal abutment reinforcement below the bottom of the new deck shall be retained as part of the new construction, except at new slab edge beams shown on Sheet 14/31. Horizontal reinforcement may be replaced in kind at no additional cost to the State.

Notes:
Zip-a-tone indicates portions of the structure to be removed.
For Sections A-A thru F-F, see Sheet 9/31.
For Modified West Abutment Details, see Sheets 13/31 thru 15/31.
The following abbreviations are used:
Typ. = Typical
M.E.L.P. = Municipal Electric Light and Power
O.B.T. = Ohio Bell Telephone Company
C.E.I. = Cleveland Electric Illuminating Company
For Stage Construction, see Sheet 1/31.

HNTB BRIDGE NO. 4				
HOWARD, NEEDLES, TAMMEN & BERGENDOFF CONSULTING ENGINEERS CLEVELAND				HNTB
REMOVAL PLANS WEST ABUTMENT				
REHABILITATION OF THE CARNegie AVENUE GRADE SEPARATION STRUCTURE (S.R.10 OVER THE CLEVELAND UNION TERMINALS CO. AND THE REGIONAL TRANSIT AUTHORITY)				
BR NO. CUY. -10-1685		STA. 57+29.72 STA. 58+85.70		
CUYAHOGA COUNTY OHIO				
DRAWN BP DATE 5-17-85	TRACED SP DATE 10-13-85	CHECKED PB DATE 7-7-85	REVIEWED DATE	REVISED DATE
				SHEET 7/31

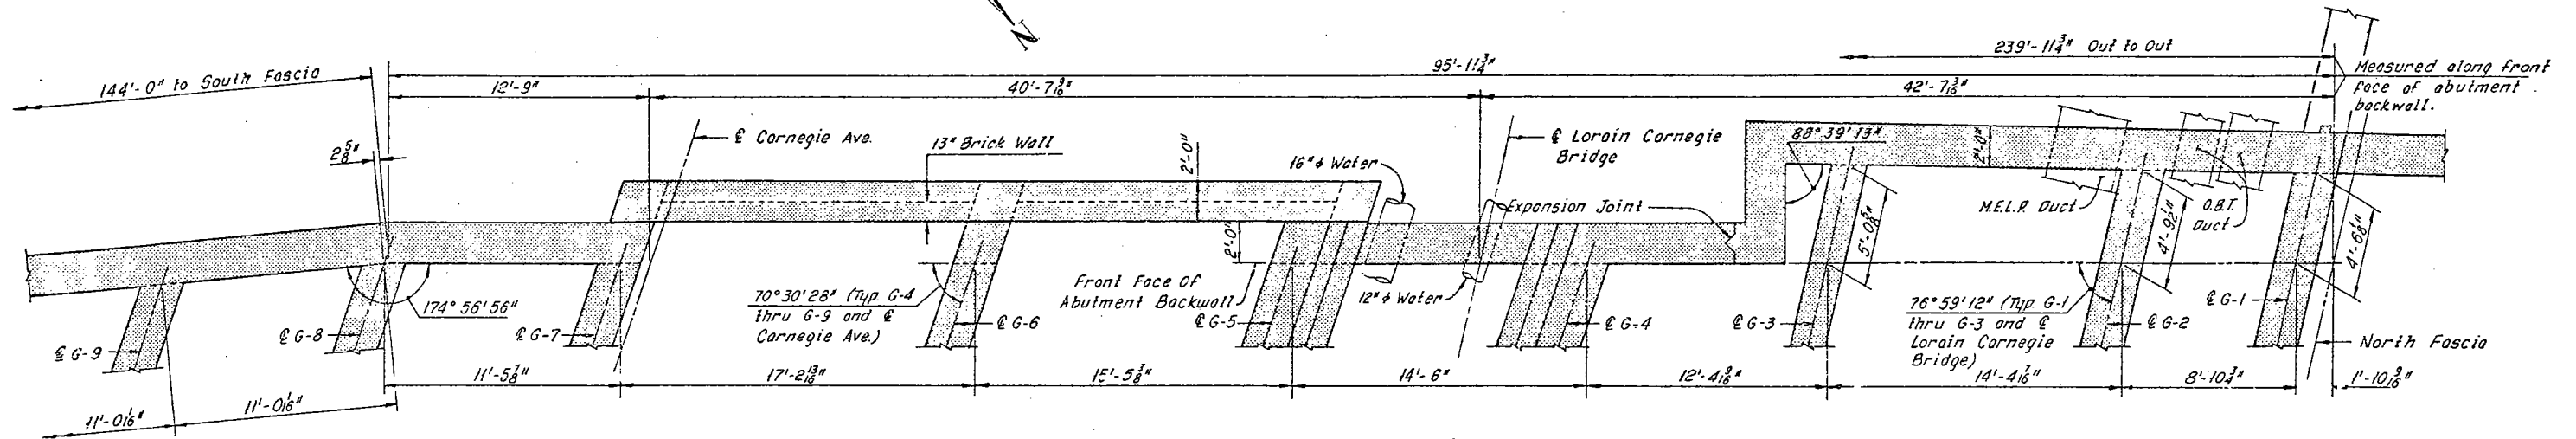

PART PLAN - WEST ABUTMENT
(Slab not shown)

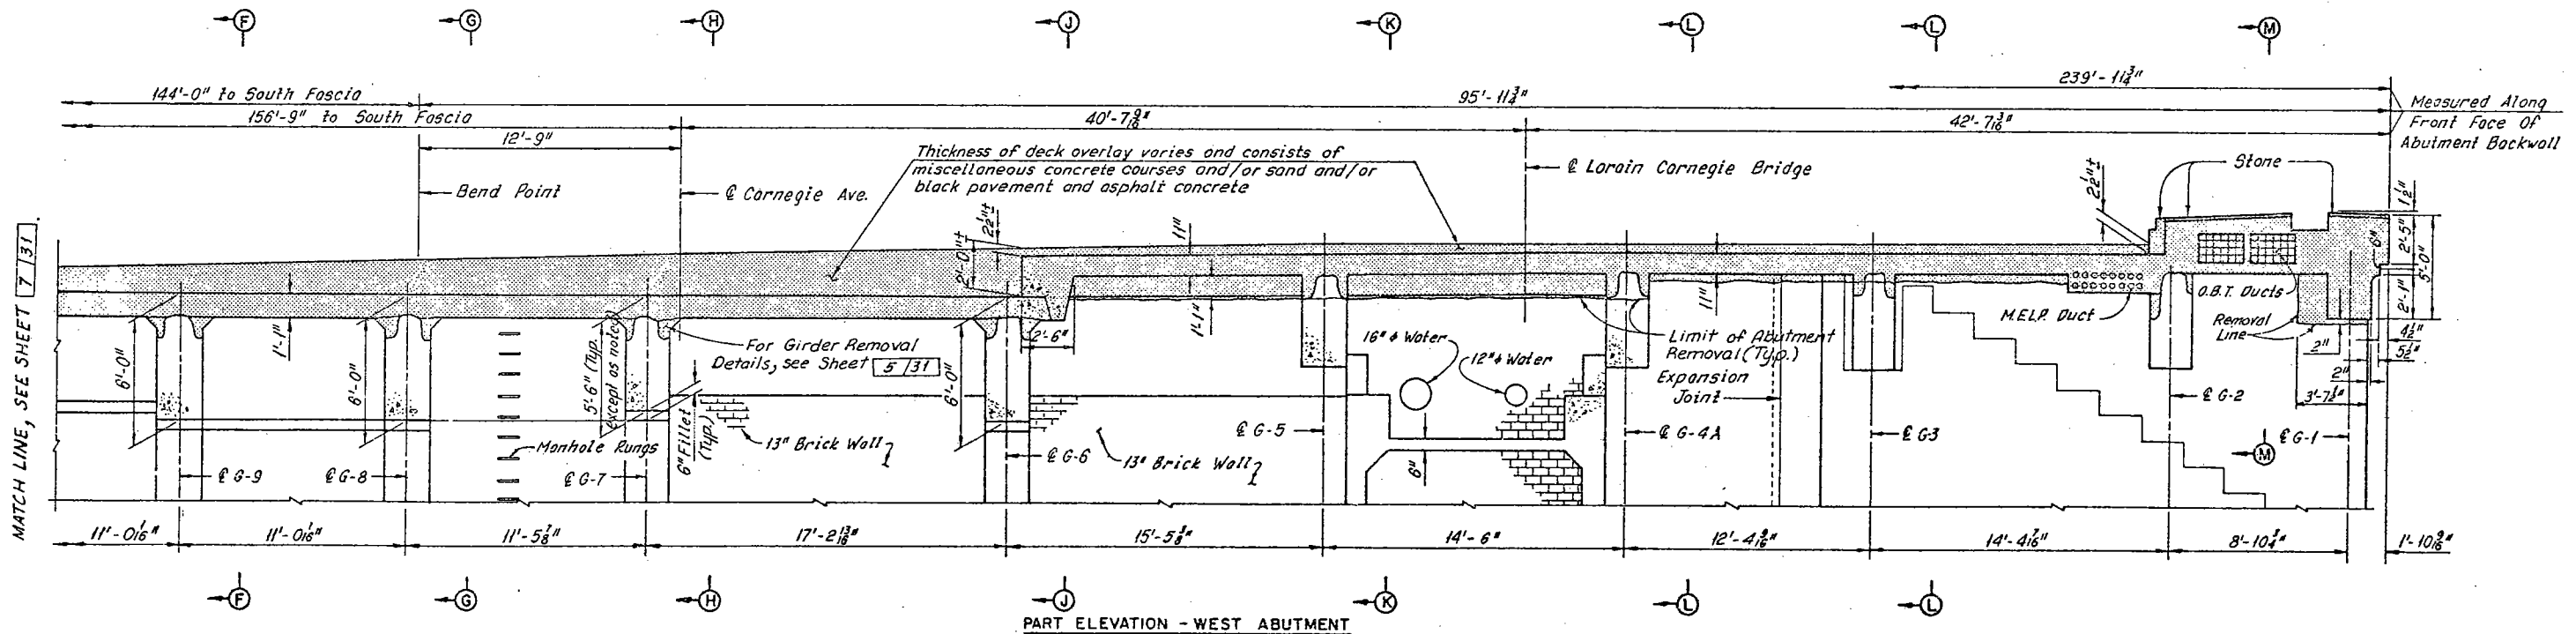

PART ELEVATION - WEST ABUTMENT

Note:
All existing vertical abutment reinforcement and all existing horizontal abutment reinforcement below the bottom of the new deck shall be retained as part of the new construction, except at new slab edge beams shown on Sheet 14/31. Horizontal reinforcement may be replaced in kind at no additional cost to the State.

Notes:
Zia-a-tone indicates portions of the structure to be removed.
For Sections F-F thru M-M, see Sheet 9/31.
For modified West Abutment details, see Sheets 13/31 thru 15/31.
The following abbreviations are used:
Typ. = Typical
M.E.L.P. = Municipal Electric Light and Power
O.B.T. = Ohio Bell Telephone Company
C.E.I. = Cleveland Electric Illuminating Company

HNTB BRIDGE NO. 4


HOWARD, NEEDLES, TAMMEN & BERGENDOFF
CONSULTING ENGINEERS
CLEVELAND

HNTB


**REMOVAL PLANS
WEST ABUTMENT**
REHABILITATION OF THE
CARNEGIE AVENUE GRADE SEPARATION STRUCTURE
(S.R.10 OVER THE CLEVELAND UNION TERMINALS CO.
AND THE REGIONAL TRANSIT AUTHORITY)
BR. NO. CUY-10-1685 STA. 57+29.72
CUYAHOGA COUNTY OHIO STA. 58+25.70

DRAWN	TRACED	CHECKED	REVIEWED	REVISED
DATE 3-18-21	DATE 10-11-21	DATE 7-7-21	DATE	DATE


SHEET 8/31

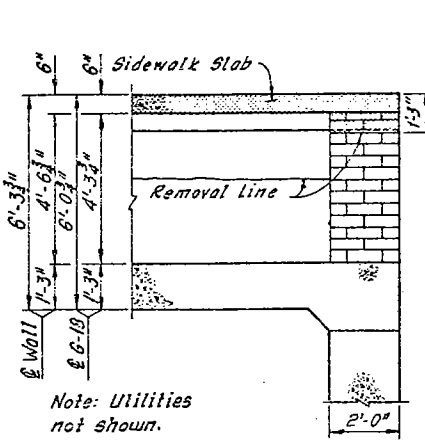


SECTION A-A

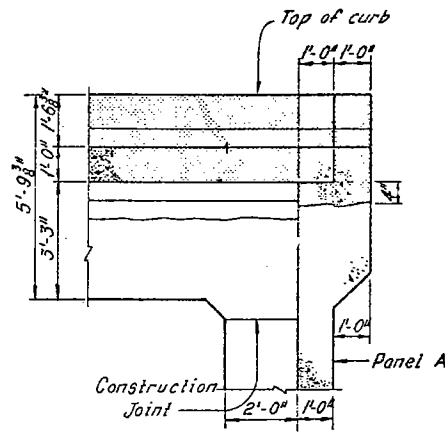


SECTION B-B

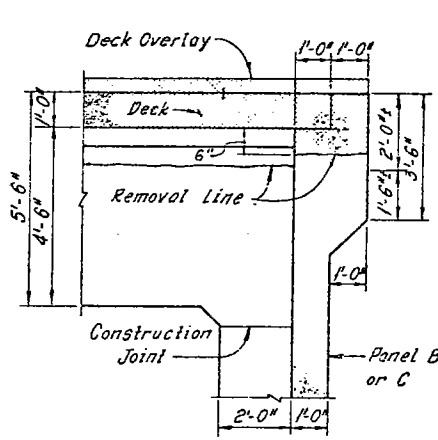


SECTION C-C

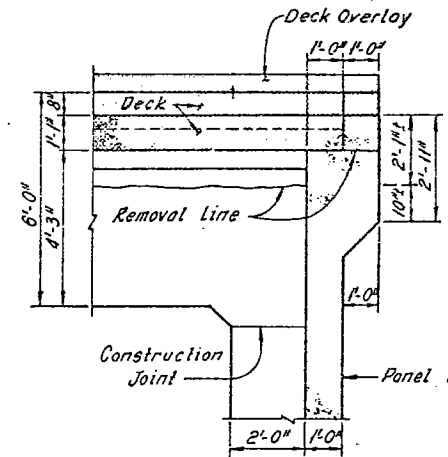


SECTION D-D

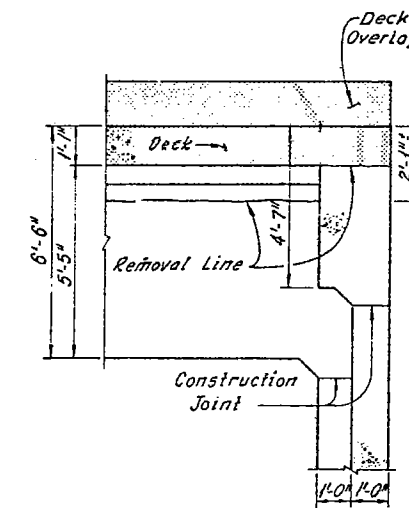


SECTION E-E

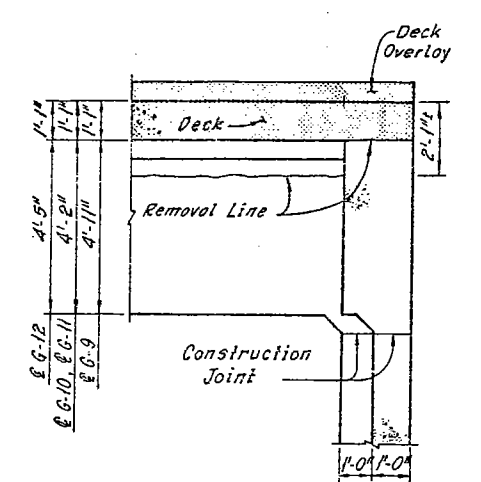


SECTION F-F

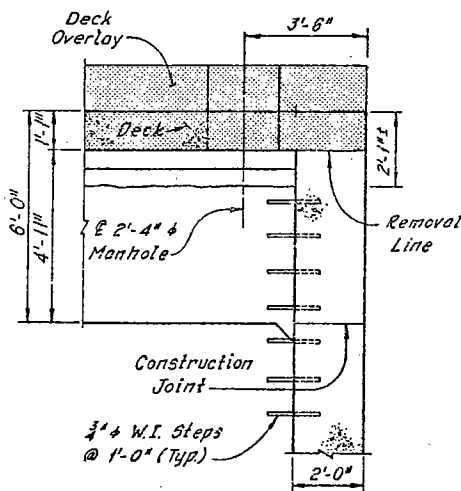


SECTION G-G

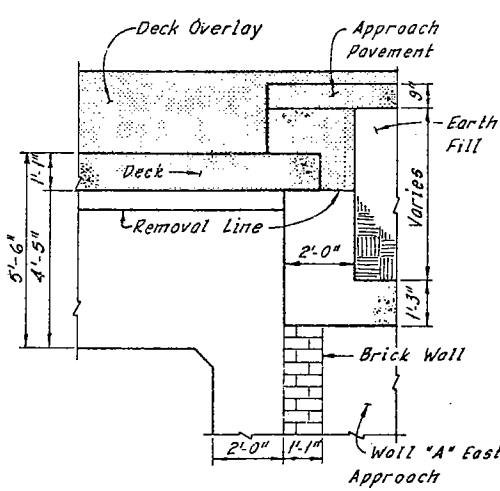


SECTION H-H

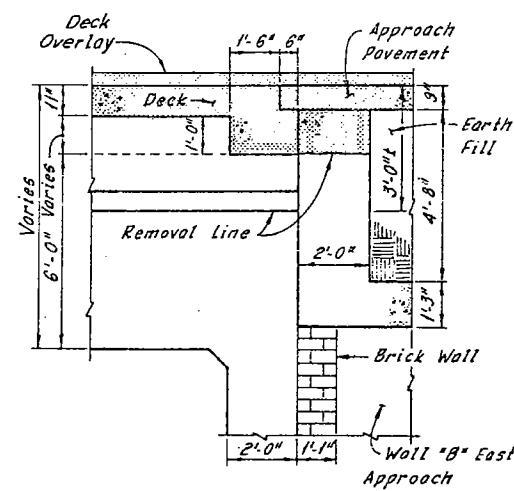


SECTION J-J

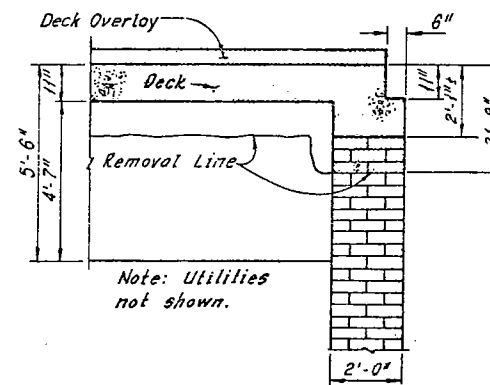

SECTION K-K

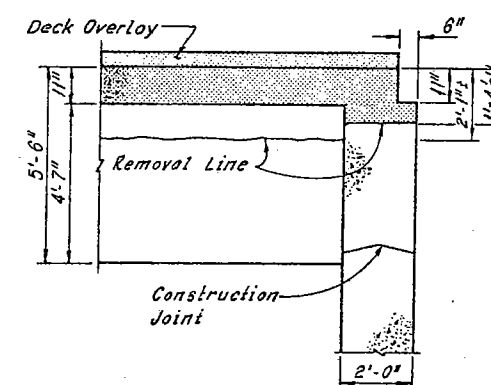

SECTION L-L

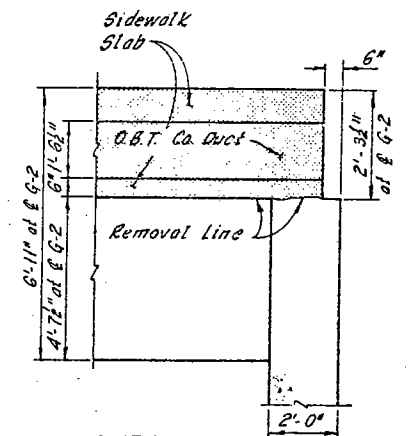

SECTION M-M

Note:
Existing reinforcement not shown. All existing vertical abutment reinforcement and all existing horizontal abutment reinforcement below the bottom of the new deck slab shall be retained as part of the new construction, except at new slab edge beams shown on Sheet 14/31. Horizontal reinforcement may be replaced in kind at no additional cost to the State.


Notes:
Zip-a-tone indicates portions of structure to be removed.
For limits of existing girder removal, see Detail A, Sheet 5/31.
For location of Sections A-A thru F-F, see Sheet 7/31.
For location of Sections F-F thru M-M, see Sheet 8/31.

HNTB BRIDGE NO. 4		HOWARD, NEEDLES, TAMMEN & BERGENDOFF CONSULTING ENGINEERS CLEVELAND		HNTB	
REMOVAL PLANS WEST ABUTMENT					
REHABILITATION OF THE CARNegie AVENUE GRADE SEPARATION STRUCTURE (S.R.10 OVER THE CLEVELAND UNION TERMINALS CO. AND THE REGIONAL TRANSIT AUTHORITY)					
BR. NO. CUY. -10-1685			STA. 57+29.72 STA. 58+85.70		
CUYAHOGA COUNTY			OHIO		
DRAWN BP	CHECKED BP	DATE 7.7.75	REVIEWED F3	DATE 7.7.75	REVISED
					SHEET 9/31


FHWA REGION	STATE	PROJECT
5	OHIO	

157
185

CUYAHOGA COUNTY
CUY-10-16.23

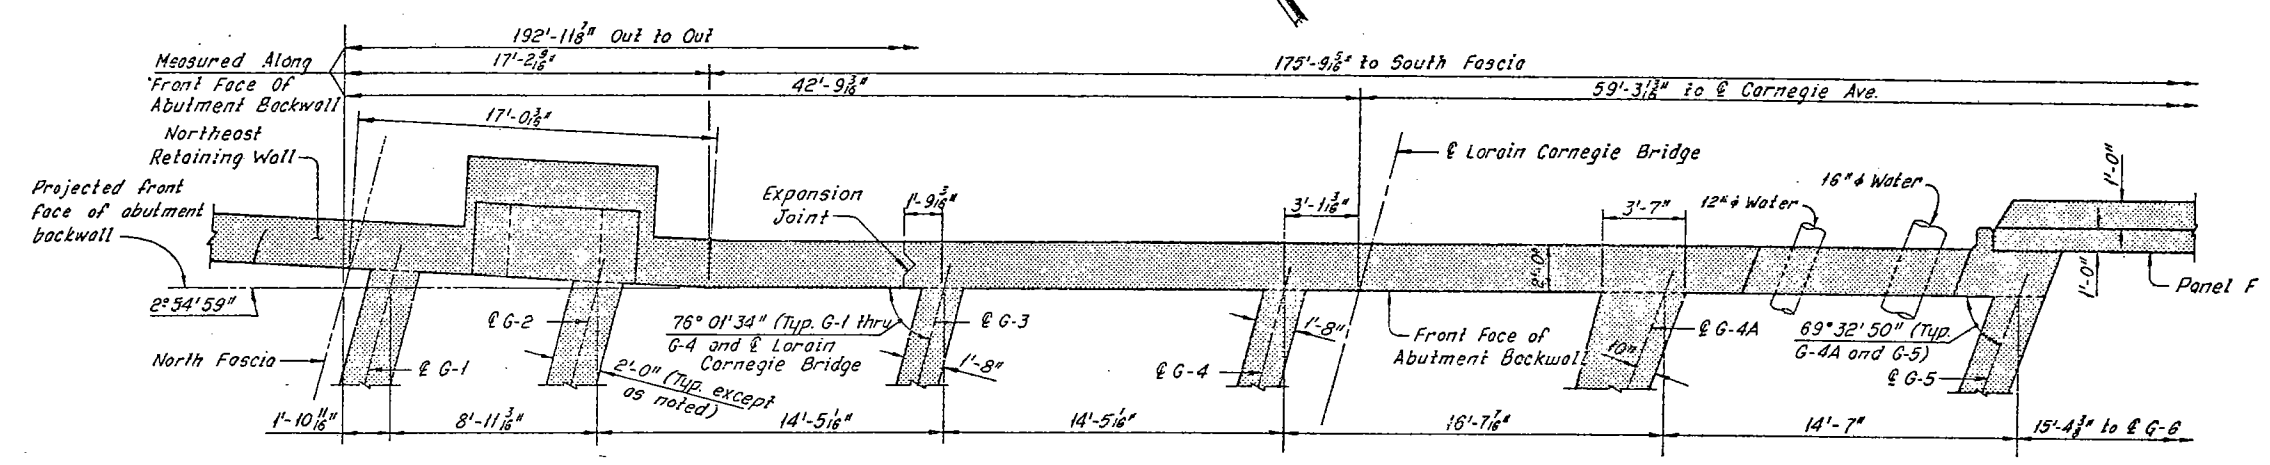

PART PLAN - EAST ABUTMENT
(Slab not shown)

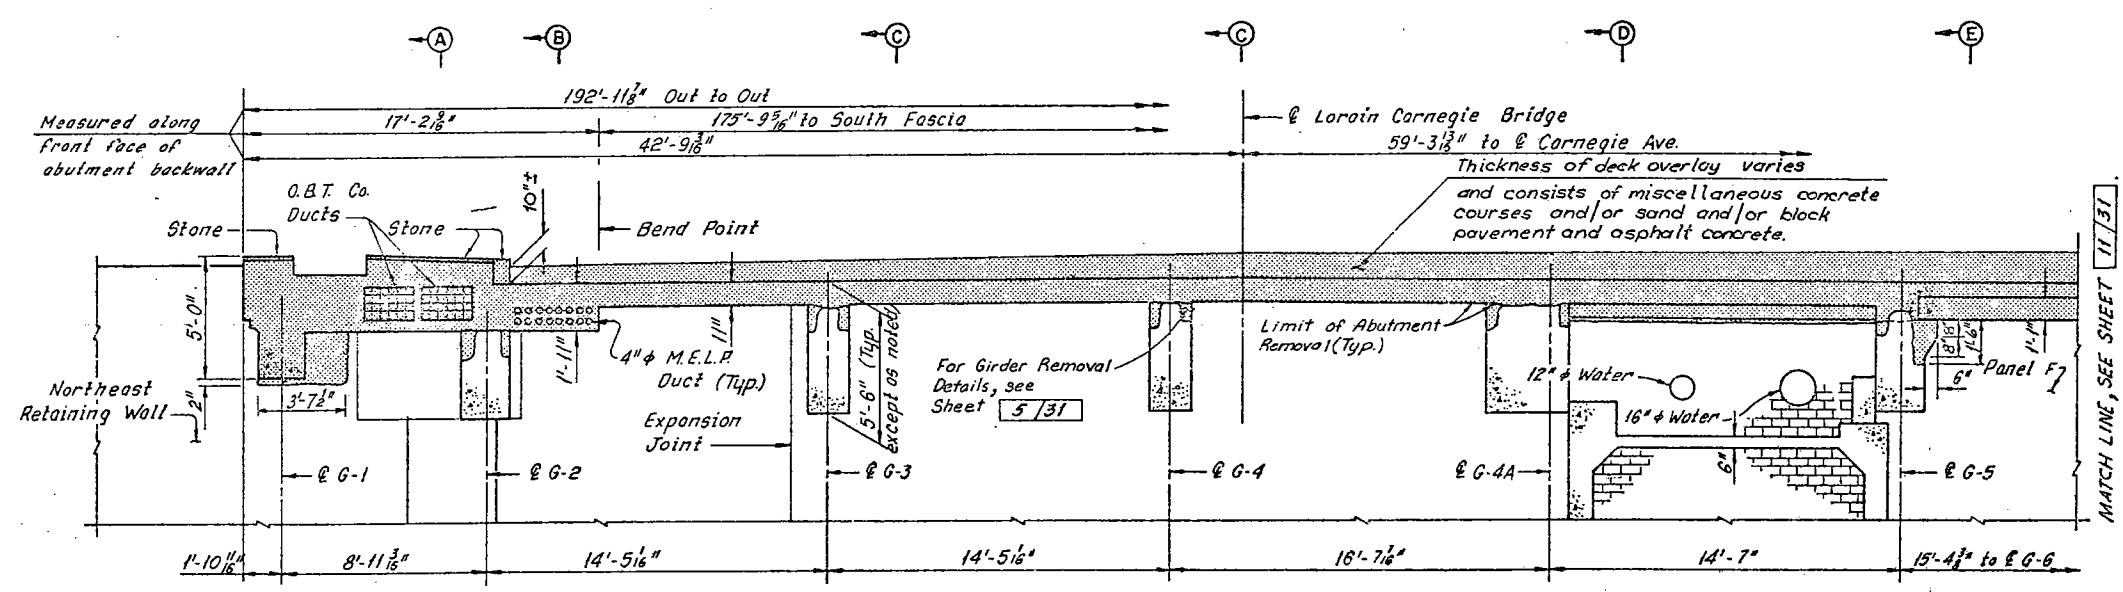

PART ELEVATION - EAST ABUTMENT

Note:
All existing vertical abutment reinforcement and all existing horizontal abutment reinforcement below the bottom of the new deck slab shall be retained as part of the new construction, except at new slab edge beams shown on Sheet 16/31. Horizontal reinforcement may be replaced in kind at no additional cost to the State.

Notes:
Zip-a-tone indicates portions of the structure to be removed.
For Sections A-A thru E-E, see Sheet 12/31.
For modified East Abutment details, see Sheets 16/31 thru 18/31.
The following abbreviations are used:
Typ. = Typical
M.E.L.P. = Municipal Electric Light and Power
O.B.T. = Ohio Bell Telephone Company
C.E.I. = Cleveland Electric Illuminating Company

HNTB BRIDGE NO. 4

HOWARD, NEEDLES, TAMMEN & BERGENDOFF
CONSULTING ENGINEERS
CLEVELAND

HNTB

**REMOVAL PLANS
EAST ABUTMENT**

REHABILITATION OF THE
CARNegie AVENUE GRADE SEPARATION STRUCTURE
(S.R.10 OVER THE CLEVELAND UNION TERMINALS CO.
AND THE REGIONAL TRANSIT AUTHORITY)

BR NO. CUY.-10-1685 STA. 57+29.72
CUYAHOGA COUNTY OHIO STA. 58+85.70


DRAWN B.S.	TRACED B.S.	CHECKED F.B.	REVIEWED	REVISED
DATE 3-17-35	DATE 6-22-35	DATE 7-7-35	DATE	DATE

SHEET 10/31


FHWA REGION	STATE	PROJECT
5	OHIO	

158
185

CUYAHOGA COUNTY
CUY-10-16.23

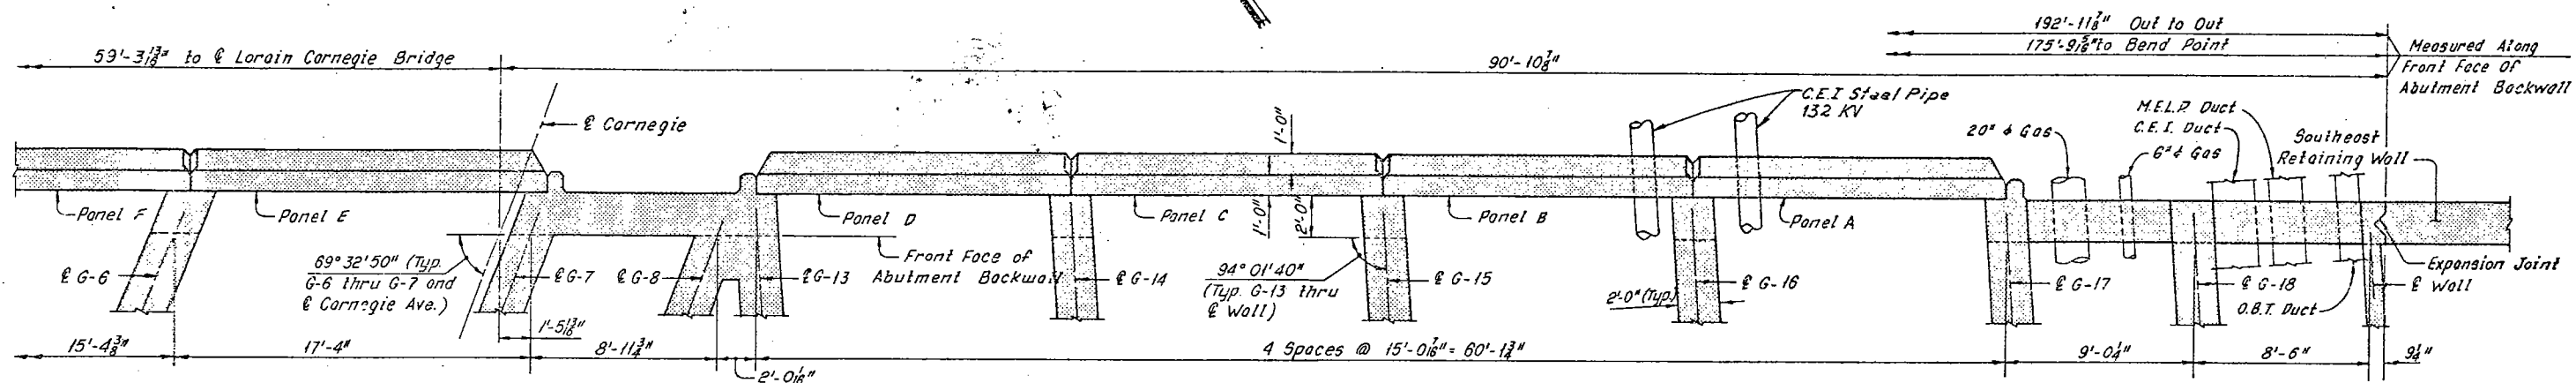

PART PLAN - EAST ABUTMENT
(Slab not shown)

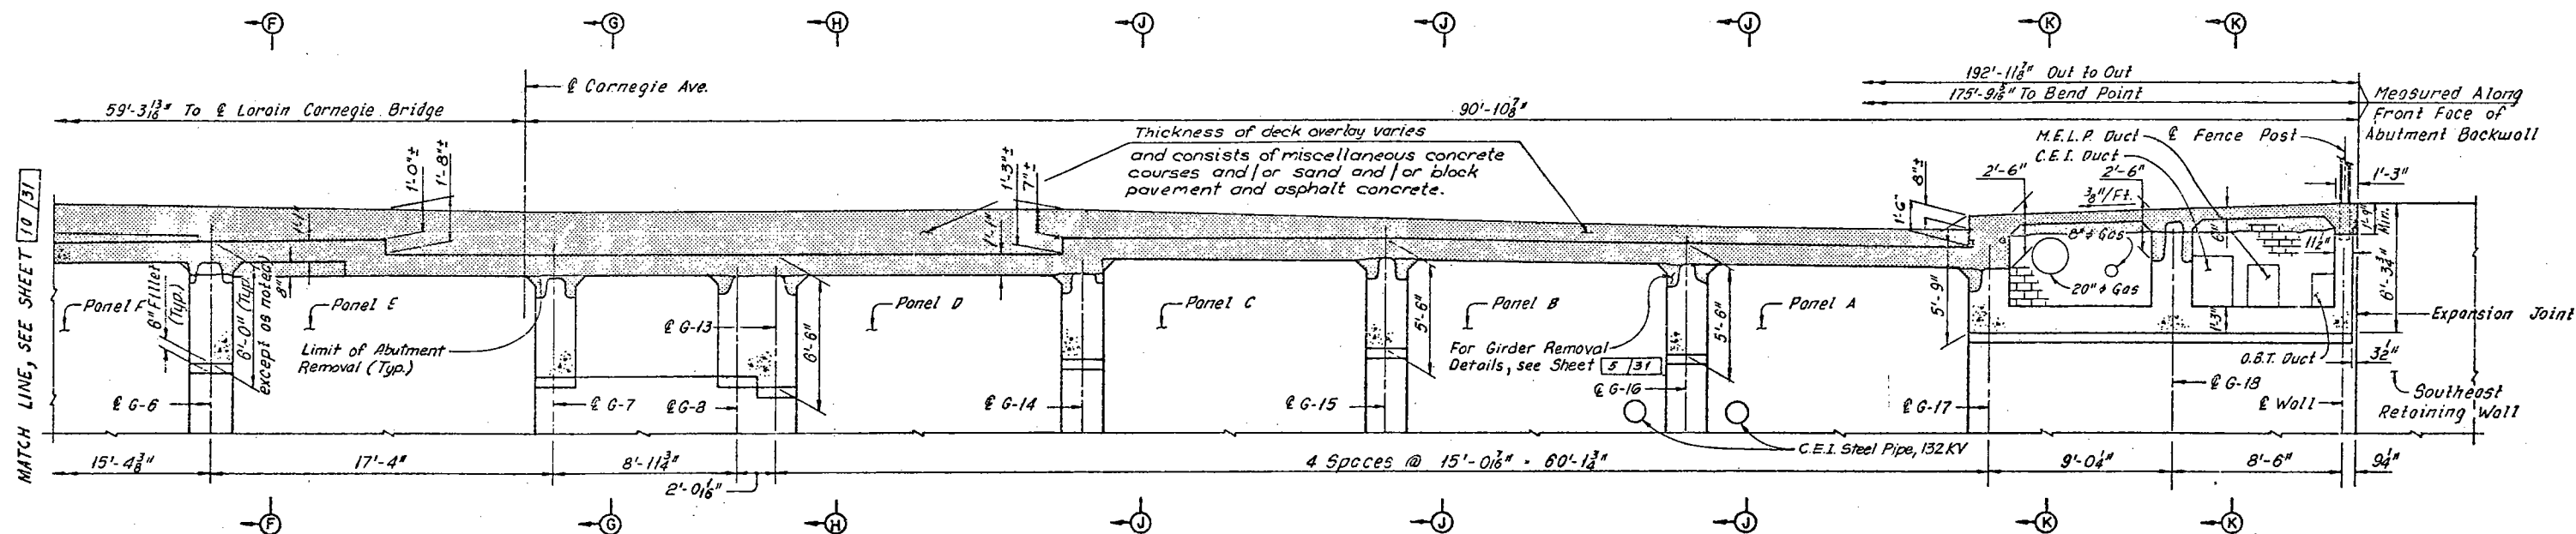

PART ELEVATION - EAST ABUTMENT

Note:
All existing vertical abutment reinforcement and all existing horizontal abutment reinforcement below the bottom of the new deck slab shall be retained as part of the new construction, except at new slab edge beams shown on Sheet 16/31. Horizontal reinforcement may be replaced in kind at no additional cost to the State.

Notes:
Zip-a-tone indicates portions of the structure to be removed.
For Sections F-F thru K-K, see Sheet 12/31.
For modified East Abutment details, see Sheets 16/31 thru 18/31.
The following abbreviations are used:
Typ. = Typical
M.E.L.P. = Municipal Electric Light and Power
O.B.T. = Ohio Bell Telephone Company
C.E.I. = Cleveland Electric Illuminating Company
For stage construction, see Sheet 1/31.

HNTB BRIDGE NO. 4

HOWARD, NEEDLES, TAMMEN & BERGENDOFF
CONSULTING ENGINEERS
CLEVELAND

HNTB

**REMOVAL PLANS
EAST ABUTMENT**
REHABILITATION OF THE
CARNEGIE AVENUE GRADE SEPARATION STRUCTURE
(S.R.10 OVER THE CLEVELAND UNION TERMINALS CO.
AND THE REGIONAL TRANSIT AUTHORITY)
BR. NO. CUY-10-1685 STA. 57+29.72
CUYAHOGA COUNTY STA. 58+85.70
OHIO


DRAWN	TRACED	CHECKED	REVIEWED	REVISED
B.P.	B.P.	F.B.		
DATE: 11-75	DATE: 10-75	DATE: 7-78	DATE:	

SHEET 11/31


FHWA REGION	STATE	PROJECT
5	OHIO	

159
185


CUYAHOGA COUNTY
CUY-10-16.23

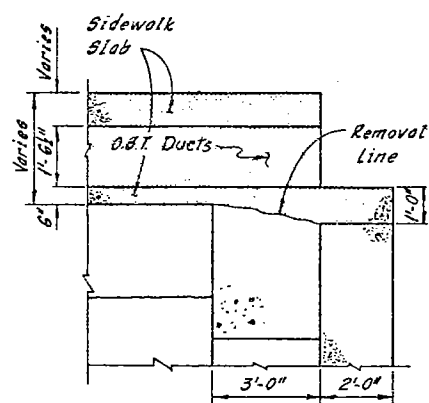


SECTION A-A

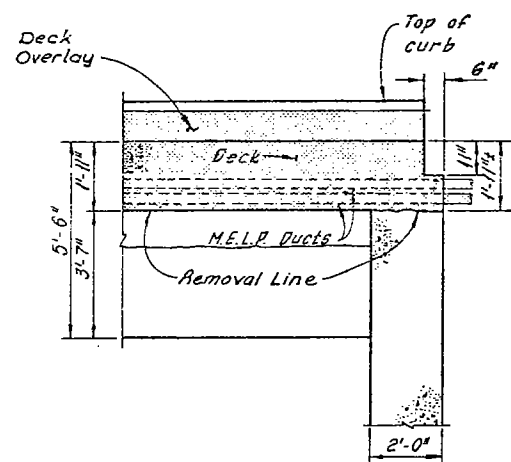


SECTION B-B

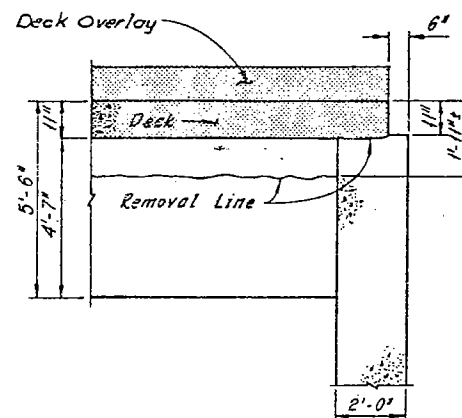


SECTION C-C

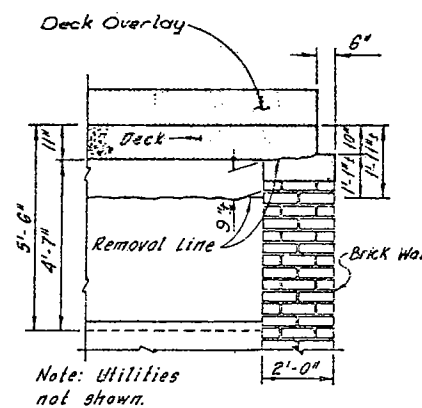


SECTION D-D

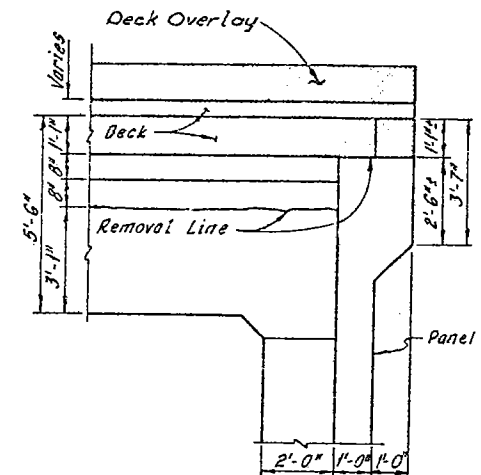


SECTION E-E

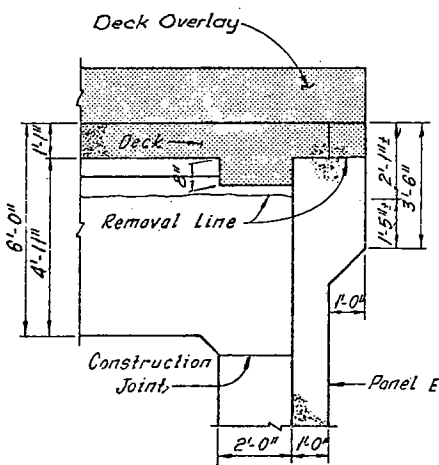


SECTION F-F

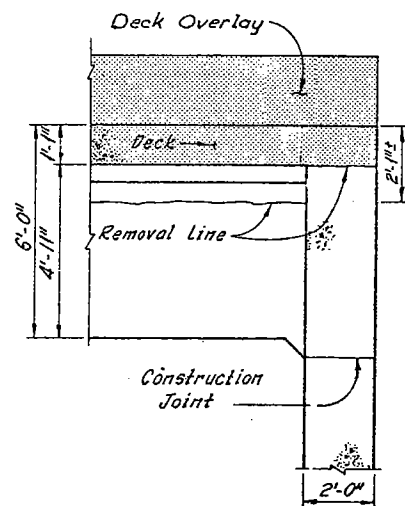


SECTION G-G

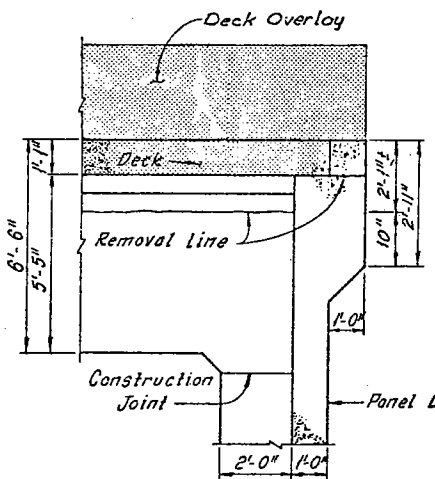

SECTION H-H

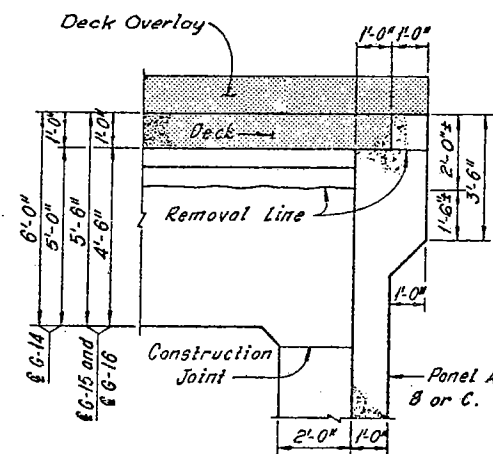

SECTION J-J

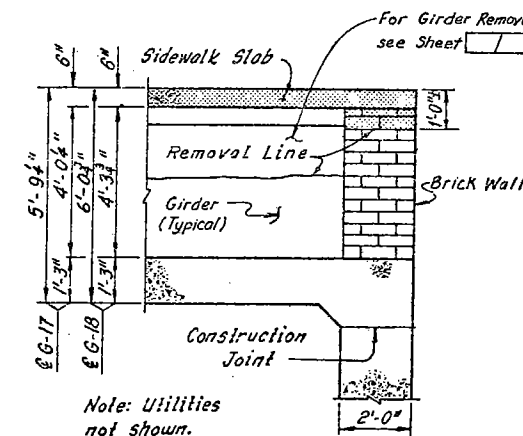

SECTION K-K

Note:
Existing reinforcement not shown. All existing vertical abutment reinforcement and all existing horizontal abutment reinforcement below the bottom of the new deck slab shall be retained as part of the new construction, except at new slab edge beams shown on Sheet 16/31. Horizontal reinforcement may be replaced in kind at no additional cost to the State.

Notes:
Zip-a-tone indicates portions of structure to be removed.
For limits of existing girder removal, see Detail A, Sheet 5/31.
For location of Sections A-A thru E-E, see Sheet 10/31.
For location of Sections F-F thru K-K, see Sheet 11/31.

HNTB BRIDGE NO. 4

HOWARD, NEEDLES, TAMMEN & BERGENDOFF
CONSULTING ENGINEERS
CLEVELAND

HNTB

REMOVAL PLANS
EAST ABUTMENT
REHABILITATION OF THE
CARNEGIE AVENUE GRADE SEPARATION STRUCTURE
(S.R.10 OVER THE CLEVELAND UNION TERMINALS CO.
AND THE REGIONAL TRANSIT AUTHORITY)
BR. NO. CUY.-10-1685 STA. 57+29.72
STA. 58+85.70
OHIO
CUYAHOGA COUNTY


DRAWN SP	TRACED FP	CHECKED FP	REVIEWED FP	REVISED
DATE: 11-75	DATE: 10-25	DATE: 2-75	DATE:	

SHEET 12/31


FHWA REGION	STATE	PROJECT
5	OHIO	

160
185

CUYAHOGA COUNTY
CUY-10-16.23

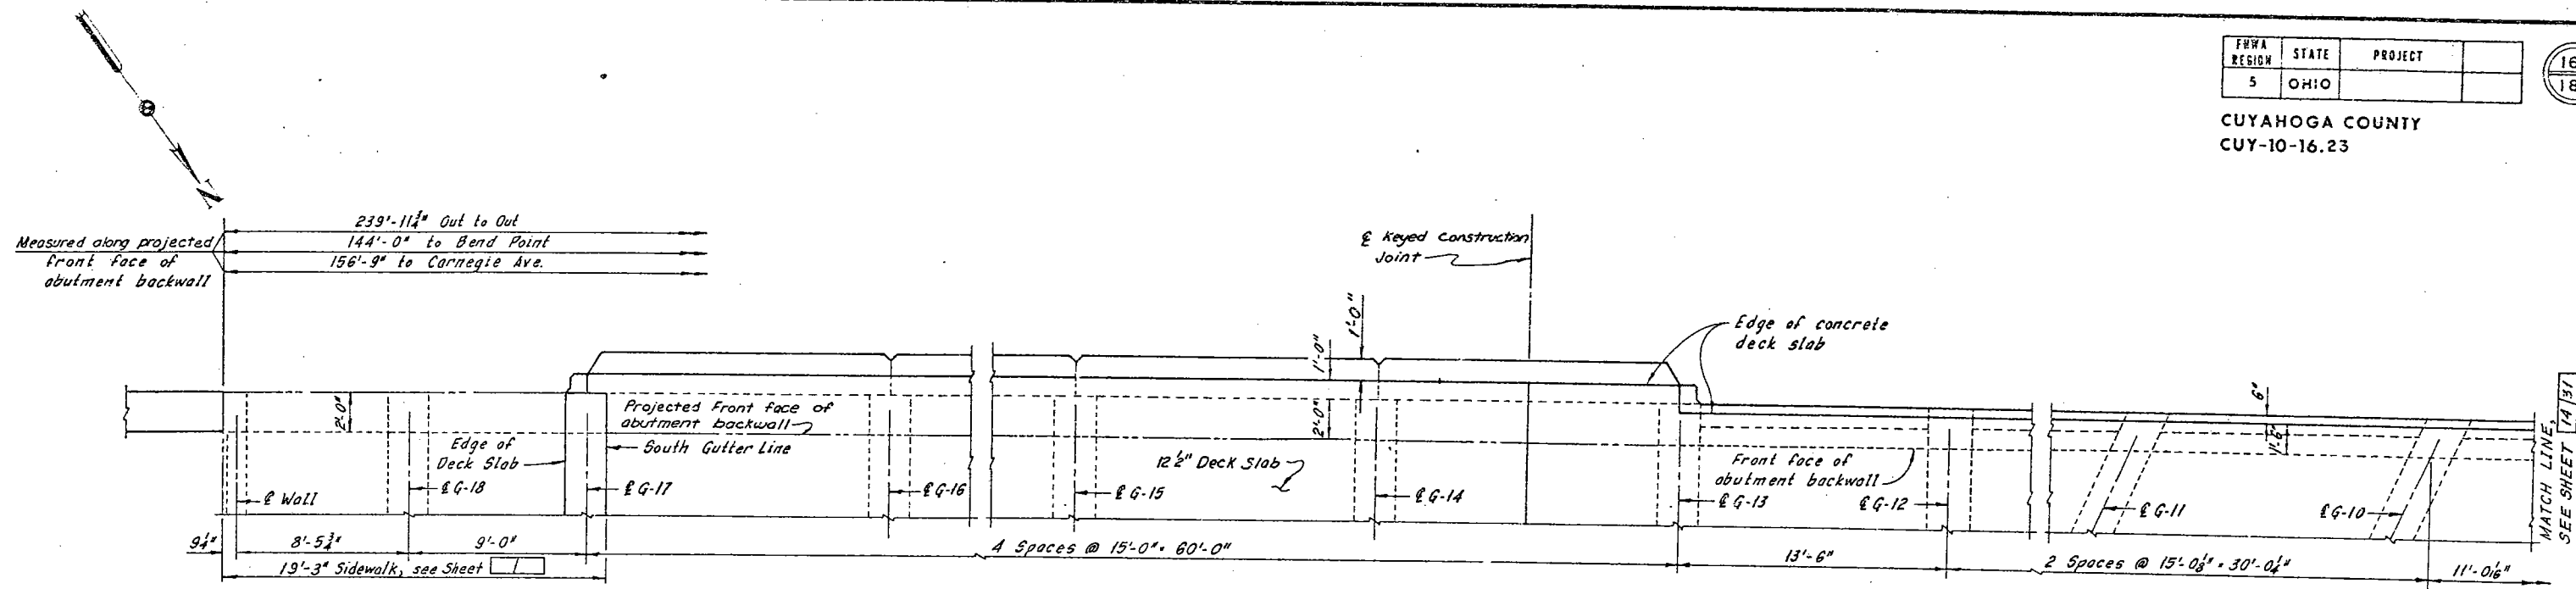

PART PLAN - WEST ABUTMENT

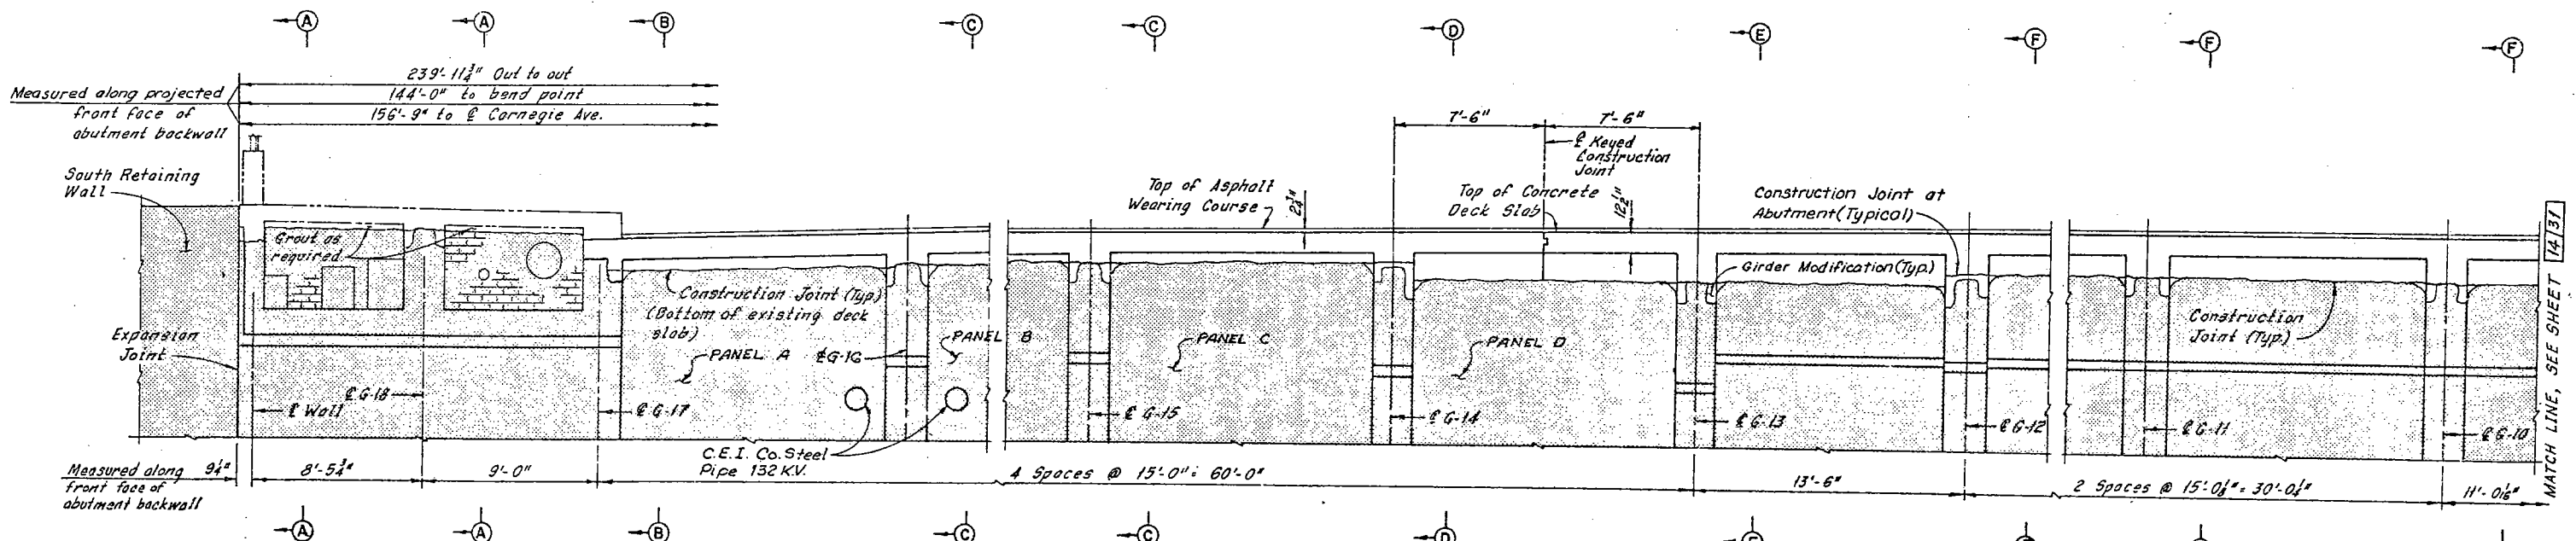

PART ELEVATION - WEST ABUTMENT

(Deck slab, girder and retained abutment reinforcement not shown)

Notes:

- Zip-a-tone indicates existing structure.
- For removal of West Abutment, see Sheets 7/31 thru 9/31.
- For Typical Girder Modification Repair, see Sheet 23/31.
- For Sections A-A thru F-F, see Sheet 15/31.
- For Sidewalk Details, see Sheet 27/31.
- For Stage Construction, see Sheet 1/31.
- For Contour Plan, see Sheet 30/31.


HNTB BRIDGE NO. 4

HOWARD, NEEDLES, TAMMEN & BERGENDOFF CONSULTING ENGINEERS CLEVELAND		HNTB	
PART MODIFIED PLAN AND ELEVATION WEST ABUTMENT			
REHABILITATION OF THE CARNEGIE AVENUE GRADE SEPARATION STRUCTURE (S.R.10 OVER THE CLEVELAND UNION TERMINALS CO. AND THE REGIONAL TRANSIT AUTHORITY)			
BR. NO. CUY-10-1685		STA. 57+29.72 STA. 58+85.70	
CUYAHOGA COUNTY		OHIO	
DRAWN AJT	TRACED SWB	CHECKED RWS	REVIEWED DATE
DATE 12-2-72	DATE 12-2-72	DATE 2-27-73	DATE
			SHEET 13/31


FHWA REGION	STATE	PROJECT
5	OHIO	

161
185

CUYAHOGA COUNTY
CUY-10-16.23

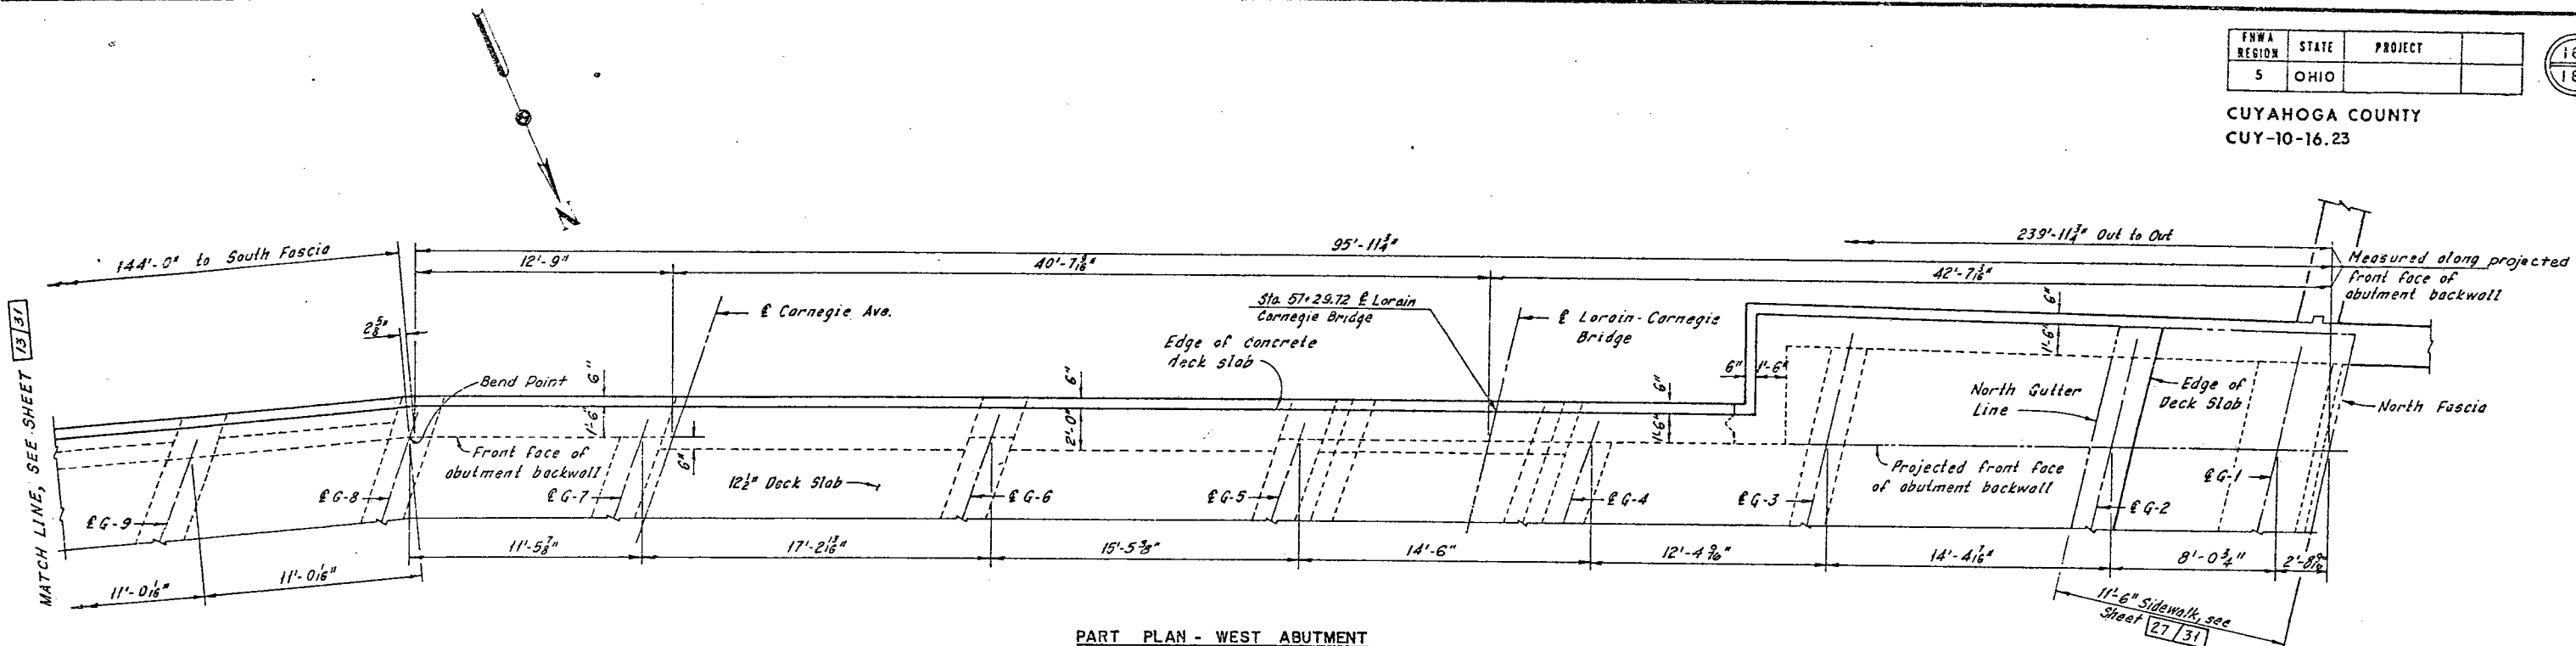

PART PLAN - WEST ABUTMENT

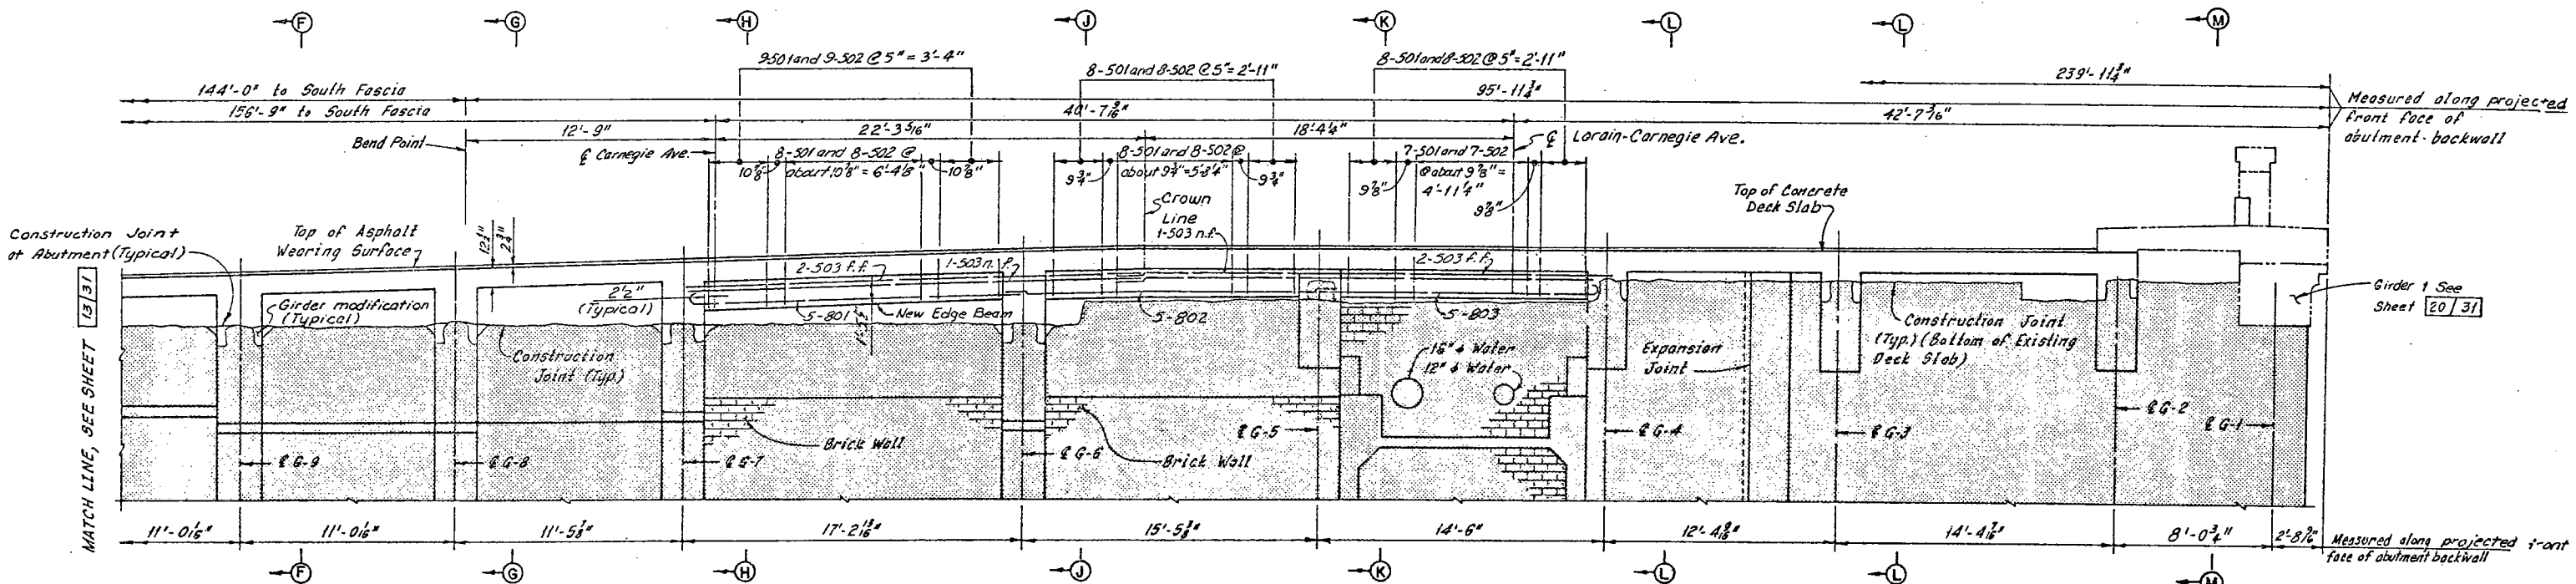

PART ELEVATION - WEST ABUTMENT
(Deck slab, girder and retained abutment reinforcement not shown)

Note:
All reinforcing bar marks shall be prefixed MA.

- Notes:
- Zip-a-tone indicates existing structure.
 - Phantom lines indicate new construction details of which are shown elsewhere in these plans.
 - For Sections F-F thru M-M, see Sheet 15/31.
 - For Reinforcement Schedule, see Sheet R/4.
 - For Stage Construction, see Sheet 7/31.
 - For Contour Plan, see Sheet 30/31.
 - For additional notes, see Sheet 13/31.

HNTB BRIDGE NO. 4

HOWARD, NEEDLES, TAMMEN & BERGENDOFF
CONSULTING ENGINEERS
CLEVELAND

HNTB

PART MODIFIED PLAN AND ELEVATION
WEST ABUTMENT

REHABILITATION OF THE
CARNEGIE AVENUE GRADE SEPARATION STRUCTURE
(S.R.10 OVER THE CLEVELAND UNION TERMINALS CO.
AND THE REGIONAL TRANSIT AUTHORITY)

BR. NO. CUY.-10-1685 STA. 57+29.72
CUYAHOGA COUNTY STA. 58+85.70
OHIO


DRAWN	TRACED	CHECKED	REVIEWED	REVISED
DATE 2-24-78	DATE 3-7-78	DATE 3-22-78	DATE	DATE

SHEET 14/31


FHWA REGION	STATE	PROJECT
5	OHIO	

162
185


CUYAHOGA COUNTY
CUY-10-16.23

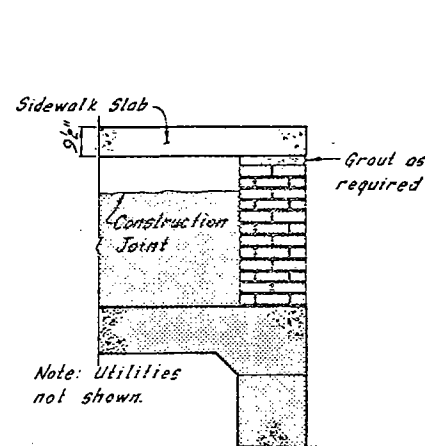


SECTION A-A

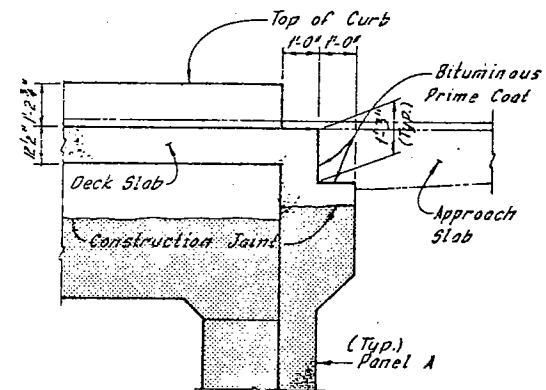


SECTION B-B

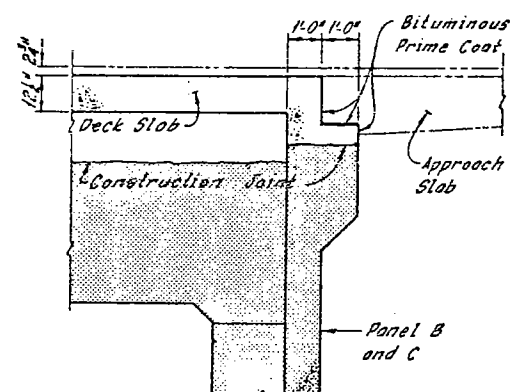


SECTION C-C

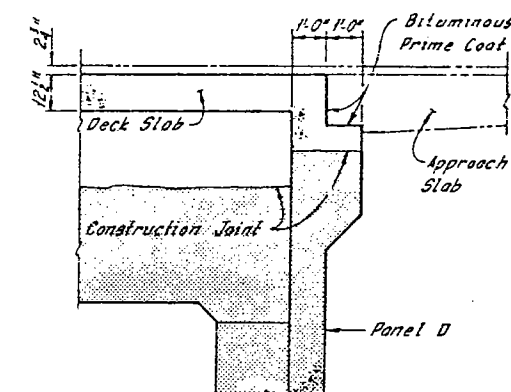


SECTION D-D

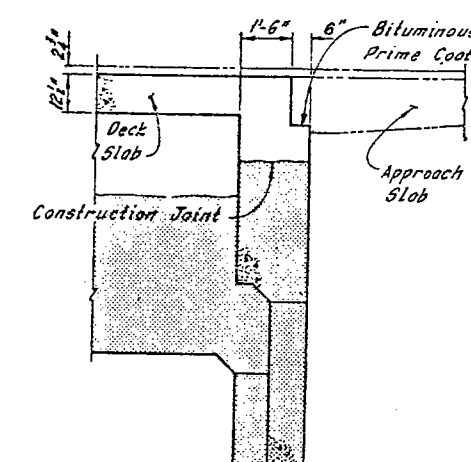


SECTION E-E

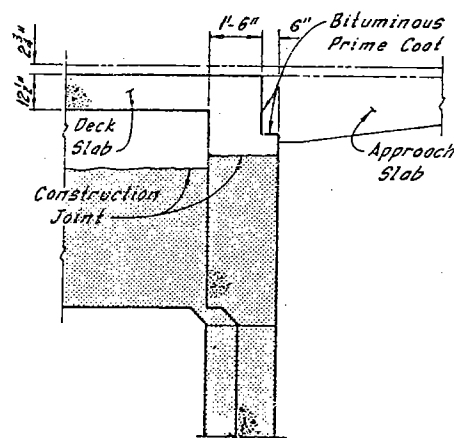


SECTION F-F

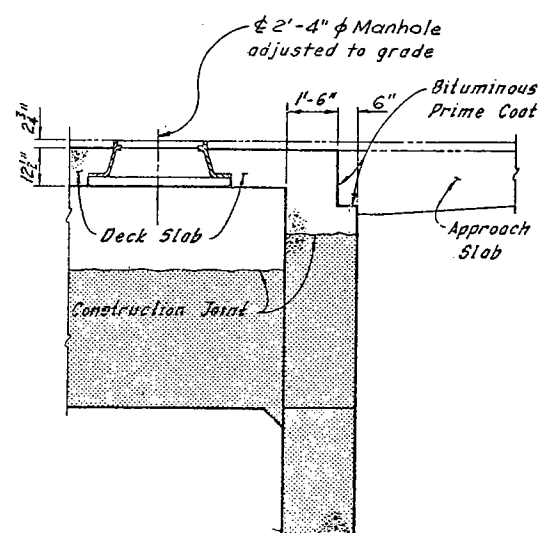


SECTION G-G

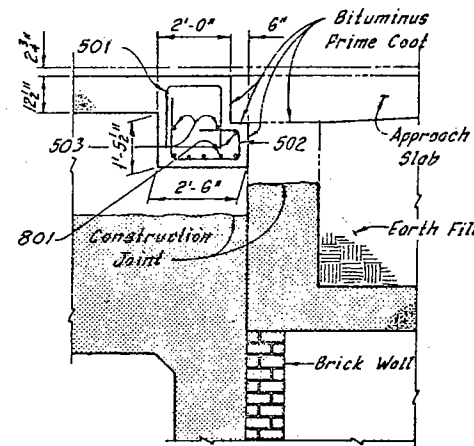


SECTION H-H

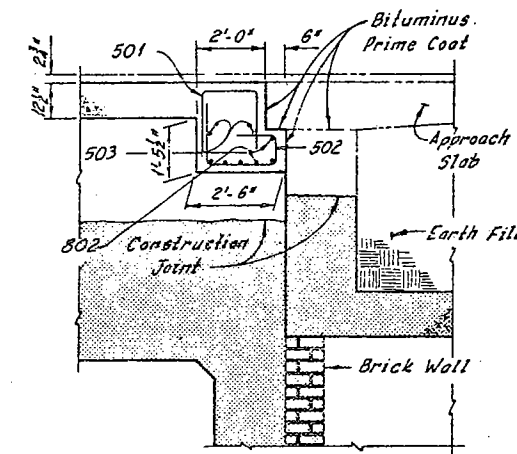


SECTION J-J

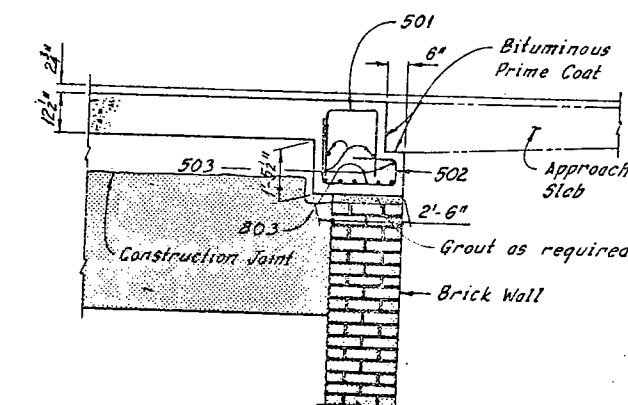

SECTION K-K

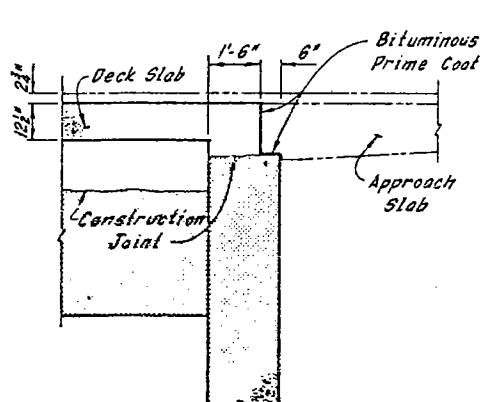

SECTION L-L

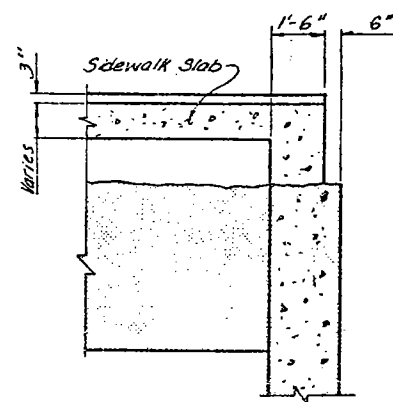

SECTION M-M

Note:
All reinforcing bar marks shall be prefixed WA.

Notes:
Zip-tone indicates existing structure.
Sidewalk, deck, girder and retained existing abutment reinforcement is not shown.
For location of Sections A-A thru F-F, see Sheet 13/31.
For location of Sections G-G thru M-M, see Sheet 14/31.
For manhole locations, see Sheet 26/31.
The cost of grouting shall be included with the unit price bid for Item 511, Class C Concrete, Abutments Above Footings, for payment.
For Reinforcement Schedule, see Sheet R/R.

HNTB BRIDGE NO. 4

HOWARD, NEEDLES, TAMMEN & BERGENDOFF
CONSULTING ENGINEERS
CLEVELAND

HNTB

MODIFIED TYPICAL CROSS SECTIONS
WEST ABUTMENT

REHABILITATION OF THE
CARNEGIE AVENUE GRADE SEPARATION STRUCTURE
(S.R.10 OVER THE CLEVELAND UNION TERMINALS CO.
AND THE REGIONAL TRANSIT AUTHORITY)

BR. NO. CUY. -10-1685 STA. 57+29.72
STA. 58+85.70

CUYAHOGA COUNTY OHIO


DRAWN	TRACED	CHECKED	REVIEWED	REVISED
WJT	CWB	RAS		
DATE 8-24-83	DATE 8-27-83	DATE 2-7-84	DATE	DATE

SHEET 15/31


FHWA REGION	STATE	PROJECT
5	OHIO	

163
185

CUYAHOGA COUNTY
CUY-10-16.23

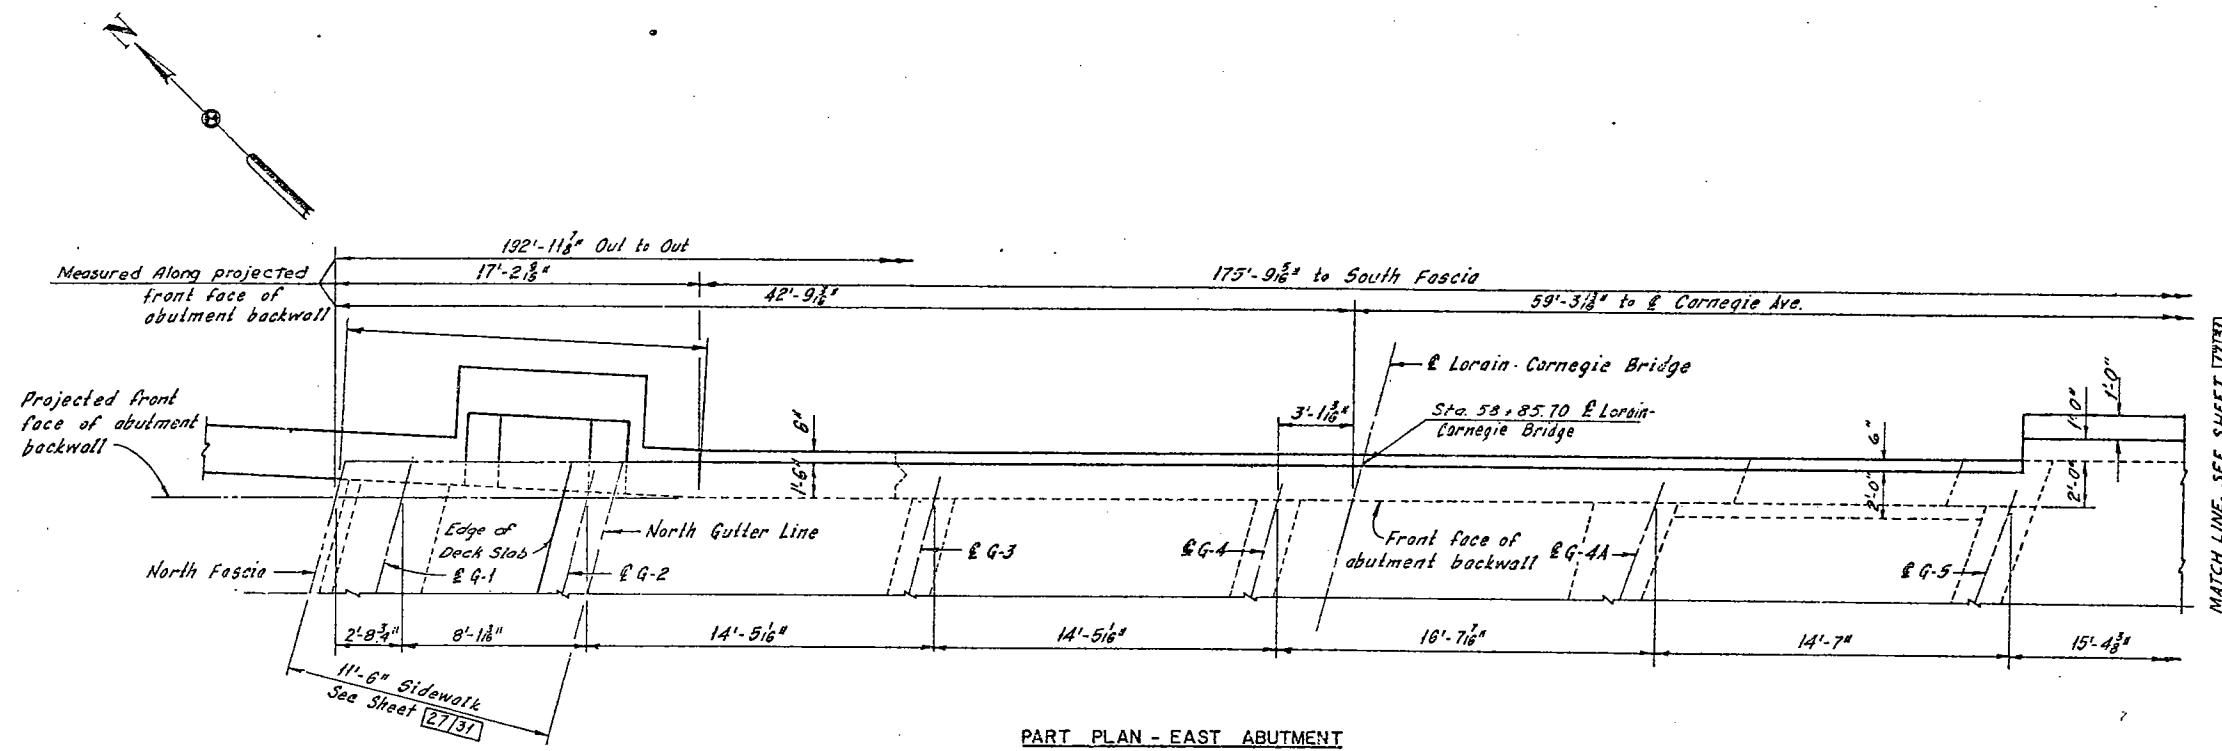

Note:
All reinforcing bar marks shall be prefixed EA.

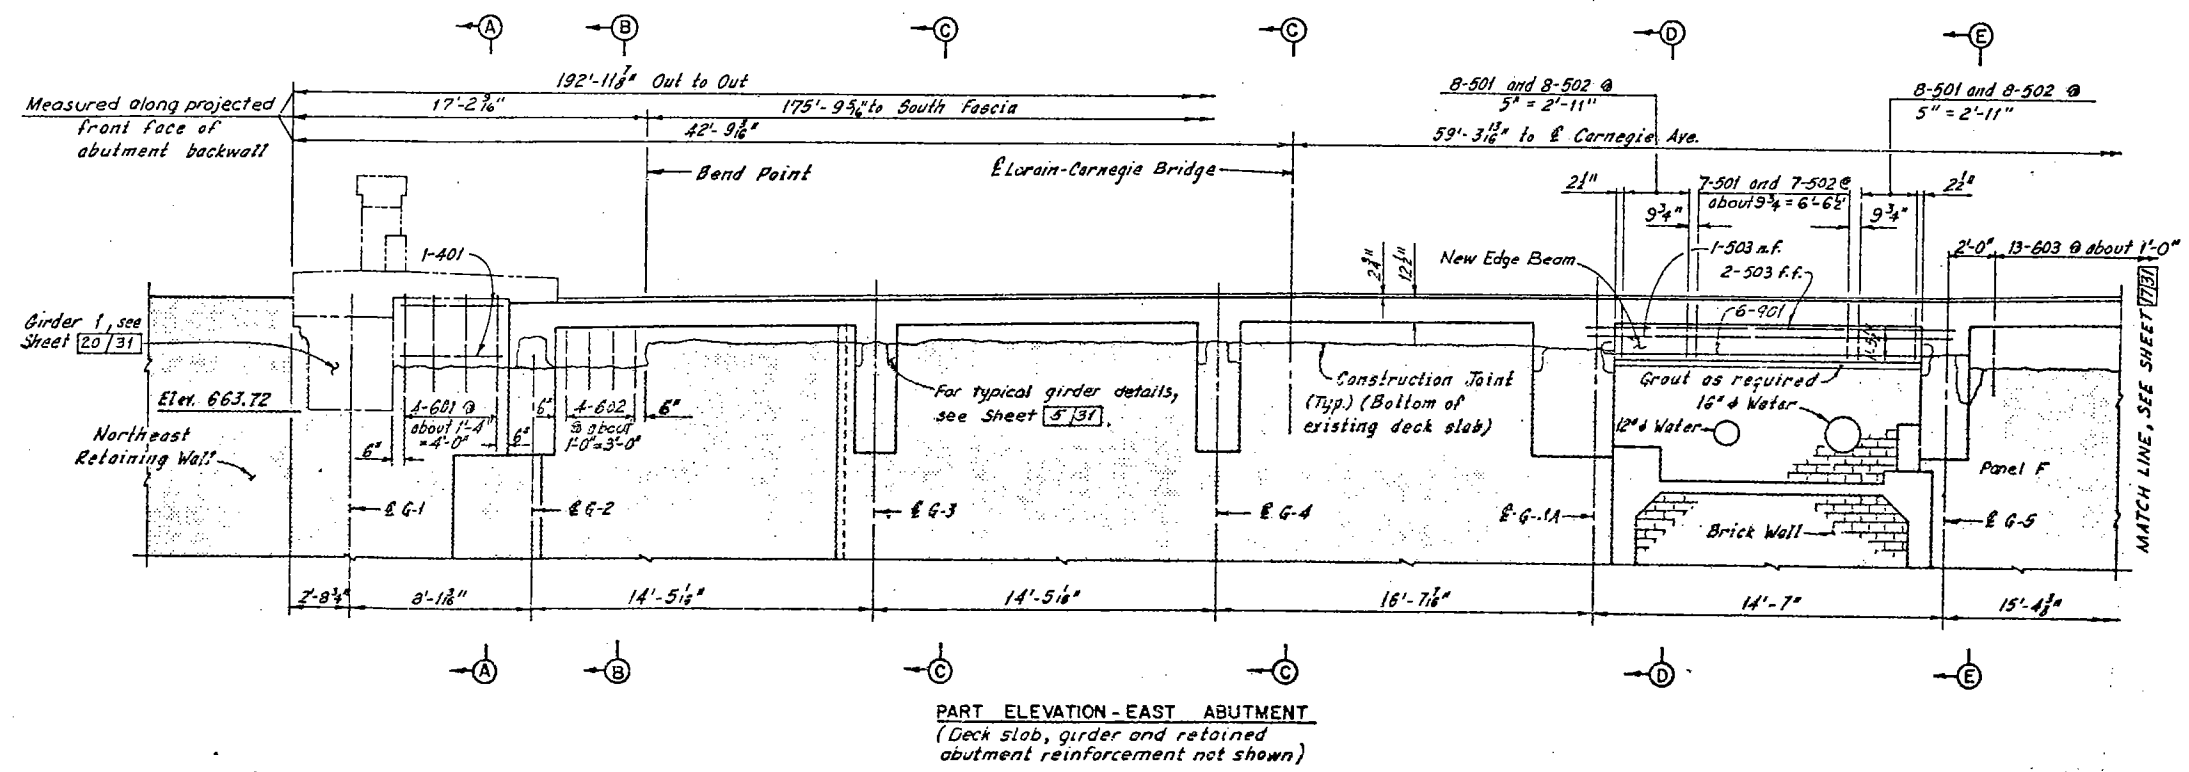

Notes:
Zip-a-tone indicates existing structure.
Phantom lines indicate new construction details of which are shown elsewhere on these plans.
For Removal of East Abutment, see Sheets 10/31 thru 12/31.
For Typical Girder Repair, see Sheet 23/31.
For Approach Slab Details, see roadway plans.
For Sections A-A thru E-E, see Sheet 18/31.
For Contour Plan, see Sheet 30/31.
For reinforcement schedule see Sheet R/4.

HNTB BRIDGE NO. 4

HOWARD, NEEDLES, TAMMEN & BERGENDOFF
CONSULTING ENGINEERS
CLEVELAND

HNTB

PART MODIFIED PLAN AND ELEVATION
EAST ABUTMENT
REHABILITATION OF THE
CARNEGIE AVENUE GRADE SEPARATION STRUCTURE
(S.R.10 OVER THE CLEVELAND UNION TERMINALS CO.
AND THE REGIONAL TRANSIT AUTHORITY).
BR. NO. CUY-10-1685 STA. 57+29.72
CUYAHOGA COUNTY STA. 58+85.70
OHIO

DRAWN AJT	TRACED DES	CHECKED RAS	REVIEWED	REVISED
DATE: 10-14-78	DATE: 10-15-78	DATE: 9-22-78	DATE	DATE


SHEET 16/31

FHWA REGION	STATE	PROJECT
5	OHIO	

184
185


CUYAHOGA COUNTY
CUY-10-16.23

MATCH LINE, SEE SHEET 183

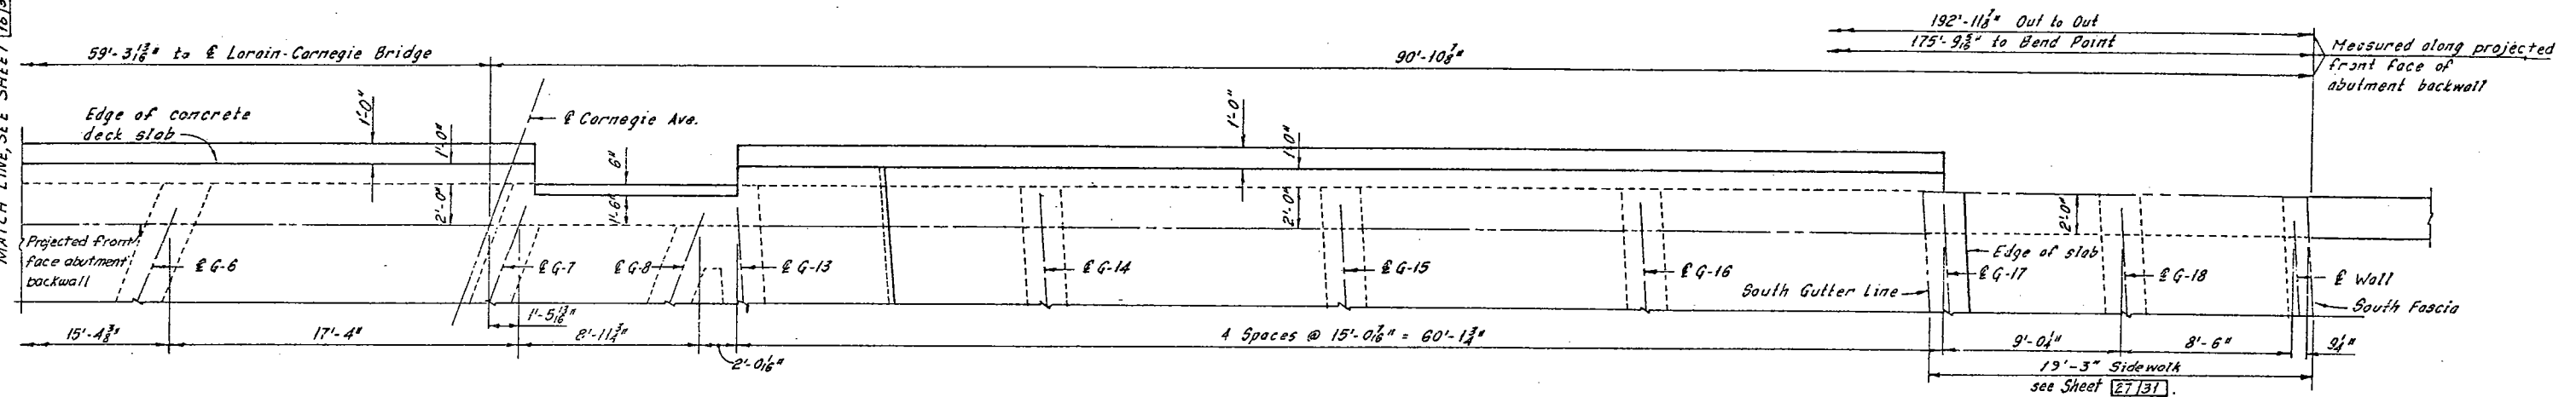

PART PLAN - EAST ABUTMENT

MATCH LINE, SEE SHEET 183

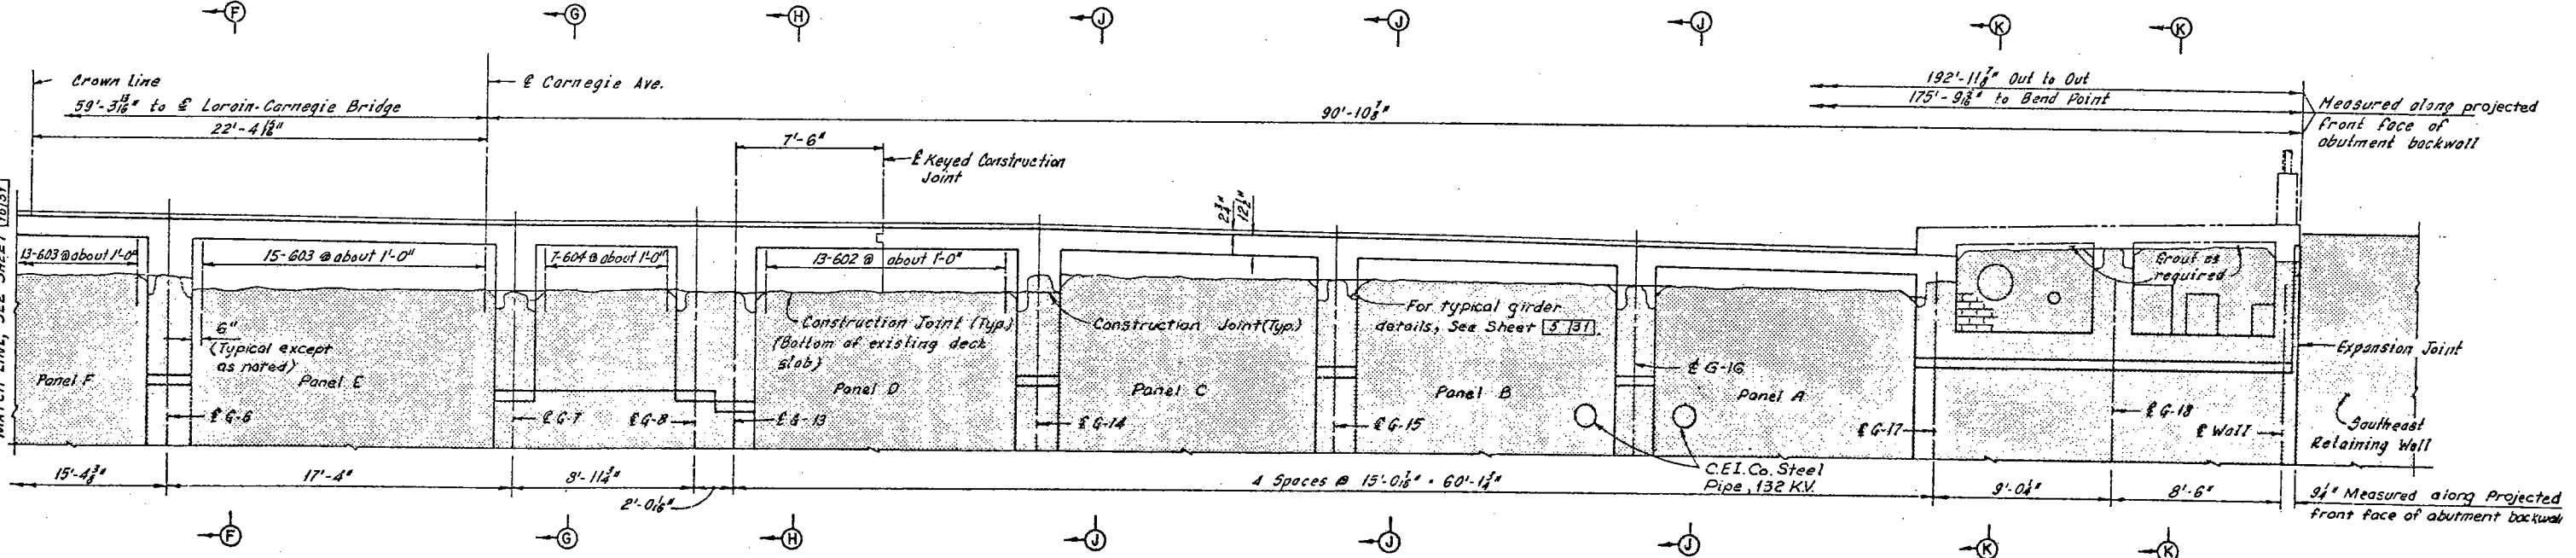

PART ELEVATION - EAST ABUTMENT
(Deck slab, girder, and retained abutment reinforcement not shown)

Note:
All reinforcing bar marks
shall be prefixed EA.

- Notes:
- Zip-o-tone indicates existing structures.
 - For Removal of East Abutment, see Sheets 10/31 thru 12/31.
 - For Typical Girder Repair, see Sheet 23/31.
 - For Approach Slab Details, see roadway plans.
 - For Sections F-F thru K-K, see Sheet 18/31.
 - For Contour Plan, see Sheet 30/31.
 - For reinforcement schedule, see Sheet R/4.

HNTB BRIDGE NO. 4

HOWARD, NEEDLES, TAMMEN & BERGENDOFF
CONSULTING ENGINEERS
CLEVELAND

HNTB

PART MODIFIED PLAN AND ELEVATION
EAST ABUTMENT
REHABILITATION OF THE
CARNEGIE AVENUE GRADE SEPARATION STRUCTURE
(S.R.10 OVER THE CLEVELAND UNION TERMINALS CO.
AND THE REGIONAL TRANSIT AUTHORITY)
BR. NO. CUY-10-1625 STA. 57+29.72
CUYAHOGA COUNTY STA. 58+85.70
OHIO


DESIGNED AJT	DRAWN BES	CHECKED RAJ	REVIEWED	REVISED
DATE 10/78	DATE 11/78	DATE 12/78	DATE	DATE

SHEET 17/31


FHWA REGION	STATE	PROJECT
5	OHIO	

165
185


CUYAHOGA COUNTY
CUY-10-16.23

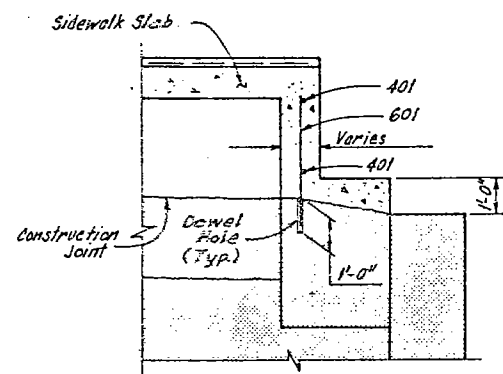


SECTION A-A

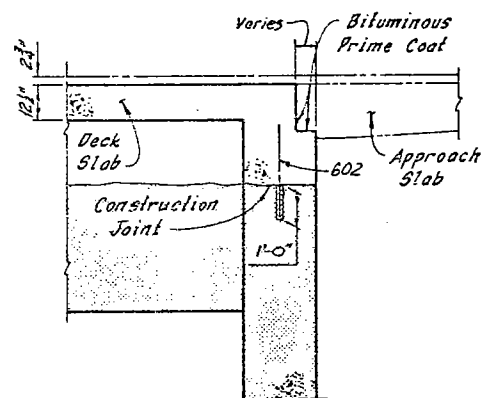

SECTION B-B

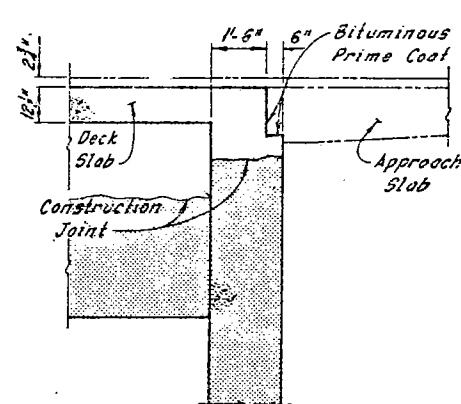


SECTION C-C

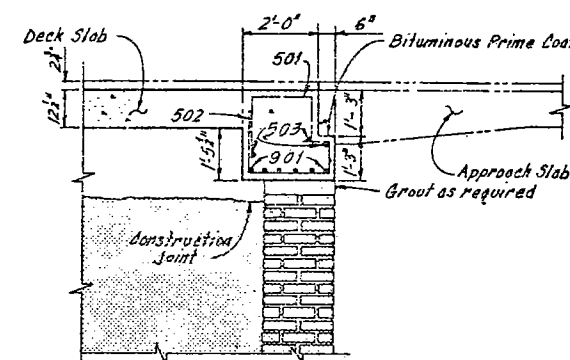


Note: Utilities not shown.


SECTION D-D

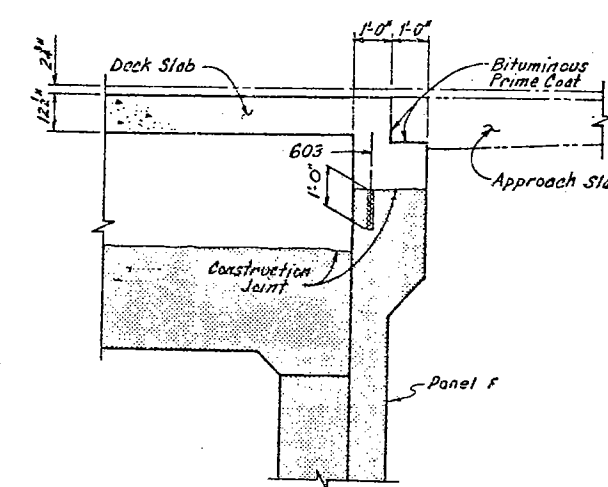


SECTION E-E

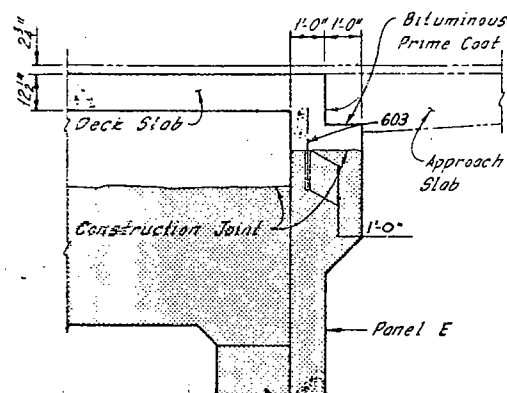


SECTION F-F

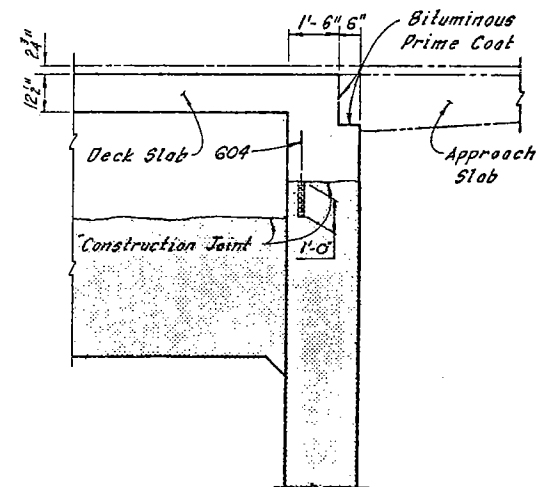


SECTION G-G

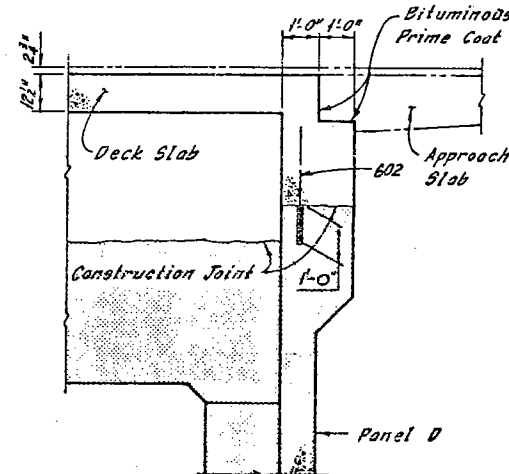

SECTION H-H

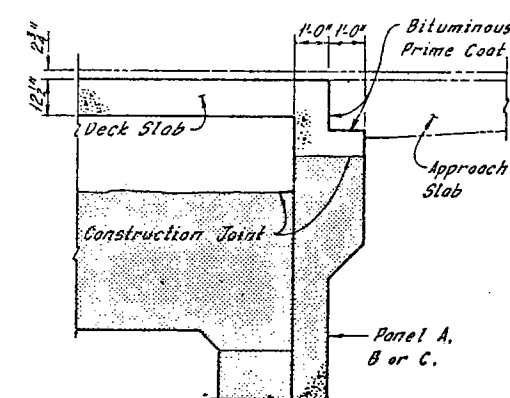

SECTION J-J

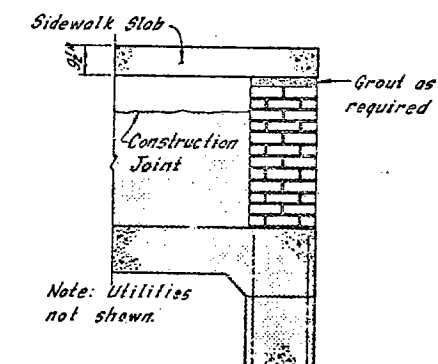

SECTION K-K

Note:
All reinforcing bar marks shall be prefixed EA.

Notes:
Zip-tone indicates existing structures.
Sidewalk, deck, existing girder and retained abutment reinforcement is not shown.
The cost of grouting shall be included with the unit price bid for Item 511, Class C Concrete, Abutments Above Footings, for payment.
For reinforcement schedule see Sheet R/4.

HNTB BRIDGE NO. 4

HOWARD, NEEDLES, TAMMEN & BERGENDOFF
CONSULTING ENGINEERS
CLEVELAND

HNTB







MODIFIED TYPICAL CROSS SECTIONS
EAST ABUTMENT
REHABILITATION OF THE
CARNegie AVENUE GRADE SEPARATION STRUCTURE
(S.R. 10 OVER THE CLEVELAND UNION TERMINALS CO.
AND THE REGIONAL TRANSIT AUTHORITY)
BR. NO. CUY-10-1685 STA. 57+29.72
CUYAHOGA COUNTY STA. 58+85.70 OHIO

DRAWN A/T	TRACED DES	CHECKED R.P.S	REVIEWED DATE	REVISED
DATE: 11-78	DATE: 11-78	DATE: 11-78	DATE	SHEET 15/31

FHWA REGION	STATE	PROJECT	
5	OHIO		

166
185

CUYAHOGA COUNTY
CUY-10-16.23

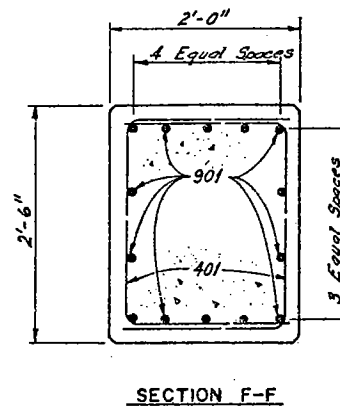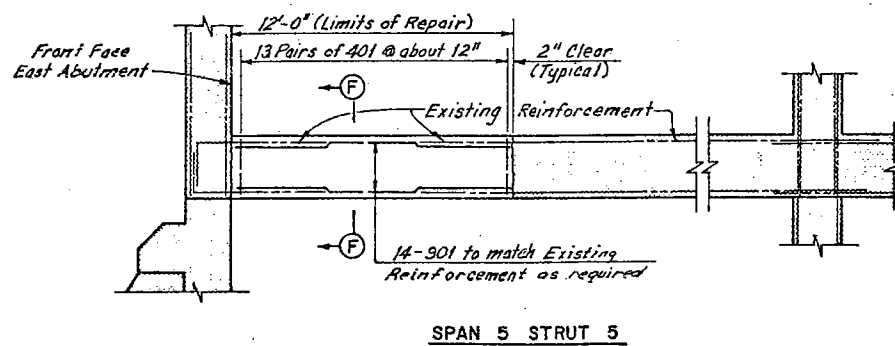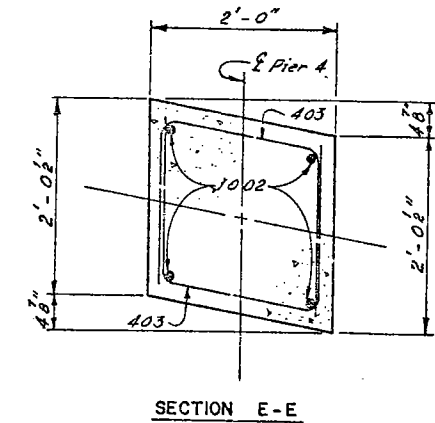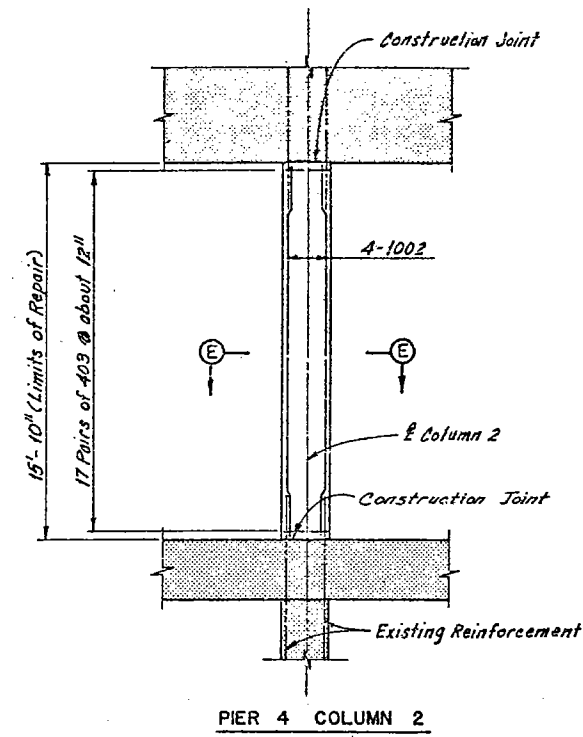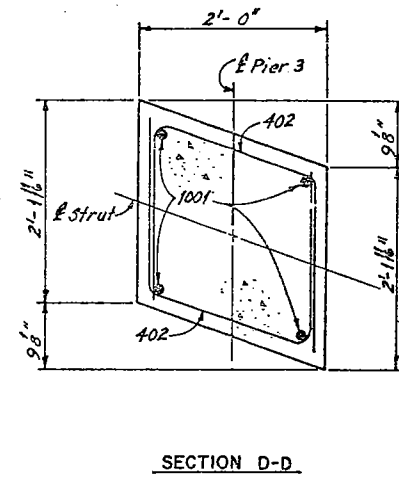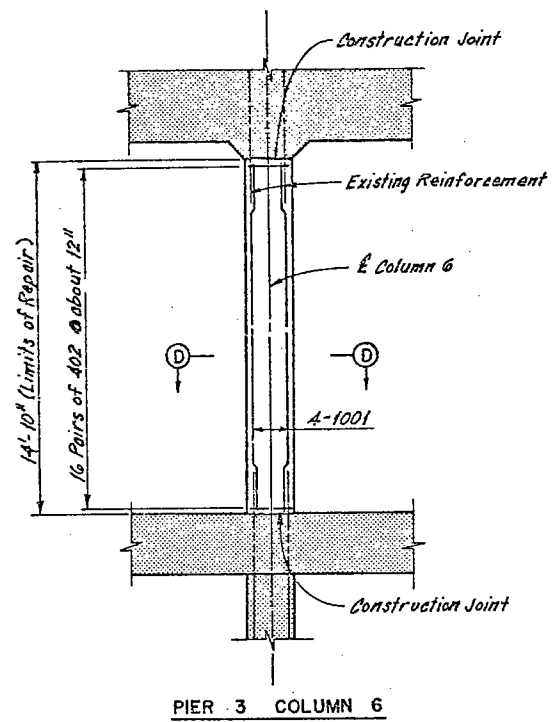

Notes:
 Zip-a-tone indicates existing structure.
 For strut and column removal details, see Sheet 6/31.
 For reinforcement schedule, see Sheet R/S.

Note: All reinforcing bar marks shall be prefixed SC.

HNTB BRIDGE NO. 4

HOWARD, NEEDLES, TAMMEN & BERGENDOFF
CONSULTING ENGINEERS
CLEVELAND


HNTB

STRUT AND COLUMN REPAIR DETAILS
 REHABILITATION OF THE
 CARNEGIE AVENUE GRADE SEPARATION STRUCTURE
 (S.R. 10 OVER THE CLEVELAND UNION TERMINALS CO.
 AND THE REGIONAL TRANSIT AUTHORITY)
 BR. NO. CUY-10-1685 STA. 57+29.72
 STA. 58+85.70
 CUYAHOGA COUNTY OHIO

DRAWN AUT	TRACED DES	CHECKED RAS	REVIEWED	REVISED
DATE 8-1-75	DATE 8-3-75	DATE 9-6-75	DATE	DATE

SHEET 19/31

CUYAHOGA COUNTY
CUY-10-16.23



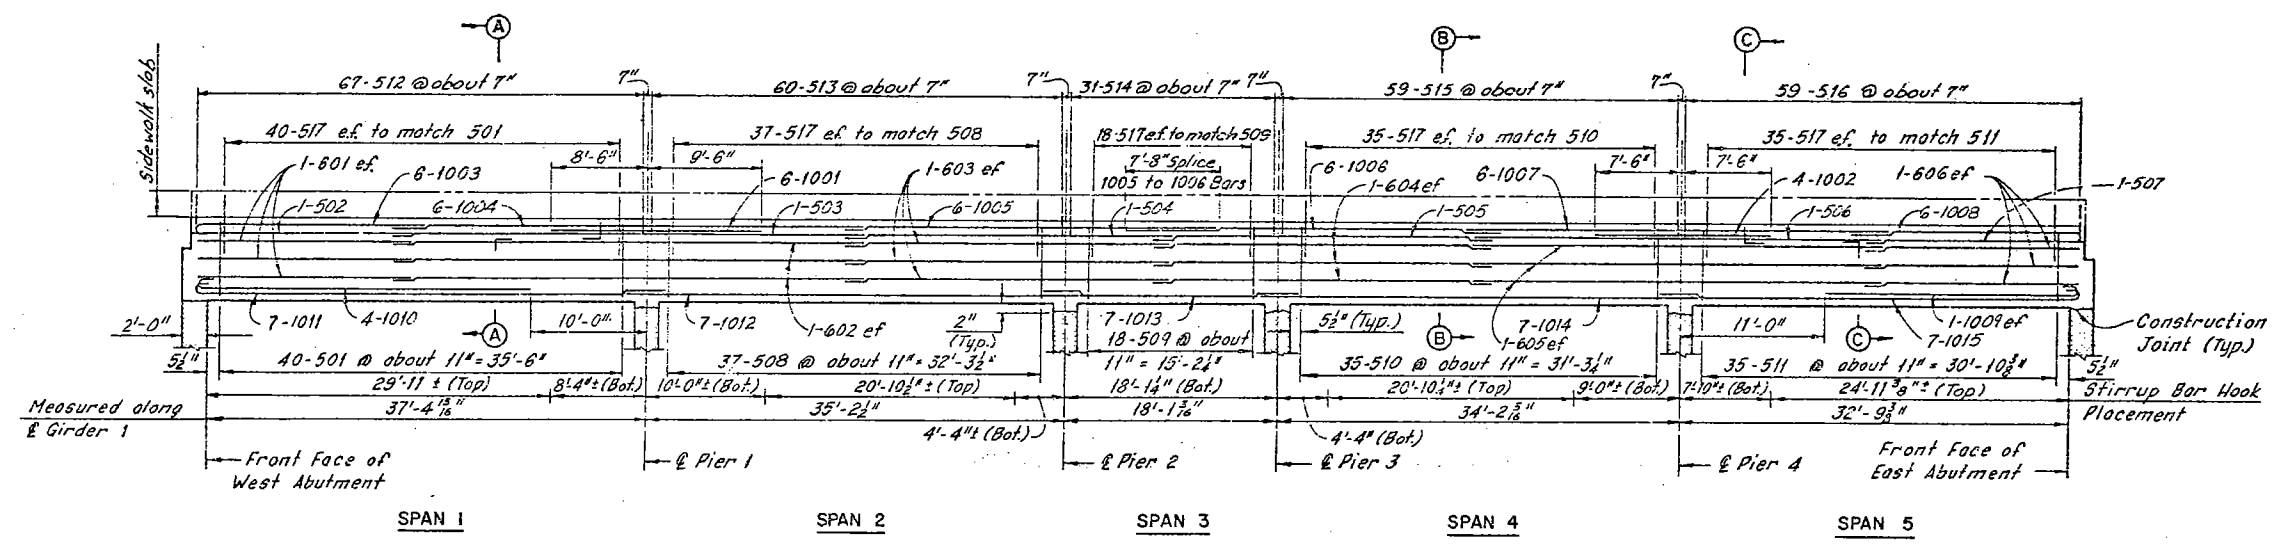


Note: All reinforcing bar marks shall be prefixed GM.

MINIMUM LAP LENGTHS (Except as noted)	
Bar No.	Lengths
5	1' - 7"
6	1' - 11"
10	3' - 2"

GIRDER DEPTH		
Location	Elev. A	Elev. B
* Front face of west abutment	670.95	667.60
± Pier 1	670.27	666.83
± Pier 2	669.62	666.13
± Pier 3	669.36	665.77
± Pier 4	668.91	665.07
* Front face of east abutment	668.48	663.72

* Given to the actual front face of abutment backwall

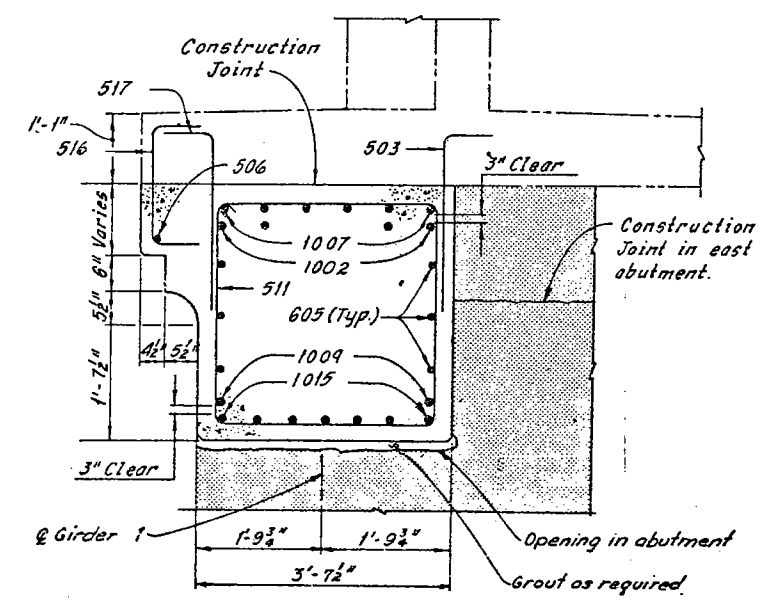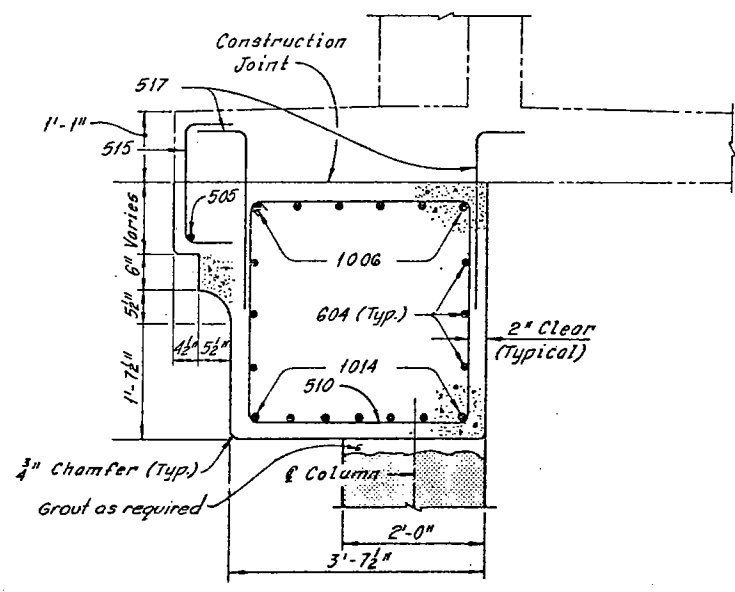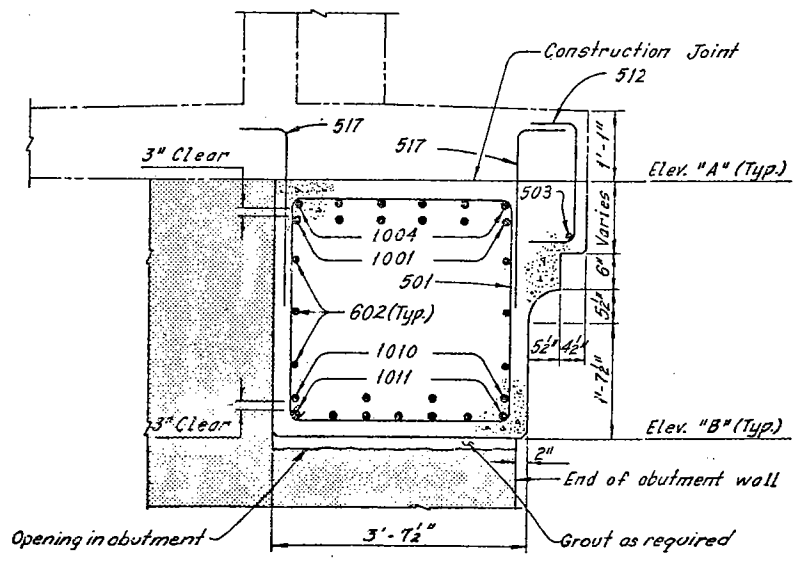

Notes:

Zip-a-tone indicates existing structure. Phantom lines indicate new construction, details of which are shown elsewhere in these plans.

For Removal Plans, see Sheets 4/31

For Sidewalk Plans, see Sheets 27/31

For Reinforcement Schedule, see Sheet R/S

The following abbreviations are used:
Typ. = Typical Bot. = Bottom
e.f. = each face f.f. = far face

The cost of grouting shall be included with the unit price bid for Item 511, Class C Concrete, Abutments Above Footings, for payment.

FNTB BRIDGE NO. 4

HOWARD, NEEDLES, TAMMEN & BERGENDOFF CONSULTING ENGINEERS CLEVELAND


HNTB

GIRDER-I REPLACEMENT

REHABILITATION OF THE CARNEGIE AVENUE GRADE SEPARATION STRUCTURE (S.R. 10 OVER THE CLEVELAND UNION TERMINALS CO. AND THE REGIONAL TRANSIT AUTHORITY) BR. NO. CUY. -10-1685 STA. 57+29.72 STA. 58+85.70 CUYAHOGA COUNTY OHIO

DRAWN BY	TRACED BY	CHECKED BY	REVIEWED BY	REVISED BY
DATE 7-28-72	DATE 8-1-72	DATE 8-7-72	DATE	DATE

SHEET 20/31

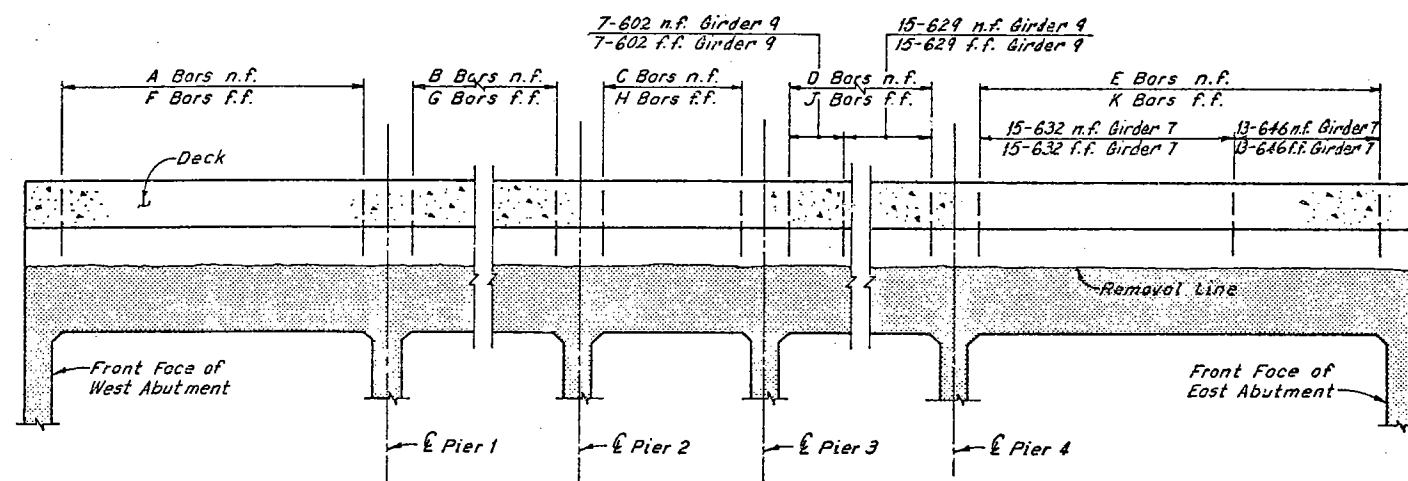

Note:
Reinforcing bars shall be spaced to match existing girder reinforcement.

TYPICAL GIRDER ELEVATION
(Existing girder reinforcement and new slab reinforcement not shown)

GIRDER	BAR A		BAR B		BAR C		BAR D		BAR E		BAR F		BAR G		BAR H		BAR J		BAR K	
	NO.	MARK	NO.	MARK	NO.	MARK	NO.	MARK	NO.	MARK	NO.	MARK	NO.	MARK	NO.	MARK	NO.	MARK	NO.	MARK
2	24	602	22	602	4	605	1 Ser. 16	607	1 Ser. 16	609	24	601	22	601	4	603	1 Ser. 16	606	1 Ser. 16	608
3	26	610	24	610	4	611	1 Ser. 20	612	1 Ser. 18	613	26	610	24	610	4	611	1 Ser. 20	612	1 Ser. 18	613
4	16	614	18	615	4	611	1 Ser. 16	616	1 Ser. 20	617	16	614	18	615	4	611	1 Ser. 16	616	1 Ser. 20	617
4A	-	-	18	615	4	611	1 Ser. 16	618	1 Ser. 20	619	-	-	18	615	4	611	1 Ser. 16	618	1 Ser. 20	619
5	18	611	22	620	1 Ser. 4	621	1 Ser. 20	622	1 Ser. 22	625	18	611	22	620	1 Ser. 4	621	1 Ser. 20	622	1 Ser. 22	624
6	1 Ser. 23	626	1 Ser. 32	627	8	628	28	628	26	629	1 Ser. 23	626	1 Ser. 32	627	8	628	28	628	26	629
7	22	629	28	630	8	630	1 Ser. 23	631	15 13 632 646	22	629	28	630	8	630	1 Ser. 23	631	15 13 632 646	26	635
8	17	603	19	633	8	601	1 Ser. 17	634	26	635	17	603	19	633	8	601	1 Ser. 17	634	26	635
9	17	601	19	605	8	602	15 602 629	-	-	17	601	19	605	8	602	15 602 629	-	-	-	-
10	19	636	21	605	-	-	-	-	-	19	635	21	605	-	-	-	-	-	-	-
11	1 Ser. 16	637	-	-	-	-	-	-	-	1 Ser. 16	637	-	-	-	-	-	-	-	-	-
12	1 Ser. 21	638	29	640	8	629	-	-	-	1 Ser. 21	639	29	636	8	636	-	-	-	-	-
13	23	601	24	633	8	630	20	629	32	635	23	601	24	633	8	630	20	629	32	635
14	19	620	32	641	8	641	19	642	21	643	19	601	32	601	8	601	19	633	21	645
15	1 Ser. 17	644	20	620	7	620	14	641	16	641	1 Ser. 17	644	20	620	7	620	14	641	16	641
16	17	611	20	611	7	620	14	620	16	604	17	611	20	611	7	620	14	620	16	604
17	16	≠ 641	20	≠ 620	8	≠ 620	16	≠ 620	18	≠ 604	16	≠ 611	20	≠ 641	8	≠ 642	16	≠ 642	18	≠ 623
18	18	604	28	604	7	641	20	641	17	642	18	604	28	604	7	641	20	641	17	642

Notes:
Zip-4-tone indicates existing structure.
For Girder 1 replacement details, see Sheet 20/31.
For Reinforcement Schedule, see Sheet R/5.
For Member Identification Plans, see Sheet 2/31.
For Typical Section thru girders, see Modified Typical Section Along Pier 3, see Sheet 22/31.

Note: All reinforcing bar marks shall be prefixed GR.

≠ denotes epoxy coated reinforcing steel

HNTB BRIDGE NO. 4

HOWARD, NEEDLES, TAMMEN & BERGENDOFF CONSULTING ENGINEERS CLEVELAND

HNTB

GIRDER REINFORCEMENT
GIRDERS 2 THRU 18
REHABILITATION OF THE
CARNEGIE AVENUE GRADE SEPARATION STRUCTURE
(S.R.10 OVER THE CLEVELAND UNION TERMINALS CO.
AND THE REGIONAL TRANSIT AUTHORITY)
BR. NO. CUY. -10-1685 STA. 57+29.72
CUYAHOGA COUNTY OHIO STA. 58+85.70


DRAWN AJT	TRACED DES	CHECKED AN	REVIEWED	REVISED
DATE 8-2-78	DATE 8-4-78	DATE 8-7-78	DATE	DATE

SHEET 21/31

FHWA REGION	STATE	PROJECT
5	OHIO	

169
185

CUYAHOGA COUNTY
CUY-10-16.23

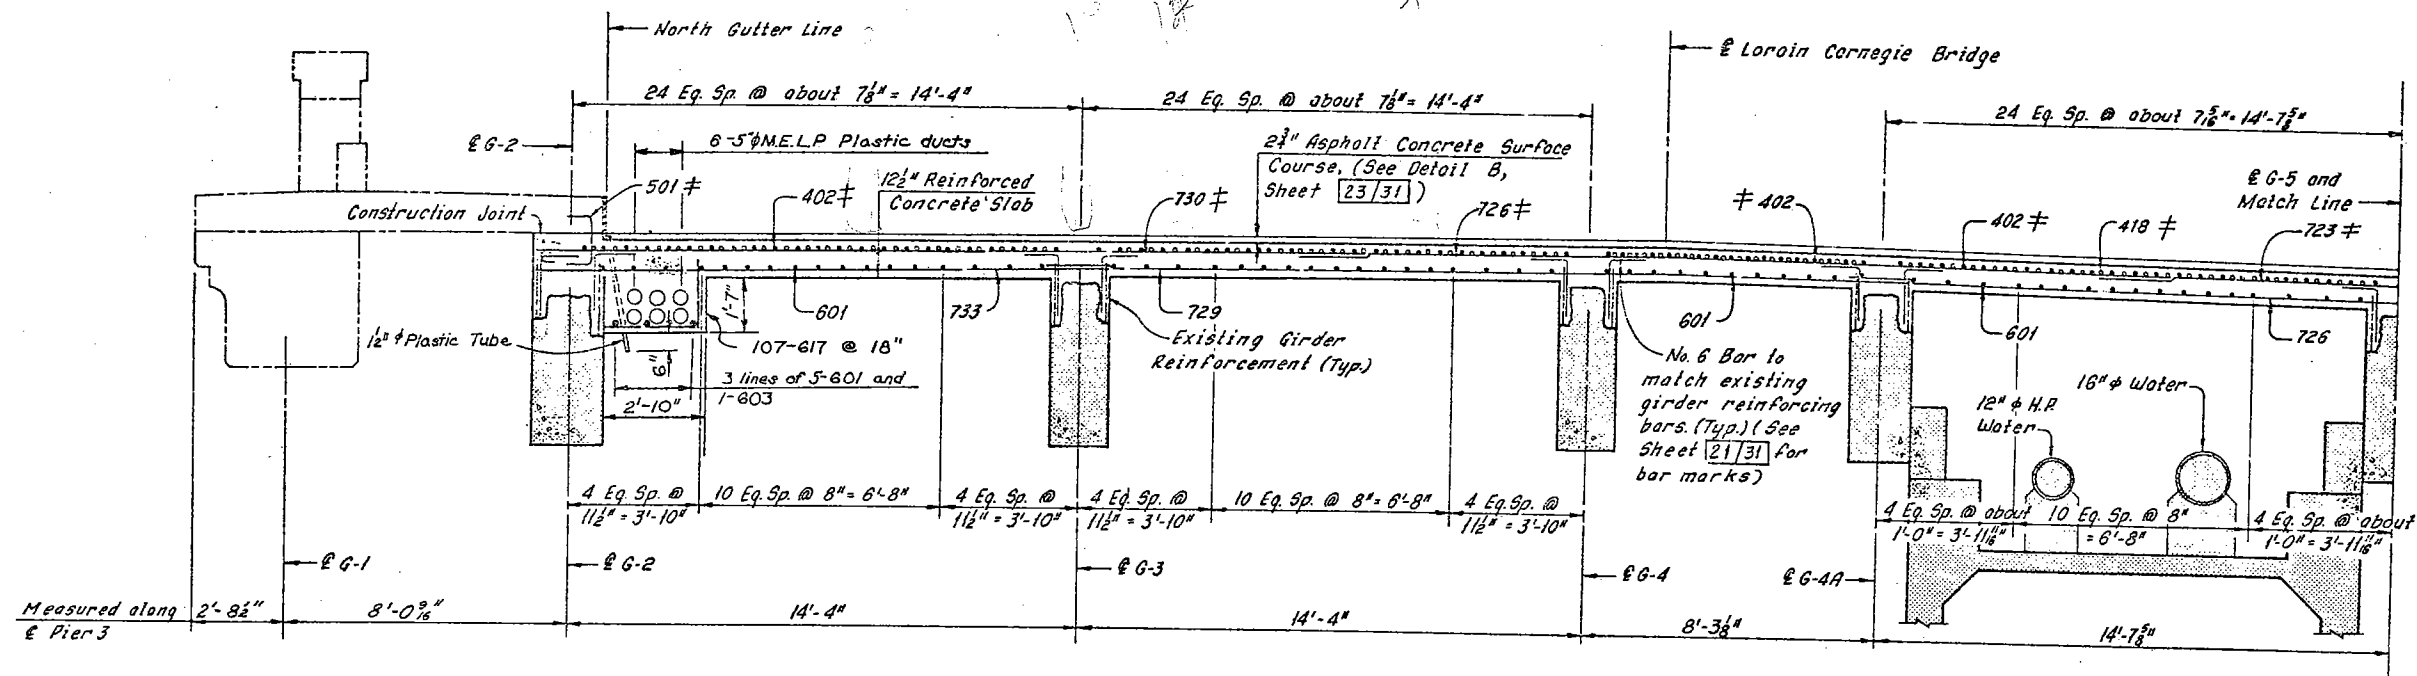


PART TYPICAL SECTION
(Columns Not Shown)

denotes epoxy coated reinforcing steel

Note: Existing Longitudinal Girder Reinforcement not shown.

Note:
Reinforcing bars shown shall be prefixed as follows:
BR = Bottom Transverse Reinforcing
TR = Top Transverse Reinforcing
LR = Longitudinal Reinforcing

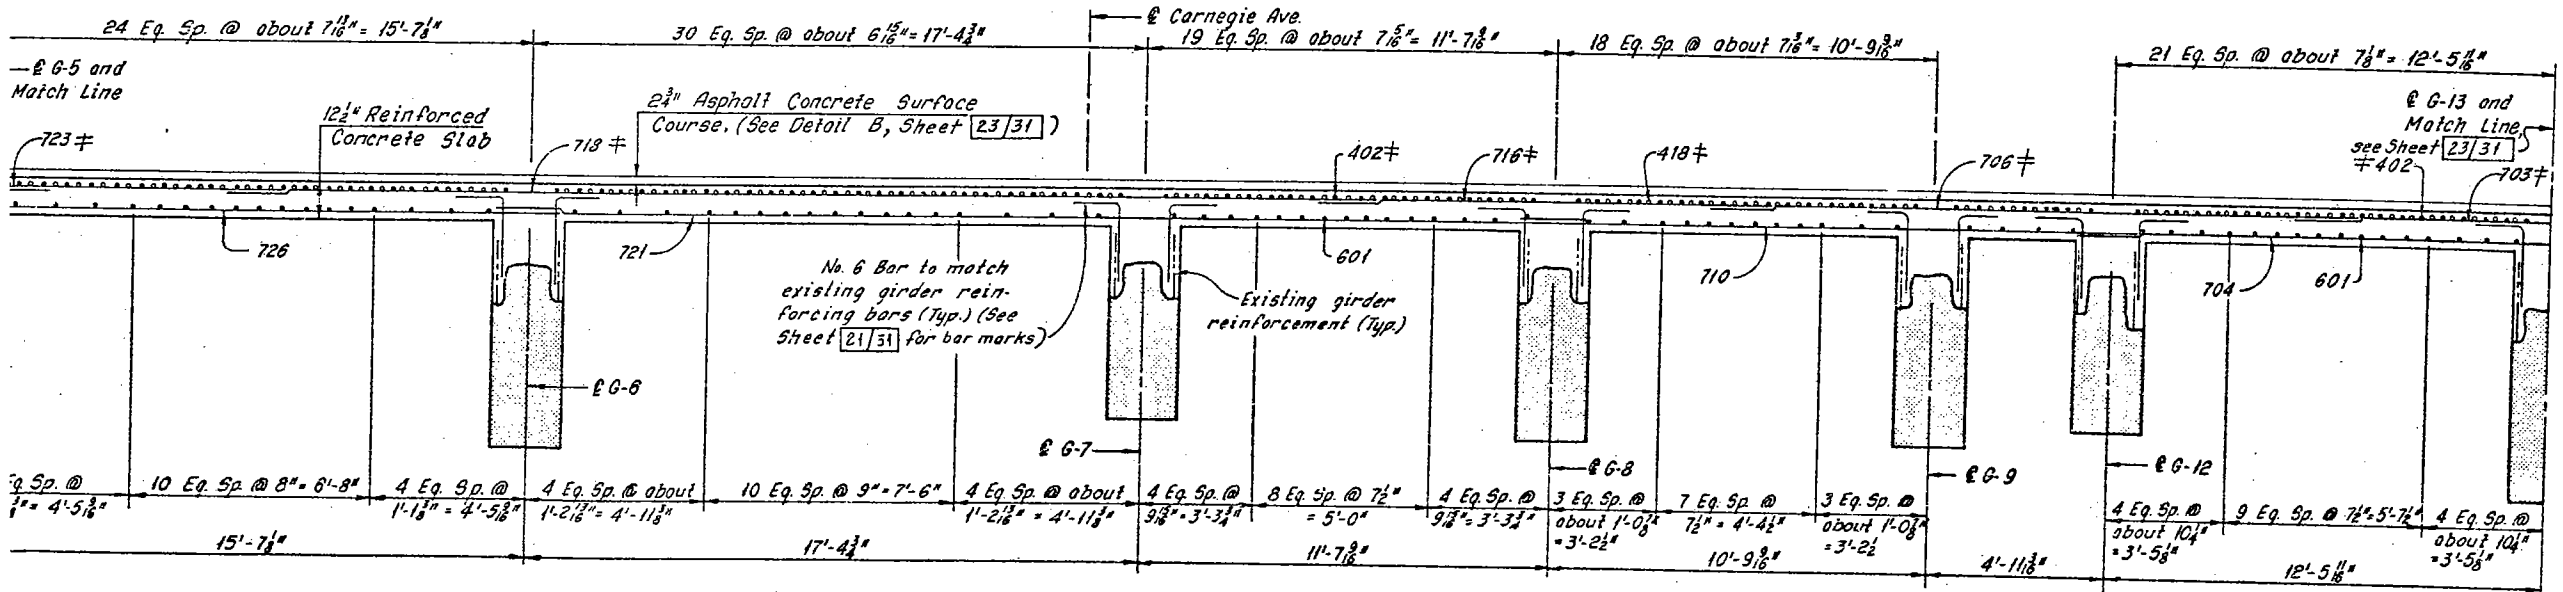

PART TYPICAL SECTION
(Columns Not Shown)

Notes:
Zip-a-tone indicates existing structures.
Phantom lines indicate new construction, details of which are shown elsewhere in these plans.
For Removal Plans, see Sheet 4/31.
For Sidewalk Details, see Sheet 27/31.
For Girder 1 Details, see Sheet 30/31.
For Reinforcement Schedule, see Sheet R/4.
The following abbreviations are used:
Typ. = Typical
H.P. = High Pressure
Eq. Sp. = Equal Spaces
For Slab Plans, see Sheets 24/31, 25/31 and 26/31.
For stage construction see Sheet 1/31.

HNTB BRIDGE NO. 4


HOWARD, NEEDLES, TAMMEN & BERGENDOFF CONSULTING ENGINEERS CLEVELAND

HNTB


MODIFIED TYPICAL SECTION
ALONG PIER 3
REHABILITATION OF THE
CARNEGIE AVENUE GRADE SEPARATION STRUCTURE
(S.R.10 OVER THE CLEVELAND UNION TERMINALS CO.
AND THE REGIONAL TRANSIT AUTHORITY)
BR. NO. CUY-10-1685 STA. 57+29.72
CUYAHOGA COUNTY OHIO STA. 58+65.70

DRAWN BY	TRACED BY	CHECKED BY	REVIEWED	REVISED
DATE 9-25-78	DATE 10-3-78	DATE 7-7-78	DATE	DATE


SHEET 22/31

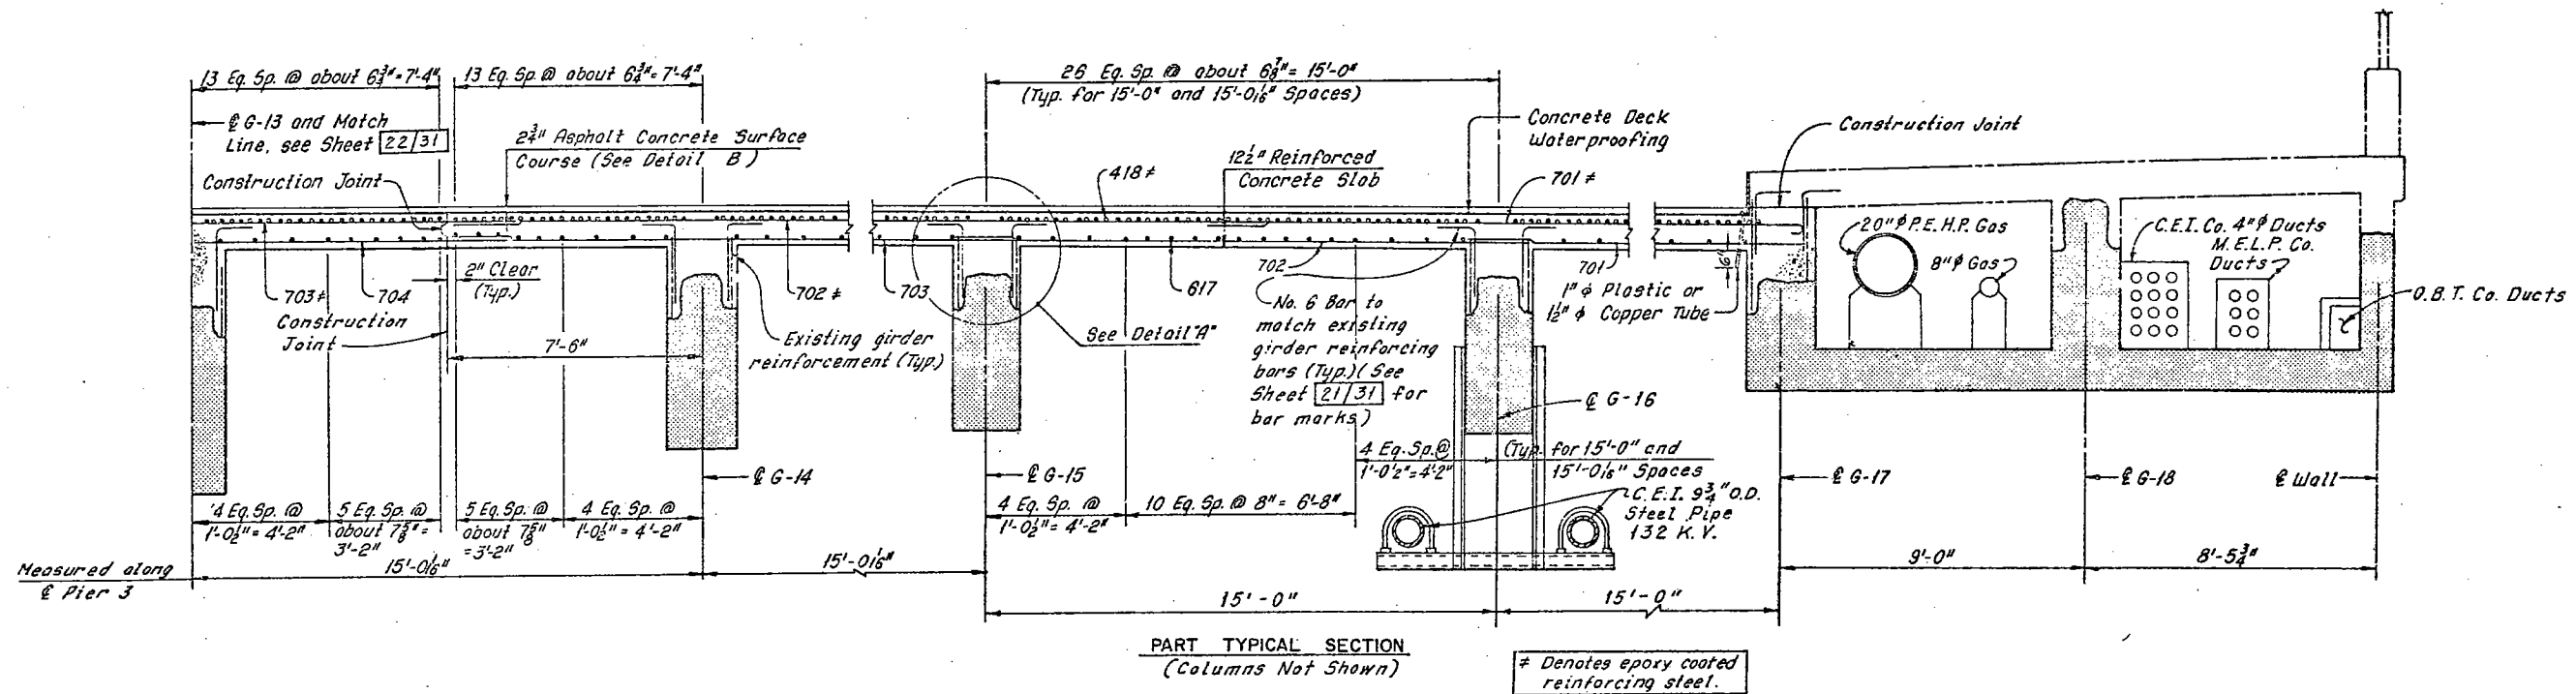

Note:
Reinforcing bars shown shall be prefixed as follows:
BR = Bottom Transverse Reinforcing
TR = Top Transverse Reinforcing
LR = Longitudinal Reinforcing

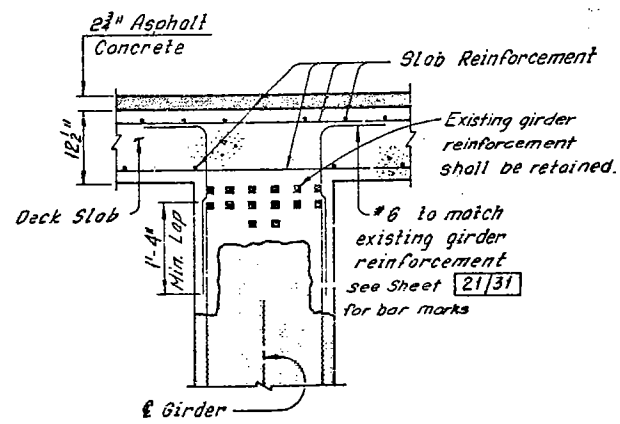

DETAIL A
(Girder 2 thru Girder 18)

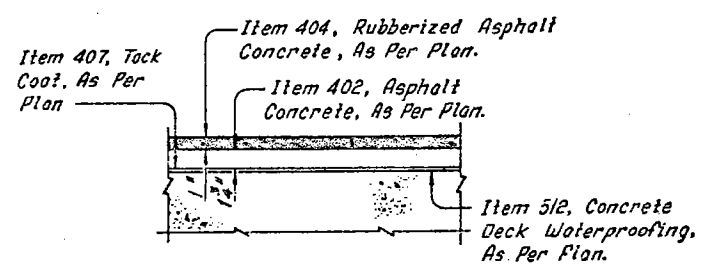

DETAIL B

Note:
For Notes, see Sheet 22/31

HNTB BRIDGE NO. 4

HOWARD, NEEDLES, TAMMEN & BERGENDOFF CONSULTING ENGINEERS CLEVELAND


HNTB

MODIFIED TYPICAL SECTION
ALONG PIER 3
REHABILITATION OF THE
CARNEGIE AVENUE GRADE SEPARATION STRUCTURE
(S.R.10 OVER THE CLEVELAND UNION TERMINALS CO.
AND THE REGIONAL TRANSIT AUTHORITY)
BR NO. CUY. -10-1685 STA 57+29.72
CUYAHOGA COUNTY STA 58+85.70 OHIO

DRAWN BY	TRACES BY	CHECKED BY	REVIEWED	RES-SEU
DATE 9-25-83	DATE 10-3-83	DATE 7-7-83	DATE	

SHEET 23/31

CUYAHOGA COUNTY
CUY-10-16.23

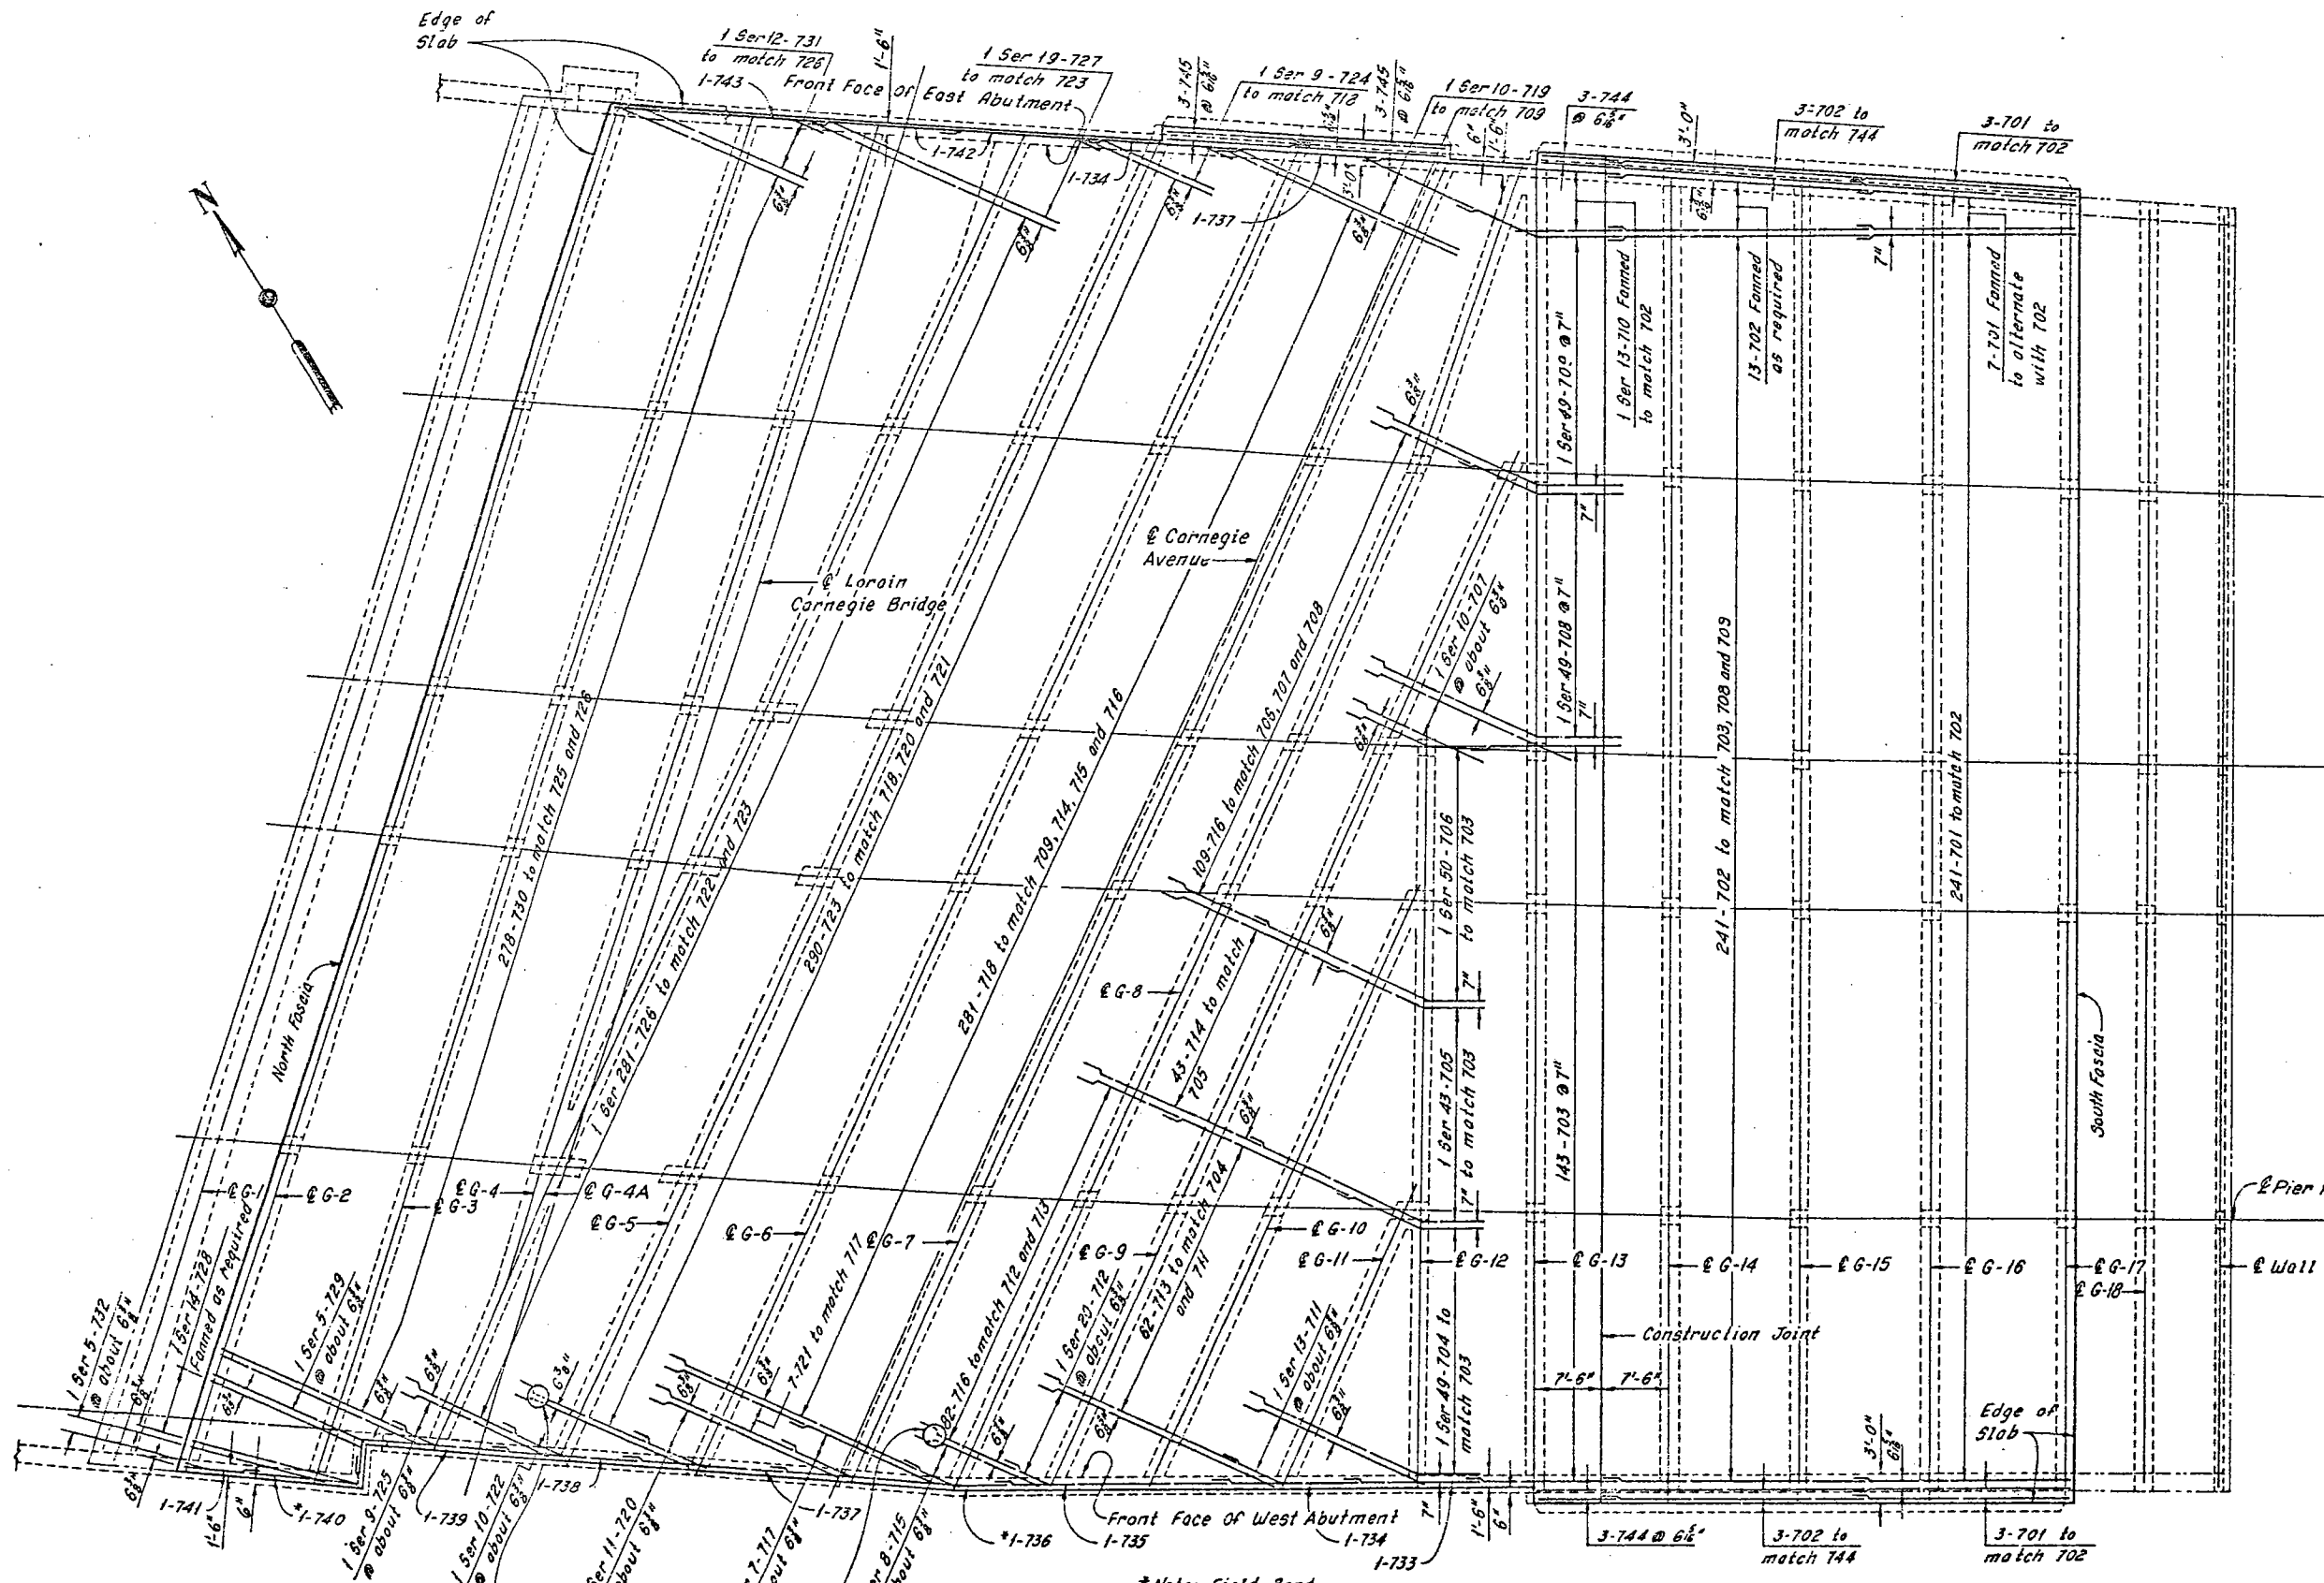

REQUIRED LAP LENGTHS	
No. 7 Bar	2'-0" Min.

Notes:
 For longitudinal deck slab reinforcement, see Sheet 26/31.
 For bottom transverse deck slab reinforcement, see Sheet 25/31.
 For modified Typical Section at Pier 3, see Sheet 22/31.
 For Sidewalk Plans and Details, see Sheet 27/31.
 For Hailing Plans and Details, see Sheet 29/31.
 For Approach Slab Details, see roadway plans.
 For reinforcement Schedule and Bending Diagrams, see Sheet R/4.
 For additional reinforcement at 30" Manholes, see Detail A, Sheet 26/31.
 For slope construction, see Sheet 1/31.

*Note: Field Bend as required.

Note: All reinforcing steel shown on this sheet shall be epoxy coated.

Note: All reinforcing bar marks shall be prefixed TR.

HNTB BRIDGE NO. 4

HOWARD, NEEDLES, TAMMEN & BERGENDOFF
CONSULTING ENGINEERS
CLEVELAND

HNTB

**SLAB PLAN
TOP TRANSVERSE REINFORCEMENT**

REHABILITATION OF THE
CARNEGIE AVENUE GRADE SEPARATION STRUCTURE
(S.R.10 OVER THE CLEVELAND UNION TERMINALS CO.
AND THE REGIONAL TRANSIT AUTHORITY)
BR. NO. CUY. -10-1685 STA. 57+29.72
CUYAHOGA COUNTY OHIO STA. 58+85.70


DRAWN E.P.	TRACED B.P.	CHECKED P.B.	REVIEWED P.B.	DATE 7-70
DATE 11-70				DATE 7-70

SHEET 24/31

FHWA REGION	STATE	PROJECT
5	OHIO	

172
185

CUYAHOGA COUNTY
CUY-10-16.23

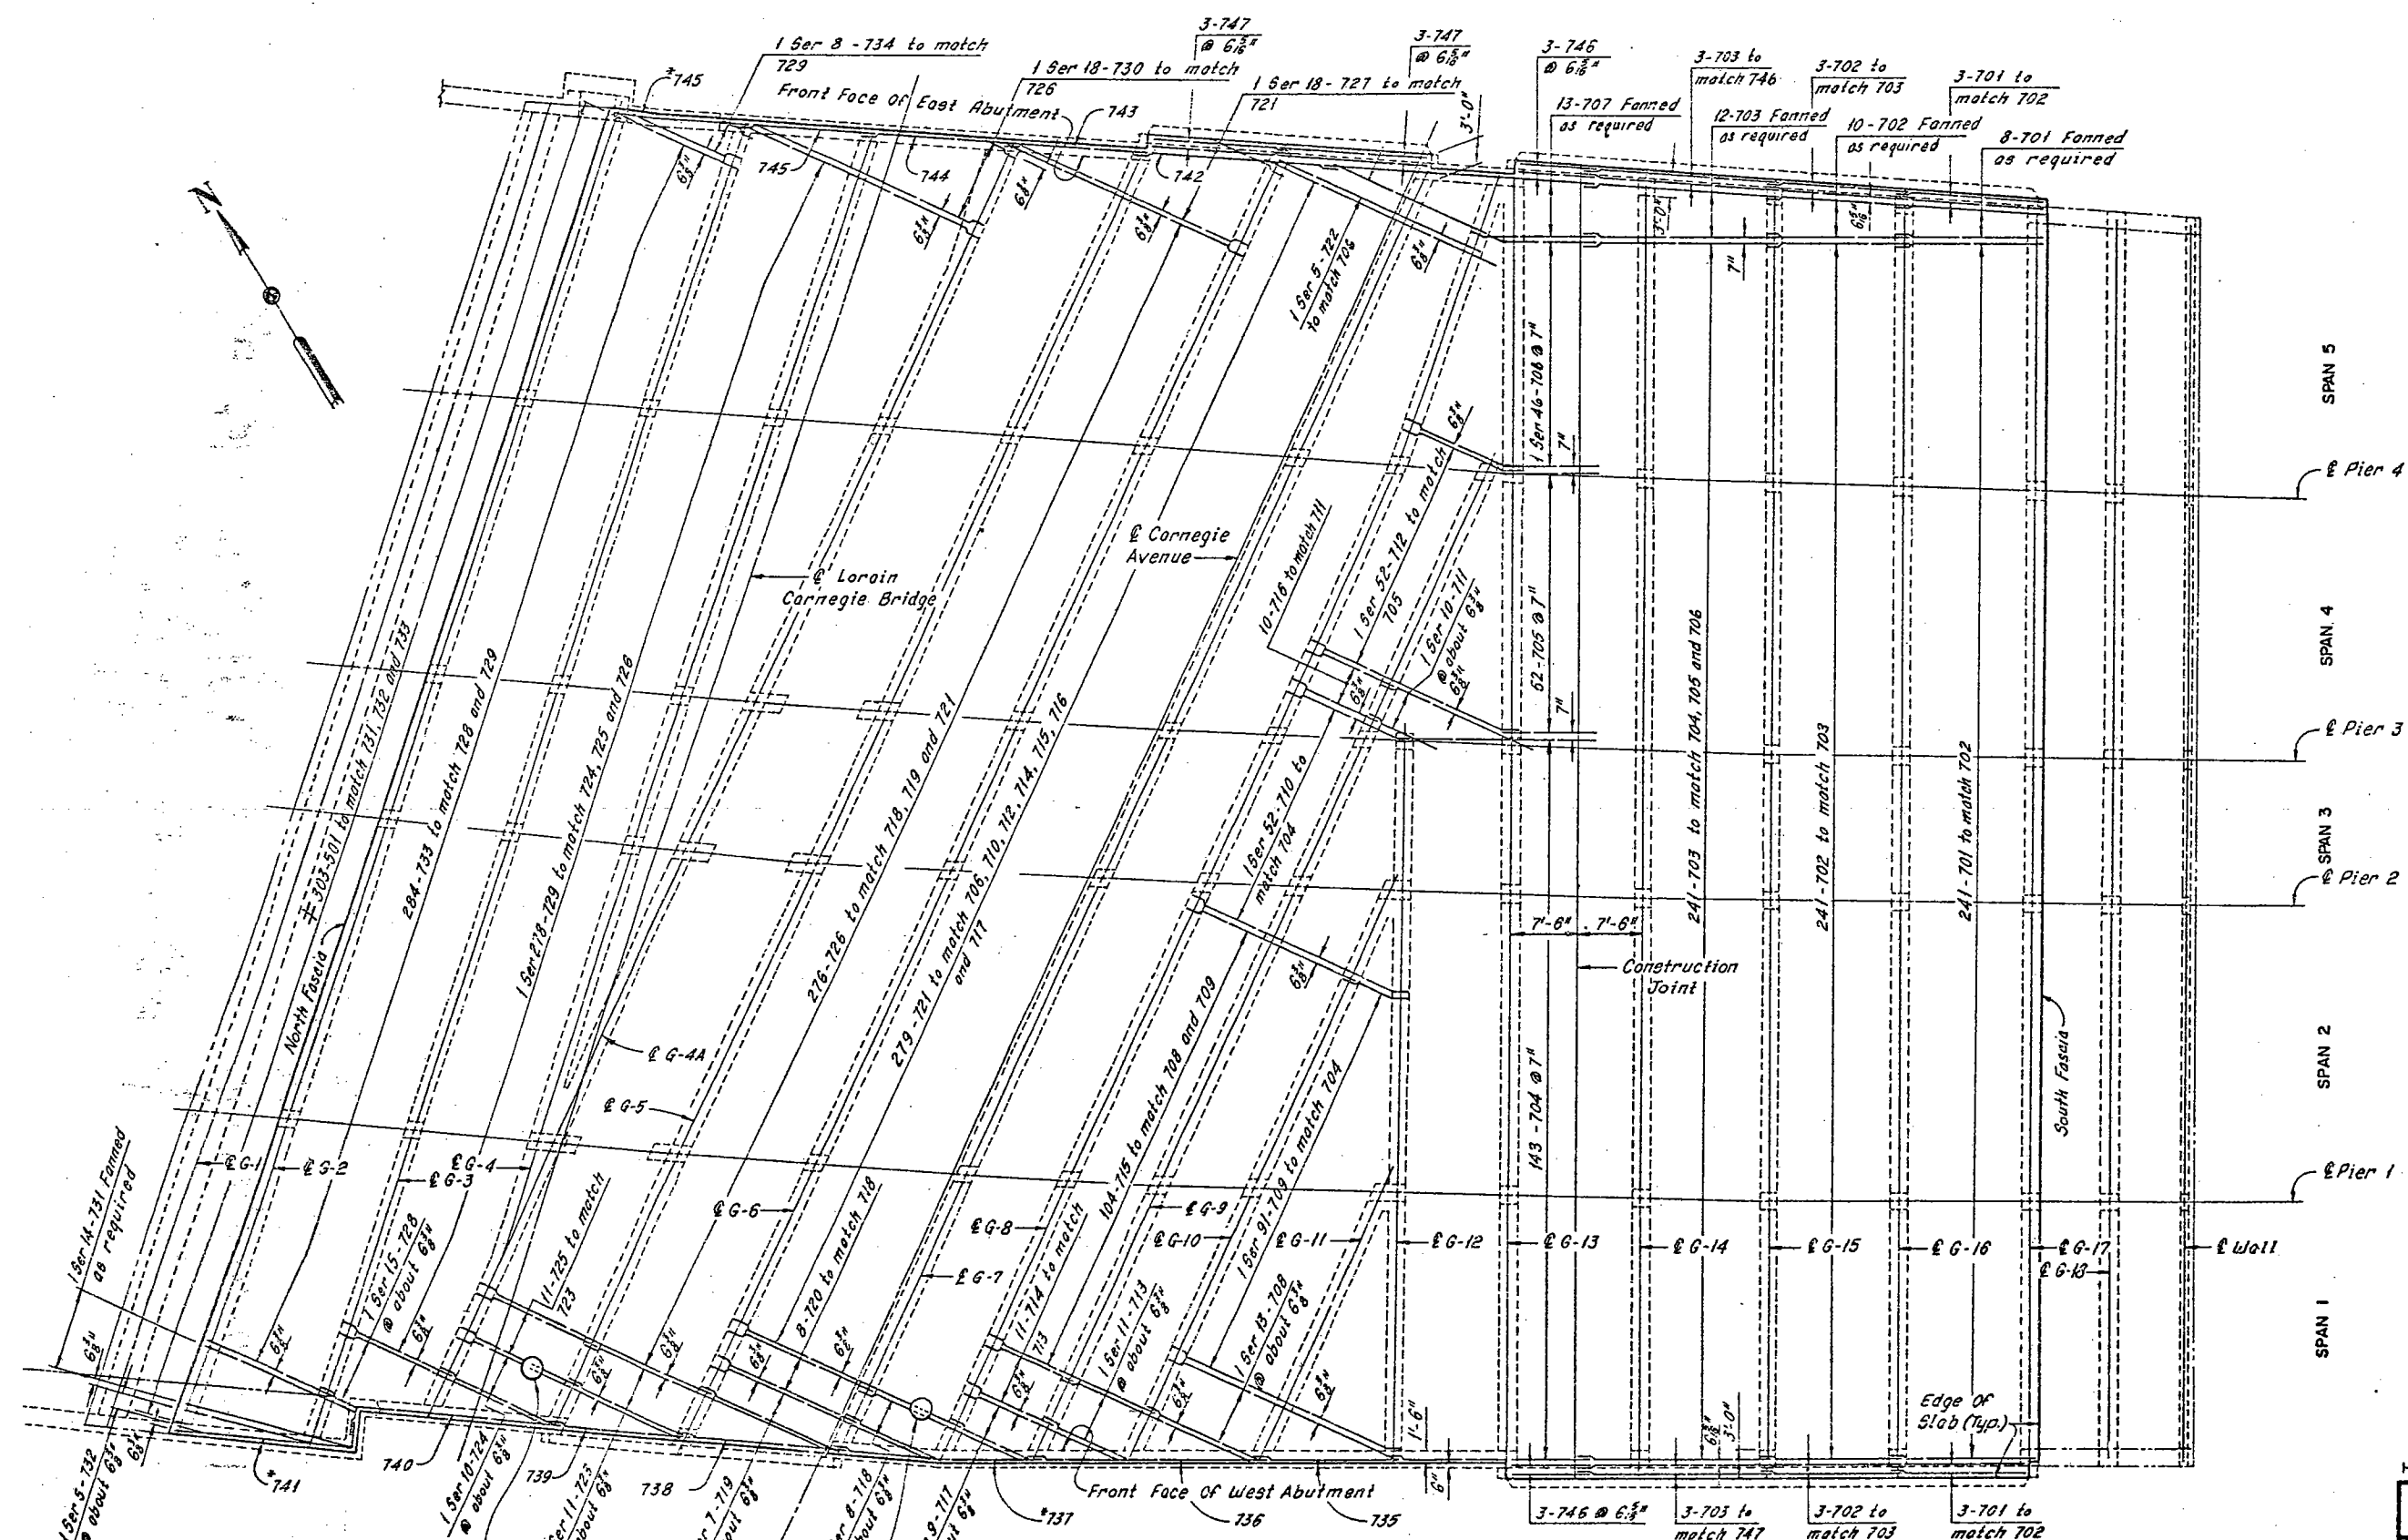

REQUIRED LAP LENGTHS	
No. 7 Bar	21'-0" Min.

Notes:
 For longitudinal deck slab reinforcement, see Sheet 26/31.
 For top transverse deck slab reinforcement, see Sheet 24/31.
 For Modified Typical Section at Pier 3, see Sheet 22/31.
 For Sidewalk Plans and Details, see Sheet 27/31.
 For Railing Plans and Details, see Sheet 29/31.
 For Approach Slab Details, see roadway plans.
 For Reinforcement Schedule and Bending Diagrams, see Sheet R/4.
 For additional reinforcement of 30" Manhole, see Detail A, Sheet 26/31.
 For slope construction, see Sheet 1/31.

*Note: Field bend as required.

Note: All reinforcing bar marks shall be prefixed BR.


± denotes epoxy coated reinforcing steel.

HNTB BRIDGE NO. 4
 HOWARD, NEEDLES, TAMMEN & BERGENDOFF
 CONSULTING ENGINEERS
 CLEVELAND



HNTB
 SLAB PLAN
 BOTTOM TRANSVERSE REINFORCEMENT
 REHABILITATION OF THE
 CARNEGIE AVENUE GRADE SEPARATION STRUCTURE
 (S.R.10 OVER THE CLEVELAND UNION TERMINALS CO.
 AND THE REGIONAL TRANSIT AUTHORITY)
 BR. NO. CUY.-10-1685 STA. 57+29.72
 CUYAHOGA COUNTY STA. 58+85.70
 OHIO

DRAWN	TRACED	CHECKED	REVIEWED	REVISED
DATE 3/20/72	DATE 3/21/72	DATE 3/21/72	DATE	DATE

SHEET 25/31

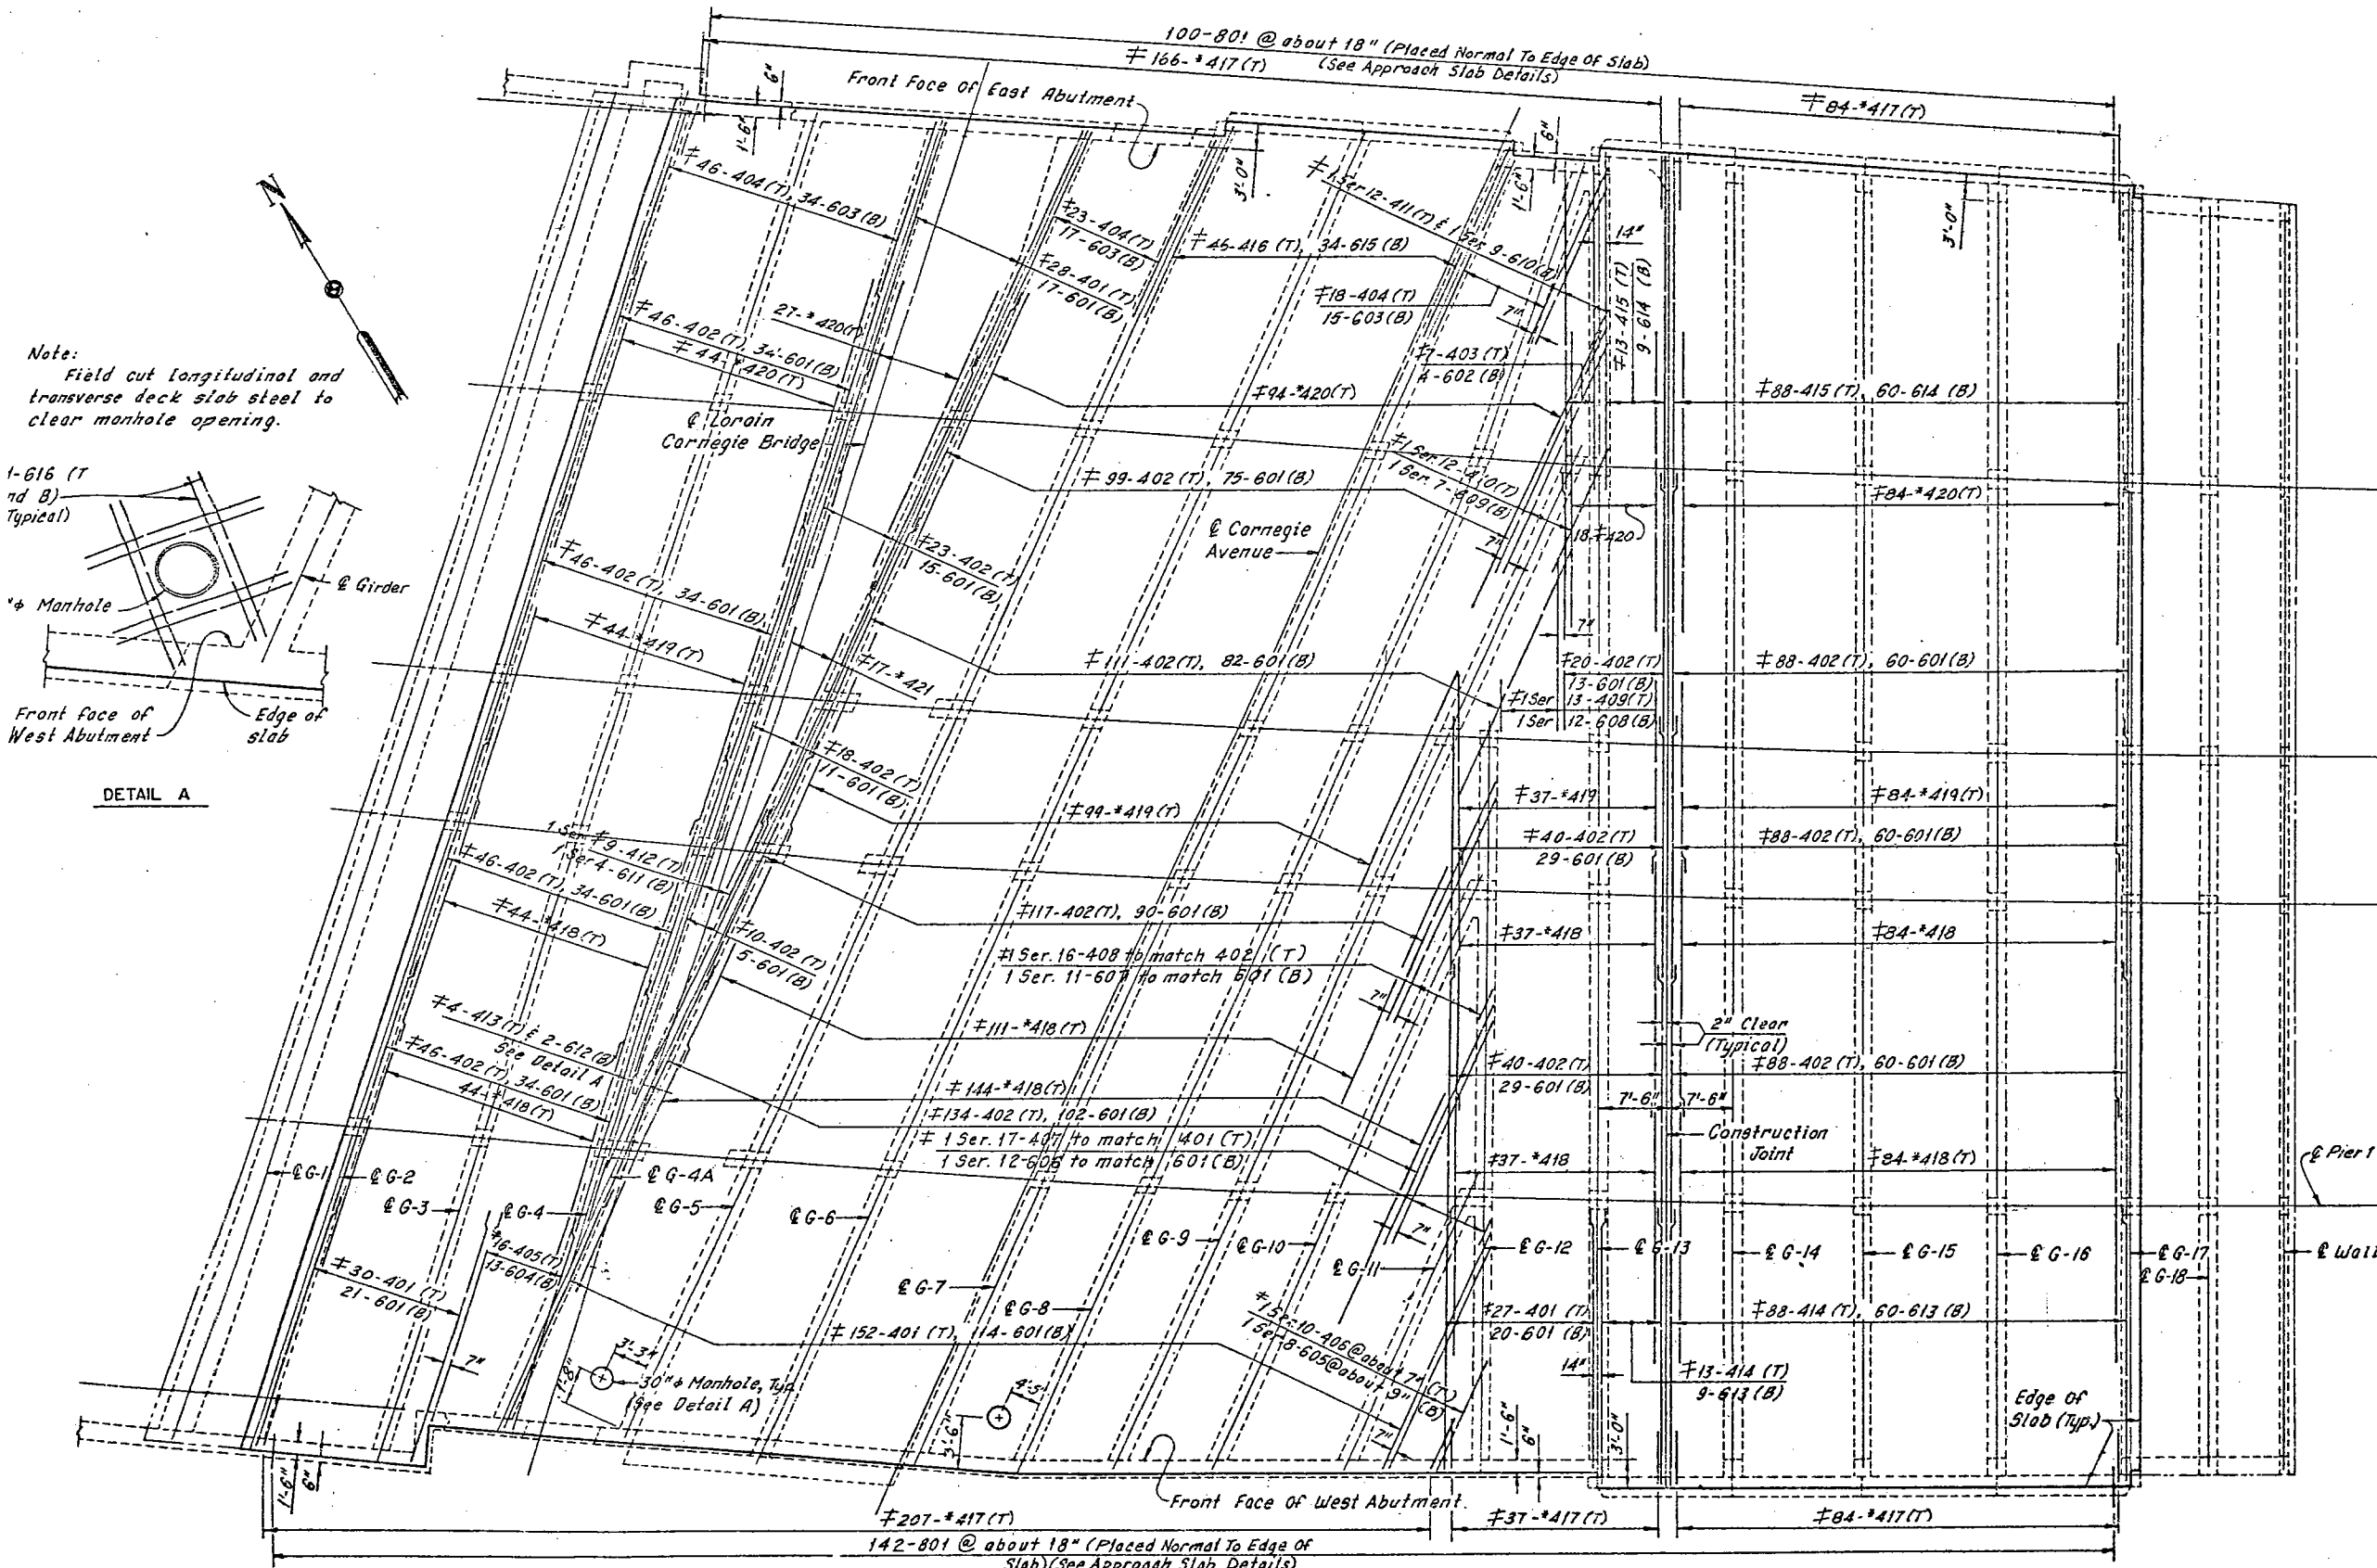

Note:
Field cut longitudinal and transverse deck slab steel to clear manhole opening.

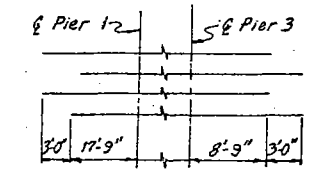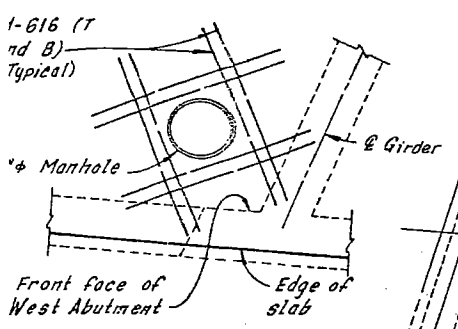

PLACEMENT OF ADDITIONAL REINFORCEMENT OVER PIERS

MINIMUM REQUIRED BAR SPLICE LENGTH	
Bar No.	Splice length
4	1'-0"
6	1'-5"

Notes:
 * Indicates additional reinforcement over piers or at abutments.
 For placement of longitudinal slab reinforcement, see Sheets 22/31 and 23/31.
 For additional notes, see Sheet 24/31.
 For Approach Slab Details, see roadway plans.
 For stage construction, see Sheet 1/31.

denotes epoxy coated reinforcing steel

Note: All reinforcing bar marks shall be prefixed L.R.

HNTB BRIDGE NO. 4

HOWARD, NEEDLES, TAMMEN & BERGENDOFF CONSULTING ENGINEERS CLEVELAND

HNTB


SLAB PLAN LONGITUDINAL REINFORCEMENT

REHABILITATION OF THE CARNegie AVENUE GRADE SEPARATION STRUCTURE (S.R.10 OVER THE CLEVELAND UNION TERMINALS CO. AND THE REGIONAL TRANSIT AUTHORITY).
 BR NO. CUY.-10-1685 STA. 57+29.72
 CUYAHOGA COUNTY STA. 58+85.70 OHIO

DRAWN	TRACED	CHECKED	REVIEWED	REVISED
DATE: 5-27-78	DATE: 5-27-78	DATE: 5-27-78	DATE: 5-27-78	DATE: 5-27-78


SHEET 26/31

CUYAHOGA COUNTY
 CUY-10-16.23

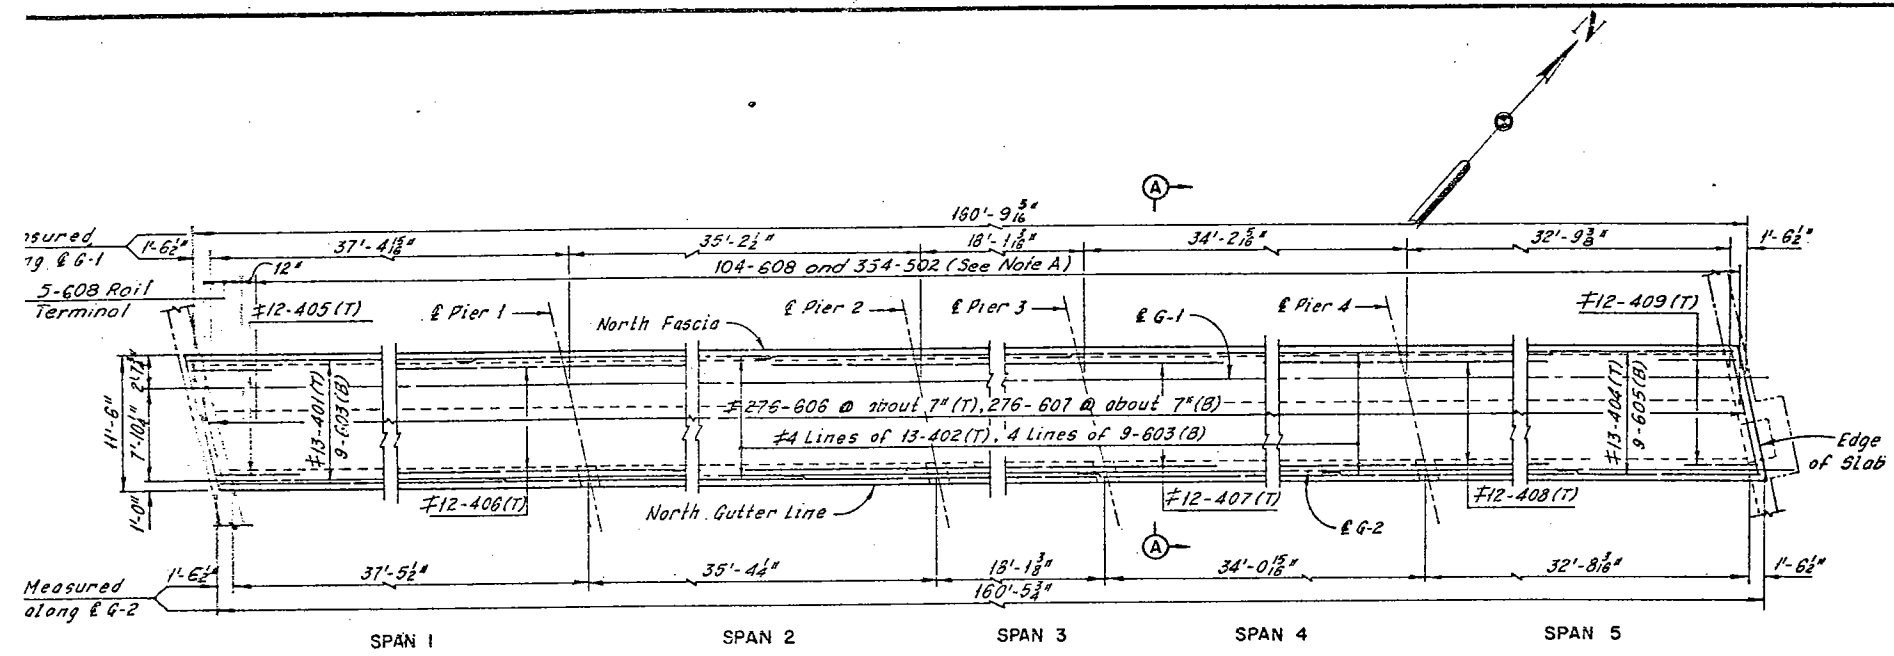


NORTH SIDEWALK PLAN
 (Concrete railing not shown)

* Indicates additional reinforcement over piers, see Placement Diagram.

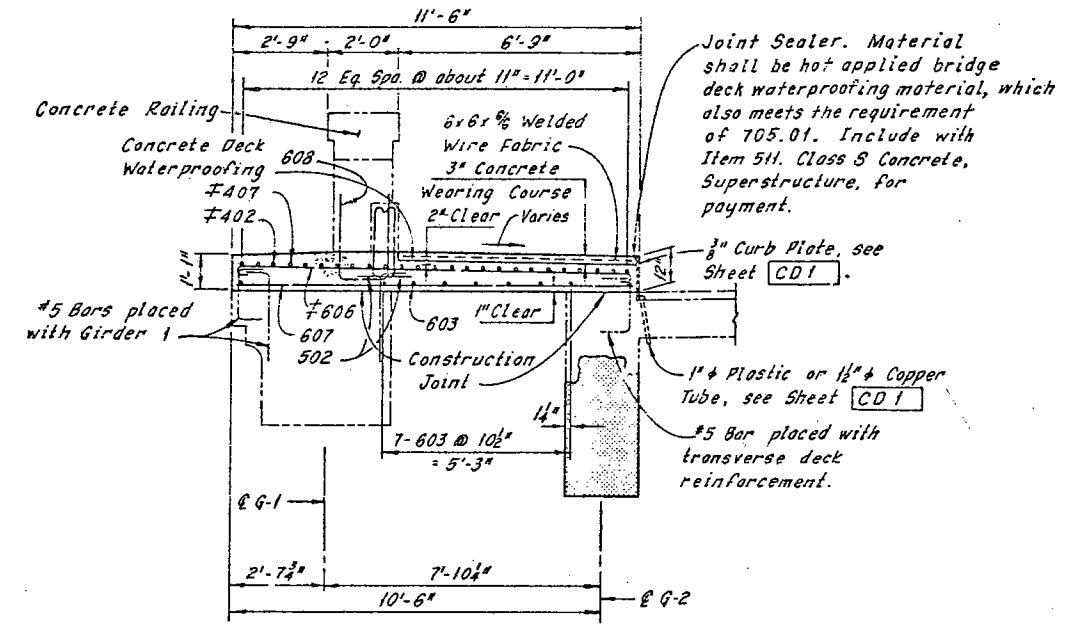


SECTION A-A

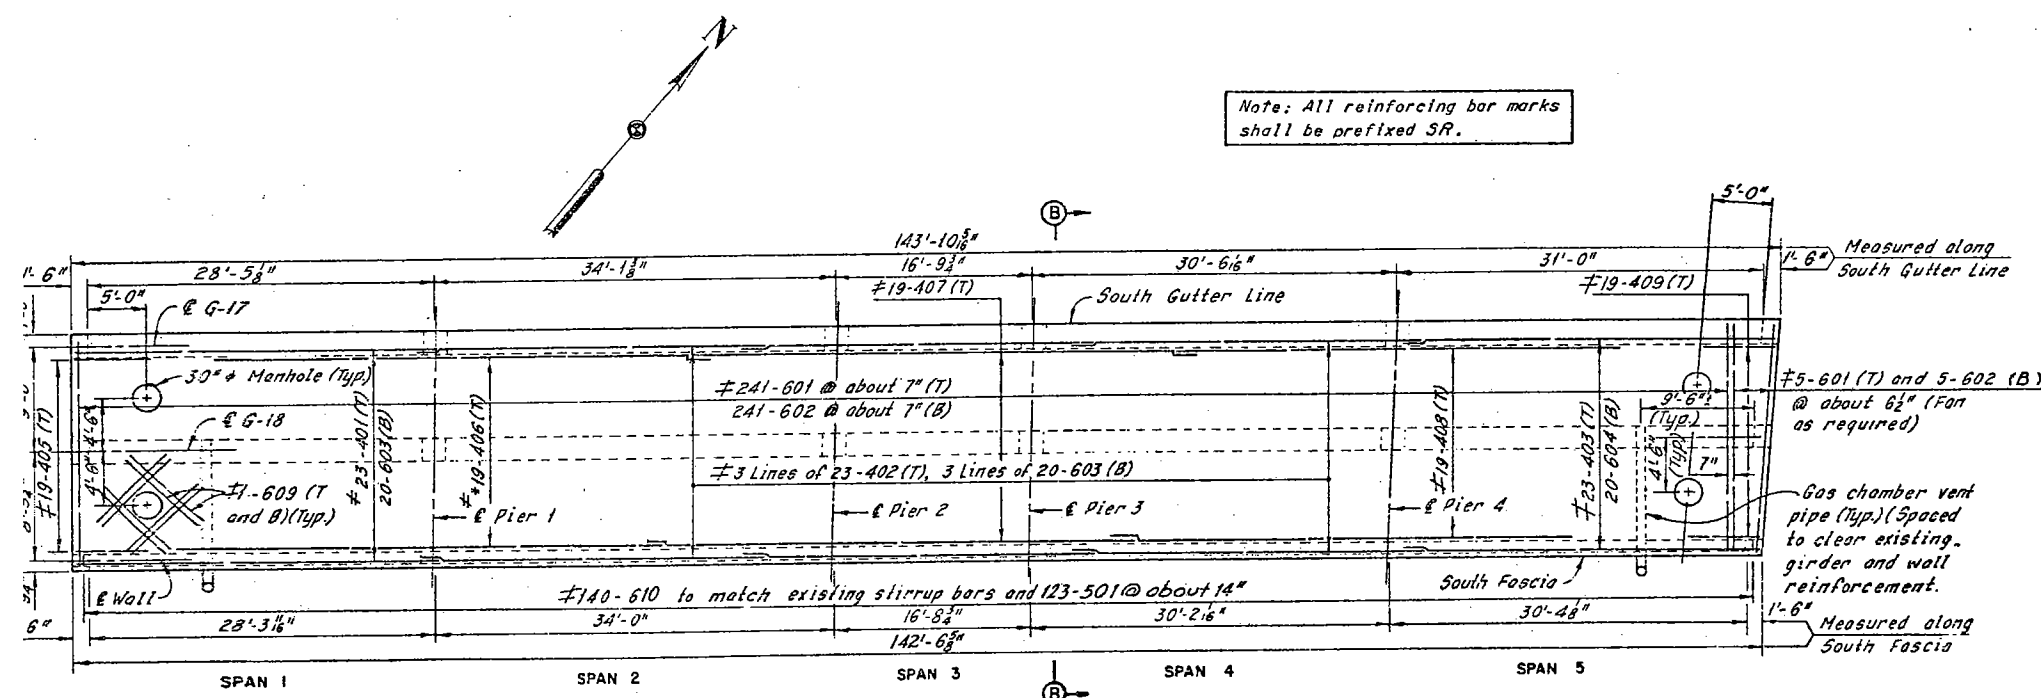

SOUTH SIDEWALK PLAN
 (Parapet and fence not shown)

* Indicates additional reinforcement over piers, see Placement Diagram.

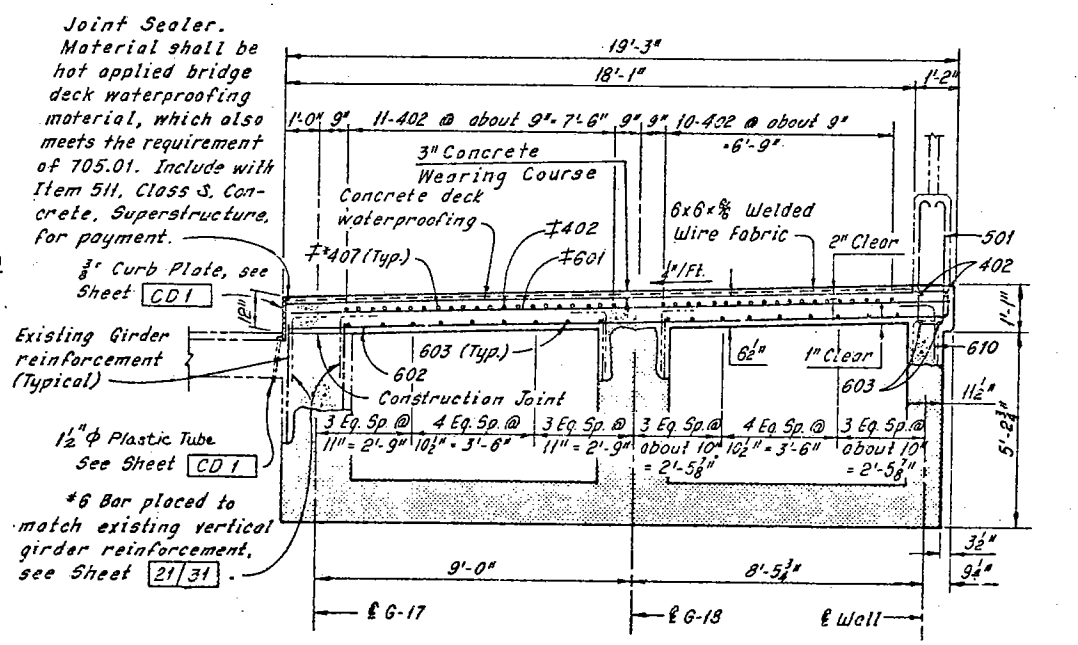

SECTION B-B
 (Utilities Not Shown)


Note: All reinforcing bar marks shall be prefixed SR.

- Notes:
- Zip-a-tone indicates existing structure.
 - Phantom lines indicate new construction, details of which are shown elsewhere in these plans.
 - For Removal Plans, see Sheets [4/31] and [5/31].
 - For details of concrete railing on north sidewalk, see Sheet [29/31].
 - For details of fence and parapet on south sidewalk, see Sheet [28/31].
 - For Girder 1 Replacement Details, see Sheet [20/31].
 - For Reinforcement Schedule, see Sheet [R/4].
 - For Gas Vent Detail, see Sheet [31/31].

denotes epoxy coated reinforcing steel

Note A:
 Bars SR502 shall be placed at 2 equal spaces (3 sets of 2 bars) between railing posts and at 1 space (2 sets of 2 bars) between railing posts and deflection joints and or railing posts and open joints. Bars SR 608 shall be placed at each face of railing posts.

PLACEMENT OF ADDITIONAL REINFORCEMENT OVER PIERS

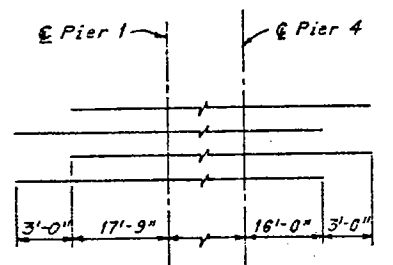


HNTB BRIDGE NO. 4		HNTB
HOWARD, NEEDLES, TAMMEN & BERGENDOFF CONSULTING ENGINEERS CLEVELAND		
SIDEWALK PLANS		
REHABILITATION OF THE CARNEGIE AVENUE GRADE SEPARATION STRUCTURE (S.R.10 OVER THE CLEVELAND UNION TERMINALS CO. AND THE REGIONAL TRANSIT AUTHORITY)		
BR. NO. CUY-10-1685	STA. 57+29.72	
CUYAHOGA COUNTY	OHIO	
DATE: 5-21-78	DATE: 7-78	SHEET 27/31

FHWA REGION	STATE	PROJECT
5	OHIO	

175
185

CUYAHOGA COUNTY
CUY-10-16.23


Preformed Expansion Joint Filler in the fencing parapet deflection joints may be either 1/2" gray sponge rubber or 1/2" gray cellular polyvinyl chloride (PVC) sponge. Either material shall meet the requirements of AASHTO M-153, Type 1 except the density of PVC sponge shall be not less than 20 lb. per cu. ft.

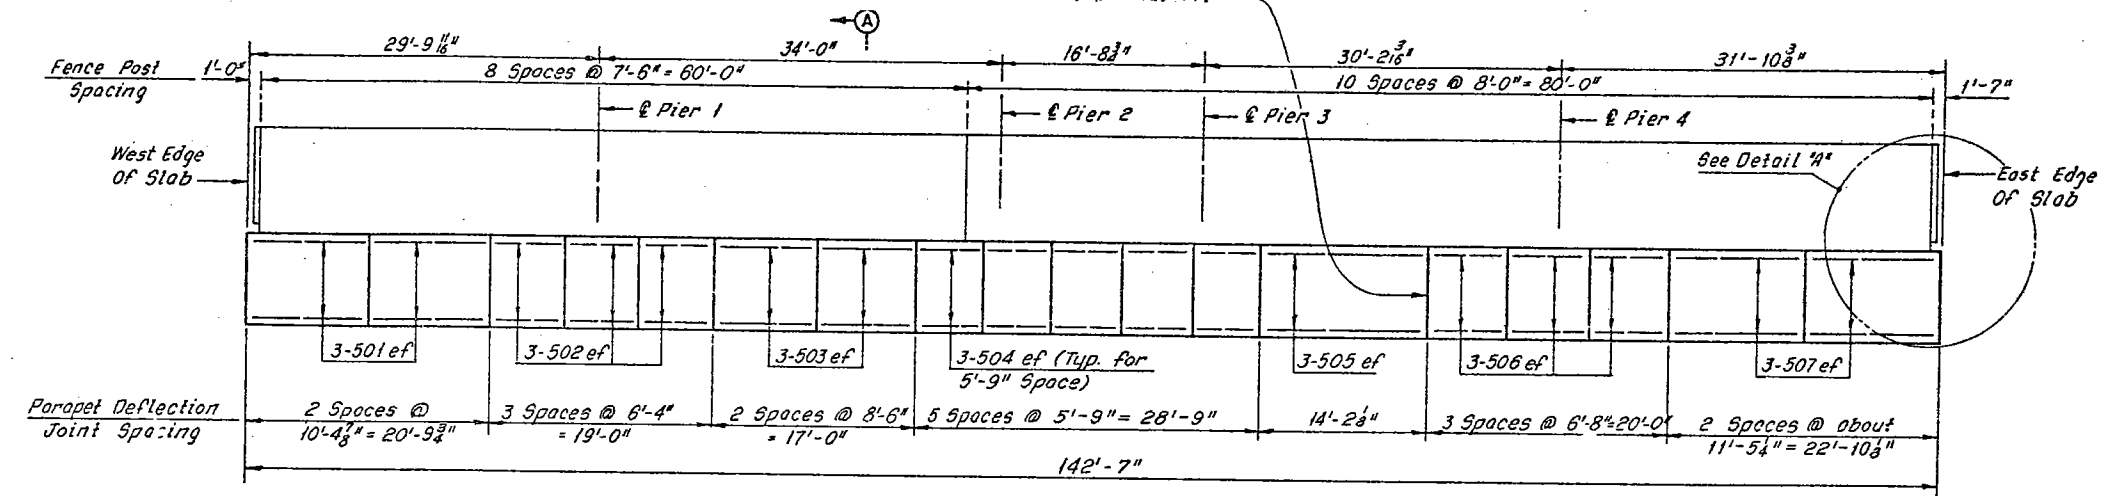


SOUTH PARAPET AND FENCE DETAILS
(Looking North)

Note:
All reinforcing bar marks shall be prefixed RB.

MARK	NO.	LENGTH	TYPE	WEIGHT (LBS)
RB501	12	10'-0"	Str.	125
RB502	18	6'-0"	Str.	113
RB503	12	8'-3"	Str.	103
RB504	30	5'-6"	Str.	172
RB505	6	13'-9"	Str.	86
RB506	18	6'-3"	Str.	117
RB507	12	11'-0"	Str.	138
TOTAL WEIGHT =				854

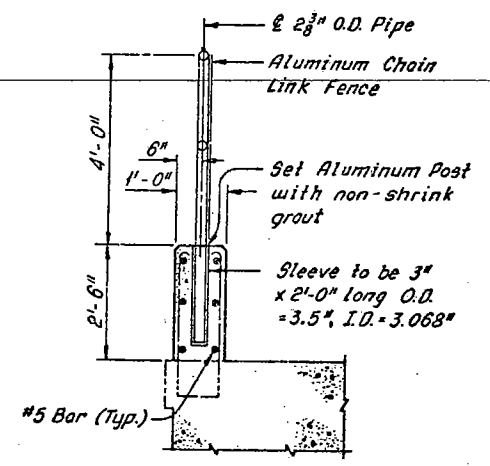

SECTION A-A

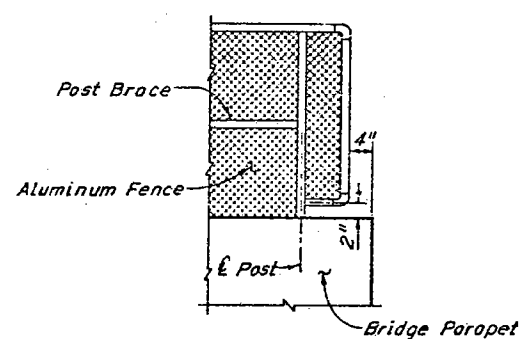

DETAIL A

Notes:
Payment for parapet and fence shall be made at the contract unit price for Item 517, Railing (Concrete Parapet with Chain-Link Fence-AASHTO Designation M-181-Type III Aluminum alloy fabric, posts, hardware and fittings.) Payment length shall be the over-all length of the parapets. Sleeves, parapet expansion joint material, grout and longitudinal reinforcing steel in the parapets shall be included with the unit price bid for Item 517, Railing (Concrete Parapet with Chain-Link Fence-AASHTO Designation M-181-Type III Aluminum alloy fabric, posts, hardware and fittings.), for payment. All other reinforcing steel in the parapets is included with Item 509, Reinforcing Steel, for payment.
Concrete parapets shall be placed in alternate sections by the use of bulkheads. Closing sections shall be placed after removal of bulkheads and after placement of sponge filler. Filler shall be flush with surface of mortar. The anchor posts shall be set in non-shrink grout.
The following abbreviation is used:
ef = each face

HNTB BRIDGE NO. 4

HOWARD, NEEDLES, TAMMEN & BERGENDOFF CONSULTING ENGINEERS CLEVELAND


HNTB

SOUTH PARAPET AND FENCE DETAILS

REHABILITATION OF THE CARNegie AVENUE GRADE SEPARATION STRUCTURE (S.R.10 OVER THE CLEVELAND UNION TERMINALS CO. AND THE REGIONAL TRANSIT AUTHORITY)
BR. NO. CUY. -10-1685 STA. 57+29.72
CUYAHOGA COUNTY STA. 58+85.70 OHIO

DRAWN	TRACED	CHECKED	REVIEWED	REVISED
R.A.S.	D.L.R.	C.K.T.		
DATE 11-27	DATE 11-27	DATE 12-77	DATE	


SHEET 28/31

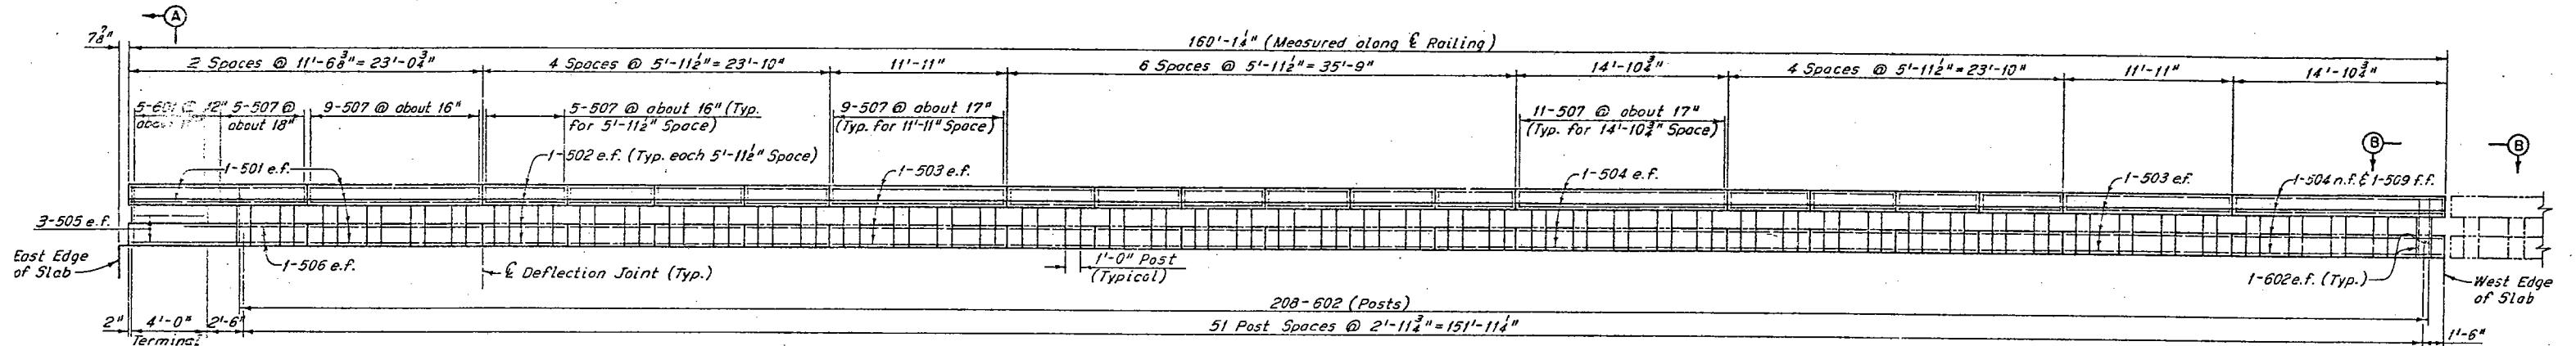


NORTH RAILING
(Looking South)

Note: All reinforcing bar marks shall be prefixed RA.


Note: The deflection joints in the railing may be either 1/4" gray sponge rubber or 1/4" gray cellular polyvinyl chloride (PVC) sponge. Either material shall meet the requirements of AASHTO M-153, Type 1, except the density of the (PVC) sponge shall be not less than 20 lb. per cu. ft.

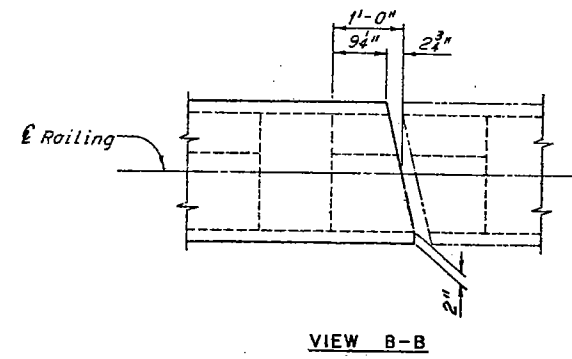


VIEW B-B

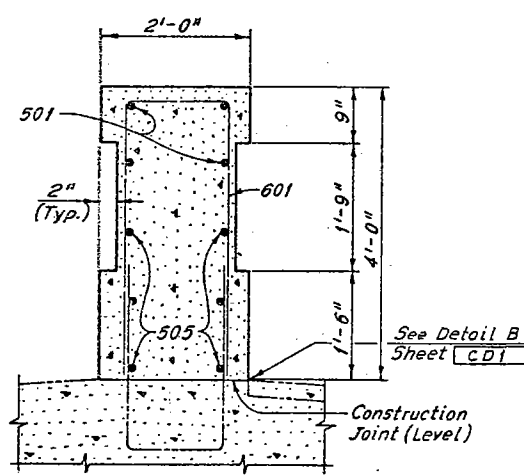

SECTION A-A

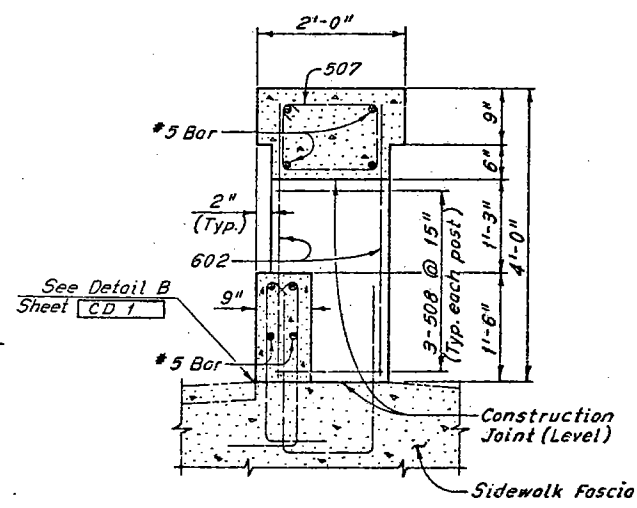


TYPICAL RAILING SECTION

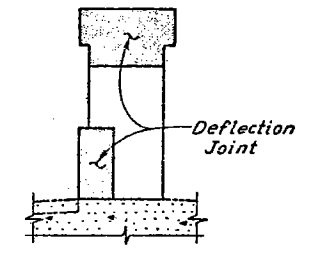

DEFLECTION JOINT DETAIL

MARK	NO.	LENGTH	TYPE	WEIGHT (LBS)
RA 501	12	11'-3"	Str.	141
RA 502	112	5'-6"	Str.	643
RA 503	16	11'-6"	Str.	192
RA 504	12	14'-6"	Str.	181
RA 505	6	3'-9"	Str.	24
RA 506	4	8'-9"	Str.	37
RA 507	124	5'-2"	109	668
RA 508	156	4'-8"	109	759
RA 509	4	14'-3"	Str.	59
RA 601	5	8'-6"	105	64
RA 602	208	3'-9"	Str.	1172
TOTAL WEIGHT =				3940

BENDING DIAGRAMS

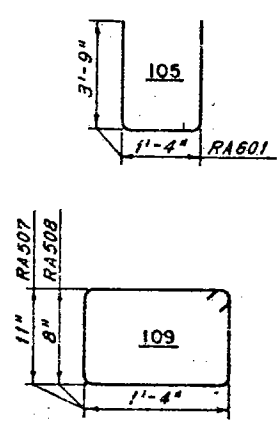

Notes:
Payment for the railing shall be made at the contract unit price bid for Items 517, Railing, As Per Plan. Payment length shall be the overall length of the railings. Railing expansion joint and deflection joint material and all reinforcing steel that does not extend into the sidewalk shall be included with Item 517 for payment. Reinforcing steel extending from the sidewalk is included with Item 509, Reinforcing Steel, for payment. Railings shall be placed in alternate sections by the use of bulkheads. Closing sections shall be placed after removal of bulkheads and after placement of sponge filler. The filler shall be attached to the face of the concrete on one side, flush with the surface of concrete and exposed edges shall be free of mortar.

The following abbreviations are used:
e.f. = each face n.f. = near face
Typ. = typical f.f. = far face

HNTB BRIDGE NO. 4

HOWARD, NEEDLES, TAMMEN & BERGENDOFF
CONSULTING ENGINEERS
CLEVELAND

HNTB

NORTH RAILING DETAILS

REHABILITATION OF THE
CARNEGIE AVENUE GRADE SEPARATION STRUCTURE
(S.R.10 OVER THE CLEVELAND UNION TERMINALS CO.
AND THE REGIONAL TRANSIT AUTHORITY)
BR. NO. CUY. -10-1685 STA. 57+29.72
CUYAHOGA COUNTY STA. 58+85.70 OH:O



DRAWN	TRACED	CHECKED	REVIEWED	REVISED
RA 5	DLR	CKS		
DATE 11-76	DATE 4-78	DATE 9-78	DATE	

SHEET 29/37

FHWA REGION	STATE	PROJECT
5	OHIO	

177
185

CUYAHOGA COUNTY
CUY-10-16.23

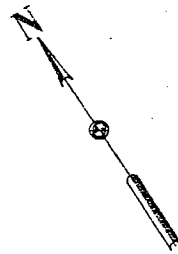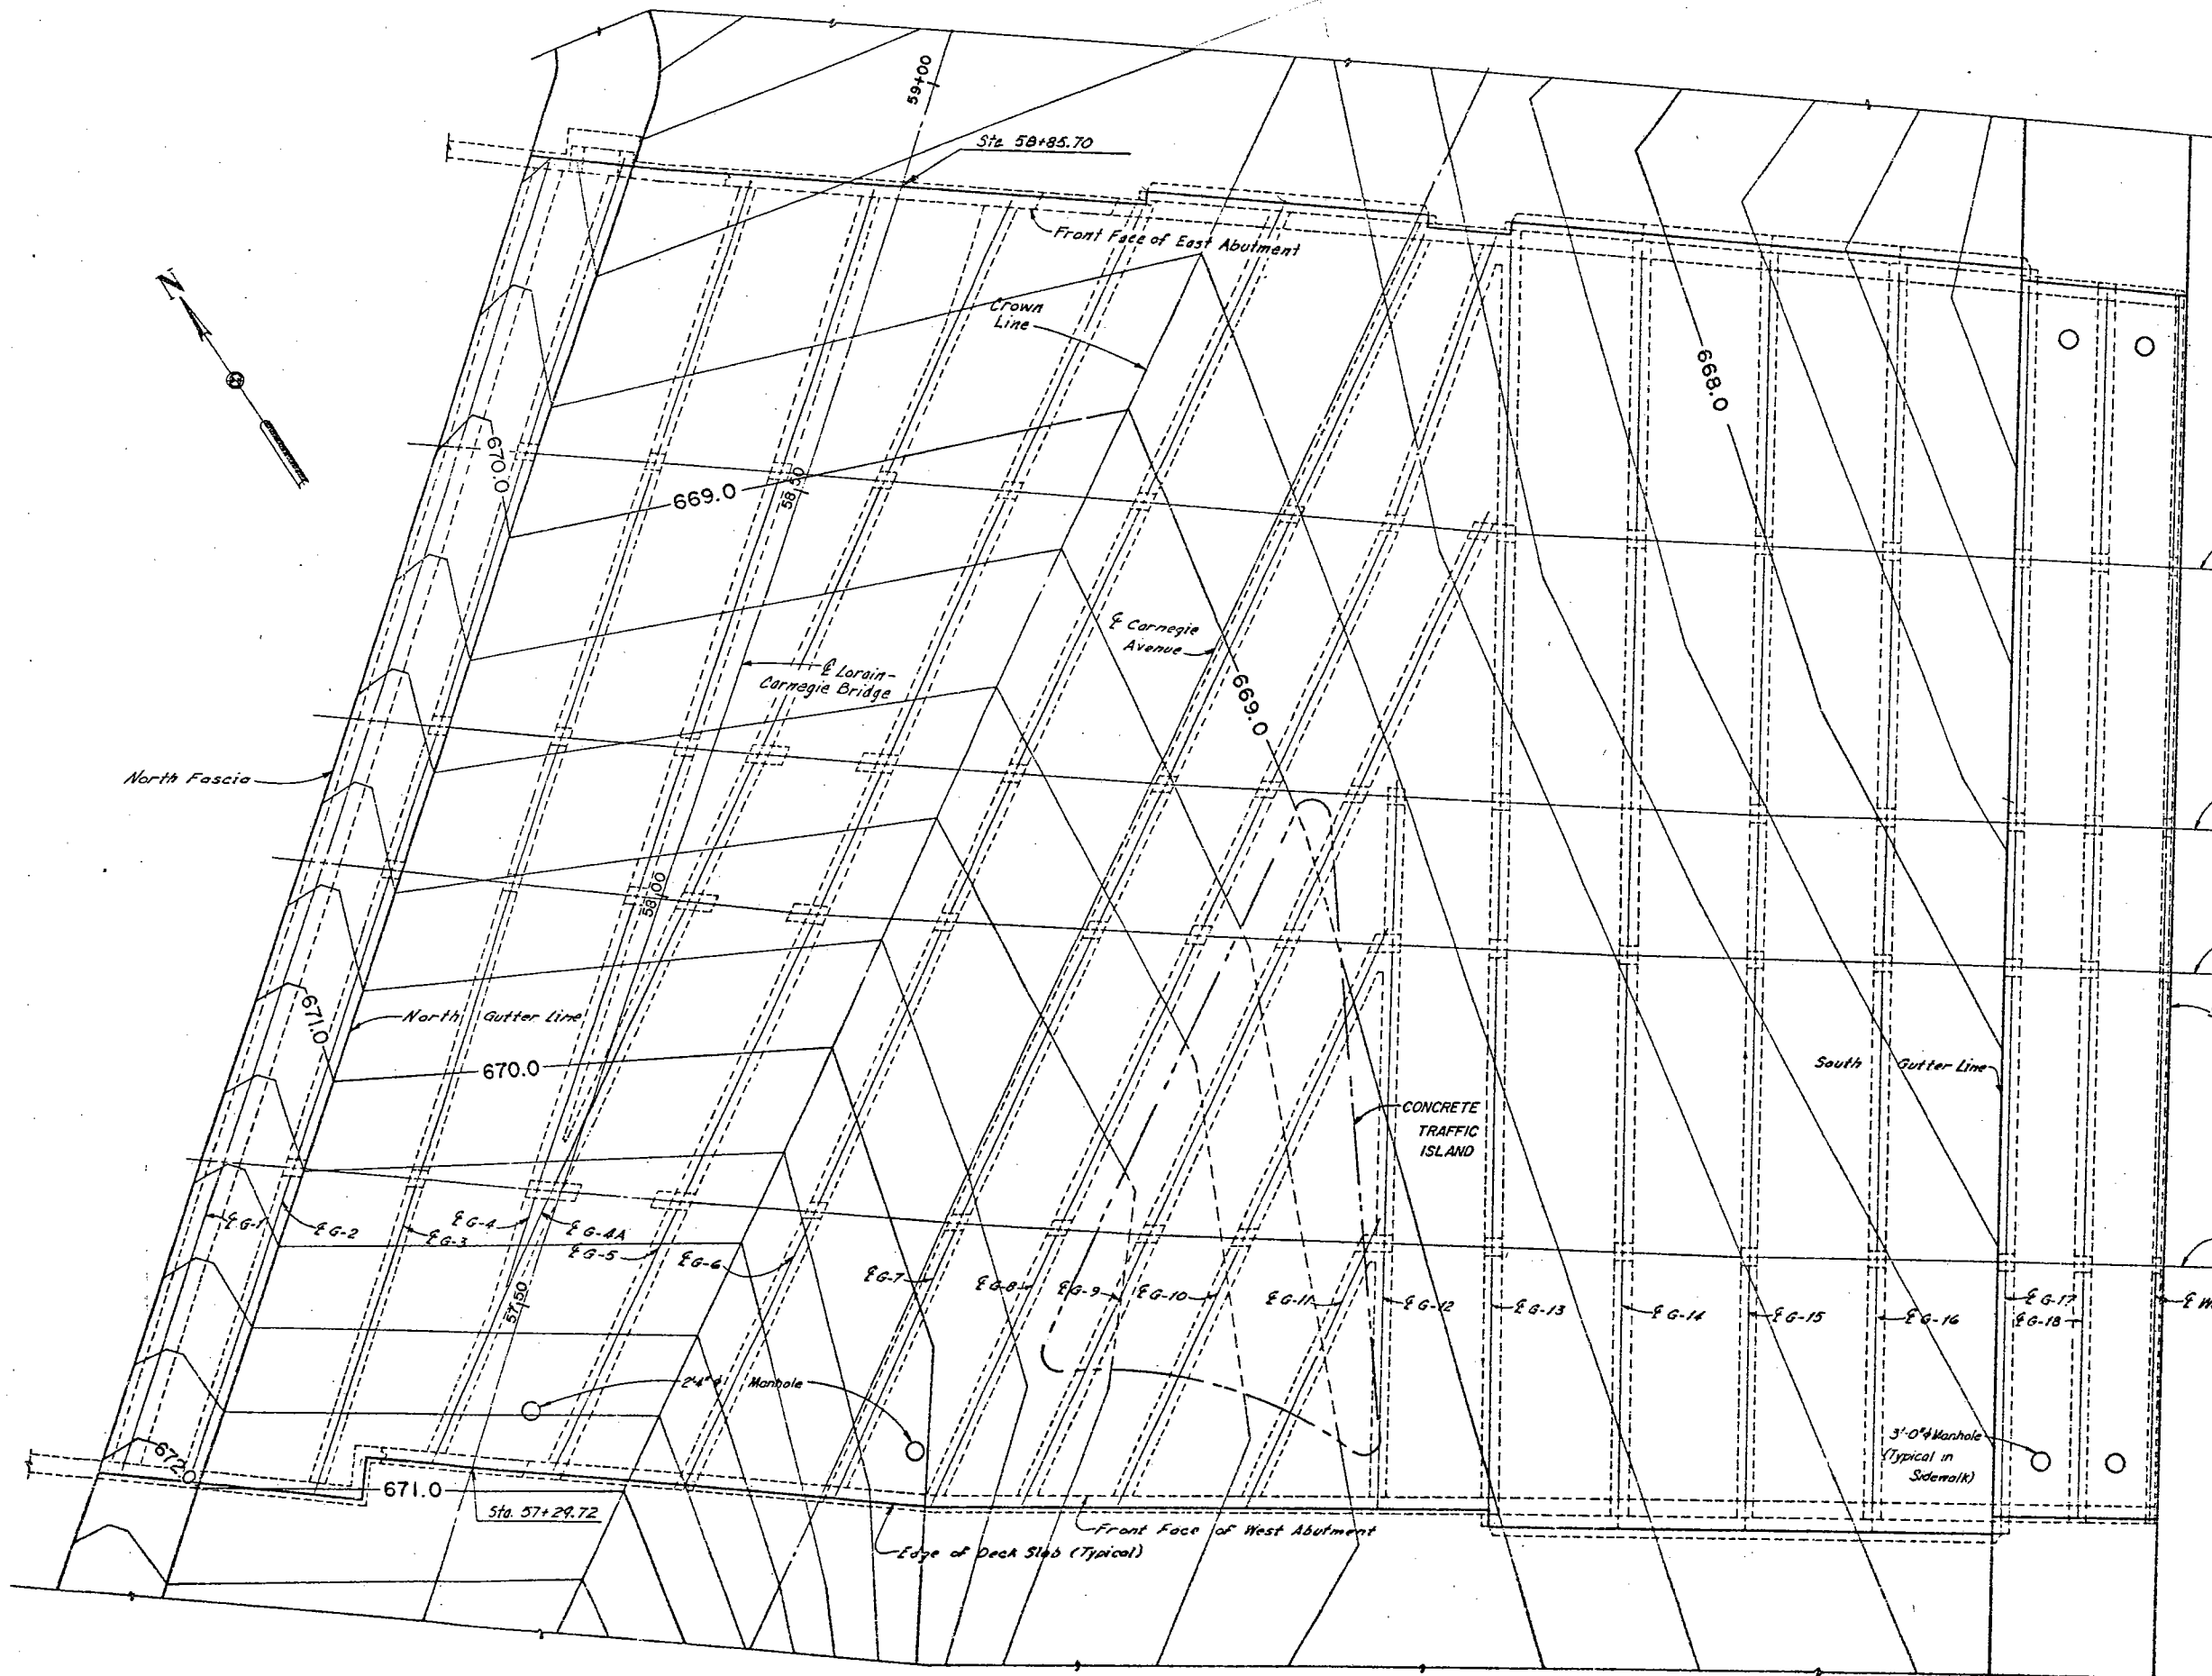

Note:
Contours are shown at top of the asphalt concrete surface course. For details of Concrete Traffic Island see Roadway Plans

10 5 0 5 10
SCALE IN FEET

CONTOUR PLAN

HNTB BRIDGE NO. 4

HOWARD, NEEDLES, TAMMEN & BERGENDOFF
CONSULTING ENGINEERS
CLEVELAND

HNTB

CONTOUR PLAN


REHABILITATION OF THE
CARNEGIE AVENUE GRADE SEPARATION STRUCTURE
(SR 10 OVER THE CLEVELAND UNION TERMINALS CO.
AND THE REGIONAL TRANSIT AUTHORITY)
BR. NO. CUY.-10-1685 STA. 57+29.72
CUYAHOGA COUNTY STA. 58+85.70 OHIO

DRAWN 80	CHECKED 104	DATE 9-25-20	REVIEWED R.S.	DATE 9-18-20	REVISED
					SHEET 30/31


ESTIMATED REPAIR QUANTITIES

LOCATION	PCS		LOCATION	REPAIR OF CRACKS		LOCATION	PCS		LOCATION	REPAIR OF CRACKS	
	SQ. FT.	LN. FT.		SQ. FT.	LN. FT.		SQ. FT.	LN. FT.		SQ. FT.	LN. FT.
PIERS											
			4-15	1	-	4-1	-	-	4-3	-	4
1	34	188	4-16	-	-	4-2	-	-	4-4	-	-
2	99	114	4-17	-	-	4-3	1	-	4-4A	-	-
3	75	114	4-18	68	-	4-4	-	-	4-5	-	-
4	311	69				4-4A	-	-	4-6	279	-
			5-1	20	-	4-5	-	-	4-7	-	-
			5-2	74	-	4-6	7	-	4-8	40	-
STRUTS											
			5-3	-	2	4-7	-	-	4-9	-	-
1-1	-	-	5-4	4	-	4-8	-	-	4-13	-	-
1-2	2	-	5-5	65	-	4-9	-	-	4-14	-	-
1-3	11	-	5-4B	86	-	4-13	-	-	4-15	-	-
1-4	2	-	5-5	-	-	4-14	-	-	4-16	4	-
1-5	-	-	5-6	97	9	4-15	-	-	4-17	18	-
1-5	20	-	5-7	12	-	4-16	-	-	4-18	11	-
1-7	-	-	5-8	8	-	4-17	-	-			
1-8	-	-	5-13	11	-	4-18	-	-	5-1	206	-
1-9	39	-	5-14	-	-				5-2	396	-
1-10	-	-	5-15	-	-				5-3	-	-
1-11	-	-	5-16	-	-	GIRDERS			5-4	6	-
1-12	-	-	5-17	65	-	1-1	48	24	5-4A	-	-
1-13	-	-	5-18	25	-	1-2	75	-	5-5	33	-
1-14	-	-				1-3	19	6	5-6	74	-
1-15	1	-				1-4	1	-	5-7	7	-
1-16	7	-	COLUMNS			1-5	2	6	5-8	-	-
1-17	-	-	1-1	1	-	1-6	132	8	5-13	2	-
1-18	13	-	1-2	18	13	1-7	-	-	5-14	-	-
			1-3	2	-	1-8	72	7	5-15	-	-
2-1	4	-	1-4	-	-	1-9	40	6	5-16	1	-
2-2	44	-	1-5	-	-	1-10	1	-	5-17	132	-
2-3	1	-	1-6	-	-	1-11	-	-	5-18	18	-
2-4	-	-	1-7	-	-	1-12	-	-			
2-4A	1	-	1-8	-	-	1-13	6	-			
2-5	1	-	1-9	1	-	1-14	-	-	ABUTMENTS AND WINGWALLS		
2-6	14	-	1-10	1	-	1-15	-	-	EAST	2297	253
2-7	-	-	1-11	1	-	1-16	-	-	WEST	543	196
2-8	-	-	1-13	1	-	1-17	79	-			
2-9	1	-	1-14	-	-	1-18	77	51			
2-10	-	-	1-15	-	-						
			1-16	-	-	2-1	18	2	UTILITY CHAMBERS		
2-12	-	-	1-17	26	-	2-2	54	-	17-18	1,265	-
2-13	-	-	1-18	6	13	2-3	-	13	7-8	7	-
2-14	-	-				2-4	1	-	4-5	567	-
2-15	-	-	2-1	-	-	2-4A	2	-	At 2	539	24
2-16	1	-	2-2	-	-	2-5	1	-			
2-17	20	1	2-3	-	-	2-6	190	-			
2-18	70	6	2-4	1	-	2-7	6	-	GRAND TOTAL	10,002	1,237
			2-4A	2	-	2-8	11	-			
			2-5	-	-	2-9	13	-			
3-1	-	-	2-6	6	-	2-10	7	-			
3-2	-	6	2-7	1	-	2-12	-	-			
3-3	1	2	2-8	-	-	2-13	1	-			
3-4	2	2	2-9	-	-	2-14	3	-			
3-4A	2	-	2-10	-	-	2-15	-	-			
3-5	1	-	2-13	-	-	2-16	8	-			
3-6	65	-	2-14	-	-	2-17	80	22			
3-7	1	-	2-15	1	-	2-18	86	55			
3-8	-	-	2-16	-	-						
3-9	1	-	2-17	45	-	3-1	54	-			
3-12	-	-	2-18	1	-	3-2	158	-			
3-13	-	-				3-3	-	-			
3-14	-	1				3-4	-	-			
3-15	-	-	3-1	4	-	3-4A	-	-			
3-16	-	-	3-2	2	-						
3-17	19	-	3-3	-	2	3-5	8	-			
3-18	-	-	3-4	-	-	3-5	95	-			
			3-4A	1	-	3-7	-	-			
4-1	-	-	3-5	-	-	3-8	20	-			
4-2	-	-	3-6	-	-	3-9	-	-			
4-3	-	1	3-7	-	-	3-12	1	-			
4-4	6	17	3-8	-	-	3-13	1	-			
4-4A	6	-	3-9	-	-	3-14	-	-			
4-5	1	-	3-12	-	-	3-15	-	-			
4-6	58	-	3-13	-	-	3-16	7	-			
4-7	1	-	3-14	-	-	3-17	92	-			
4-8	-	-	3-15	-	-	3-18	40	-			
4-9	6	-	3-16	-	-						
4-13	2	-	3-17	-	-	4-1	304	-			
4-14	-	-	3-18	-	-	4-2	145	-			


Note:
The 8" steel pipe shall be placed to clear vertical reinforcement.

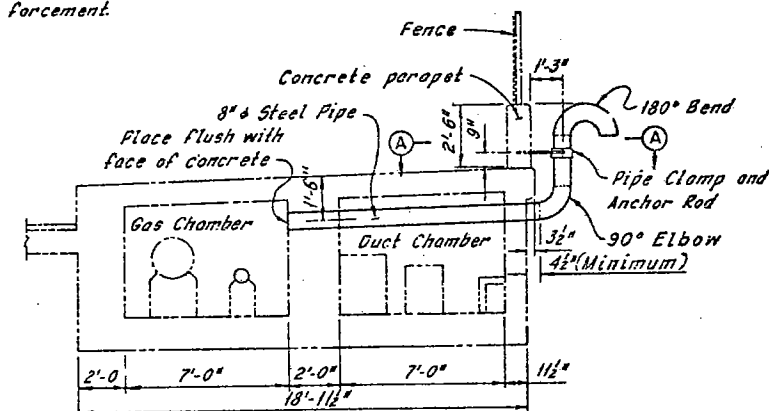

TYPICAL GAS CHAMBER VENT DETAIL

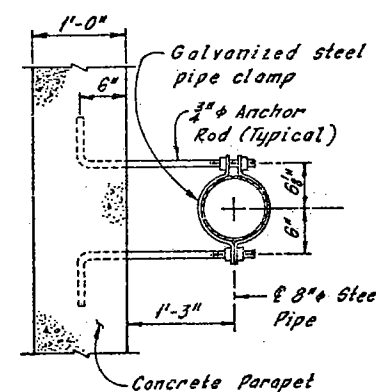

SECTION A-A
(Parapet Reinforcement not shown)

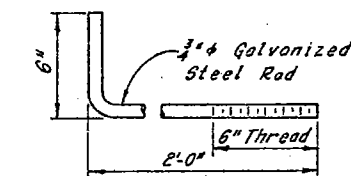

ANCHOR BOLT DETAIL
4 Required

(Threads are to be Unified Standard Series for Basic Major Diameter of 3/4")

Notes:
PCS indicates Patching Concrete Structures.
For Member Identification Plans, see Sheet 2/31.
For location of Gas Chamber Vents, see Sheet 27/31.
Utility Chambers are identified as at or between the girders called out, for the entire length of the Grade Separation.
All costs for venting the gas chamber shall be borne by the gas company, and shall be paid for at the Lump Sum price bid for Item Special, East Ohio Gas Company H. P. Pipe Air Vents, Complete As Per Plan.

HNTB BRIDGE NO. 4


HOWARD, NEEDLES TAMMEN & BERGENDOFF CONSULTING ENGINEERS CLEVELAND **HNTB**

ESTIMATED REPAIR QUANTITIES AND GAS CHAMBER VENT DETAILS


REHABILITATION OF THE CARNEGIE AVENUE GRADE SEPARATION STRUCTURE (S.R.10 OVER THE CLEVELAND UNION TERMINALS CO. AND THE REGIONAL TRANSIT AUTHORITY) BR. NO. CUY-10-1685 STA. 57+29.72 STA. 58+65.70 CUYAHOGA COUNTY OHIO

DRAWN BY BP	TRACED BY RAS	CHECKED BY RAS	REVIEWED BY	REVISED BY
DATE: 2/13/22	DATE: 2/14/22	DATE: 2/14/22	DATE:	DATE:


SHEET 31 / 31

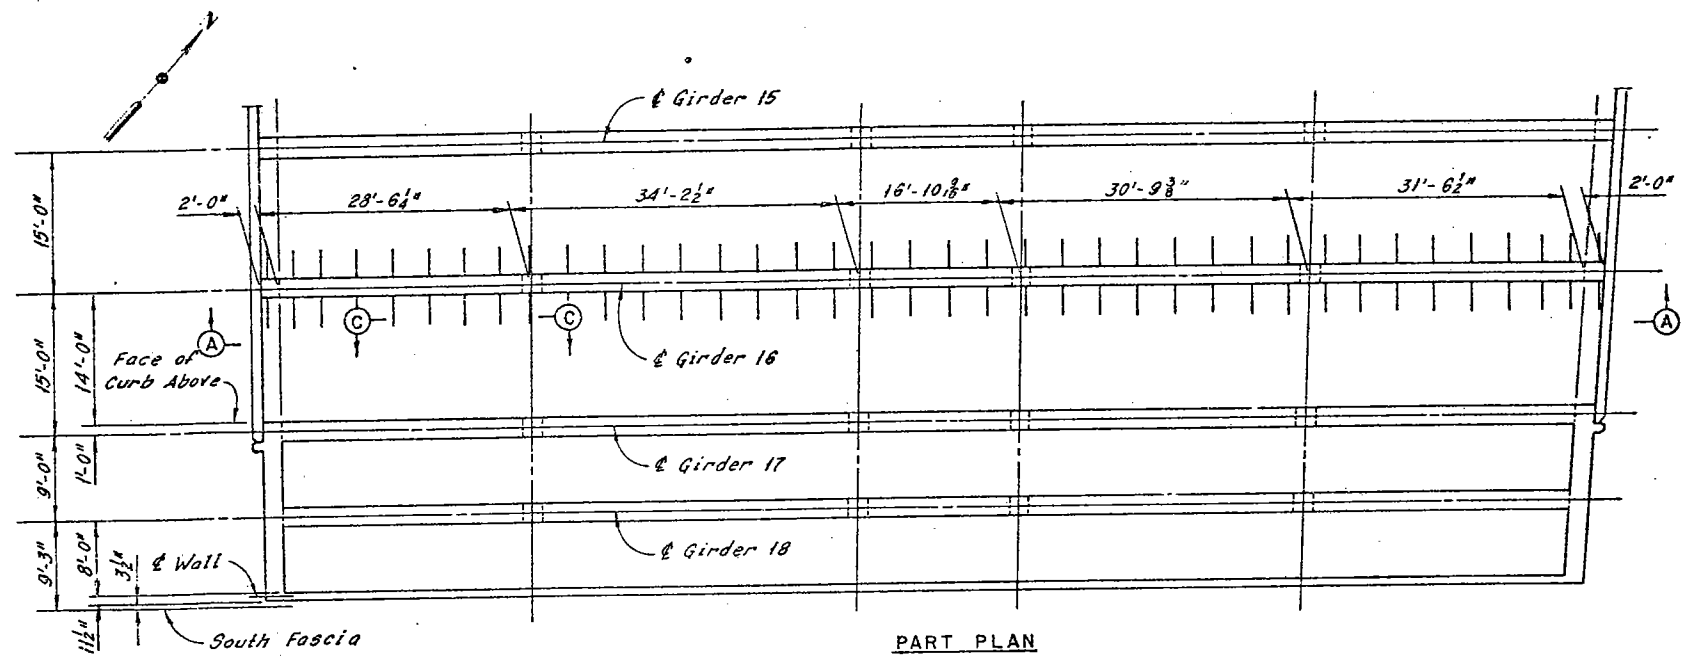

PART PLAN
CARNEGIE AVENUE GRADE
SEPARATION STRUCTURE
(Dimension shown are from original plans)

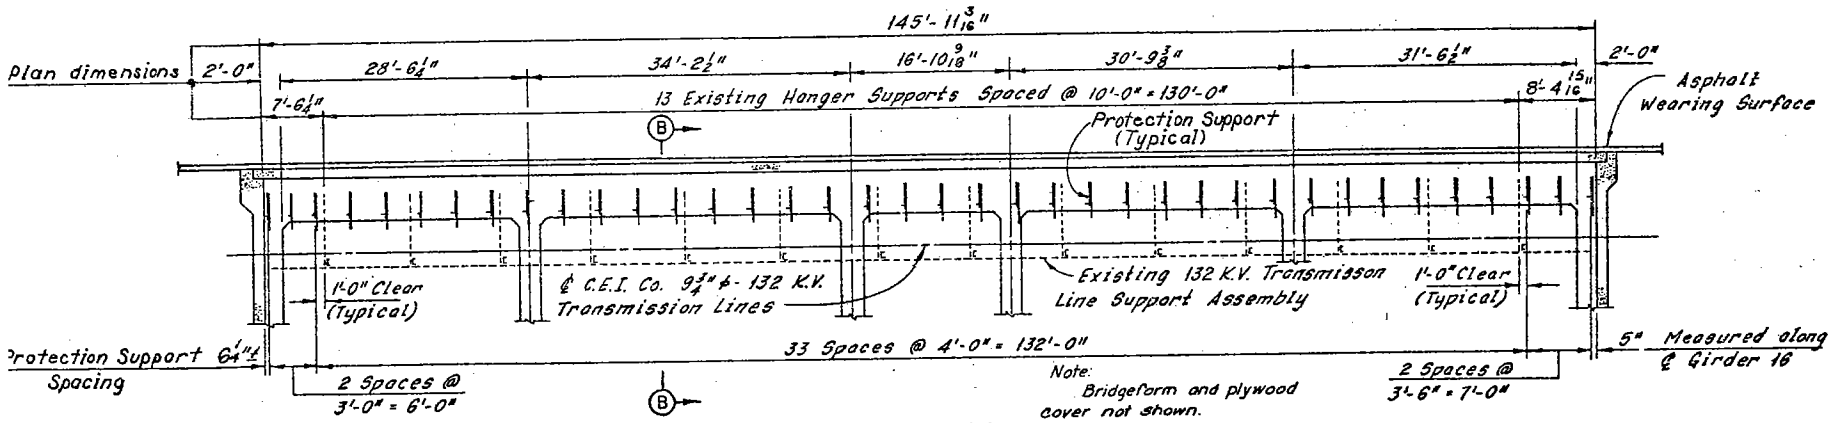


SECTION A-A

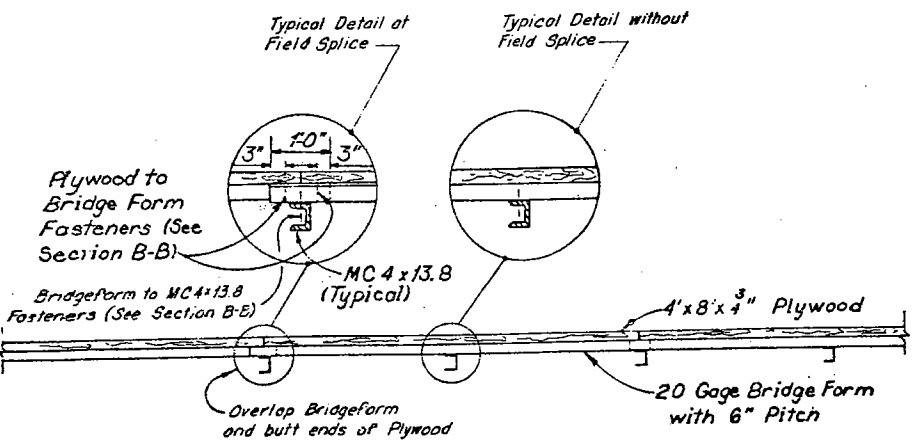

SECTION C-C

Notes:
All structural steel shall be ASTM A572 except as noted. (Approx. 16,000 lbs.)
ASTM A572 shall be given one shop coat of primer as per Article 514, System B.
Bridge form, similar to Bethlehem Bridgeform, shall be ASTM A446, Grade E with the following properties:
Thickness = 20 gage
Pitch = 6 in. Depth = 2 in.
I = .400 in.⁴/ft.
S.M. = 0.372 in.³/ft.
F_y = 80,000 psi
Allowable design stress = 30,000 psi
Wedge anchors shall be equivalent to Phillips Wedge Anchors with a minimum pullout load of 40,600 lbs. and a minimum shear load of 48,660 lbs.
1/2" turned bolts shall be ASTM A307.
All temporary protection at the 132 K.V. Transmission Lines, as per plan, shall be in place prior to concrete deck and girder removal between Girder 15 and Girder 17, and shall remain in place until all required work is complete on the permanent structure between Girder 15 and Girder 17.

1/2" Turned Bolt with two Washers or 4" Wood Screws placed from the underside with one washer, 4 per line on 4' max. centers and as shown in Section C-C (Typical)

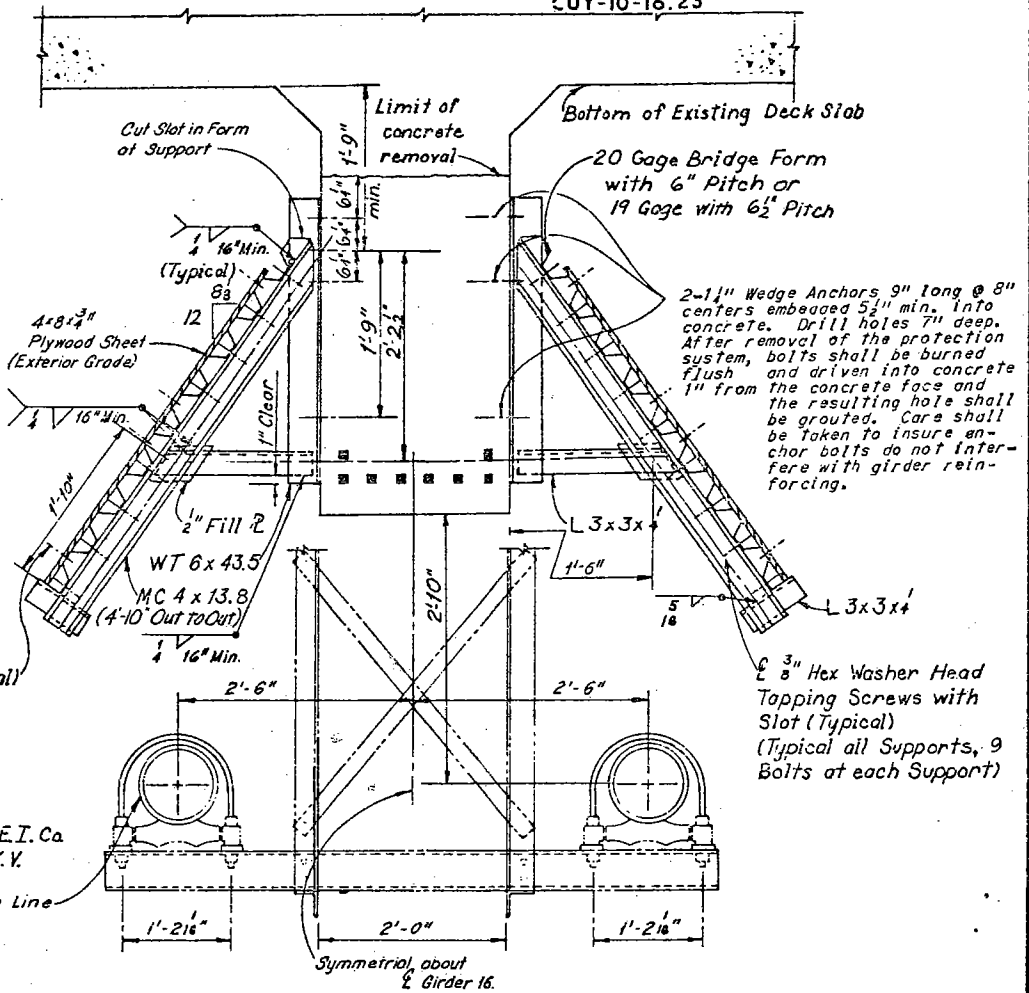

SECTION B-B

Note: The 132 K.V. pipe type cables contain three copper insulated cables and insulating fluid at a nominal 200 psi. The steel pipes and corrosion control covering on the pipes must be protected from any and all damage.

All labor, material and equipment required for the placement and removal of all temporary transmission line protection devices, as per plan, shall be included in the unit price bid for Item Special, Temporary Protection At 132 K.V. Transmission Lines.
Materials used in the protection system shall become the property of the Contractor upon completion of the work, and shall be removed by him from the site.
The Contractor shall assume full responsibility for any damage to the 132 K.V. lines and its supports, and for damages resulting from damage to these lines. The Contractor shall take extraordinary precautions to insure against any damage to the 132 K.V. lines during erection and removal of the temporary protection system and against concrete dropping between Girders 15 and 17. The protection system is designed only for an accidental occurrence of a 50 lb. block of concrete dropping from the level of the deck. If any concrete pieces drop on the protection system, the Contractor shall cease operations, inspect the protection system and make necessary repairs to the system subject to the approval, prior to resuming operations, by the State of Ohio Project Engineer assigned to implement the contract.

Supporting members have been designed for basic allowable stresses increased 50%. Anchors have been designed for a 1.6 Factor of Safety.
The Contractor or his agents must notify the Cleveland Electric Illuminating Company (623-1350, Extension 2445) at least 24 hours in advance if any work is to be performed in the vicinity of the two C.E.I. 132 K.V. pipe type cables. The Illuminating Company will provide a field representative during the time any work is performed near the 132 K.V. cables.

HNTB BRIDGE NO. 4

HOWARD NEEDLES TAMMEN & BERGENOFF CONSULTING ENGINEERS CLEVELAND

HNTB


TEMPORARY PROTECTION FOR THE 132 K.V. TRANSMISSION LINES

REHABILITATION OF THE CARNEGIE AVENUE GRADE SEPARATION STRUCTURE (S.R.10 OVER THE CLEVELAND UNION TERMINALS CO. AND THE REGIONAL TRANSIT AUTHORITY)

BR NO. CUY.-10-1685 STA. 57+29.72
CUYAHOGA COUNTY OHIO STA. 58+85.70


DRAWN B.M.P.	TRACED M.M.P.	CHECKED J.H.S.F.S.	REVIEWED	REVISED
DATE 3-16-79	DATE 3-30-79	DATE 4-12-79	DATE	DATE

SHEET 31A/31

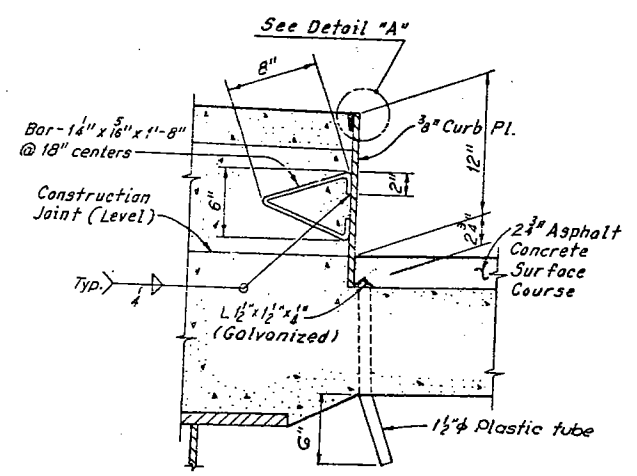


SIDWALK CURB PLATE AND
SUBDRAINAGE FOR SURFACE COURSE DETAIL

For location of drain tubes,
see General Note 24, Sheet GN.5.

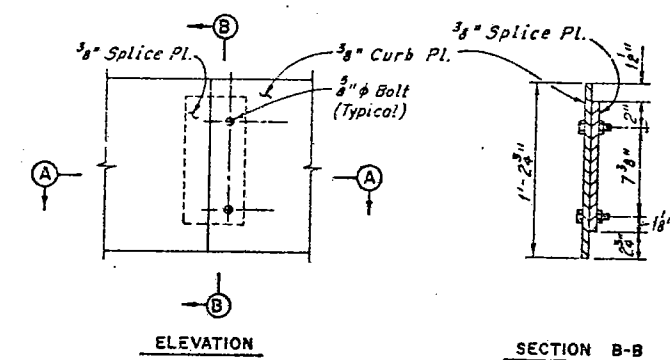


ELEVATION SECTION B-B

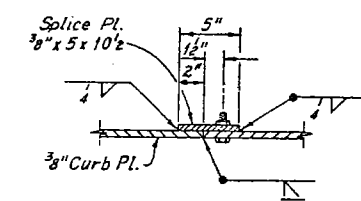


SECTION A-A
CURB PLATE SPLICE DETAIL


Note:
Remove bolts after field
welds have been completed
Plug weld holes flush with
curb plate.

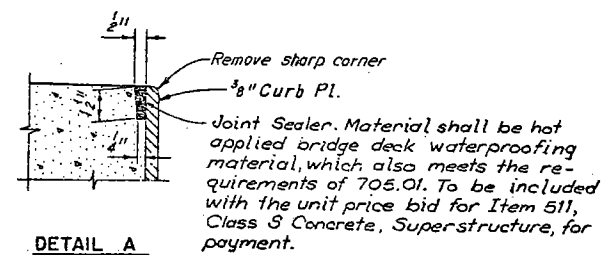


DETAIL A

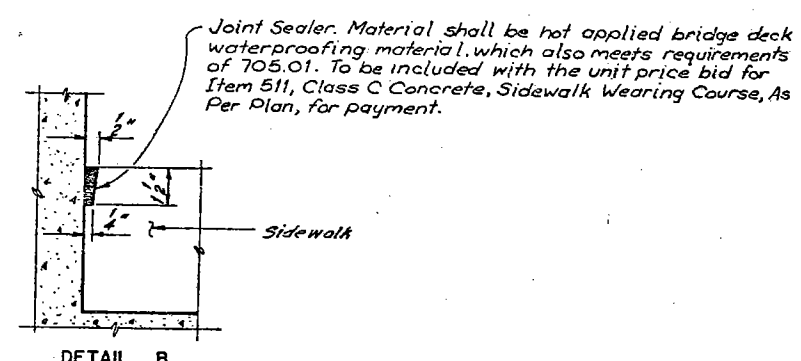

DETAIL B

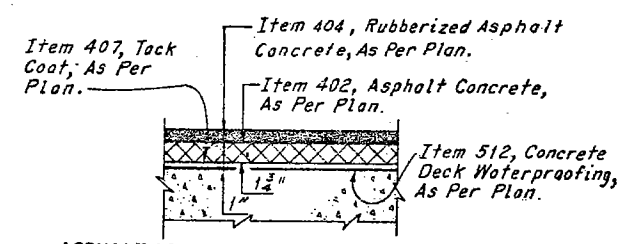

ASPHALT CONCRETE SURFACE COURSE DETAIL

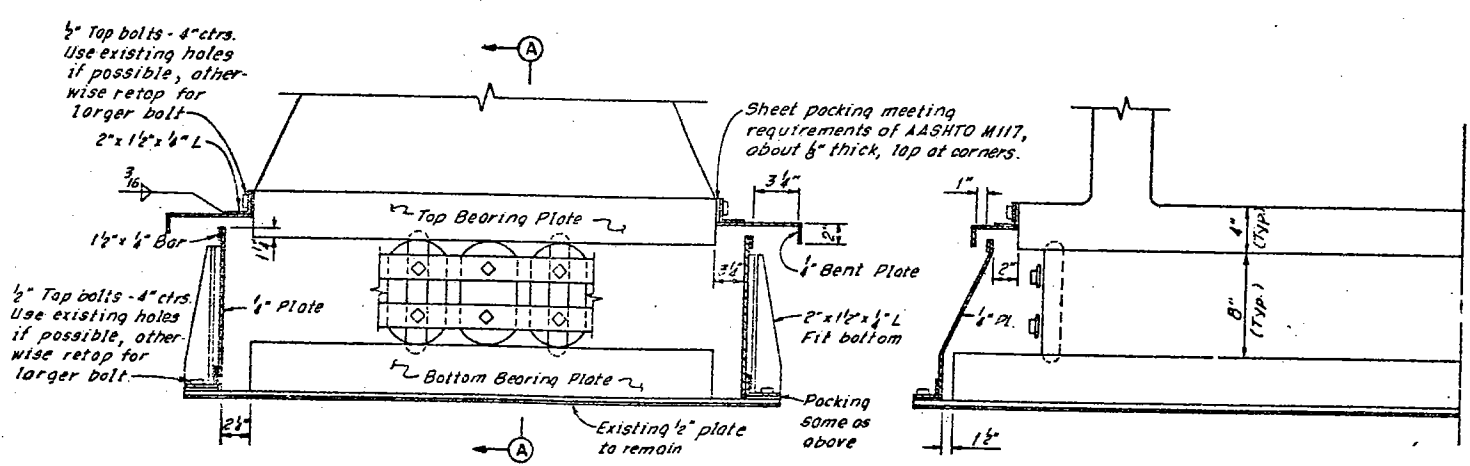

SECTION THROUGH GREASE BOX

SECTION A-A

EXPANSION BEARING GREASE BOX REPLACEMENT DETAILS
All new metal parts shall be ASTM A588

LOCATION	TOP PLATE		BOTTOM PLATE		NUMBER OF GREASE BOXES REQUIRED	BASE PLATE THICKNESS
	LONG.	TRANS.	LONG.	TRANS.		
West Pylon - Exterior	3'-4"	2'-8"	3'-6"	3'-5"	2	3 1/2"
West Pylon - Interior	3'-4"	3'-1"	3'-6"	3'-11"	2	4"
East Abutment - Exterior	3'-4"	3'-3"	3'-6"	3'-11 1/2"	2	4"
East Abutment - Center	2'-7"	2'-8"	2'-7"	3'-5"	1	3 1/2"

Note:
Curb plate, curb plate anchors and splice plates shall be ASTM A36 Steel.

HNTB BRIDGE NO. 3 AND 4

HOWARD, NEEDLES, TAMMEN & BERGENDOFF CONSULTING ENGINEERS CLEVELAND

HNTB

COMMON DETAILS

CUYAHOGA COUNTY OHIO

DRAWN CAP	CHECKED EES	DATE 12/16/10	REVIEWED RAS	DATE 12/20/10	REVISION
--------------	----------------	------------------	-----------------	------------------	----------

SHEET CD / 1

MARK	NO.	LENGTH	TYPE	SER. INCR.	WEIGHT (LBS.)
EAST ABUTMENT					
EA401	52	29'-0"	Str		2522
EA402	42	10'-6"	Str		237
EA501	41	3'-2"	105		335
EA502	4	31'-3"	Str		330
EA503	264	3'-9"	163		4333
EA504	37	6'-0"	Str		222
EA505	13	18'-0"	Str		284
EA601	118	12'-6"	100		2215
EA602	76	6'-0"	105		635
Total Weight (Uncoated)					2,252
Total Weight (Epoxy Coated)					3,525
BOX AT E. ABUTMENT					
BA01	25	21'-9"	Str		378
BS01	96	3'-9"	163		325
BS601	46	12'-6"	100		854
BS602	28	6'-0"	105		252
Total Weight (Uncoated)					627
Total Weight (Epoxy Coated)					1,242
WEST PYLON					
WP401	137	27'-6"	Str		2517
WP402	12	2'-9"	Str		22
WP501	54	15'-0"	109		545
WP502	4	26'-6"	Str		311
WP503	4	26'-9"	Str		312
WP504	12	23'-0"	Str		228
WP505	16	36'-3"	Str		305
WP506	205	13'-0"	109		2793
WP507	24	2'-9"	Str		59
WP601	82	12'-9"	Str		1579
WP602	82	27'-9"	Str		3418
WP603	82	23'-0"	Str		2853
WP604	41	29'-0"	Str		1786
WP605	4	5'-8"	108		34
WP606	4	5'-11"	109		36
WP607	52	3'-9"	105		293
WP608	52	5'-7"	105		280
WP609	52	7'-2"	100		560
WP610	16	9'-7"	100		250
WP611	12	7'-10"	105		147
WP612	12	8'-4"	105		250
WP801	111	28'-10"	100		2545
WP1001	10	28'-3"	100		3216
WP1002	8	28'-6"	100		289
P1101	28	24'-3"	Str		3508
P1102	14	31'-6"	Str		2343
P1103	8	20'-0"	Str		257
P1104	28	13'-9"	Str		2546
P1105	28	31'-0"	Str		4632
Total Weight (Uncoated)					24,846
Total Weight (Epoxy Coated)					32,348
PIER 7					
PA01	4	16'-0"	Str		43
PA02	4	23'-6"	Str		63
PA03	2	16'-9"	Str		22
PA04	1	16'-6"	Str		13
PA05	7	13'-0"	Str		81
PA06	3	7'-4"	104		35
PA07	3	15'-7"	126		31
PA08	2	9'-7"	104		33
PA09	4	6'-6"	Str		17
PA10	3	4'-4"	104		9
Total Weight (Uncoated)					285

MARK	NO.	LENGTH	TYPE	SER. INCR.	WEIGHT (LBS.)
PIER 10					
10P401	10	19'-0"	Str		127
10P402	4	23'-5"	Str		63
10P403	1	9'-2"	Str		6
10P404	1	8'-5"	Str		6
10P405	1	8'-3"	Str		6
10P406	2	16'-0"	Str		22
10P407	1	16'-5"	Str		11
10P408	2	18'-5"	Str		25
10P409	6	4'-5"	Str		18
10P410	7	3'-11"	104		18
10P411	3	7'-3"	104		15
10P412	4	13'-5"	104		36
10P413	2	15'-10"	104		21
10P414	3	21'-3"	126		43
10P415	1	6'-0"	Str		4
10P416	2	5'-0"	Str		7
10P417	6	6'-2"	104		25
10P418	6	6'-5"	104		26
Total Weight =					479
PIER 12					
12P401	36	16'-6"	Str		397
12P402	2	4'-0"	Str		5
12P403	2	3'-3"	Str		4
12P404	2	2'-9"	Str		4
12P405	2	11'-5"	Str		15
12P406	1	11'-3"	Str		8
12P407	20	7'-4"	104		98
12P408	4	18'-7"	105		50
12P409	2	25'-0"	105		33
12P410	2	5'-6"	Str		7
12411	2	6'-0"	Str		8
Total Weight =					629
SLAB - W. L.E. SPAN					
SA401	412	12'-0"	Str		3303
SA402	91	13'-6"	Str		821
SA403	82	30'-0"	101		1643
SA404	440	30'-0"	Str		8818
SA405	82	16'-0"	101		876
SA406	14	28'-9"	Str		269
SA407	28	16'-3"	Str		304
SA408	103	13'-0"	Str		894
SA501	116	7'-10"	155		948
SA502	32	30'-0"	Str		1001
SA503	8	17'-6"	Str		146
SA504	62	7'-8"	155		496
SA505	600	3'-6"	163		2190
SA506	24	2'-9"	Str		69
SA601	490	29'-2"	101		21466
SA602	295	28'-9"	Str		12739
SA603	322	31'-9"	Str		15356
SA604	295	22'-0"	Str		9748
SA605	320	30'-0"	Str		14419
SA606	80	18'-0"	Str		2163
SA607	246	12'-5"	100		4619
SA608	299	3'-0"	105		1343
SA609	298	3'-2"	105		1418
SA610	176	6'-0"	105		1586
SA611	18	24'-3"	101		667
SA612	18	27'-3"	Str		737
SA613	24	24'-2"	101		871
SA614	24	26'-9"	Str		964
SA615	59	23'-6"	101		2047
SA616	58	26'-3"	Str		2287
SA617	64	28'-3"	Str		2812
SA618	10	8'-0"	100		120
SA619	12	7'-6"	100		135
SA620	30	6'-9"	100		304
SA621	168	29'-6"	Str		7444
SA622	12	4'-9"	105		84
SA623	12	8'-4"	105		150
SA801	40	30'-0"	Str		3204
SA802	10	22'-6"	Str		601
Total Weight (Uncoated)					67,823
Total Weight (Epoxy Coated)					61,239










MARK	NO.	LENGTH	TYPE	SER. INCR.	WEIGHT (LBS.)
SLAB - SPAN 1					
SB401	103	13'-0"	Str		294
SB402	103	24'-6"	Str		1686
SB403	613	12'-0"	Str		4954
SB404	82	30'-0"	101		1643
SB405	688	30'-0"	Str		13788
SB406	82	12'-9"	101		698
SB407	28	12'-3"	Str		229
SB501	290	7'-10"	155		2369
SB502	8	23'-6"	Str		196
SB503	4	11'-6"	Str		48
SB504	28	21'-9"	Str		635
SB505	28	30'-0"	Str		876
SB506	4	14'-3"	Str		59
SB507	980	3'-6"	163		3577
SB601	794	29'-2"	101		34784
SB602	397	28'-9"	Str		17143
SB603	794	31'-9"	Str		37965
SB604	397	22'-0"	Str		13118
SB605	560	30'-0"	Str		25234
SB606	80	14'-6"	Str		1742
SB607	400	12'-6"	100		7510
SB608	400	3'-0"	105		1802
SB609	400	3'-2"	105		1903
SB610	288	6'-0"	105		2595
SB801	8	25'-4"	100		541
SB802	4	13'-5"	100		143
SB803	28	23'-7"	100		1763
SB804	42	30'-0"	Str		3364
SB805	6	23'-0"	Str		368
Total Weight (Uncoated)					96,398
Total Weight (Epoxy Coated)					85,131
SLAB - SPAN 2					
SC401	206	13'-0"	Str		1789
SC402	82	30'-0"	101		1643
SC403	138	30'-0"	Str		2766
SC404	82	14'-9"	101		808
SC405	28	13'-9"	Str		257
SC501	96	7'-10"	155		784
SC502	12	23'-6"	Str		294
SC503	8	30'-0"	Str		250
SC504	4	14'-6"	Str		61
SC505	324	3'-6"	163		1183
SC601	268	29'-2"	101		11741
SC602	134	28'-9"	Str		5786
SC603	268	31'-9"	Str		12781
SC604	134	22'-0"	Str		4428
SC605	160	30'-0"	Str		7210
SC606	80	14'-9"	Str		1772
SC607	134	12'-6"	100		2516
SC608	134	3'-0"	105		604
SC609	134	3'-2"	105		637
SC610	96	6'-0"	105		865
SC801	12	30'-0"	Str		961
SC802	6	17'-0"	Str		272
SC803	12	25'-4"	100		812
Total Weight (Uncoated)					32,310
Total Weight (Epoxy Coated)					27,910

*Denotes Epoxy Coated Reinforcing Steel.

FHWA REGION	STATE	PROJECT
5	OHIO	

CUYAHOGA COUNTY
CUY-10-16.23

181
185

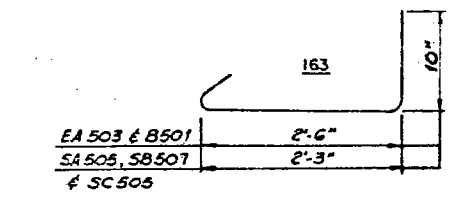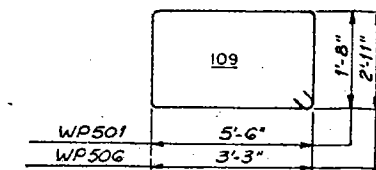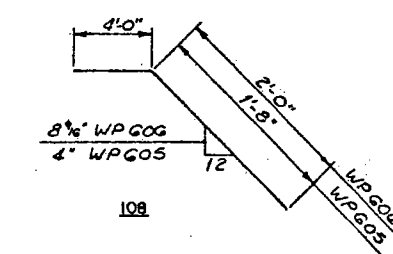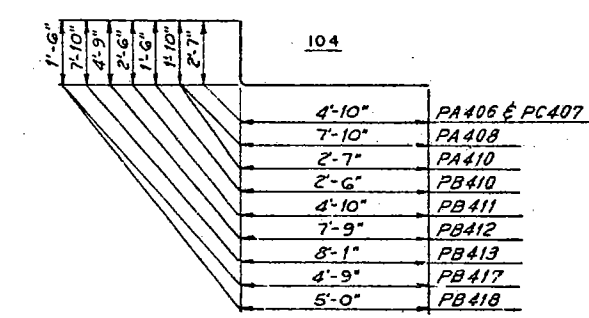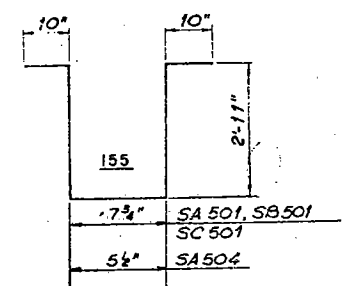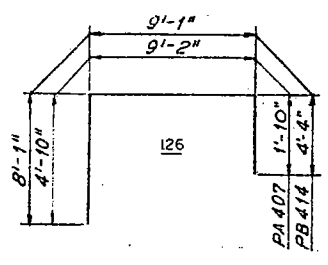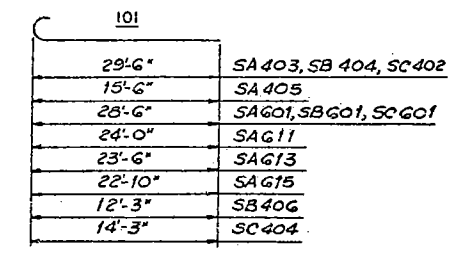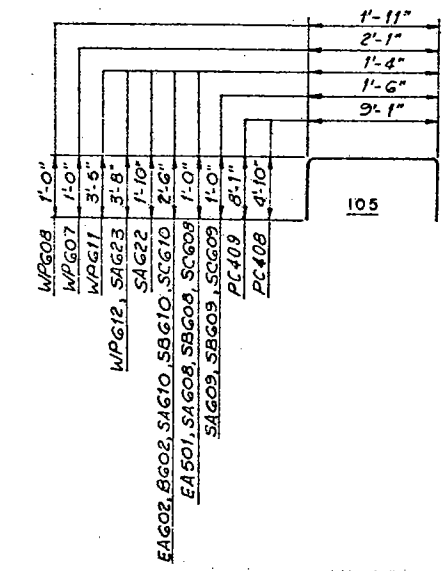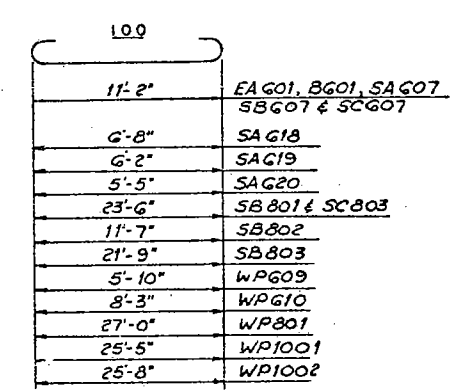

VOID 3/19/84

H.N.T.B. BRIDGE NO. 3

HOWARD NEEDLES TAMMEN & BERGENDOFF CONSULTING ENGINEERS CLEVELAND **HNTB**

REINFORCEMENT SCHEDULE

REHABILITATION OF THE LORAIN-CARNEGIE BRIDGE (S.R. 10 OVER THE CUYAHOGA RIVER)
BR. NO. CUY.-10-1618 STA. 22+19.19
CUYAHOGA COUNTY, OHIO STA. 55+04.56








DATE: 12/22/83
CHECKED: D.L.R.
DATE: 12/22/83
REVIEWED: DATE: SHEET: R/1

MARK	NO	LENGTH	TYPE	SER INCR.	WEIGHT (LBS.)
EAST ABUTMENT					
*EA401	52	29'-9"	Str		1033
*EA402	48	10'-6"	Str		337
EA501	41	3'-2"	105		135
EA502	4	31'-3"	Str		130
EA503	264	3'-9"	163		1033
EA504	37	6'-0"	Str		232
EA505	13	18'-0"	Str		244
*EA601	118	12'-6"	100		2215
EA602	76	6'-0"	105		595
Total Weight (Uncoated) = 2,459					
* Total Weight (Epoxy Coated) = 3,585					
BOX AT E. ABUTMENT					
*B401	26	21'-9"	Str		378
B501	96	3'-9"	163		375
*B601	46	12'-6"	100		864
B602	28	6'-0"	105		252
Total Weight (Uncoated) = 627					
* Total Weight (Epoxy Coated) = 1,242					
WEST Pylon					
*WP401	127	27'-6"	Str		2517
*WP402	12	2'-9"	Str		22
WP501	42	15'-3"	100		825
WP502	4	26'-6"	Str		111
WP503	4	26'-9"	Str		112
WP504	12	23'-0"	Str		285
WP505	14	36'-3"	Str		435
WP506	206	13'-0"	100		2702
WP507	24	2'-9"	Str		60
*WP601	82	12'-9"	Str		1370
*WP602	82	27'-9"	Str		3410
*WP603	52	21'-0"	Str		2823
WP604	41	20'-0"	Str		1784
WP605	4	5'-9"	100		34
WP606	4	5'-11"	105		32
WP607	52	21'-0"	105		292
WP608	52	21'-0"	105		290
WP609	52	7'-0"	100		560
WP610	14	21'-0"	105		270
WP611	12	7'-0"	105		141
WP612	12	21'-0"	105		150
*WP701	111	29'-0"	100		5545
WP1001	10	28'-3"	100		1216
WP1002	8	28'-5"	100		981
*WP1101	28	24'-3"	Str		3608
*WP1102	12	31'-6"	Str		2327
WP1103	2	20'-0"	Str		840
WP1104	28	11'-0"	Str		1242
WP1105	28	31'-0"	Str		4612
Total Weight (Uncoated) = 52,848					
* Total Weight (Epoxy Coated) = 16,848					

MARK	NO	LENGTH	TYPE	SER INCR.	WEIGHT (LBS.)
PIER 10					
10P401	10	19'-0"	Str		127
10P402	4	23'-6"	Str		63
10P403	1	9'-6"	Str		6
10P404	1	8'-6"	Str		6
10P405	1	8'-3"	Str		6
10P406	2	16'-9"	Str		22
10P407	1	16'-6"	Str		11
10P408	2	18'-6"	Str		25
10P409	6	4'-6"	Str		18
10P410	7	3'-11"	104		18
10P411	3	7'-3"	104		15
10P412	4	13'-5"	124		36
10P413	2	15'-10"	104		21
10P414	3	21'-3"	126		43
10P415	1	6'-0"	Str		4
10P416	2	5'-0"	Str		7
10P417	6	5'-2"	104		25
10P418	6	6'-5"	104		26
Total Weight = 479					
PIER 12					
12P401	35	15'-6"	Str		397
12P402	2	4'-3"	Str		5
12P403	2	3'-3"	Str		4
12P404	2	2'-0"	Str		4
12P405	2	11'-6"	Str		15
12P406	1	11'-3"	Str		8
12P407	1	7'-6"	100		88
12P408	2	18'-7"	105		50
12P409	2	25'-0"	105		33
12P410	2	5'-6"	Str		7
12P411	2	6'-0"	Str		6
Total Weight = 620					

MARK	NO	LENGTH	TYPE	SER INCR.	WEIGHT (LBS.)
SLAB - SPAN 1					
*SB401	103	13'-0"	Str		894
*SB402	103	24'-6"	Str		1686
*SB403	618	12'-0"	Str		4954
*SB404	82	30'-0"	101		1643
*SB405	688	30'-0"	Str		13788
*SB406	82	12'-9"	101		698
*SB407	28	12'-3"	Str		229
SB501	290	7'-10"	155		2369
SB502	8	23'-6"	Str		195
SB503	4	11'-6"	Str		48
SB504	26	21'-9"	Str		635
SB505	28	30'-0"	Str		876
SB506	4	14'-3"	Str		59
SB507	980	3'-6"	163		3577
*SB601	794	1'-9"	101		98
SB603	97	40'"	Str		26,000
SB604	397	3'-8"	Str		2,058
SB605	560	30'-0"	Str		25,234
SB606	80	14'-6"	Str		1742
*SB607	400	12'-6"	100		7510
*SB608	400	3'-0"	105		1802
SB609	400	3'-2"	105		1903
SB610	288	6'-0"	105		2595
SB801	8	25'-4"	100		541
SB802	4	13'-5"	100		143
SB803	28	23'-7"	100		1763
SB804	42	30'-0"	Str		3364
SB805	6	21'-0"	Str		369
Total Weight (Uncoated) = 5,221					
* Total Weight (Epoxy Coated) = 5,413					
SLAB - SPAN 2					
*S401	206	13'-0"	Str		1789
*S402	92	30'-0"	101		1643
*S403	138	30'-0"	Str		2766
*S404	82	14'-9"	101		808
*S405	28	13'-9"	Str		257
S501	96	7'-10"	155		782
S502	12	21'-6"	Str		222
S503	8	20'-3"	Str		250
S504	4	14'-6"	Str		41
S505	324	3'-6"	163		1183
*S406	768	2	101		7208
S407	12	1'-10"	Str		33
S408	12	4'-9"	Str		60
S409	160	30'-0"	Str		7,710
S410	92	14'-3"	Str		1,772
*S411	12	12'-6"	100		2516
S412	144	7'-0"	155		604
S413	144	21'-2"	105		637
S414	96	6'-0"	105		865
S415	72	30'-0"	Str		641
S416	72	17'-0"	Str		172
S417	12	21'-0"	100		72
Total Weight (Uncoated) = 32,02					
* Total Weight (Epoxy Coated) = 32,02					

Denotes Epoxy Coated Reinforcing Steel.

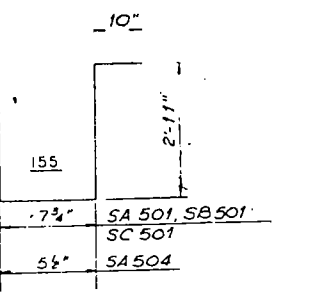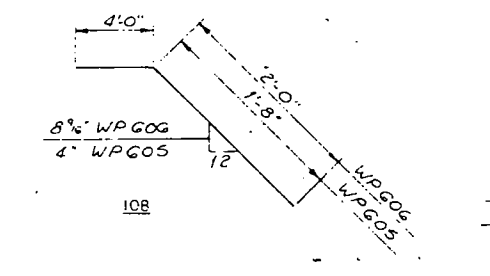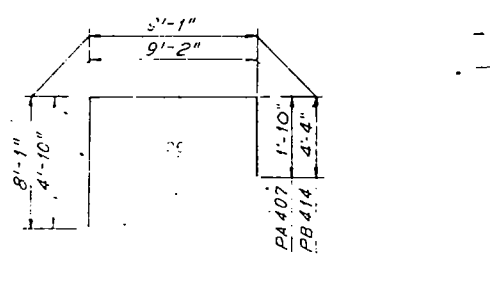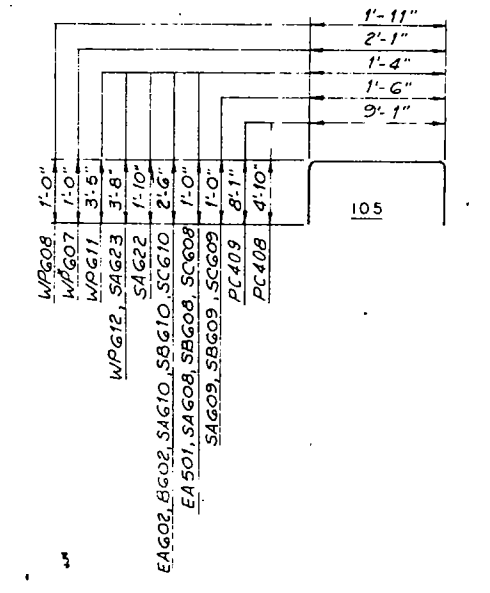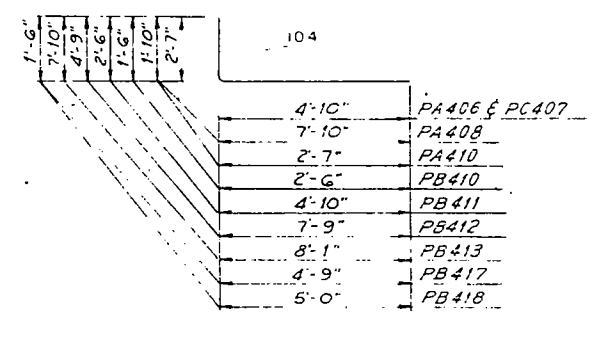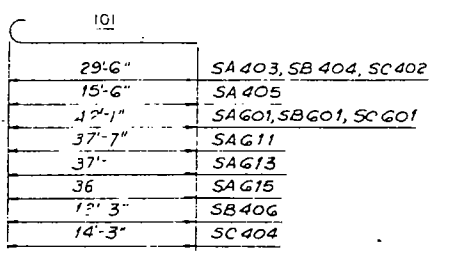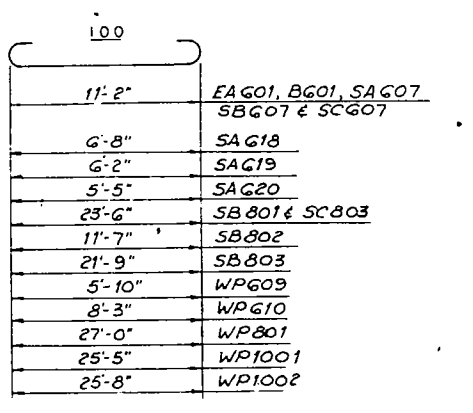

EA403 & B501
S4505, SB507
& SC405

HNTB BRIDGE NO 3
H. WARD NEILSON, TAMMIE & BERGENSDORF
INCORPORATED
CLEVELAND

HNTB

REINFORCEMENT SCHEDULE

REHABILITATION OF THE
LORAIN-CARNEGIE BRIDGE
(SR 10 OVER THE CUYAHOGA RIVER)
BR NO CUY-10-1618 STA. 22+19.19
STA. 55+04.56

MARK	NO.	LENGTH	TYPE	SER. INCR.	WEIGHT (LBS)
SLAB-SPAN 3					
0401 #	224	13'-0"	Str		7156
0402 #	206	25'-0"	Str		3440
0403 #	82	33'-0"	101		1643
0404 #	928	23'-0"	Str		18196
0405 #	82	25'-3"	101		1383
0406 #	28	24'-3"	Str		454
2501	332	7'-10"	155		3121
2502	40	23'-5"	Str		980
2503	8	11'-5"	Str		96
2504	4	21'-5"	Str		90
2505	36	30'-0"	Str		1126
2506	4	27'-3"	Str		114
2507	1284	3'-5"	163		4687
2601 #	1256	29'-2"	101		46262
2602 #	528	28'-0"	Str		22800
2603	1056	31'-9"	Str		50359
2604	528	22'-0"	Str		17447
2605	720	30'-0"	Str		32443
2606	80	28'-0"	Str		3464
2607 #	528	12'-6"	100		9913
2608 #	528	3'-0"	105		2379
2609	528	3'-2"	105		2511
2610	380	6'-0"	105		3425
801	40	25'-4"	100		2706
802	8	13'-5"	100		287
803	4	23'-4"	100		249
804	60	30'-0"	Str		4806
805	6	12'-0"	Str		192
Total Weight (Uncoated)					= 128,003
Total Weight (Epoxy Coated)					= 113,626
SLAB-SPAN 4					
401 #	206	13'-0"	Str		1789
402 #	82	30'-0"	101		1643
403 #	138	30'-0"	Str		2766
404 #	82	14'-9"	101		809
405 #	28	13'-9"	Str		257
501	96	7'-0"	155		784
502	12	23'-6"	Str		294
503	8	30'-0"	Str		250
504	4	14'-6"	Str		61
505	324	3'-6"	163		1183
601 #	268	29'-2"	101		11741
602 #	134	28'-9"	Str		5786
603	268	31'-9"	Str		12781
604	134	22'-0"	Str		4428
605	160	30'-0"	Str		7210
606	80	14'-9"	Str		1772
607 #	134	12'-5"	100		2516
608 #	134	3'-0"	105		604
609	134	3'-2"	105		637
610	96	6'-0"	105		865
701	12	30'-0"	Str		961
702	6	17'-0"	Str		272
703	12	25'-4"	100		812
Total Weight (Uncoated)					= 32,310
Total Weight (Epoxy Coated)					= 27,910
SLAB-SPAN 5					
101 #	927	13'-0"	Str		8050
102 #	206	25'-0"	Str		3440
103 #	82	33'-0"	101		1643
104 #	1018	30'-0"	Str		20401
105 #	82	15'-0"	101		1041
106 #	28	18'-0"	Str		337
01	414	7'-10"	155		3322
02	44	23'-5"	Str		1078
03	8	11'-6"	Str		96
04	8	21'-6"	Str		179
05	40	30'-0"	Str		1252
06	1336	3'-5"	163		5096

MARK	NO.	LENGTH	TYPE	SER. INCR.	WEIGHT (LBS)
*SF601	1140	29'-2"	101		49942
*SF602	570	22'-0"	Str		24614
SF603	1140	31'-9"	Str		54365
SF604	570	22'-0"	Str		18835
SF605	800	30'-0"	Str		36048
SF606	80	22'-3"	Str		2674
*SF607	570	12'-6"	100		10732
*SF608	570	3'-0"	105		2569
SF609	570	3'-2"	105		2711
SF610	412	6'-0"	105		3713
SF801	44	25'-3"	100		2966
SF802	8	13'-5"	100		297
SF803	4	23'-4"	100		249
SF804	66	30'-0"	Str		5287
SF805	6	6'-5"	Str		104
Total Weight (Uncoated)					= 138,322
# Total Weight (Epoxy Coated)					= 122,738
SLAB-SPAN 6					
*SG401	412	12'-5"	Str		3440
*SG402	164	17'-0"	101		1862
*SG403	358	30'-0"	Str		7174
*SG404	28	2'-0"	Str		51
SG501	160	7'-10"	155		1307
SG502	16	30'-0"	Str		501
SG503	4	4'-3"	Str		18
SG504	20	23'-6"	Str		490
SG505	540	3'-6"	163		1971
*SG601	442	29'-2"	101		19363
*SG602	221	28'-9"	Str		9543
SG603	442	31'-9"	Str		21078
SG604	221	22'-0"	Str		7303
SG605	320	30'-0"	Str		14419
SG606	80	4'-6"	Str		541
*SG607	222	12'-6"	100		4168
*SG608	222	3'-0"	105		1000
SG609	222	3'-2"	105		1056
SG610	160	6'-0"	105		1442
SG801	24	30'-0"	Str		1922
SG802	6	9'-3"	Str		148
SG803	20	23'-2"	100		1344
Total Weight (Uncoated)					= 53,540
# Total Weight (Epoxy Coated)					= 46,601
SLAB-SPAN 7					
*SH401	1030	13'-0"	Str		8945
*SH402	206	25'-0"	Str		3440
*SH403	82	30'-0"	101		1643
*SH404	1123	30'-0"	Str		22605
*SH405	82	14'-9"	101		808
*SH406	28	13'-9"	Str		257
SH501	446	7'-10"	155		3644
SH502	44	30'-0"	Str		1377
SH503	4	17'-6"	Str		73
SH504	48	23'-5"	Str		1176
SH505	8	11'-6"	Str		96
SH506	4	21'-3"	Str		89
SH507	1500	3'-6"	163		5476
*SH601	1230	29'-2"	101		53884
*SH602	615	28'-9"	Str		26557
SH603	1230	31'-9"	Str		58657
SH604	615	22'-0"	Str		20322
SH605	980	30'-0"	Str		39653
SH606	80	18'-6"	Str		2223
*SH607	616	12'-5"	100		11565
*SH608	616	3'-0"	105		2772
SH609	616	3'-2"	105		2930
SH410	446	6'-0"	105		4301
SH801	72	30'-0"	Str		5767
SH802	6	3'-9"	Str		60
SH803	48	25'-4"	100		3247
SH804	8	13'-5"	100		287
SH805	4	23'-2"	100		247
Total Weight (Uncoated)					= 149,325
# Total Weight (Epoxy Coated)					= 132,480






MARK	NO.	LENGTH	TYPE	SER. INCR.	WEIGHT (LBS)
SLAB-SPAN 8					
*SJ401	412	13'-0"	Str		3578
*SJ402	144	17'-6"	101		1917
*SJ403	358	30'-0"	Str		7174
*SJ404	28	3'-9"	Str		70
SJ501	160	7'-10"	155		1307
SJ502	16	30'-0"	Str		501
SJ503	4	5'-0"	Str		21
SJ504	20	23'-6"	Str		490
SJ505	540	3'-6"	163		1971
*SJ601	444	29'-2"	101		19453
*SJ602	222	28'-9"	Str		9587
SJ603	444	31'-9"	Str		21173
SJ604	222	22'-0"	Str		7336
SJ605	320	30'-0"	Str		14419
SJ606	80	5'-3"	Str		631
*SJ607	224	12'-6"	100		4204
*SJ608	224	3'-0"	105		1009
SJ609	224	3'-2"	105		1065
SJ610	160	6'-0"	105		1442
SJ801	24	30'-0"	Str		1922
SJ802	6	10'-0"	Str		160
SJ803	20	25'-4"	100		1353
Total Weight (Uncoated)					= 53,791
# Total Weight (Epoxy Coated)					= 46,994
SLAB-SPAN 9					
*SK401	1236	13'-0"	Str		10733
*SK402	206	25'-0"	Str		3440
*SK403	164	17'-0"	101		1917
*SK404	1348	30'-0"	Str		27014
*SK405	28	3'-9"	Str		70
SK501	510	7'-10"	155		4165
SK502	52	30'-0"	Str		1627
SK503	4	8'-3"	Str		34
SK504	56	23'-6"	Str		1373
SK505	8	11'-6"	Str		96
SK506	4	21'-6"	Str		90
SK507	1716	3'-6"	163		6264
*SK601	1408	29'-2"	101		61689
*SK602	704	28'-9"	Str		30400
SK603	1408	31'-9"	Str		67145
SK604	704	22'-0"	Str		23262
SK605	1040	30'-0"	Str		46862
SK606	80	9'-3"	Str		1111
*SK607	706	12'-6"	100		13255
*SK608	706	3'-0"	105		3181
SK609	706	3'-2"	105		3358
SK610	508	6'-0"	105		4578
SK801	78	30'-0"	Str		6248
SK802	6	24'-6"	Str		392
SK803	56	25'-4"	100		3788
SK804	8	13'-5"	100		287
SK805	4	23'-4"	100		249
Total Weight (Uncoated)					= 170,929
# Total Weight (Epoxy Coated)					= 151,699

* Denotes Epoxy Coated Reinforcing Steel.

FHWA REGION	STATE	PROJECT
5	OHIO	

CUYAHOGA COUNTY
CUY-10-16.23

182
185

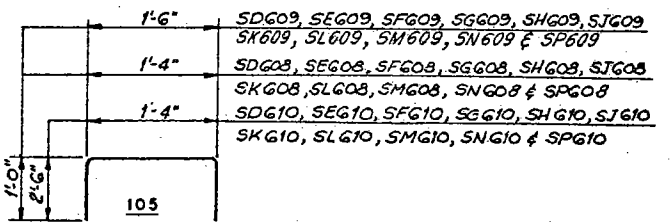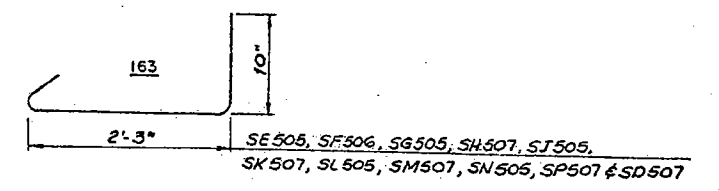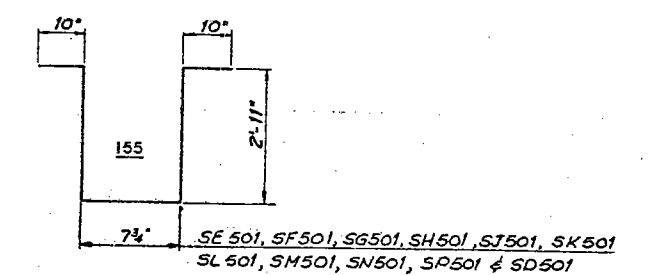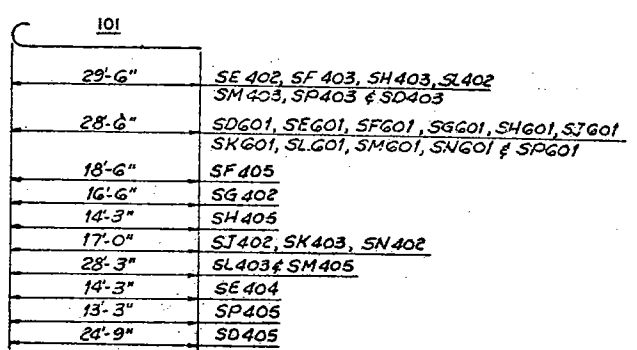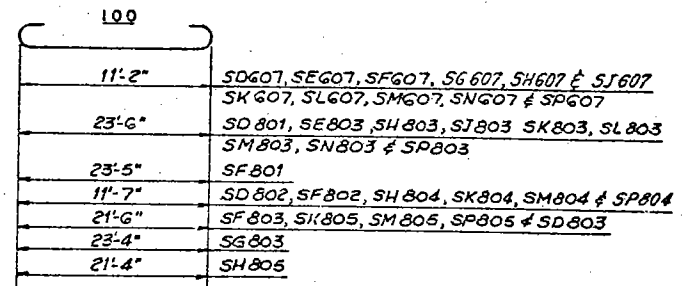

VOID 3/14/34

H.N.T.B. BRIDGE NO. 3

HOWARD NEEDLES TAMMEN & BERGENDOFF
CONSULTING ENGINEERS
CLEVELAND

HNTB

REINFORCEMENT SCHEDULE

REHABILITATION OF THE
LORAIN-CARNEGIE BRIDGE
(S.R. 10 OVER THE CUYAHOGA RIVER)

BR. NO. CUY-10-1618 STA. 22+19.19
CUYAHOGA COUNTY STA. 55+04.56 CHIO

DRAWN	TRACED	CHECKED	REVIEWED	REVISED
R.A.S.		G.L.P.		
DATE 10-27-75	DATE	DATE 10-27-75	DATE	DATE

SHEET R/2

FHWA REGION	STATE	PROJECT
5	OHIO	

165
185

CUYAHOGA COUNTY
CUY-10-16.23

MARK	NO.	LENGTH	TYPE	SER INCR.	WEIGHT (LBS.)
STAIR - COLUMN REPAIR					
SC401	25	5'-4"	104		93
SC402	32	5'-1"	104		105
SC403	35	2'-10"	104		110
SC901	14	1'-10"	STR		550
SC1301	2	1'-4"	STR.		250
SC1302	4	1'-4"	STR.		259
Total weight =					1,390

MARK	NO.	LENGTH	TYPE	SER INCR.	WEIGHT (LBS.)
SIMPLE GI					
GM501	40	1'-2"	104		549
GM502	1	1'-2"	STR.		21
GM503	1	3'-10"	STR.		40
GM504	1	2'-11"	STR.		30
GM505	1	2'-9"	STR.		29
GM506	1	3'-10"	STR.		38
GM507	1	1'-7"	STR.		20
GM508	37	1'-3"	104		511
GM509	19	1'-5"	104		251
GM510	35	1'-7"	104		494
GM511	1 Ser. 35	14'-0"	104	0.2"	551
GM512	67	1'-0"	104		210
GM513	60	1'-1"	104		193
GM514	31	1'-2"	104		102
GM515	59	1'-3"	104		202
GM516	1 Ser. 59	3'-2"	104	0.2"	224
GM517	330	1'-4"	104		1,146

GM601	8	2'-5"	STR.		185
GM602	8	3'-0"	STR.		351
GM603	6	2'-9"	STR.		259
GM604	8	2'-3"	STR.		255
GM605	6	3'-1"	STR.		327
GM606	5	1'-3"	STR.		174







GM1001	6	1'-1"	STR.		464
GM1002	4	1'-3"	STR.		258
GM1003	6	2'-1"	101		585
GM1004	6	4'-2"	STR.		1,093
GM1005	6	3'-2"	STR.		833
GM1006	6	3'-1"	STR.		820
GM1007	6	3'-5"	STR.		868
GM1008	6	2'-5"	101		527
GM1009	2	2'-11"	101		214
GM1010	4	3'-5"	101		525
GM1011	7	4'-1"	101		1,267
GM1012	7	3'-5"	STR.		1,160
GM1013	7	2'-5"	STR.		648
GM1014	7	3'-5"	STR.		1,130
GM1015	7	3'-5"	101		1,130
Total weight =					17,750

MARK	NO.	LENGTH	TYPE	SER INCR.	WEIGHT (LBS.)
GIRDER 2-19					
GM501	231	2'-7"	104		1,092
GM502	75	2'-5"	104		390
GM503	33	3'-0"	104		209
GM504	162	2'-0"	104		587
GM505	64	2'-5"	104		442
GM506	1 Ser. 14	3'-9"	104	0.2"	93
GM507	1 Ser. 14	3'-10"	104	0.2"	99
GM508	1 Ser. 14	4'-0"	104	0.2"	103
GM509	1 Ser. 14	3'-9"	104	0.2"	95
GM510	102	2'-5"	104		363
GM511	15	2'-0"	104		592
GM512	2 Ser. 21	2'-10"	104	0.2"	143
GM513	2 Ser. 17	2'-10"	104	0.2"	142
GM514	12	2'-11"	104		112
GM515	72	2'-0"	104		270
GM516	2 Ser. 17	2'-10"	104	0.2"	130
GM517	2 Ser. 21	2'-10"	104	0.2"	140
GM518	2 Ser. 14	2'-5"	104	0.2"	114
GM519	2 Ser. 21	2'-10"	104	0.2"	143
GM520	23	2'-0"	104		813
GM521	2 Ser. 4	2'-5"	104	0.2"	34

MARK	NO.	LENGTH	TYPE	SER INCR.	WEIGHT (LBS.)
GM622	2 Ser. 27	2'-11"	104	0.2"	185
GM623	12	3'-0"	104		81
GM624	1 Ser. 22	3'-3"	104	0.1"	114
GM625	1 Ser. 22	3'-3"	104	0.1"	150
GM626	2 Ser. 22	4'-7"	104	0.1"	308
GM627	2 Ser. 22	4'-4"	104	0.1"	405
GM628	32	4'-1"	104		441
GM629	174	4'-0"	104		1,045
GM630	23	3'-10"	104		507
GM631	2 Ser. 23	3'-9"	104	0.2"	297
GM632	30	4'-10"	104		213
GM633	125	3'-5"	104		591
GM634	2 Ser. 17	3'-7"	104	0.2"	198
GM635	115	4'-2"	104		725
GM636	75	3'-3"	104		376
GM637	2 Ser. 14	3'-4"	104	0.2"	154
GM638	1 Ser. 21	3'-6"	104	0.2"	114
GM639	1 Ser. 21	3'-10"	104	0.2"	93
GM640	25	3'-11"	104		171
GM641	150	2'-10"	104		809
GM642	77	2'-11"	104		337
GM643	21	3'-11"	104		97
GM644	2 Ser. 17	2'-4"	104	0.2"	126
GM645	21	2'-10"	104		121
GM646	25	4'-4"	104		169
Total Weight (uncoated) =					13,400
# Total Weight (Epoxy Coated) =					651

Denotes Epoxy Coated Reinforcing Steel.

Note:
Only 18-GR604 bars, 16-GR611 bars, 44-GR620 bars, 36-GR641 bars and 24-GR642 bars shall be epoxy coated.

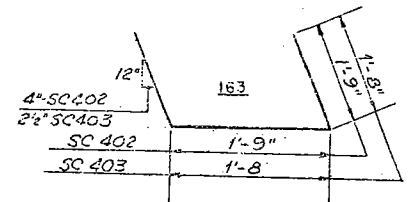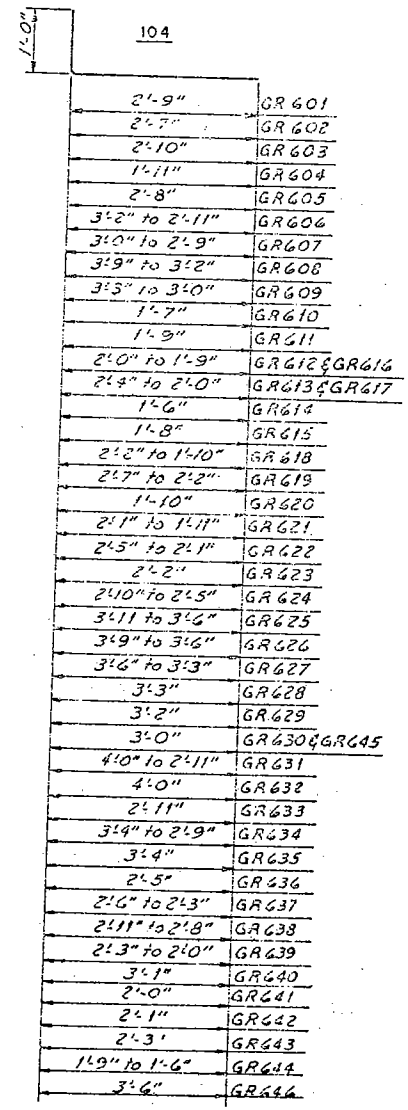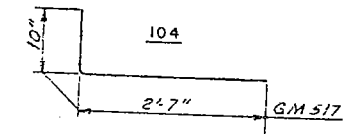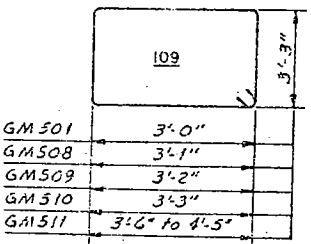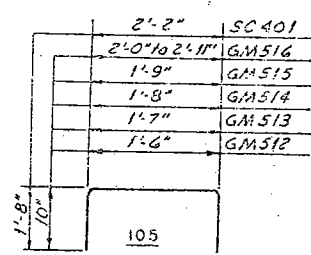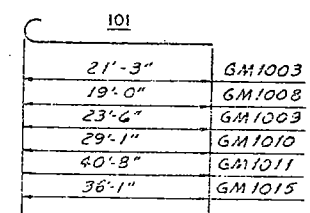

HNTB BRIDGE NO 4

HOWARD NEEDLES TAMMEN & BERGENDOFF
CONSULTING ENGINEERS
CLEVELAND

HNTB

REINFORCEMENT SCHEDULE

REHABILITATION OF THE
CARNEGIE AVENUE GRADE SEPARATION STRUCTURE
(SR 10 OVER THE CLEVELAND UNION TERMINALS CO.
AND THE REGIONAL TRANSIT AUTHORITY)
BR. NO. CUY-10-1685 STA. 57+29.72
CUYAHOGA COUNTY STA. 58+85.70

DATE: 03/10/00

COUNTY OF CUYAHOGA
CLEVELAND, OHIO

FROM Felix A. Spittler DATE October 7, 1974
TO Albert S. Porter, County Engineer SUBJECT Lorain-Carnegie Bridge Project
(Carnegie Avenue Grade Separation).

In the initiated Ordinance No. 47814 authorizing the Mayor to enter into a contract with the Cleveland Union Terminals Company passed January 6, 1919, by a vote of 30,731 FOR to 19,859 AGAINST, effective January 8th, 1919, the Cleveland Terminals Company, in Sec. 29, agreed to build the Grade Separation (carry Central Avenue and Central Viaduct over the tracks of said Terminals Company). In Sec. 85 of the same ordinance the Terminals Company agreed to construct, maintain, repair and rebuild the structures mentioned in this ordinance as they became necessary, by and at the expense of the Terminals Company.


Ordinance No. 8552 passed January 28, 1929, effective March 10, 1929, amended section 30 of Ordinance No. 47814, and provided for the construction of a bridge carrying Central Avenue S.E. and Central Viaduct over the tracks of said Terminals Company, 15 ft. southerly from the center line of Ontario Street S.E. measured along the center line of said avenue and a point 185 feet southerly from the center line of Ontario Street S.E. measured along the center line of said avenue (Carnegie Avenue Grade Separation).

Ordinance No. 93109 passed December 8, 1930, mentioned the extension to the Cleveland Union Terminal Bridge in section 1(d) in connection with the Lorain-Central Bridge project.

Probate Court Case No. 200388 (Lorain-Carnegie Bridge Project) Parcels C, D, and H obligated the County to maintain the southwesterly and northeasterly walls of the Cleveland Union Terminals Company which were to be used as and for piers and/or abutments to support said bridge or bridges and/or approaches thereto and the extension to the Terminals Company bridge.

It appears that the County is responsible for the extension added to the northwest of the original bridge and the southwesterly and northeasterly walls affected, but that the Terminals Company is responsible for the original bridge. To completely follow through on this matter would seem to be a legal matter requiring considerable research by the Prosecutor's Office.

PRELIMINARY ONLY

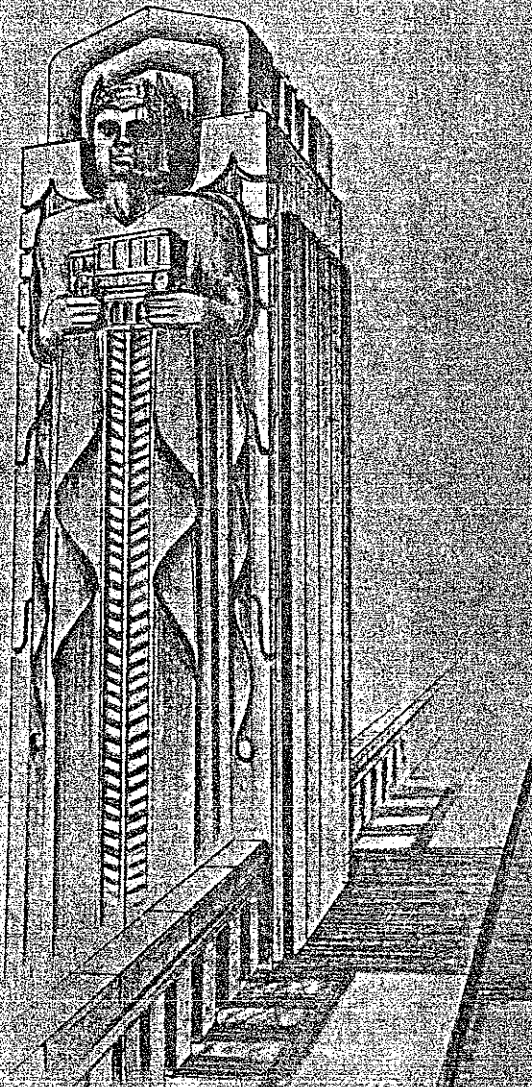

APRIL
1969


REHABILITATION STUDIES

**LORAIN
CARNEGIE
BRIDGE**


ALBERT S. PORTER
County Engineer
Cuyahoga County, Ohio

HOWARD, NEEDLES, TAMMEN & BERGENDOFF
CONSULTING ENGINEERS **HNTB**

FIGURE 5
 CARNEGIE AVENUE
 GRADE SEPARATION
 STRUCTURE

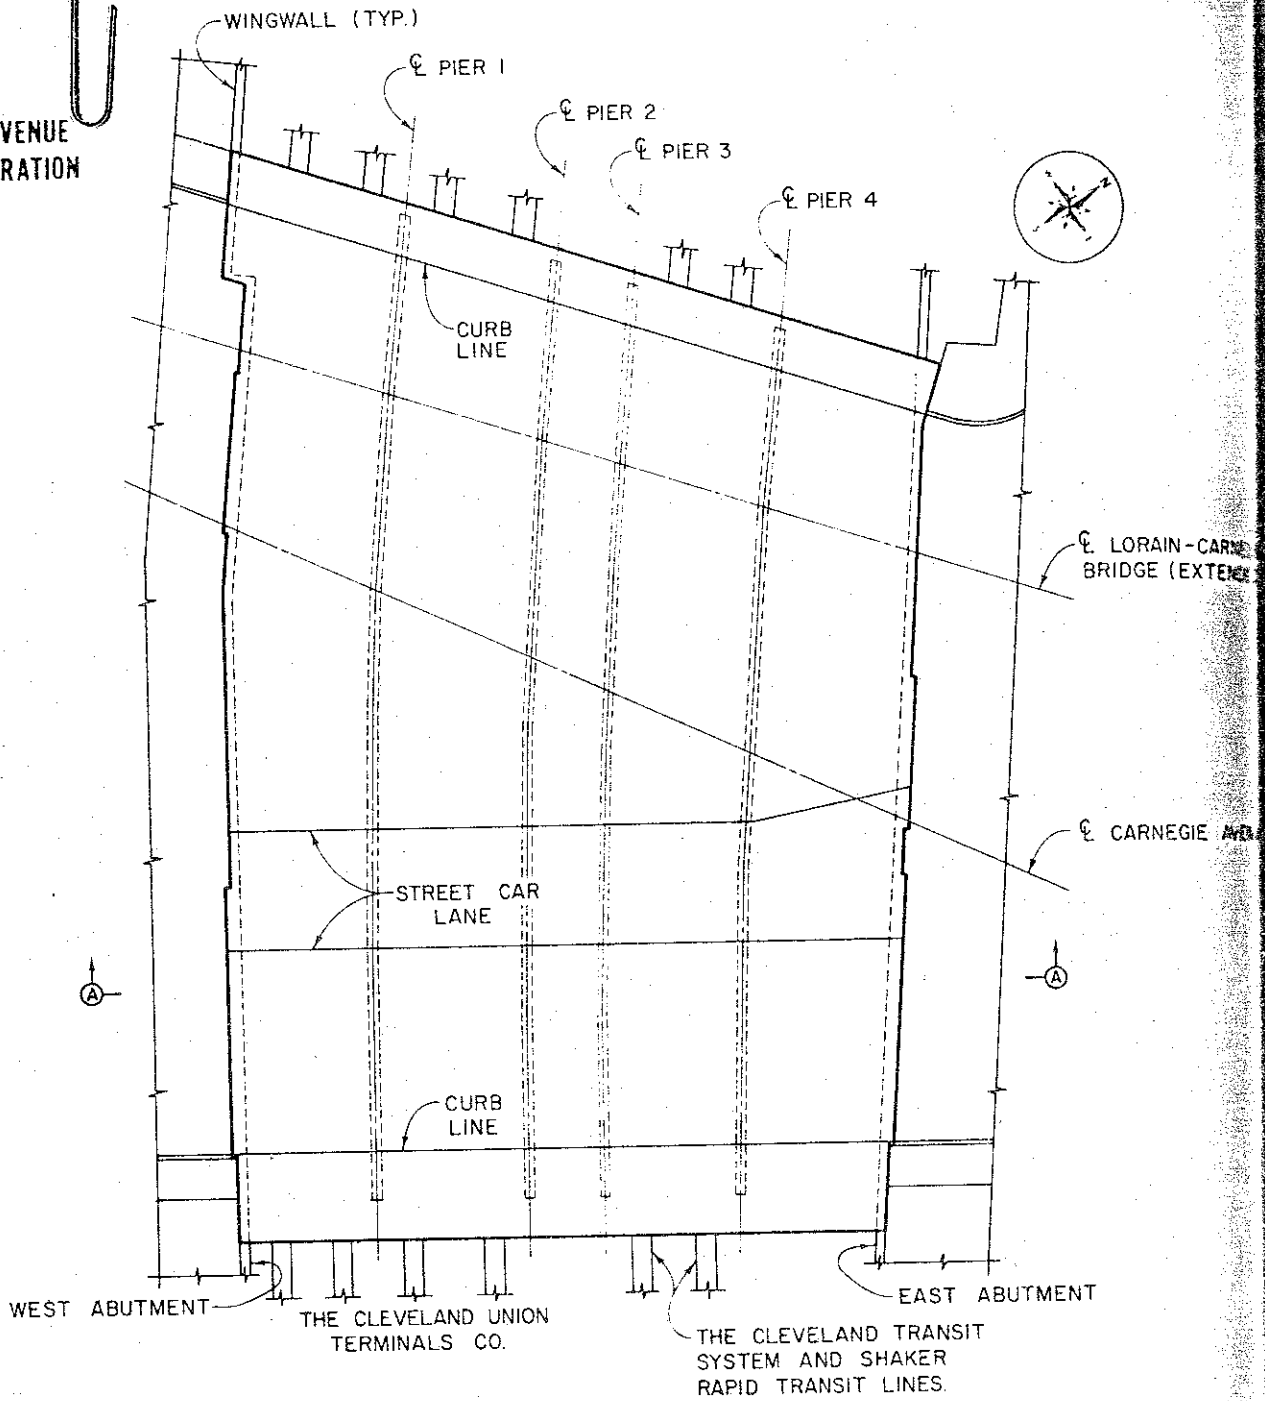

PLAN
 (SHOWING EXISTING
 CONDITIONS)

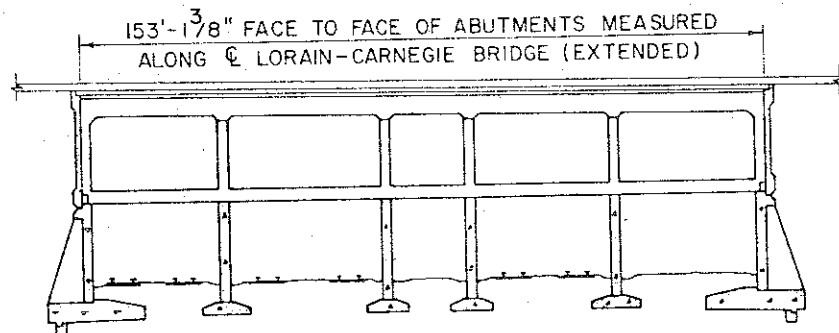

ELEVATION A-A

The approach roadways are supported on embankment between retaining walls. At the west approach, the retaining walls continue approximately 375 ft beyond the abutment bearings. At the east end, the north wall continues to adjoin the rapid transit grade separation structure, but the south wall terminates at the Commercial Road intersection.

— A General Plan and Elevation of the Carnegie Avenue Grade Separation Structure over the Rapid Transit tracks is shown on Figure 5. This bridge was designed to carry two tracks of street railway traffic and several converging lanes of vehicular traffic on the upper deck with provisions for six tracks of street railway traffic on a future lower deck. The structure comprises five variable length reinforced concrete girder spans having a total length of 153 ft.

C. Lorain-Carnegie Bridge

1. Truss Spans

The steel truss spans over the Cuyahoga River Valley are of deck design, the main carrying elements being Pratt trusses. Each span has four parallel trusses except the simple span at the east end which has three variably spaced trusses. The main members of the trusses are box sections made up of plate and angle channel sections riveted together with lacing bars. Lateral bracing is provided in the exterior bays in the plane of the lower chord members. Each truss line is supported by a pair of bearings on reinforced concrete piers.

The upper roadway deck is a reinforced concrete slab topped with an asphaltic wearing surface. The deck is supported by longitudinal stringers which span between transverse floorbeams. The floorbeams are supported on the top chords of the trusses at panel points (See Figure 6). A planned lower roadway deck has not been constructed, but floorbeams for all three bays are in place. A reinforced concrete utility deck, located in the center bay below the planned lower deck, is carried on longitudinal stringers and transverse floorbeams which are connected to truss verticals.

TABLE II

DESIGN RATING OF EXISTING MEMBERS

LORAIN-CARNEGIE BRIDGE

<u>Location</u>	<u>Member</u>	<u>HS Rating</u>		
		<u>4 Lanes</u>	<u>5 Lanes</u>	<u>6 Lanes</u>
Truss Spans	Interior Stringers	22.2	22.2	20.7
	Fascia Stringers	41.4	42.0	11.7
	Intermediate Floorbeams			
	Center Bay	13.4	16.1	15.3
	Exterior Bays	28.8	24.5	22.9
West Approach Spans	Interior Stringers	25.3	25.3	23.8
	Fascia Stringers	30.1	30.5	8.5
	Intermediate Floorbeams			
	Center Bay	12.4	16.5	15.3
	Exterior Bays	14.1	14.0	13.8

bridge are as follows:

Minimum Yield Point

ASTM A7 - 30,000 psi

ASTM A94 - 45,000 psi

Basic Allowable Design Stress

ASTM A7 - 16,000 psi

ASTM A94 - 24,000 psi

The minimum design ratings obtained using the above allowable stresses are shown in Table II. In order to meet current design standards for modern loadings, the Lorain-Carnegie Bridge should be rehabilitated to provide a minimum rating of HS-20. From a study of Table II, it is apparent that, in the truss spans, the intermediate floorbeams in the center bay will require strengthening for all alternates, and that the fascia stringers will require strengthening for the six-lane alternate. In the approach spans, all floorbeams require strengthening for all alternates, and the fascia stringers must be strengthened for the six-lane alternate. Because of the complexities created by the difference in eccentricity for dead and live loads, the steel columns in the approach spans were not rated, but instead the stresses were checked for HS20 loading. All columns of the approach spans will require strengthening.

At the time of the original construction, the beams used for the intermediate floorbeams in the exterior bays of the truss spans were the minimum sections available with the desired depth. As a result, these floorbeams were understressed for the original design. The ratings shown in Table II assume these members to be in new condition. Deterioration though has occurred in some of the floorbeams adjacent to the curb stringers. Each beam flange could be corroded up to 1/16 inch without overstressing the members, and, for the purposes of this report, it has been assumed that repair or strengthening will not be required.

B. Carnegie Avenue Grade Separation

Design rating of deteriorated reinforced concrete members is not feasible. Therefore, preliminary design of the Carnegie Avenue Grade

Separation consisted of checking the capacity of the members for their repaired condition.

Allowable stresses used for existing concrete members were based on their original composition and on design stresses prevalent at the time of construction. These values should be checked by testing representative core borings prior to preparation of contract plans for reconstruction work. For analyzing the Carnegie Avenue Grade Separation the following values were used for existing materials:


Concrete: Ultimate Compressive Strength	$f'_c = 3,000$ psi	}
Basic Allowable Compression	$f_c = 1,200$ psi	
Shear	$f_v = 90$ psi	
Modular Ratio(E_s/E_c)	$n = 10$	

Reinforcing Steel: Basic Allowable Tension $f_s = 18,000$ psi


The allowable stresses for new materials were in accordance with the American Association of State Highway Officials 1965 Standard Specifications for Highway Bridges including the Ohio Department of Highways Supplement thereto.

Considering the deck slab to be ineffective, the longitudinal girders were found to be deficient at the supports. By properly bonding the new deck slab to the existing girders to function as a T-beam, the girders, when repaired, will be adequate to carry HS 20 loads. The columns and other substructure elements, when restored, will be adequate for HS 20 loadings without strengthening.


For
Repaired
Condition

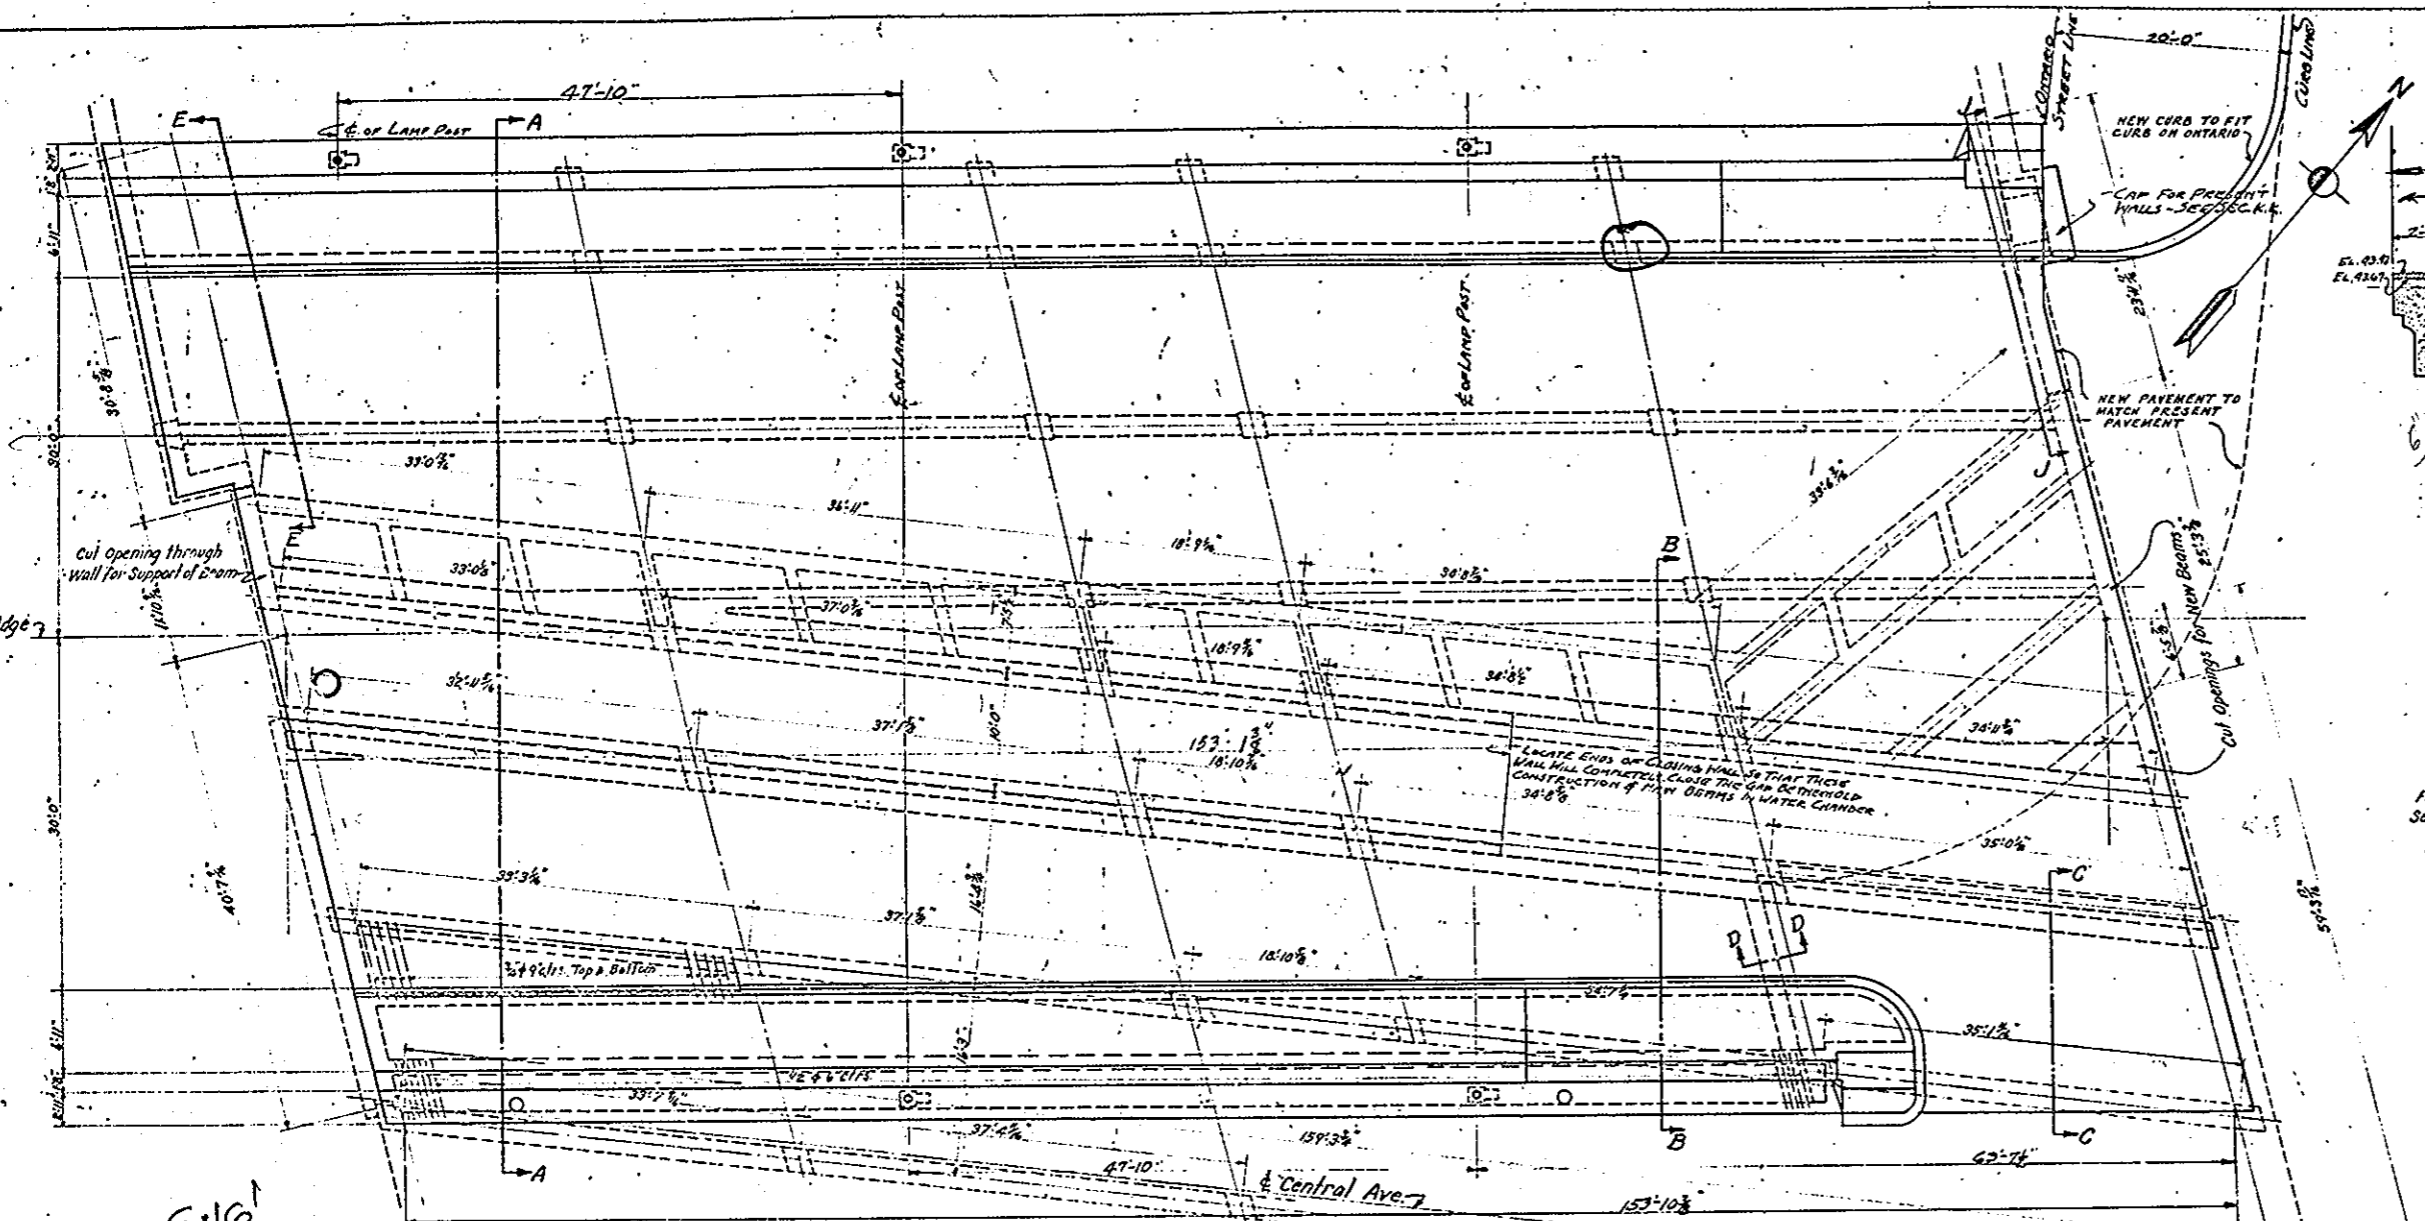

PLAN OF EXTENSION OF CENTRAL AVE. BRIDGE
Scale 1/8"=1'-0" (Carnegie Ave.)

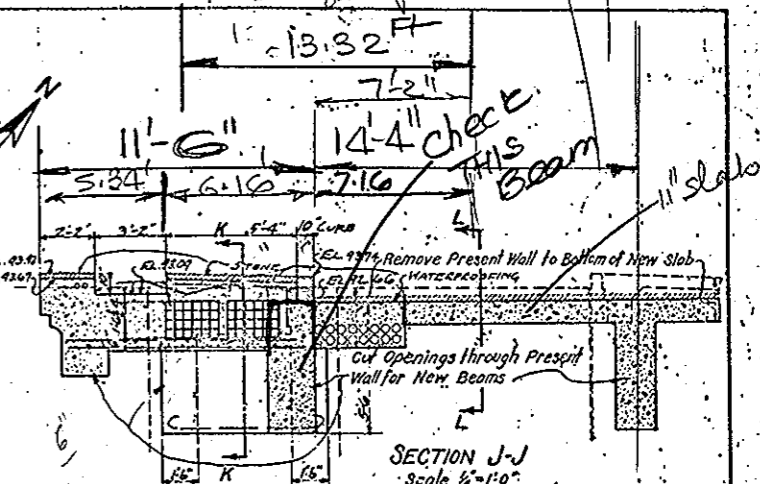


SECTION J-J
Scale 1/2"=1'-0"

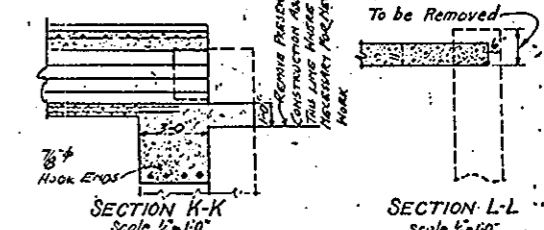


SECTION K-K
Scale 1/2"=1'-0"


SECTION L-L
Scale 1/2"=1'-0"

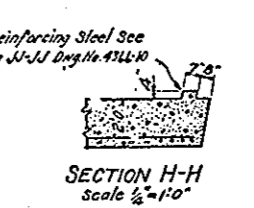

SECTION H-H
Scale 1/2"=1'-0"

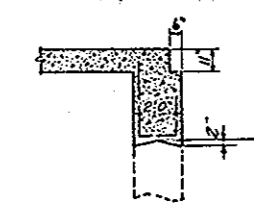


SECTION F-F
Scale 1/2"=1'-0"

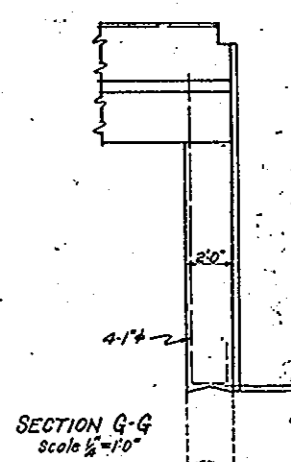


SECTION G-G
Scale 1/2"=1'-0"


For Reinforcing Steel See Section J-J Draw No. 1111-10

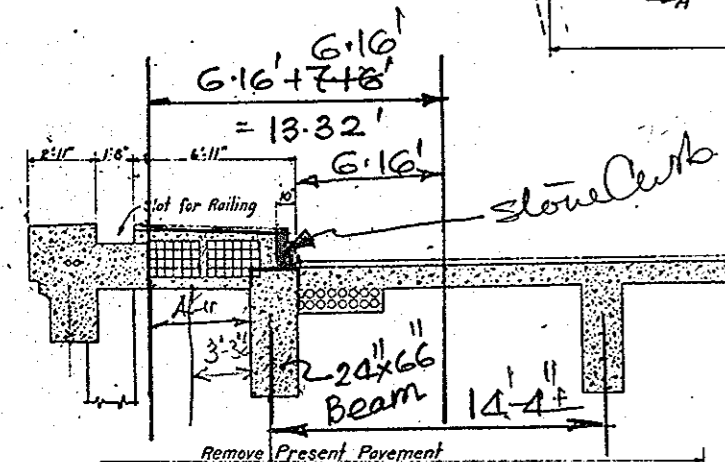


SECTION D-D
Scale 1/2"=1'-0"

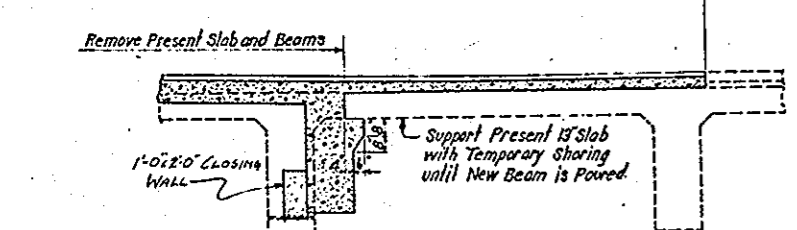


SECTION C-C
Scale 1/2"=1'-0"

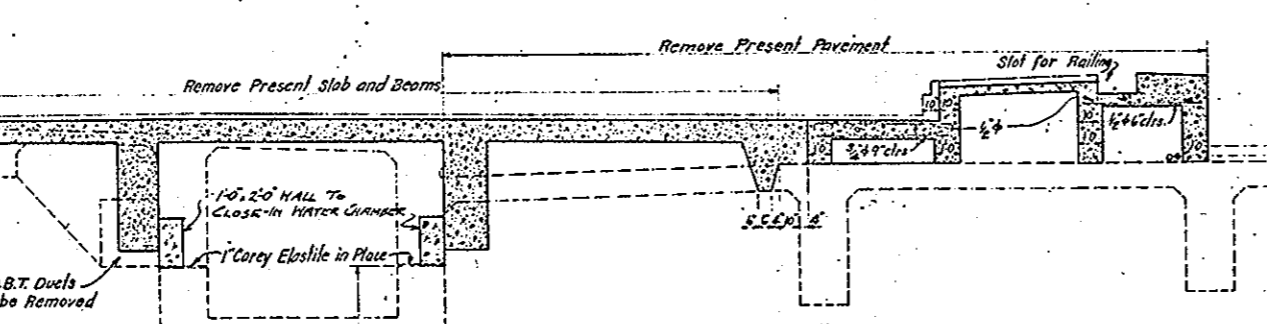

SECTION A-A
Scale 1/2"=1'-0"

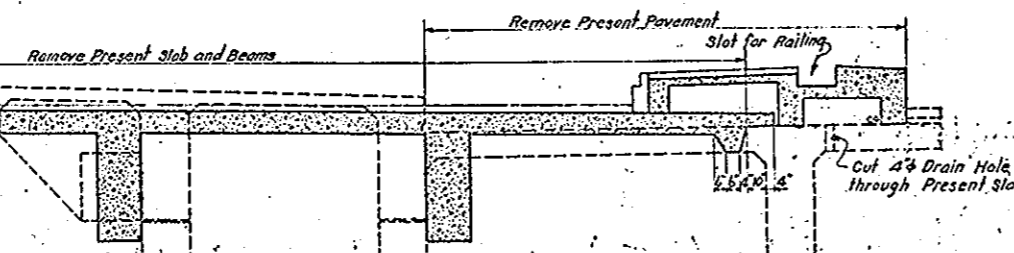

SECTION B-B
Scale 1/2"=1'-0"

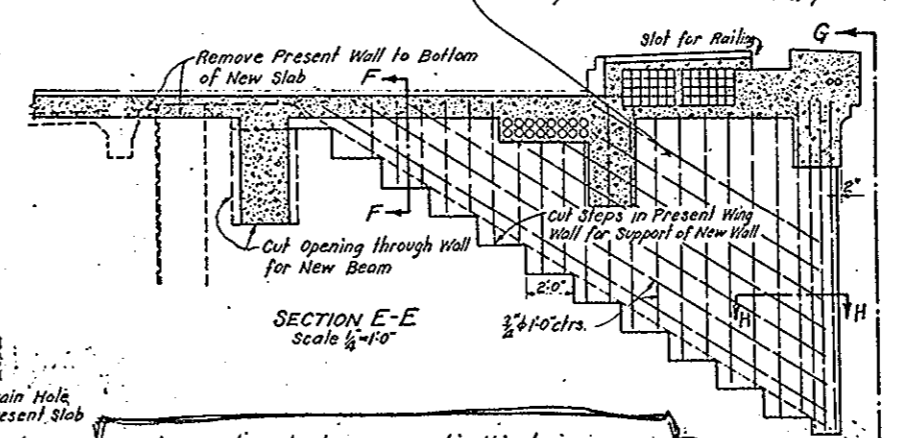


SECTION E-E
Scale 1/2"=1'-0"

Note: Loads and stresses used in this design are those specified by the Ohio State Highway Department for Highway Structures for H-20 loading. (20 Ton Trucks)


APPROVED BY

CO. COMM.	
CO. AUDITOR	
CO. ENG.	
BRIDGE ENG.	
CITY ENG.	


CUYAHOGA COUNTY	
BOARD OF COMMISSIONERS J. R. ZMUNT J. H. HARRIS W. E. COOK	COUNTY SURVEYOR F. R. WILLIAMS COUNTY BRIDGE ENGINEER A. M. FELGATE
LORAIN - CENTRAL BRIDGE CLEVELAND, O.	
CENTRAL AVE BRIDGE EXTENSION	
SCALE 1/8"=1'-0"	DRAWING NO. 18
FILE NO. 4366	WILBUR WATSON AND F. R. WALKER CONSULTING ENGINEERS AND ARCHITECTS CLEVELAND
DR. MADE JAN. 23, 1920	DR. BY W. W. WALKER
REV. BY	REMARKS

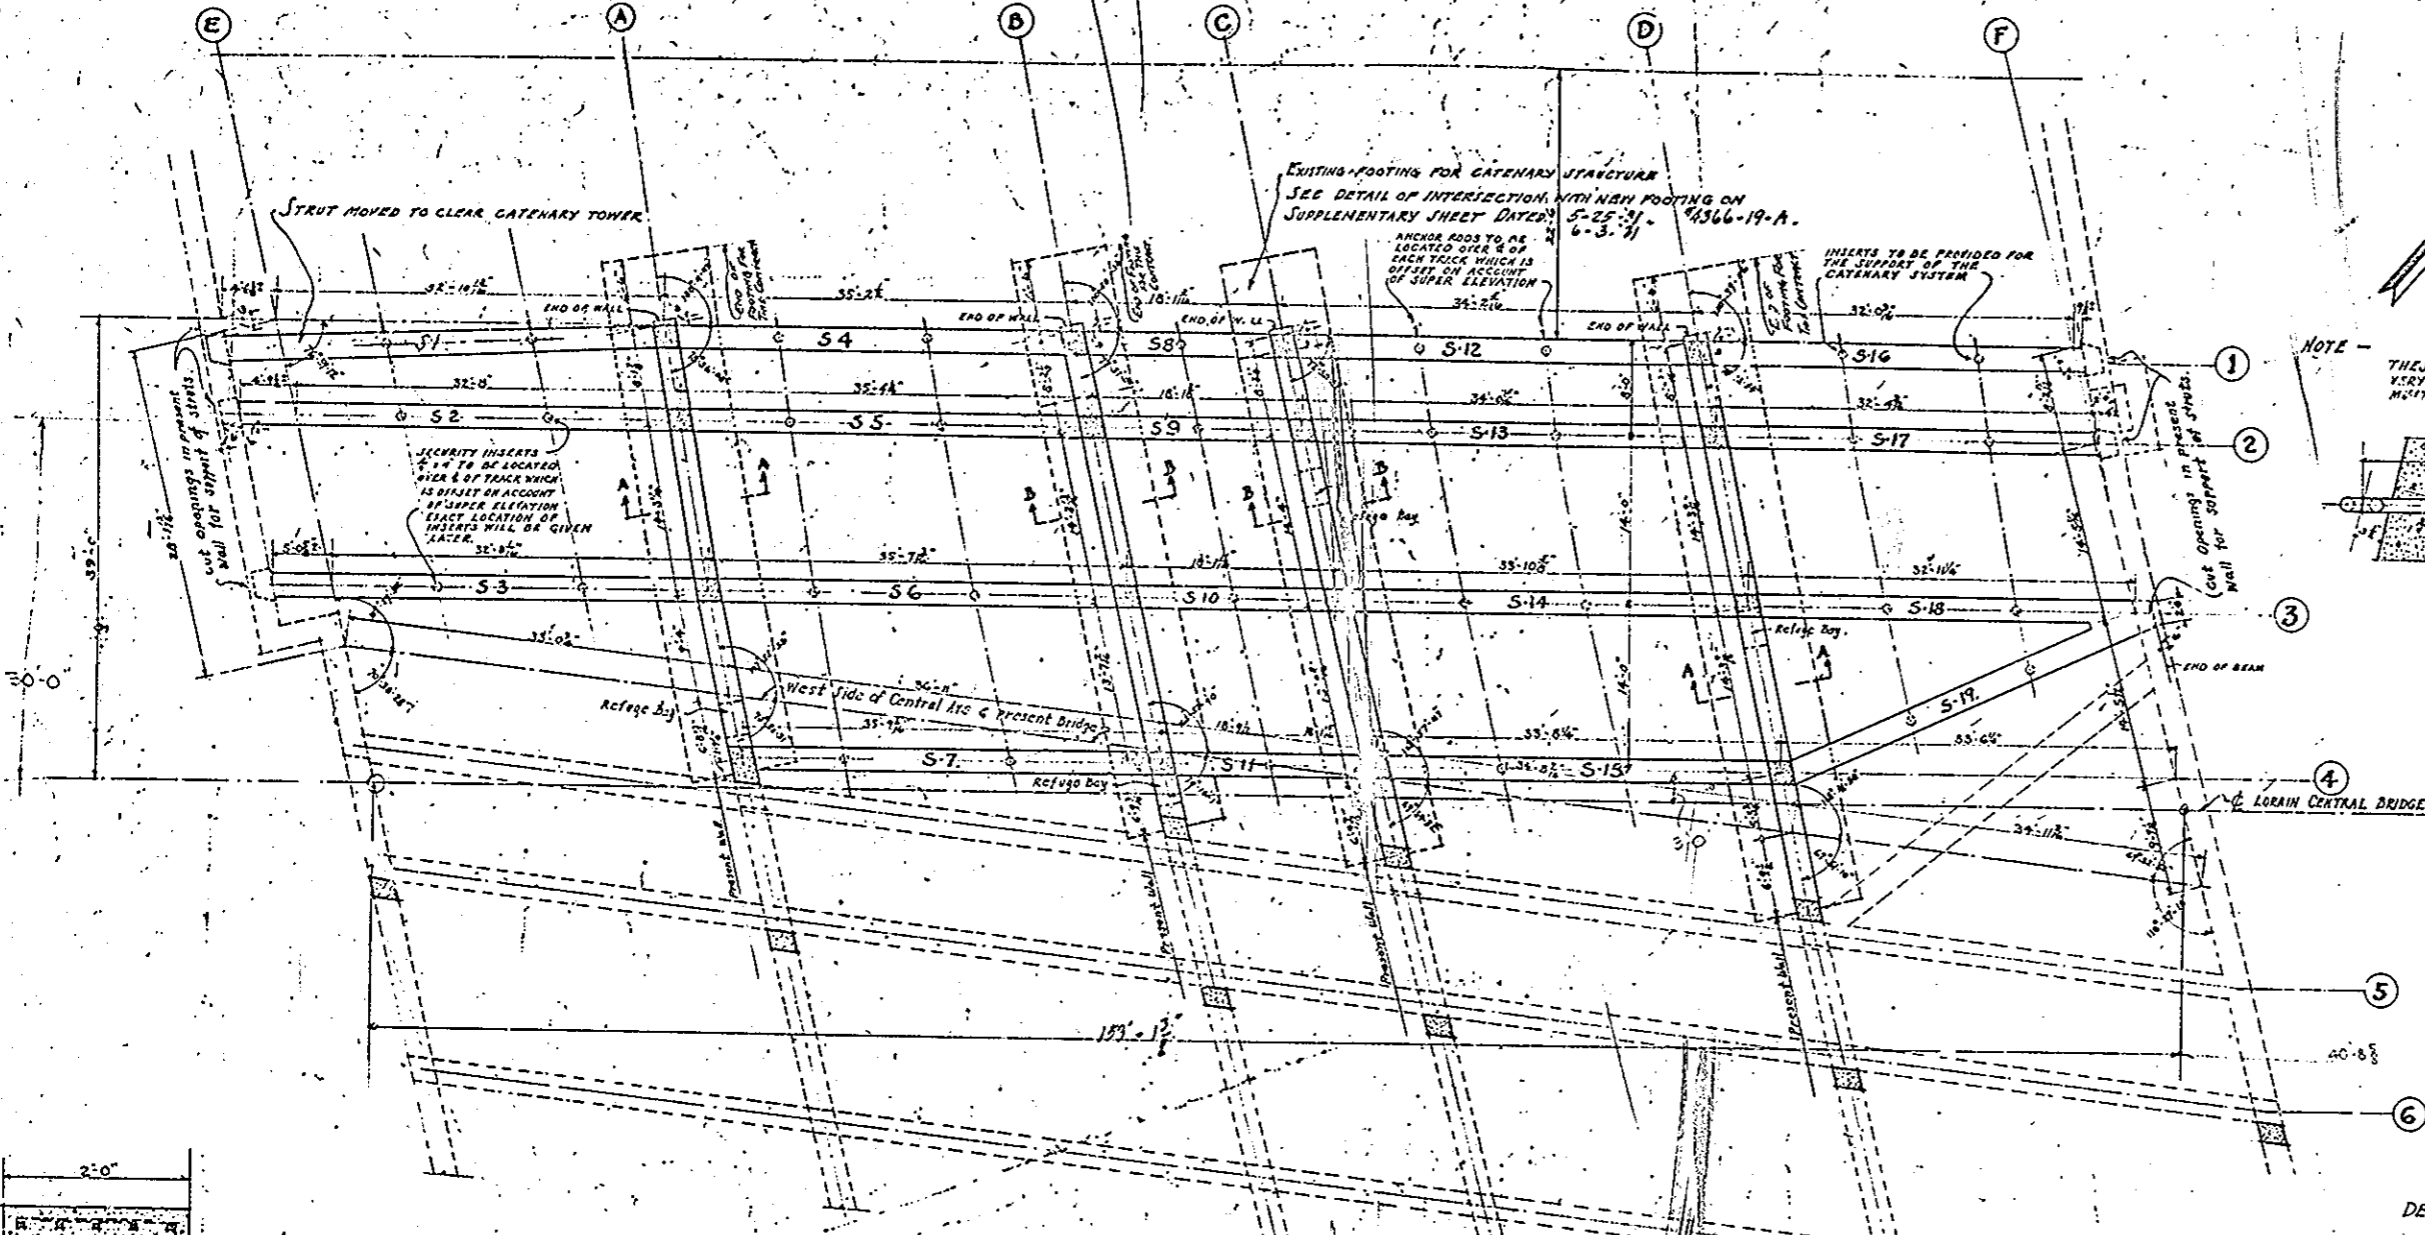


NOTE - THESE STRUTS ARE TO BE BUILT VERY CLOSE TO LIVE WIRES WHICH MUST BE PROTECTED.

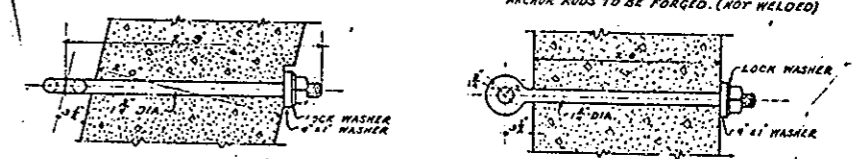


TYPICAL DETAILS OF ANCHOR RODS
SCALE 1/2" = 1'-0"

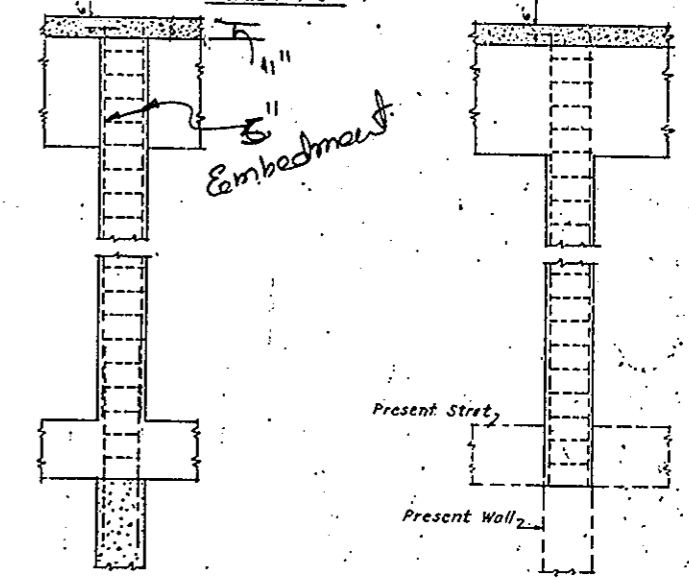



DETAIL OF COLS ON LINES 1-2-3-4 DETAIL OF COLS ON LINES 5-6.

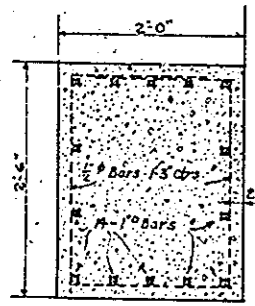


TYPICAL SECTION OF STRUTS
S1 TO S19 INCL.

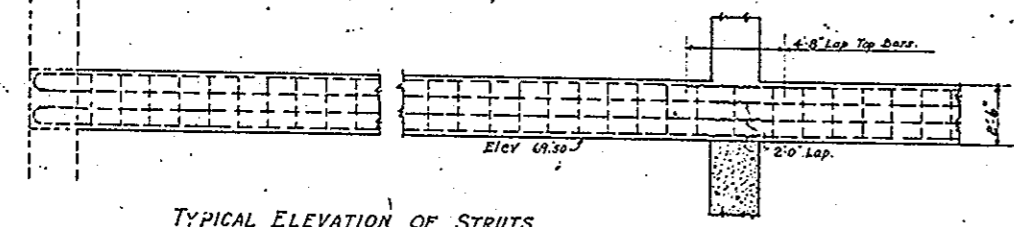


TYPICAL ELEVATION OF STRUTS.

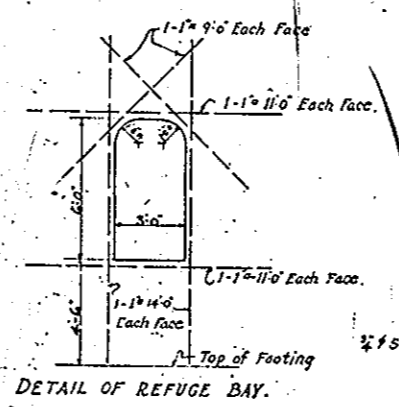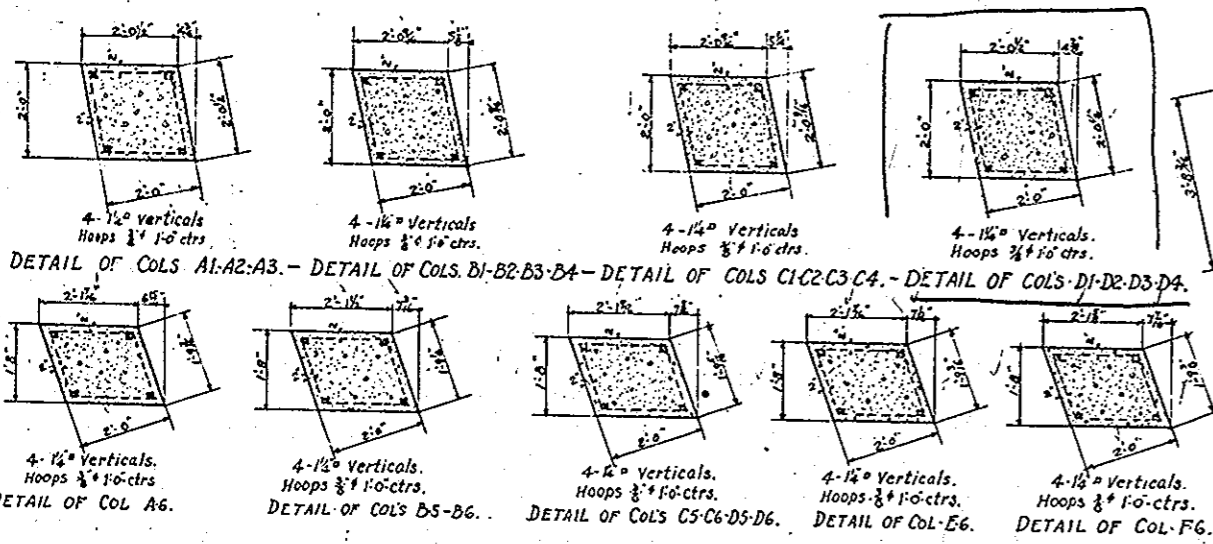

DETAIL OF REFUGE BAY.

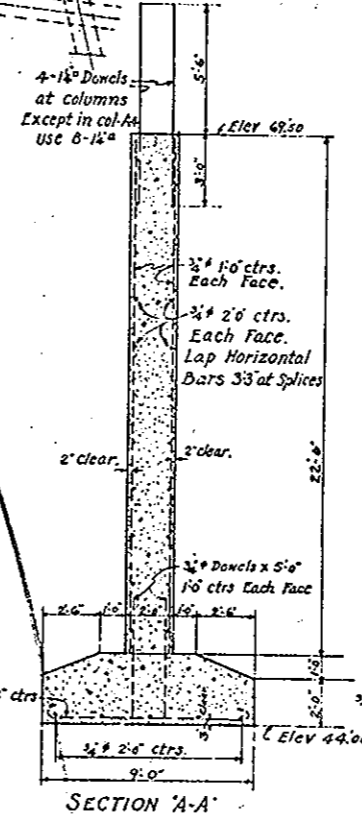

SECTION A-A

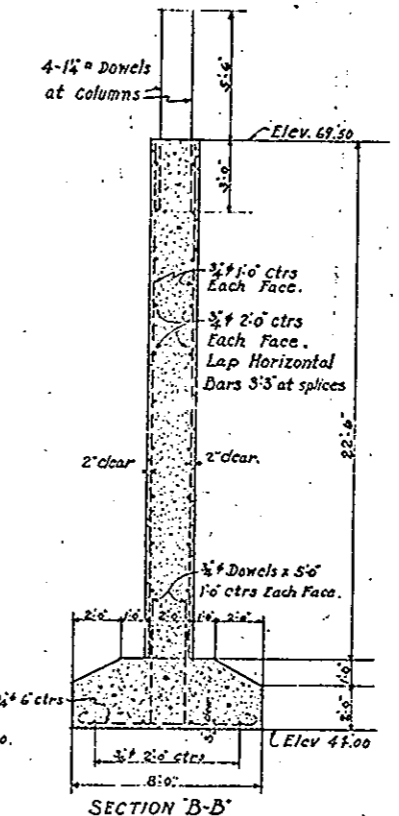

SECTION B-B

APPROVED BY

CO. COMM. _____

CO. ENG. _____

CO. ARCHT. _____

DESIGN. ENG. _____










CUYAHOGA COUNTY

BOARD OF COMMISSIONERS J. R. ZMUNT J. H. HARRIS W. E. COOK	COUNTY SURVEYOR F. R. WILLIAMS COUNTY BRIDGE ENGINEER A. M. FELGATE
---	--

LORAIN - CENTRAL BRIDGE
CLEVELAND, O.

CENTRAL AVE. BRIDGE EXTENSION
SCALE 1/8" = 1'-0"

FILE NO. A366	WILBUR WATSON AND F. R. WALKER CONSULTING ENGINEERS AND ARCHITECTS CLEVELAND	DRAWING NO. 119
DRAWING MADE 11/12/20	DRAWN BY W.P.P.	CHECKED BY A.M.
DATE 11/12/20	DATE 11/12/20	DATE 11/12/20
REVISIONS	REVISIONS	REVISIONS
NO. 1	1/23/21 End of footing on line C and struts	

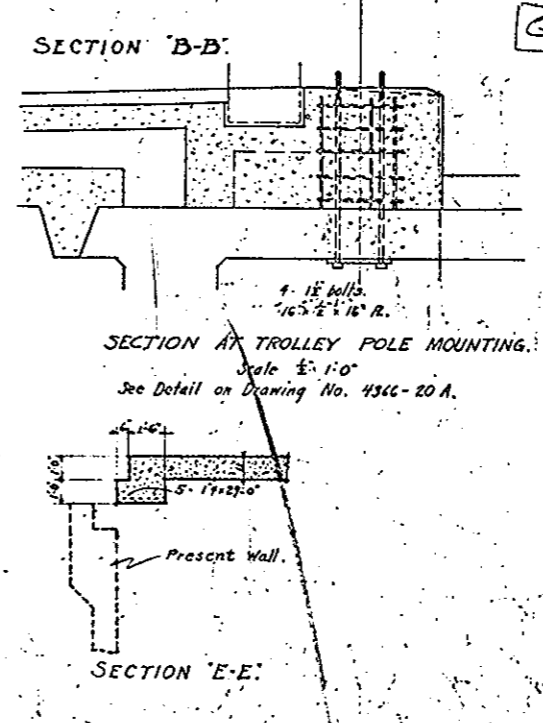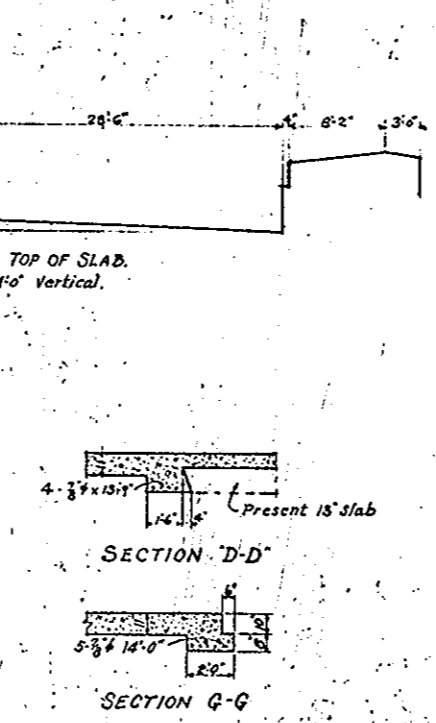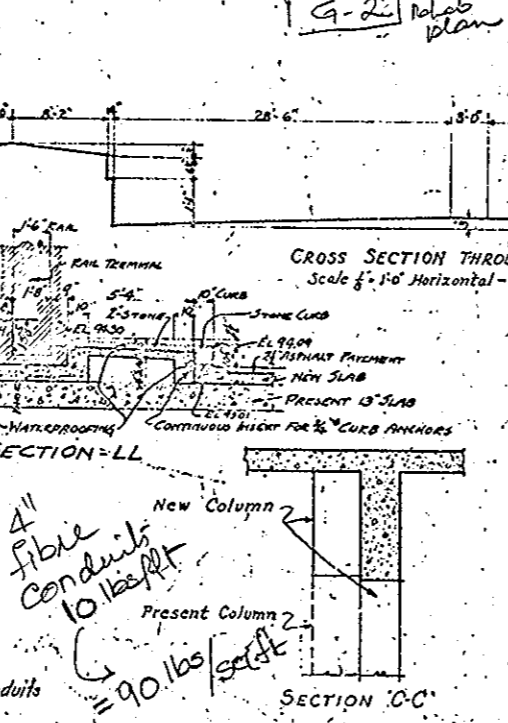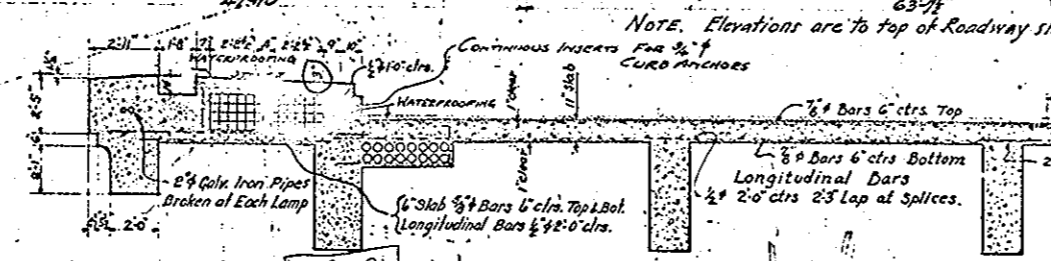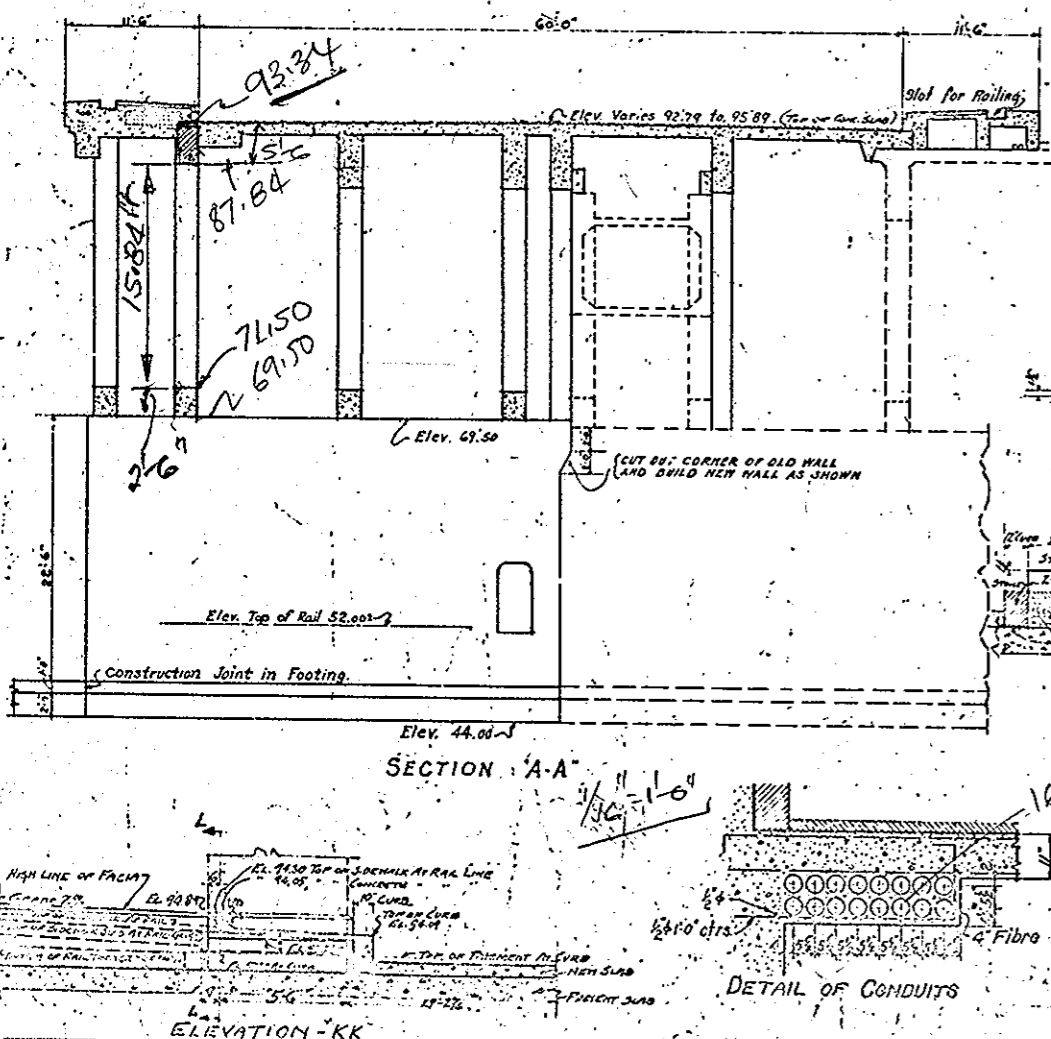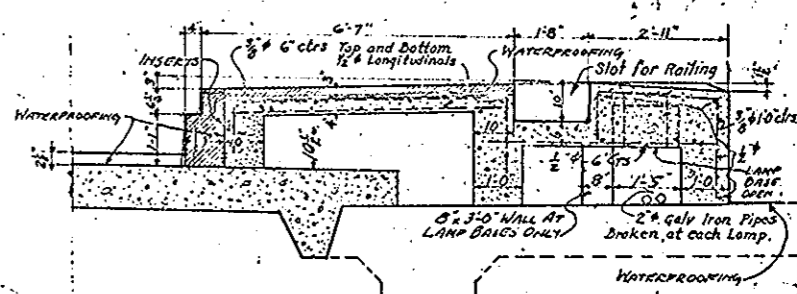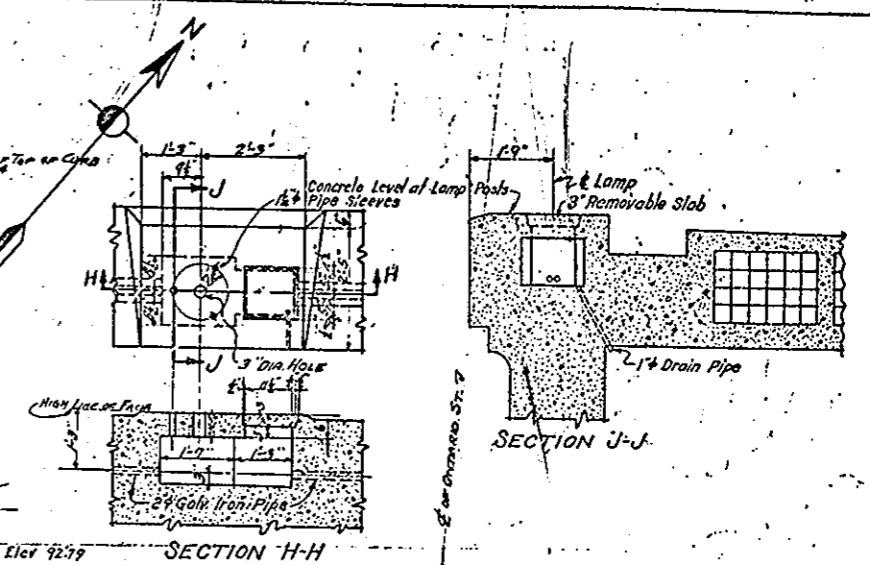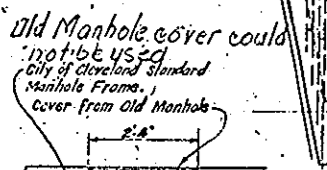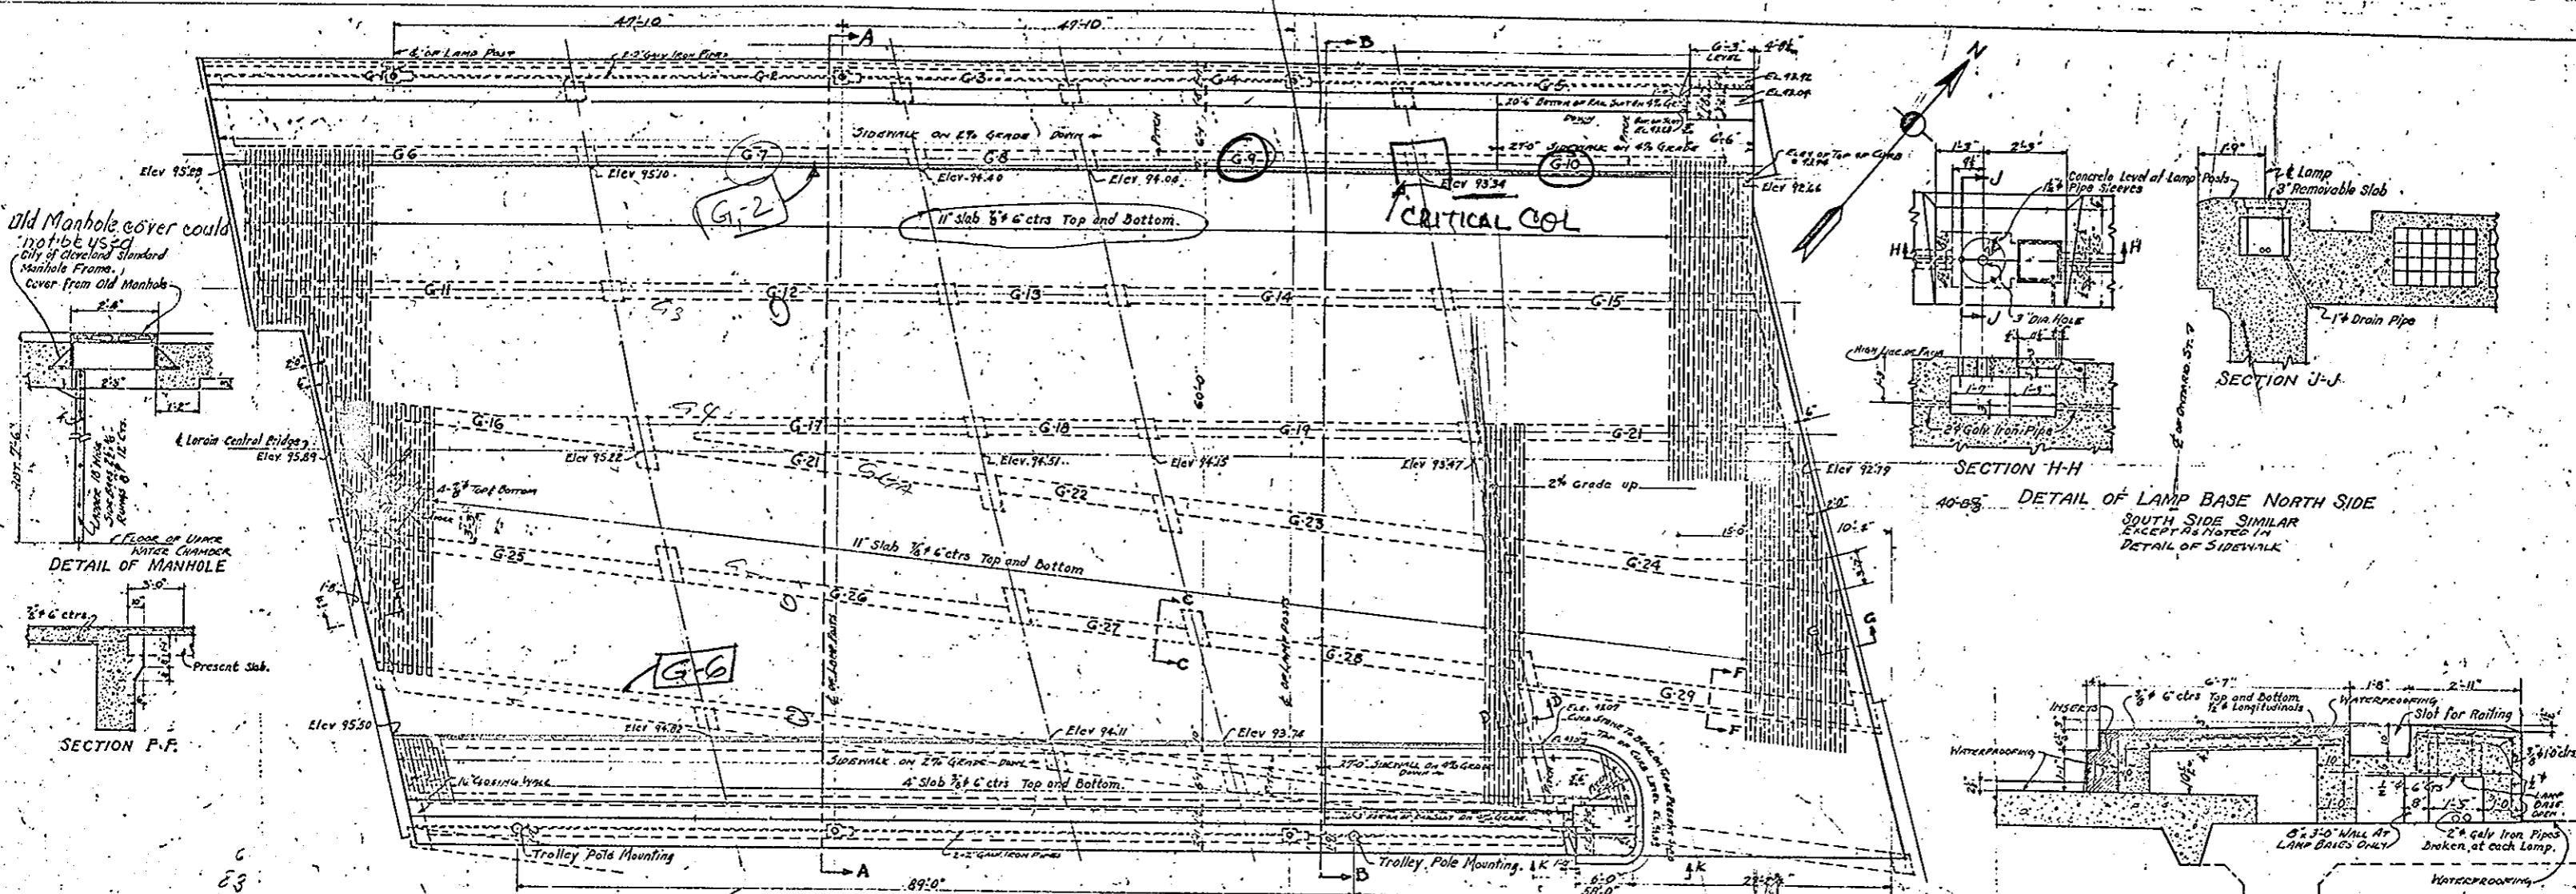

APPROVED BY

G-G Relets plan

CO. COMM.	_____
CO. AUDITOR	_____
CO. ENG.	_____
BRIDGE ENG.	_____
CITY ENG.	_____

CUYAHOGA COUNTY








BOARD OF COMMISSIONERS	J. R. ZMUNT	COUNTY SURVEYOR	F. R. WILLIAMS
J. H. HARRIS	_____	COUNTY BRIDGE ENGINEER	A. M. FELGATE
W. E. COOK	_____		

LORAIN - CENTRAL BRIDGE - CLEVELAND, O.

CENTRAL AVE. BRIDGE EXTENSION

SCALE 1/2" = 1'-0"

FILE NO.	4366	DRAWING NO.	20
DRAWN BY	WILBUR WATSON AND F. R. WALKER	DATE	18-16-20
CHECKED BY	_____	APPROVED BY	_____
DATE	_____	REMARKS	_____
REV. BY	_____	DATE	_____
REMARKS	_____		

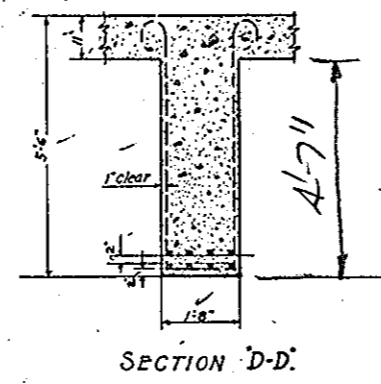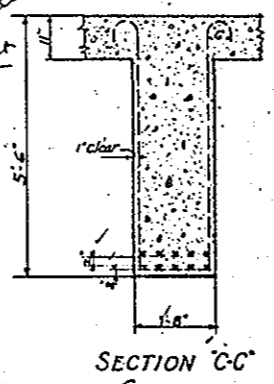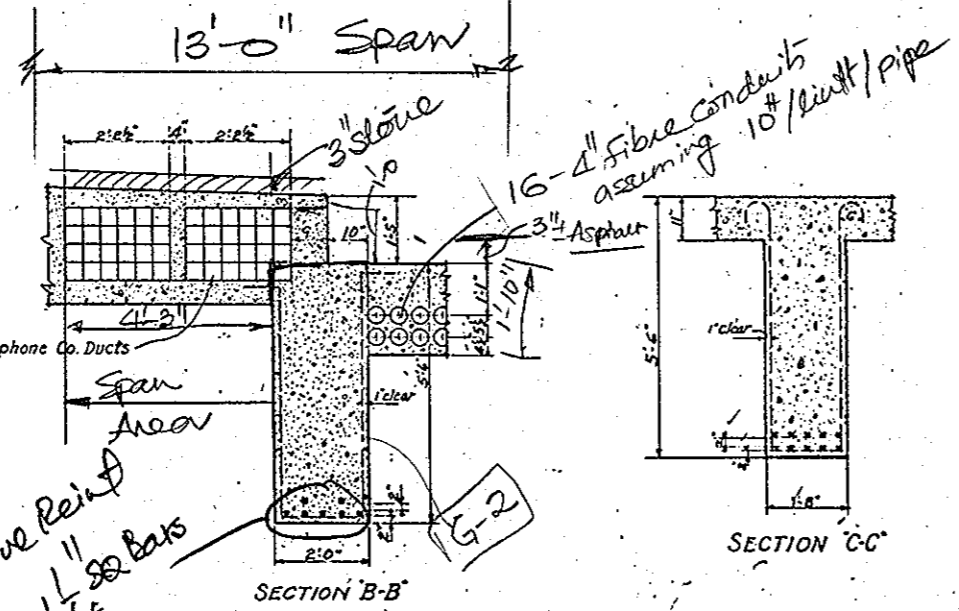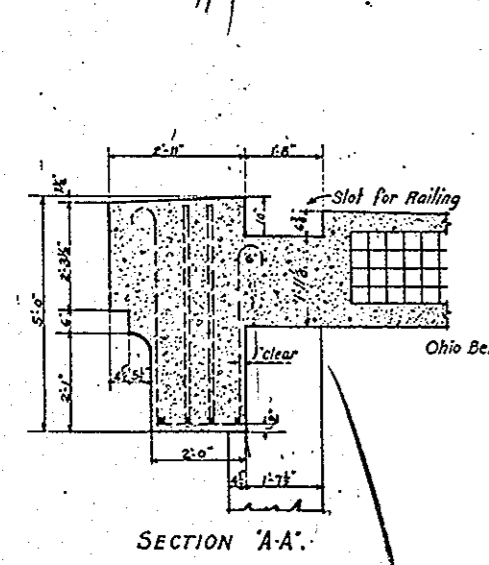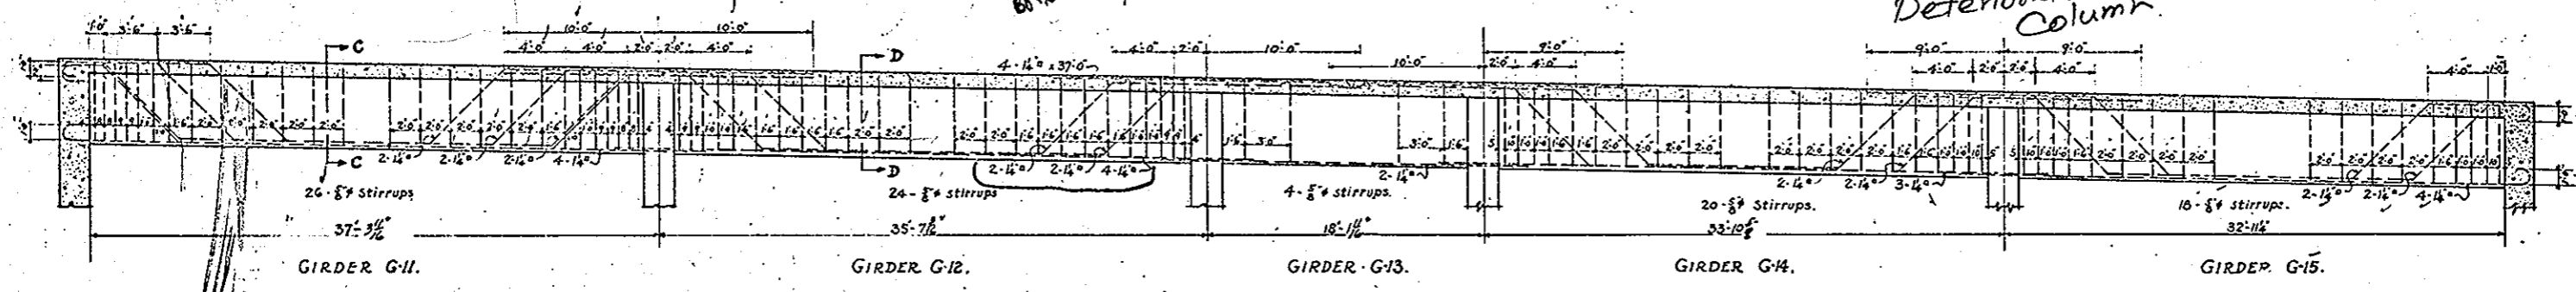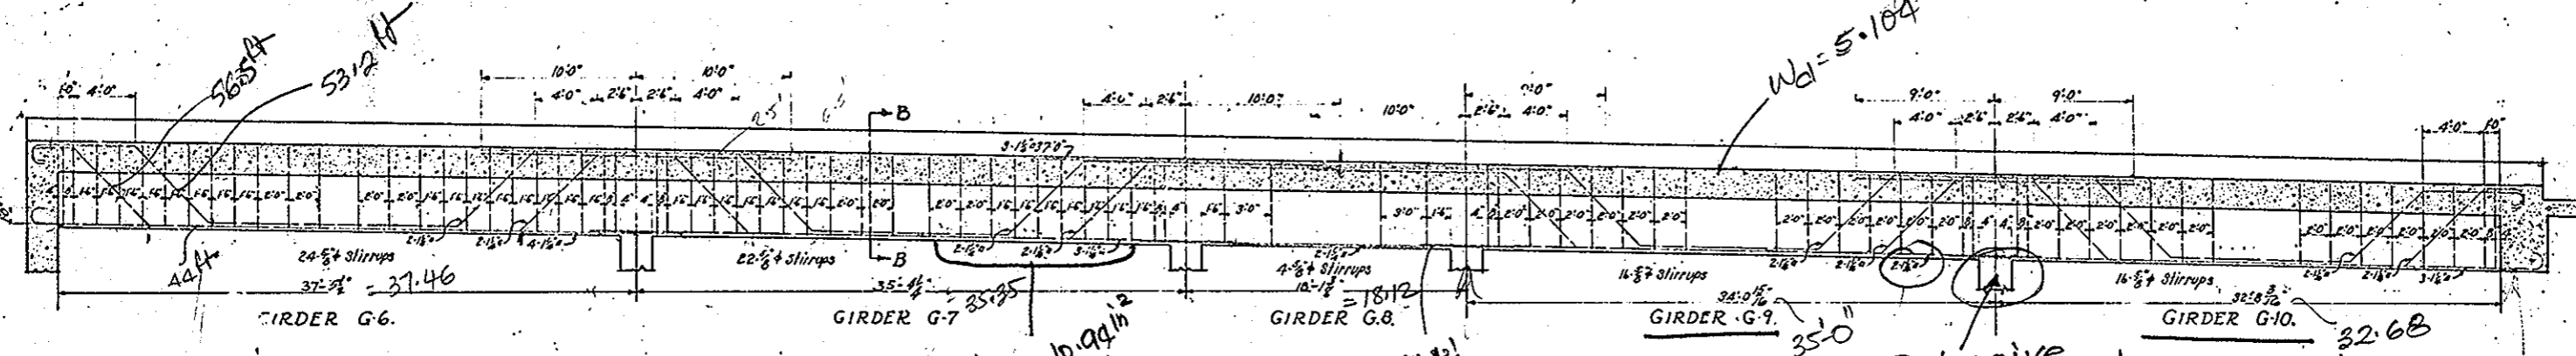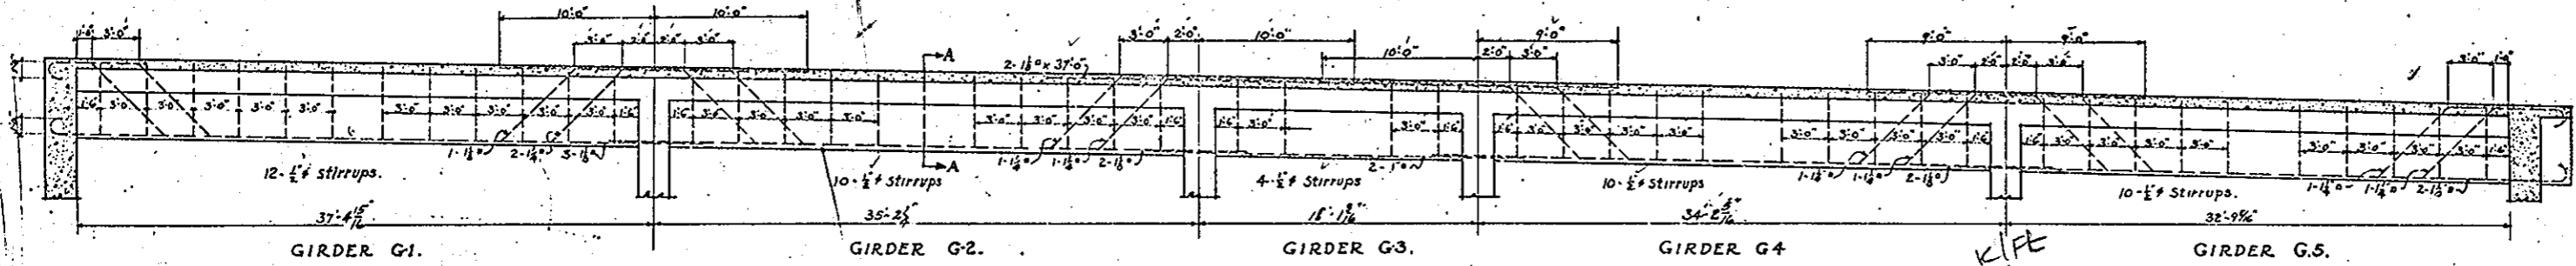

Positive Reinft
7-1 1/4" #8 Bars
For 7 bars 10.94 sq in.
1/4" = 1'-0"
(D.I.L. = 5.104 K/FT)
4.751 K/FT

Carnegie Grade Separation Structure

APPROVED BY

CO. COMM.	
AVOC. COMM.	
CO. ENG.	
PROJ. ENG.	

CUYAHOGA COUNTY	
BOARD OF COMMISSIONERS J. R. ZMUNT J. H. HARRIS W. E. COOK	COUNTY SURVEYOR F. R. WILLIAMS COUNTY BRIDGE ENGINEER A. M. FELGATE
LORAIN - CENTRAL BRIDGE CLEVELAND, O.	
CENTRAL AVE. BRIDGE EXTENSION	
SCALE 3/16" = 1'-0"	
FILE NO. A366	DRAWING NO. 21
WILBUR WATSON AND F. R. WALKER CONSULTING ENGINEERS AND ARCHITECTS CLEVELAND	
DRAWING MADE JAN. 23, 1930	TRACED BY W. P. A. K.
CHECKED BY W. P. A. K.	DATE 1-15-30
APPROVED BY	DATE
REV. BY	DATE
REMARKS	REMARKS

Issue No A Oct. 11, 1926.
REVISIONS:

Issue No B Dec. 28, 1926.
 Moved Gas and Duct Lines
 Chambers one bay east.
 Added Framing Plan.

Issue No C Mar. 8, 1927.
 Revised Framing Plan and
 Section A-A. Added note on
 Water and Sewer Lines.

Issue No 1 Mar. 14, 1927.
 Revised Note.
 Approved by Chief Engineer.

Issue No 2 Mar. 16, 1927.
 Removed Street Lines for Atlas Pl.

Issue No 3 Apr. 14, 1927.
 Moved 6" Water Line to the
 Chamber covering 30" Water Line.

Issue No 4 May 19, 1927.
 Fixed location of St. Car Tracks.
 Revised Framing Plan and Section.

Issue No 5 June 8, 1927.
 Minor Revisions.

Issue No 6 July 1, 1927.
 Redesigned and Redrawn.

Issue No 7 Oct. 12, 1927.
 Revised for 2 Track Subway on
 West side of Bridge.

Issue No 8 Oct. 25, 1927.
 Added C.E.I. Co. Pole Socket.
 Drawing Traced Minor Revisions.

Issue No 9 Nov. 30, 1927.
 Signed By Chief Engineer.
 Minor Revisions.

Issue No 10 Jan. 24, 1928.
 Approved By Heads of Departments.

Issue No 11 Feb. 6, 1928.
 All Water Lines Moved to West
 Side of Bridge.

Issue No 12 April 24, 1928.
 Revised details of water lines.
 Approved by the City.

Issue No 13 Sept. 1, 1928.
 Plan Conforms to Structure as
 Built.

WE HEREBY CERTIFY THAT THIS PLAN
 SHOWS THE STRUCTURE AS BUILT.

E. P. Marsh
 ENGINEER OF STRUCTURES

H. P. Rogelers
 ASST. ENGINEER OF CONSTRUCTION


Designed By G.I.C. & J.H.C. 7-1-1927.

Detailed By S.H. Oct. 12, 1927.


Traced By S.H. Oct. 25, 1927.

Checked By G.I.C. Nov. 1, 1927.

Corrected Nov. 3, 1927.
L. S. Dorman
 Designing Engineer

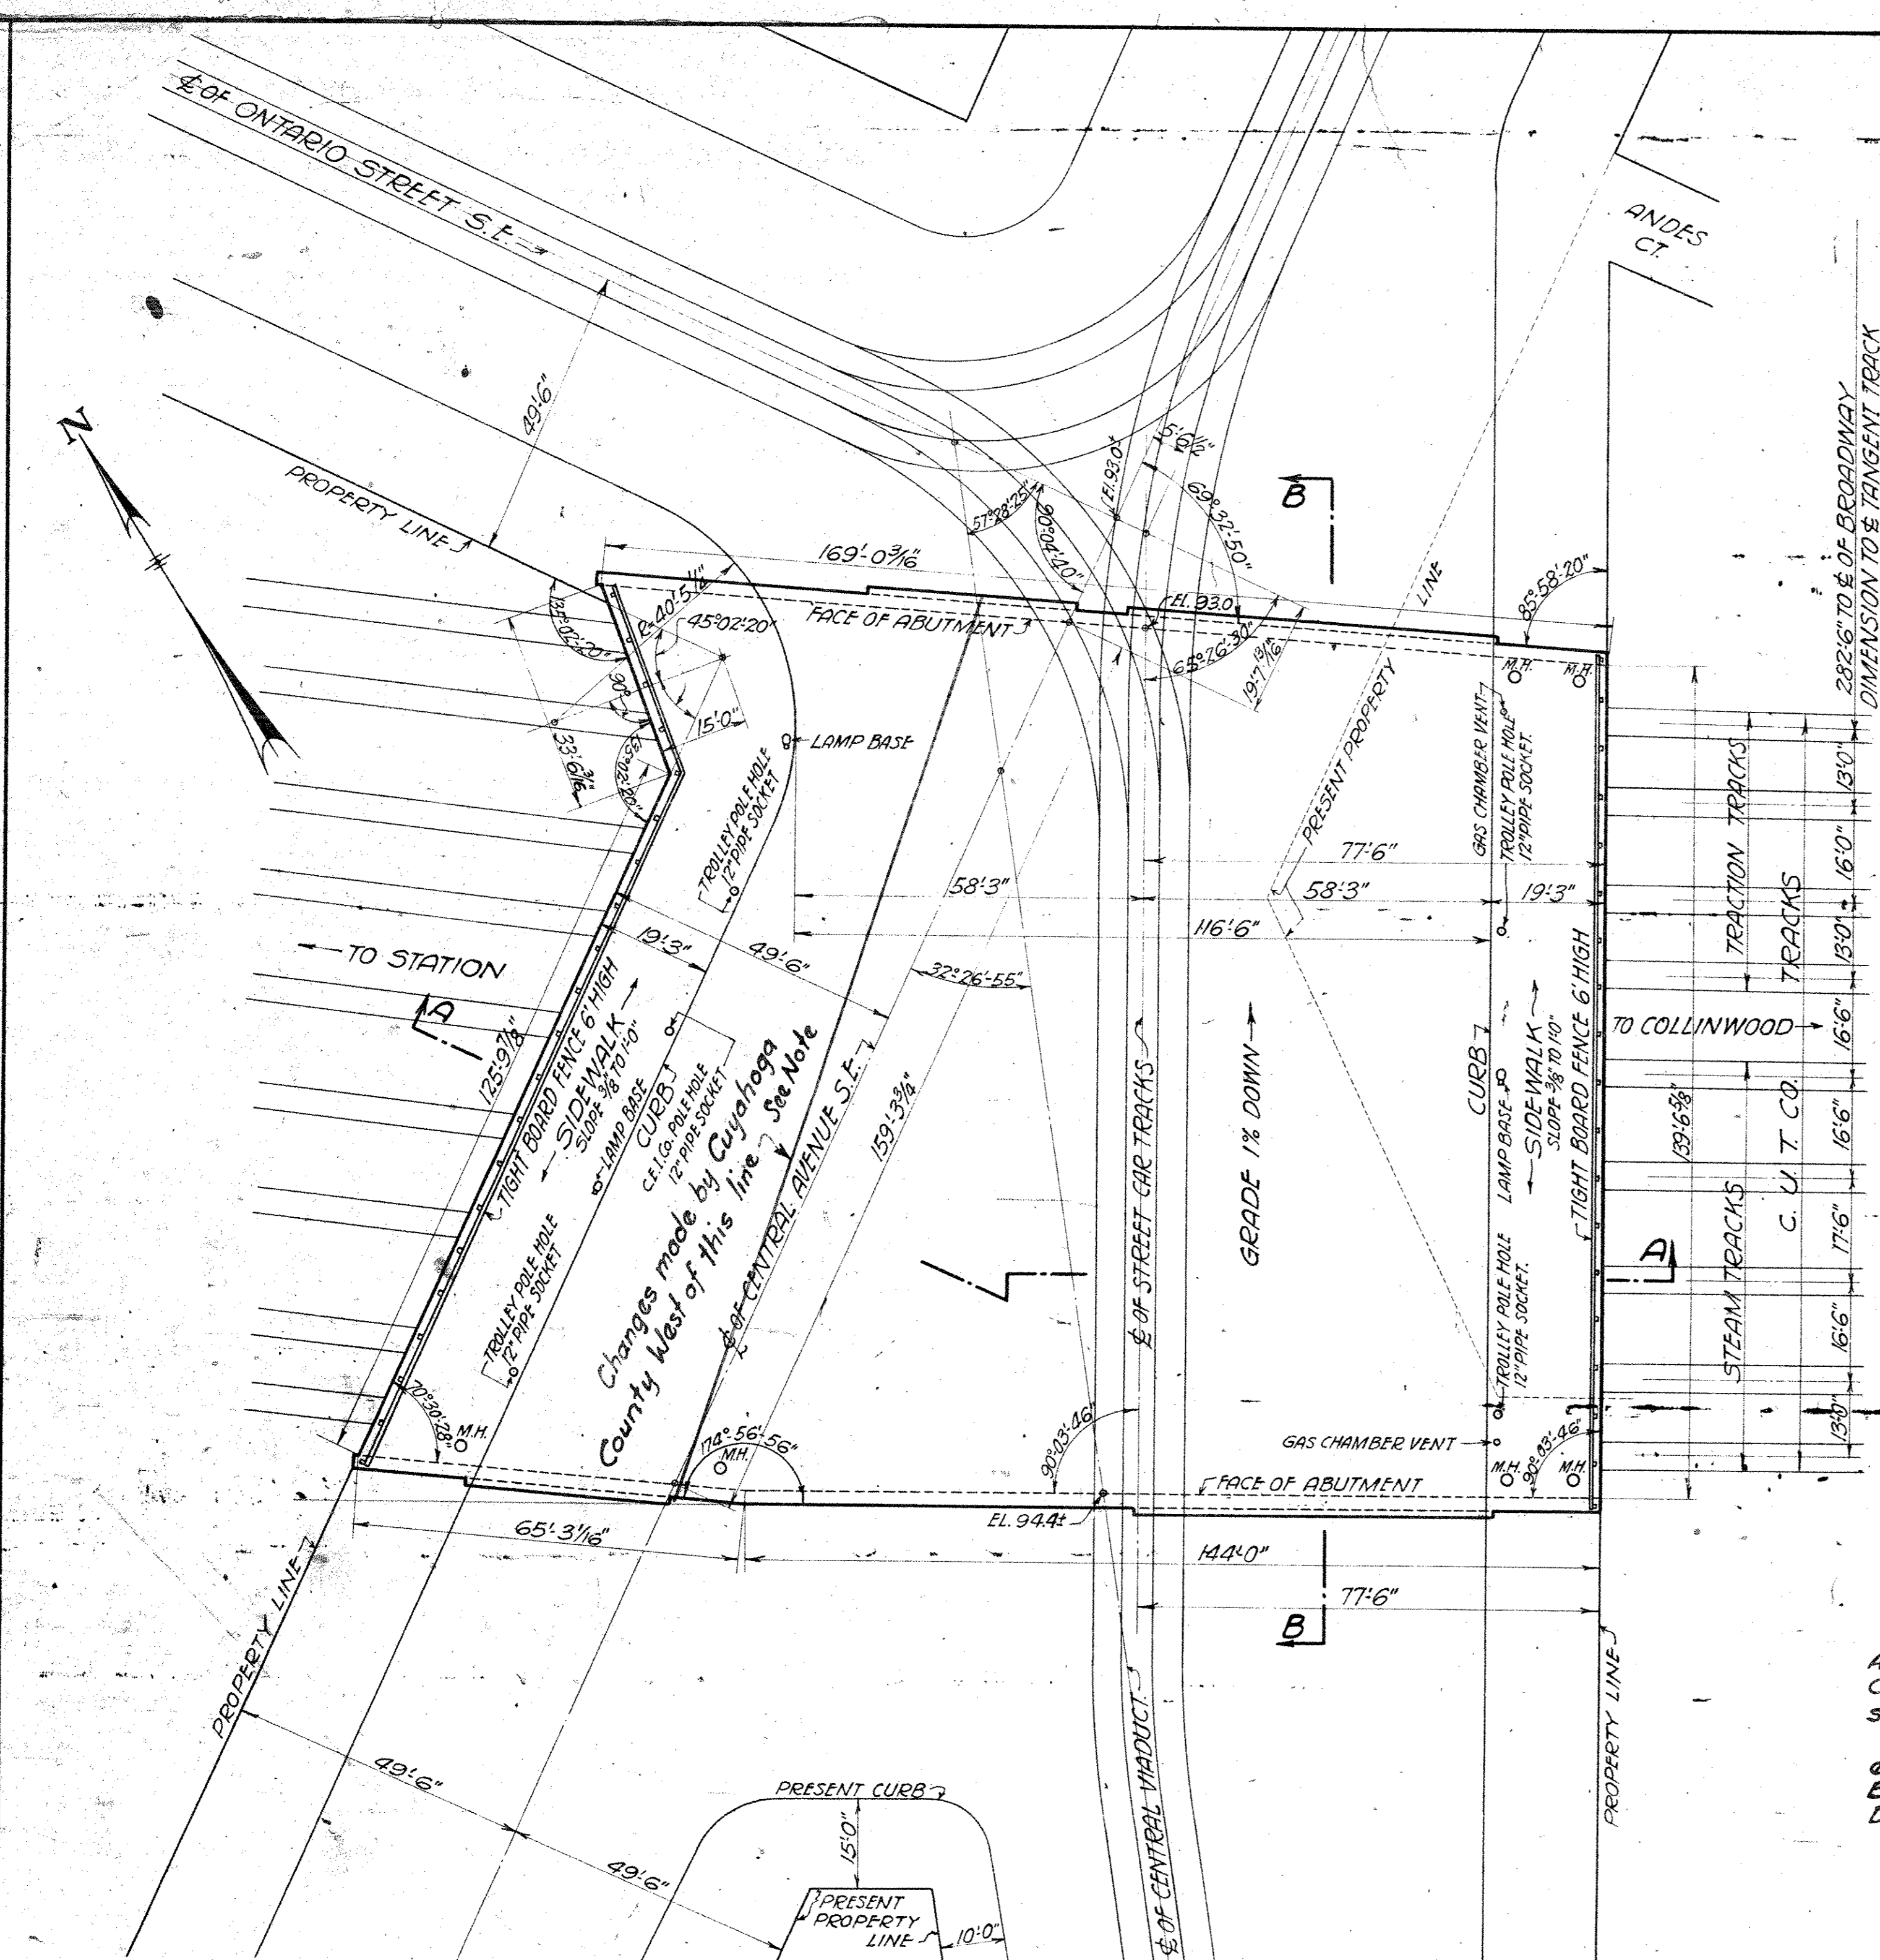


GENERAL PLAN

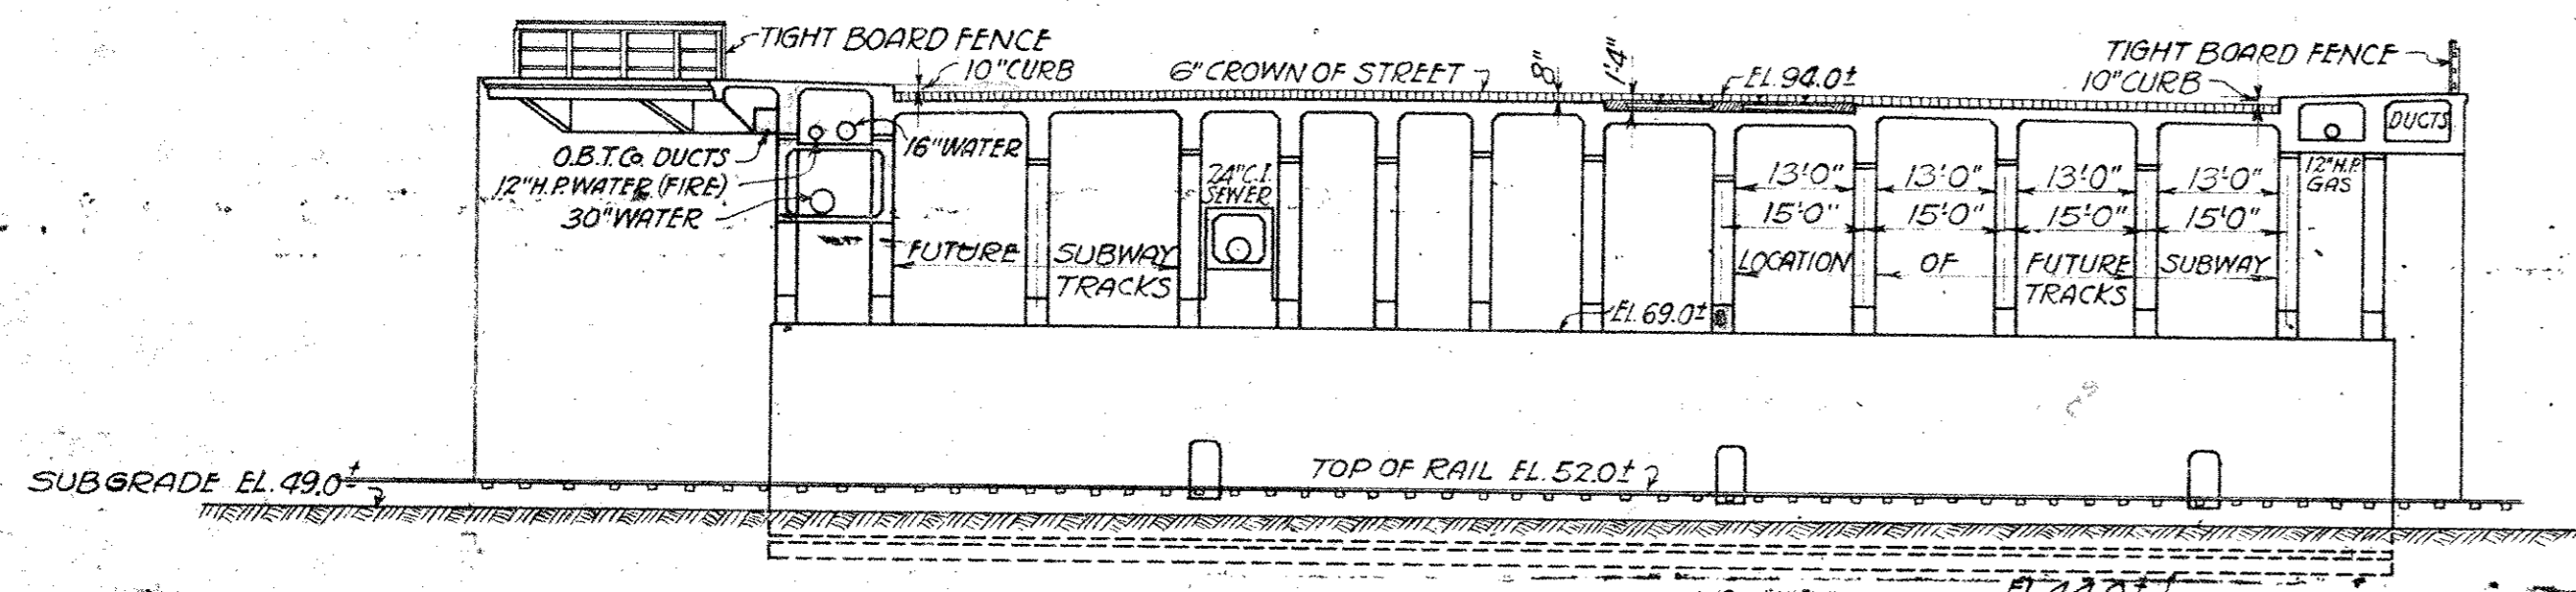


SECTION A-A

GENERAL NOTES:
 All Concrete except duct encasement to be Class 2
 (6 Bags of Cement per Cu. Yd.)
 Duct encasement concrete to be Class 3
 (4 1/3 Bags of Cement per Cu. Yd.)
 No Construction Joints to be made, except as
 shown, without specific authority from the
 Engineer of Structures, C.U.T. Co.
 For explanation of method of marking bent bars,
 see "Standard Bar Marks" Sheet No. 1 of 1,
 Issue No 2 dated June 20, 1927.
 Specifications used for design - C.U.T. Co's.
 "Specifications for Highway Bridges and
 Viaducts" Issue No 1 dated July 10, 1924.
 All exposed edges of Concrete to be chamfered
 1/4" unless otherwise noted.
 In making splices for reinforcement bars the bond
 distance shall be as follows:
 3/8" # 1-6", 1/2" # 2-4", 5/8" # 2-6", 3/4" # 3-10", 7/8" # 3-6",
 1" # 8-10", 4" # 4-0", 1 1/8" # 2-6" and 1 1/4" # 5-0."

Note: Subsequent to the completion of the Central
 Avenue Bridge in accordance with this Plan, the
 County of Cuyahoga made alterations in the westerly
 side of this Bridge and extended it to the west.
 For information concerning the alterations and
 extensions see the County's Plans for "Lorain-Central
 Bridge, Cleveland, Ohio; Central Ave. Bridge Extension"
 Drawings Nos. 18 to 22 inclusive.

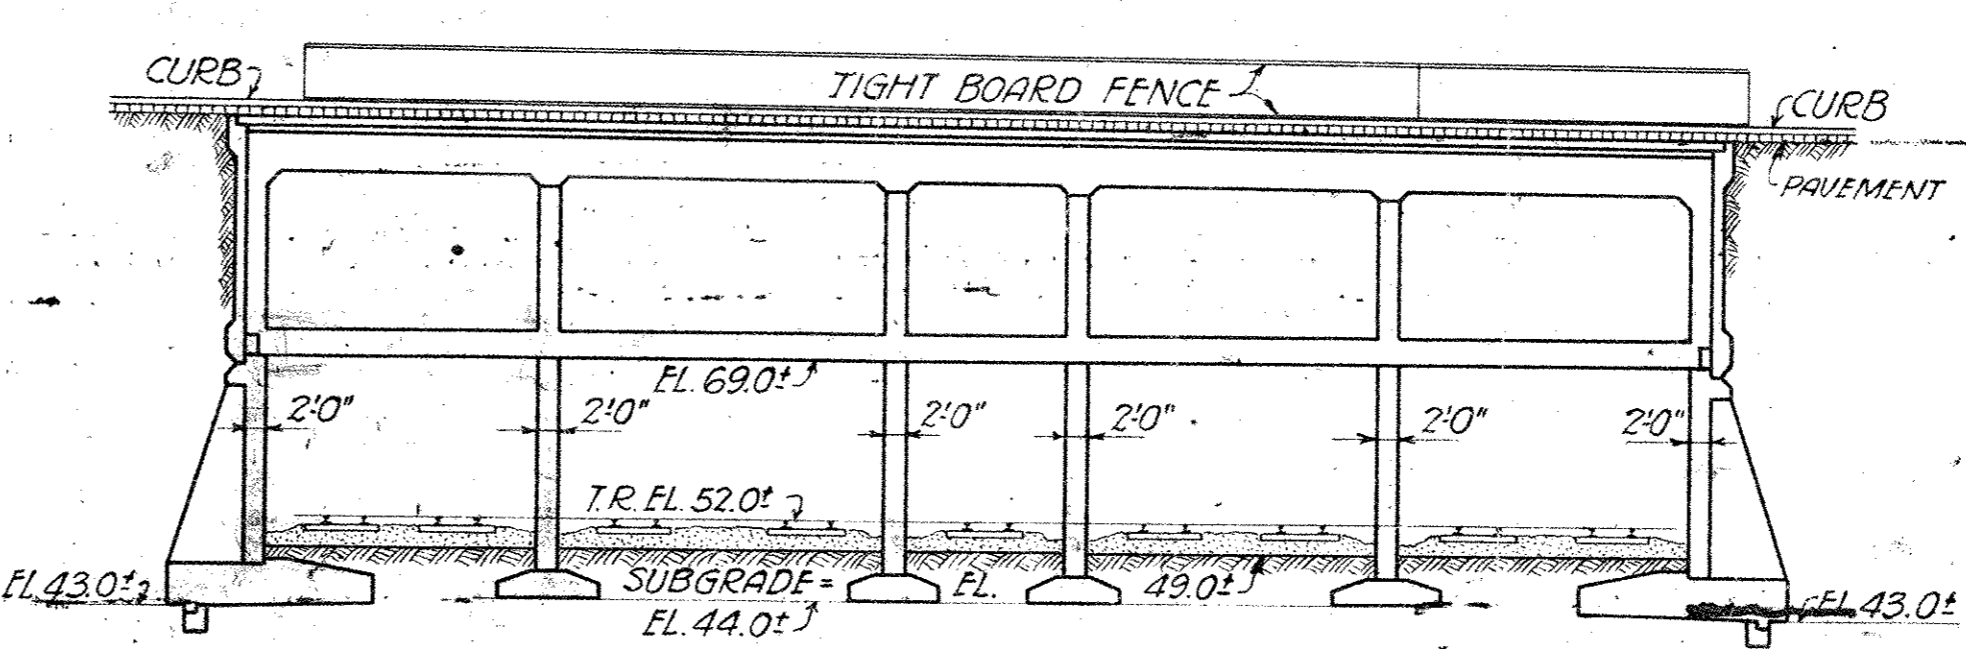

SECTION B-B

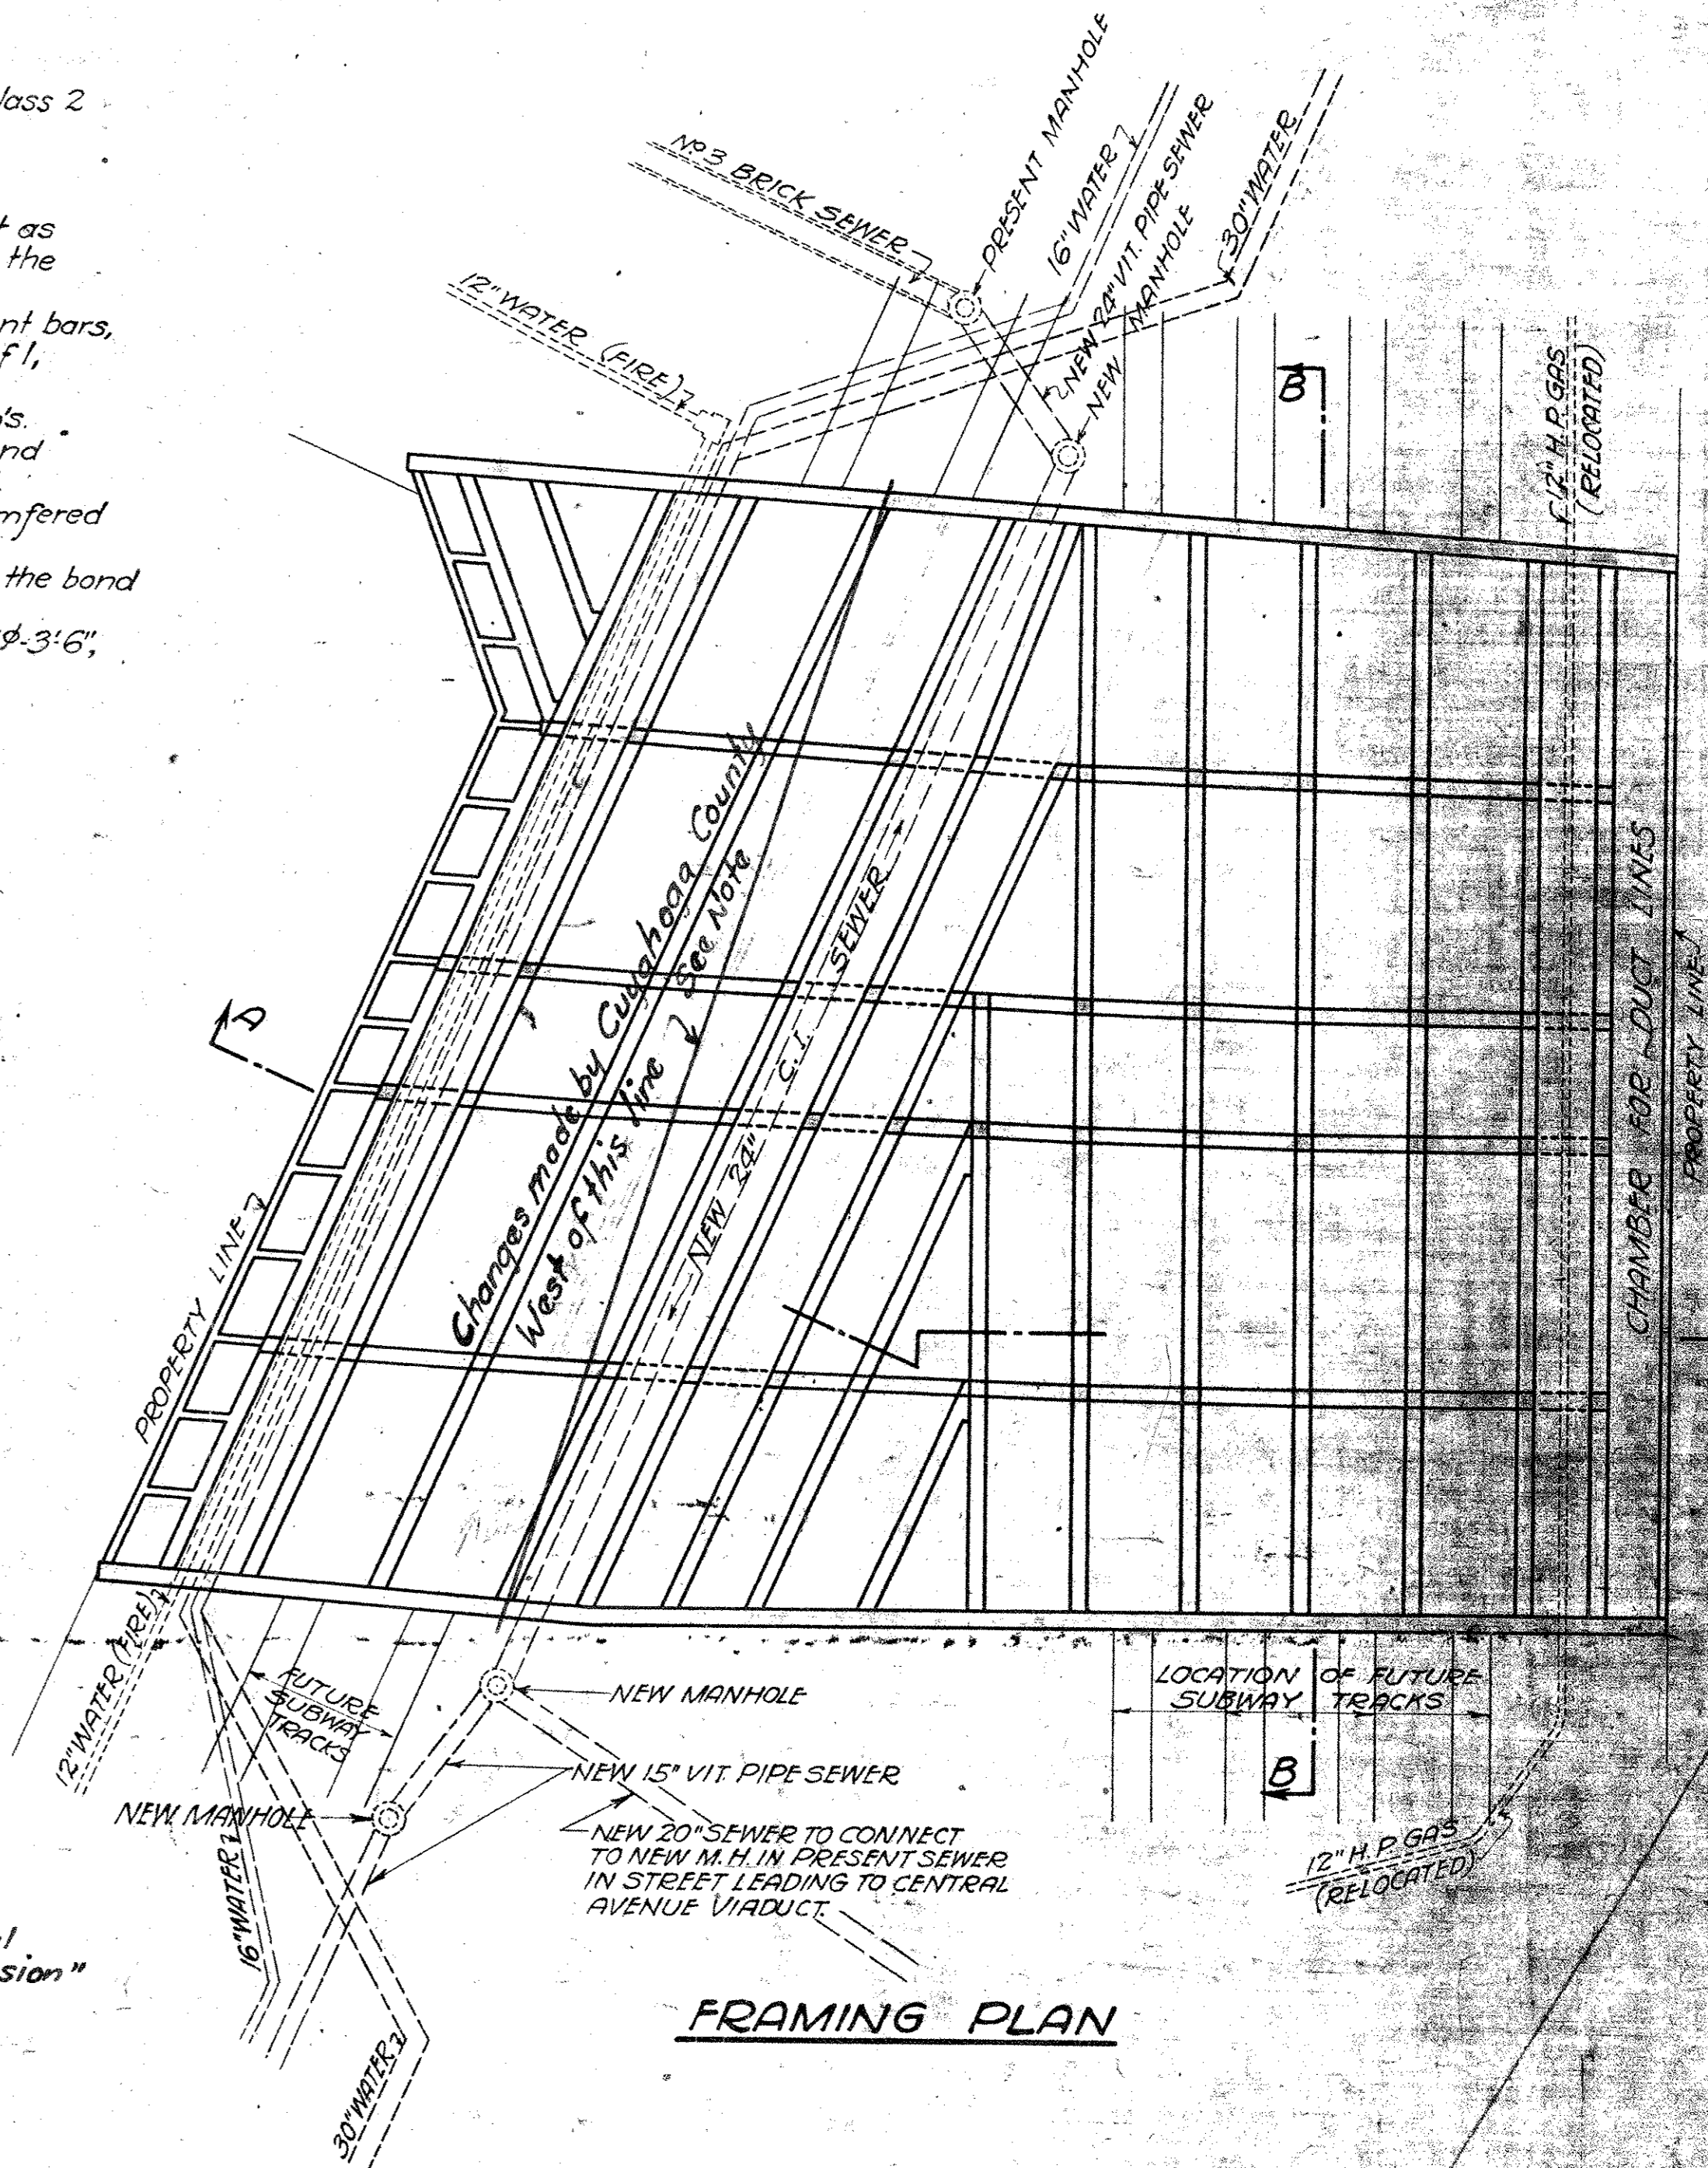

FRAMING PLAN


Plan Approved
CITY OF CLEVELAND
 By *ROBERT HOFFMANN*
 Commissioner of Engineering & Construction
 Date 4-19-28.

THE CLEVELAND UNION TERMINALS CO
CENTRAL AVE. BRIDGE
 GENERAL PLAN
 AND SECTIONS
 CLEVELAND, OHIO
 OFFICE OF ENGINEER OF STRUCTURES
 SCALE: 1" = 20'-0"
 ISSUE NO. 13
 DATE: 10-11-26
 REVISION: 7-1-27

113-065-5

FILE NO. 113-265

Issue No A July 1, 1927.
 REVISIONS:
 Issue No B Oct. 26, 1927.
 Traced & Checked.
 Issue No 1 Nov. 30, 1927.
 Signed By Chief Engineer.
 Minor Revisions.
 Issue No 2 Jan. 24, 1928.
 Approved By Heads of Department.
 Issue No 3 April 24, 1928.
 Approved by the City.
 Issue No 4 Sept. 1, 1933.
 Plan Conforms to Structure as
 Built.

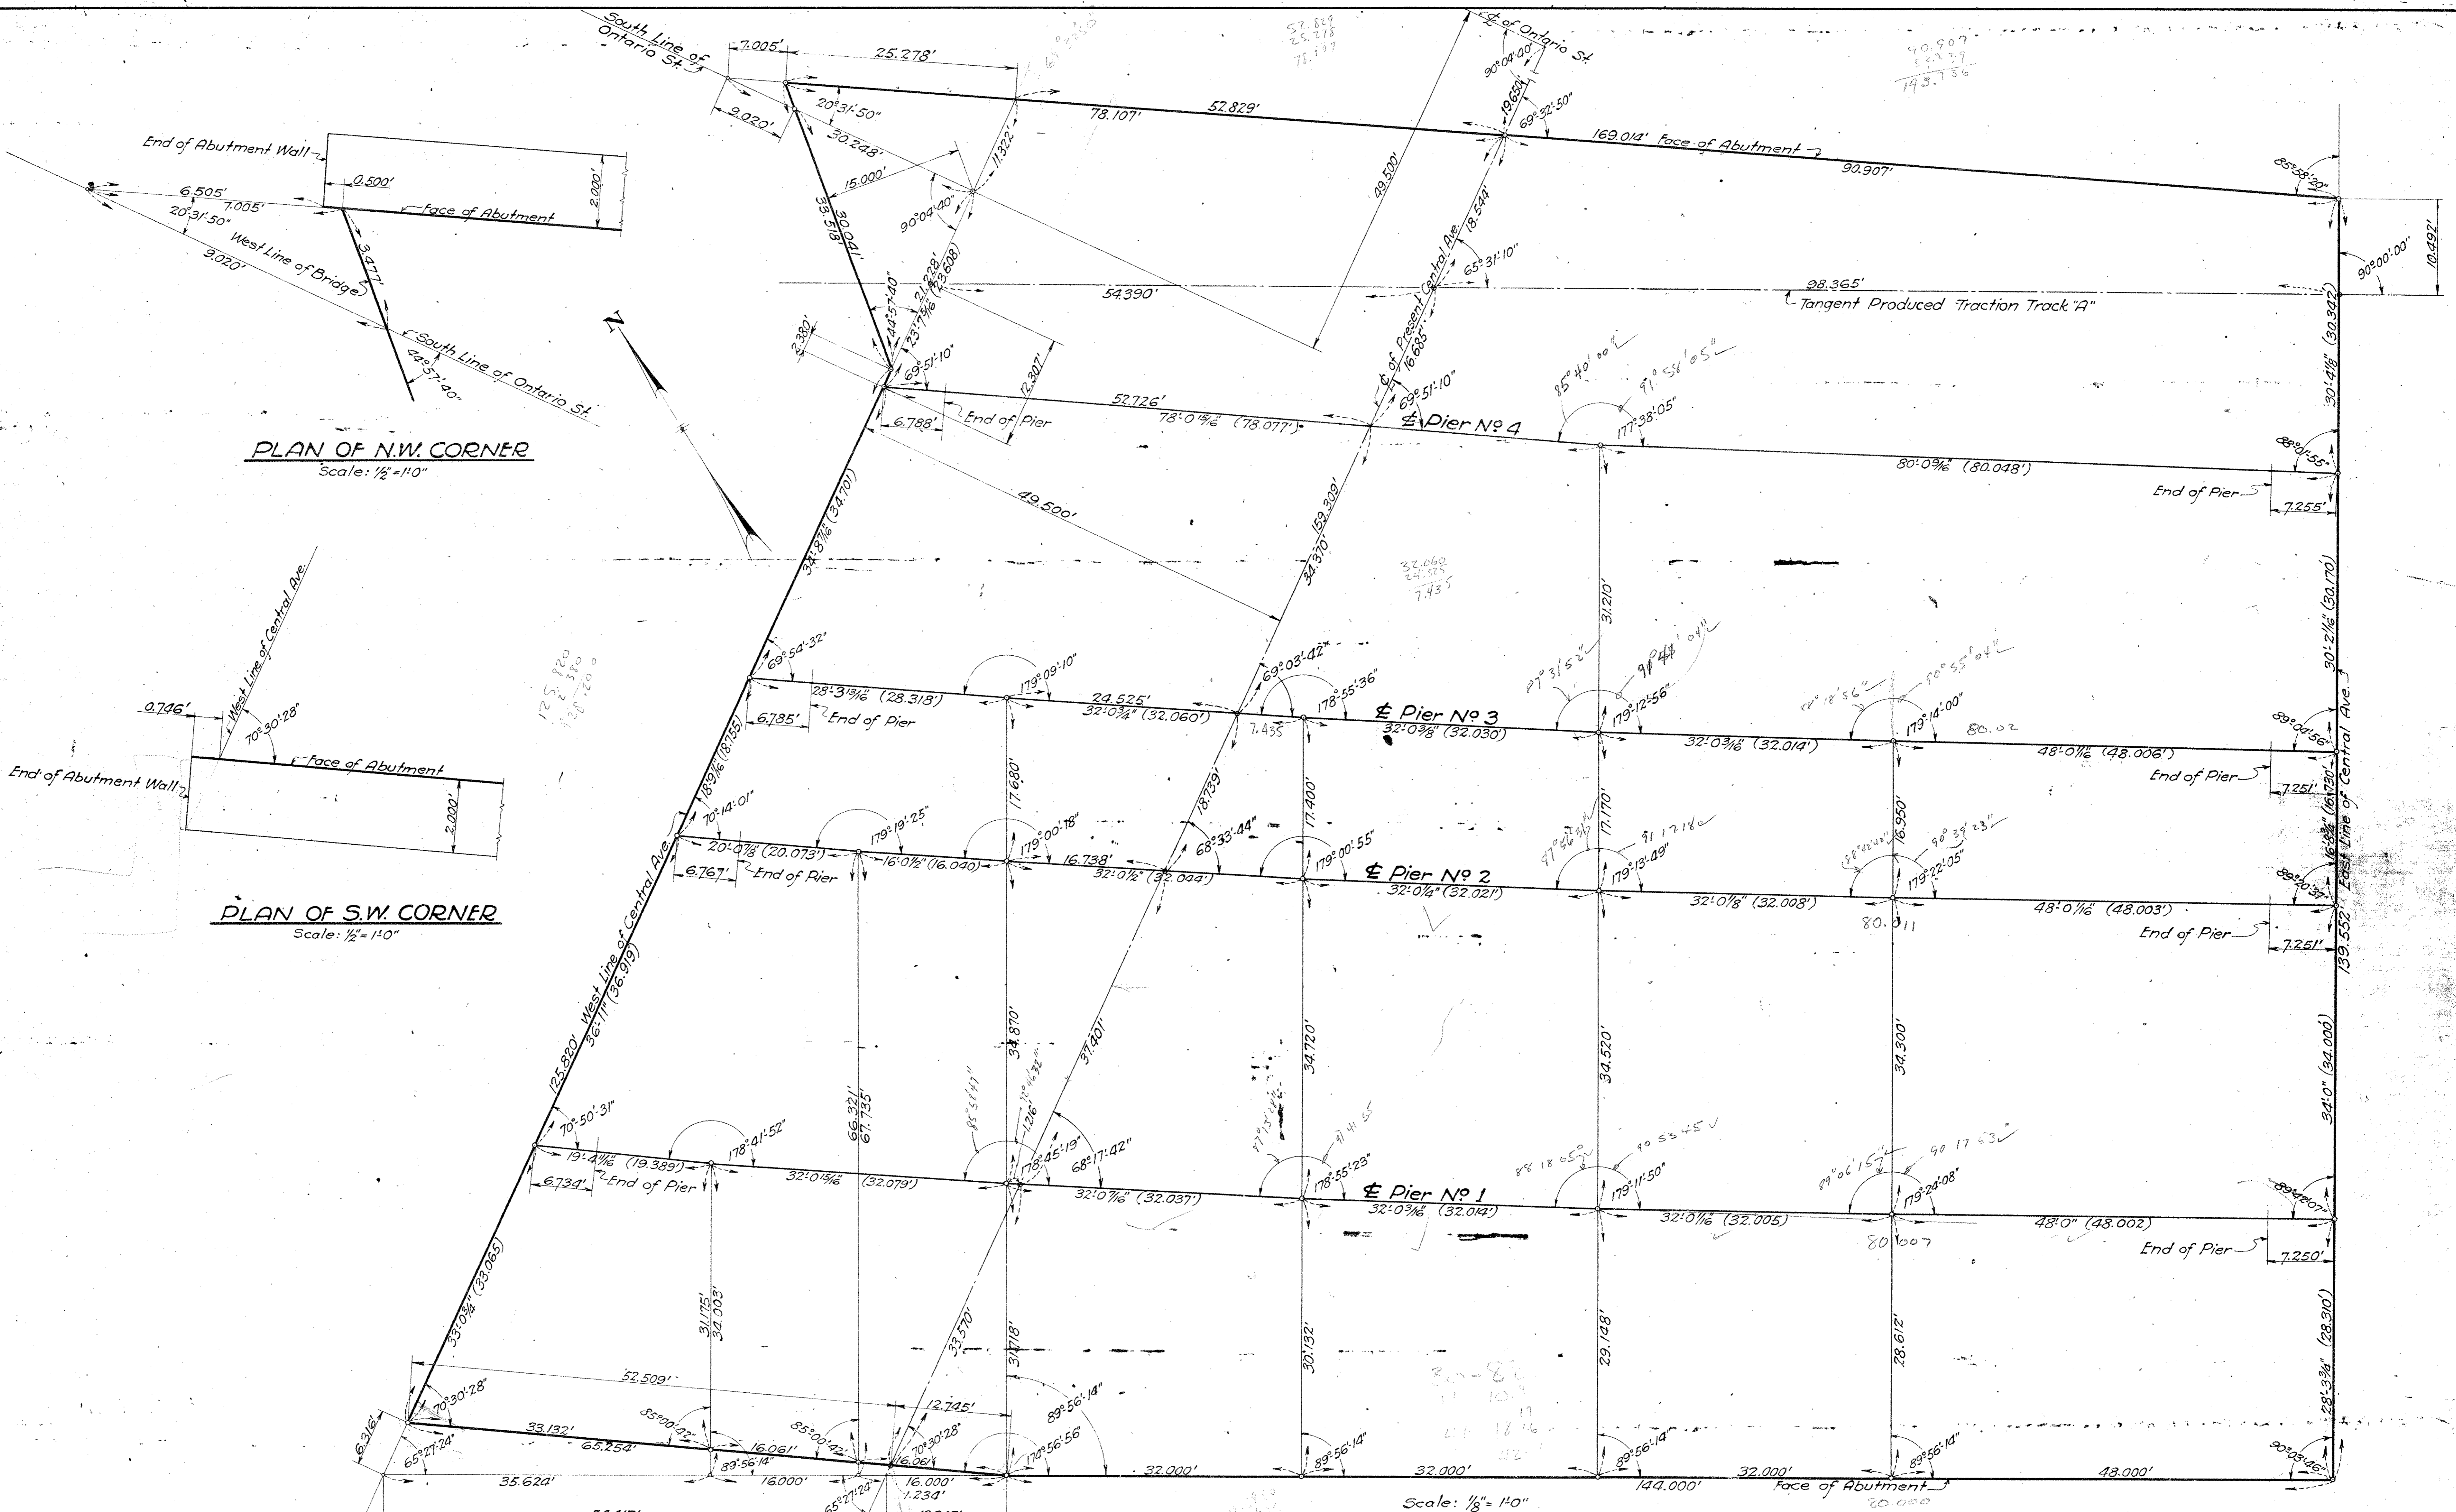

PLAN OF N.W. CORNER
 Scale: 1/2" = 10'

PLAN OF S.W. CORNER
 Scale: 1/2" = 10'

Scale: 1/8" = 10'

WE HEREBY CERTIFY THAT THIS PLAN
 SHOWS THE STRUCTURE AS BUILT.

E. C. Marsh 7/1/27
 ENGINEER OF STRUCTURES
J. H. C. & T. W. 10/26/27
 ASST. ENGINEER OF CONSTRUCTION

Designed By G.C. July 1, 1927.
 Detailed By J.H.C. July 1, 1927.
 Traced By S.H. Oct. 26, 1927.
 Checked By J.H.C. & T.W. 10-26-1927.
 Correct Nov 30, 1927.
A. L. Gorman
 Designing Engineer




Approved *E. C. Marsh*
 Engineer of Structures
 Approved *J. H. C. & T. W.*
 Principal Assistant Engineer
 Approved *H. W. ...*
 Assistant Electrical Engineer
 Approved *J. H. C. & T. W.*
 Engineer of Construction

Plan Approved
CITY OF CLEVELAND
 By **ROBERT HOFFMANN**
 Commissioner of Engineering & Construction
 Date 4-13-28.

THE CLEVELAND UNION TERMINALS CO.
CENTRAL AVE. BRIDGE
LAYOUT PLAN
 CLEVELAND, OHIO.
 OFFICE OF ENGINEER OF STRUCTURES
 SCALE: AS SHOWN
 ISSUE NO. 4
 DATE JULY 1, 1927
 REVISED 9-1-33
E. C. Marsh
 CHIEF ENGINEER

Issue No. 1 Oct. 3, 1927.
 Revisions:-
 Issue No. 2 Oct. 10, 1927.
 Section 'A-A' added. Drawing traced.
 Issue No. 3 Oct. 11, 1927.
 Approved by Chief Engineer.
 Issue No. 4 Oct. 17, 1927.
 Approved by Commissioner of
 Engineering & Construction of the
 City of Cleveland.
 Issue No. 5 Oct. 19, 1927.
 Revised to conform with The
 Cleveland Railway Co.'s Drawing No. 3454.
 Issue No. 6 Jan. 23, 1928.
 Approved By Heads of Departments.

Issue No. 5 Sept. 1, 1933.
 Plan Conforms to Structure as
 Built.

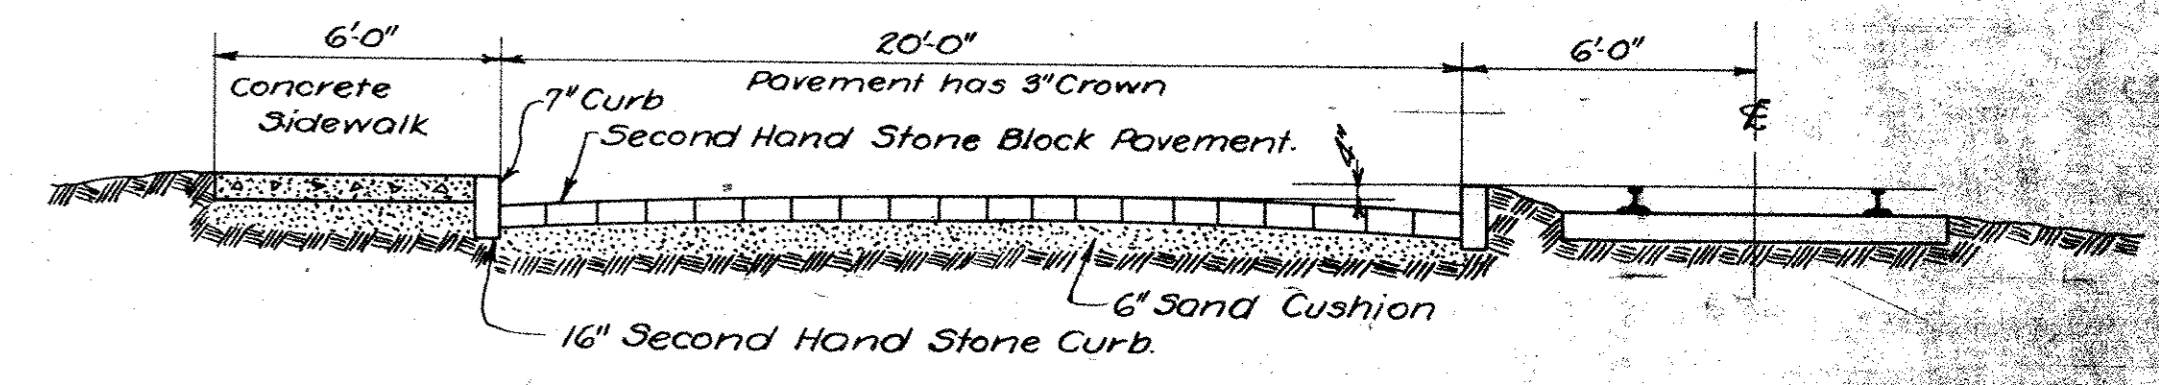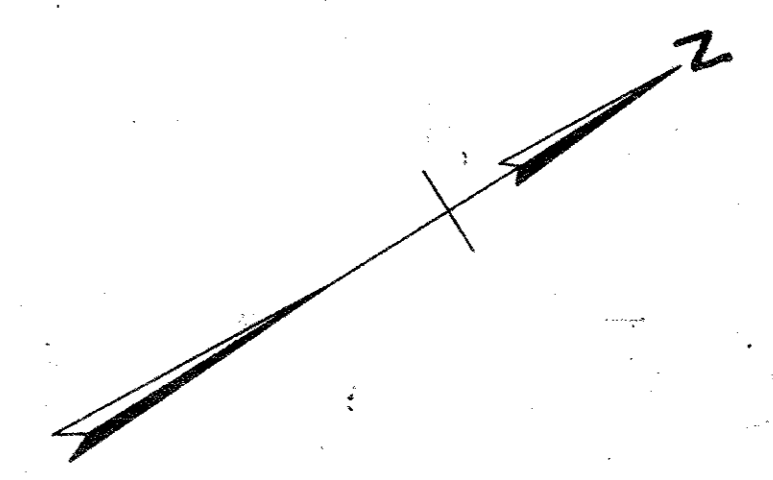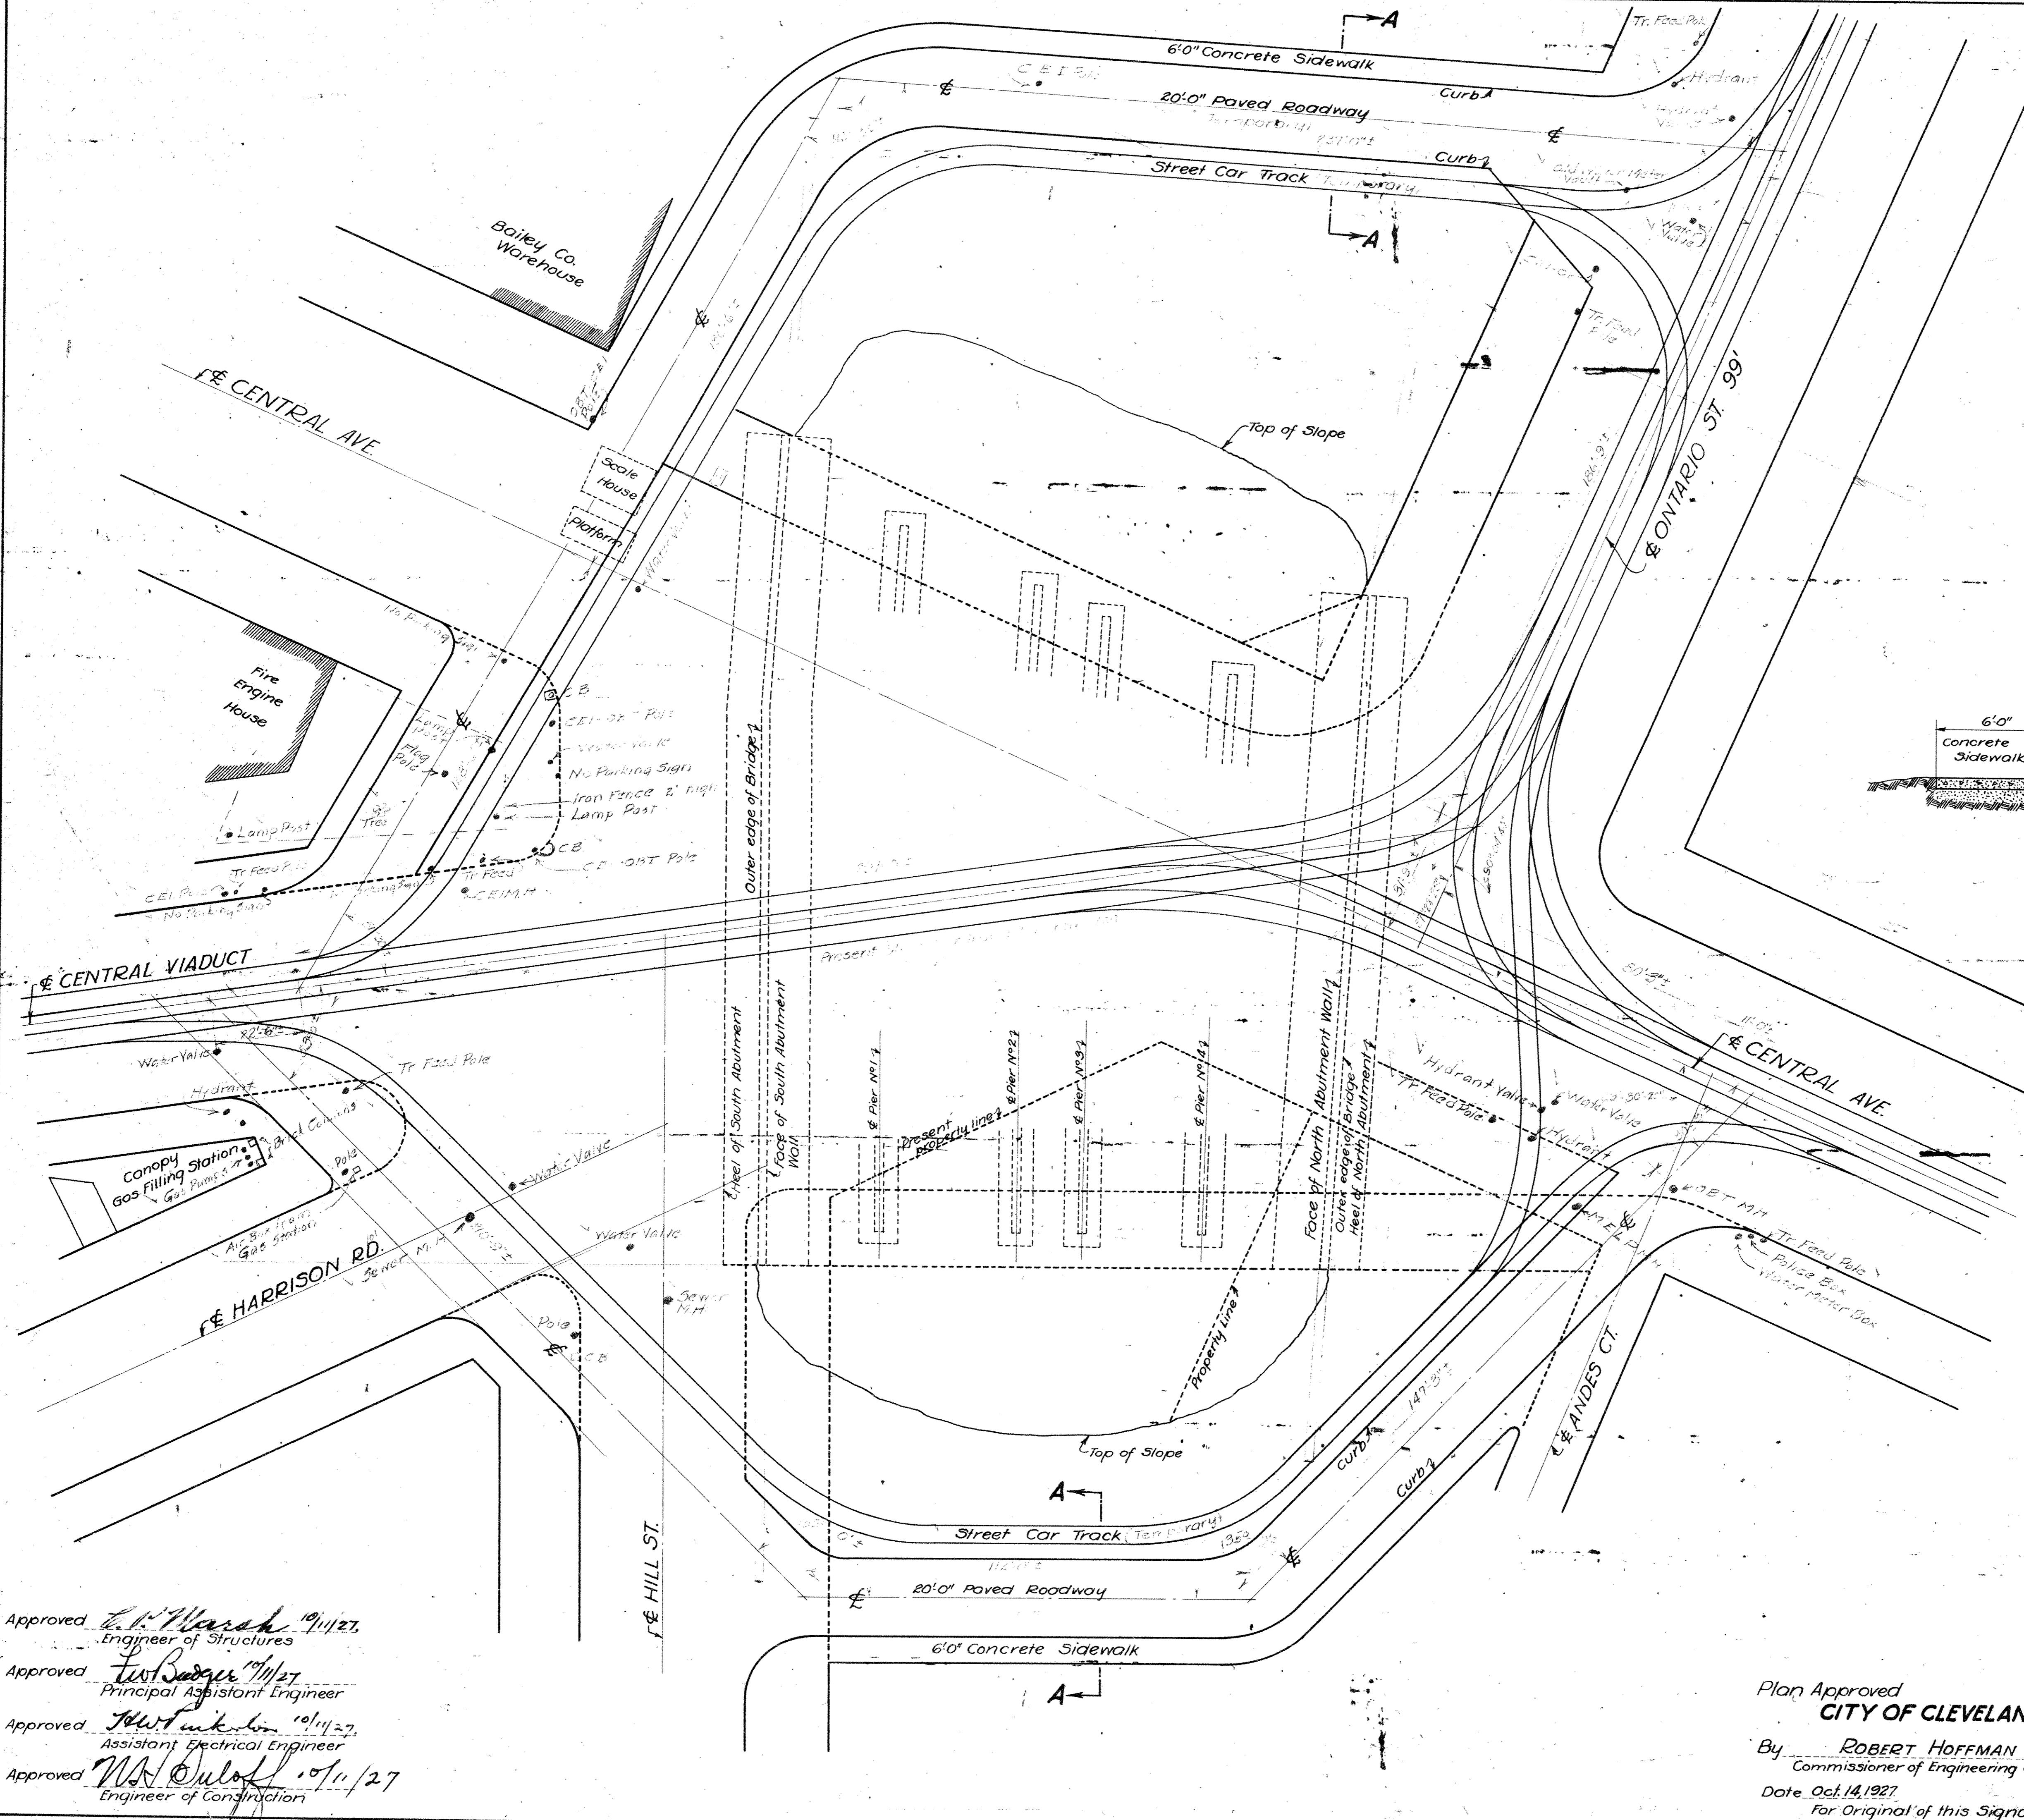

SECTION A-A
 Scale: 1/4" = 1'-0"

WE HEREBY CERTIFY THAT THIS PLAN
 SHOWS THE STRUCTURE AS BUILT.

E. C. Marsh 9/11/24
 ENGINEER OF STRUCTURES
H. P. Beaman 8/29/24
 ASST. ENGINEER OF CONSTRUCTION


Designed By F.L.G. Oct. 3, 1927
 Detailed By G.T.C. Oct. 4, 1927
 Traced By H.B. Oct. 10, 1927
 Checked By G.T.C. Oct. 11, 1927
 Correct OCT. 11, 1927
H. L. Dorman
 Designing Engineer

Approved *E. C. Marsh* 10/11/27
 Engineer of Structures
 Approved *Wm. Rogers* 10/11/27
 Principal Assistant Engineer
 Approved *Wm. T. Tucker* 10/11/27
 Assistant Electrical Engineer
 Approved *W. A. Ouloff* 10/11/27
 Engineer of Construction

Plan Approved
CITY OF CLEVELAND,
 By **ROBERT HOFFMAN**
 Commissioner of Engineering & Construction
 Date Oct. 14, 1927
 For Original of this Signature
 See Blue-Print filed under No. 113-0655

THE CLEVELAND UNION TERMINALS CO.
CENTRAL AVE. BRIDGE
TRAFFIC DIVERSION PLAN
 CLEVELAND OHIO
 OFFICE OF ENGINEER OF STRUCTURES
 SCALE: 1" = 20' 0"
 ISSUE No. 5
 DATE: Oct. 3, 1927
 REVISED: 7-1-33
Wm. T. Tucker
 CHIEF ENGINEER
 FILE No. 113-0655

Issue No A May 26, 1927.
REVISIONS:
 Issue No B Oct. 27, 1927.
 Checked and Traced.
 Issue No 1 Nov. 30, 1927.
 Signed By Chief Engineer
 Issue No 2 Jan. 24, 1928.
 Approved By Heads of Departments.
 Issue No 3 Feb. 6, 1928.
 Changed G10-F to G6-F.
 Issue No 4 April 24, 1928.
 Approved by the City.
 Issue No 5 Sept. 1, 1933.
 Plan Conforms to Structure as
 Built.

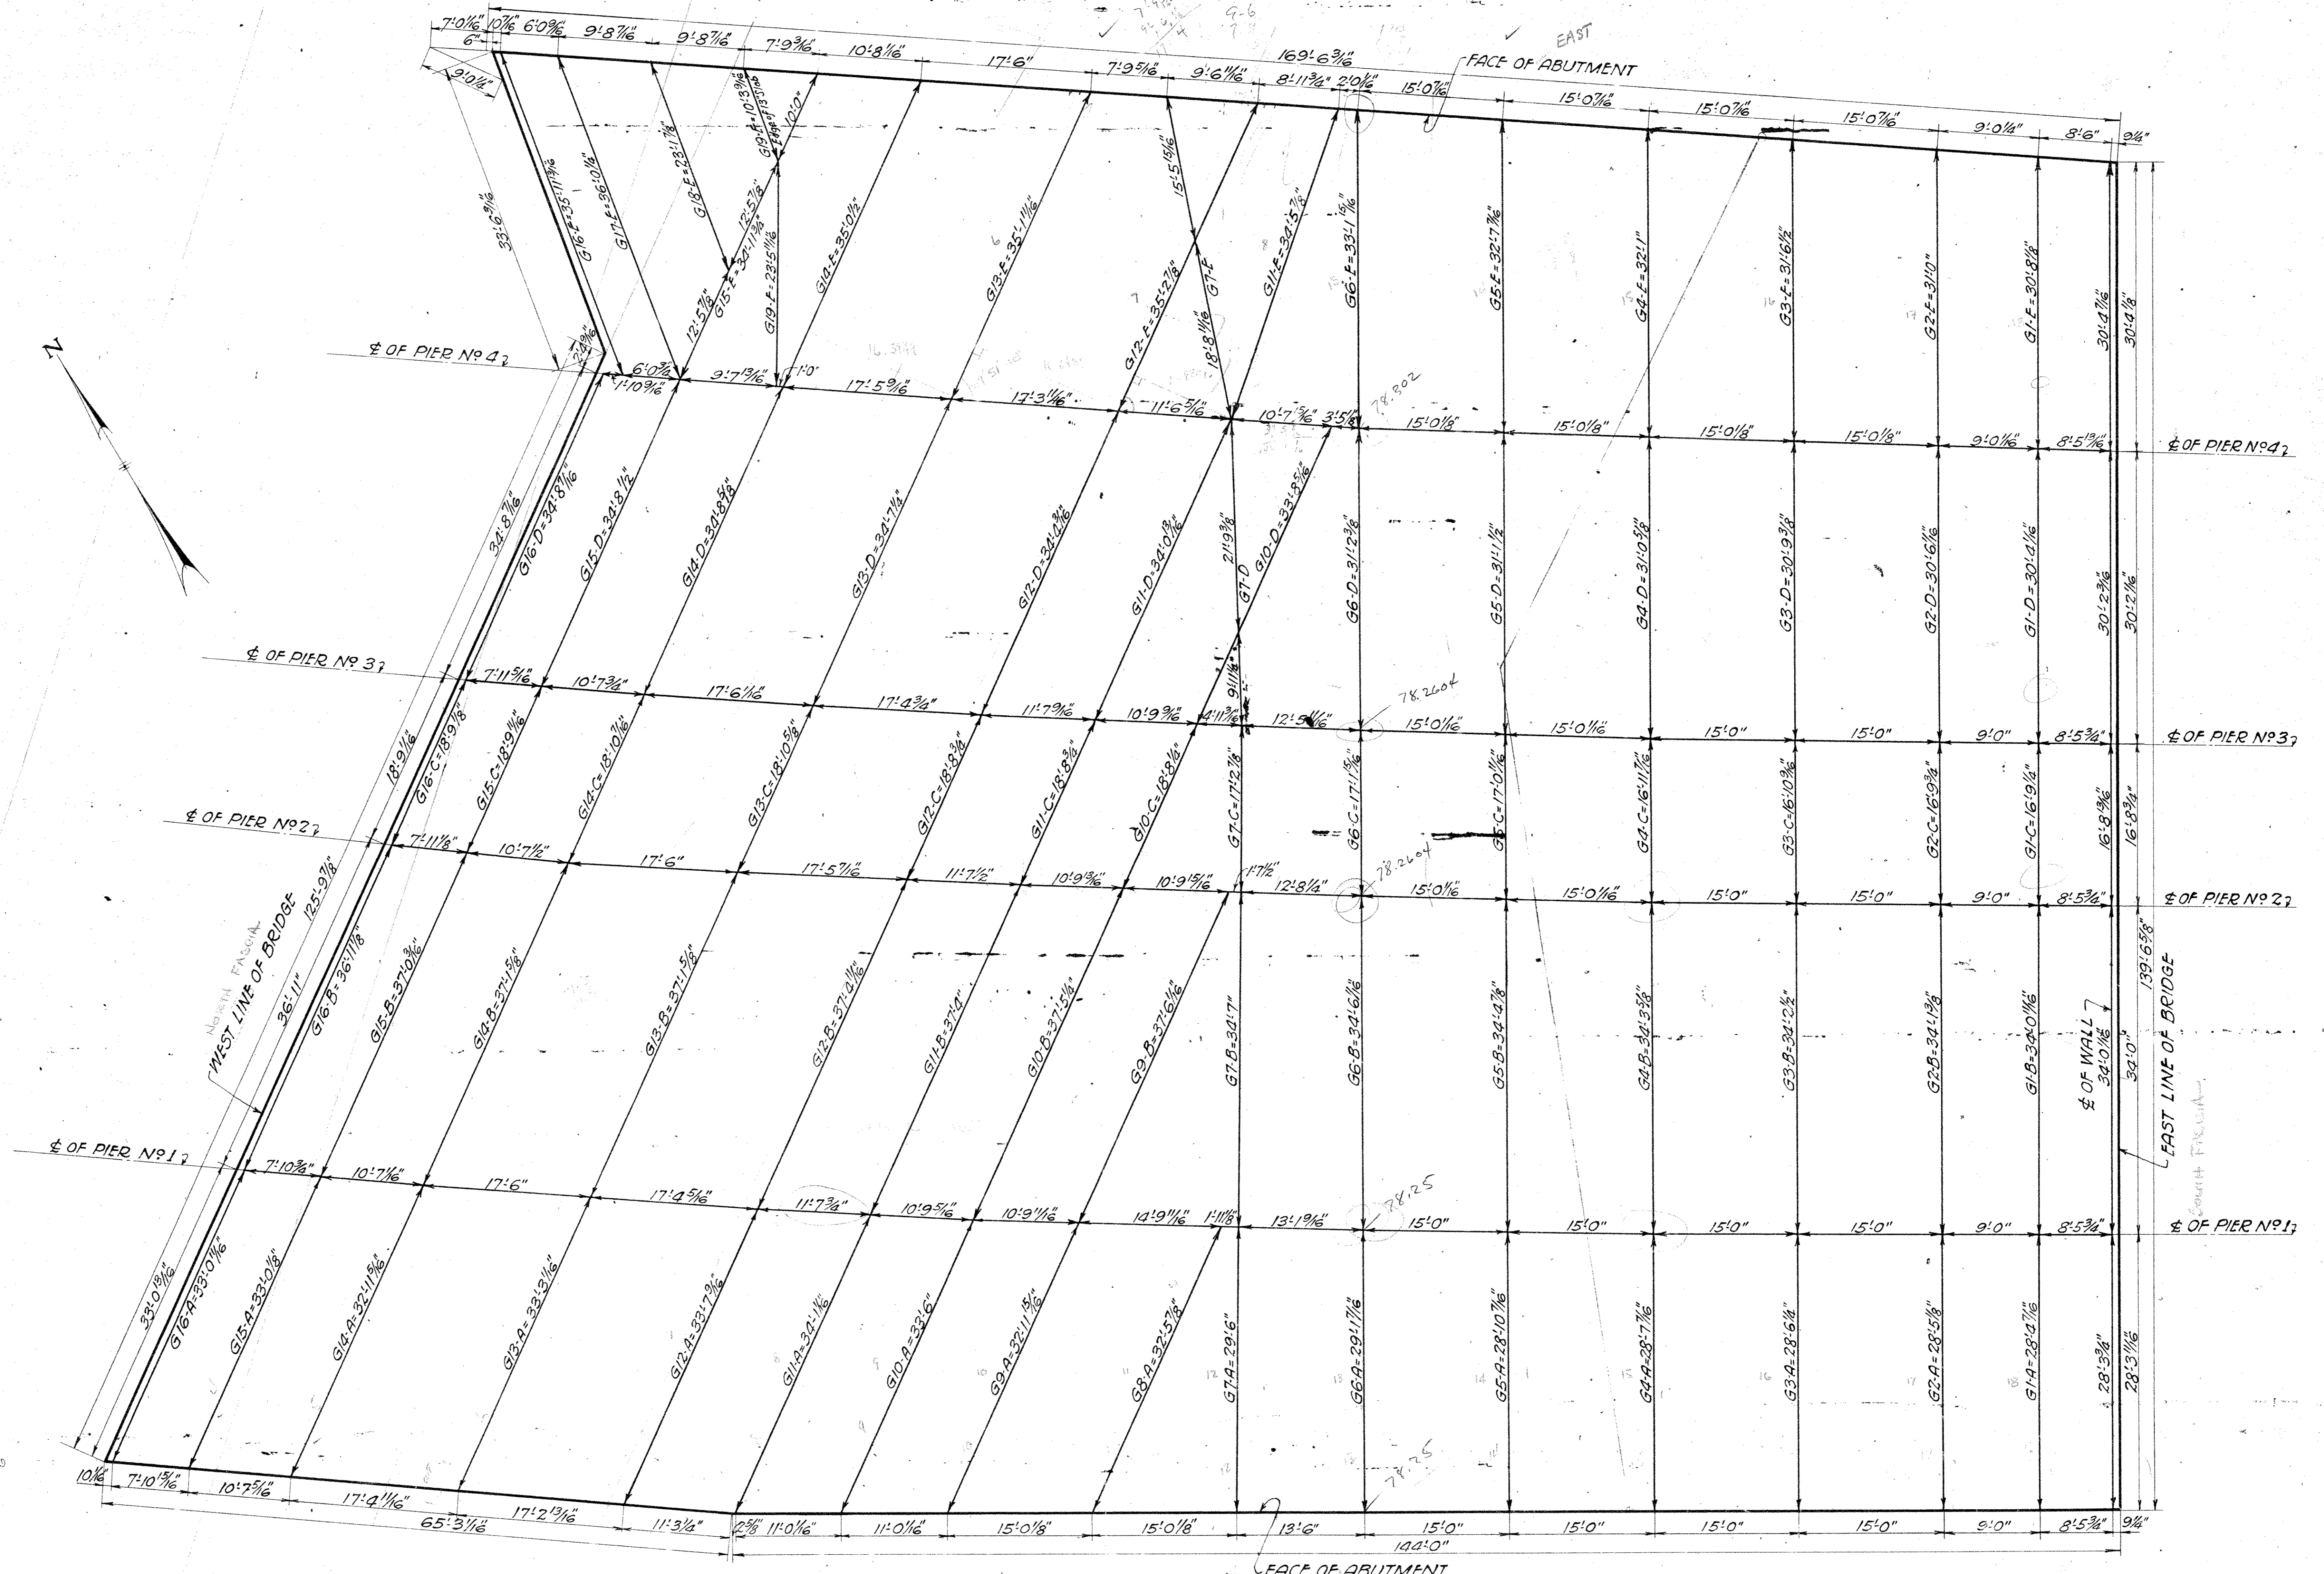

WE HEREBY CERTIFY THAT THIS PLAN
 SHOWS THE STRUCTURE AS BUILT.
E. C. M...
 ENGINEER OF STRUCTURES
H. P. ...
 ASST. ENGINEER OF CONSTRUCTION

Designed By G.T.C. & J.H.C. 5-26-1927.
 Detailed By H.B. May 26, 1927.
 Traced By S.H. Oct. 27, 1927.
 Checked By T.W. Nov. 10, 1927.
 Correct Nov. 30, 1927.
H. L. ...
 Designing Engineer

Approved *E. C. M...*
 Engineer of Structures
 Approved *J. ...*
 Principal Assistant Engineer
 Approved *S. ...*
 Assistant Electrical Engineer
 Approved *J. ...*
 Engineer of Construction

Note: Lengths as given for
 Girders are along the \perp .

Plan Approved
CITY OF CLEVELAND
 By **ROBERT HOFFMANN**
 Commissioner of Engineering & Construction
 Date 4-13-28.

THE CLEVELAND UNION TERMINALS CO.
CENTRAL AVE. BRIDGE
FRAMING PLAN
FOR DECK
 CLEVELAND, OHIO.
 OFFICE OF ENGINEER OF STRUCTURES
 SCALE: 1/8" = 1'-0"
 ISSUE NO. 5
 DATE: MAY 26, 1927
 REVISED 7-1-33
J. ...
 CHIEF ENGINEER
 FILE NO 113-065

Issue B Oct. 24, 1930
 Added note No. 6 and
 revised title.

Issue No. 1 Oct. 27, 1930.
 Signed by the chief engineer.



Designed by E.E.H. LOS
 Detailed by L.O.S.
 Checked by E.E.H.
 Correct [Signature]
 Assistant Engineer

Approved [Signature] 10/24/30
 Engineer of Structures
 Approved [Signature] 10/25
 Principal Assistant Engineer
 Approved [Signature] 10/27/30
 Engineer of Construction
 Approved [Signature] 10/27/30
 Assistant Electrical Engineer

CENTRAL


- Note:
 Location of piers and abutments is based upon following assumptions:
1. Net clearance equals 7 feet.
 2. Maximum width of piers 24' except as noted.
 3. Maximum superelevation on circular curves of
 (a) 5 inches for traction tracks and
 (b) 4 inches for steam tracks with a run-off in the length of spiral.
 4. Length of car for all tracks equals 86'; Truck centers equal 60'.
 5. Top of low rail elevation for all tracks within limits of bridge equals 52.0'
 6. The under clearance line for that portion of the bridge extension structure over the C.U.T. Co. tracks is at elevation 64.50.

THE CLEVELAND UNION TERMINALS COMPANY
 LOCATION OF PIERS FOR CENTRAL AVE. BR. EXTENSION
 CLEVELAND, OHIO.
 Office of Engineer of Structures

Scale 1"=10ft.
 Issue No. 1

Oct. 13, 1930
 Revised [Signature] 10/27/30
 Chief Engineer

Issue No A Oct. 18, 1927.
REVISIONS:
 Issue No B Nov. 3, 1927.
 Revised for C.F.I. Co. Insert.
 Drawing Checked and Traced.
 Issue No 1 Nov. 30, 1927.
 Signed By Chief Engineer.
 Issue No 2 Jan. 24, 1928.
 Approved By Heads of Departments.
 Issue No 3 Feb. 7, 1928.
 Removed Water Chambers.
 Issue No 4 Apr. 24, 1928.
 Approved by the City.
 Issue No 5 Sept. 1, 1933.
 Plan Conforms to Structure as Built.

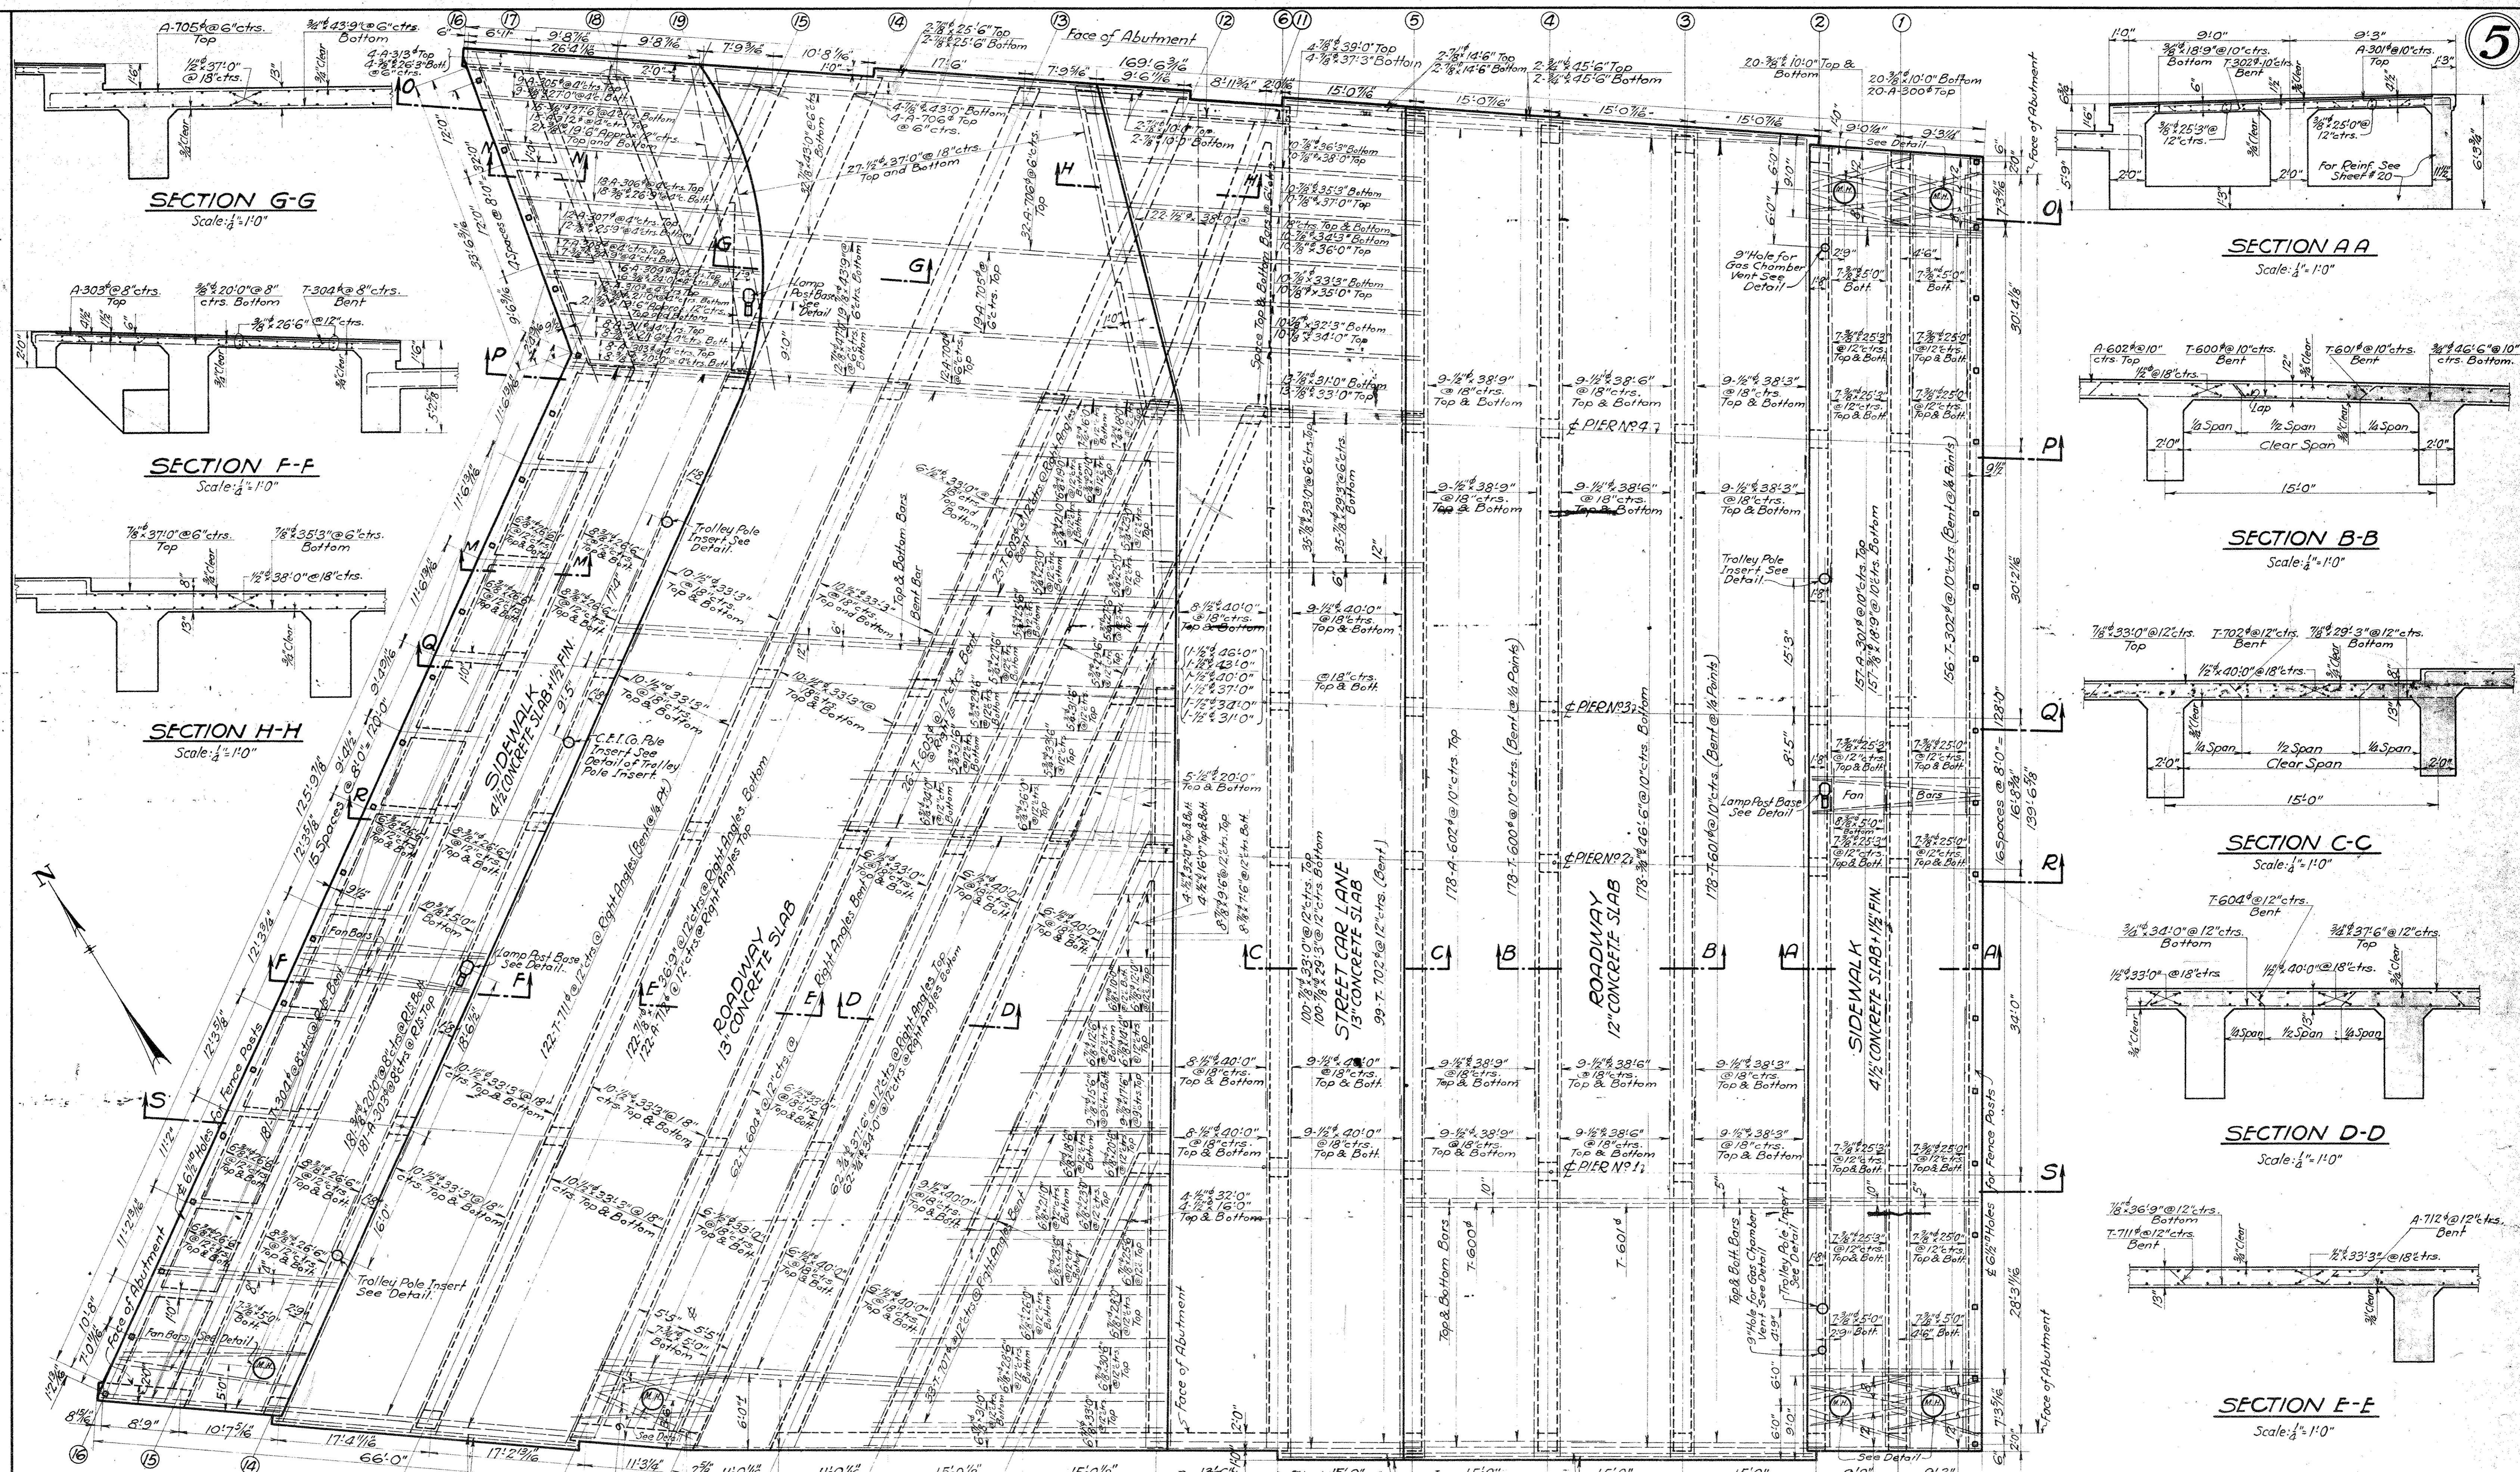

SECTION G-G
 Scale: 1/4" = 1'-0"

SECTION F-F
 Scale: 1/4" = 1'-0"

SECTION H-H
 Scale: 1/4" = 1'-0"

SECTION A-A
 Scale: 1/4" = 1'-0"

SECTION B-B
 Scale: 1/4" = 1'-0"

SECTION C-C
 Scale: 1/4" = 1'-0"

SECTION D-D
 Scale: 1/4" = 1'-0"

SECTION E-E
 Scale: 1/4" = 1'-0"

We hereby certify that this plan shows the structure as built.
E. D. Marsh
 ENGINEER OF STRUCTURES
J. P. ...
 ASST. ENGINEER OF CONSTRUCTION
 Designed By G.T.C. May 27, 1927.
 Detailed By S.H. Oct. 18, 1927.
 Traced By S.H. Nov. 3, 1927.
 Checked By L.C.B. Nov. 5, 1927.
 Corrected Nov. 30, 1927.
J. L. ...
 Designing Engineer

Approved *E. D. Marsh*
 Engineer of Structures
 Approved *J. P. ...*
 Principal Assistant Engineer
 Approved *J. H. ...*
 Assistant Electrical Engineer
 Approved *J. L. ...*
 Engineer of Construction







NOTE: For Sections M-M and N-N See Sheet No 19
 For Sections O-O, P-P, Q-Q, R-R & S-S See Sh. No 11
 All Manholes are City of Cleveland Standard 2'-4" Manholes.
 For Details of Manholes, Lamp Post Base, 9" Hole for Gas Chamber Vent, Trolley Pole & C.F.I. Co. Pole Anchorage See Sheet No 19.
 See Sheets #18 & 18A for Details at Curtain Walls.

PLAN OF ROADWAY & SIDEWALK SLABS
 Scale: 1/4" = 1'-0"

Plan Approved
CITY OF CLEVELAND
 By *ROBERT HOFFMANN*
 Commissioner of Engineering & Construction
 Date 4-13-28.


THE CLEVELAND UNION TERMINALS CO.
CENTRAL AVE. BRIDGE
ROADWAY AND SIDEWALK SLABS
 CLEVELAND, OHIO.
 OFFICE OF ENGINEER OF STRUCTURES
 SCALE: AS NOTED. DATE: 10-18-1927.
 ISSUE NO. 5. REVISED 9-1-33
J. L. ...
 CHIEF ENGINEER
 FILE NO 113-065

Issue No A Aug. 5, 1927.
 REVISIONS:
 Issue No B Nov. 16, 1927.
 Drawing Checked.
 Issue No C Dec. 5, 1927.
 Drawing Traced.
 Issue No 1 Dec. 16, 1927.
 Signed By Chief Engineer.
 Issue No 2 Jan. 24, 1928.
 Approved By Heads of Departments.
 Issue No 3 April 20, 1928.
 Approved by the City.
 Issue No 4 Sept. 1, 1933.
 Plan Conforms to Structure as Built.

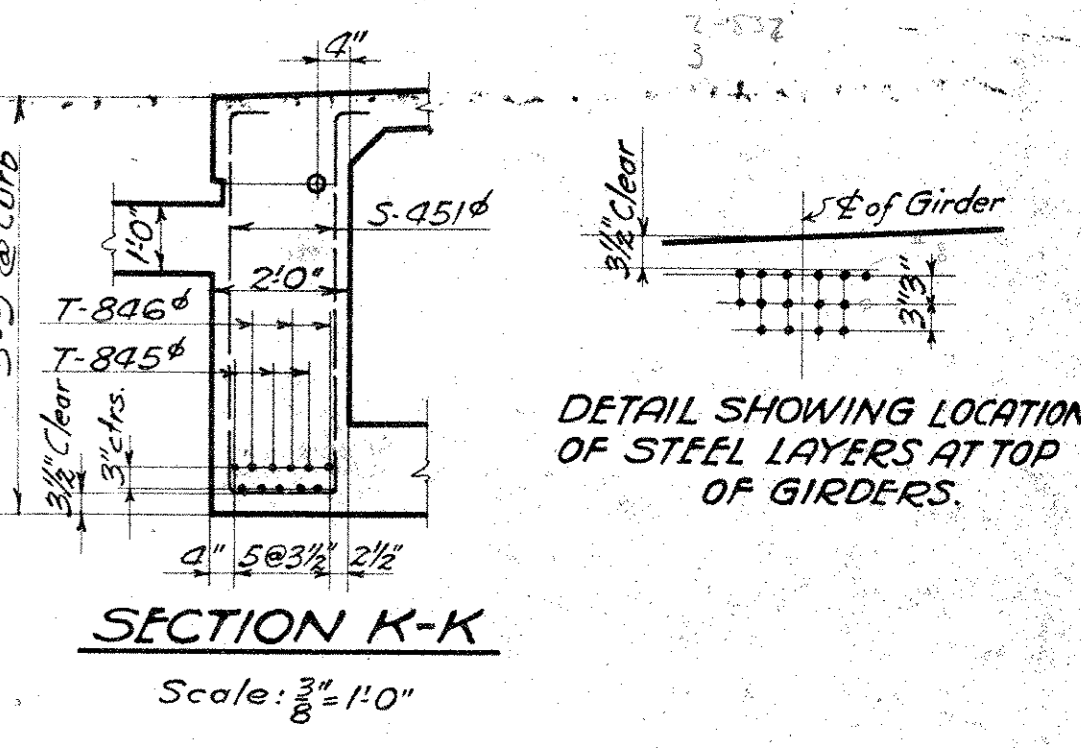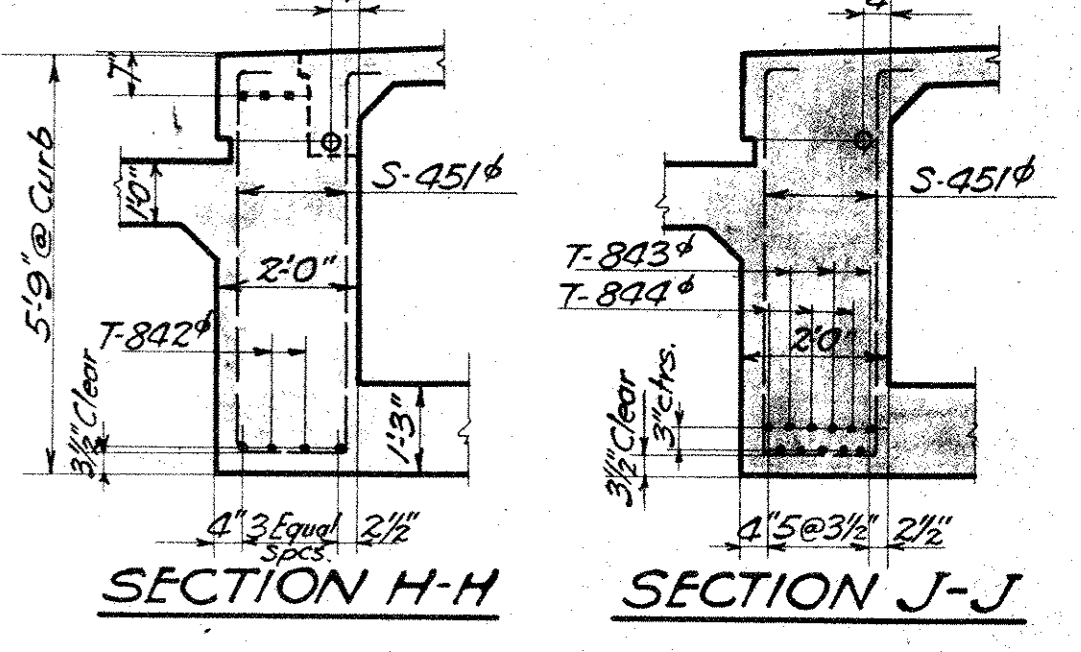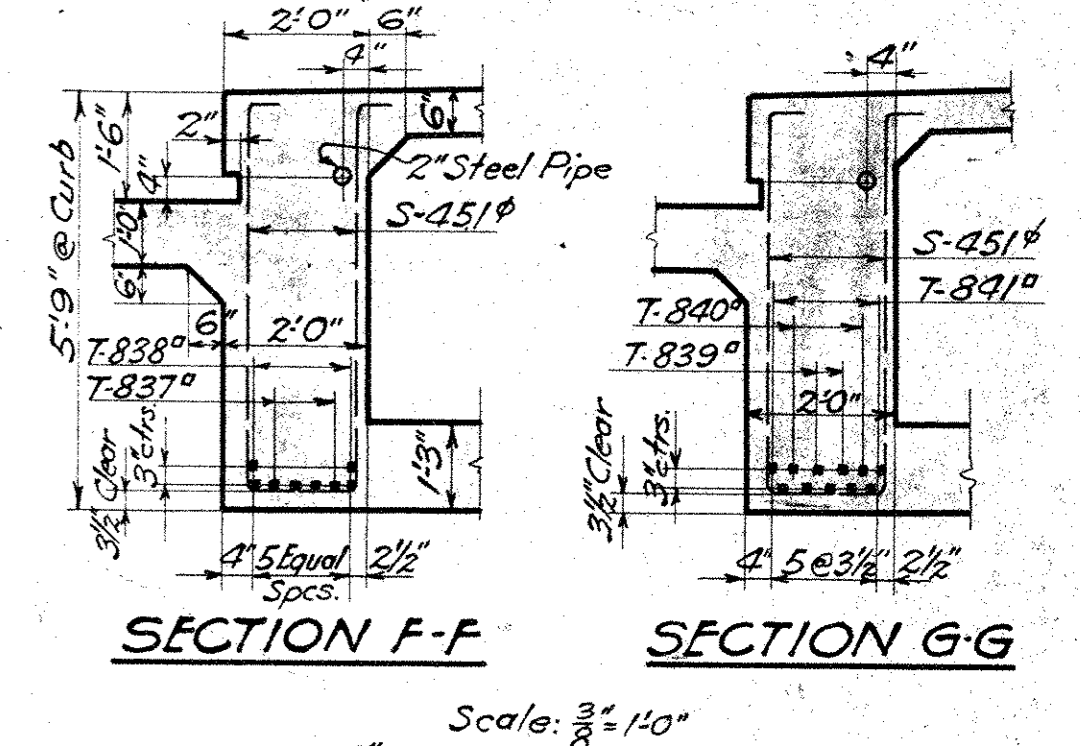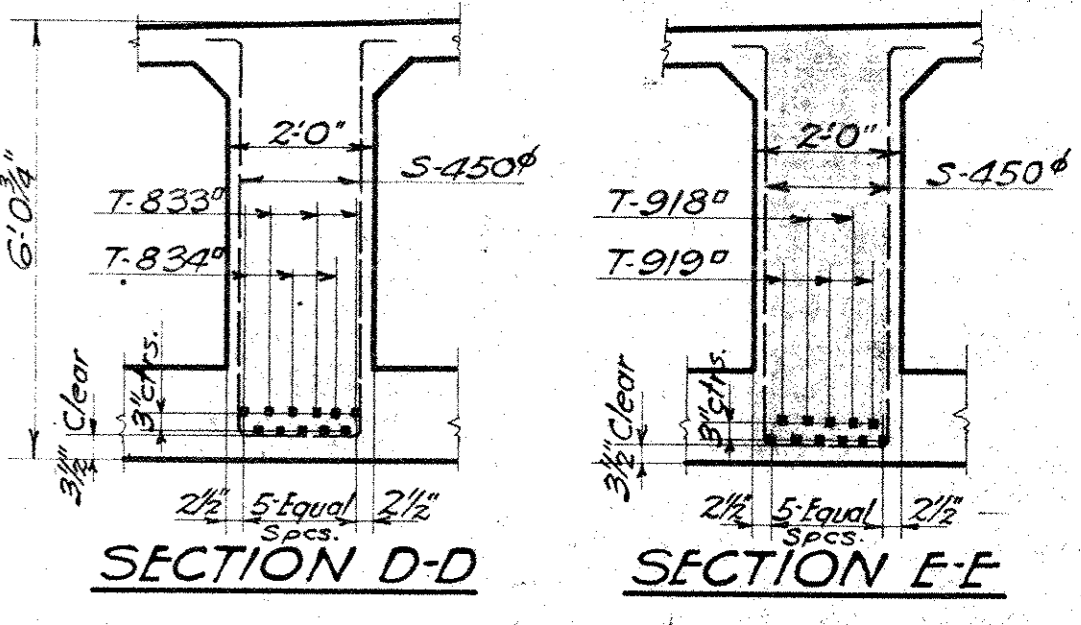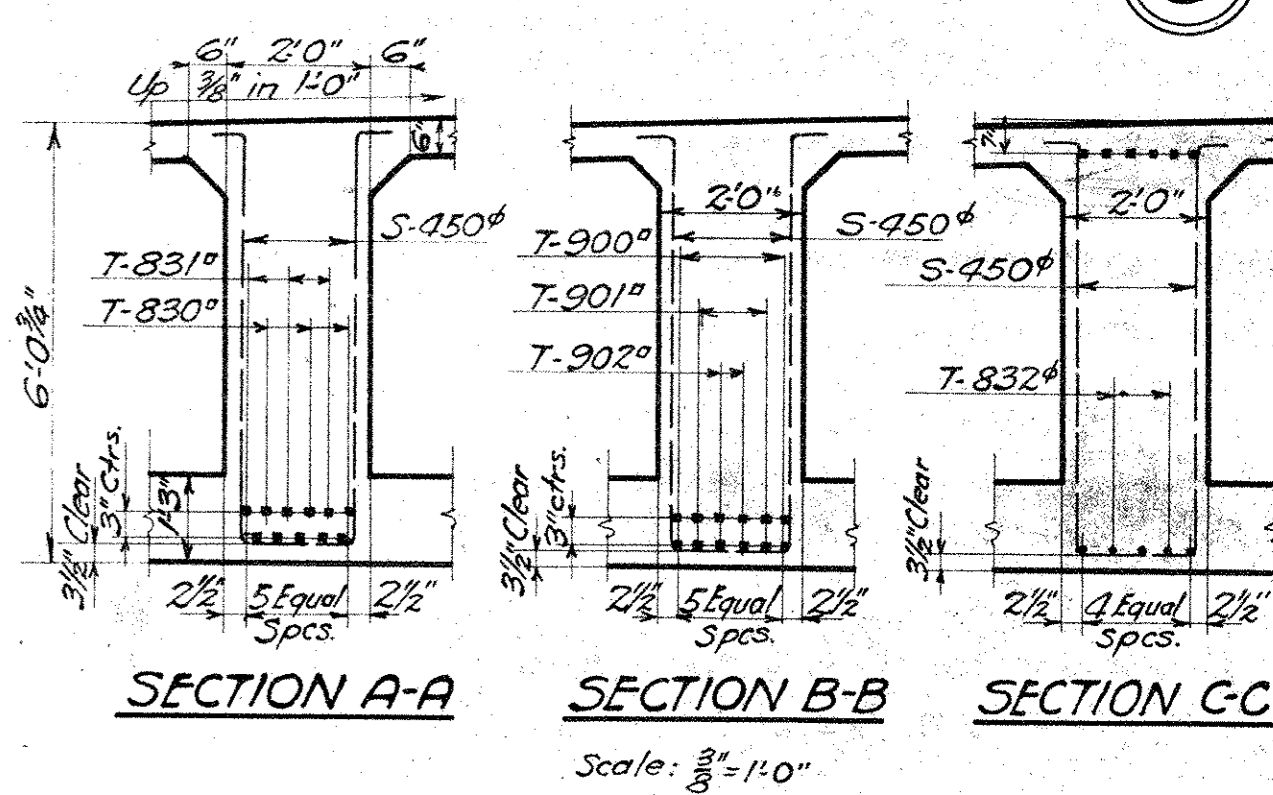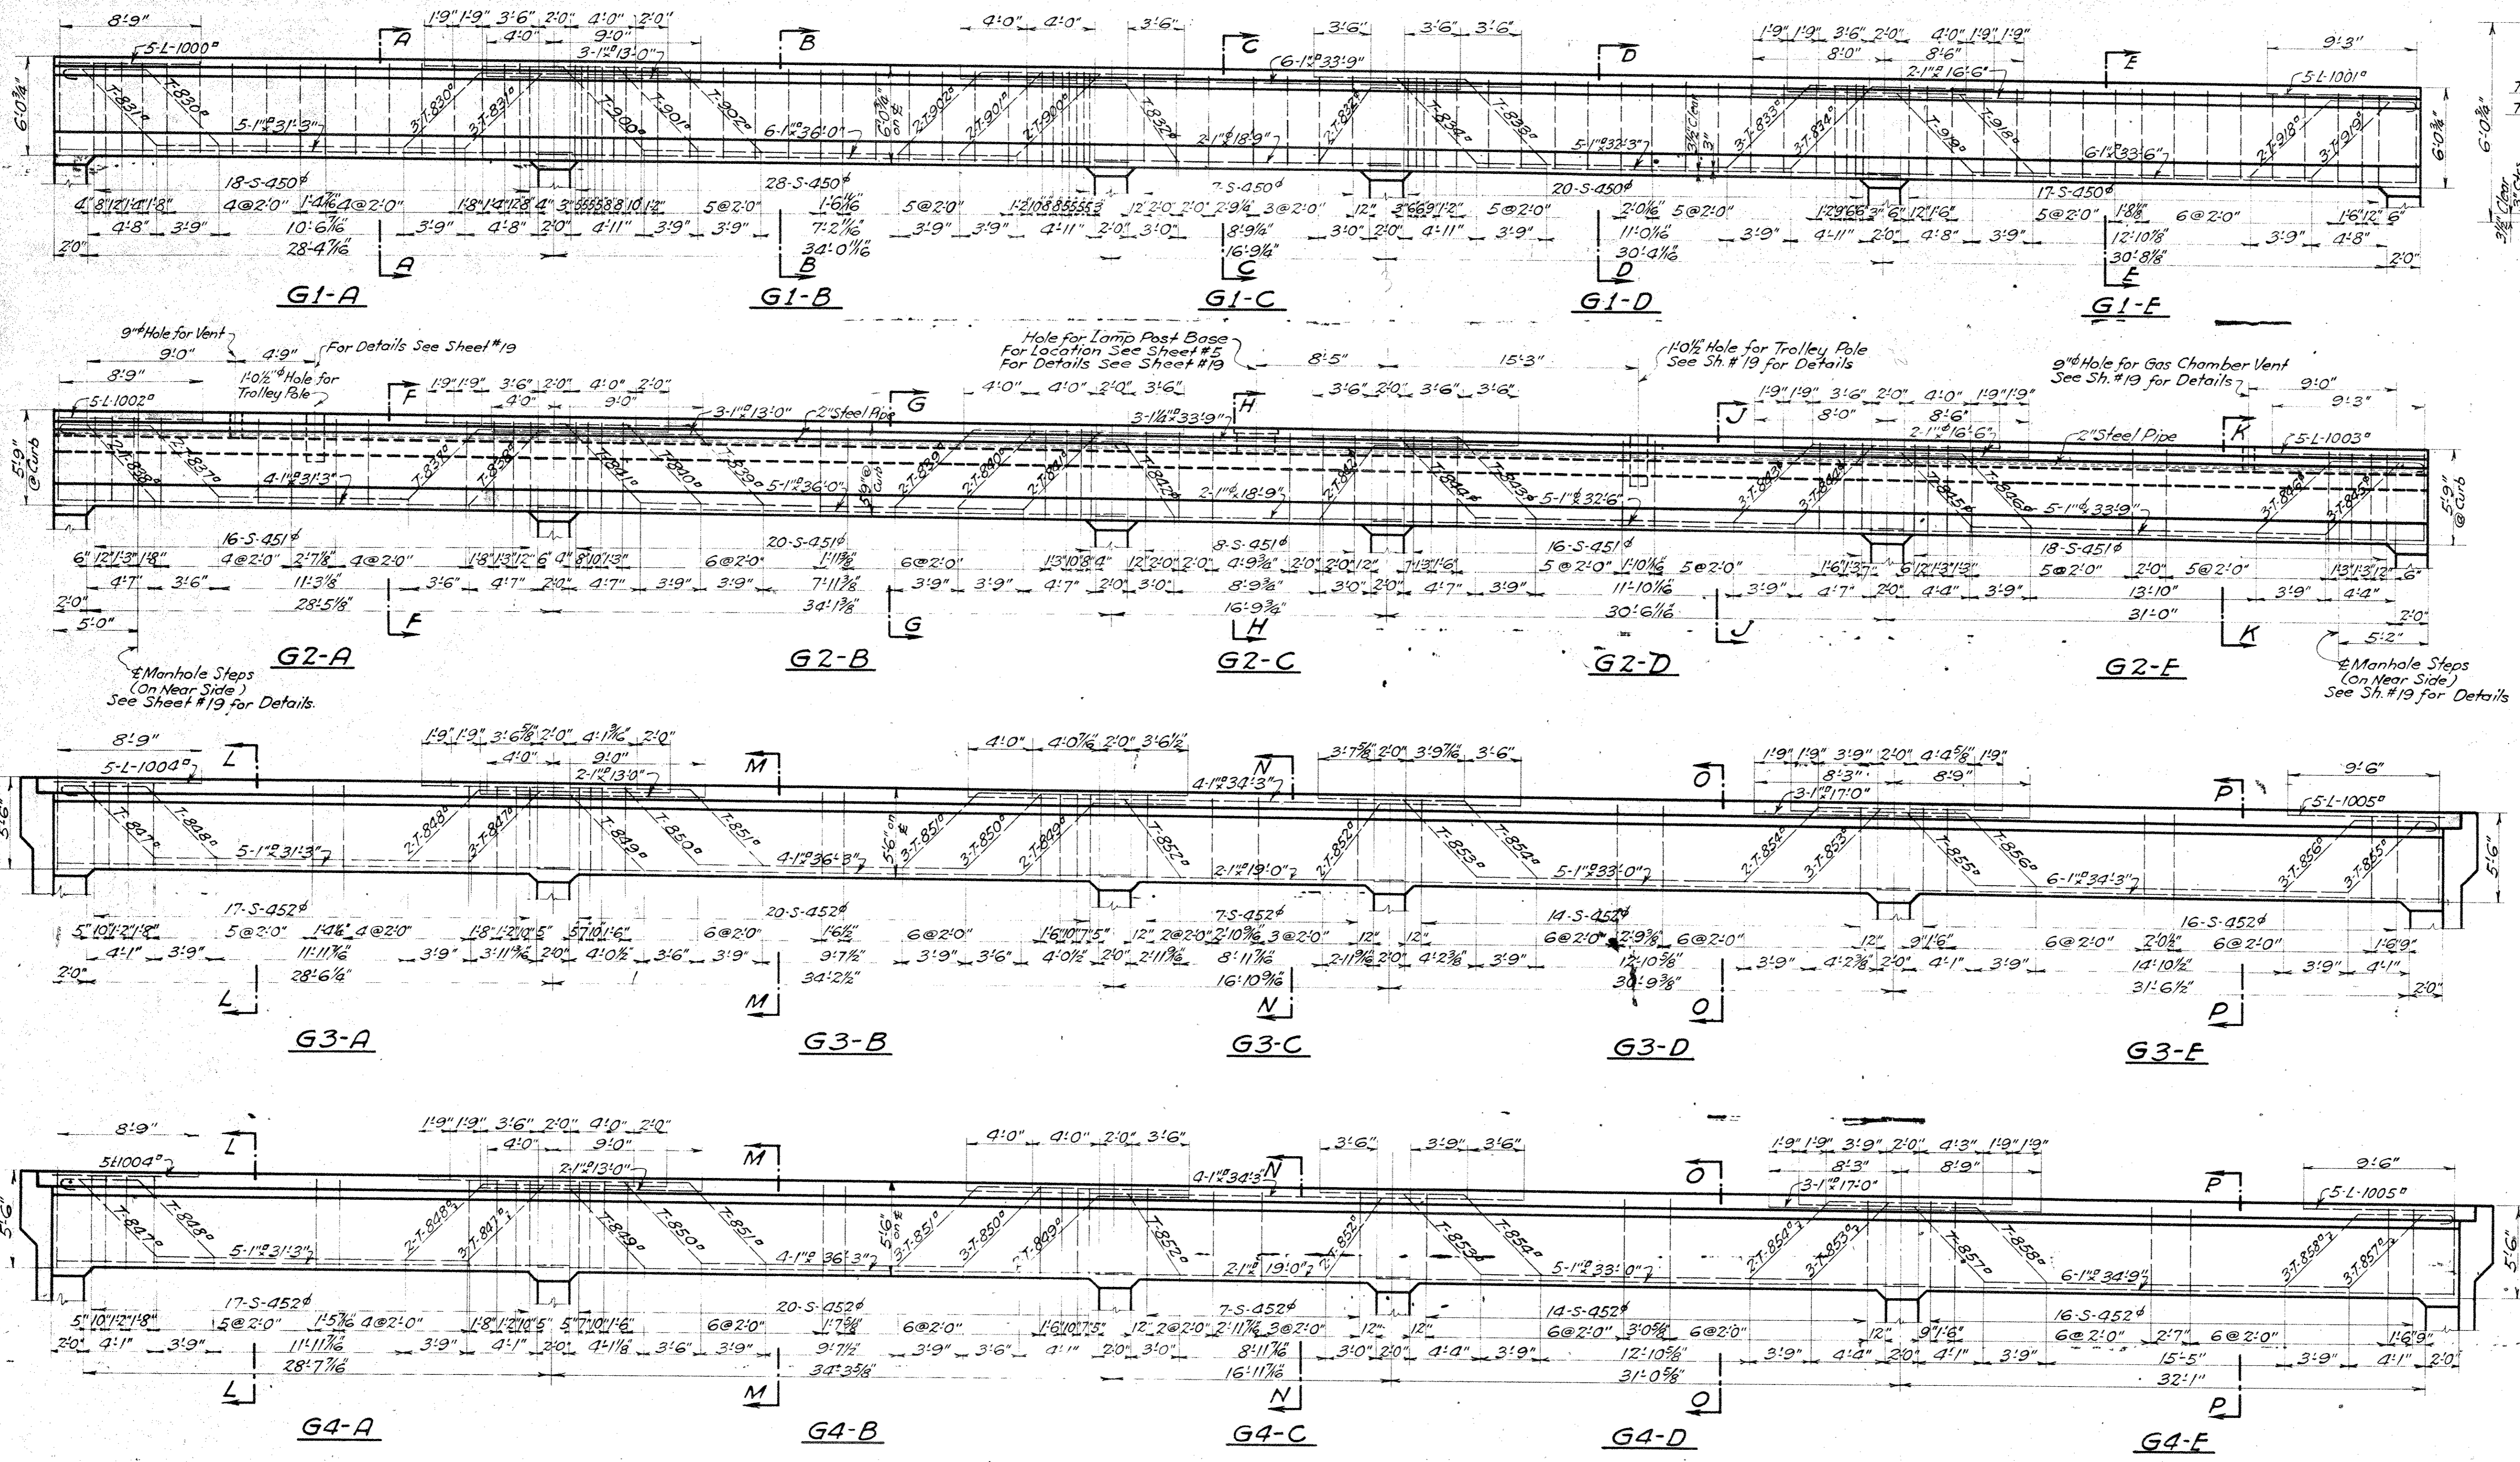

GIRDER ELEVATIONS
 Scale: 3/8" = 1'-0"

Note: All Dimensions on Elevations are measured on 1/2" of Girder

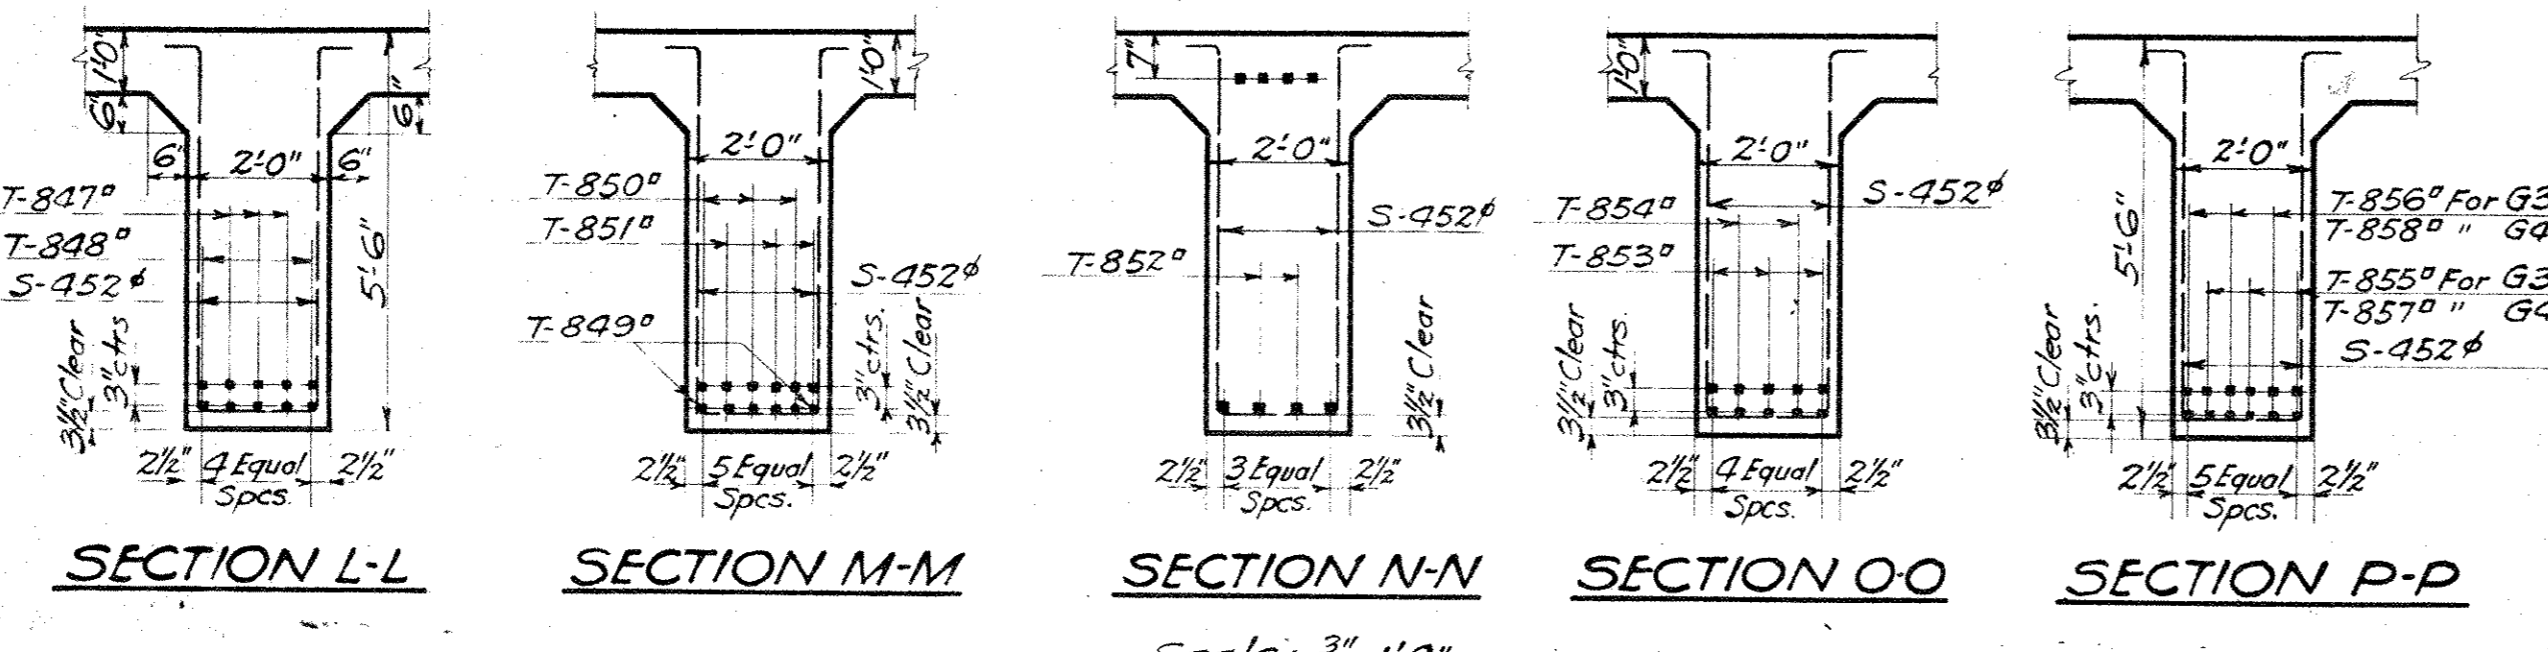

WE HEREBY CERTIFY THAT THIS PLAN SHOWS THE STRUCTURE AS BUILT

W. V. Mersch 7/1/34
 ENGINEER OF STRUCTURES

W. J. ...
 ASST. ENGINEER OF CONSTRUCTION

Designed By G.T.C. July 5, 1927.
 Detailed By L.C.B. Aug. 5, 1927.
 Traced By S.H. Dec. 5, 1927.
 Checked By T.W. Dec. 16, 1927.
 Corrected Dec. 16, 1927.
F. L. ...
 Designing Engineer

Approved *E. R. ...*
 Engineer of Structures
 Approved *W. J. ...*
 Principal/Assistant Engineer
 Approved *J. W. ...*
 Assistant Electrical Engineer
 Approved *T. H. ...*
 Engineer of Construction

Plan Approved
 CITY OF CLEVELAND

By *ROBERT HOFFMANN*
 Commissioner of Engineering & Construction
 Date: 4-13-28

THE CLEVELAND UNION TERMINALS CO.
CENTRAL AVE. BRIDGE
 DETAILS OF GIRDERS
 NO. 1, 2, 3 AND 4
 CLEVELAND, OHIO.
 OFFICE OF ENGINEER OF STRUCTURES
 SCALE: AS SHOWN
 ISSUE NO. 4
 DATE AUG. 5, 1927.
 REVISED 7-1-33

Issue No. A Aug. 11, 1927
Revisions

Issue No. B Nov. 16, 1927
Drawing Checked.


Issue No. 1 Dec. 16, 1927
Signed by Chief Engineer
Traced

Issue No. 2 Jan. 24, 1928
Approved By Heads of Departments.

Issue No. 3 Feb. 17, 1928
Revised to move Water Chambers
to West side of Bridge, and added
Girder G6-E.

Issue No. 4 April 24, 1928
Approved by the City.

Issue No. 5 Sept. 1, 1933
Plan Conforms to Structure as
Built.

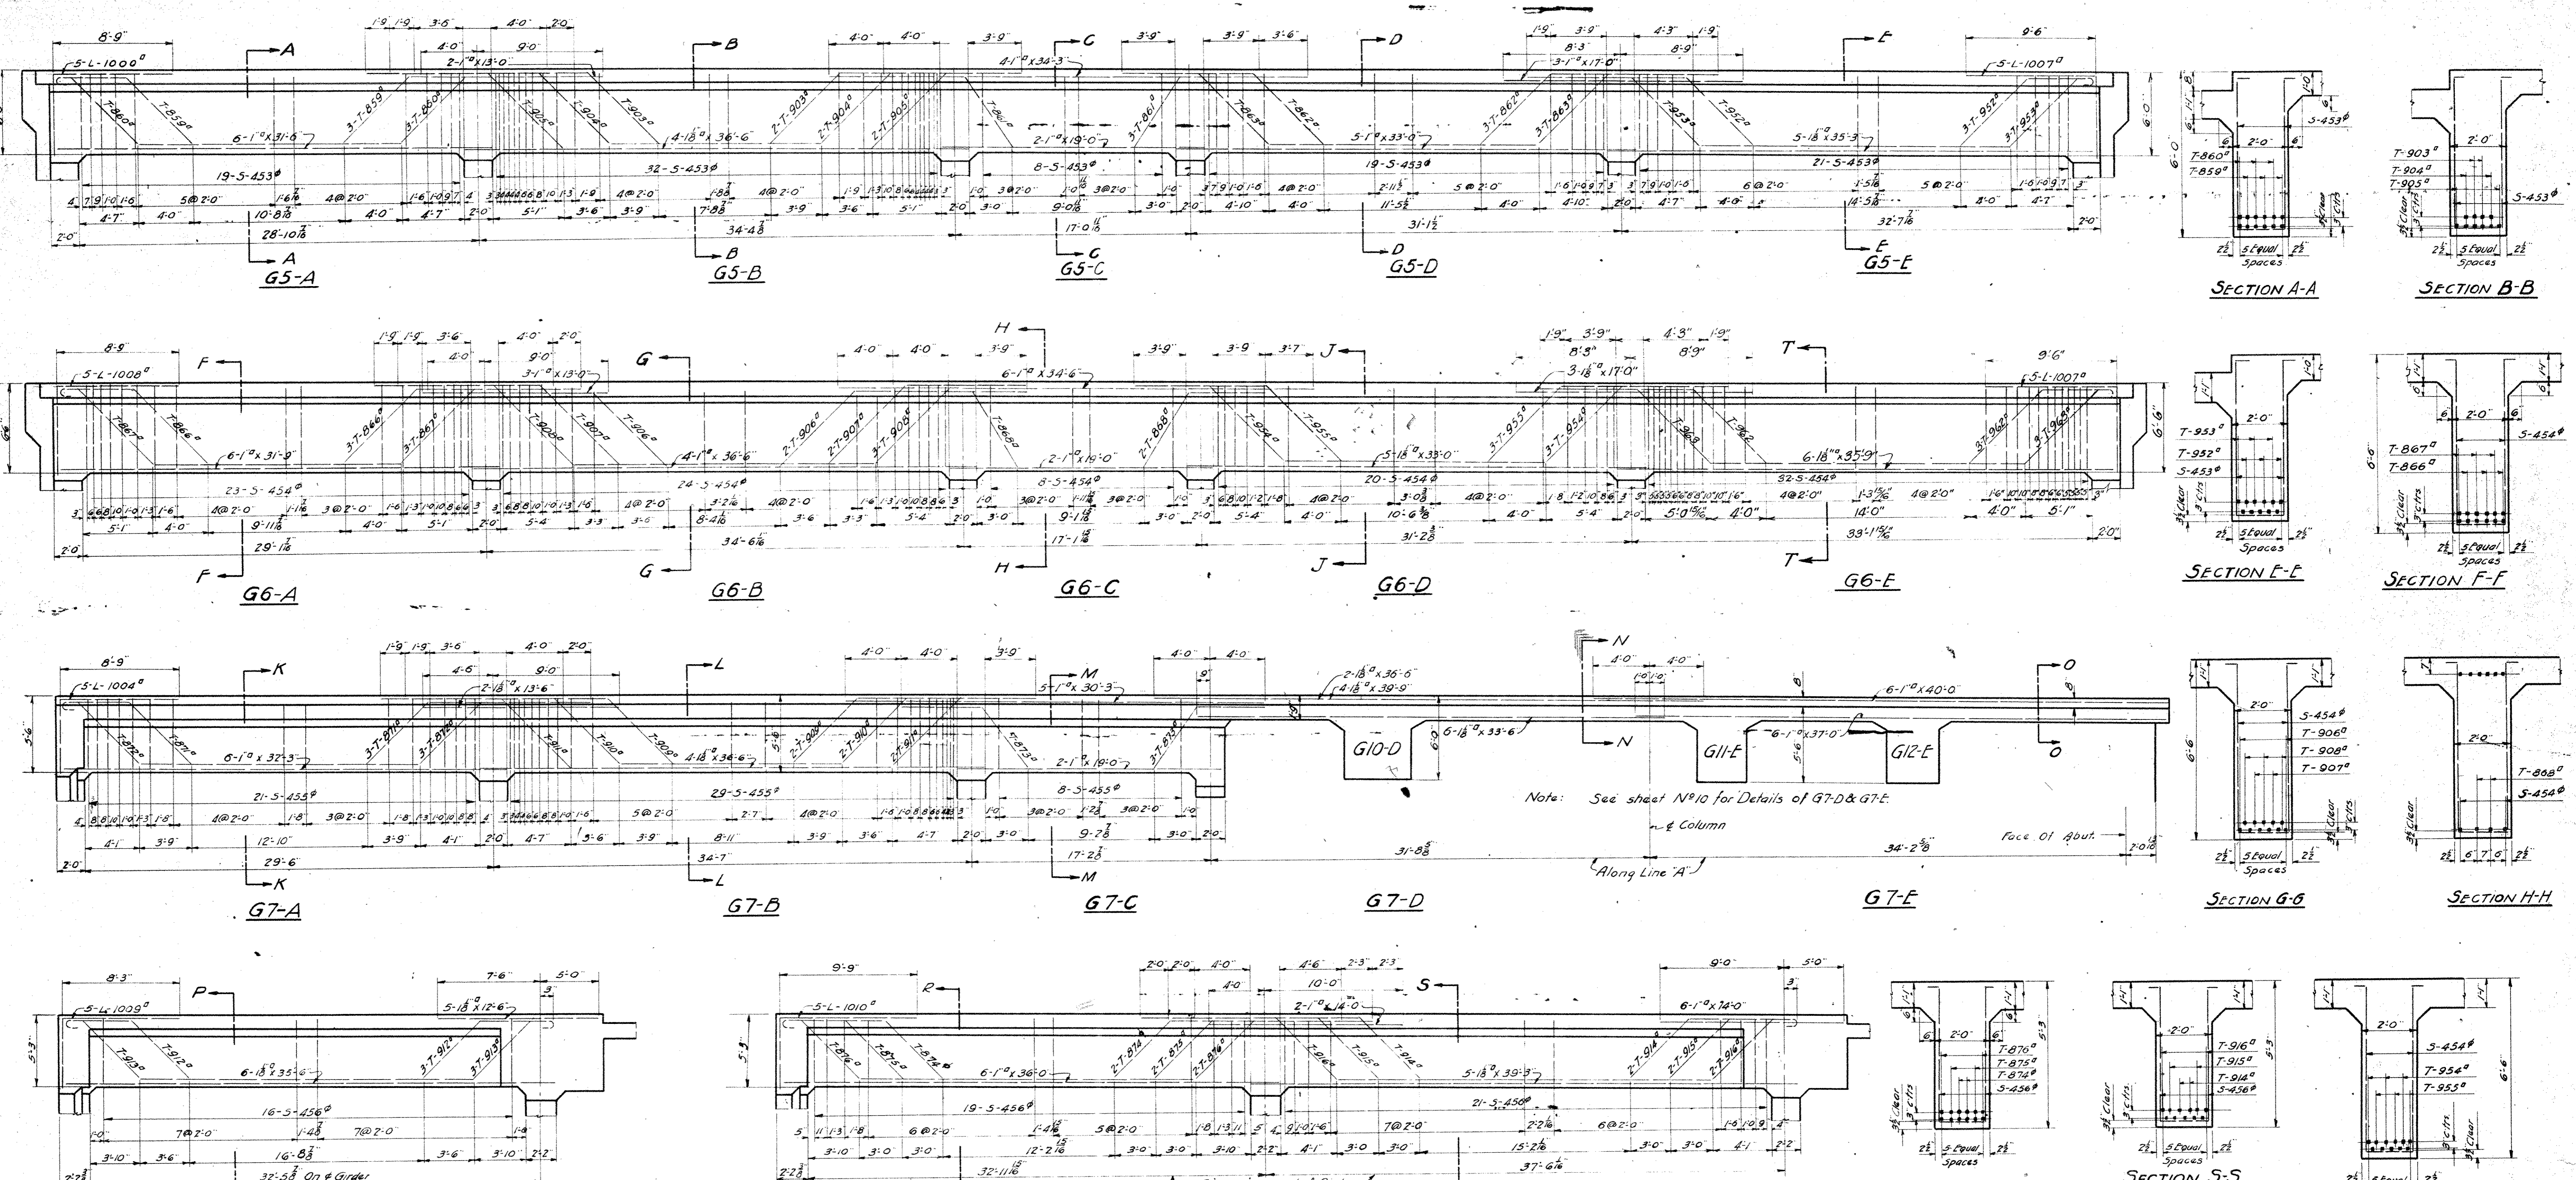

WE HEREBY CERTIFY THAT THIS PLAN
SHOWS THE STRUCTURE AS BUILT.

E. V. Murrill 9/11/24
ENGINEER OF STRUCTURES

W. J. ... 1/20/28
ASST. ENGINEER OF CONSTRUCTION


Designed By G.T.C. July 5, 1927
Detailed By L.C.D. Aug. 11, 1927
Traced By J.J.N. Nov. 29, 1927
Checked By T.W. Nov. 30, 1927
Correct. N.V.V. 30, 1927
G. S. ...
Designing Engineer

Approved *E. V. Murrill*
Engineer of Structures

Approved *W. J. ...*
Principal Assistant Engineer

Approved *...*
Assistant Electrical Engineer

Approved *...*
Engineer of Construction

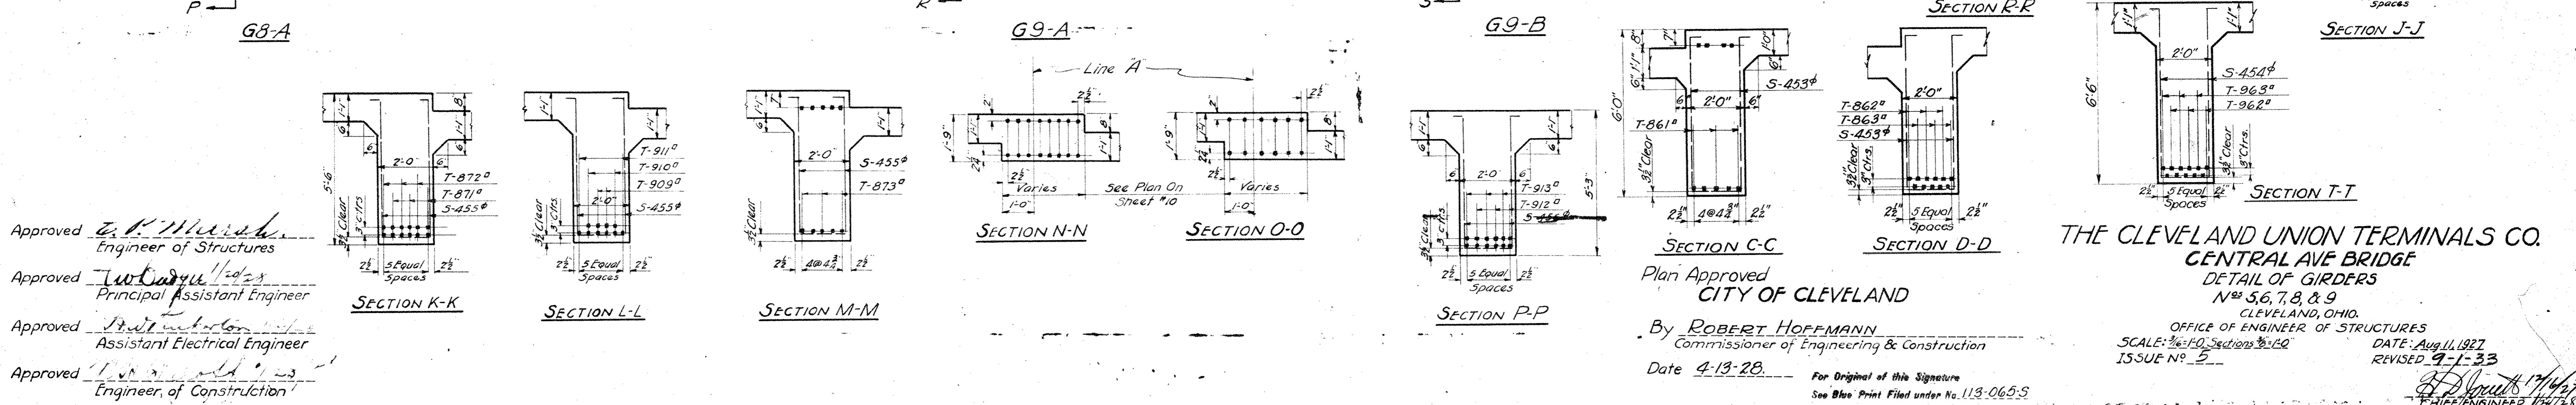

THE CLEVELAND UNION TERMINALS CO.
CENTRAL AVE BRIDGE
DETAIL OF GIRDERS
Nos. 5, 6, 7, 8, & 9
CLEVELAND, OHIO.
OFFICE OF ENGINEER OF STRUCTURES
SCALE: 3/4" = 1'-0" Sections 3'-10"
ISSUE No. 2

DATE: April 11, 1927
REVISED 9-1-33

By *ROBERT HOFFMANN*
Commissioner of Engineering & Construction

Date 4-13-28.





For Original of this Signature
See Blue Print Filed under No. 113-065-S

E. V. Murrill
ENGINEER

Issue No A Aug. 17, 1927
 Revisions
 Issue No B Nov. 15, 1927
 Drawing Checked
 Issue No 1 Nov. 30, 1927
 Approved by Chief Engineer
 Issue No 2 Dec. 20, 1927
 Traced & Checked
 Issue No 3 Dec. 29, 1927
 Signed by the Chief Engineer
 Issue No 4 Jan. 24, 1928
 Approved By Heads of Departments


Issue No 5 Feb. 8, 1928
 Removed Water Chamber from
 Elevation and Sections.
 Removed Girder G10-E
 Issue No 6 April 24, 1928
 Approved by the City

Issue No 7 Sept. 1, 1933
 Plan Conforms to Structure as
 Built

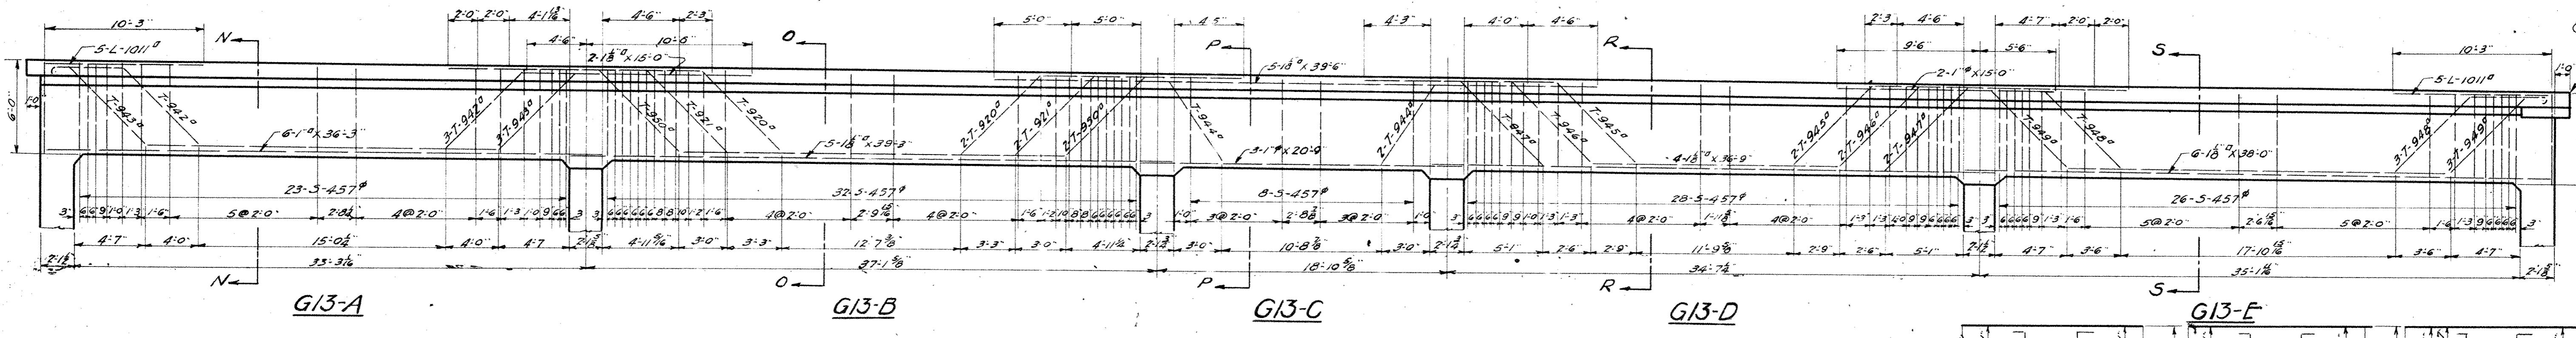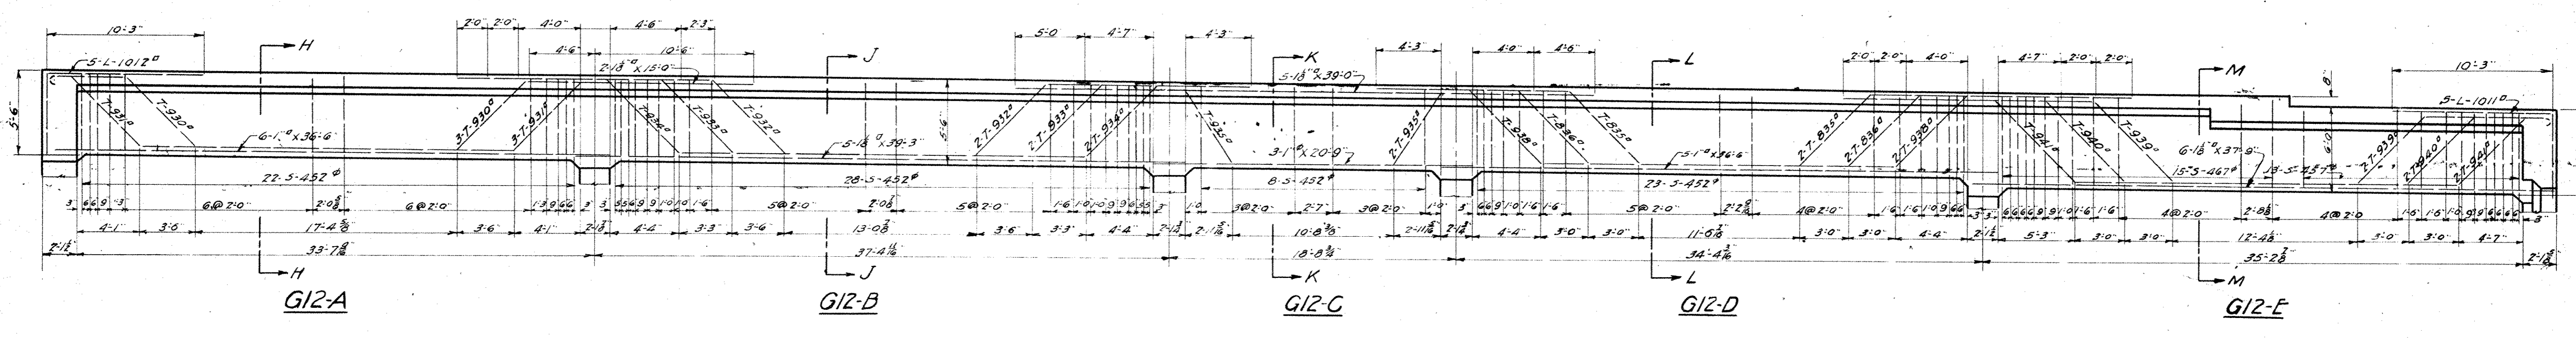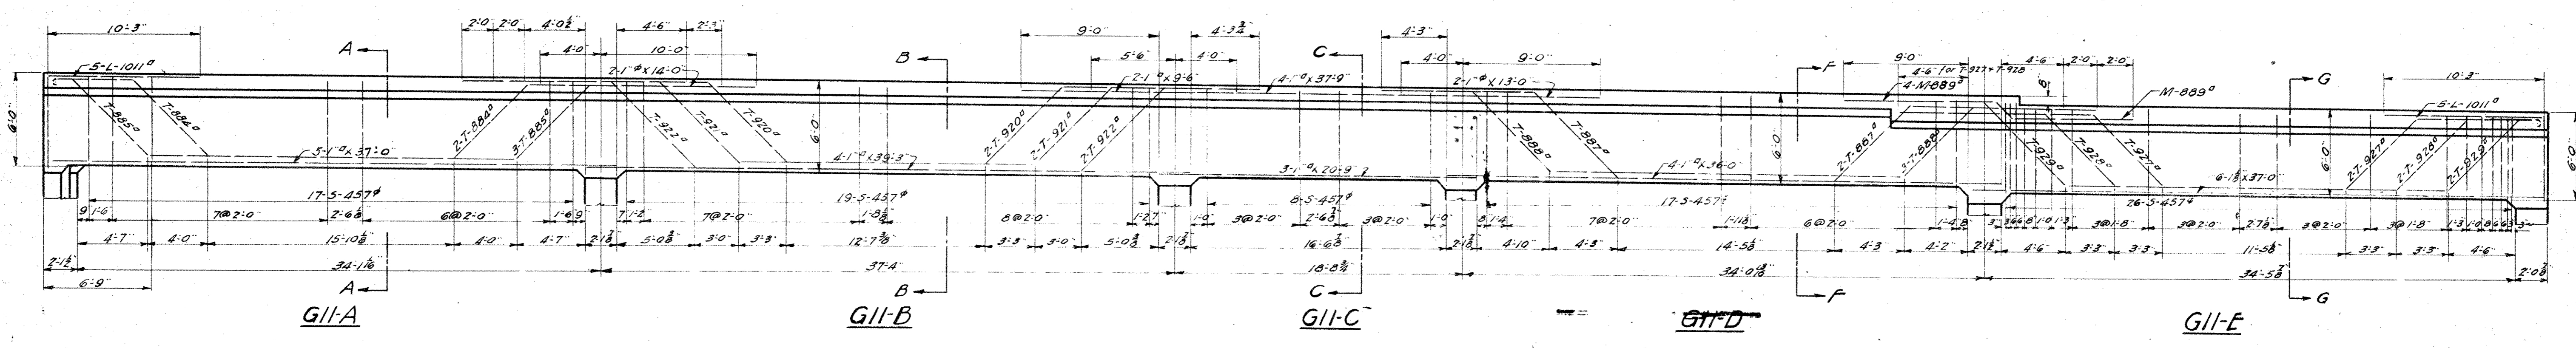
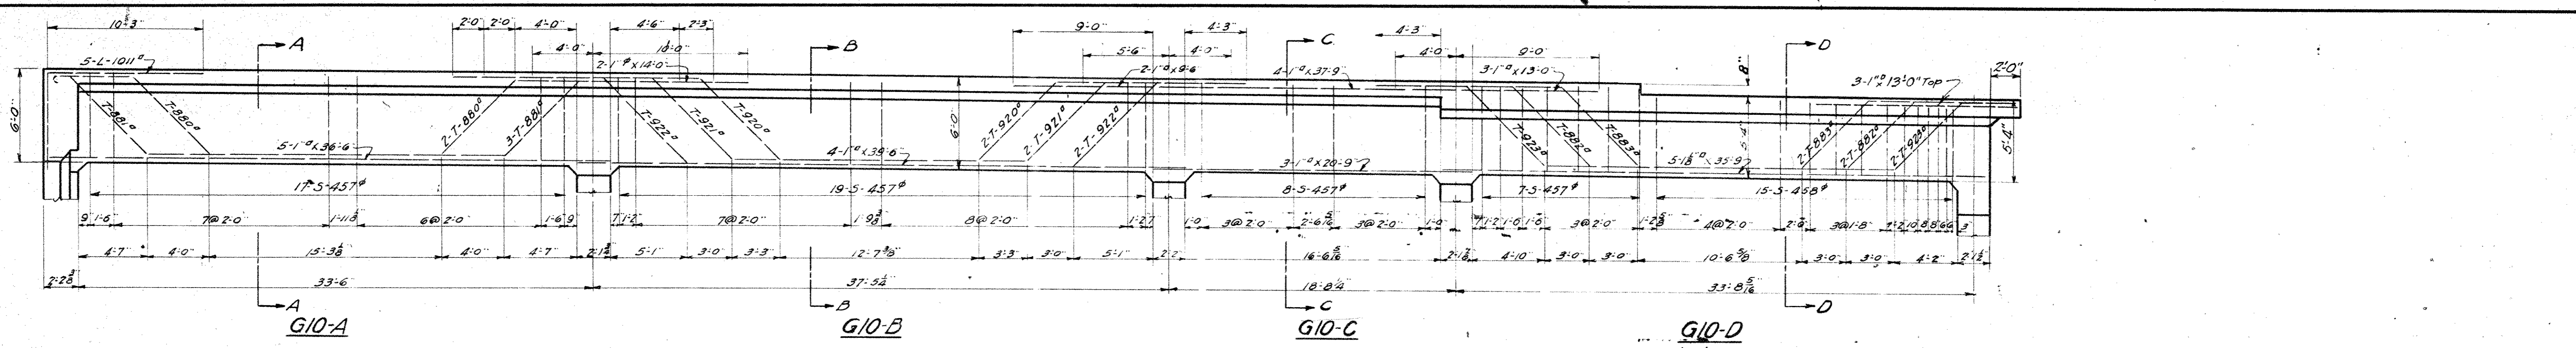


Note: All dimensions on elevations are measured on G Girder.

See sheet No 10 for details.

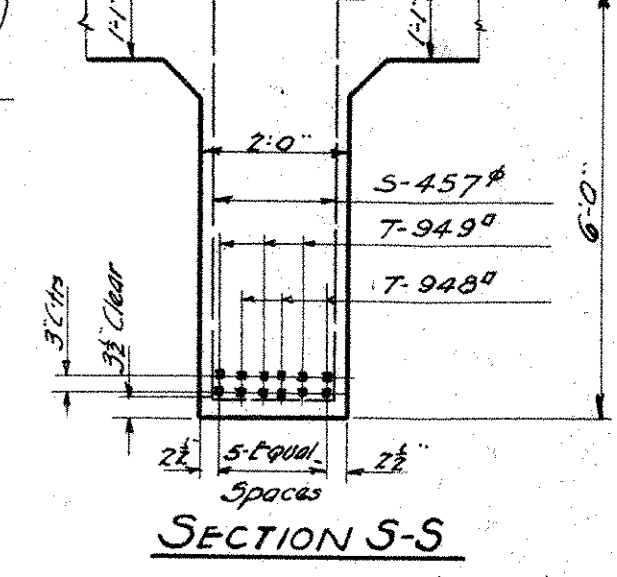

We HEREBY CERTIFY THAT THIS PLAN SHOWS THE STRUCTURE AS BUILT.
 C. C. ... ENGINEER OF STRUCTURES
 T. W. ... ASST. ENGINEER OF CONSTRUCTION

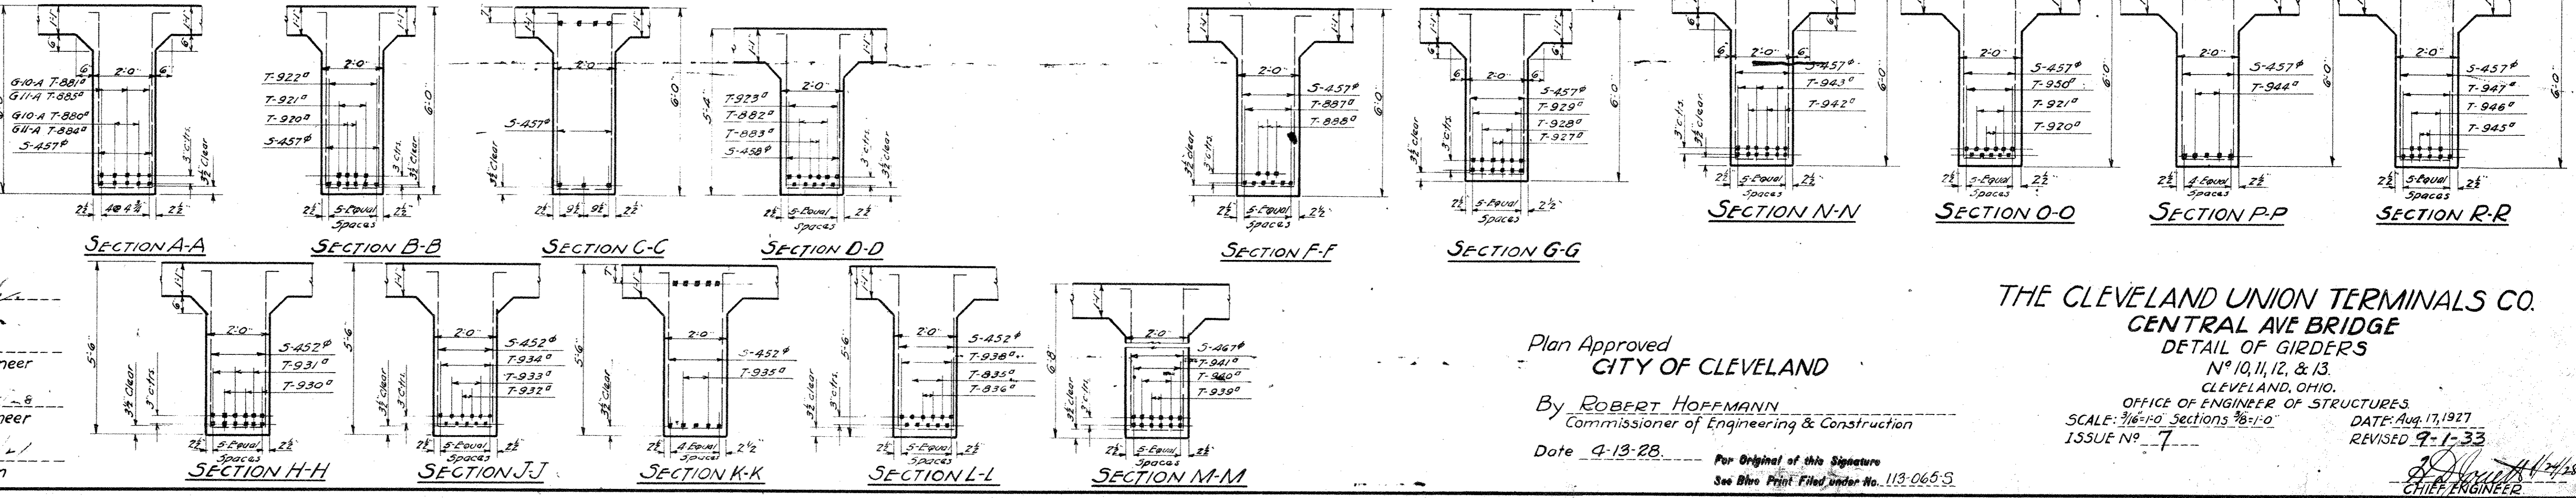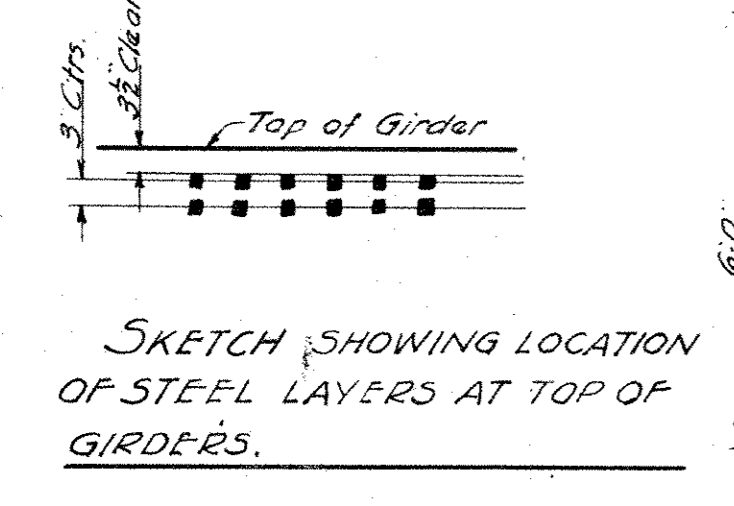




Designed By G.T.C. July 5, 1927
 Detailed By L.C.B. Aug 11, 1927
 Traced By J.I.N. Dec. 19, 1927
 Checked By T.W. Dec. 20, 1927
 Correct Dec 24 1927
 S. S. ... Designing Engineer

Approved ... Engineer of Structures
 Approved ... Principal Assistant Engineer
 Approved ... Assistant Electrical Engineer
 Approved ... Engineer of Construction

Plan Approved
 CITY OF CLEVELAND
 By ROBERT HOFFMANN
 Commissioner of Engineering & Construction
 Date 4-13-28

THE CLEVELAND UNION TERMINALS CO.
 CENTRAL AVE BRIDGE
 DETAIL OF GIRDERS
 No 10, 11, 12, & 13.
 CLEVELAND, OHIO.
 OFFICE OF ENGINEER OF STRUCTURES
 SCALE: 3/16"=1'-0" Sections 3/8"=1'-0"
 ISSUE No 7
 DATE: Aug. 17, 1927
 REVISED 9-1-33
 CHIEF ENGINEER

Issue No A Oct. 20, 1927
 Revisions
 Issue No B Nov. 15, 1927
 Drawing Checked
 Issue No 1 Nov. 30, 1927
 Approved by Chief Engineer
 Issue No 2 Dec. 22, 1927
 Traced & Checked
 Issue No 3 Dec. 29, 1927
 Signed by the Chief Engineer
 Issue No 4 Jan. 24, 1928
 Approved By Heads of Departments
 Issue No 5 Feb. 8, 1928
 Removed Water Chamber from
 Elevation and Sections.
 Issue No 6 April 24, 1928
 Approved by the City.
 Issue No 7 Sept. 1, 1933
 Plan Conforms to Structure, as
 Built

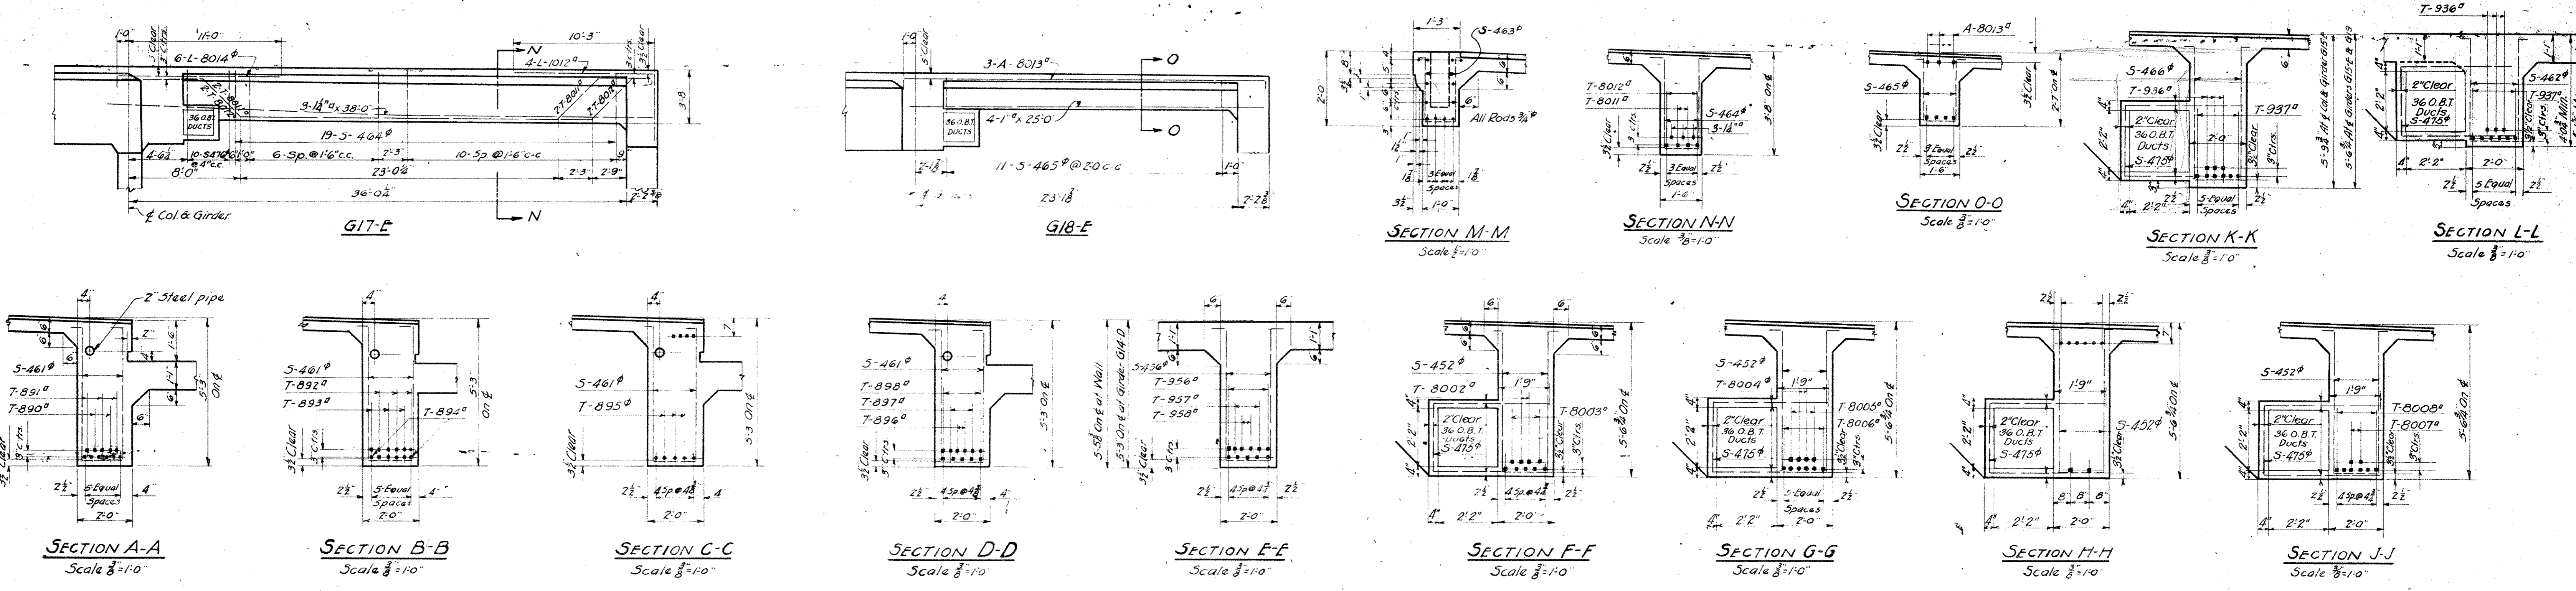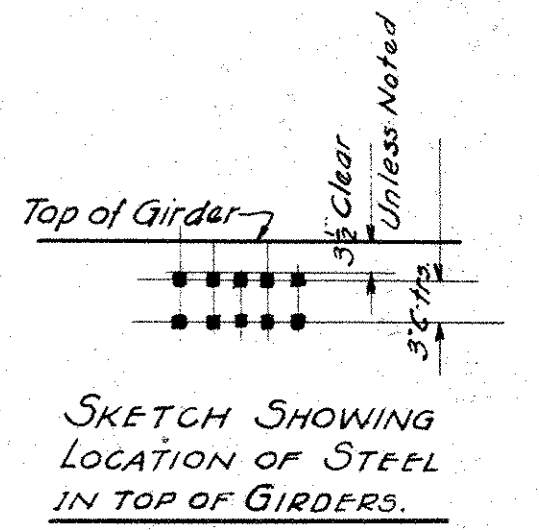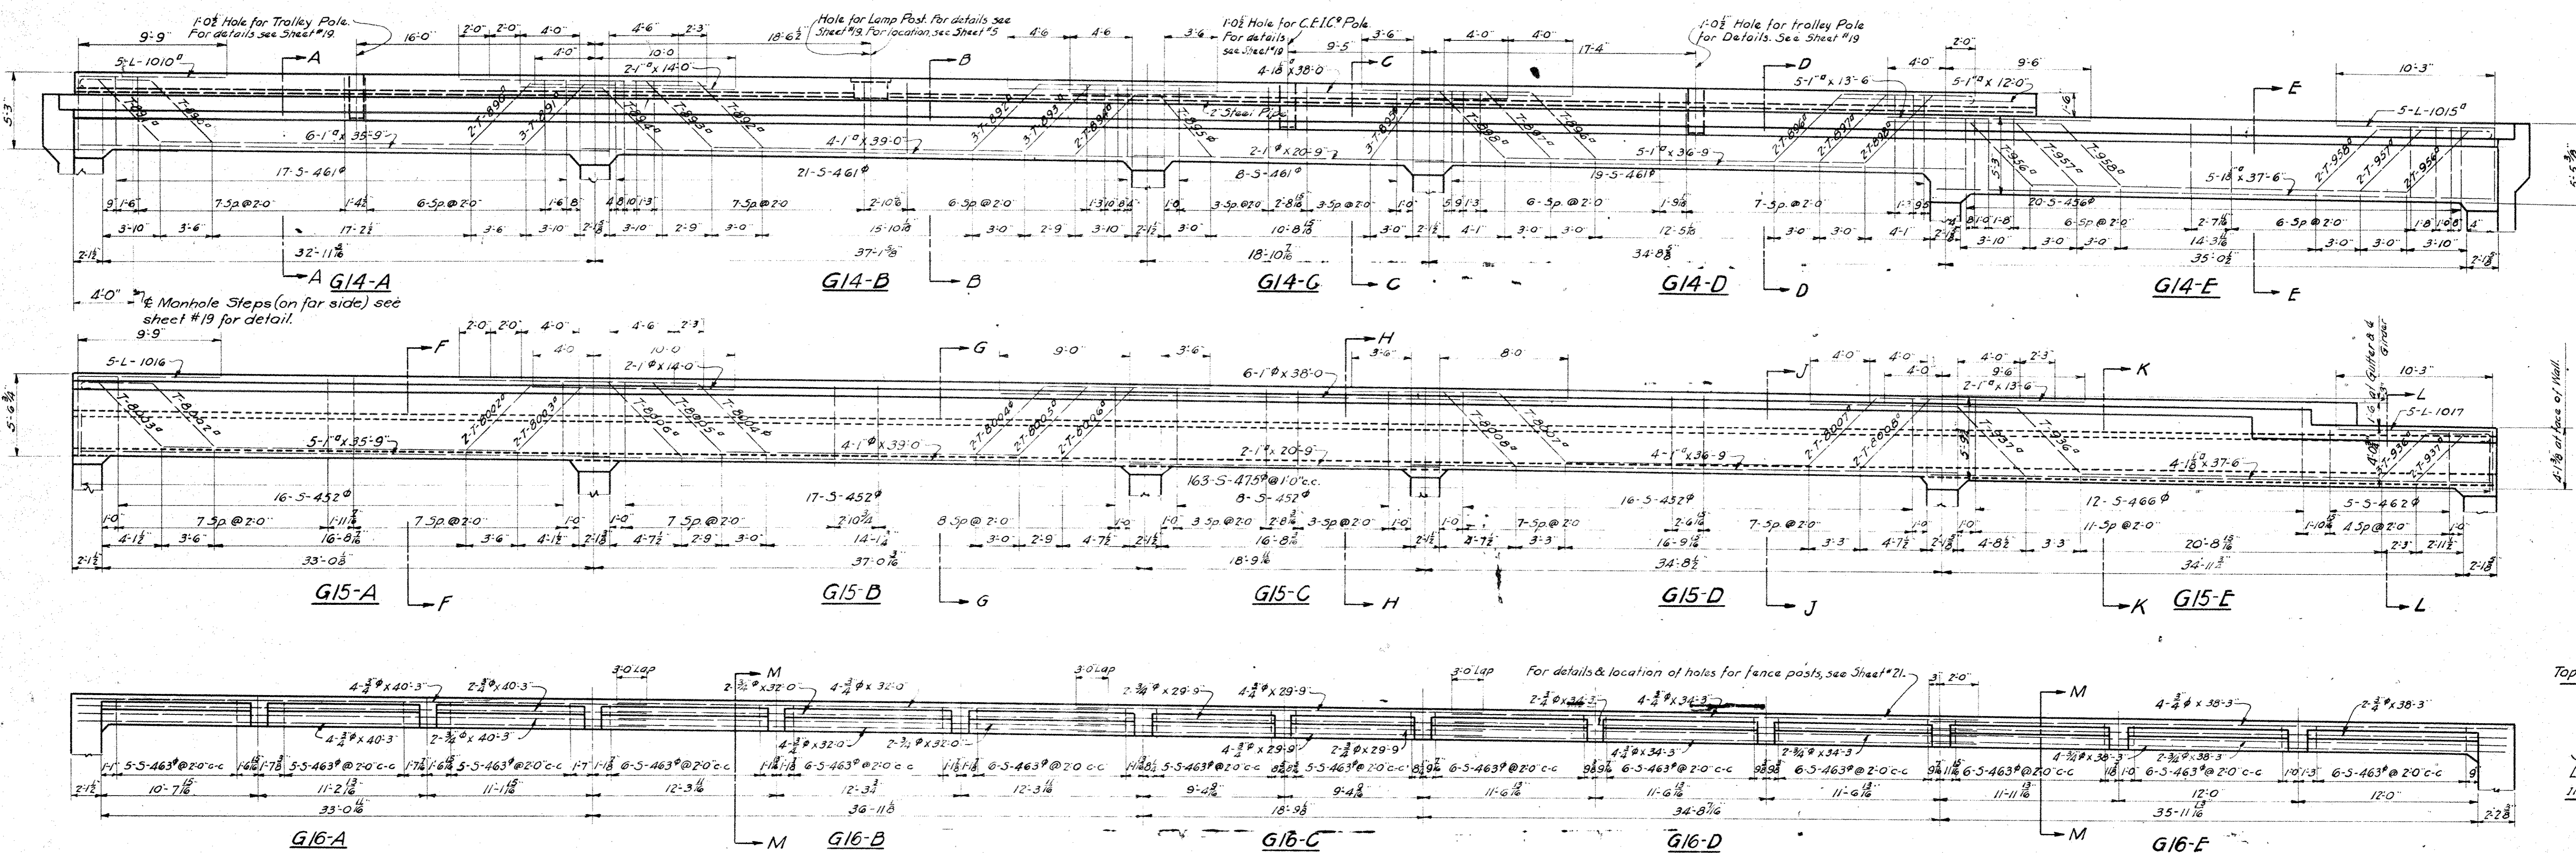

We HEREBY CERTIFY THAT THIS PLAN
 SHOWS THE STRUCTURE AS BUILT.
 W. Marsh
 ENGINEER OF STRUCTURES
 H. L. ...
 ASST. ENGINEER OF CONSTRUCTION

Note: All Dimensions on Elevations
 are measured on $\frac{1}{2}$ Girders.

Designed By G.T.C. & J.H.C. Oct. 10, 1927
 Detailed By L.C.B. Oct. 20, 1927
 Traced By J.J.N. Dec. 22, 1927
 Checked By T.W. Dec. 23, 1927
 Correct Dec. 29, 1927
 F.L. ...
 Designing Engineer

Approved W. Marsh
 Engineer of Structures
 Approved H. L. ...
 Principal Assistant Engineer
 Approved M. ...
 Assistant Electrical Engineer
 Approved F. L. ...
 Engineer of Construction

Plan Approved
 CITY OF CLEVELAND

By ROBERT HOFFMANN
 Commissioner of Engineering & Construction
 Date 4-13-28

THE CLEVELAND UNION TERMINALS CO.
 CENTRAL AVE BRIDGE
 DETAIL OF GIRDERS
 G14, G15, G16, G17, & G18.
 CLEVELAND, OHIO.
 OFFICE OF ENGINEER OF STRUCTURES
 SCALE: 1/8\"





Issue No A Oct. 20, 1927

REVISIONS:-
Issue No B Nov. 22, 1927
Drawing Checked and Traced.





Issue No 1 Nov. 30, 1927
Signed By Chief Engineer.

Issue No 2 Jan. 24, 1928
Approved By Heads of Departments.
Issue No 3 Feb. 21, 1928.
Revised to move all Water
Chambers to West side of Bridge,
removed Girder G10-E, added G6-F.
Issue No 4 April 24, 1928.
Approved by the City.

Issue No 5 Sept. 1, 1933.
Plan Conforms to Structure as
Built.

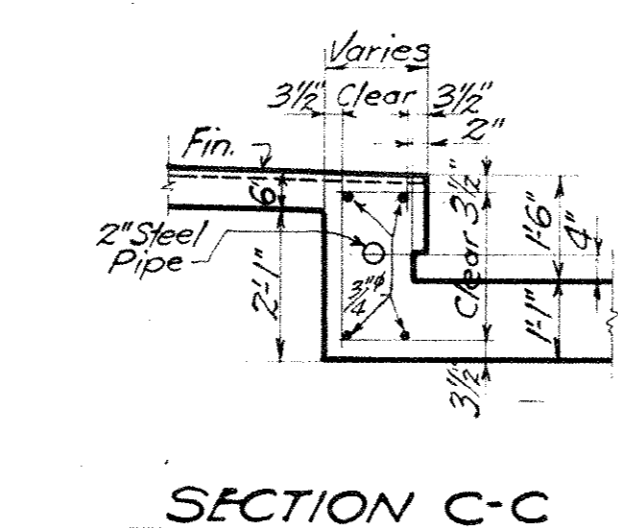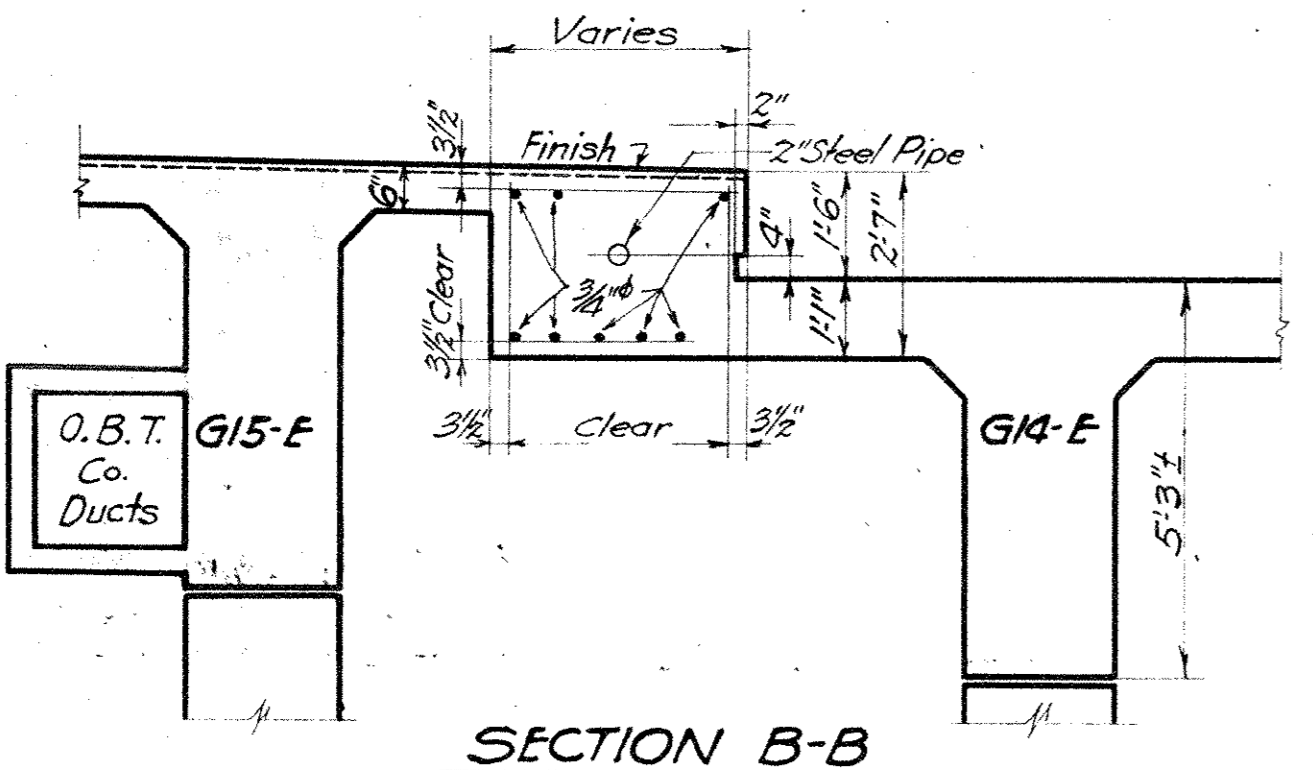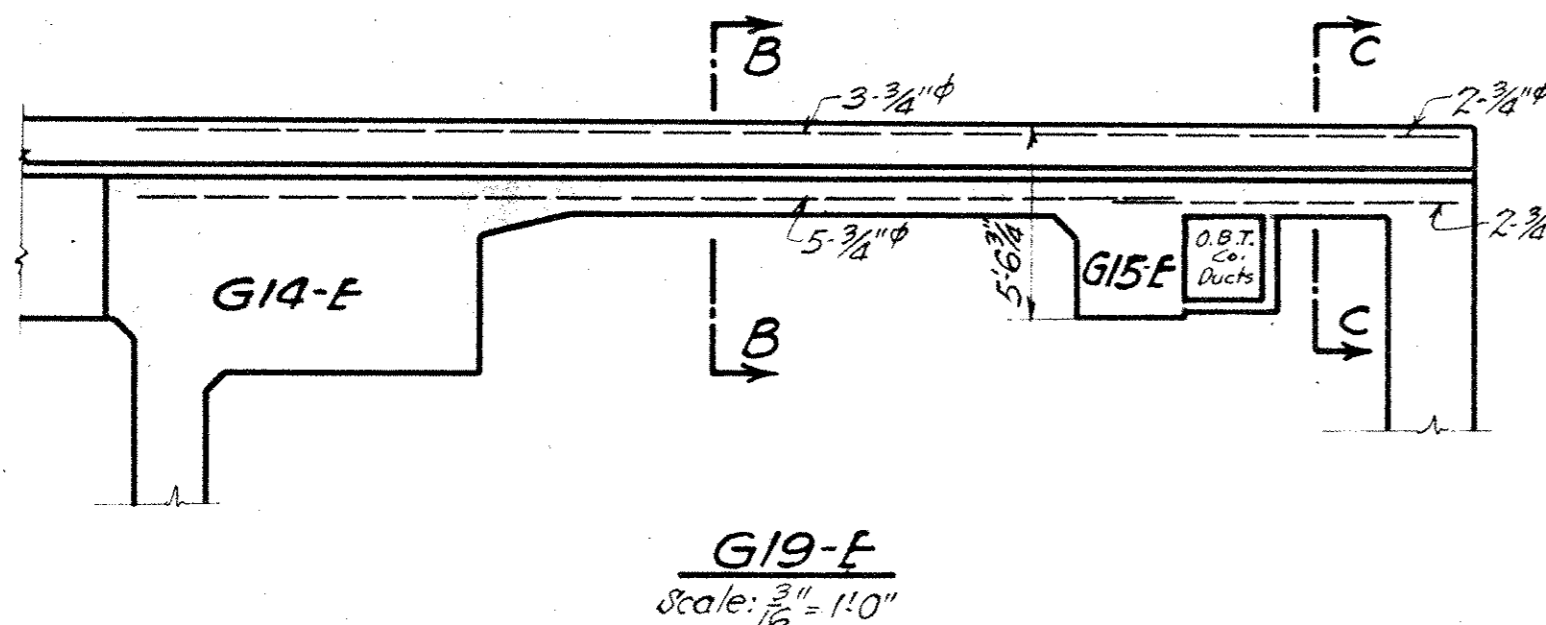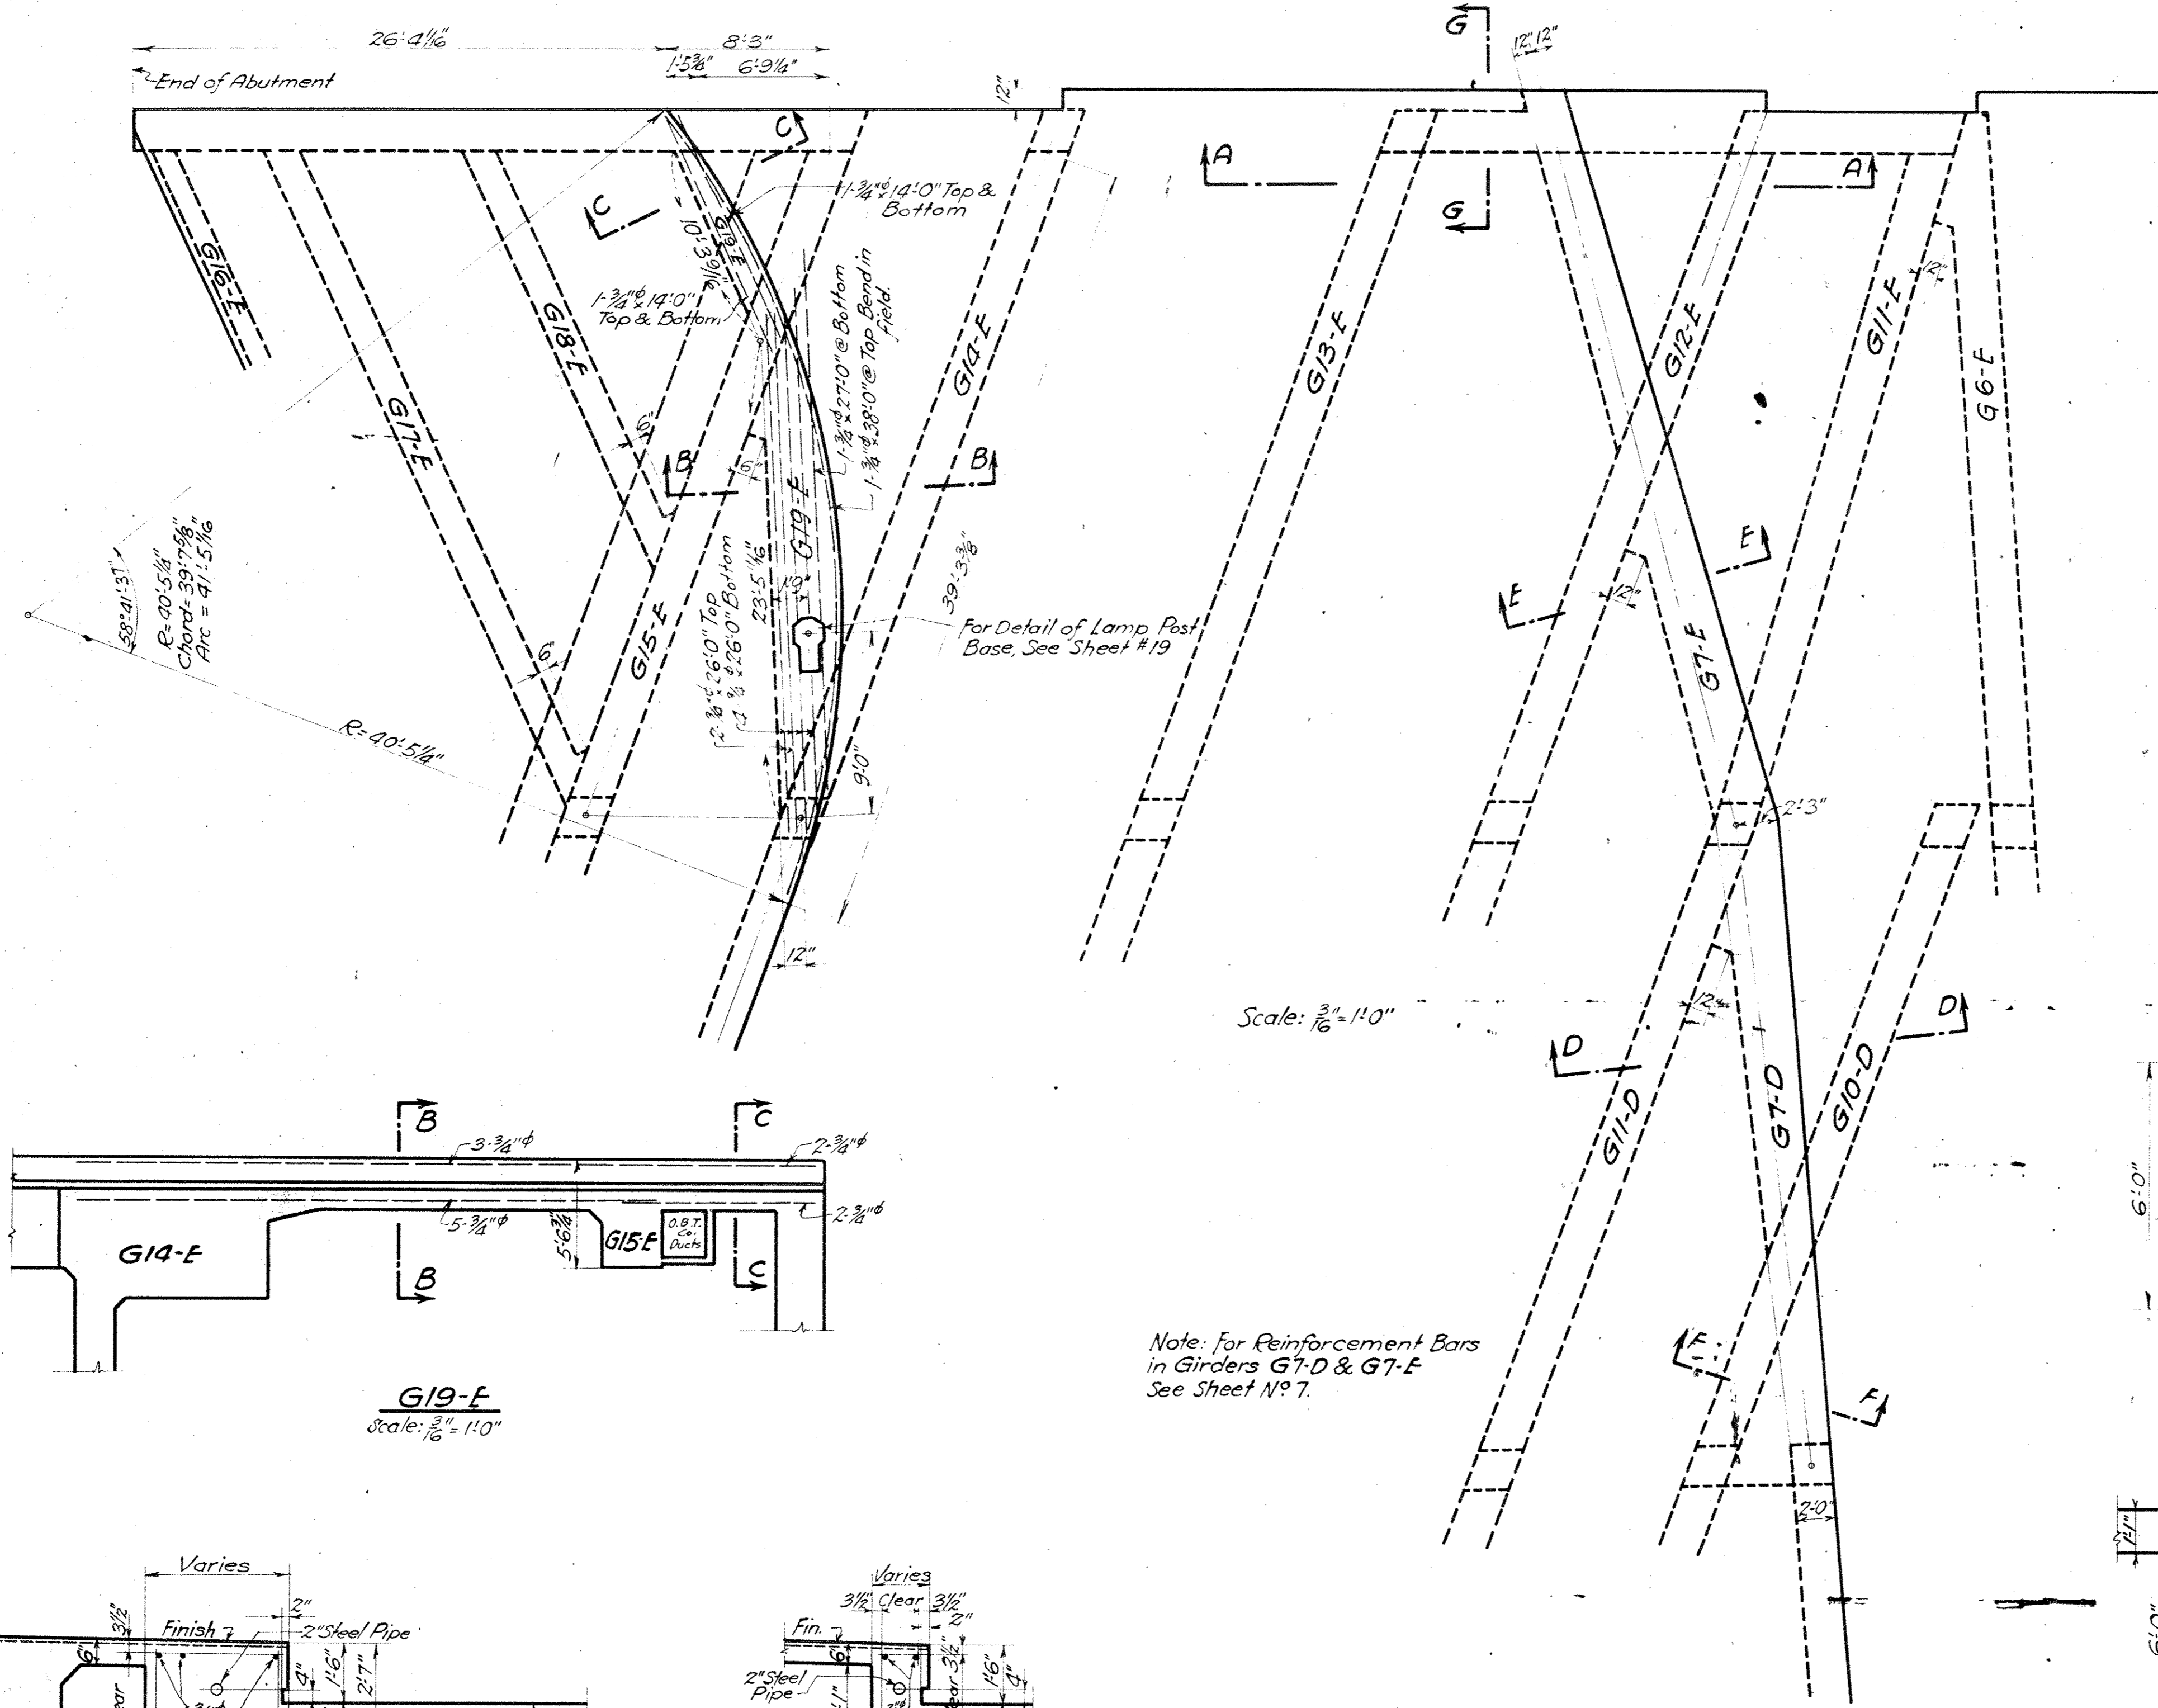

Note: For Reinforcement Bars
in Girders G7-D & G7-E
See Sheet No 7.

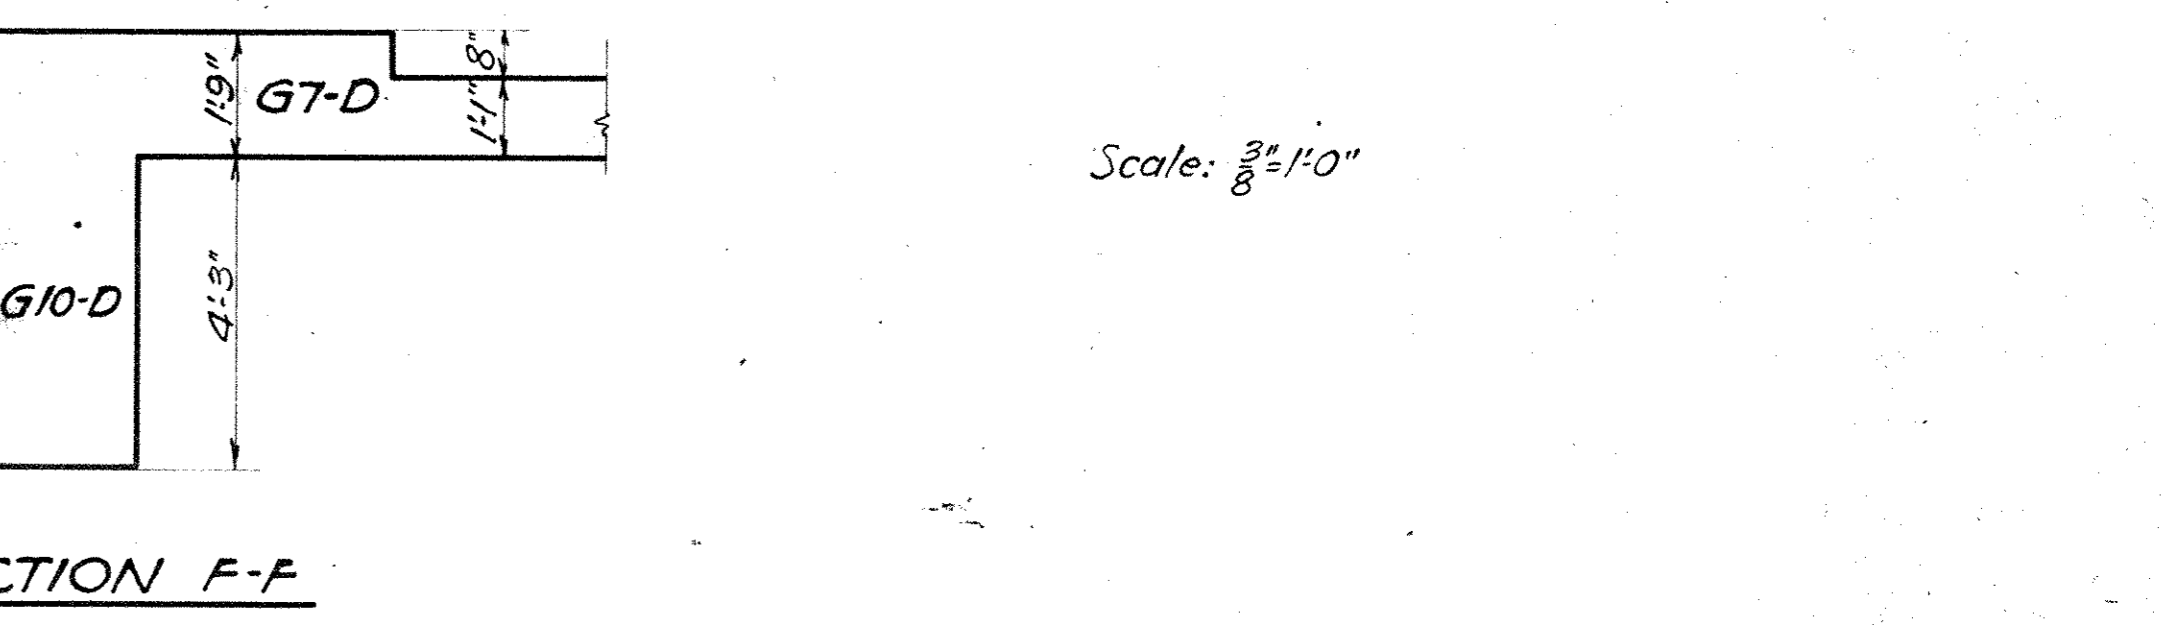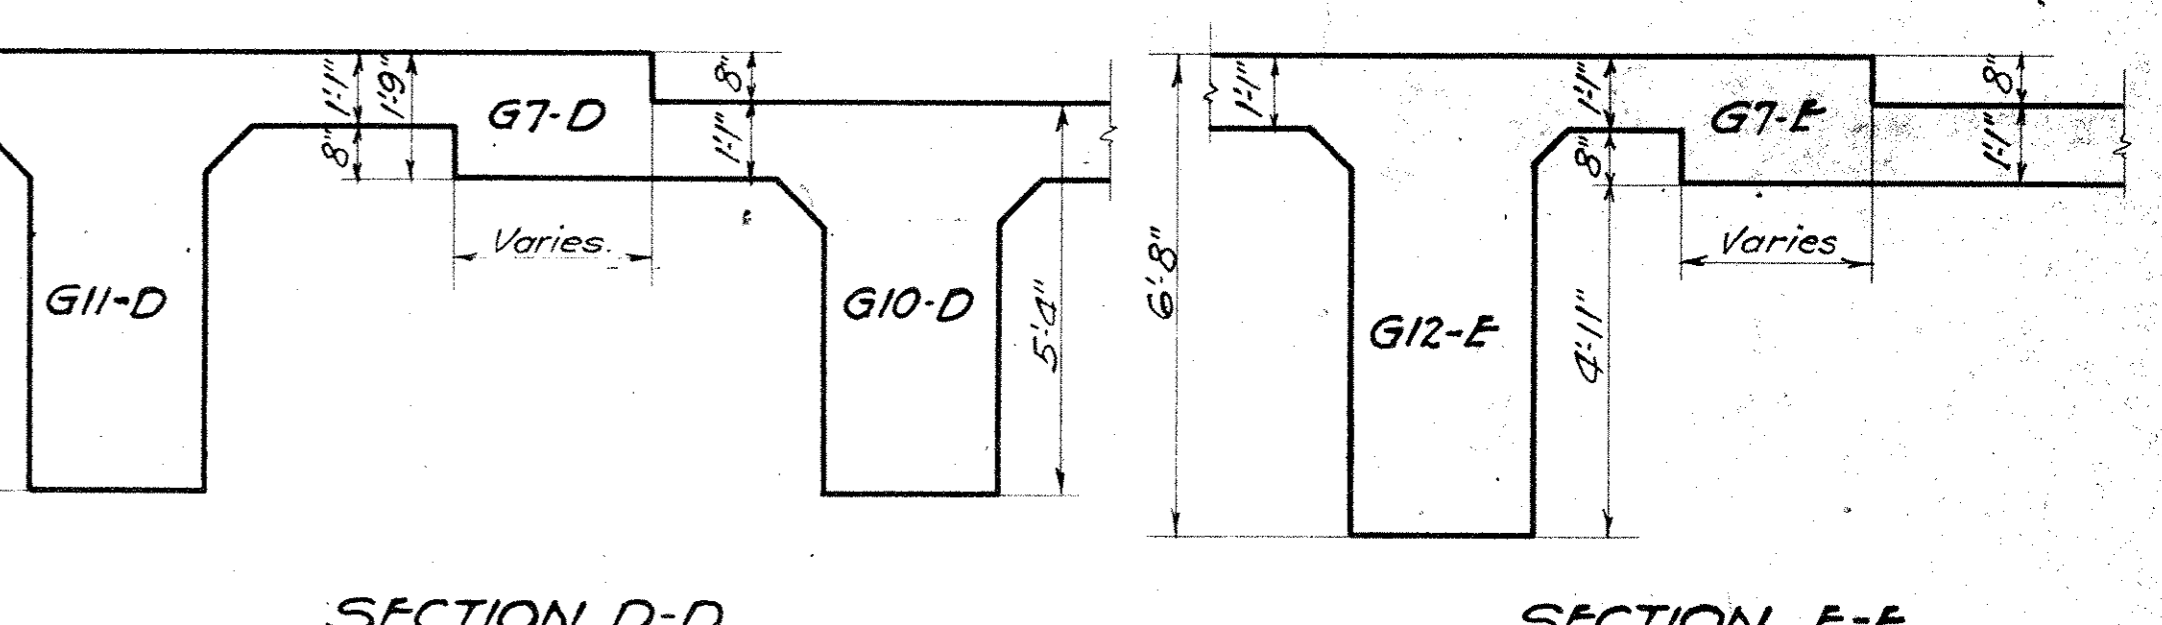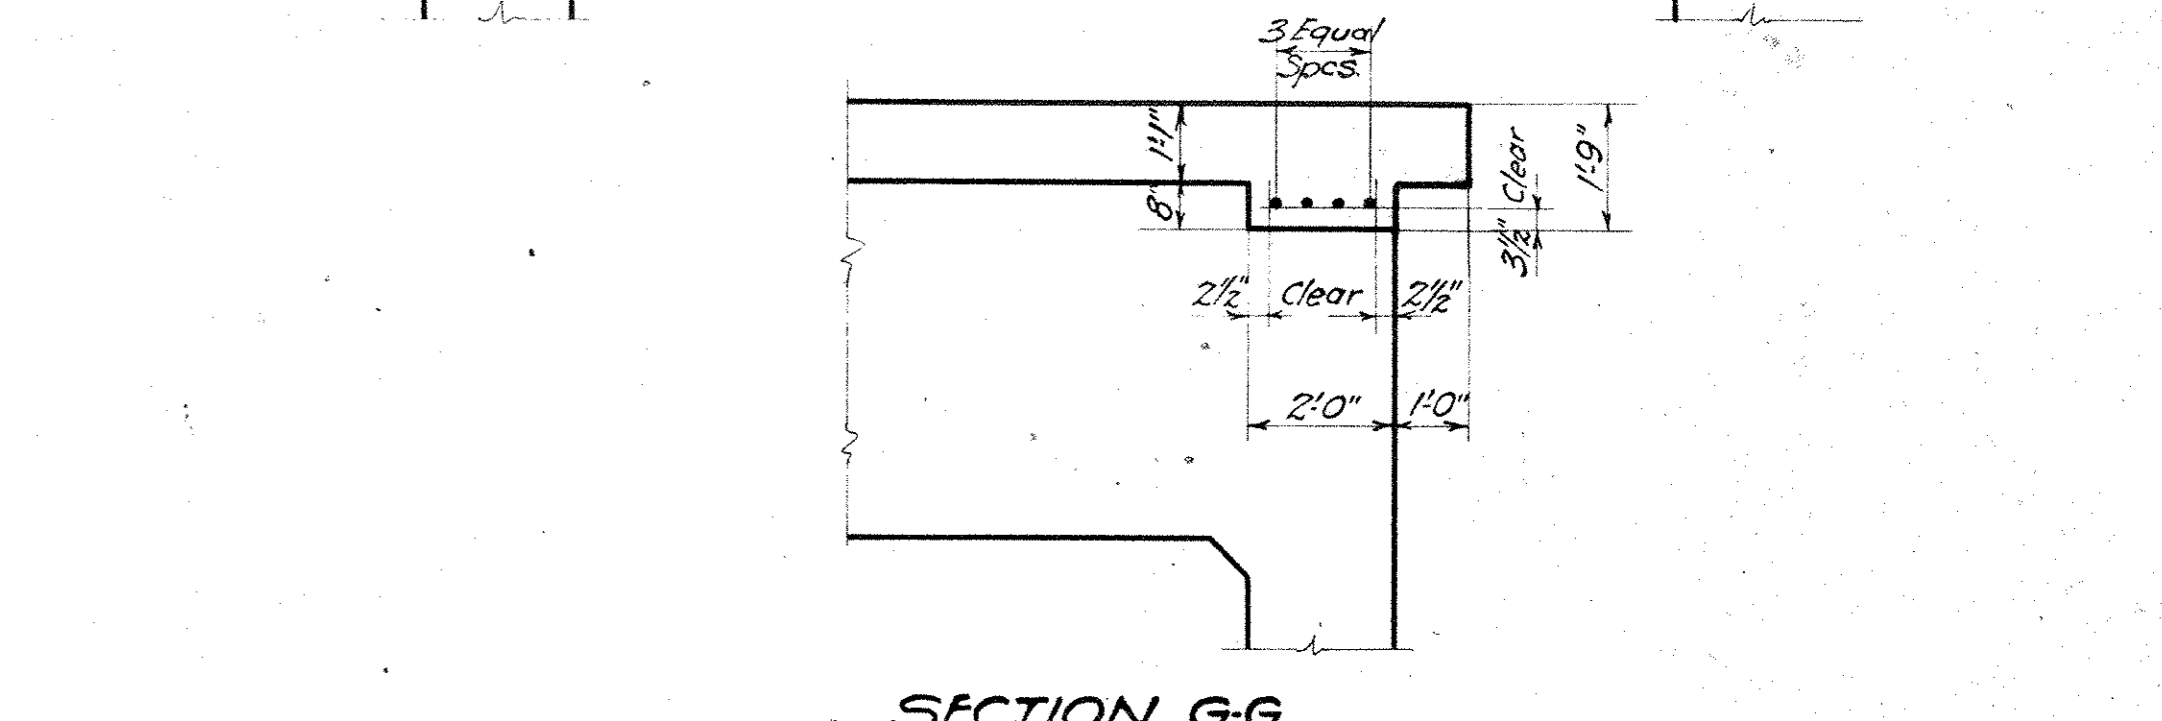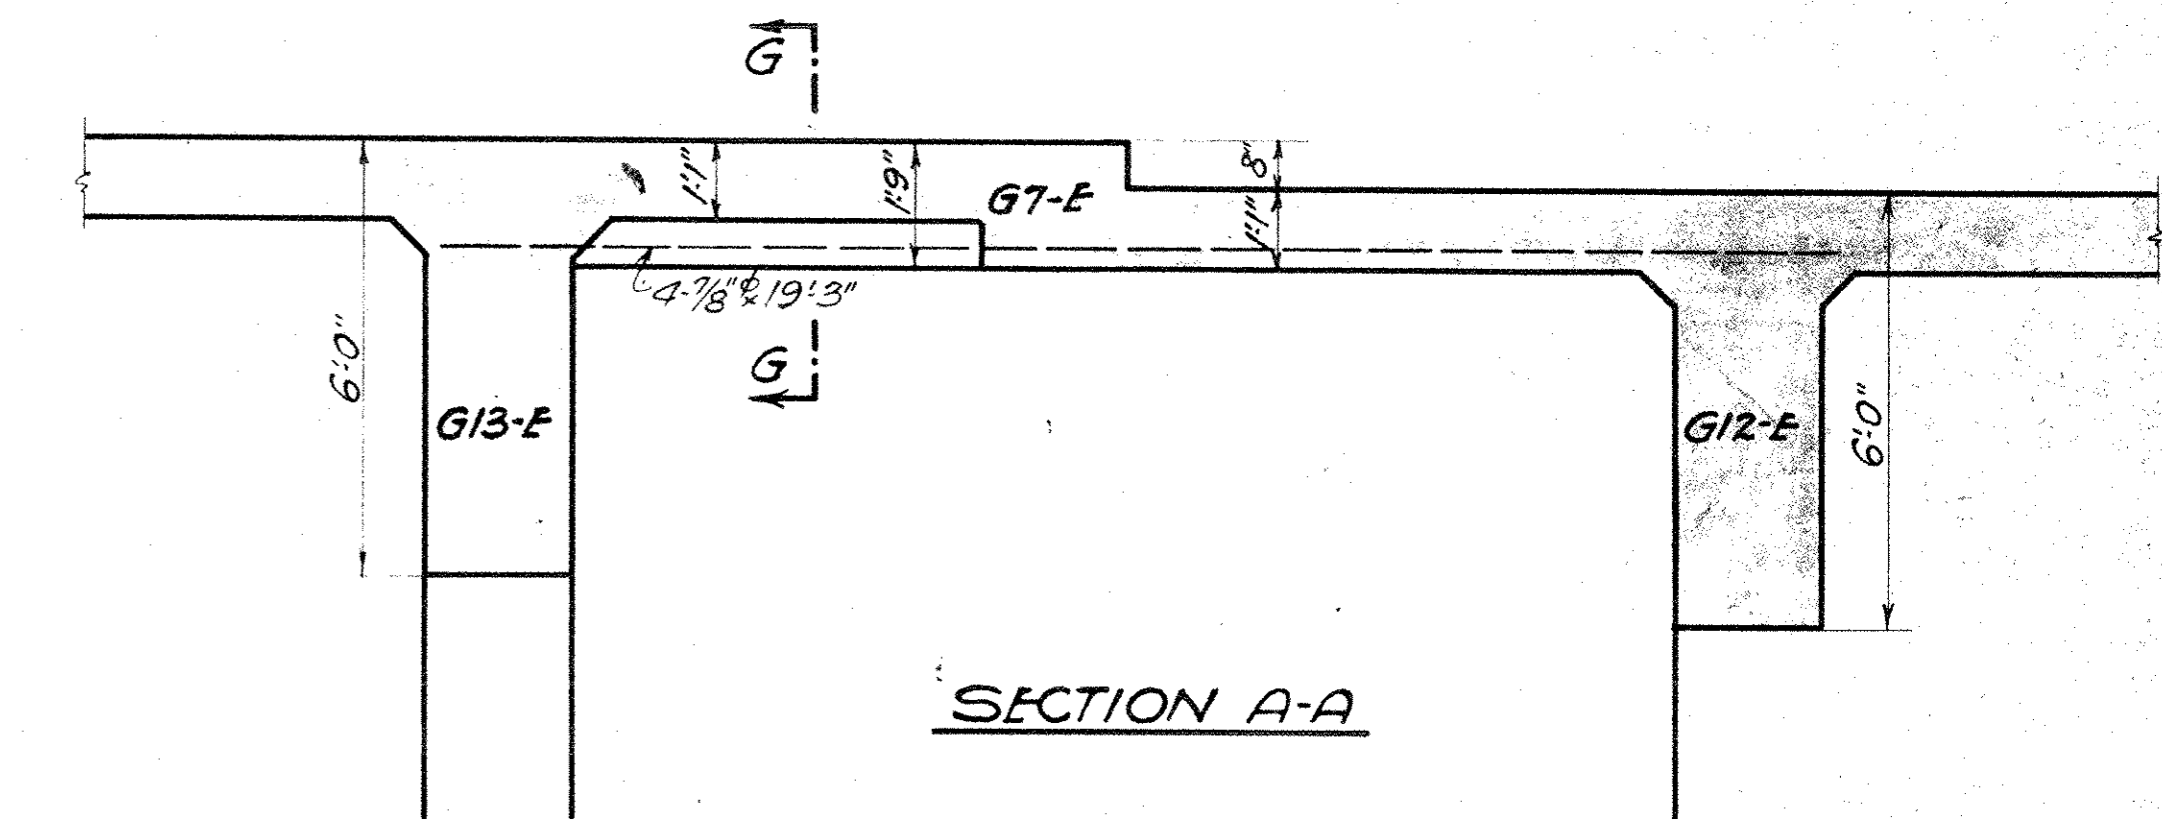

We HEREBY CERTIFY THAT THIS PLAN
SHOWS THE STRUCTURE AS BUILT.

G. C. ...
ENGINEER OF STRUCTURES
H. B. ...
ASST. ENGINEER OF CONSTRUCTION


Designed By G.T.C. Sept. 30, 1927.
Detailed By T.W. Oct. 20, 1927.
Traced By S.H. Nov. 22, 1927.
Checked By L.C.B. Nov. 15, 1927.
Correct Nov. 30, 1927.
Designing Engineer

Approved *G. C. ...*
Engineer of Structures
Approved *T. W. ...*
Principal Assistant Engineer
Approved *S. H. ...*
Assistant Electrical Engineer
Approved *L. C. B. ...*
Engineer of Construction


Plan Approved
CITY OF CLEVELAND
By ROBERT HOFFMANN
Commissioner of Engineering & Construction
Date 4-13-28.

THE CLEVELAND UNION TERMINALS CO.
CENTRAL AVE. BRIDGE
DETAILS OF GIRDERS
G7-D, G7-E & G19-F
OFFICE OF ENGINEER OF STRUCTURES
SCALE AS SHOWN
DATE OCT. 20, 1927.
REVISED 9-1-33
ISSUE No. 5


Issue No A Oct. 20, 1927
 REVISIONS:
 Issue No B Nov. 21, 1927
 Checked and Drawing Traced.
 Issue No 1 Nov. 30, 1927
 Signed By Chief Engineer.
 Issue No 2 Jan. 24, 1928
 Approved By Heads of Departments.
 Issue No 3 Feb. 8, 1928
 Removed Water Chambers.
 Issue No 4 April 24, 1928
 Approved by the City.
 Issue No 5 Sept. 1, 1933
 Plan Conforms to Structure as Built.

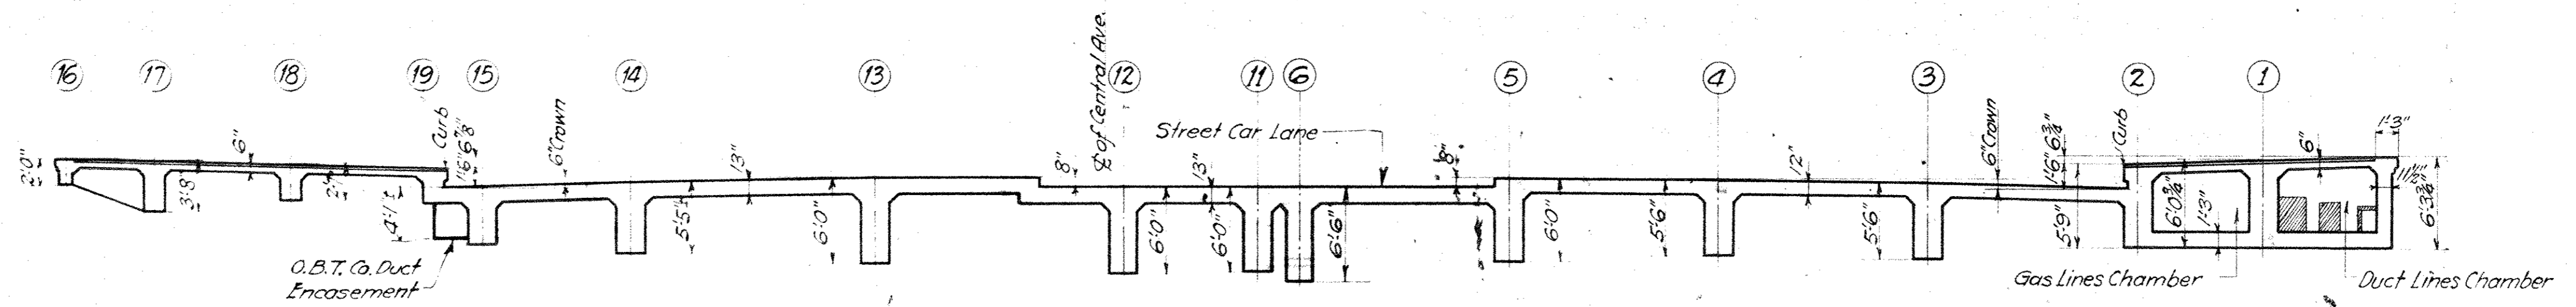


SECTION O-O

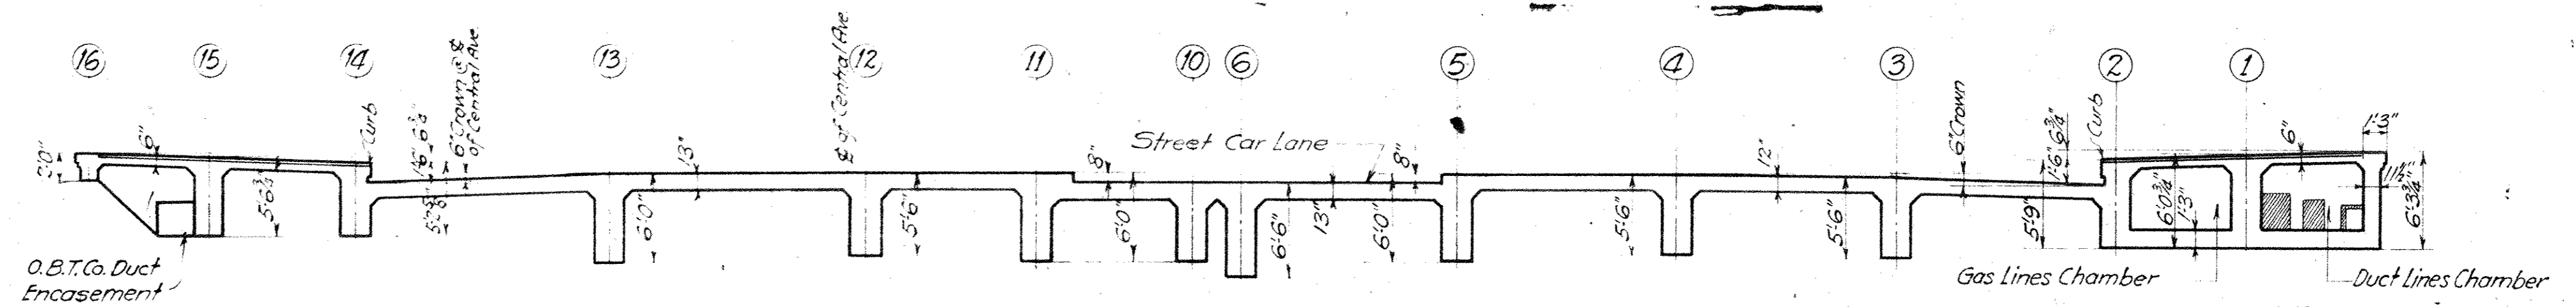


SECTION P-P

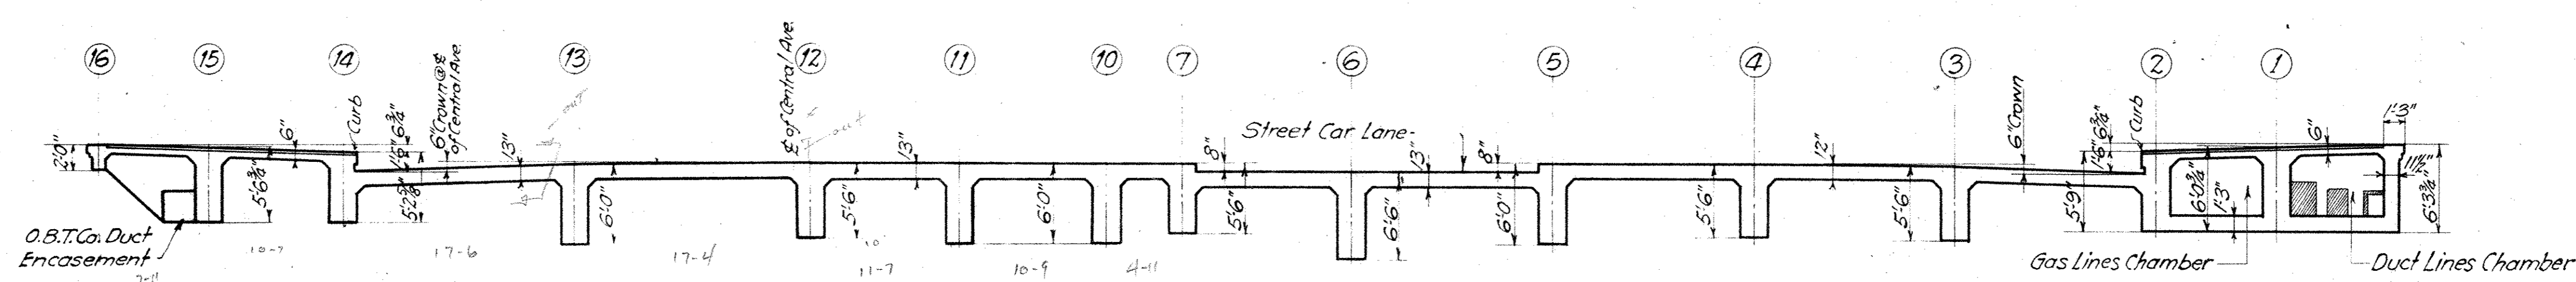

SECTION Q-Q

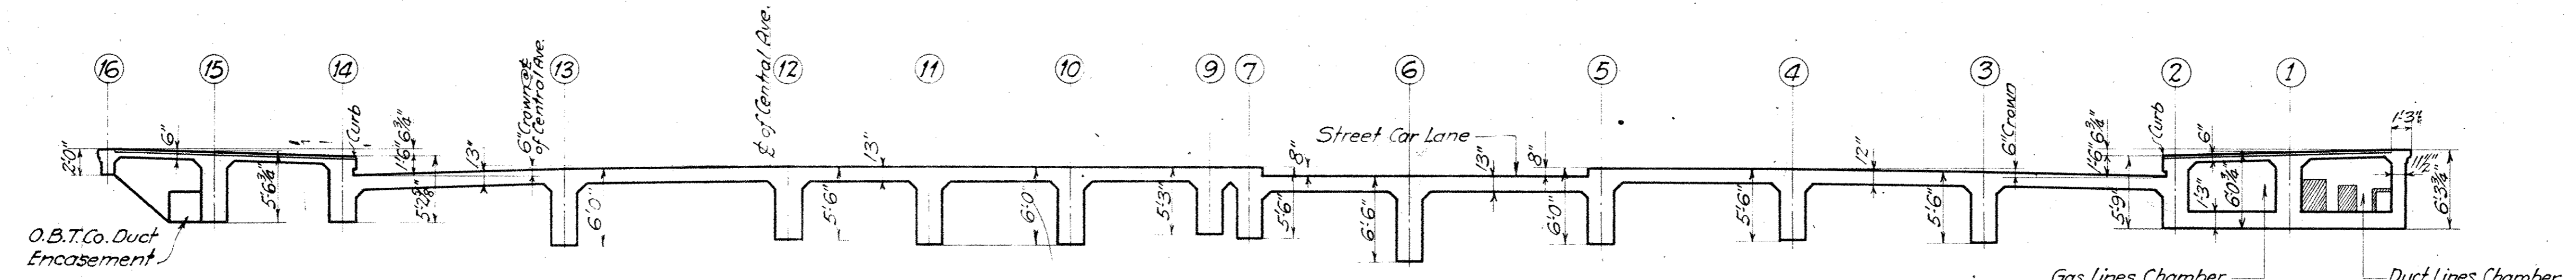

SECTION R-R

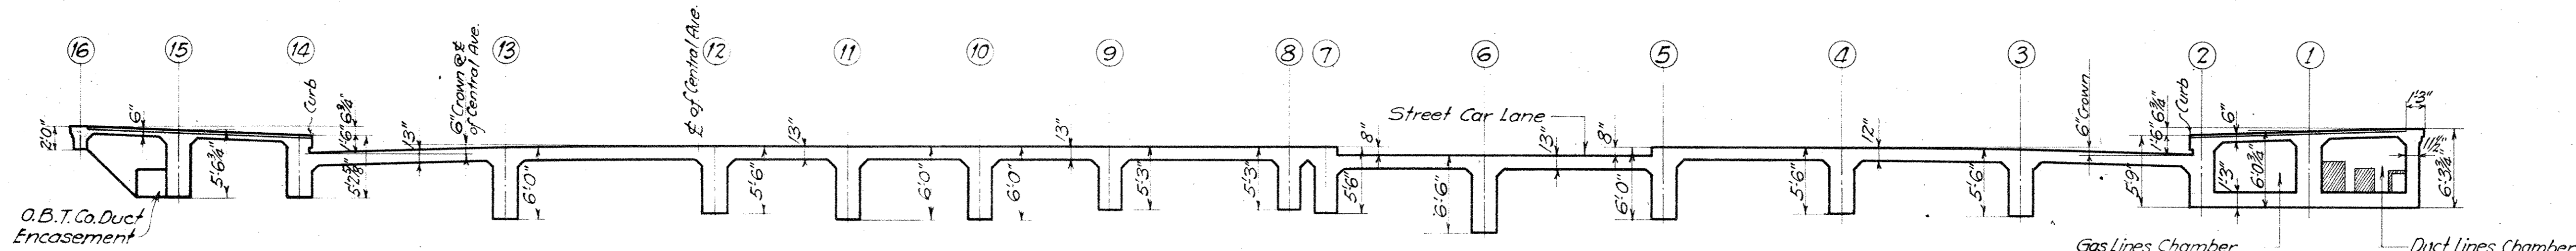

SECTION S-S

NOTE: For Location of Sections See Sheet No 5

WE HEREBY CERTIFY THAT THIS PLAN SHOWS THE STRUCTURE AS BUILT

E. C. Marsh
 ENGINEER OF STRUCTURES
 ASST. ENGINEER OF CONSTRUCTION

Designed By G.T.C. & J.H.C. 7-5-1927
 Detailed By S.H. Oct. 20, 1927
 Traced By S.H. Nov. 21, 1927
 Checked By T.W. Nov. 18, 1927
 Corrected Nov. 30, 1927
A.L. Johnson
 Designing Engineer

Approved *E.P. Marsh*
 Engineer of Structures
 Approved *J.W. Smith*
 Principal Assistant Engineer
 Approved *W.H. ...*
 Assistant Electrical Engineer
 Approved *...*
 Engineer of Construction

Plan Approved
 CITY OF CLEVELAND


By *ROBERT HOFFMANN*
 Commissioner of Engineering & Construction
 Date 4-13-28

For Original of this Signature
 See Blue Print Filed under No. 113-046-3

THE CLEVELAND UNION TERMINALS CO.
 CENTRAL AVE. BRIDGE
 CROSS SECTIONS OF DECK
 CLEVELAND, OHIO.
 OFFICE OF ENGINEER OF STRUCTURES
 SCALE: 1/4" = 1'-0"
 ISSUE No. 5
 DATE OCT. 20, 1927
 REVISED 9-1-33

REVISIONS:

- Issue No B Nov. 23, 1927. Drawing Checked and Traced.
- Issue No 1 Nov. 30, 1927. Signed By Chief Engineer.
- Issue No 2 Jan. 24, 1928. Approved By Heads of Departments.
- Issue No 3 April 24, 1928. Approved by the City.
- Issue No 4 July 30, 1928. Revised Details of Catenary Anchor Rods.
- Issue No 5 Sept. 1, 1933. Plan Conforms to Structure as Built.

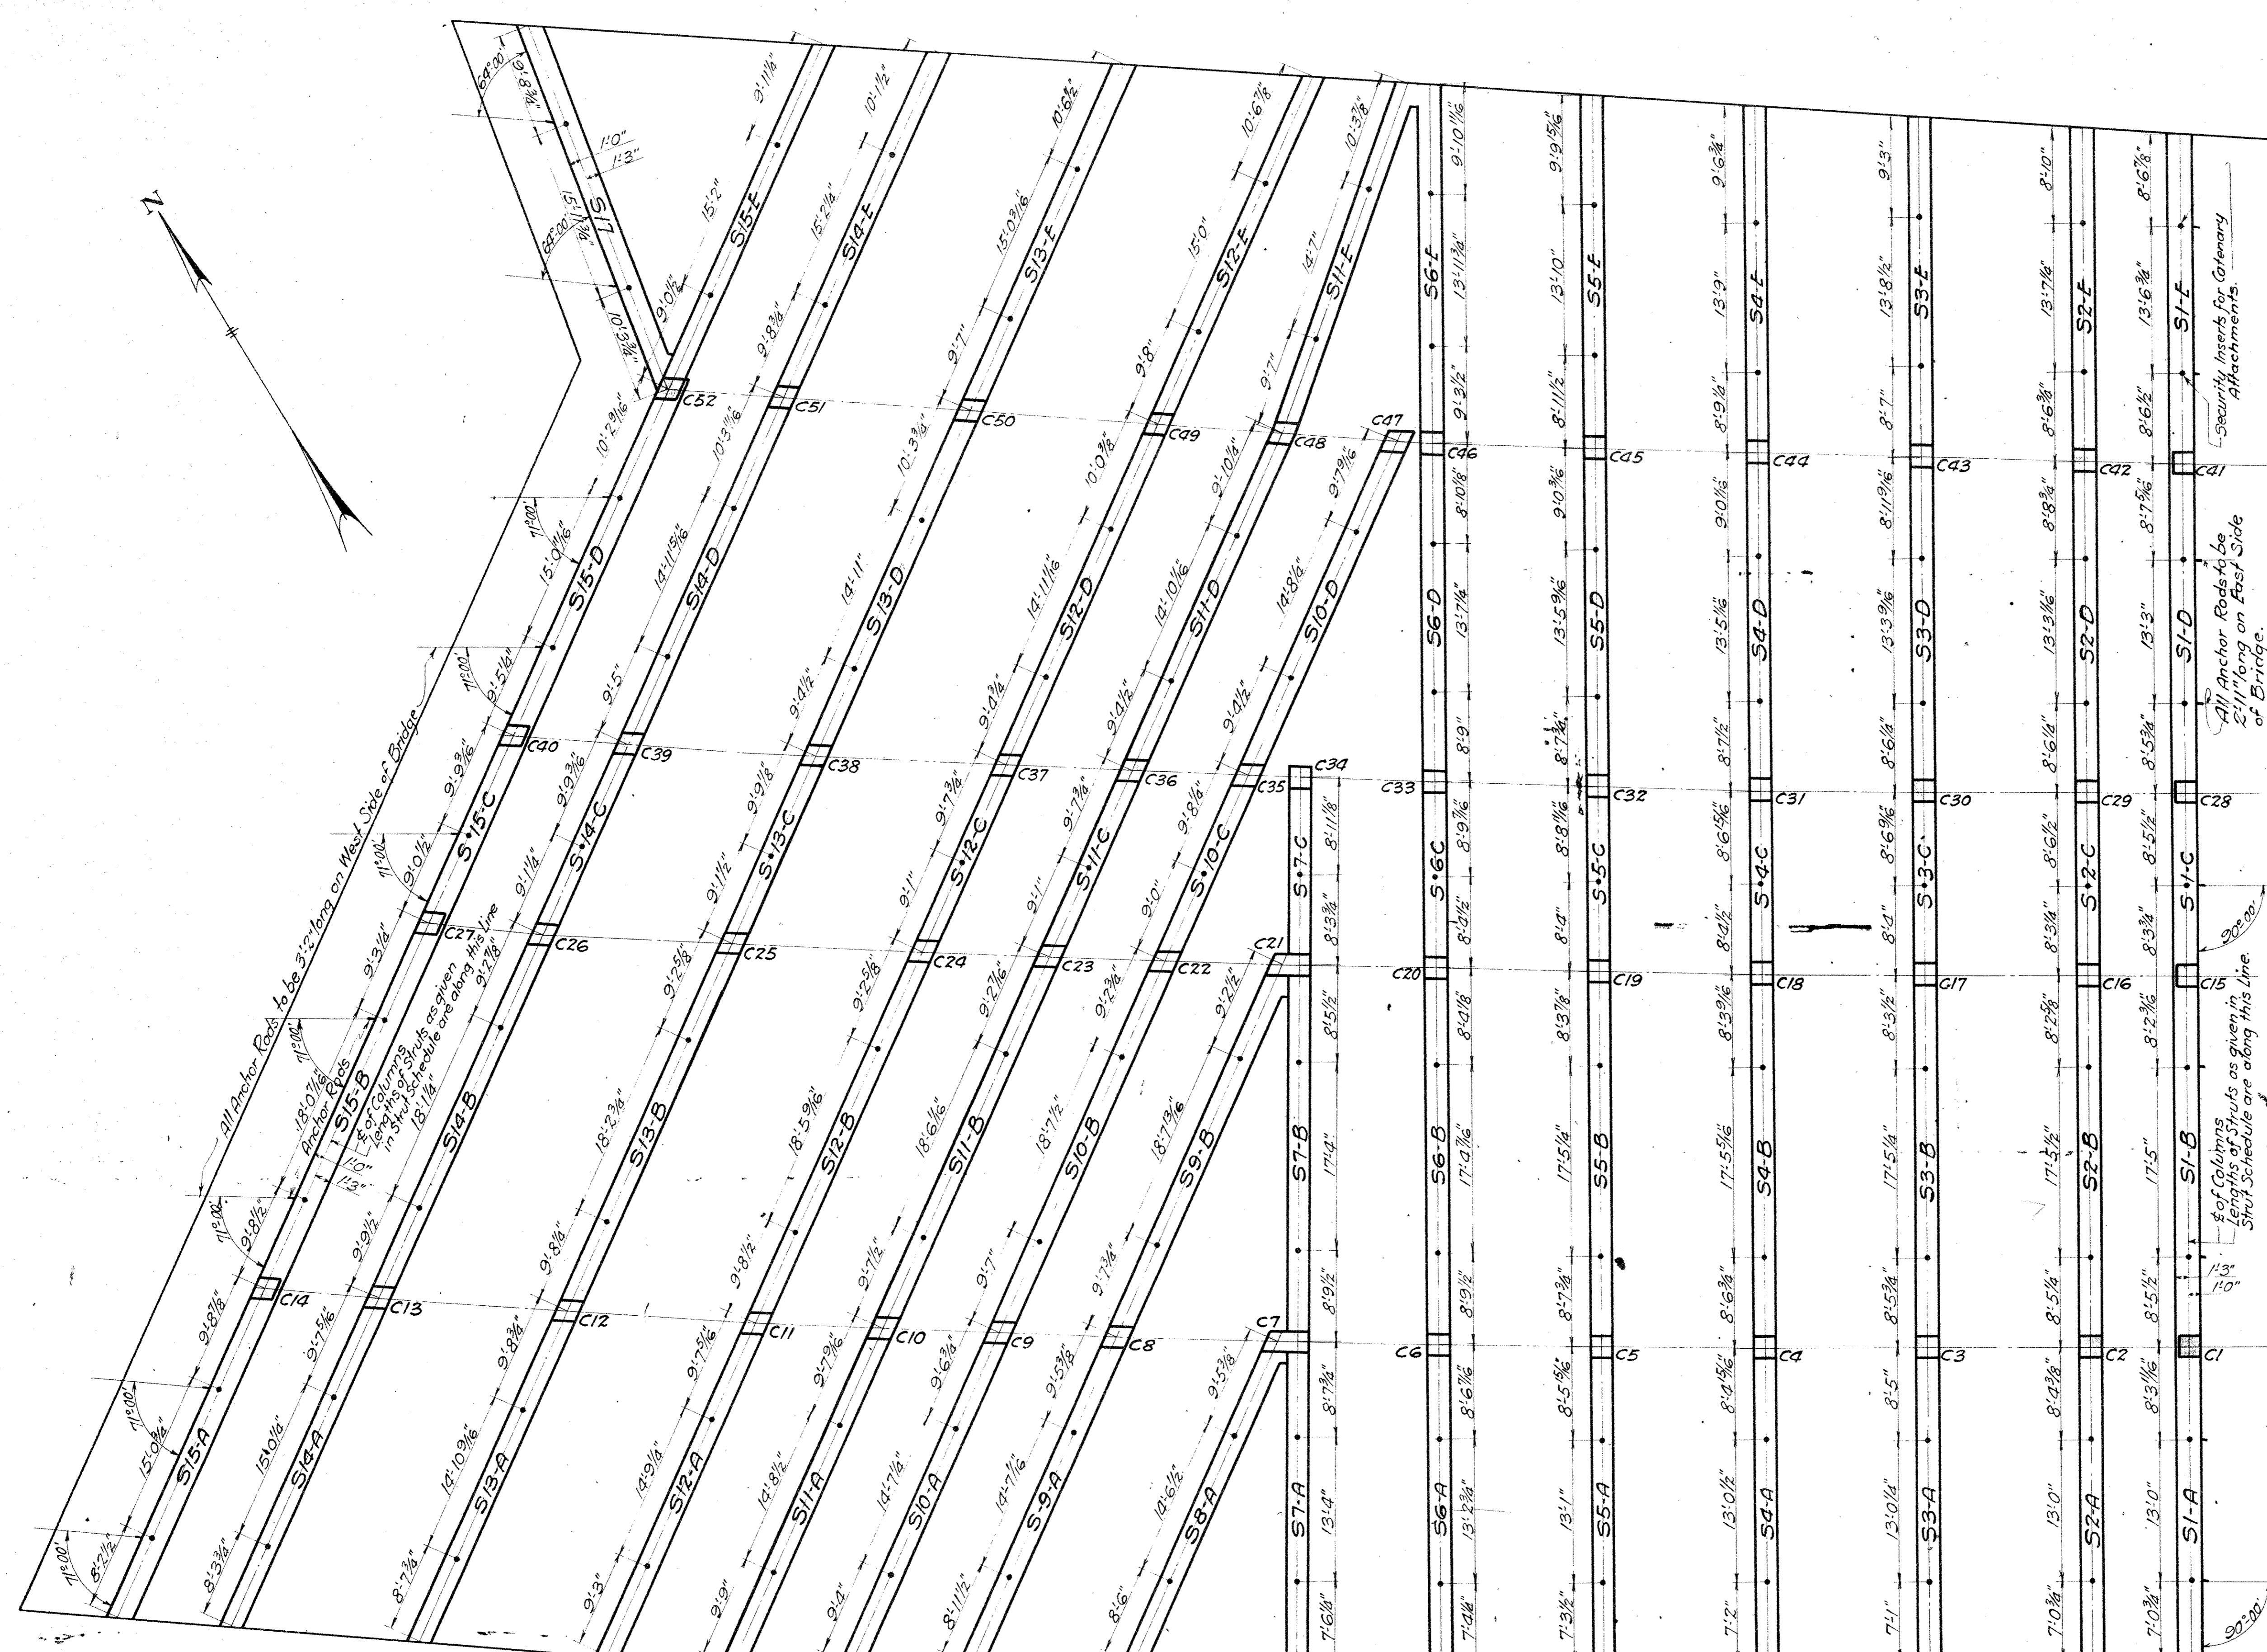


We HEREBY CERTIFY THAT THIS PLAN SHOWS THE STRUCTURE AS BUILT


E. C. Mark
ENGINEER OF STRUCTURES
ASST. ENGINEER OF CONSTRUCTION

Designed By G.T.C. May 31, 1927.
Detailed By H.B. May 31, 1927.
Traced By S.H. Nov. 23, 1927.
Checked By J.H.C. Nov. 23, 1927.
Correct *W.C.* 12/23/1927.
G.L. Hoffman
Designing Engineer



Approved *E. C. Mark*
Engineer of Structures
Approved *J. W. ...*
Principal Assistant Engineer
Approved *J. H. C.*
Assistant Electrical Engineer
Approved *G. L. Hoffman*
Engineer of Construction

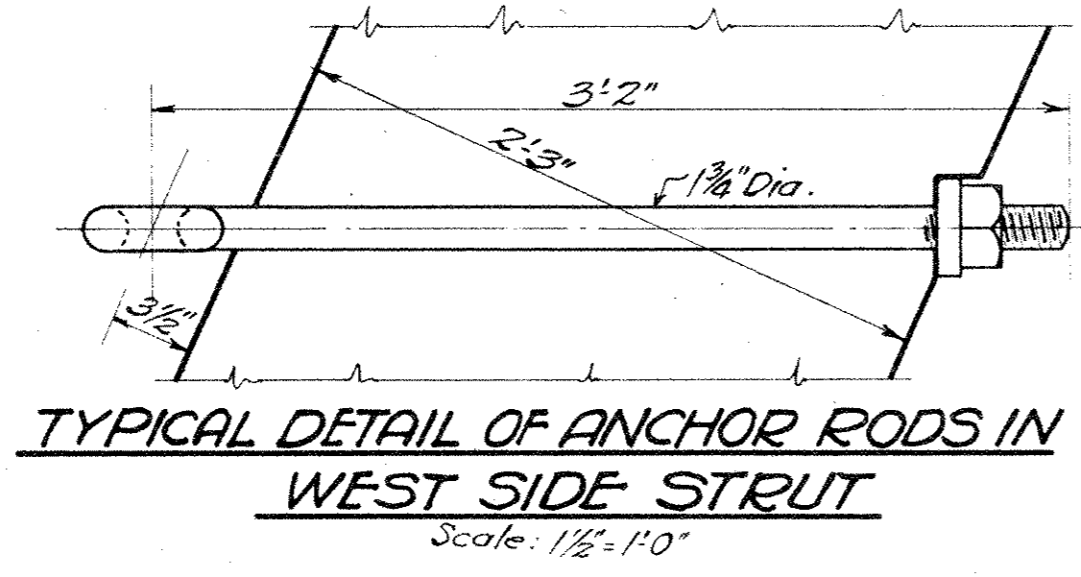

FRAMING PLAN OF STRUTS
Scale: 1/8" = 1'-0"
Note: For Dimensions See Sheet No 2.

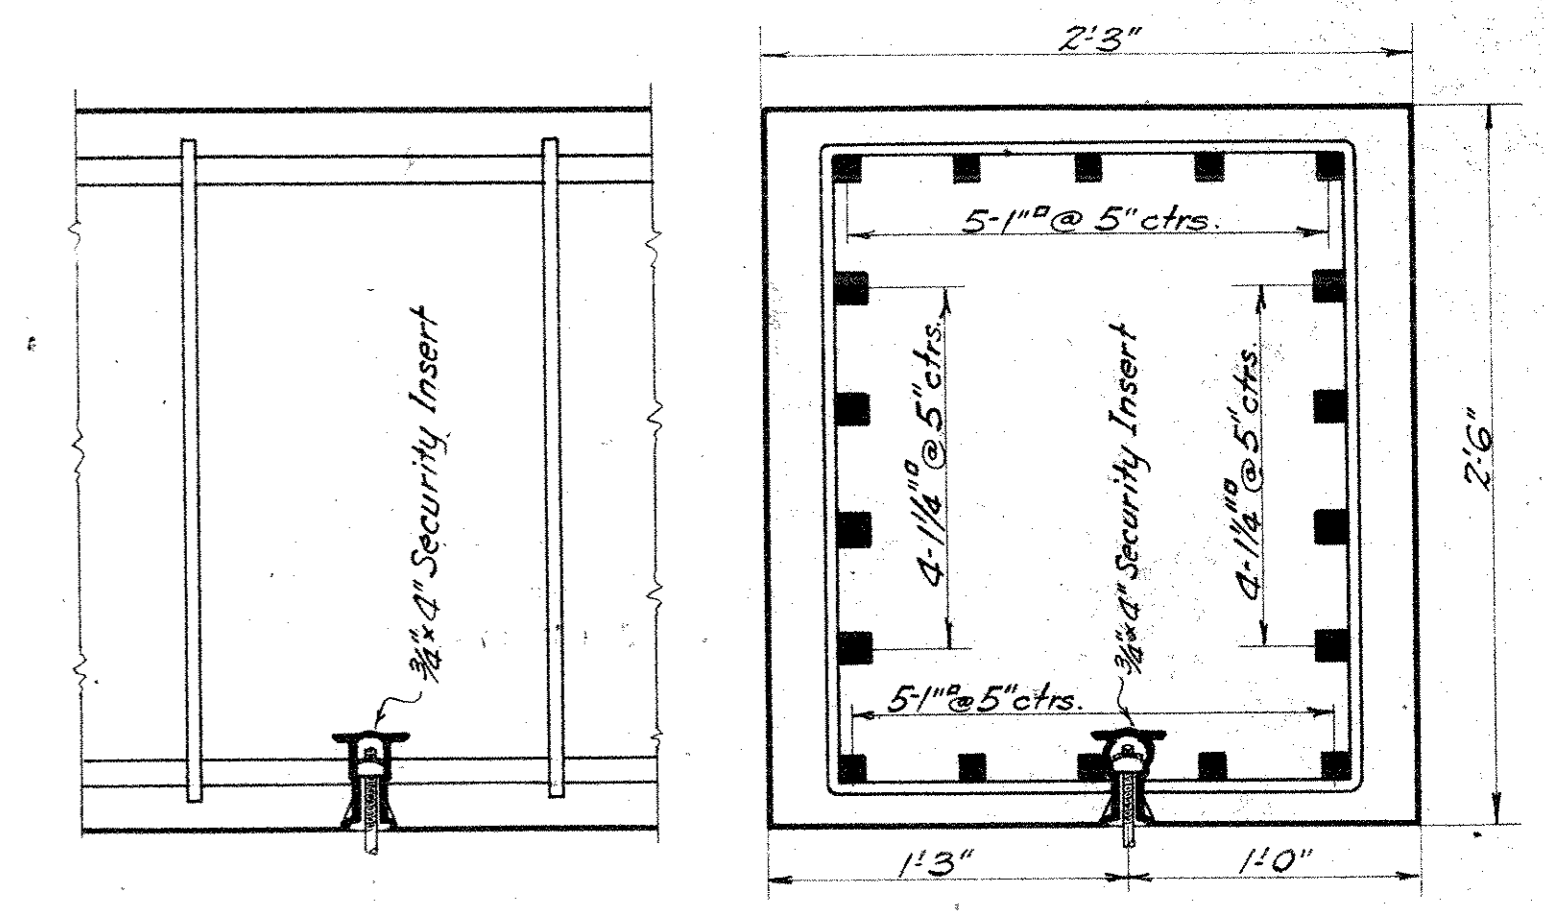

TYPICAL SECTION OF INTERIOR STRUTS
Showing Catenary Attachments and Reinforcement.
Scale: 1/2" = 1'-0"

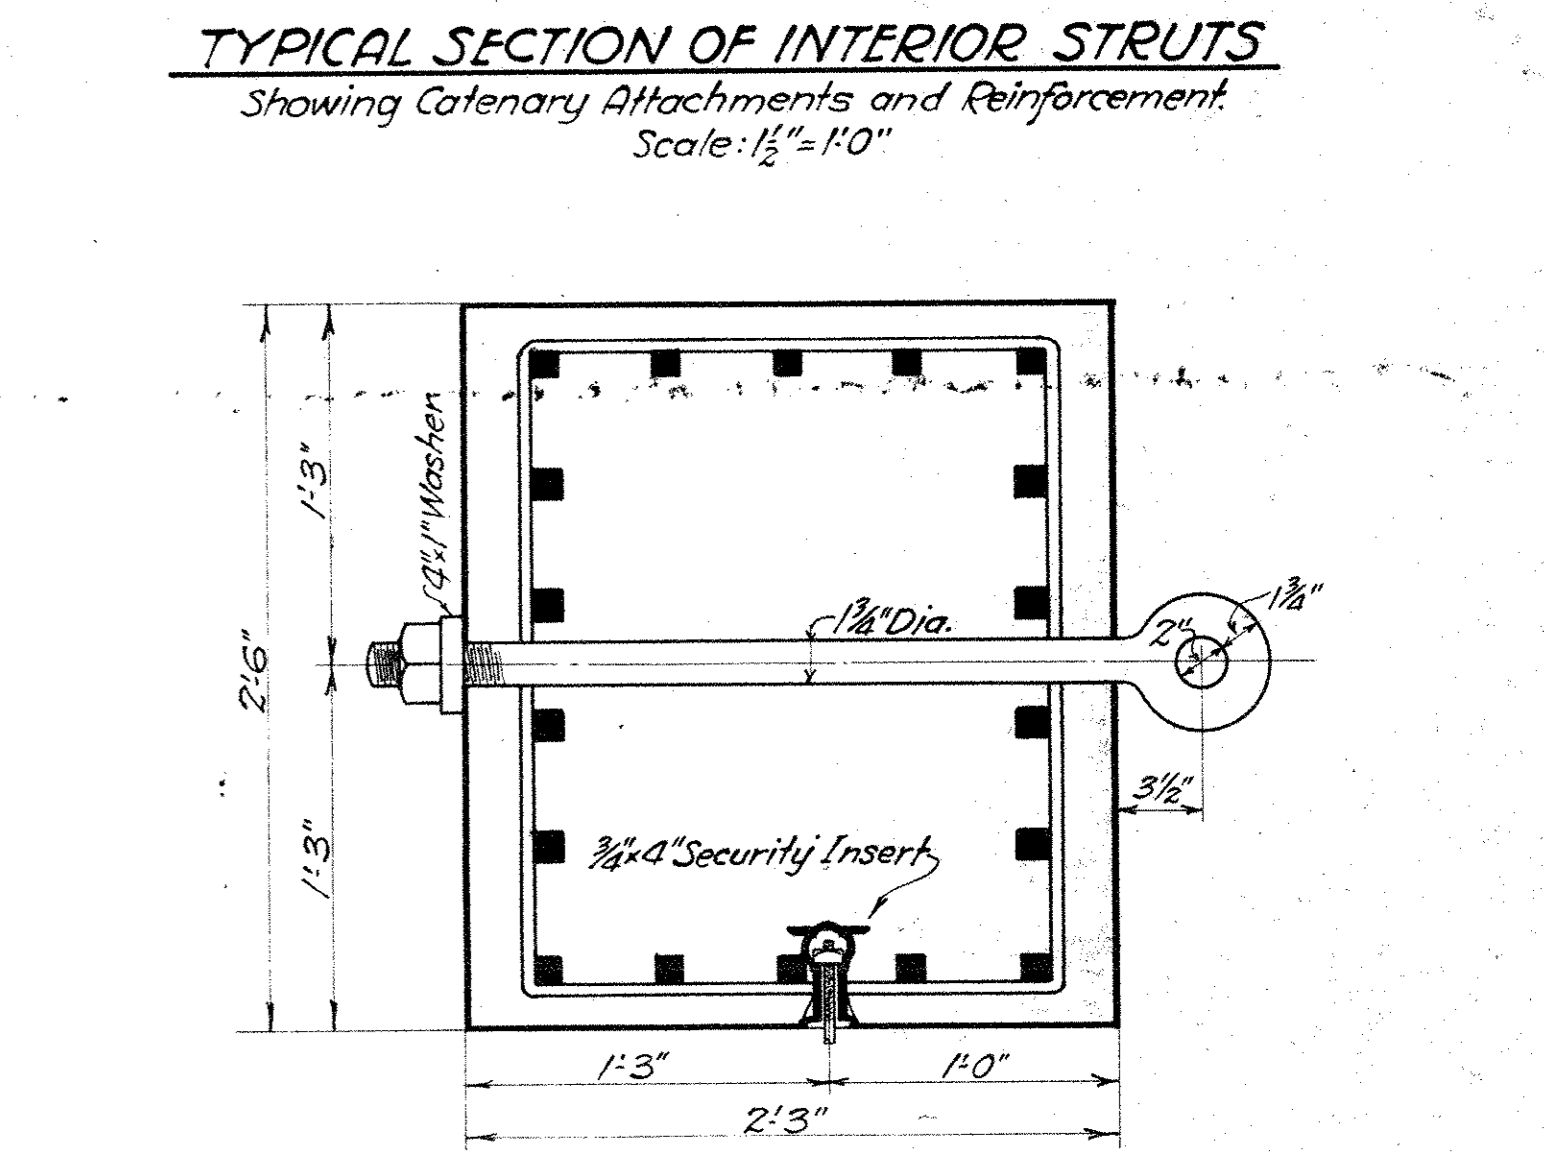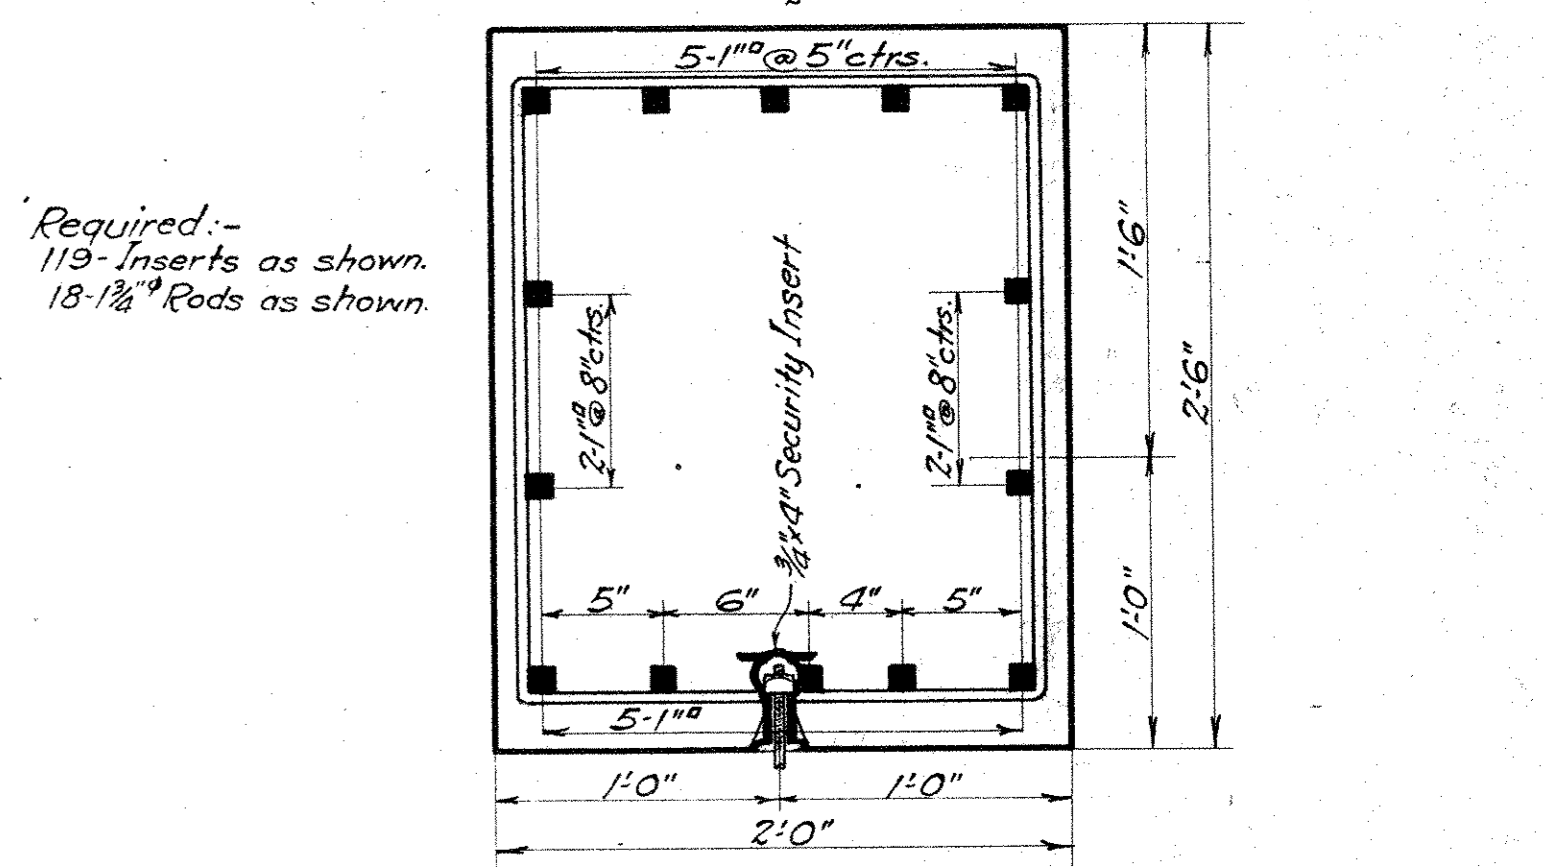


NOTE: All parts of Catenary Attachments to be hot dip galvanized.

Plan Approved
CITY OF CLEVELAND


By *ROBERT HOFFMANN*
Commissioner of Engineering & Construction
Date 4-13-28

THE CLEVELAND UNION TERMINALS CO.
CENTRAL AVE. BRIDGE
PLAN OF COLUMNS AND STRUTS
CLEVELAND, OHIO.
OFFICE OF ENGINEER OF STRUCTURES
SCALE: AS SHOWN. DATE MAY 31, 1927.
ISSUE NO. 5. REVISED 9-1-33.
G. L. Hoffman
CHIEF ENGINEER


Issue No A June 20, 1927
 Revisions:-
 Issue No B Nov. 12, 1927
 Drawing checked & Minor revisions traced.
 Issue No 1 Nov. 30, 1927
 Signed By Chief Engineer.
 Issue No 2 Jan. 24, 1928
 Approved By Heads of Departments.
 Issue No 3 April 24, 1928
 Approved by the City.
 Issue No 4 Aug. 2, 1928
 Revised Hoops in C7 & C21.
 Issue No 5 Sept. 1, 1933
 Plan Conforms to Structure as Built.

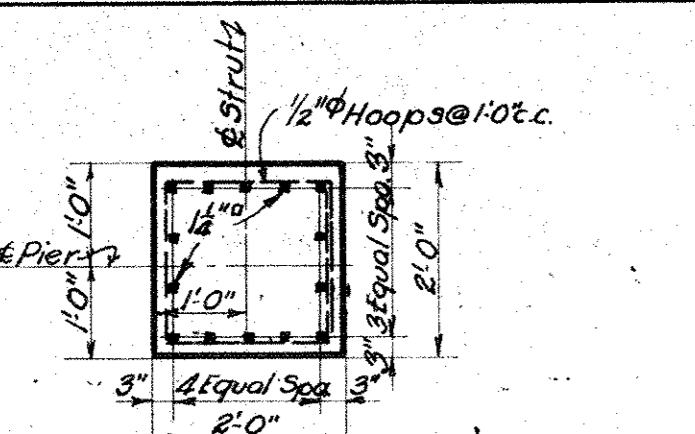


DETAIL OF COL'S C1 TO C6 Incl.

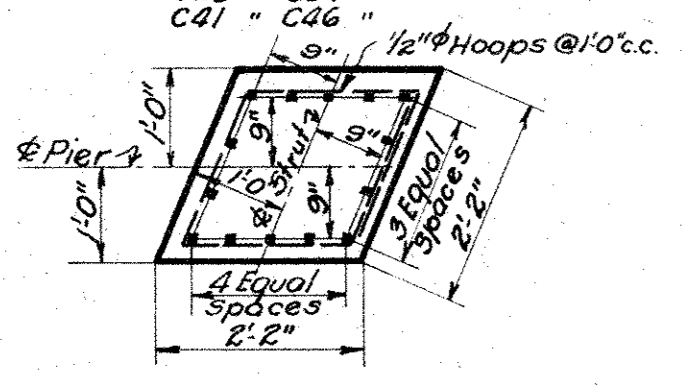


DETAIL OF COL'S C7, C8, C9, C51, C52

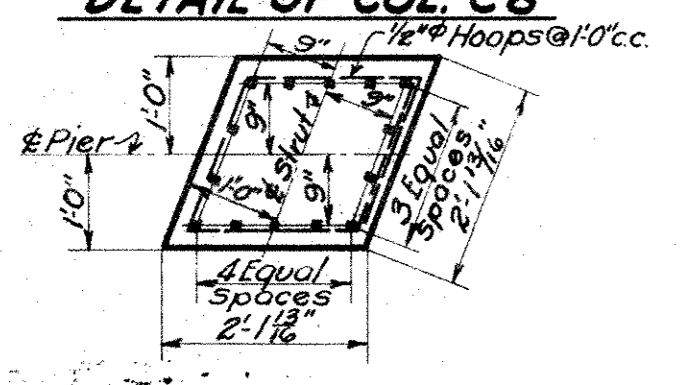


DETAIL OF COL'S C35 & C36

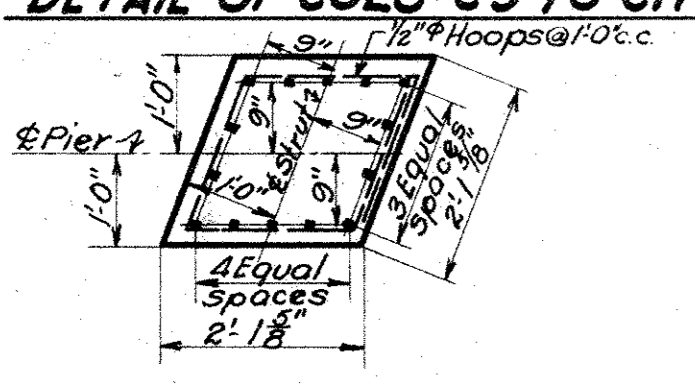


DETAIL OF COL'S C9 TO C11 Incl.

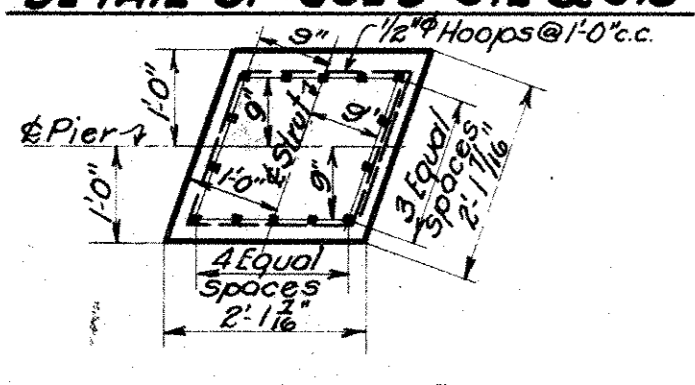

DETAIL OF COL'S C12 & C13

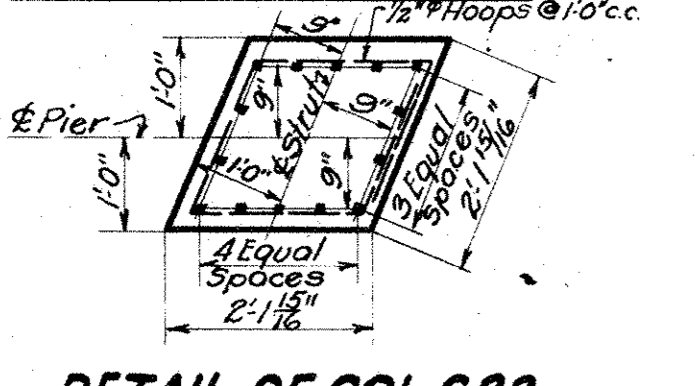


DETAIL OF COL C14

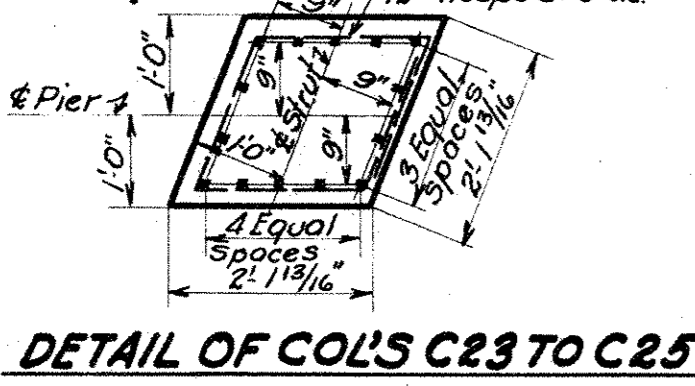


DETAIL OF COL C22




DETAIL OF COL'S C23 TO C25 Incl.

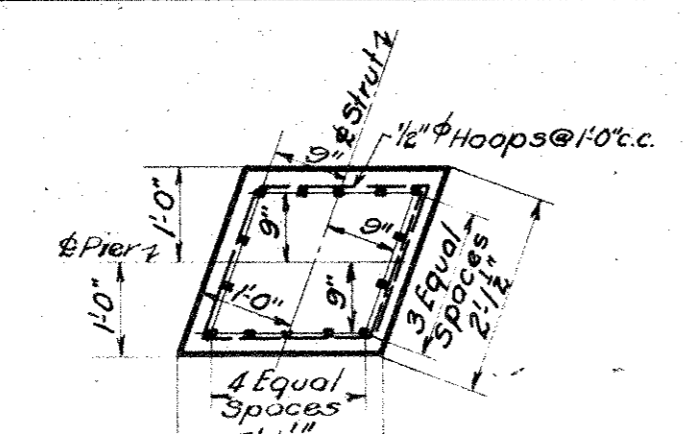


DETAIL OF COL'S C26 & C27

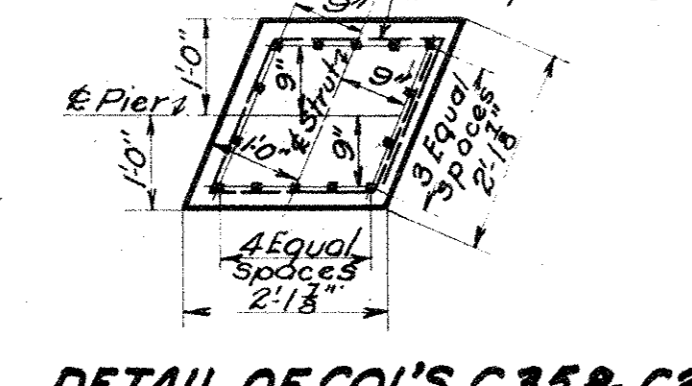


DETAIL OF COL'S C35 & C36

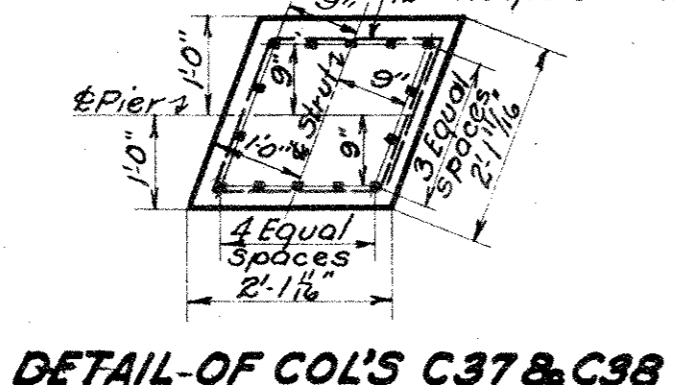

DETAIL OF COL'S C37 & C38

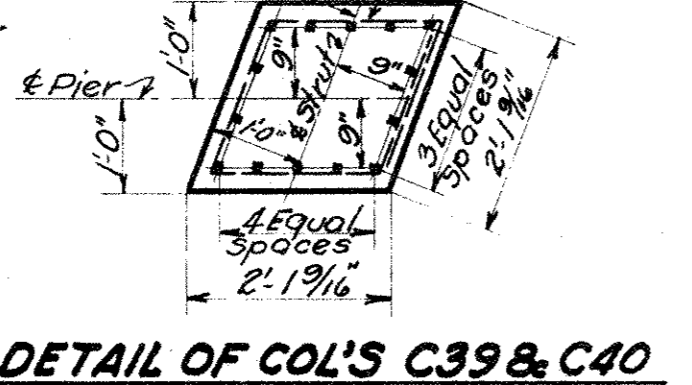


DETAIL OF COL'S C39 & C40 AND COL'S C47 TO C52 Incl.

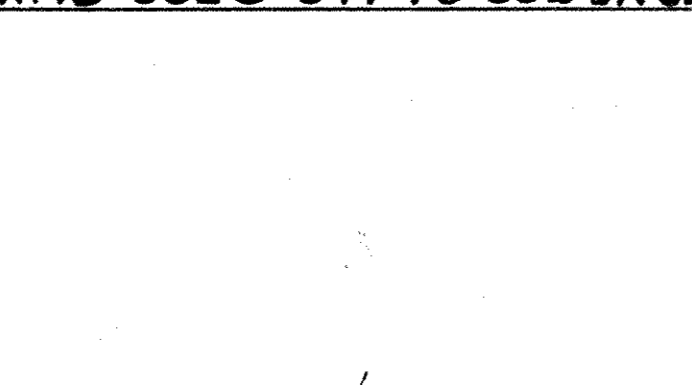


DETAIL OF COL C7



DETAIL OF COL C21

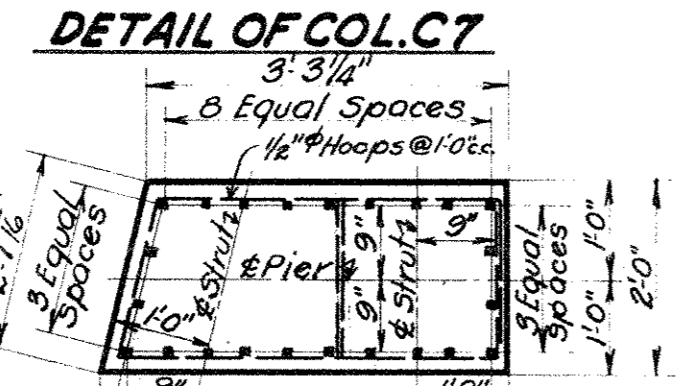

TYPICAL INSIDE STRUT DETAIL

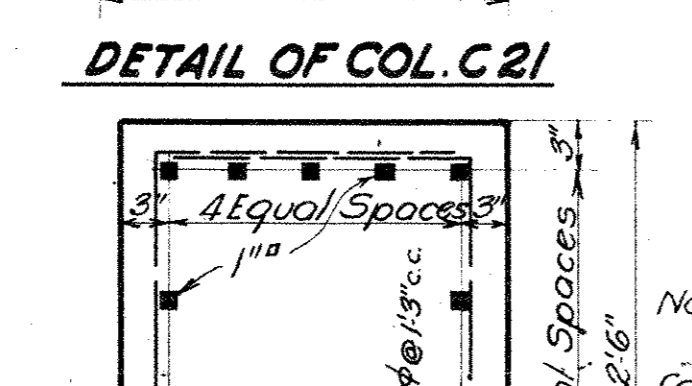


OUTSIDE STRUTS

NO.	SIZE	LENGTH	HOOPS	VERTICAL STEEL
C1	2'0" x 2'0"	19'2 3/4"	17-H-440#	12-1/4" x 25'0"
C2	2'0" x 2'0"	19'2 3/4"	17-H-440#	14-1/4" x 22'9"
C3	2'0" x 2'0"	18'3"	16-H-440#	14-1/4" x 23'0"
C4	2'0" x 2'0"	18'5 1/2"	16-H-440#	14-1/4" x 23'0"
C5	2'0" x 2'0"	17'11 1/2"	16-H-440#	14-1/4" x 22'6"
C6	2'0" x 2'0"	16'9 3/4"	15-H-440#	14-1/4" x 22'6"
C7	2'0" x 2'0"	18'5 1/2"	16-H-440#	23-1/4" x 22'6"
C8	2'2" x 2'2"	18'8 3/8"	17-H-443#	14-1/4" x 23'3"
C9	2'1 1/2" x 2'1 1/2"	17'11 1/2"	16-H-443#	14-1/4" x 23'3"
C10	2'1 1/2" x 2'1 1/2"	17'11 1/2"	16-H-443#	14-1/4" x 23'3"
C11	2'1 1/2" x 2'1 1/2"	18'5 1/2"	16-H-443#	14-1/4" x 23'3"
C12	2'1 1/2" x 2'1 1/2"	17'10 1/2"	16-H-443#	14-1/4" x 23'0"
C13	2'1 1/2" x 2'1 1/2"	19'9 3/8"	18-H-443#	14-1/4" x 22'9"
C14	2'1 1/2" x 2'1 1/2"	19'9 3/8"	18-H-443#	14-1/4" x 25'0"
C15	2'0" x 2'0"	18'10 3/4"	16-H-440#	14-1/4" x 24'9"
C16	2'0" x 2'0"	18'10 3/4"	17-H-440#	14-1/4" x 22'6"
C17	2'0" x 2'0"	17'10 3/4"	16-H-440#	14-1/4" x 22'9"
C18	2'0" x 2'0"	18'1"	16-H-440#	14-1/4" x 22'9"
C19	2'0" x 2'0"	17'7 3/8"	16-H-440#	16-1/4" x 22'3"
C20	2'0" x 2'0"	16'5 3/8"	14-H-440#	14-1/4" x 22'3"
C21	2'1 1/2" x 2'1 1/2"	18'1 3/8"	16-H-443#	23-1/4" x 22'3"
C22	2'1 1/2" x 2'1 1/2"	17'7 1/2"	16-H-443#	14-1/4" x 23'0"
C23	2'1 1/2" x 2'1 1/2"	17'7 1/2"	16-H-443#	14-1/4" x 23'0"
C24	2'1 1/2" x 2'1 1/2"	18'1 3/8"	16-H-443#	14-1/4" x 23'0"
C25	2'1 1/2" x 2'1 1/2"	17'6 1/2"	16-H-443#	14-1/4" x 22'9"
C26	2'1 1/2" x 2'1 1/2"	19'5 1/8"	17-H-443#	14-1/4" x 22'6"
C27	2'1 1/2" x 2'1 1/2"	19'5 1/8"	17-H-443#	14-1/4" x 24'9"
C28	2'0" x 2'0"	18'8 3/4"	17-H-440#	14-1/4" x 24'6"
C29	2'0" x 2'0"	18'8 3/4"	17-H-440#	14-1/4" x 22'3"
C45	2'0" x 2'0"	17'1 3/8"	15-H-440#	14-1/4" x 21'9"
C46	2'0" x 2'0"	15'11 1/2"	14-H-440#	14-1/4" x 21'9"
C47	2'1 1/2" x 2'1 1/2"	17'1 3/8"	15-H-443#	14-1/4" x 21'9"
C48	2'1 1/2" x 2'1 1/2"	16'5 3/8"	15-H-443#	14-1/4" x 21'9"
C49	2'1 1/2" x 2'1 1/2"	16'5 3/8"	14-H-443#	14-1/4" x 22'6"
C50	2'1 1/2" x 2'1 1/2"	17'0 3/8"	15-H-443#	14-1/4" x 22'3"
C51	2'1 1/2" x 2'1 1/2"	17'5 1/2"	15-H-443#	14-1/4" x 22'0"
C52	2'1 1/2" x 2'1 1/2"	18'8 3/8"	17-H-443#	14-1/4" x 24'3"


NO.	SIZE	LENGTH	STIRRUPS	TOP STEEL	BOTTOM STEEL	SIDE STEEL
S-1-A	2'3" x 2'6"	28'4 1/2"	22-5-447#	5-L-820#	5-L-820#	8-L-1025#
S-2-A	2'0" x 2'0"	28'5 1/2"	22-5-446#	5-L-820#	5-L-820#	4-1" x 31'6"
S-3-A	"	28'6"	22-5-446#	5-L-820#	5-L-820#	4-1" x 31'6"
S-4-A	"	28'7 1/2"	23-5-446#	5-L-820#	5-L-820#	4-1" x 31'6"
S-5-A	"	28'10 1/2"	23-5-446#	5-L-820#	5-L-820#	4-1" x 31'6"
S-6-A	"	29'1 1/2"	23-5-446#	5-L-821#	5-L-821#	4-1" x 32'3"
S-7-A	"	29'6"	23-5-446#	5-L-821#	5-L-821#	4-1" x 32'3"
S-8-A	"	32'3 1/2"	26-5-446#	5-L-822#	5-L-822#	4-1" x 34'6"
S-9-A	"	32'11 1/2"	26-5-446#	5-L-823#	5-L-823#	4-1" x 36'0"
S-10-A	"	33'6"	26-5-446#	5-L-824#	5-L-824#	4-1" x 36'6"
S-11-A	"	34'1 1/2"	27-5-446#	5-L-819#	5-L-819#	4-1" x 37'3"
S-12-A	"	33'7 1/2"	27-5-446#	5-L-824#	5-L-824#	4-1" x 36'6"
S-13-A	"	33'9 1/2"	26-5-446#	5-L-824#	5-L-824#	4-1" x 36'6"
S-14-A	"	32'11 1/2"	26-5-446#	5-L-823#	5-L-823#	4-1" x 36'0"
S-15-A	2'3" x 2'6"	33'0 1/2"	26-5-447#	5-L-823#	5-L-823#	8-L-1026#
S-1-B	"	34'0 1/2"	26-5-447#	5-1" x 38'0"	5-1" x 36'0"	8-1 1/2" x 36'0"
S-2-B	2'0" x 2'0"	34'1 1/2"	26-5-446#	5-1" x 38'0"	5-1" x 36'0"	4-1" x 36'0"
S-3-B	"	34'2 1/2"	26-5-446#	5-1" x 38'0"	5-1" x 36'0"	4-1" x 36'0"
S-4-B	"	34'3 1/2"	26-5-446#	5-1" x 38'0"	5-1" x 36'0"	4-1" x 36'0"
S-5-B	"	34'4 1/2"	26-5-446#	5-1" x 38'0"	5-1" x 36'0"	4-1" x 36'0"
S-6-B	"	34'6 1/2"	27-5-446#	5-1" x 38'0"	5-1" x 36'0"	4-1" x 36'0"
S-7-B	"	34'7 1/2"	27-5-446#	5-1" x 38'0"	5-1" x 36'0"	4-1" x 36'0"
S-8-B	"	37'6 1/2"	29-5-446#	5-L-816#	5-1" x 39'6"	4-1" x 39'6"
S-9-B	"	37'11 1/2"	29-5-446#	5-1" x 39'6"	5-1" x 39'6"	4-1" x 39'6"
S-10-B	"	37'11 1/2"	29-5-446#	5-1" x 38'0"	5-1" x 36'0"	4-1" x 39'6"
S-11-B	"	37'4"	29-5-446#	5-1" x 41'6"	5-1" x 39'6"	4-1" x 39'6"
S-12-B	"	37'4"	29-5-446#	5-1" x 41'6"	5-1" x 39'6"	4-1" x 39'6"
S-13-B	"	37'11 1/2"	28-5-446#	5-1" x 41'6"	5-1" x 39'6"	4-1" x 39'6"
S-14-B	"	37'11 1/2"	28-5-446#	5-1" x 41'6"	5-1" x 39'6"	4-1" x 39'6"
S-15-B	2'3" x 2'6"	37'0 1/2"	28-5-447#	5-1" x 41'6"	5-1" x 39'6"	8-1 1/2" x 39'6"
S-1-C	"	16'9 1/2"	12-5-447#	5-1" x 21'0"	5-1" x 19'0"	8-1 1/2" x 19'0"
S-2-C	2'0" x 2'0"	16'9 1/2"	12-5-446#	5-1" x 21'0"	5-1" x 19'0"	4-1" x 19'0"
S-3-C	"	16'10 1/2"	12-5-446#	5-1" x 21'0"	5-1" x 19'0"	4-1" x 19'0"
S-4-C	"	16'11 1/2"	12-5-446#	5-1" x 21'0"	5-1" x 19'0"	4-1" x 19'0"
S-5-C	"	17'0 1/2"	12-5-446#	5-1" x 21'0"	5-1" x 19'0"	4-1" x 19'0"
S-6-C	"	17'4 1/2"	13-5-446#	5-1" x 21'0"	5-1" x 19'0"	4-1" x 19'0"
S-7-C	"	17'2 1/2"	13-5-446#	5-L-813#	5-1" x 19'0"	4-1" x 19'0"

NO.	SIZE	LENGTH	STIRRUPS	TOP STEEL	BOTTOM STEEL	SIDE STEEL
S-10-C	2'0" x 2'6"	18'8 1/2"	14-5-446#	5-1" x 22'9"	5-1" x 20'9"	4-1" x 20'9"
S-11-C	"	18'8 1/2"	14-5-446#	5-1" x 22'9"	5-1" x 20'9"	4-1" x 20'9"
S-12-C	"	18'8 1/2"	14-5-446#	5-1" x 22'9"	5-1" x 20'9"	4-1" x 20'9"
S-13-C	"	18'10 1/2"	14-5-446#	5-1" x 22'9"	5-1" x 20'9"	4-1" x 20'9"
S-14-C	"	18'10 1/2"	14-5-446#	5-1" x 22'9"	5-1" x 20'9"	4-1" x 20'9"
S-15-C	2'3" x 2'6"	18'9 1/2"	14-5-447#	5-1" x 22'9"	5-1" x 20'9"	8-1 1/2" x 20'9"
S-1-D	"	30'4 1/2"	23-5-447#	5-1" x 34'9"	5-1" x 32'9"	8-1 1/2" x 32'9"
S-2-D	2'0" x 2'6"	30'6 1/2"	23-5-446#	5-1" x 34'9"	5-1" x 32'9"	4-1" x 32'9"
S-3-D	"	30'8 1/2"	23-5-446#	5-1" x 34'9"	5-1" x 32'9"	4-1" x 32'9"
S-4-D	"	31'0 1/2"	24-5-446#	5-1" x 34'9"	5-1" x 32'9"	4-1" x 32'9"
S-5-D	"	31'1 1/2"	24-5-446#	5-1" x 34'9"	5-1" x 32'9"	4-1" x 32'9"
S-6-D	"	31'2 1/2"	24-5-446#	5-1" x 34'9"	5-1" x 32'9"	4-1" x 32'9"
S-10-D	"	33'9 1/2"	26-5-446#	5-L-819#	5-1" x 36'0"	4-1" x 36'0"
S-11-D	"	34'0 1/2"	26-5-446#	5-1" x 38'0"	5-1" x 36'0"	4-1" x 36'0"
S-12-D	"	34'1 1/2"	26-5-446#	5-1" x 38'0"	5-1" x 36'0"	4-1" x 36'0"
S-13-D	"	34'1 1/2"	27-5-446#	5-1" x 38'0"	5-1" x 36'0"	4-1" x 36'0"
S-14-D	"	34'3 1/2"	26-5-446#	5-1" x 38'0"	5-1" x 36'0"	4-1" x 36'0"
S-15-D	2'3" x 2'6"	34'0 1/2"	26-5-447#	5-1" x 38'0"	5-1" x 36'0"	8-1 1/2" x 36'0"


Issue No A June 20, 1927.
REVISIONS:
 Issue No B Nov. 10, 1927.
 Checked and Drawing Traced.
 Issue No 1 Nov. 30, 1927.
 Signed By Chief Engineer.
 Issue No 2 Jan. 24, 1928.
 Approved By Heads of Departments.
 Issue No 3 April 24, 1928.
 Approved by the City.
 Issue No 4 Sept. 1, 1933.
 Plan Corrected to Conform to Structure as Built.

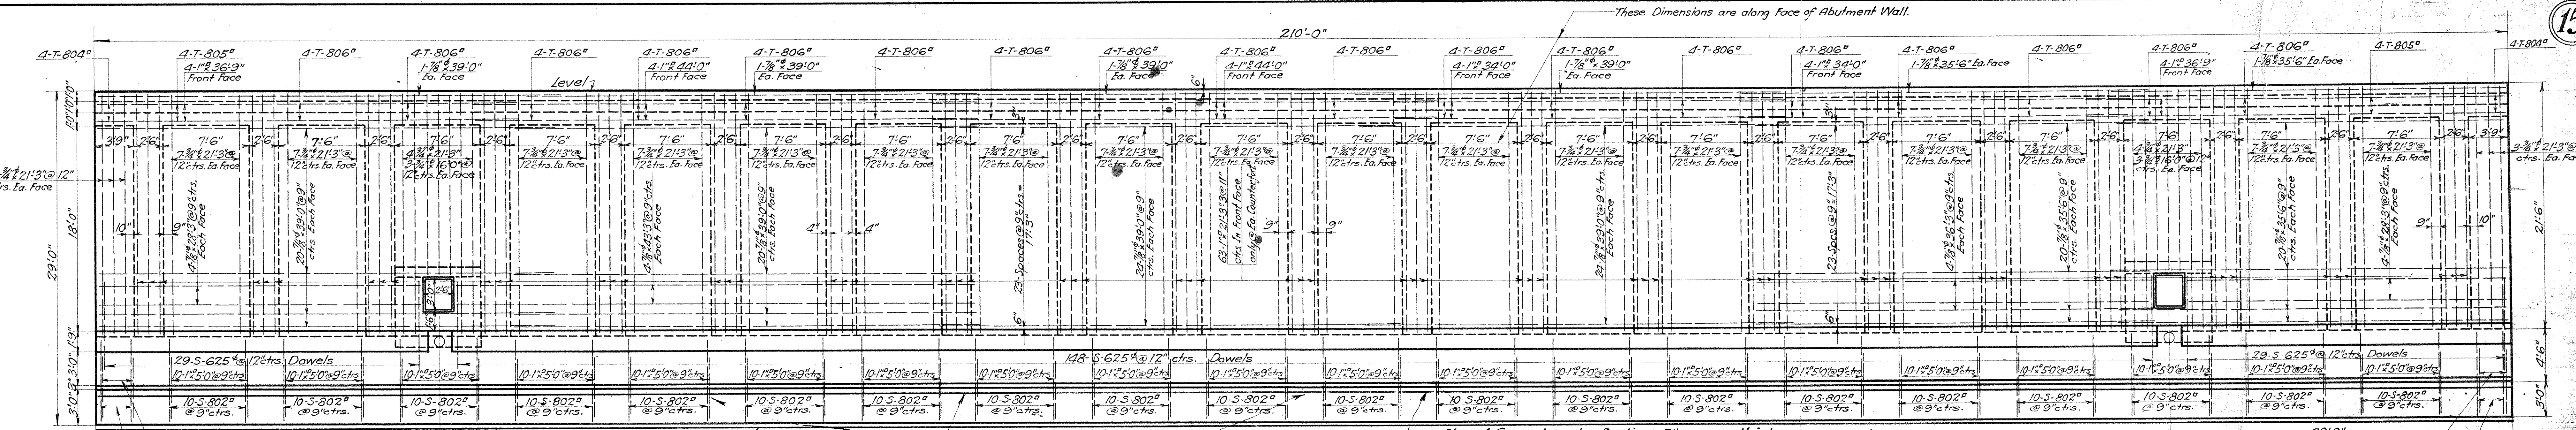


ELEVATION
 Scale: $\frac{3}{8} = 1'-0''$
 Showing Wall Reinforcement & Dowels

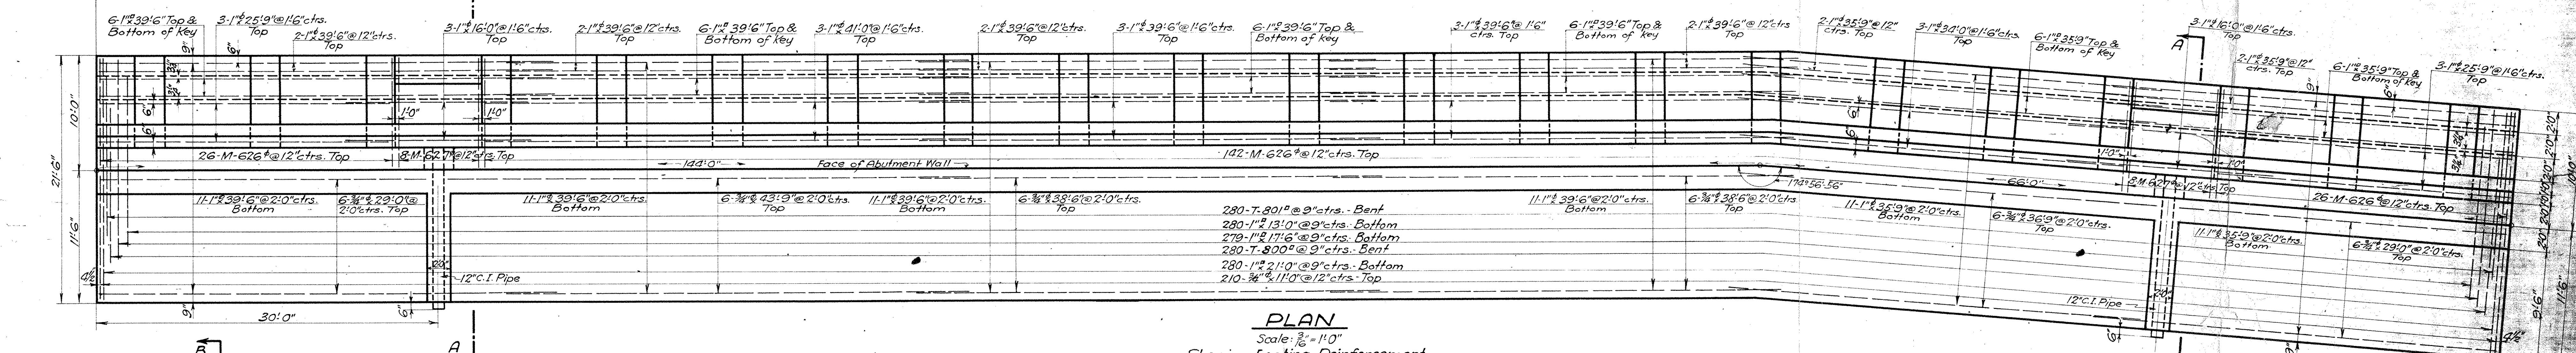


PLAN
 Scale: $\frac{3}{8} = 1'-0''$
 Showing Footing Reinforcement

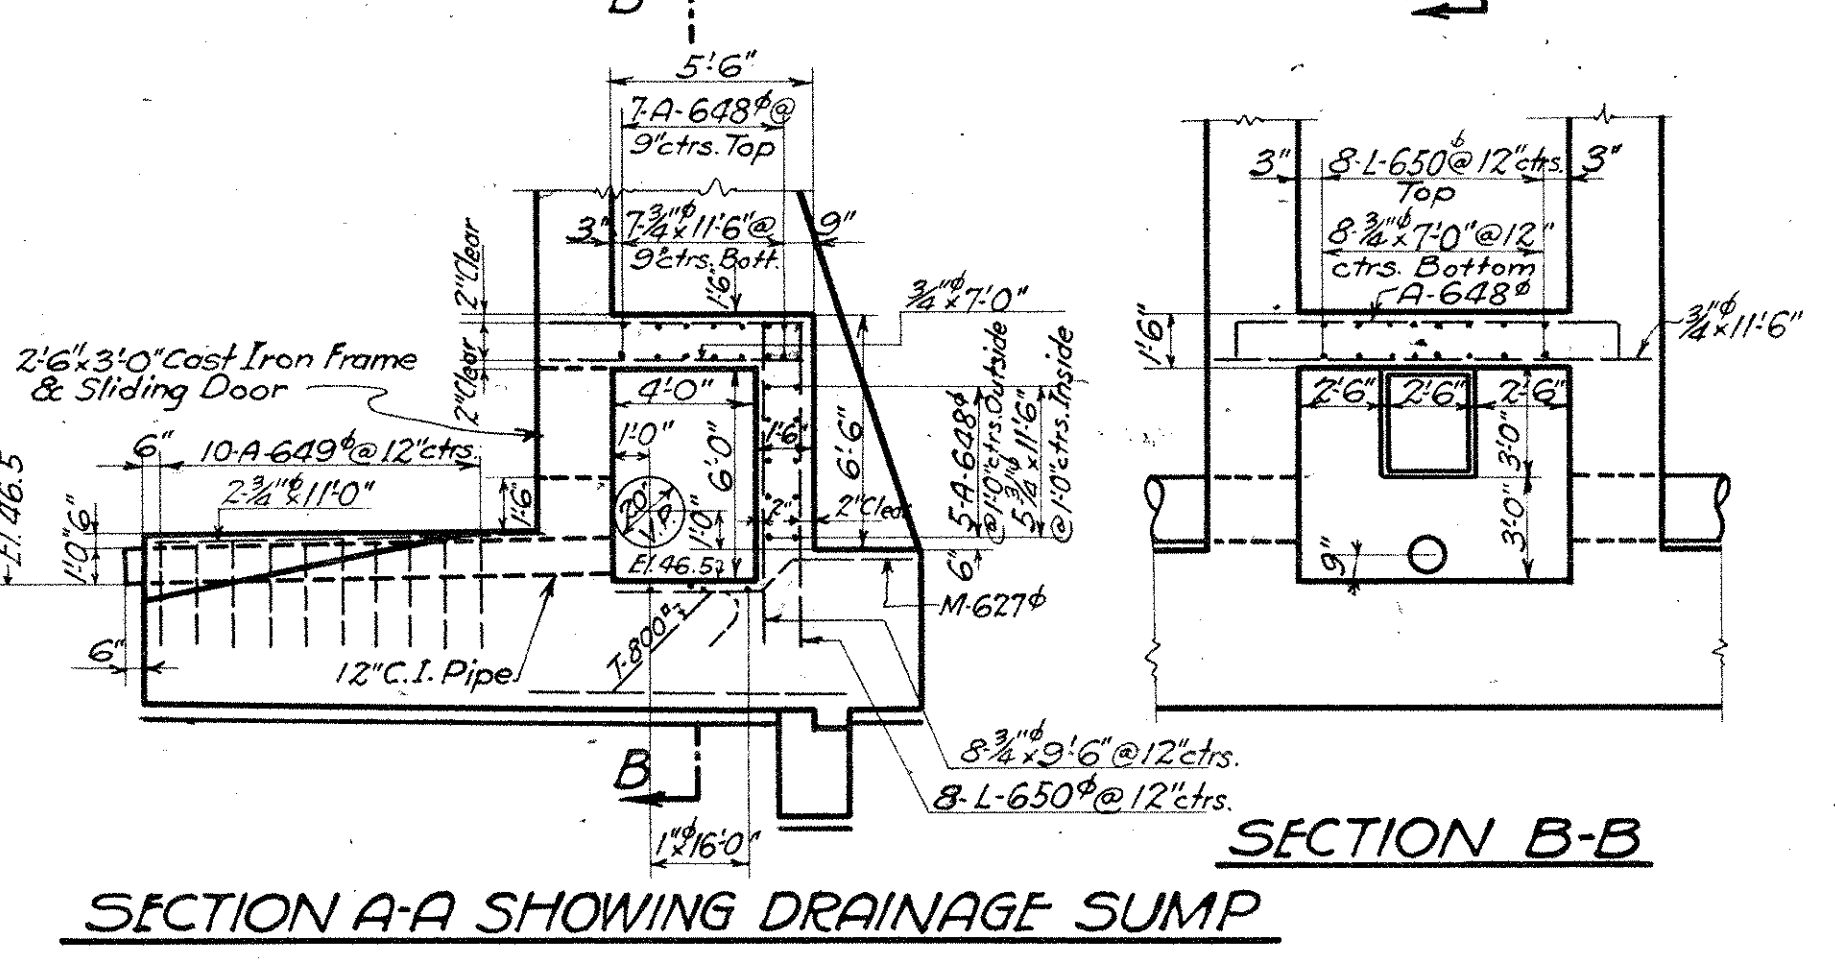


SECTION A-A SHOWING DRAINAGE SUMP
 Scale: $\frac{3}{8} = 1'-0''$

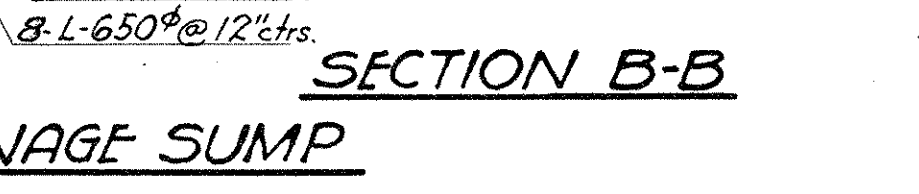


SECTION B-B
 Scale: $\frac{3}{8} = 1'-0''$

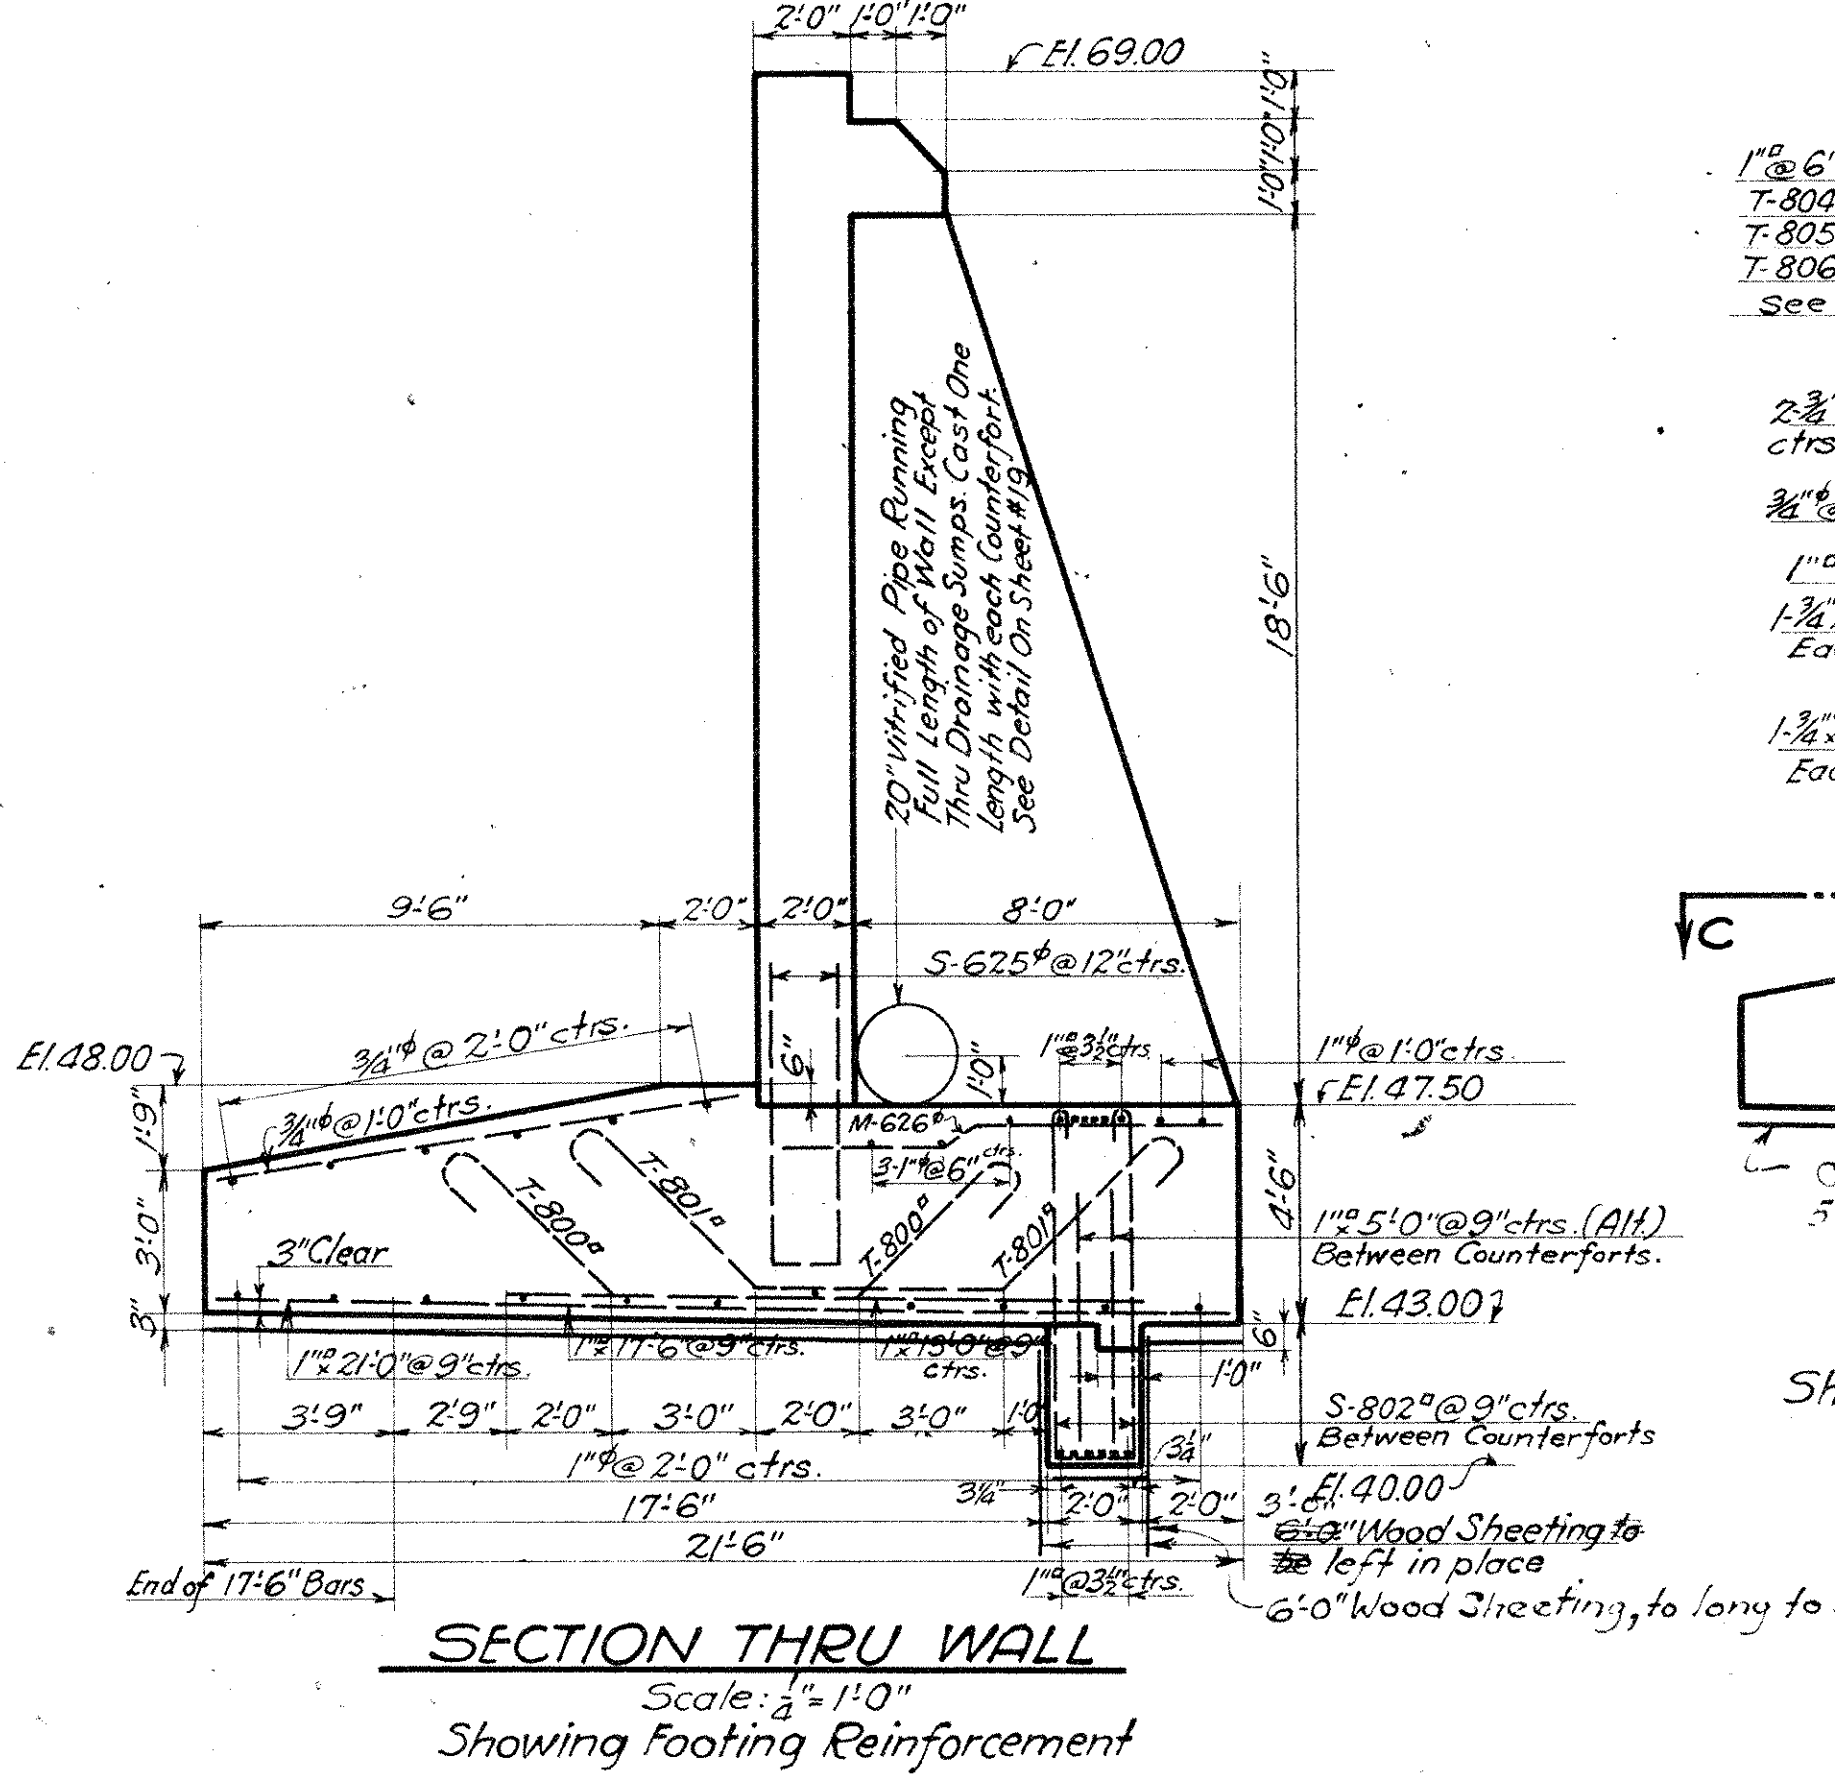


SECTION THRU WALL
 Scale: $\frac{3}{8} = 1'-0''$
 Showing Wall & Counterfort Reinforcement

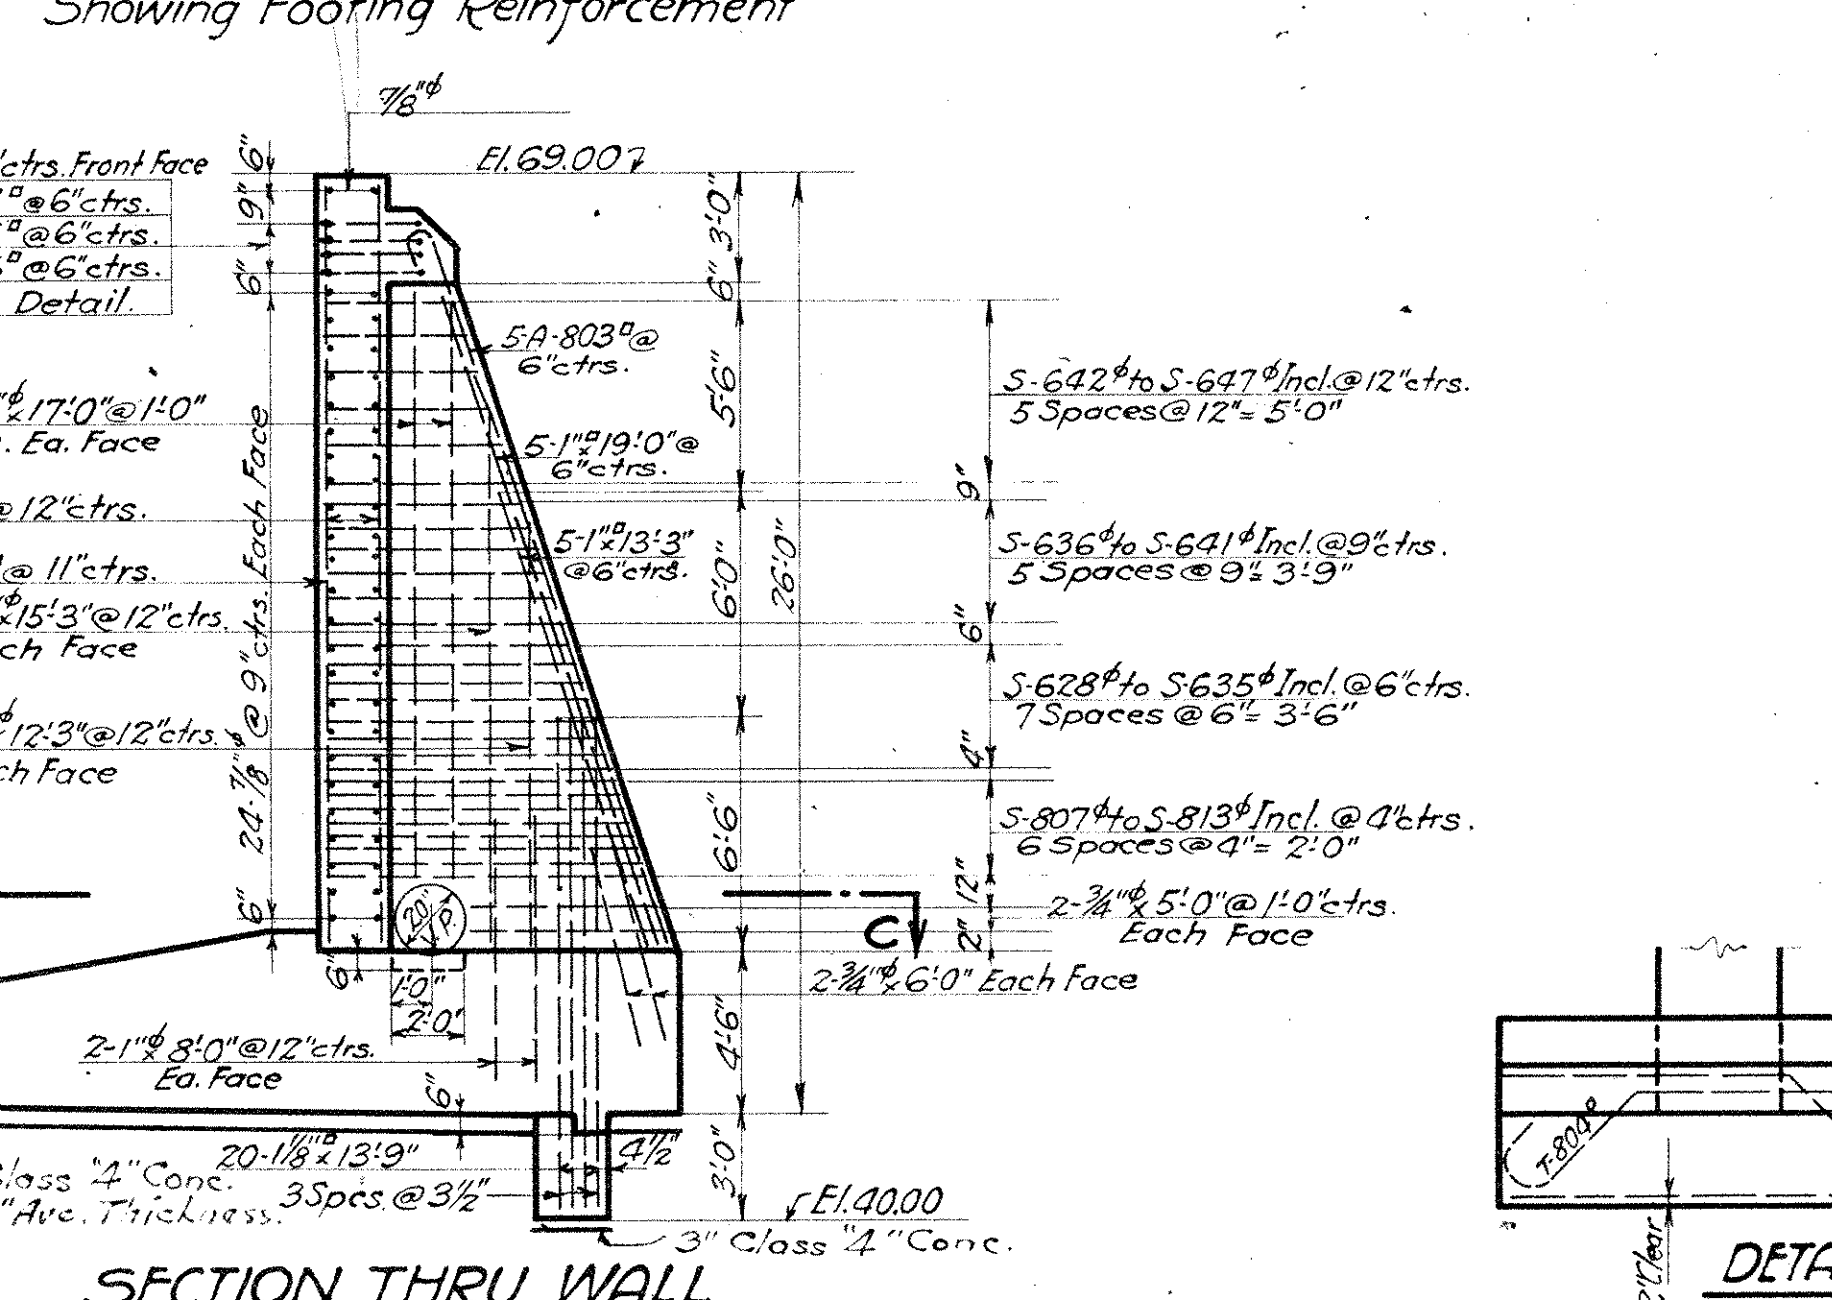


SECTION THRU WALL
 Scale: $\frac{3}{8} = 1'-0''$
 Showing Wall & Counterfort Reinforcement

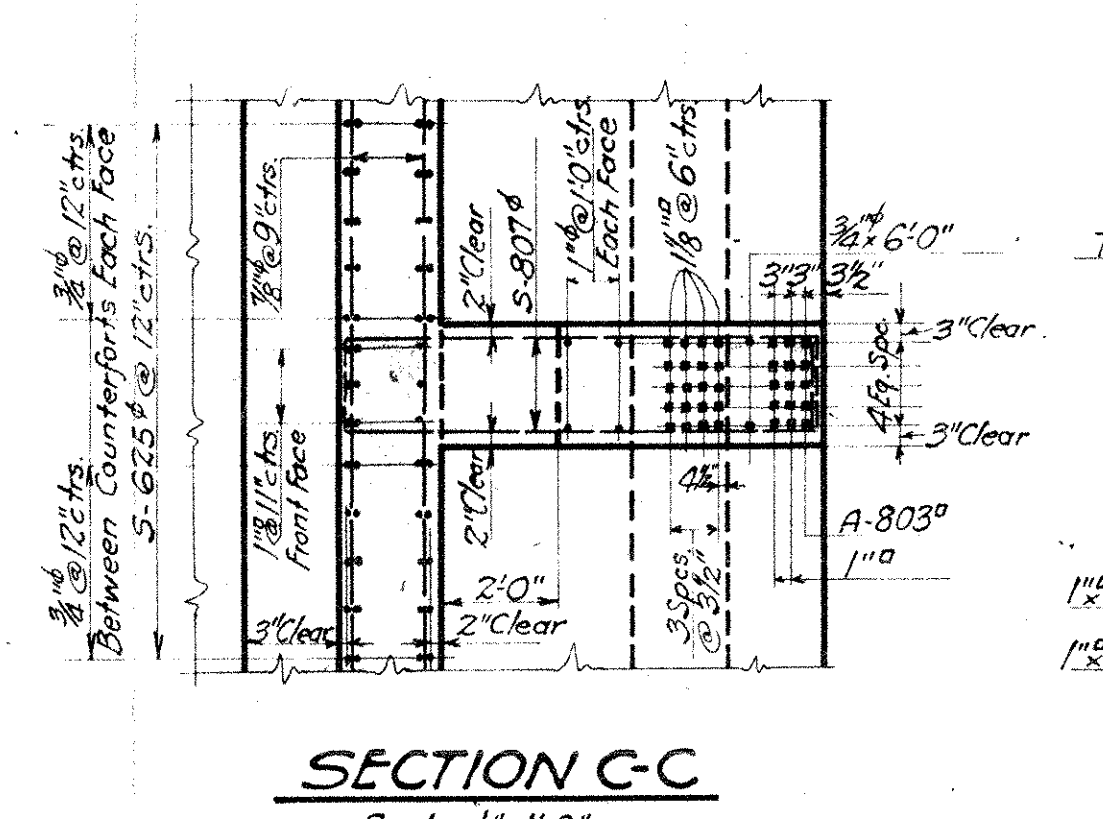

SECTION C-C
 Scale: $\frac{3}{8} = 1'-0''$

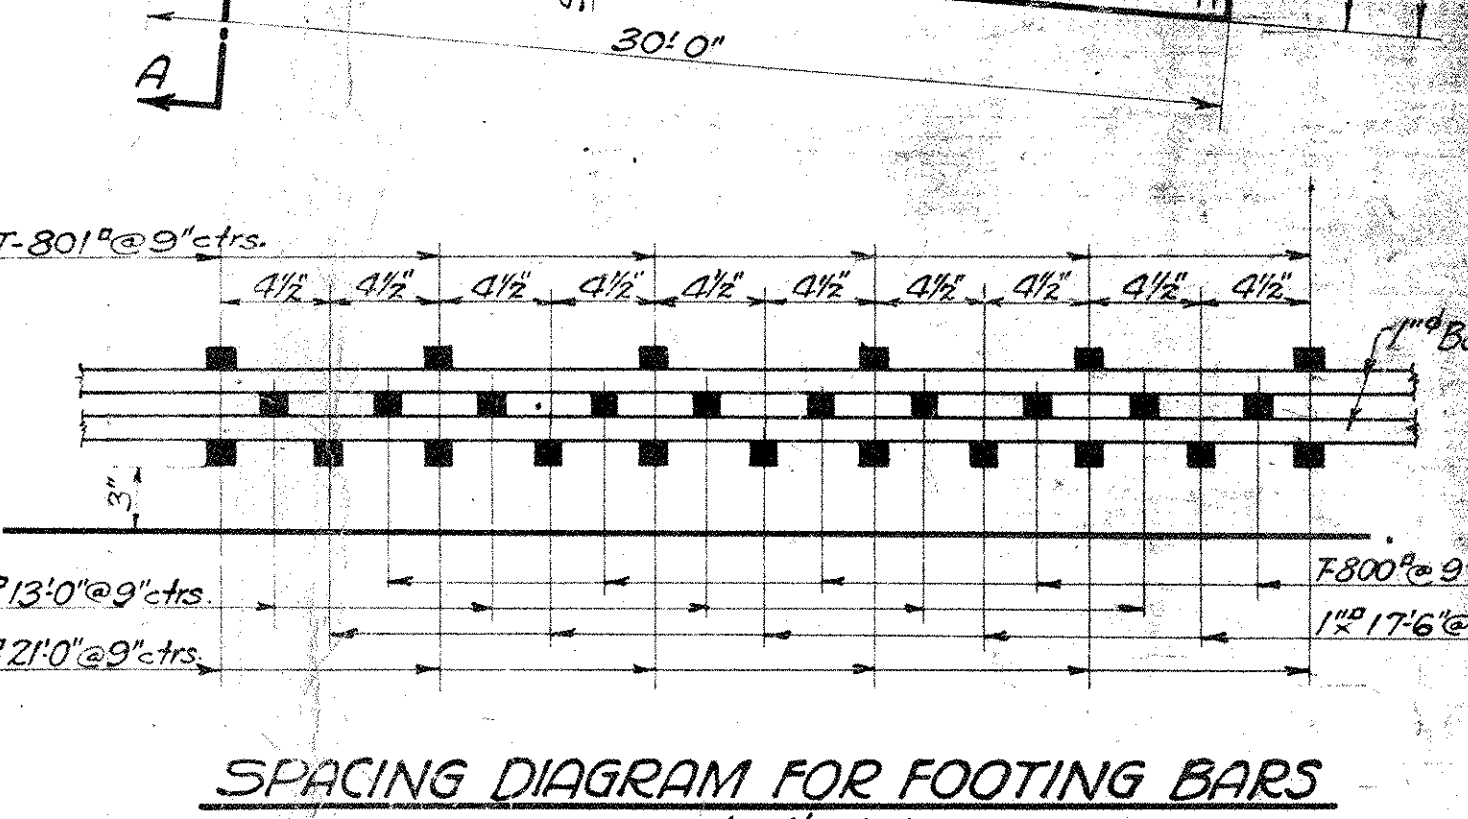

SPACING DIAGRAM FOR FOOTING BARS
 Scale: $\frac{1}{2} = 1'-0''$

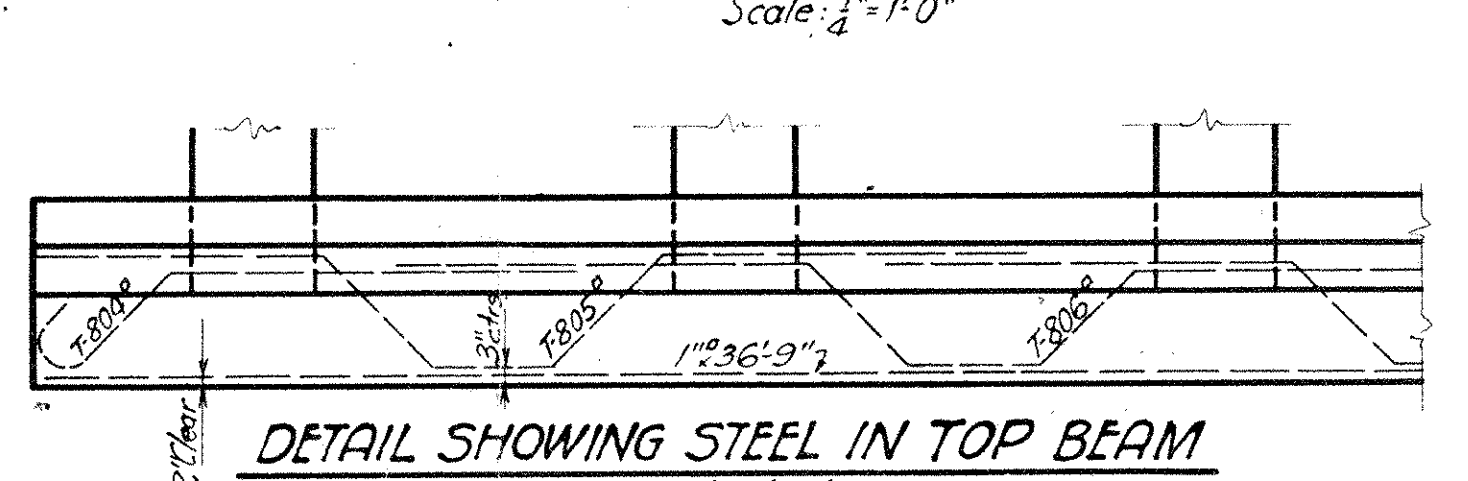

DETAIL SHOWING STEEL IN TOP BEAM
 Scale: $\frac{3}{8} = 1'-0''$

WE HEREBY CERTIFY THAT THIS PLAN SHOWS THE STRUCTURE AS BUILT.
 E. J. ...
 ENGINEER OF STRUCTURES
 ASST. ENGINEER OF CONSTRUCTION

Designed By G.T.C. June 20, 1927.
 Detailed By L.C.B. June 20, 1927.
 Traced By S.H. Nov. 10, 1927.
 Checked By J.H.C. Nov. 3, 1927.
 Correct Nov. 30, 1927.
 Designing Engineer

Approved ...
 Engineer of Structures
 Approved ...
 Principal Assistant Engineer
 Approved ...
 Assistant Electrical Engineer
 Approved ...
 Engineer of Construction

USE THIS DETAIL AT BOTH ENDS OF WALL
 Scale: $\frac{1}{2} = 1'-0''$

Plan Approved
 CITY OF CLEVELAND
 By ROBERT HOFFMANN
 Commissioner of Engineering & Construction
 Date 4-13-28

THE CLEVELAND UNION TERMINALS CO.
CENTRAL AVE. BRIDGE
 PLAN AND DETAILS
 SOUTH ABUTMENT
 CLEVELAND, OHIO
 OFFICE OF ENGINEERS OF STRUCTURES
 SCALE: AS SHOWN DATE: 6-20-1927
 ISSUE NO. 4 REVISED 7-1-33
 See Blue Print Filed under No. 113-0655
 ENGINEER

Issue No A Oct. 14, 1927.

REVISIONS:


Issue No B Nov. 7, 1927.
Checked and Drawing Traced.

Issue No 1 Nov. 30, 1927.
Signed By Chief Engineer.


Issue No 2 Jan. 24, 1928.
Approved By Heads of Departments.

Issue No 3 April 24, 1928.
Approved by the City.


Issue No 4 Sep. 1, 1933.
Plan Corrected to Conform to
Structure as Built.

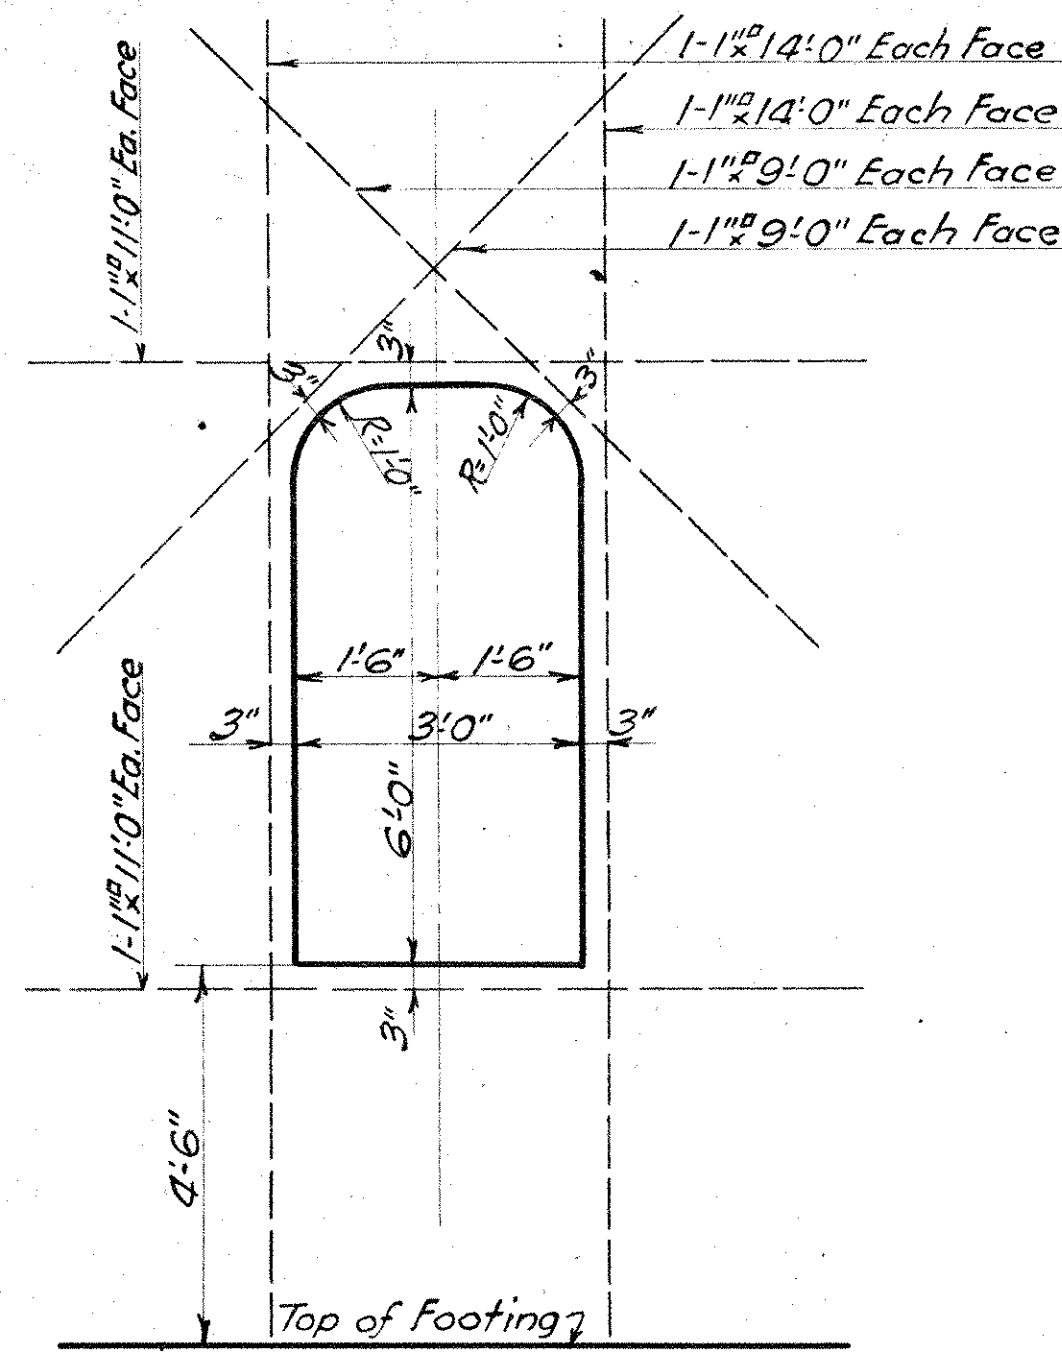


DETAIL OF REFUGE OPENING
Scale: 1/2" = 1'-0"

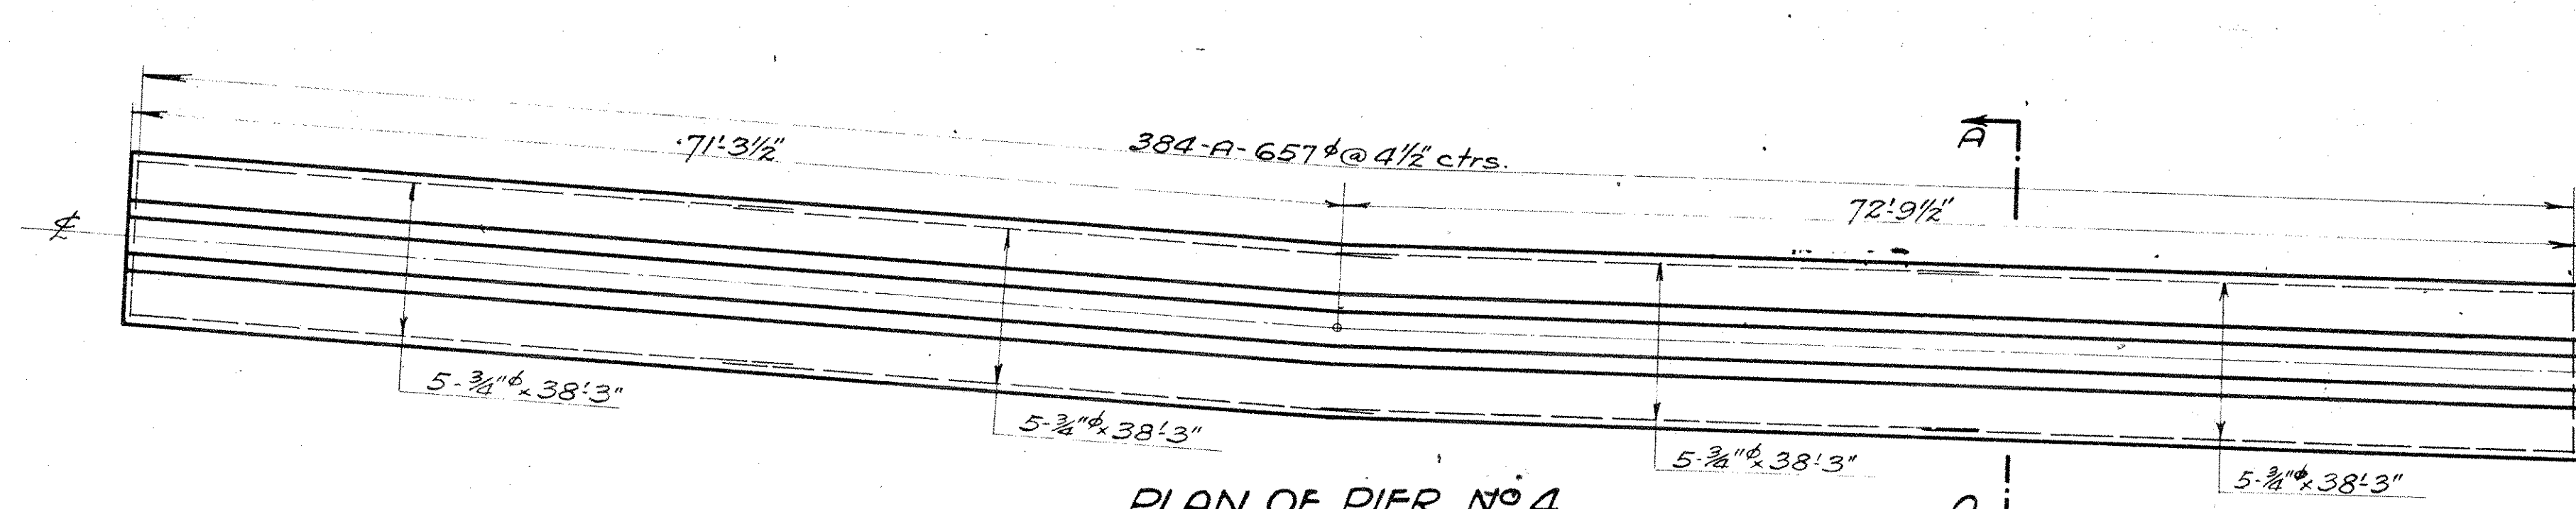


PLAN OF PIER No 4
Scale: 1/8" = 1'-0"

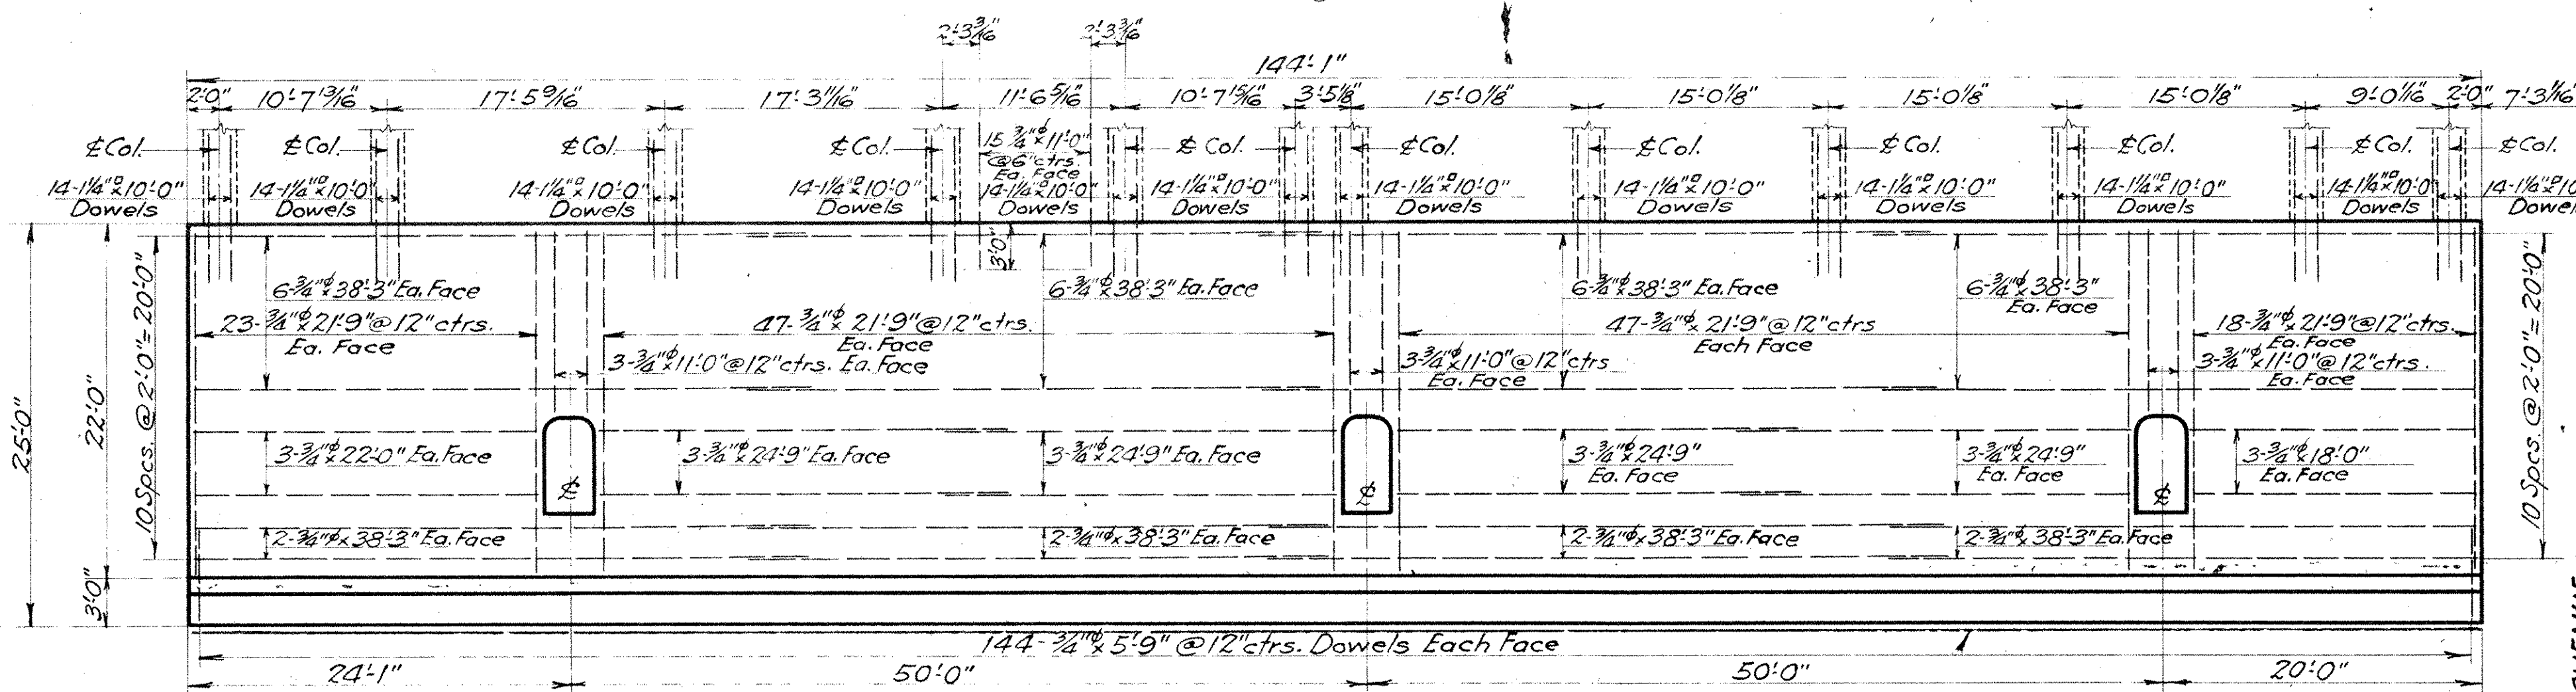


ELEVATION OF PIER No 4
Scale: 1/8" = 1'-0"

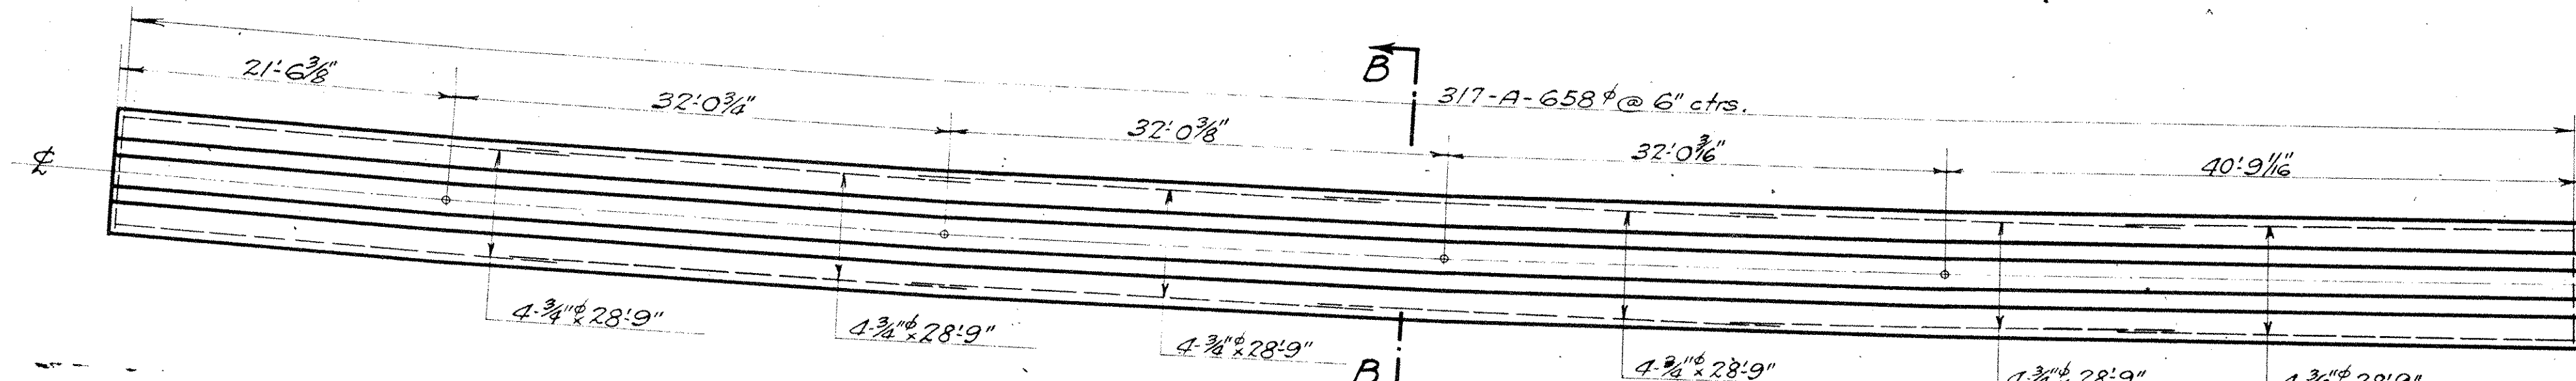


PLAN OF PIER No 3
Scale: 1/8" = 1'-0"

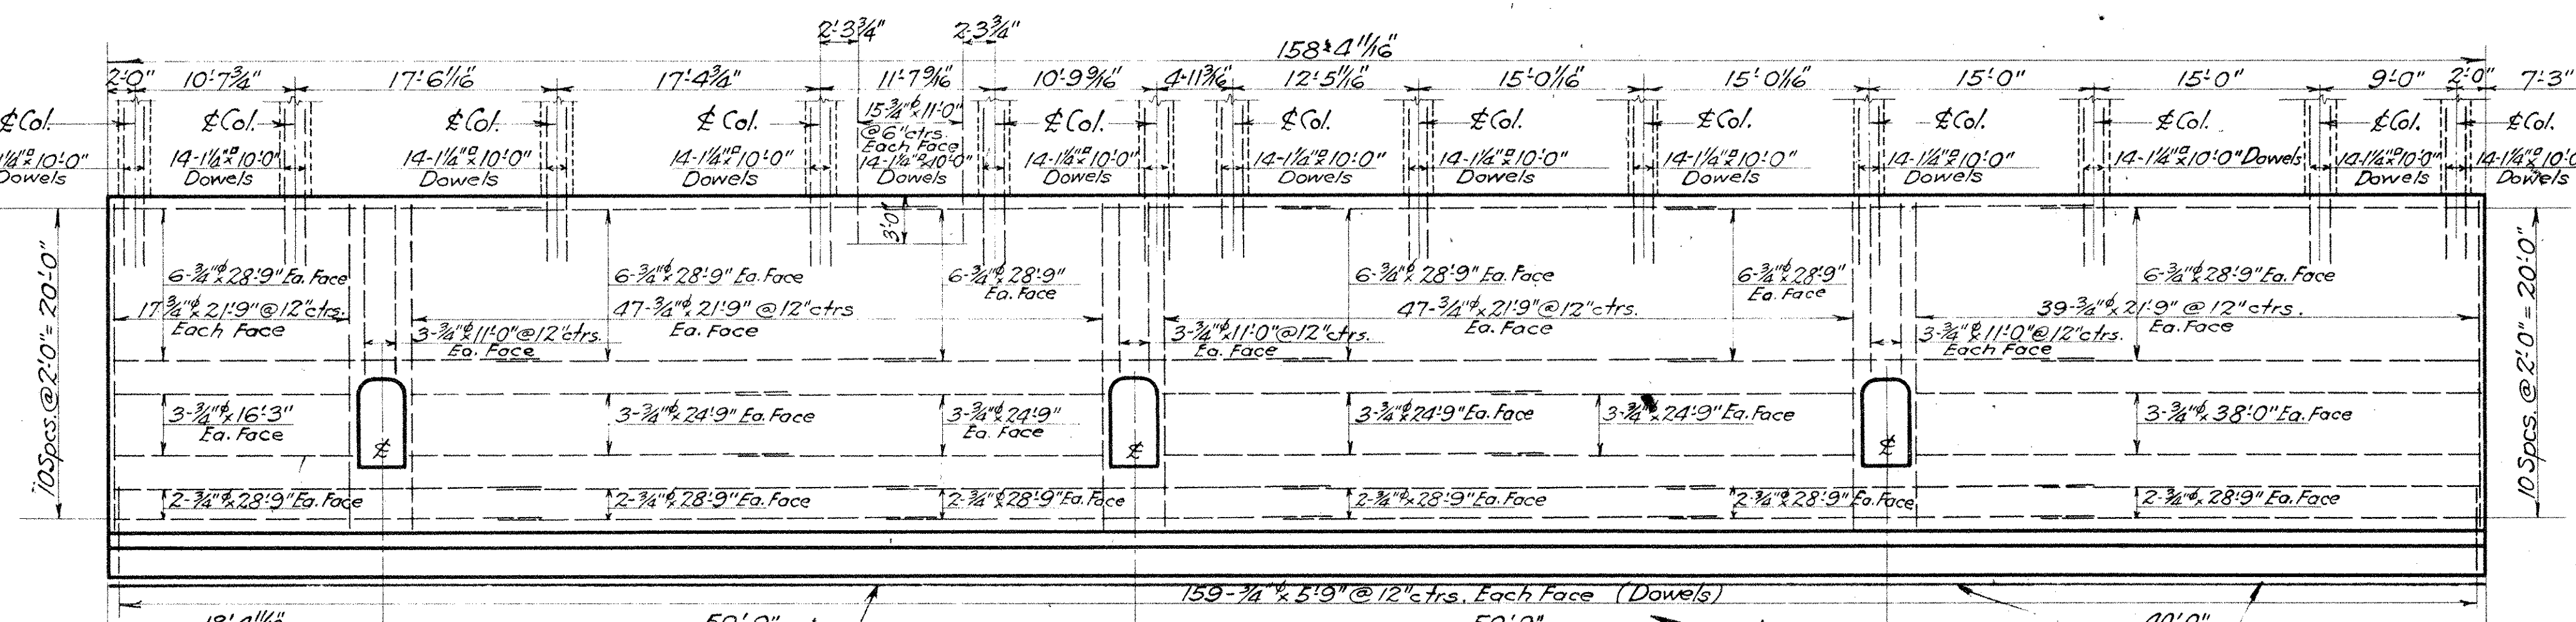

ELEVATION OF PIER No 3
Scale: 1/8" = 1'-0"

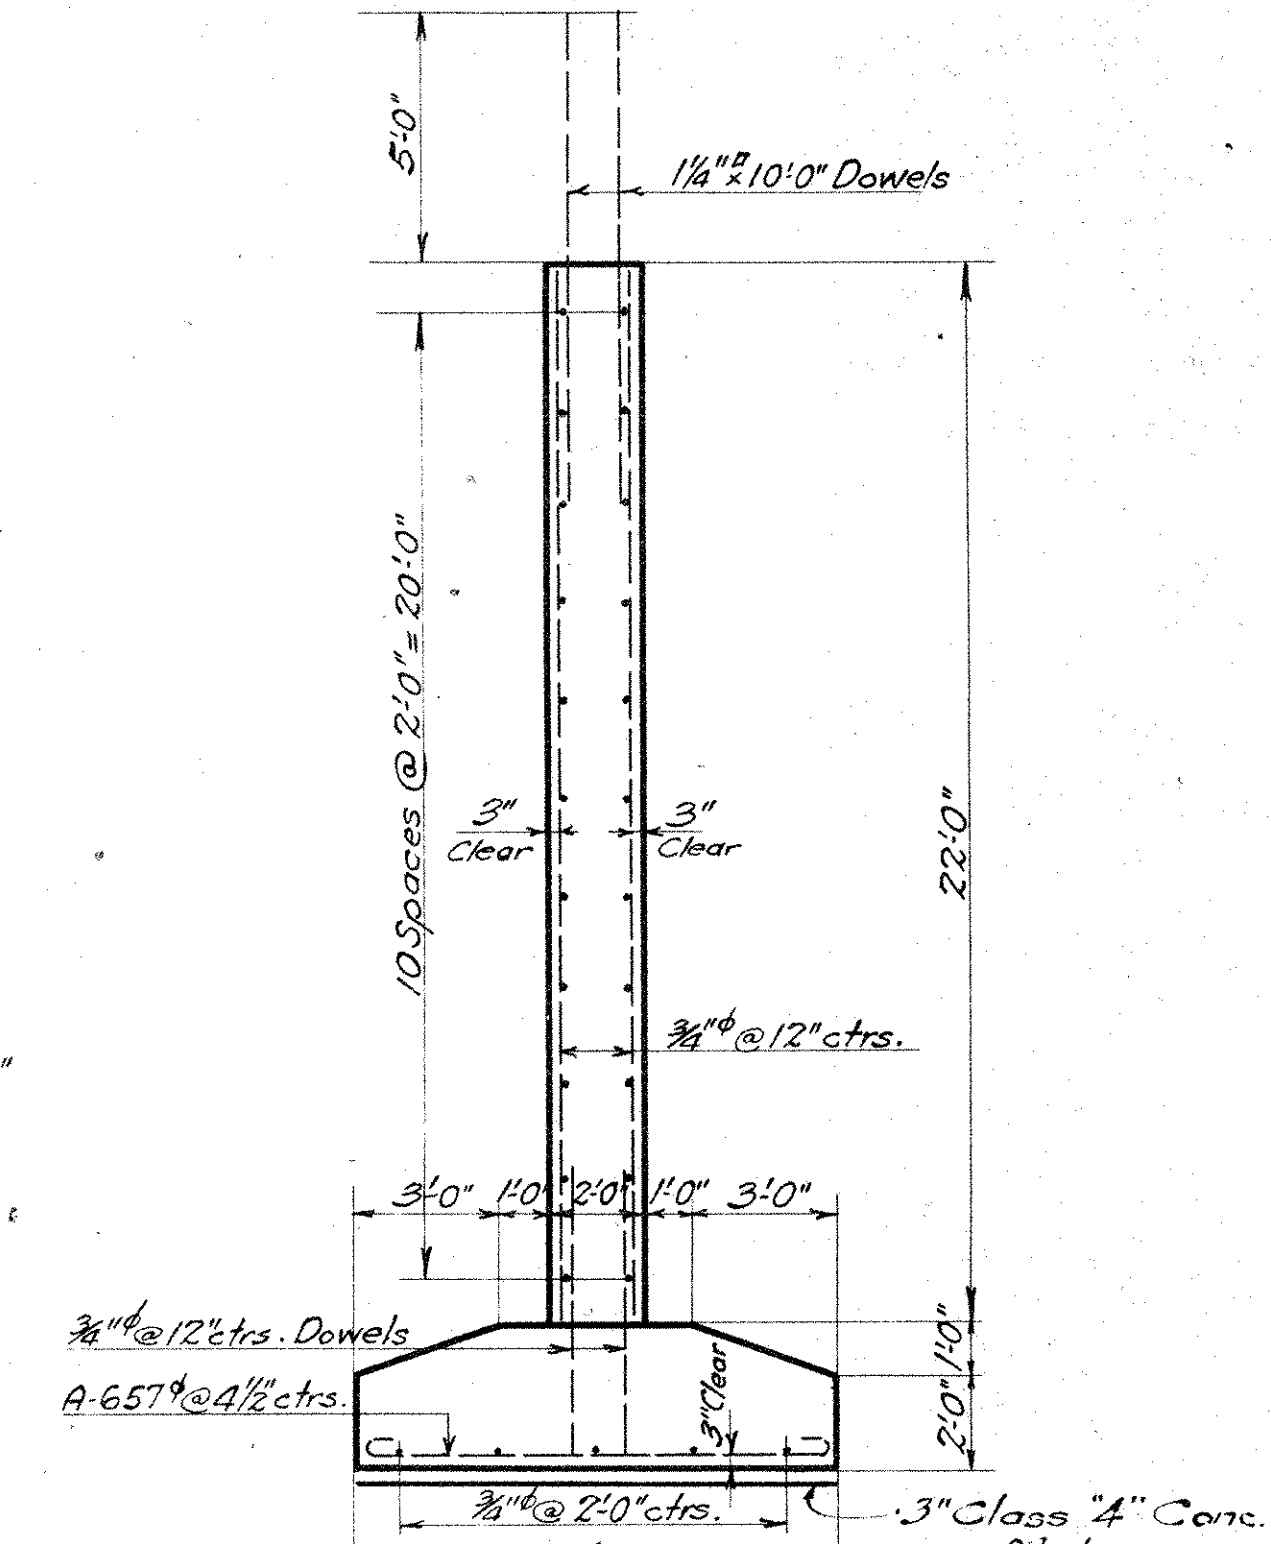

SECTION A-A
Scale: 1/4" = 1'-0"

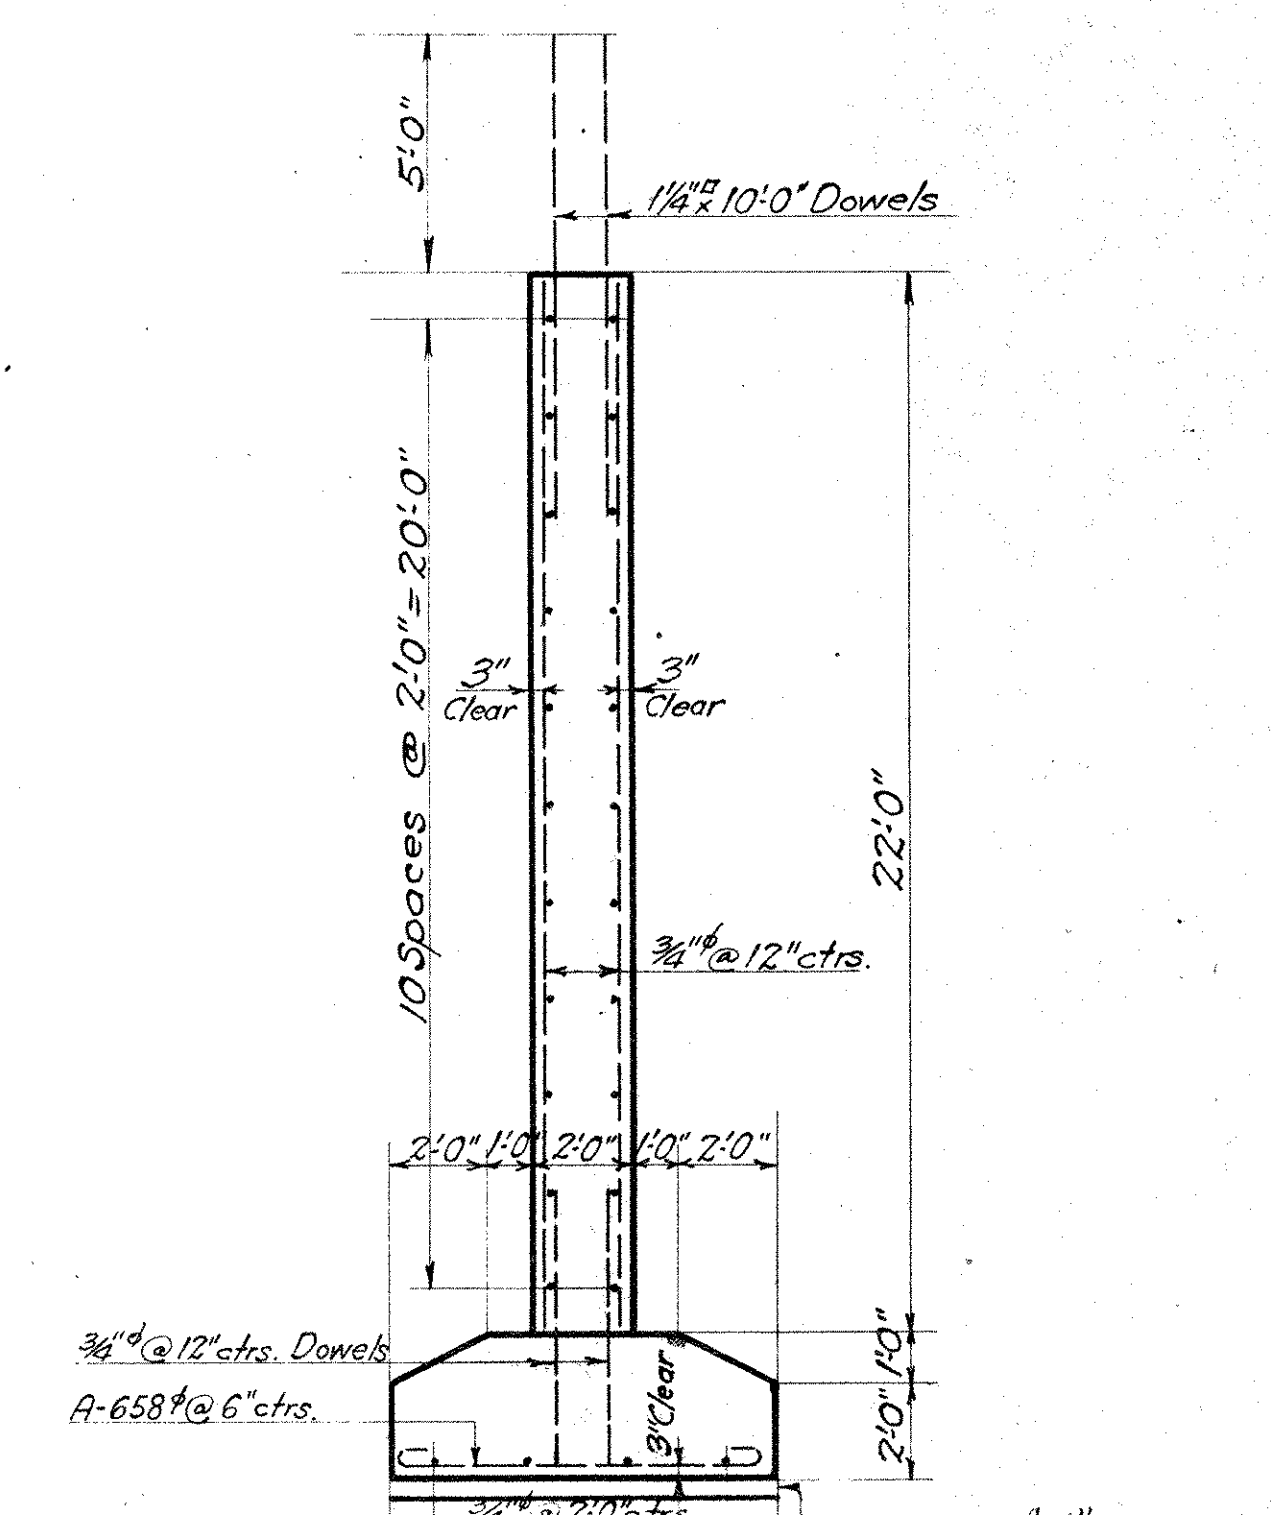

SECTION B-B
Scale: 1/4" = 1'-0"

WE HEREBY CERTIFY THAT THIS PLAN
SHOWS THE STRUCTURE AS BUILT.

E. V. Marsh 6/14/34
ENGINEER OF STRUCTURES

H. P. ... 4/24/35
ASST. ENGINEER OF CONSTRUCTION

Designed By G.T.C. 6-10-1927.
Detailed By G.T.C. 10-14-1927.
Traced By S.H. 11-7-1927.
Checked By J.H.C. 10-31-1927.
Correct No. 30, 1927.
A. L. ...
Designing Engineer


Approved *E. V. Marsh*
Engineer of Structures
Approved *J. W. ...*
Principal Assistant Engineer
Approved *W. ...*
Assistant Electrical Engineer
Approved *W. ...*
Engineer of Construction

Plan Approved
CITY OF CLEVELAND
By *ROBERT HOFFMANN*
Commissioner of Engineering & Construction
Date 4-13-28.
For Original of this Signature
See Blue Print Filed under No. 113-065-5.


THE CLEVELAND UNION TERMINALS CO.
CENTRAL AVE. BRIDGE
PLAN AND DETAILS OF
PIERS No 3 & 4
CLEVELAND, OHIO.
OFFICE OF ENGINEER OF STRUCTURES
SCALE: AS SHOWN
ISSUE No. 4
DATE 10-14-1927
REVISED 9-1-33.
E. V. Marsh 11/30/28
CHIEF ENGINEER 11/30/28

Issue No A Nov. 1, 1927.
 Revisions:-
 Issue No 1 Nov. 30, 1927.
 Approved by Chief Engineer.
 Issue No 2 Dec. 28, 1927.
 Drawing traced and checked.
 Issue No 3 Dec. 29, 1927.
 Signed by the Chief Engineer.
 Issue No 4 Jan. 24, 1928.
 Approved By Heads of Departments.
 Issue No 5 Feb. 13, 1928.
 Moved all Water Lines to West side of Bridge.
 Issue No 6 April 24, 1928.
 Revised details of water lines.
 Approved by the City.

Issue No 7 Sept. 1, 1933.
 Plan Conforms to Structure as Built.

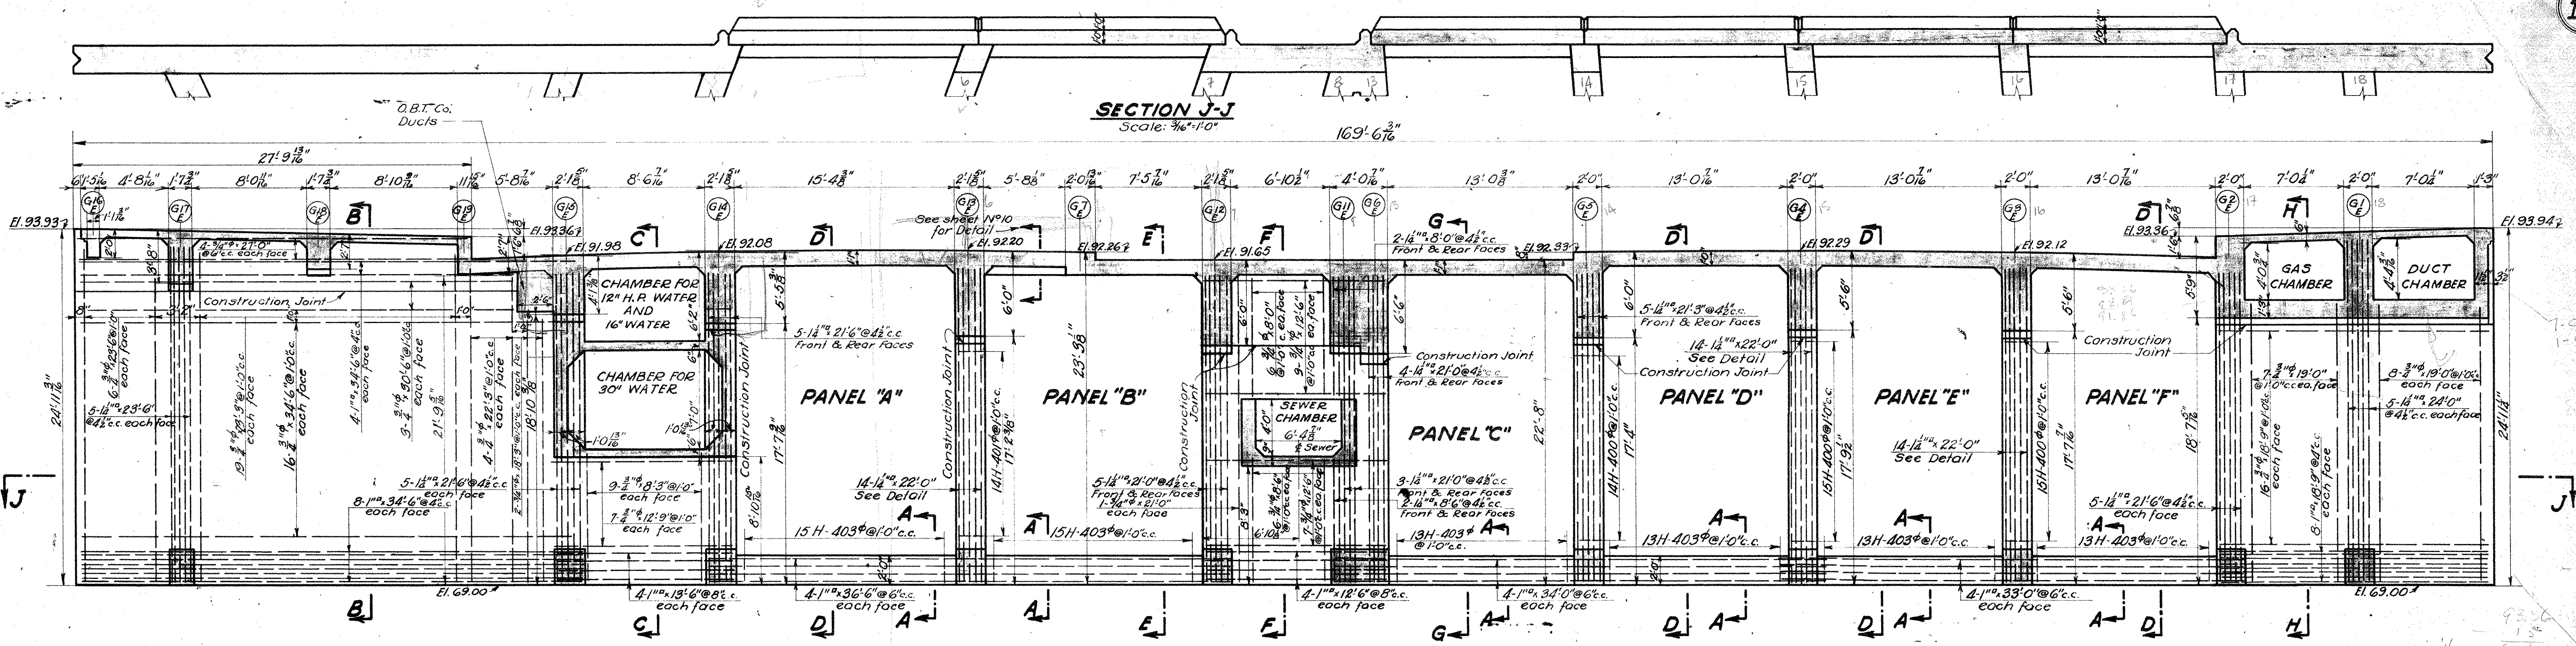

NOTE:-
 ALL DIMENSIONS TO BE MEASURED ALONG FACE OF WALL

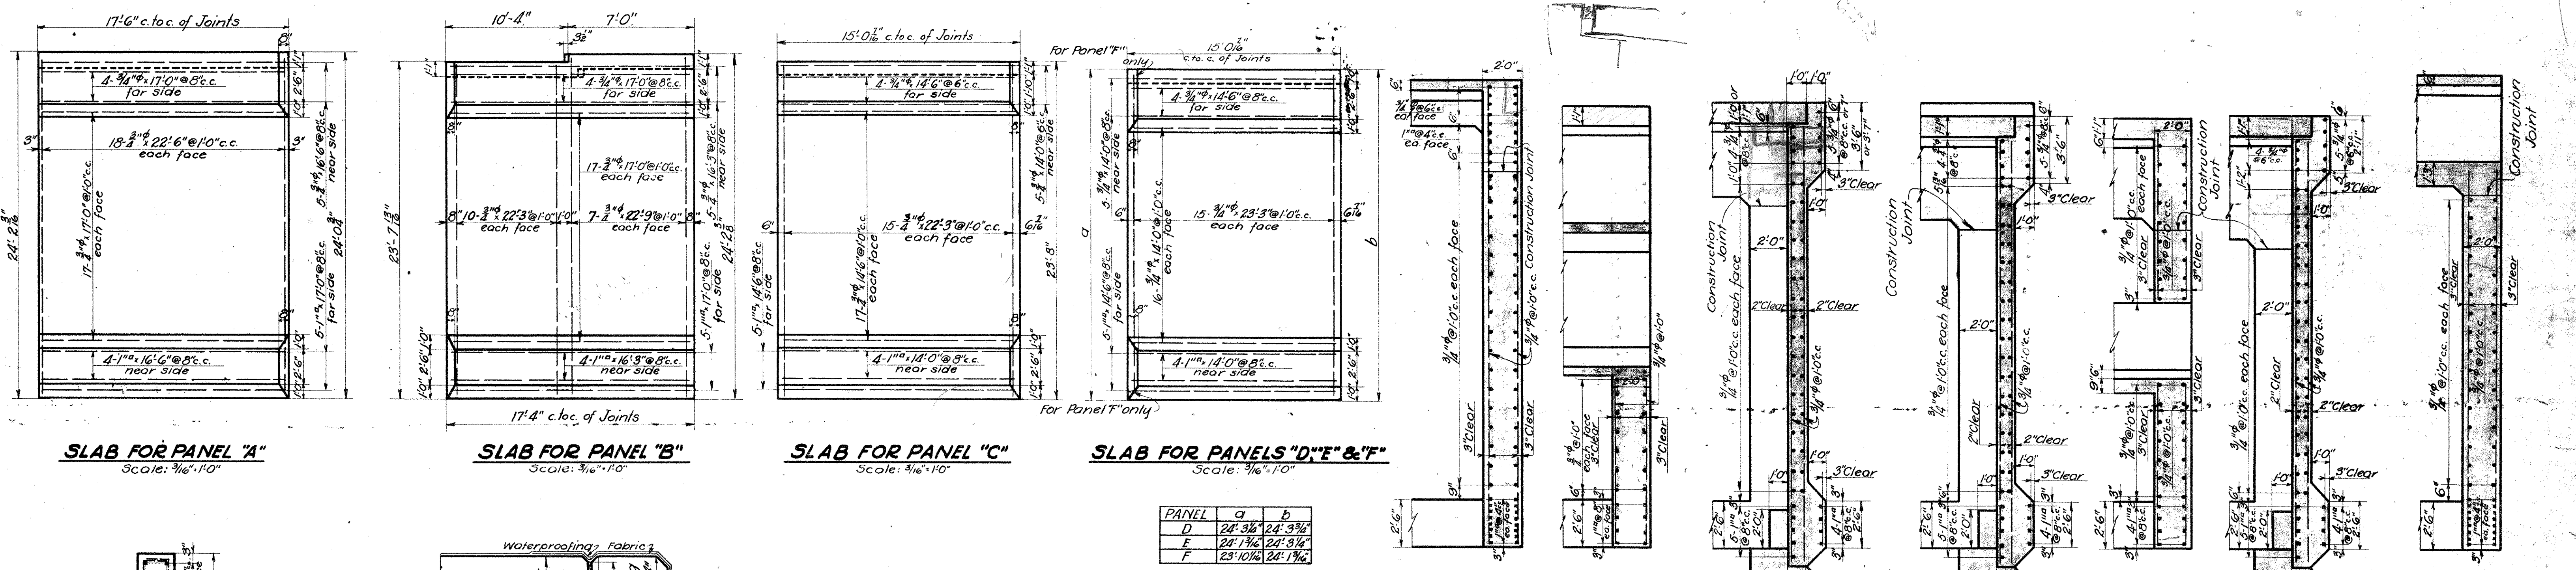

PANEL	a	b
D	27'-3 1/2"	24'-3 1/2"
E	27'-1 1/2"	24'-3 1/2"
F	23'-10 1/2"	24'-1 1/2"

WE HEREBY CERTIFY THAT THIS PLAN SHOWS THE STRUCTURE AS BUILT.

C. O. McEachron
 ENGINEER OF STRUCTURES

ASST. ENGINEER OF CONSTRUCTION

Designed By G.T.C. July 1, 1927.
 Detailed By H.B. Nov. 1, 1927.
 Traced By H.B. Dec. 28, 1927.
 Checked By J.H.C. Dec. 29, 1927.
 Correct Dec. 29, 1927.
H. L. Gorman
 Designing Engineer


Approved *C. O. McEachron*
 Engineer of Structures

Approved *W. J. Sadler*
 Principal Assistant Engineer

Approved *H. W. ...*
 Assistant Electrical Engineer


Approved *...*
 Engineer of Construction

JOINT BETWEEN REMOVABLE SLABS AND DECK SLAB
 Scale: 1"=1'-0"

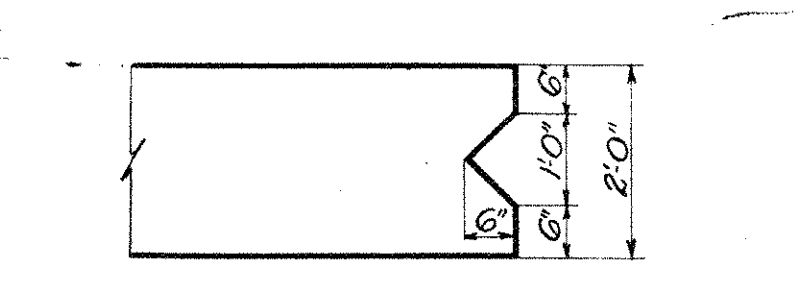


USE THIS DETAIL AT BOTH ENDS OF WALL
 Scale: 1/2"=1'-0"

SECTIONS SHOWING WATERPROOFING AROUND REMOVABLE SLABS
 Scale: 1/2"=1'-0"

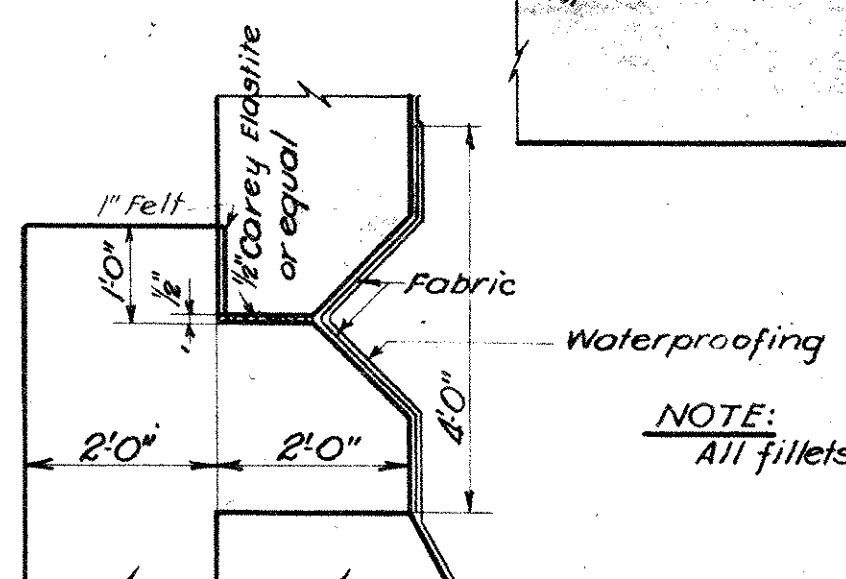

NOTE: For classes of Waterproofing see Specifications.

DETAIL OF REINFORCING STEEL IN COLUMNS AT WALL
 Scale: 1/2"=1'-0"

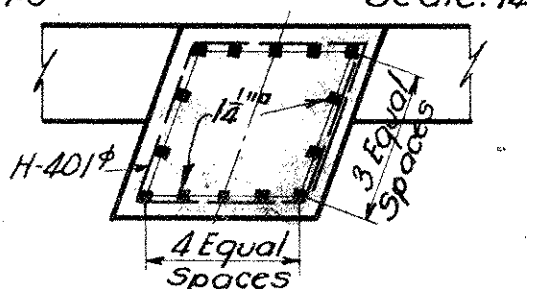

Note:- The ends of all service tunnels shall be bricked up after the utilities are in place.

Plan Approved
CITY OF CLEVELAND

By **ROBERT HOFFMANN**
 Commissioner of Engineering & Construction
 Date: 4-13-28

THE CLEVELAND UNION TERMINALS CO
CENTRAL AVE. BRIDGE
 ELEVATION AND DETAIL OF NORTH CURTAIN WALL
 CLEVELAND, OHIO.
 OFFICE OF ENGINEER OF STRUCTURES
 SCALE: As shown. DATE: Nov. 1, 1927.
 ISSUE No. 7. REVISED 7-1-32.

H. W. ...
 CHIEF ENGINEER

Issue No A June 30, 1927.

REVISIONS:
Issue No B Nov. 28, 1927.
Drawing Checked and Traced.

Issue No 1 Nov. 30, 1927.
Signed By Chief Engineer.

Issue No 2 Dec. 6, 1927.
Minor Revisions.



Issue No 3 Dec. 28, 1927.
Changed note on Waterproofing.

Issue No 4 Jan. 24, 1928.
Approved By Heads of Department.

Issue No 5 Feb. 24, 1928.
Revised to move all Water Chambers to West side of Bridge. Added section showing new Water Chamber.


Issue No 6 April 24, 1928.
Revised details of water lines. Approved by the City.

Issue No 7 Sept. 1, 1933.
Plan Corrected to Conform to Structure as Built.

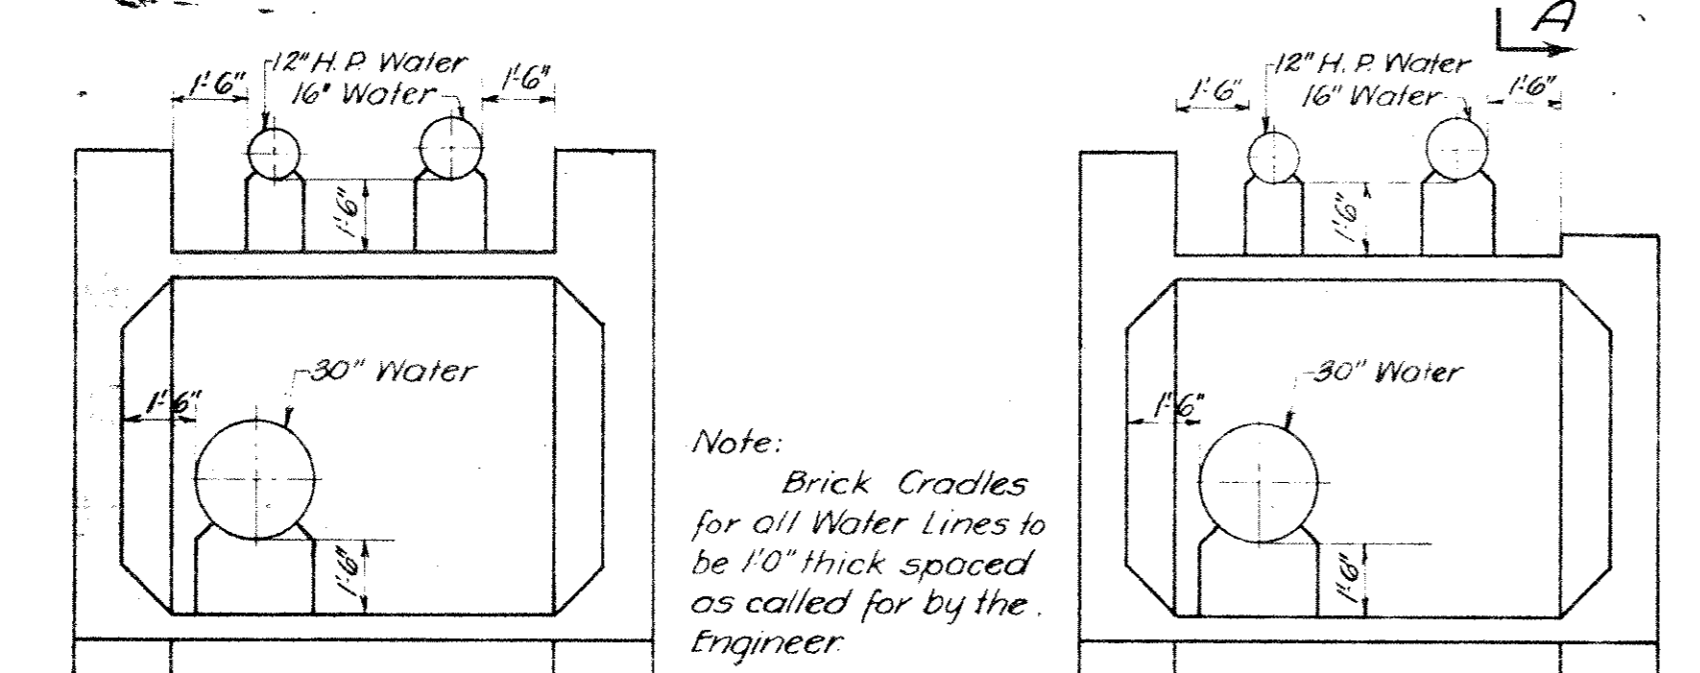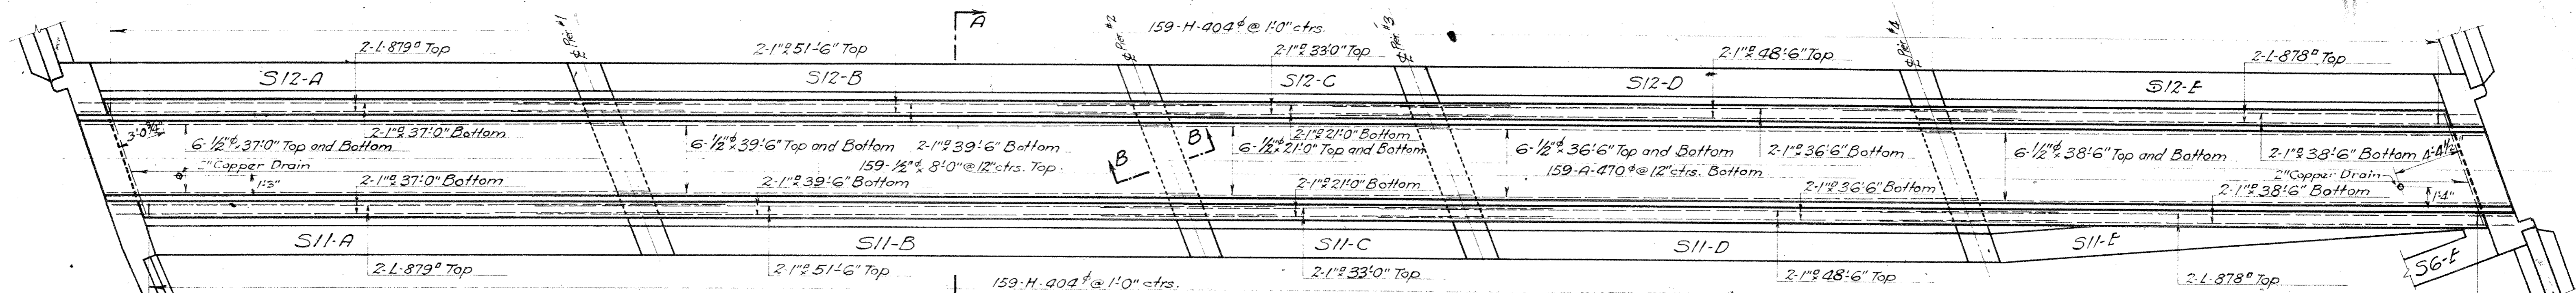


SECTION THRU WATER CHAMBERS WEST SIDE OF BRIDGE Showing all Water Lines Scale: 1/2"=1'-0"

PLAN OF SEWER CHAMBER Scale: 3/8"=1'-0"

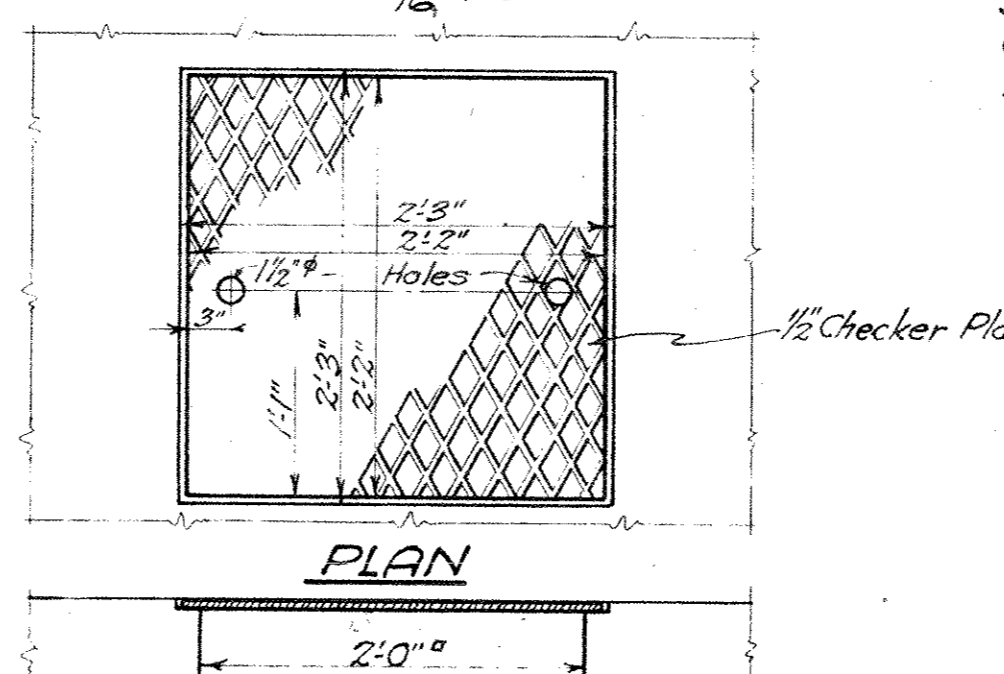


Concrete Cradles for 24" C.I. Sewer Pipe 3'-0" x 1'-0" x 6'-0" cts. Cradles vary in height and must be built up to center line of Pipe.


DETAIL OF SEWER CRADLE

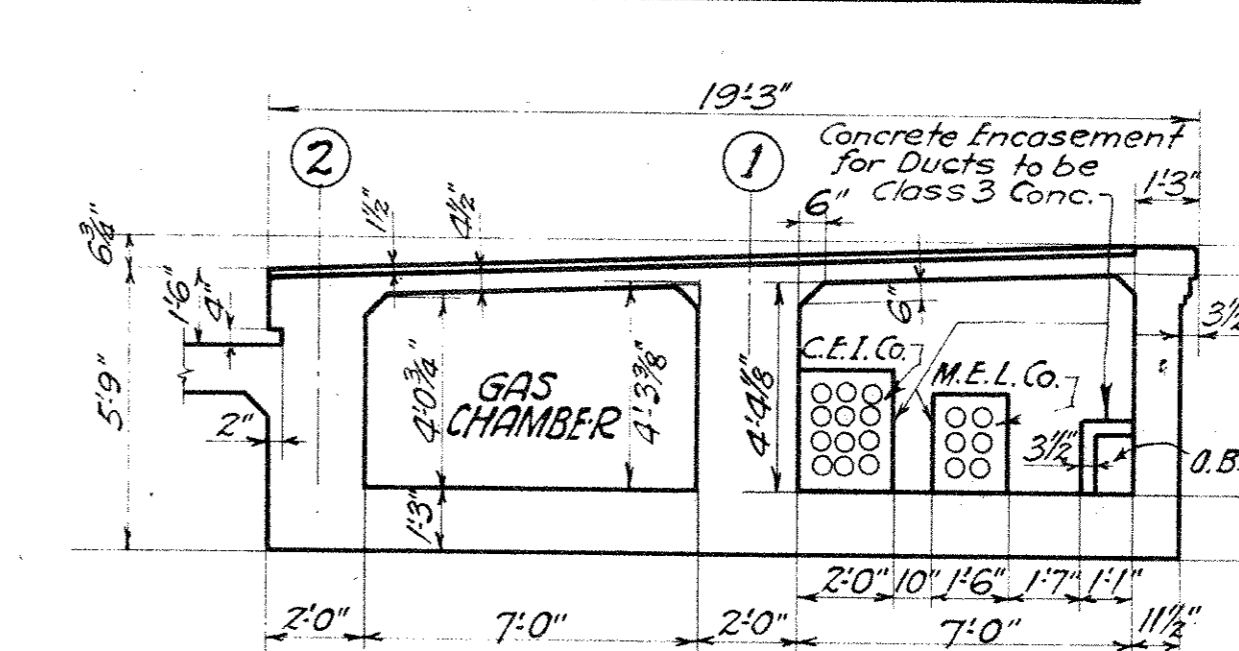


SECTION THRU EAST SIDEWALK SHOWING GAS & DUCT CHAMBERS Scale: 1/4"=1'-0"

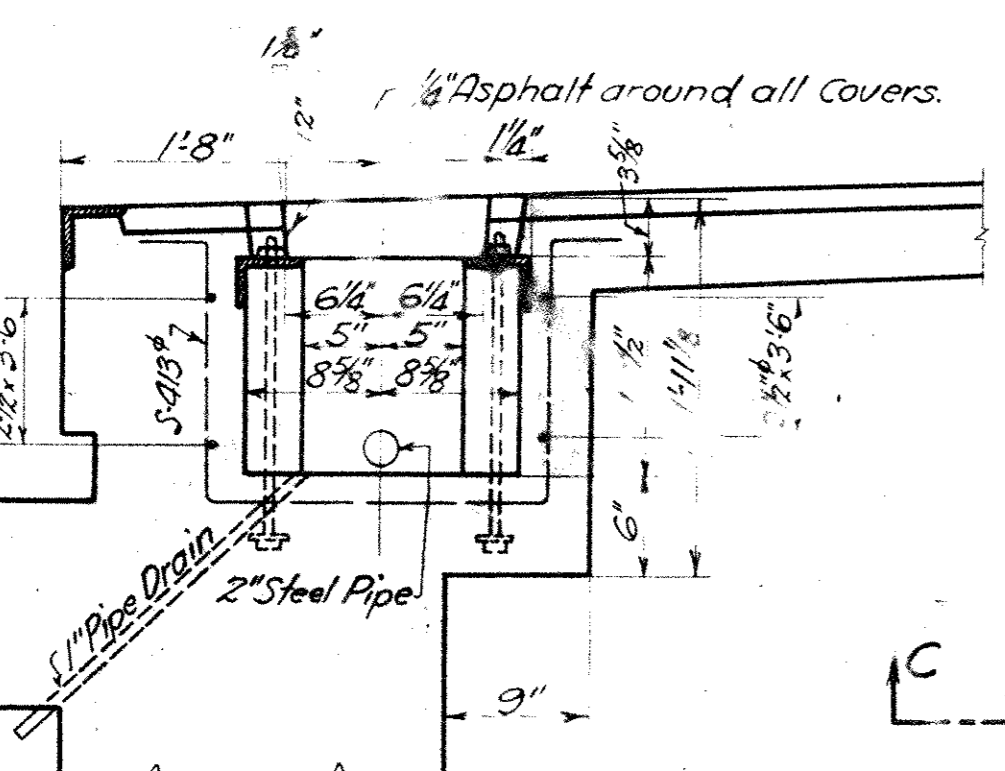


SECTION C-C

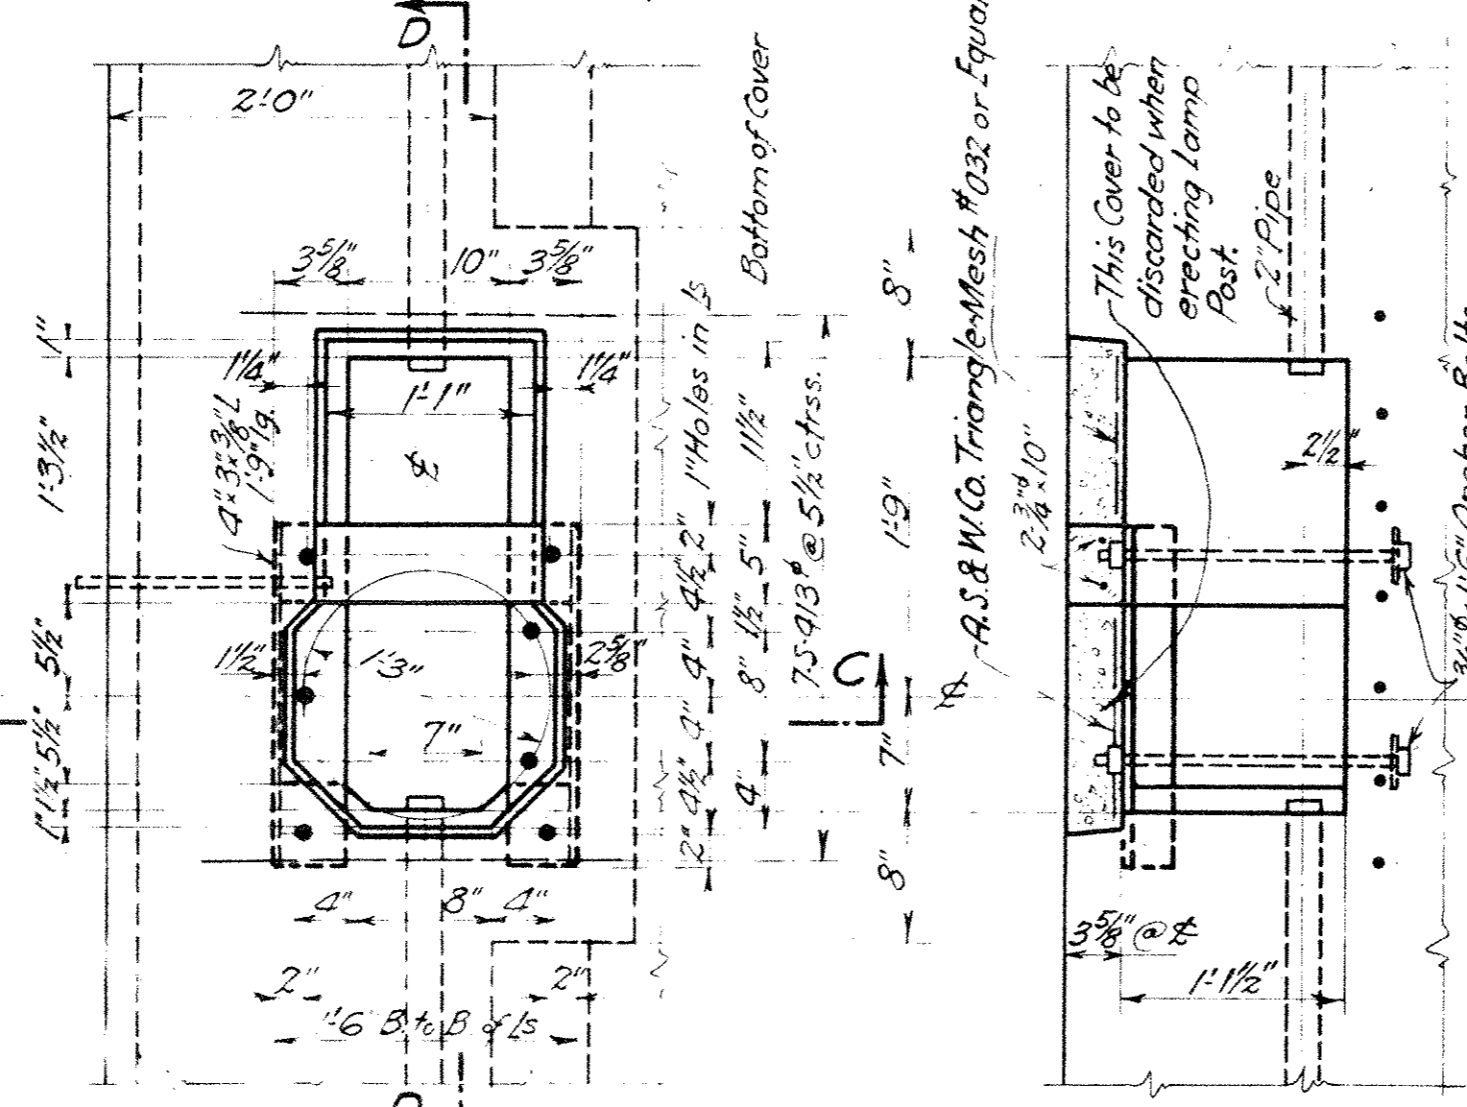


PLAN 2 Covers Removed DETAILS OF LAMP POST BASE Scale: 1"=1'-0"

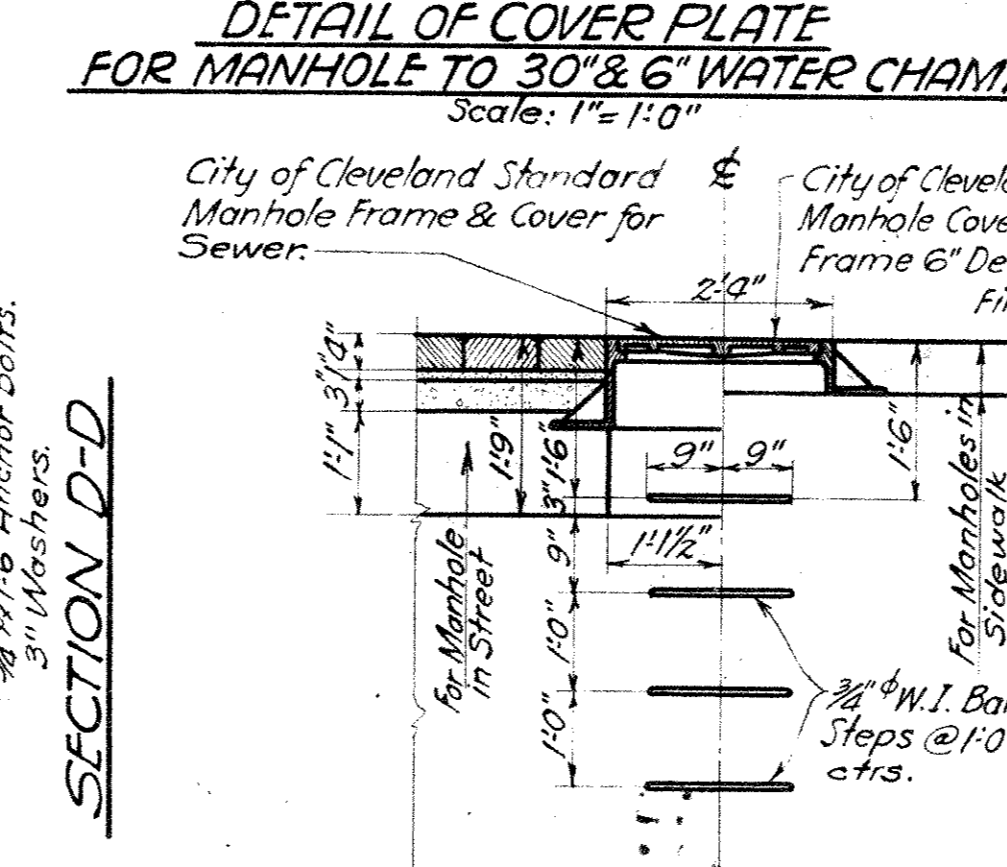


DETAIL SHOWING MANHOLE FRAMES Scale: 1/2"=1'-0"

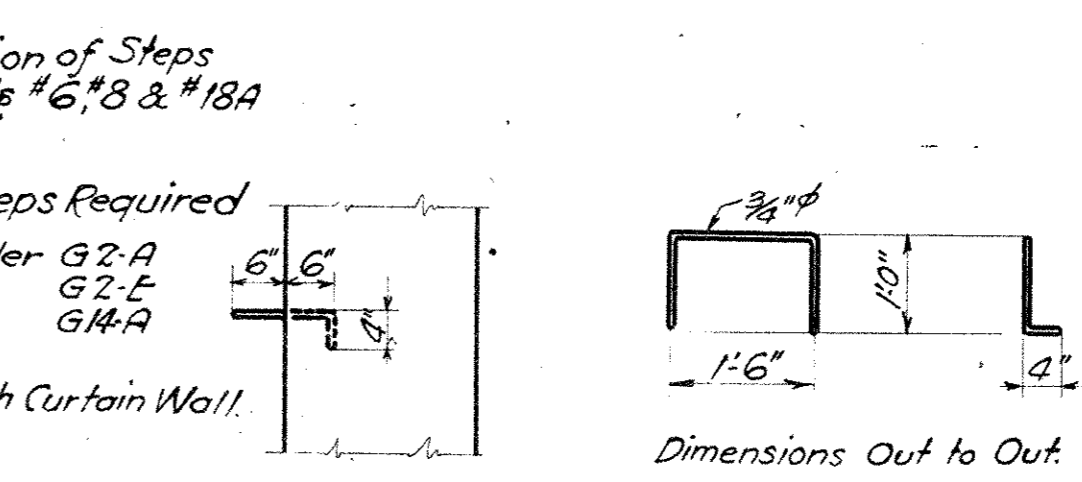


DETAILS OF W.I. STEP

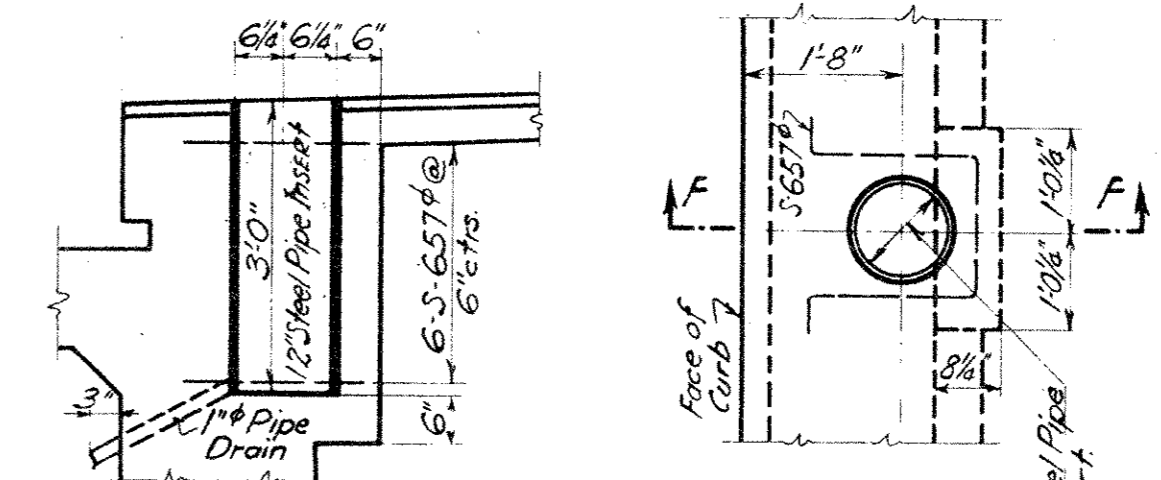


SECTION F-F DETAILS OF TROLLEY POLE ANCHORAGE Scale: 1/2"=1'-0"

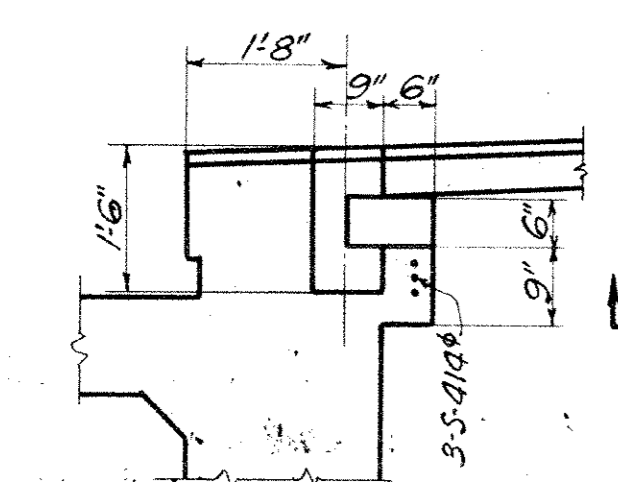


SECTION H-H

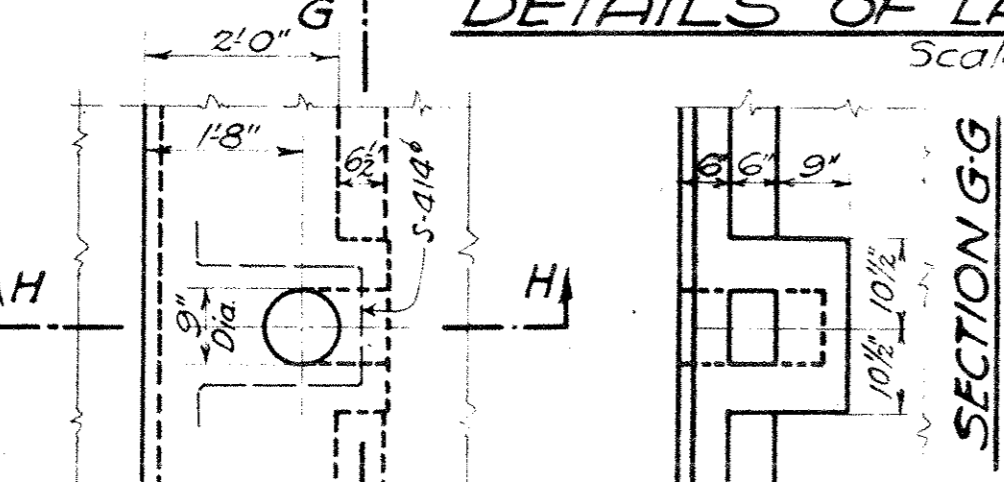


DETAILS OF GAS CHAMBER VENT ANCHORAGE Scale: 1/2"=1'-0"

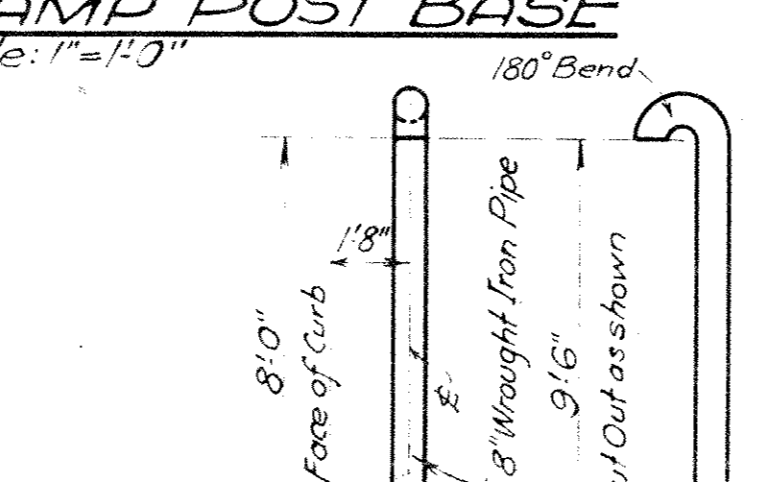


DETAIL OF VENT FOR GAS CHAMBER Scale: 1/2"=1'-0"

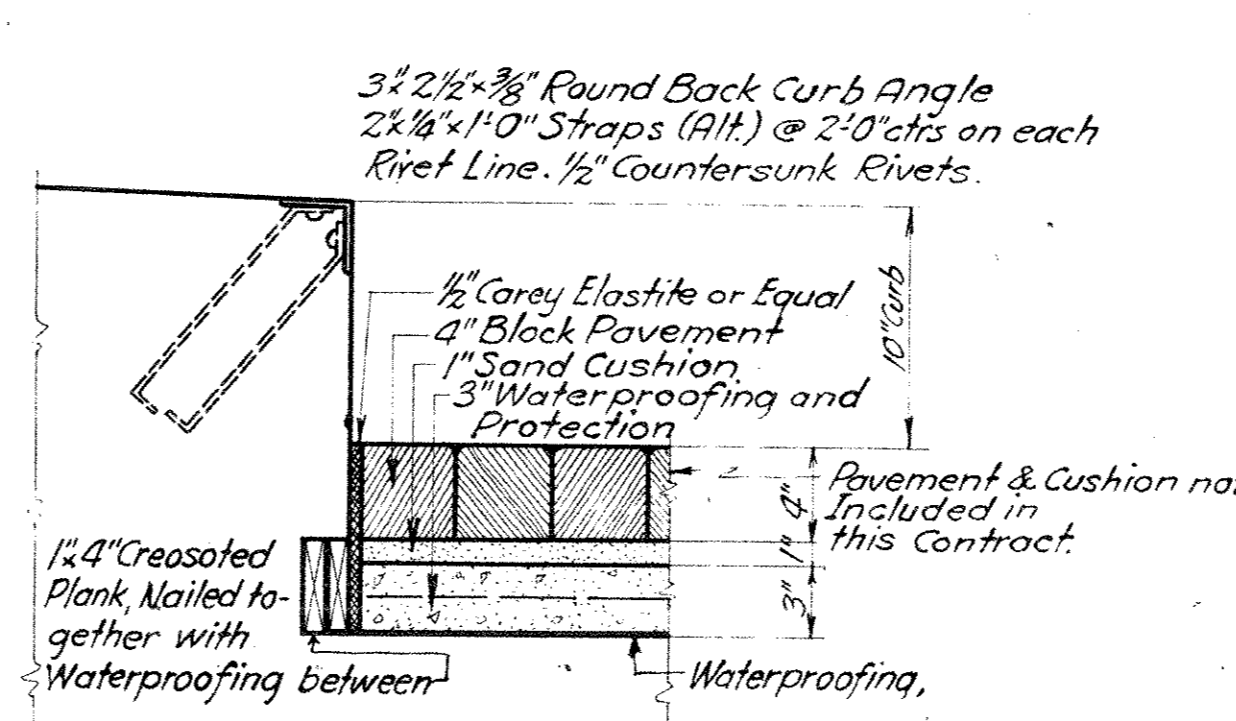


CURB AND PAVING DETAIL Scale: 1/2"=1'-0"

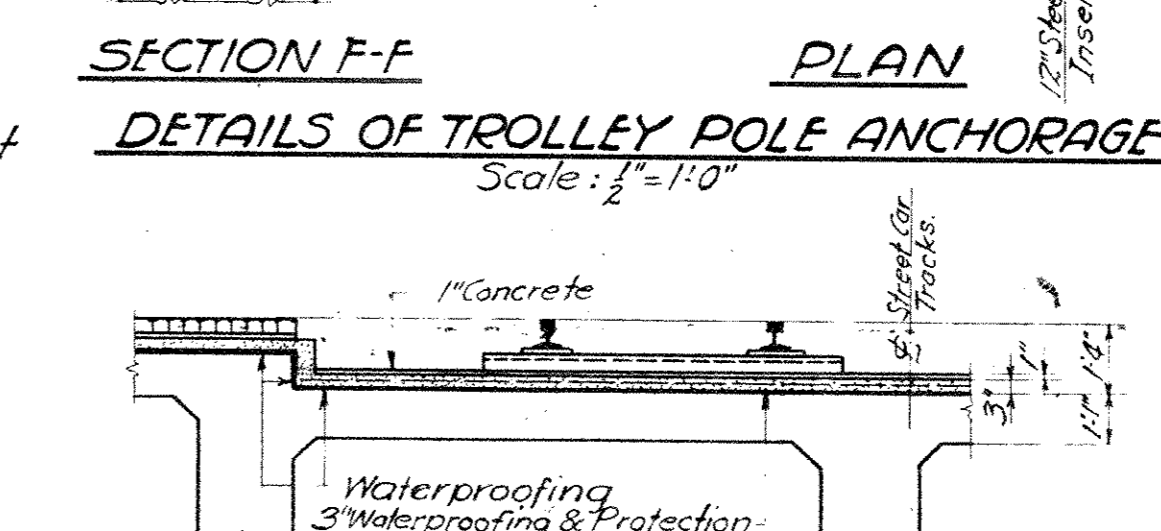


SECTION THRU STREET CAR TRACKS Scale: 1/4"=1'-0"

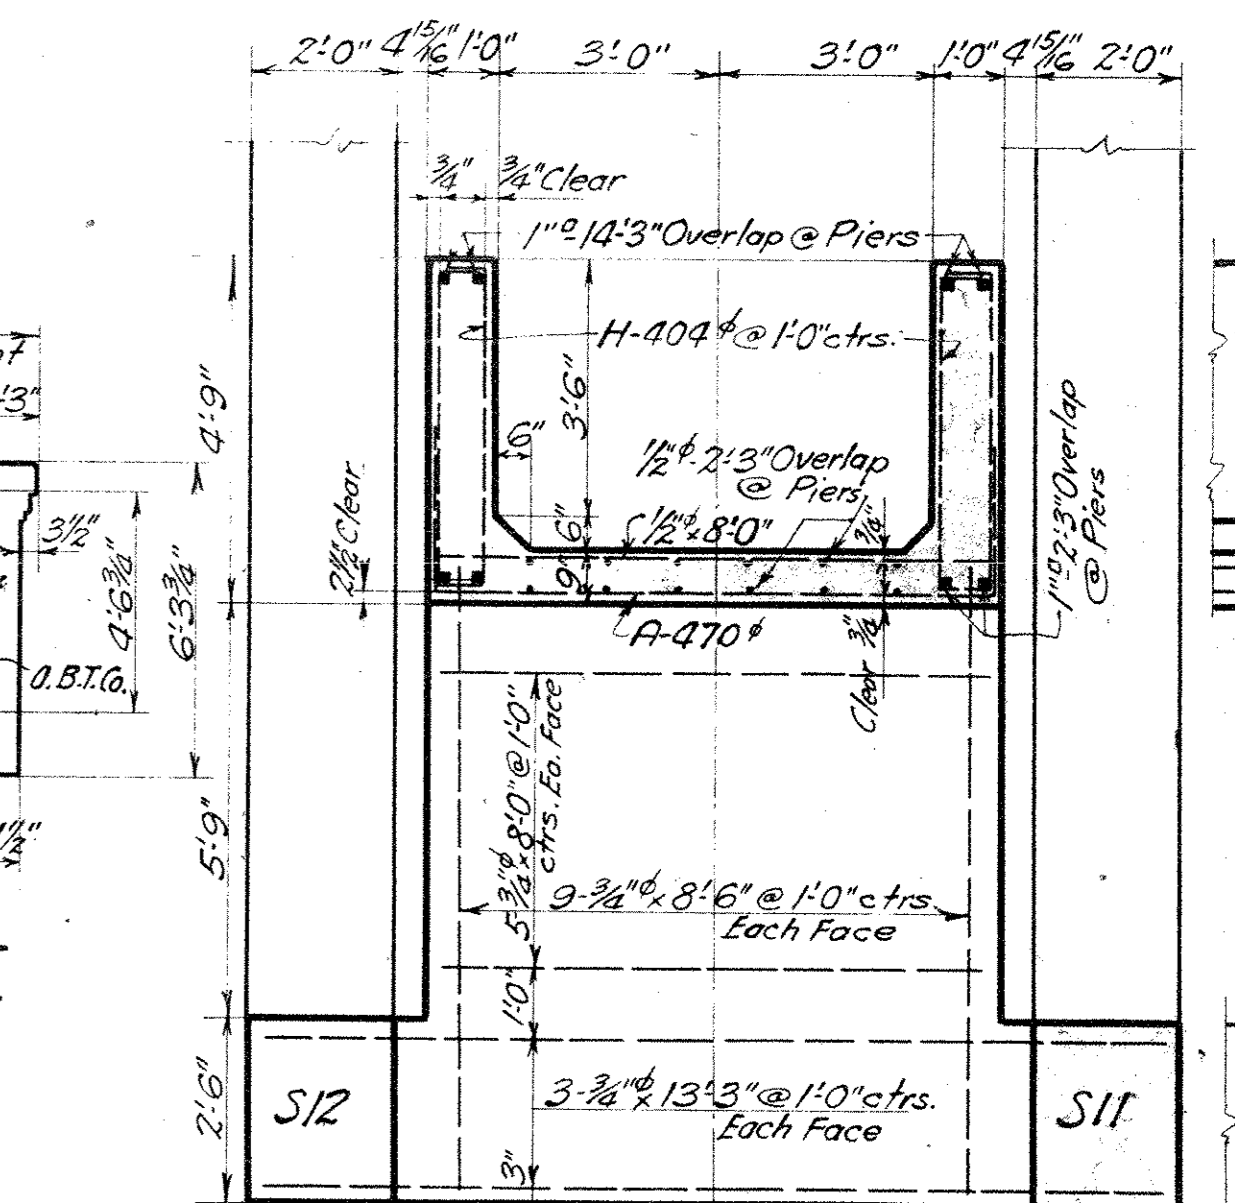

SECTION A-A SECTION B-B Note: Same for all Piers. Scale: 3/8"=1'-0"

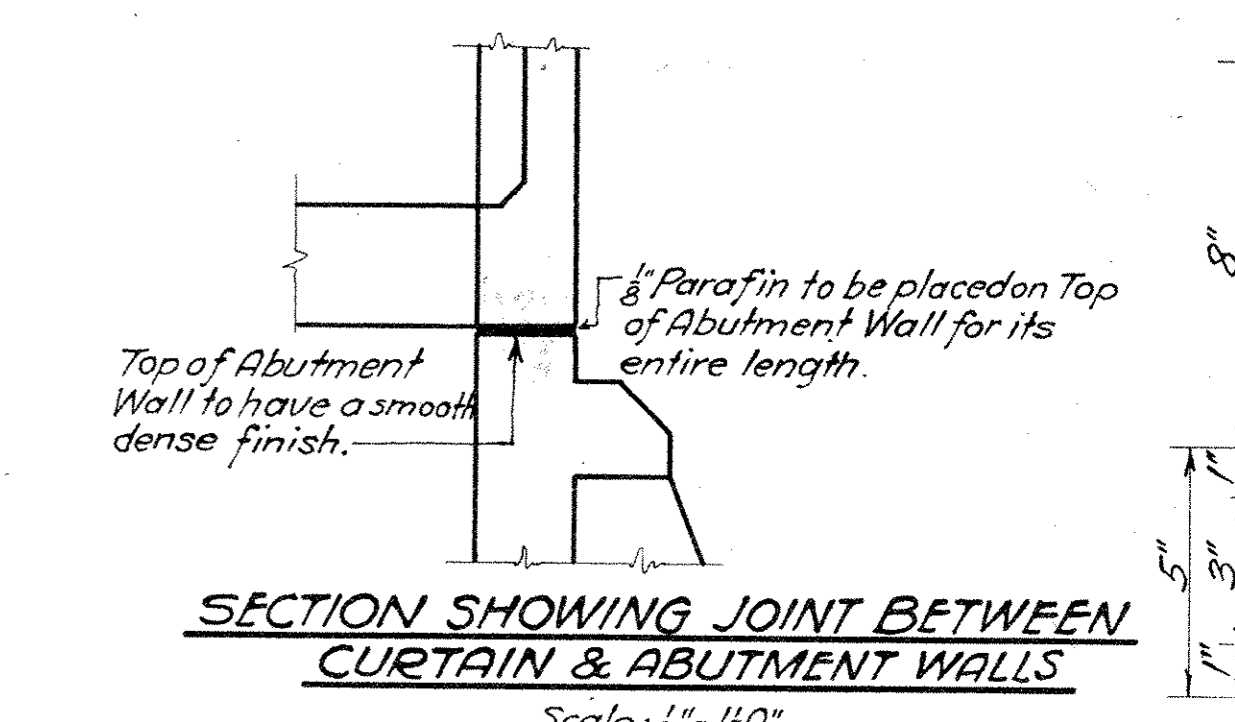

SECTION SHOWING JOINT BETWEEN CURTAIN & ABUTMENT WALLS Scale: 1/4"=1'-0"

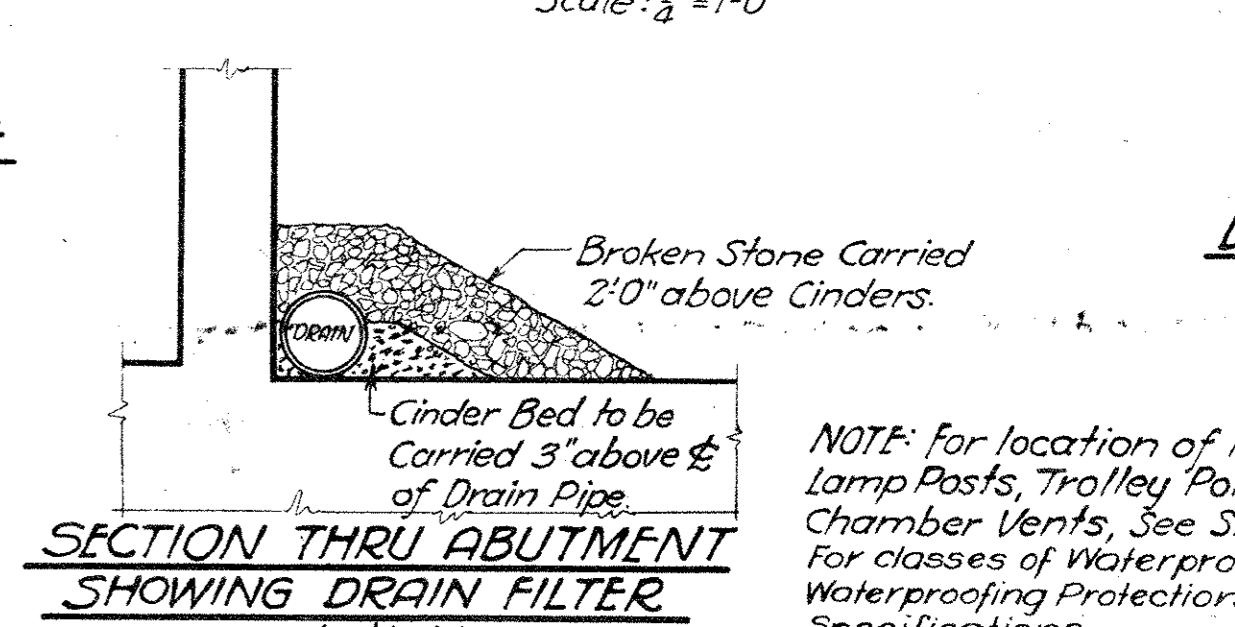

SECTION THRU ABUTMENT SHOWING DRAIN FILTER Scale: 1/4"=1'-0"

DETAIL AT COPING Scale: 3/8"=1'-0"

We Hereby Certify That This Plan Shows the Structure as Built.

L. V. Marsh, ENGINEER OF STRUCTURES

H. P. ... ASST. ENGINEER OF CONSTRUCTION

Designed By G.T.C. June 30, 1927.

Detailed By L.C.B. June 30, 1927.

Traced By S.H. Nov. 28, 1927.

Checked By T.W. Nov. 28, 1927.

Corrected By J.C. 30, 1927.


H. L. ... Designing Engineer

Approved E. O. Marsh, Engineer of Structures


Approved J. ... Principal Assistant Engineer

Approved ... Assistant Electrical Engineer


Approved ... Engineer of Construction

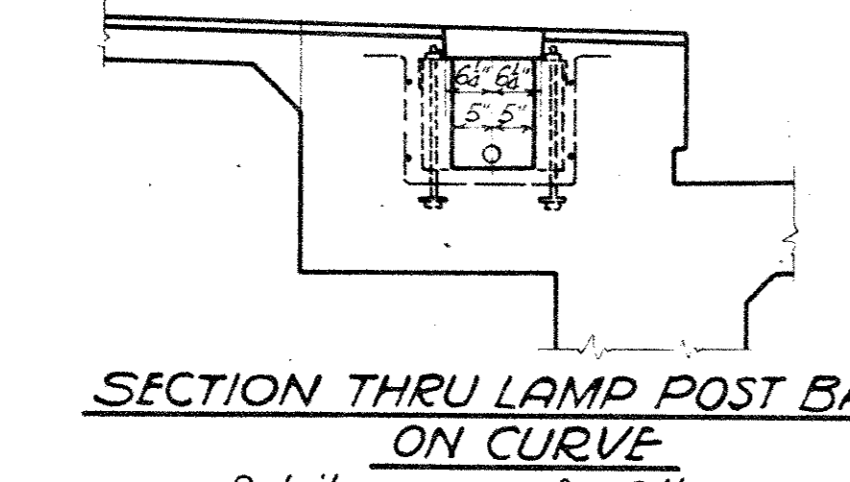


SECTION THRU LAMP POST BASE ON CURVE Details same as for Others

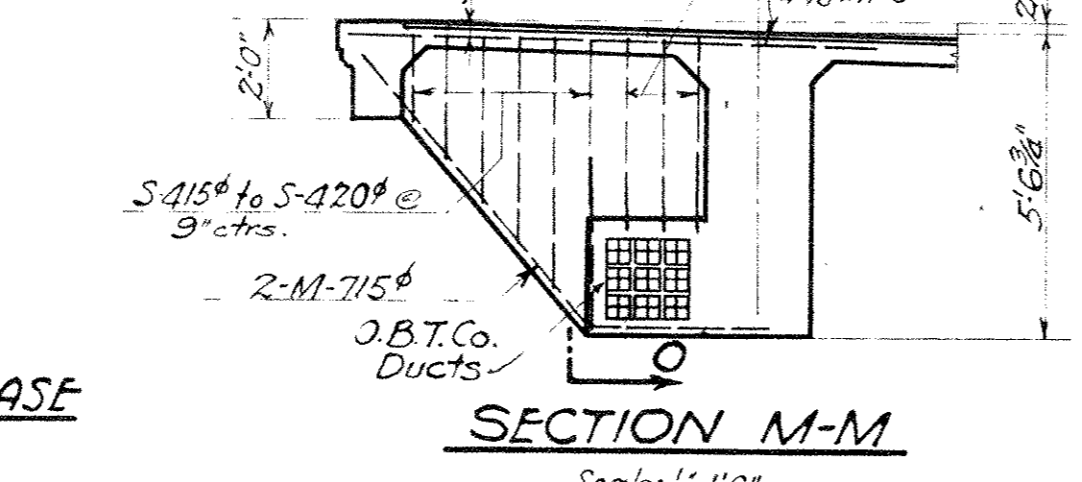

SECTION M-M Scale: 1/2"=1'-0"

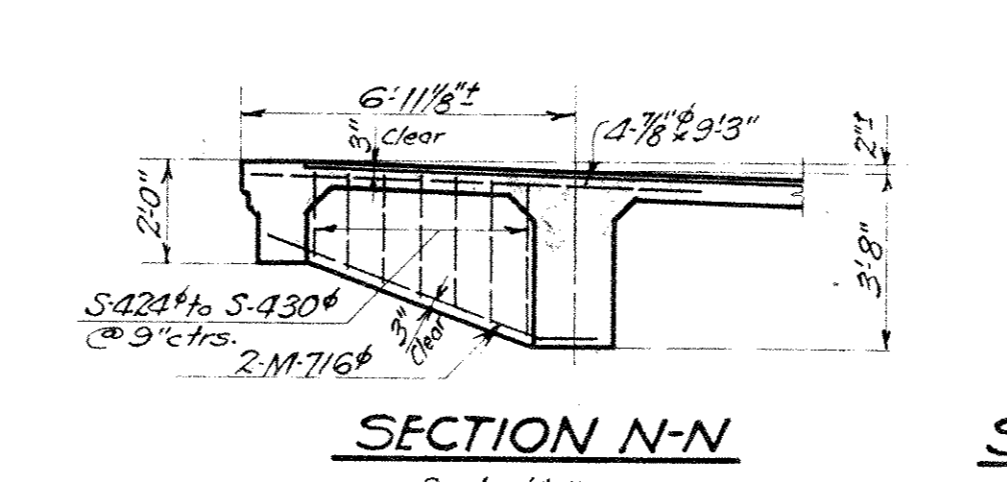

SECTION N-N Scale: 1/2"=1'-0"

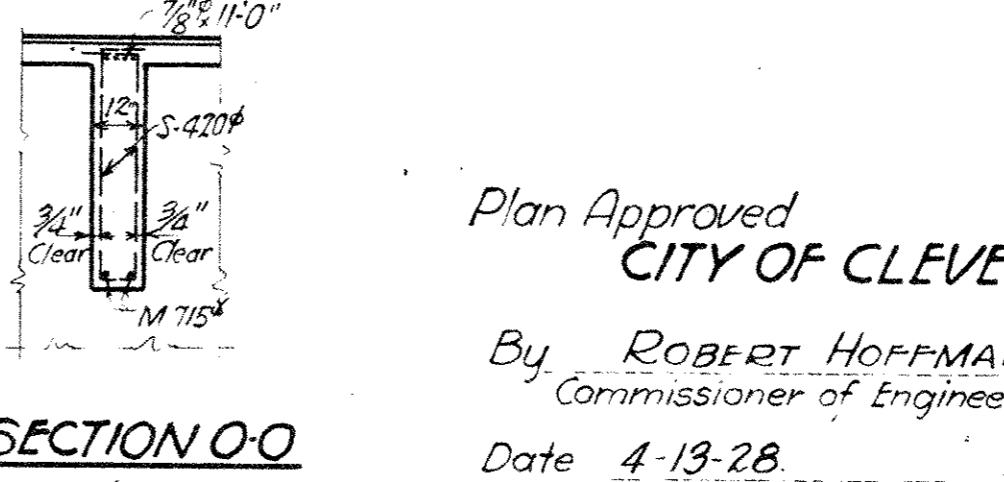

SECTION O-O Scale: 1/2"=1'-0"

For location of Sections See Sh. # 5

Plan Approved CITY OF CLEVELAND


By ROBERT HOFFMANN, Commissioner of Engineering & Construction

Date 4-13-28

THE CLEVELAND UNION TERMINALS CO. CENTRAL AVE. BRIDGE UTILITIES SUPPORTS, MISCELLANEOUS DETAILS

OFFICE OF ENGINEER OF STRUCTURES SCALE: AS SHOWN DATE: JUNE 30, 1927

ISSUE NO. 7 REVISOR: J. ... CHIEF ENGINEER

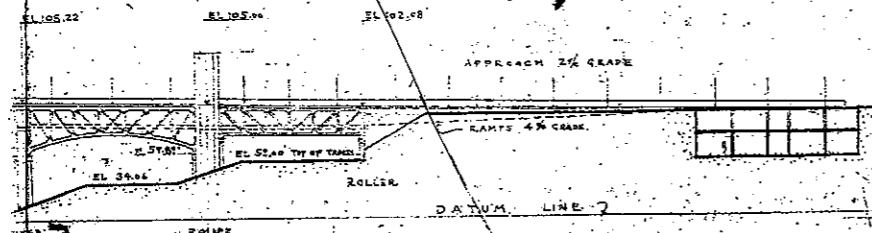



LORAIN CENTRAL BRIDGE

COMMISSIONERS OF CUYAHOGA COUNTY
 J. R. ZMUNT J. H. HARRIS W. E. COOK

COUNTY SURVEYOR
 F. R. WILLIAMS

COUNTY BRIDGE ENGINEER
 A. M. FELGATE


CONSULTING ENGINEERS AND ARCHITECTS
 WILBUR, J. WATSON AND F. R. WALKER

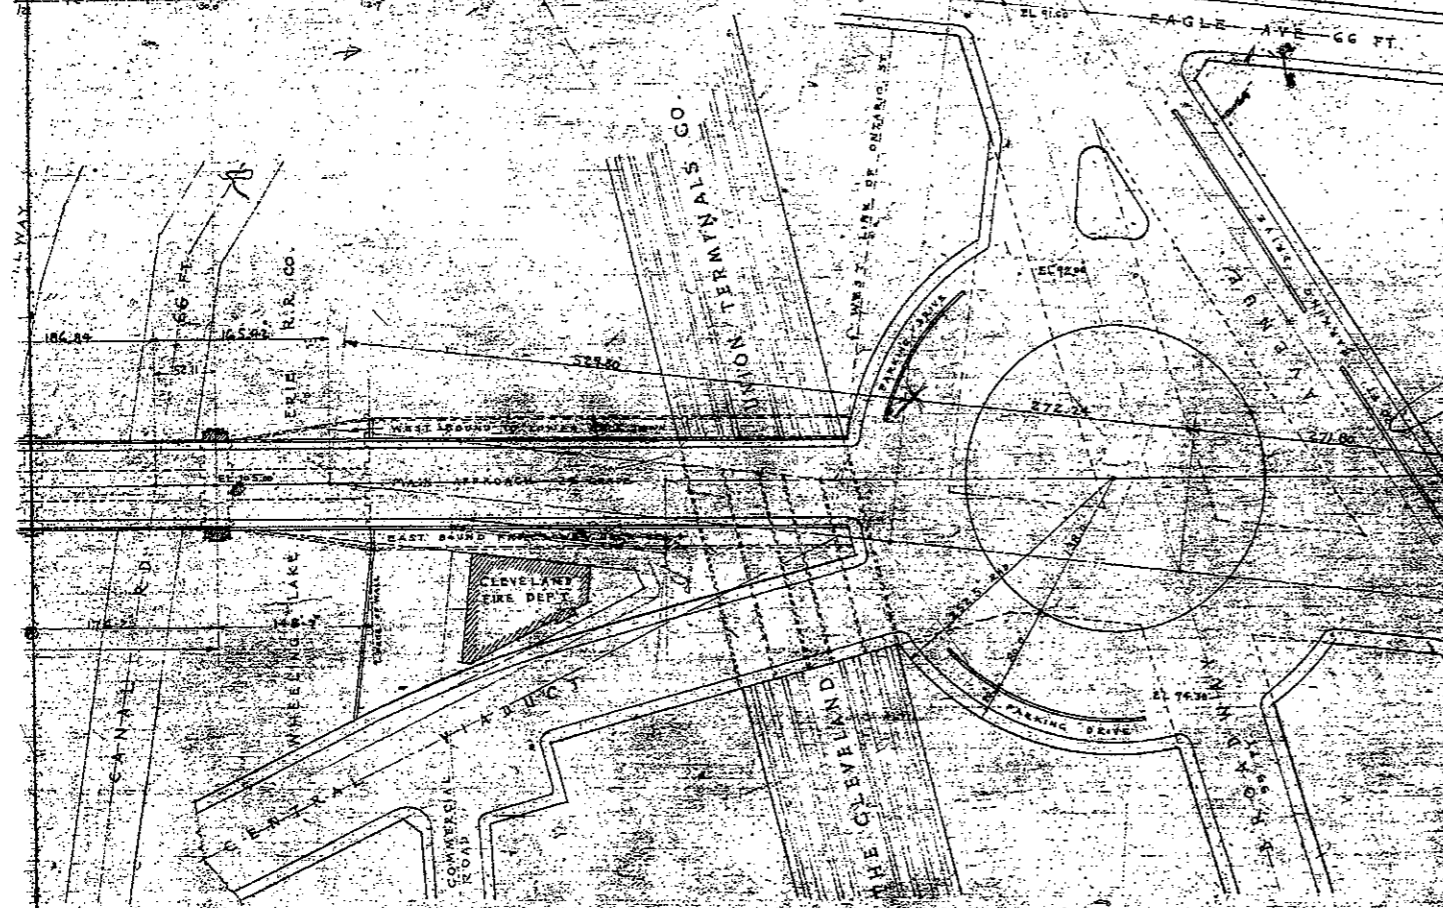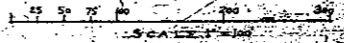

Walter E. Cook CO. COMMRS.
James CO. SUPERVISOR
A. M. Felgate CO. BRIDGE ENG.
W. J. Watson CO. ARCHT.

SFN 1801503

11
 11
 9'8
 8.5"
 11"
 17"


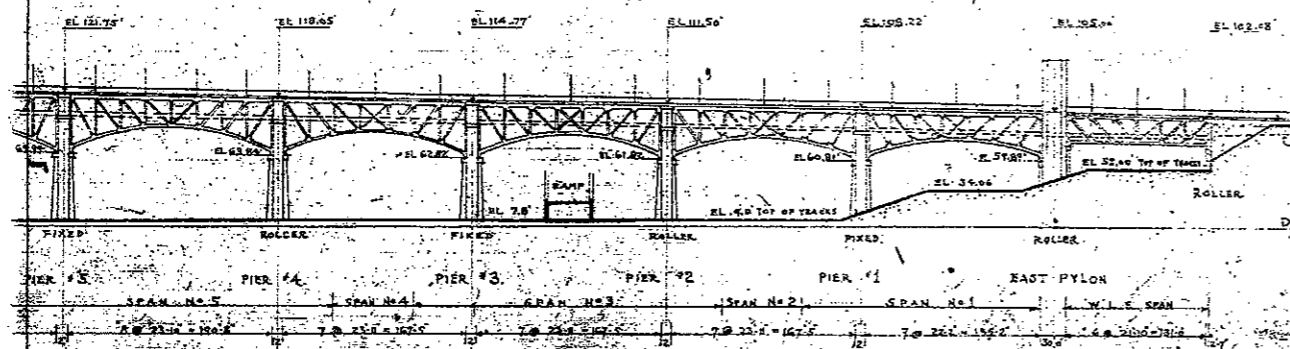


LORAIN CEN

COMMISSIONERS
J. R. ZMUNT J. H. ...



COUNTY
T. R. W
COUNTY BR
A. M. E

CONSULTING ENGIN
WILKIE J. WATSON

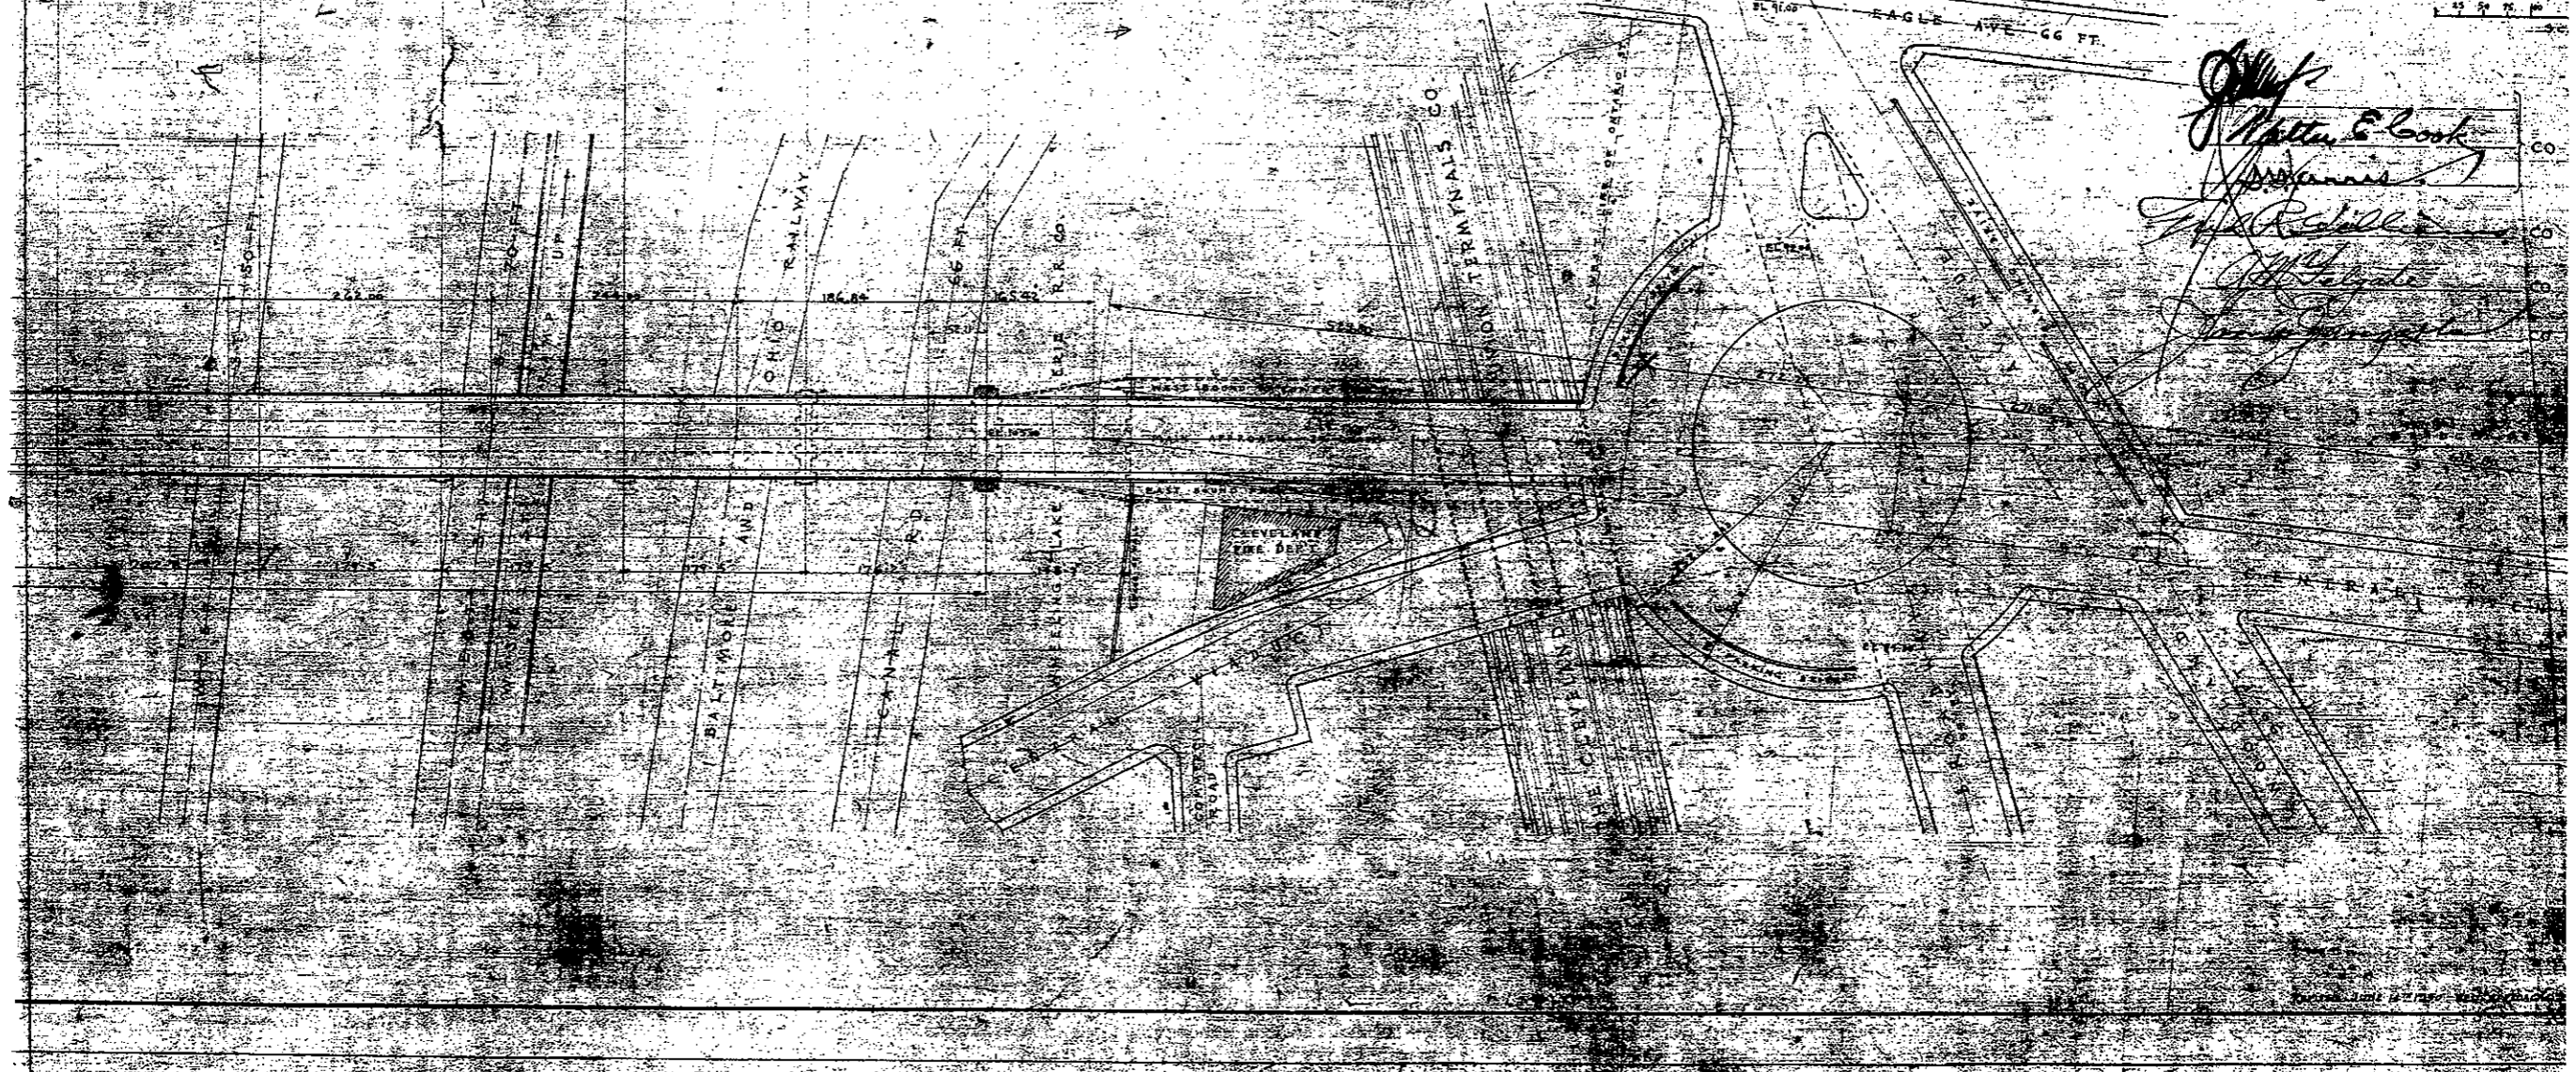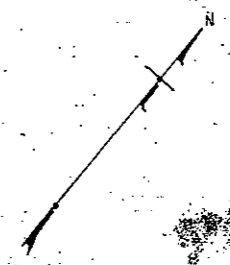

John E. Cook
W. J. Watson
W. J. Watson
W. J. Watson
W. J. Watson

SFN 180 503

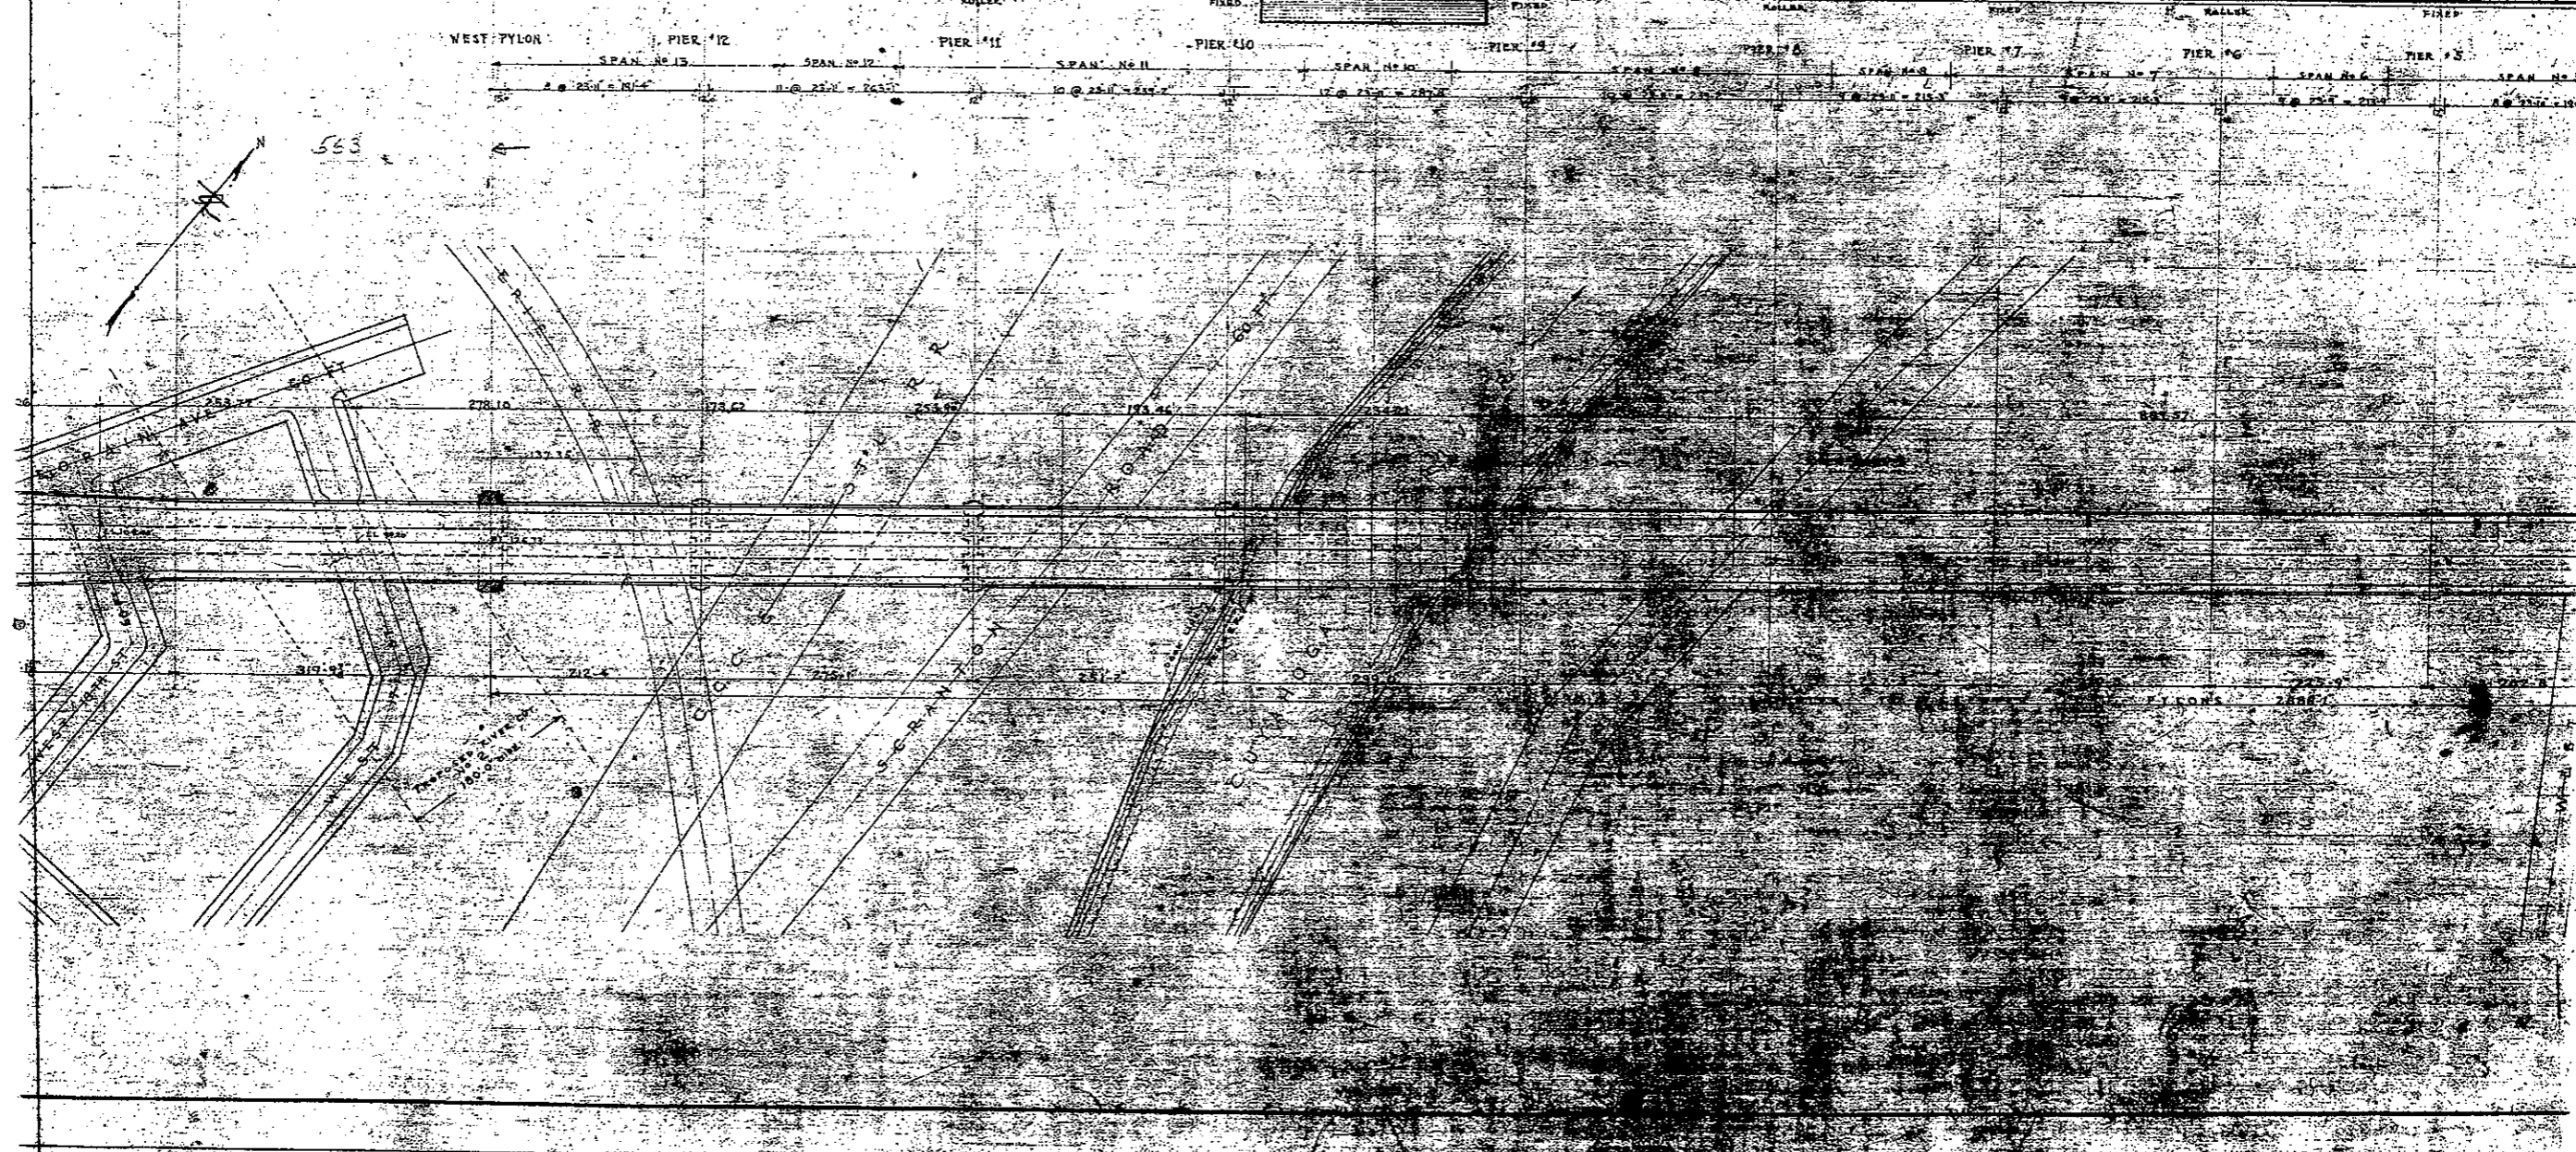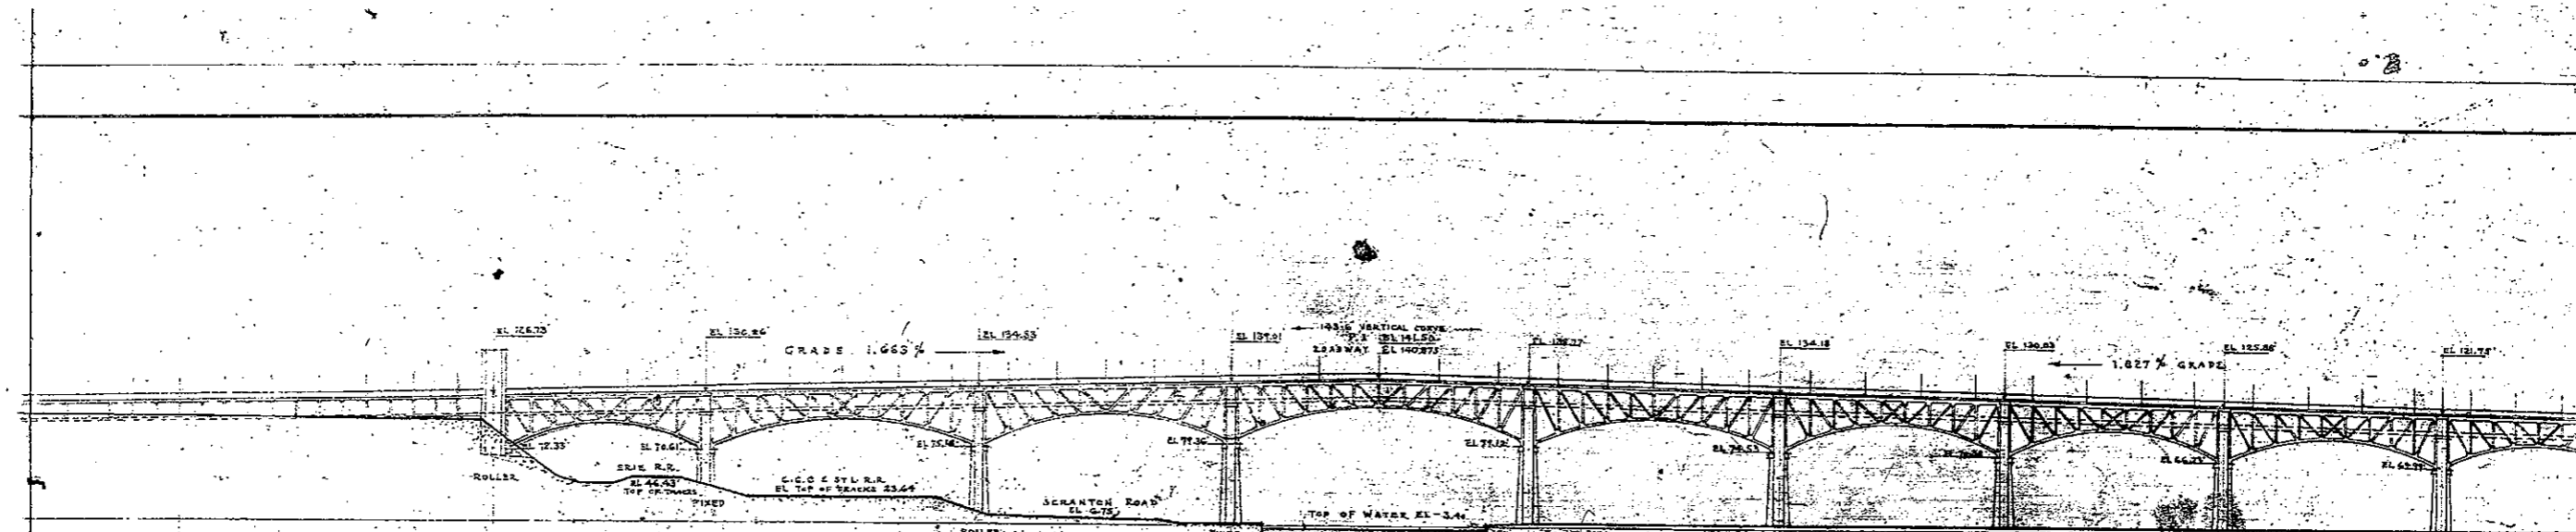

SFN 1801503

17"


11"

8.5"

8.5"

11"

17"

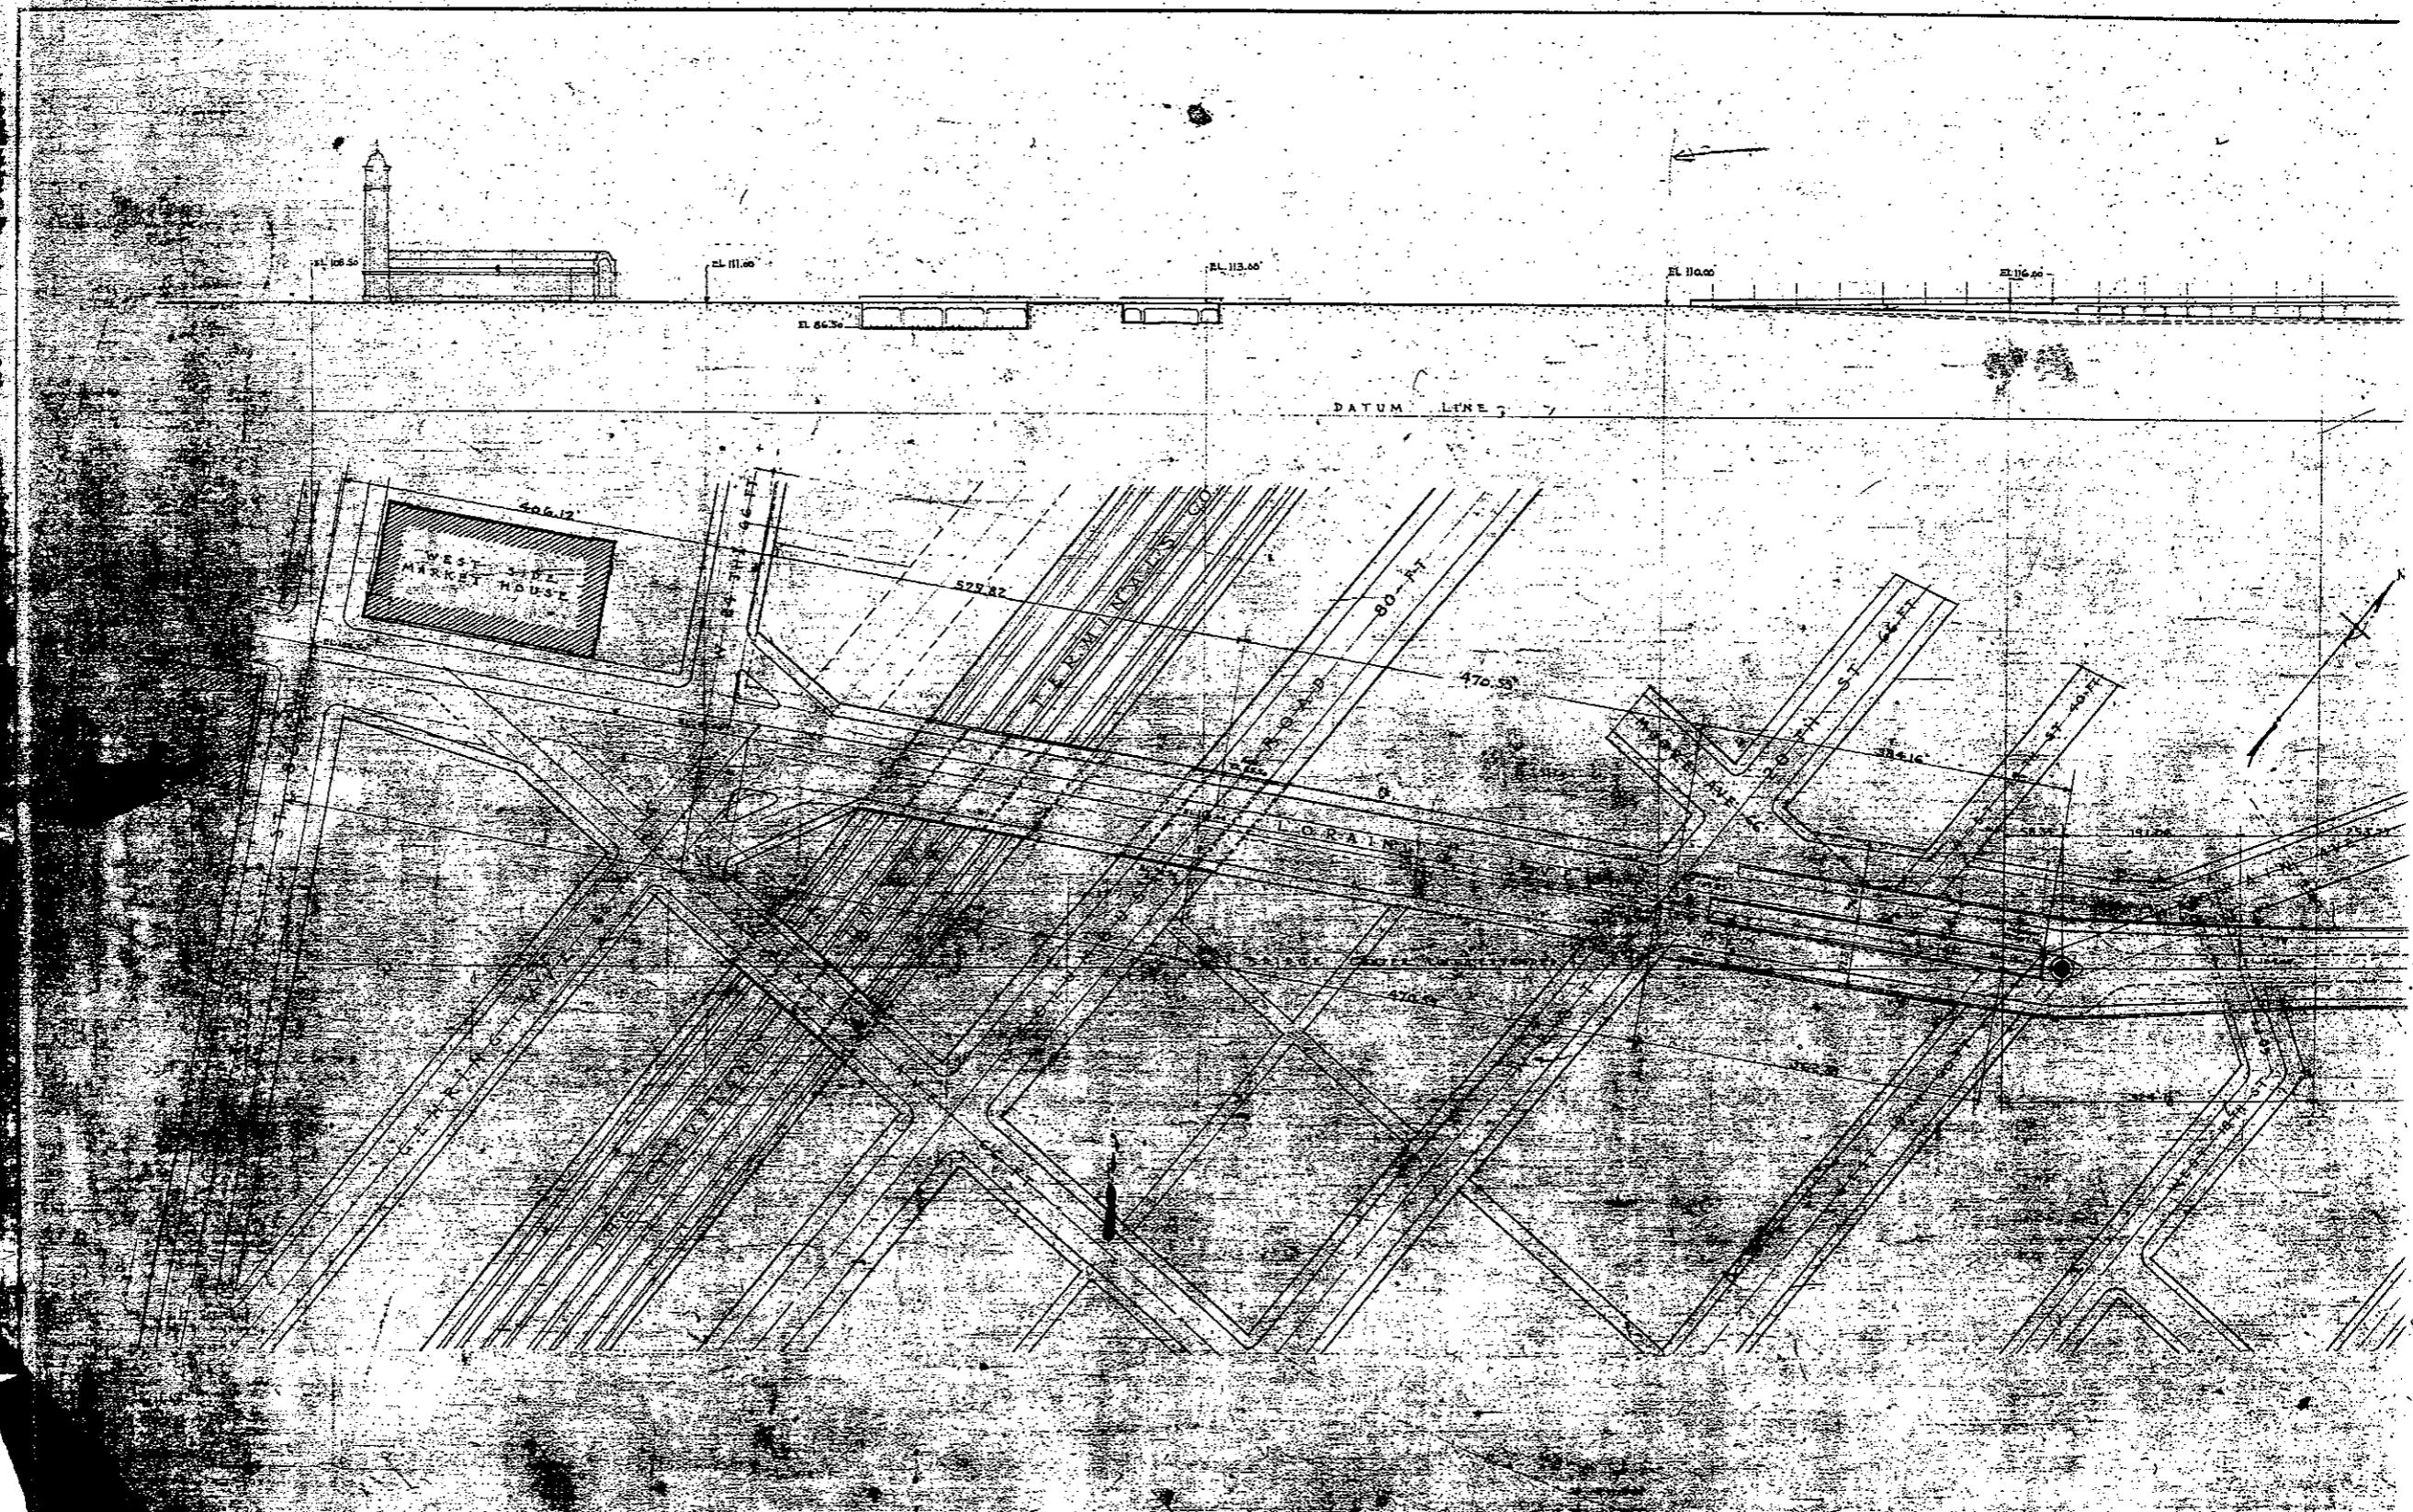


SFN 1801503

MICROFILMED
OCT 6 1987



SFN | 80 | 50 | 3

MICROFILMED
OCT 6 1987

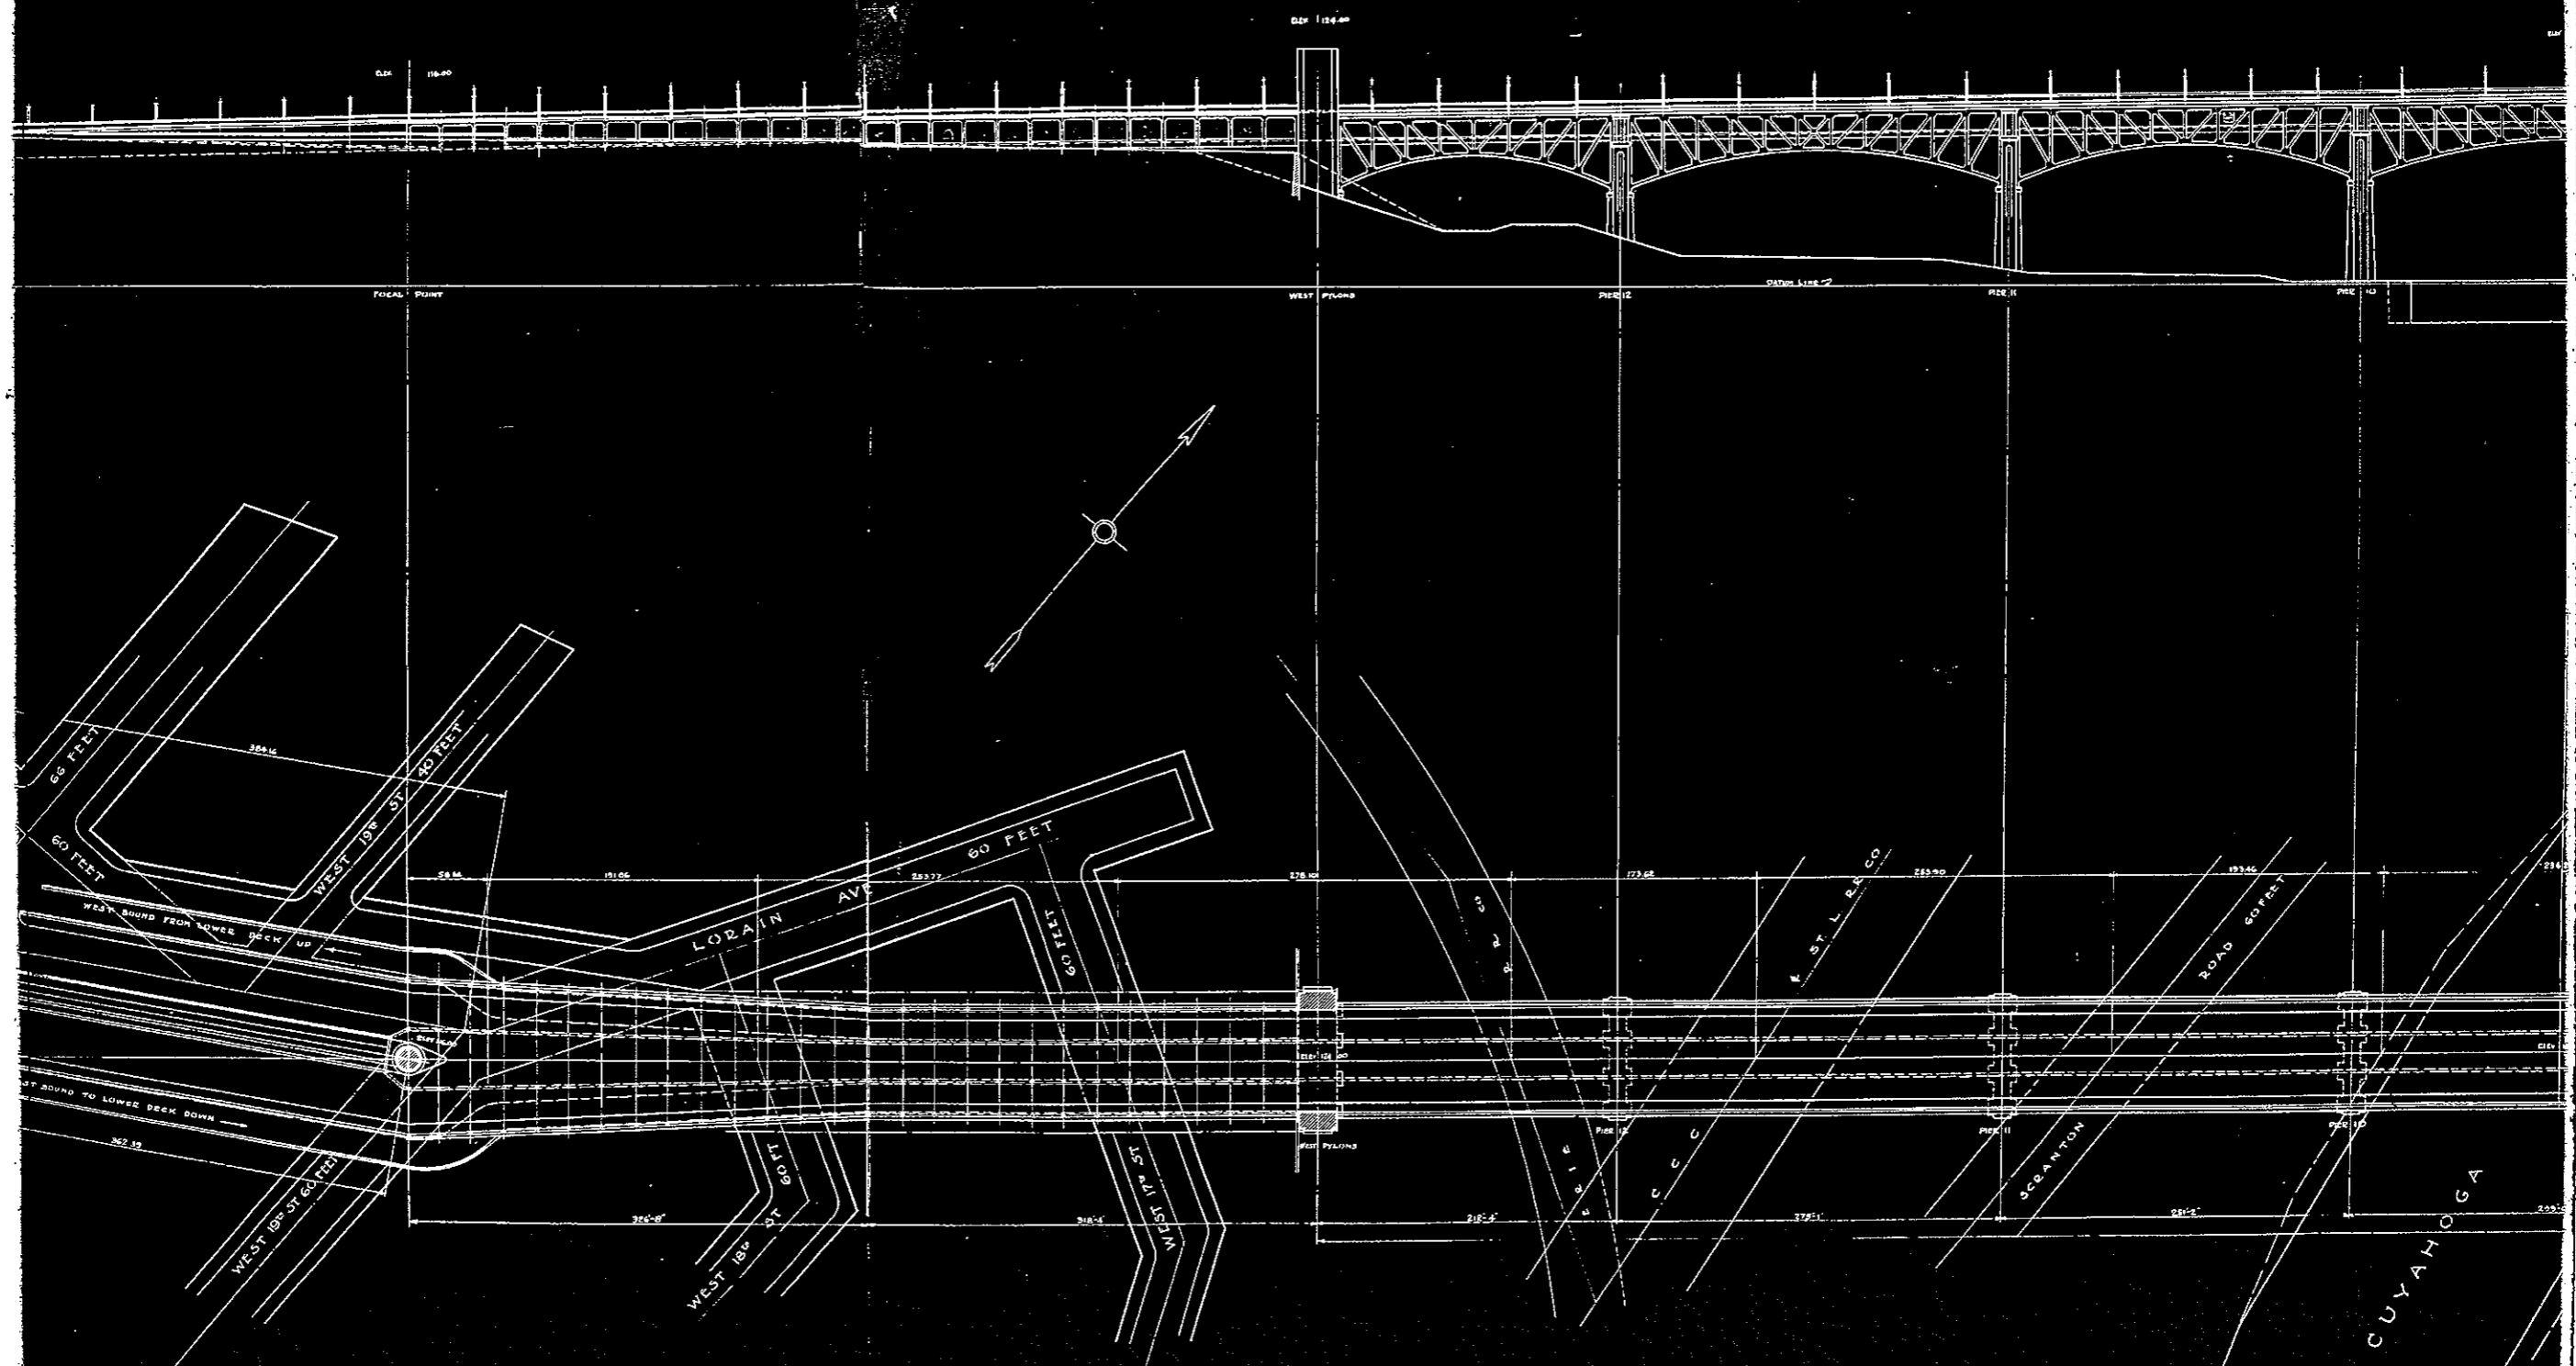


SFN 1801503

MICROFILMED

OCT 6 1987


MICROFILMED

JUL 6 1987

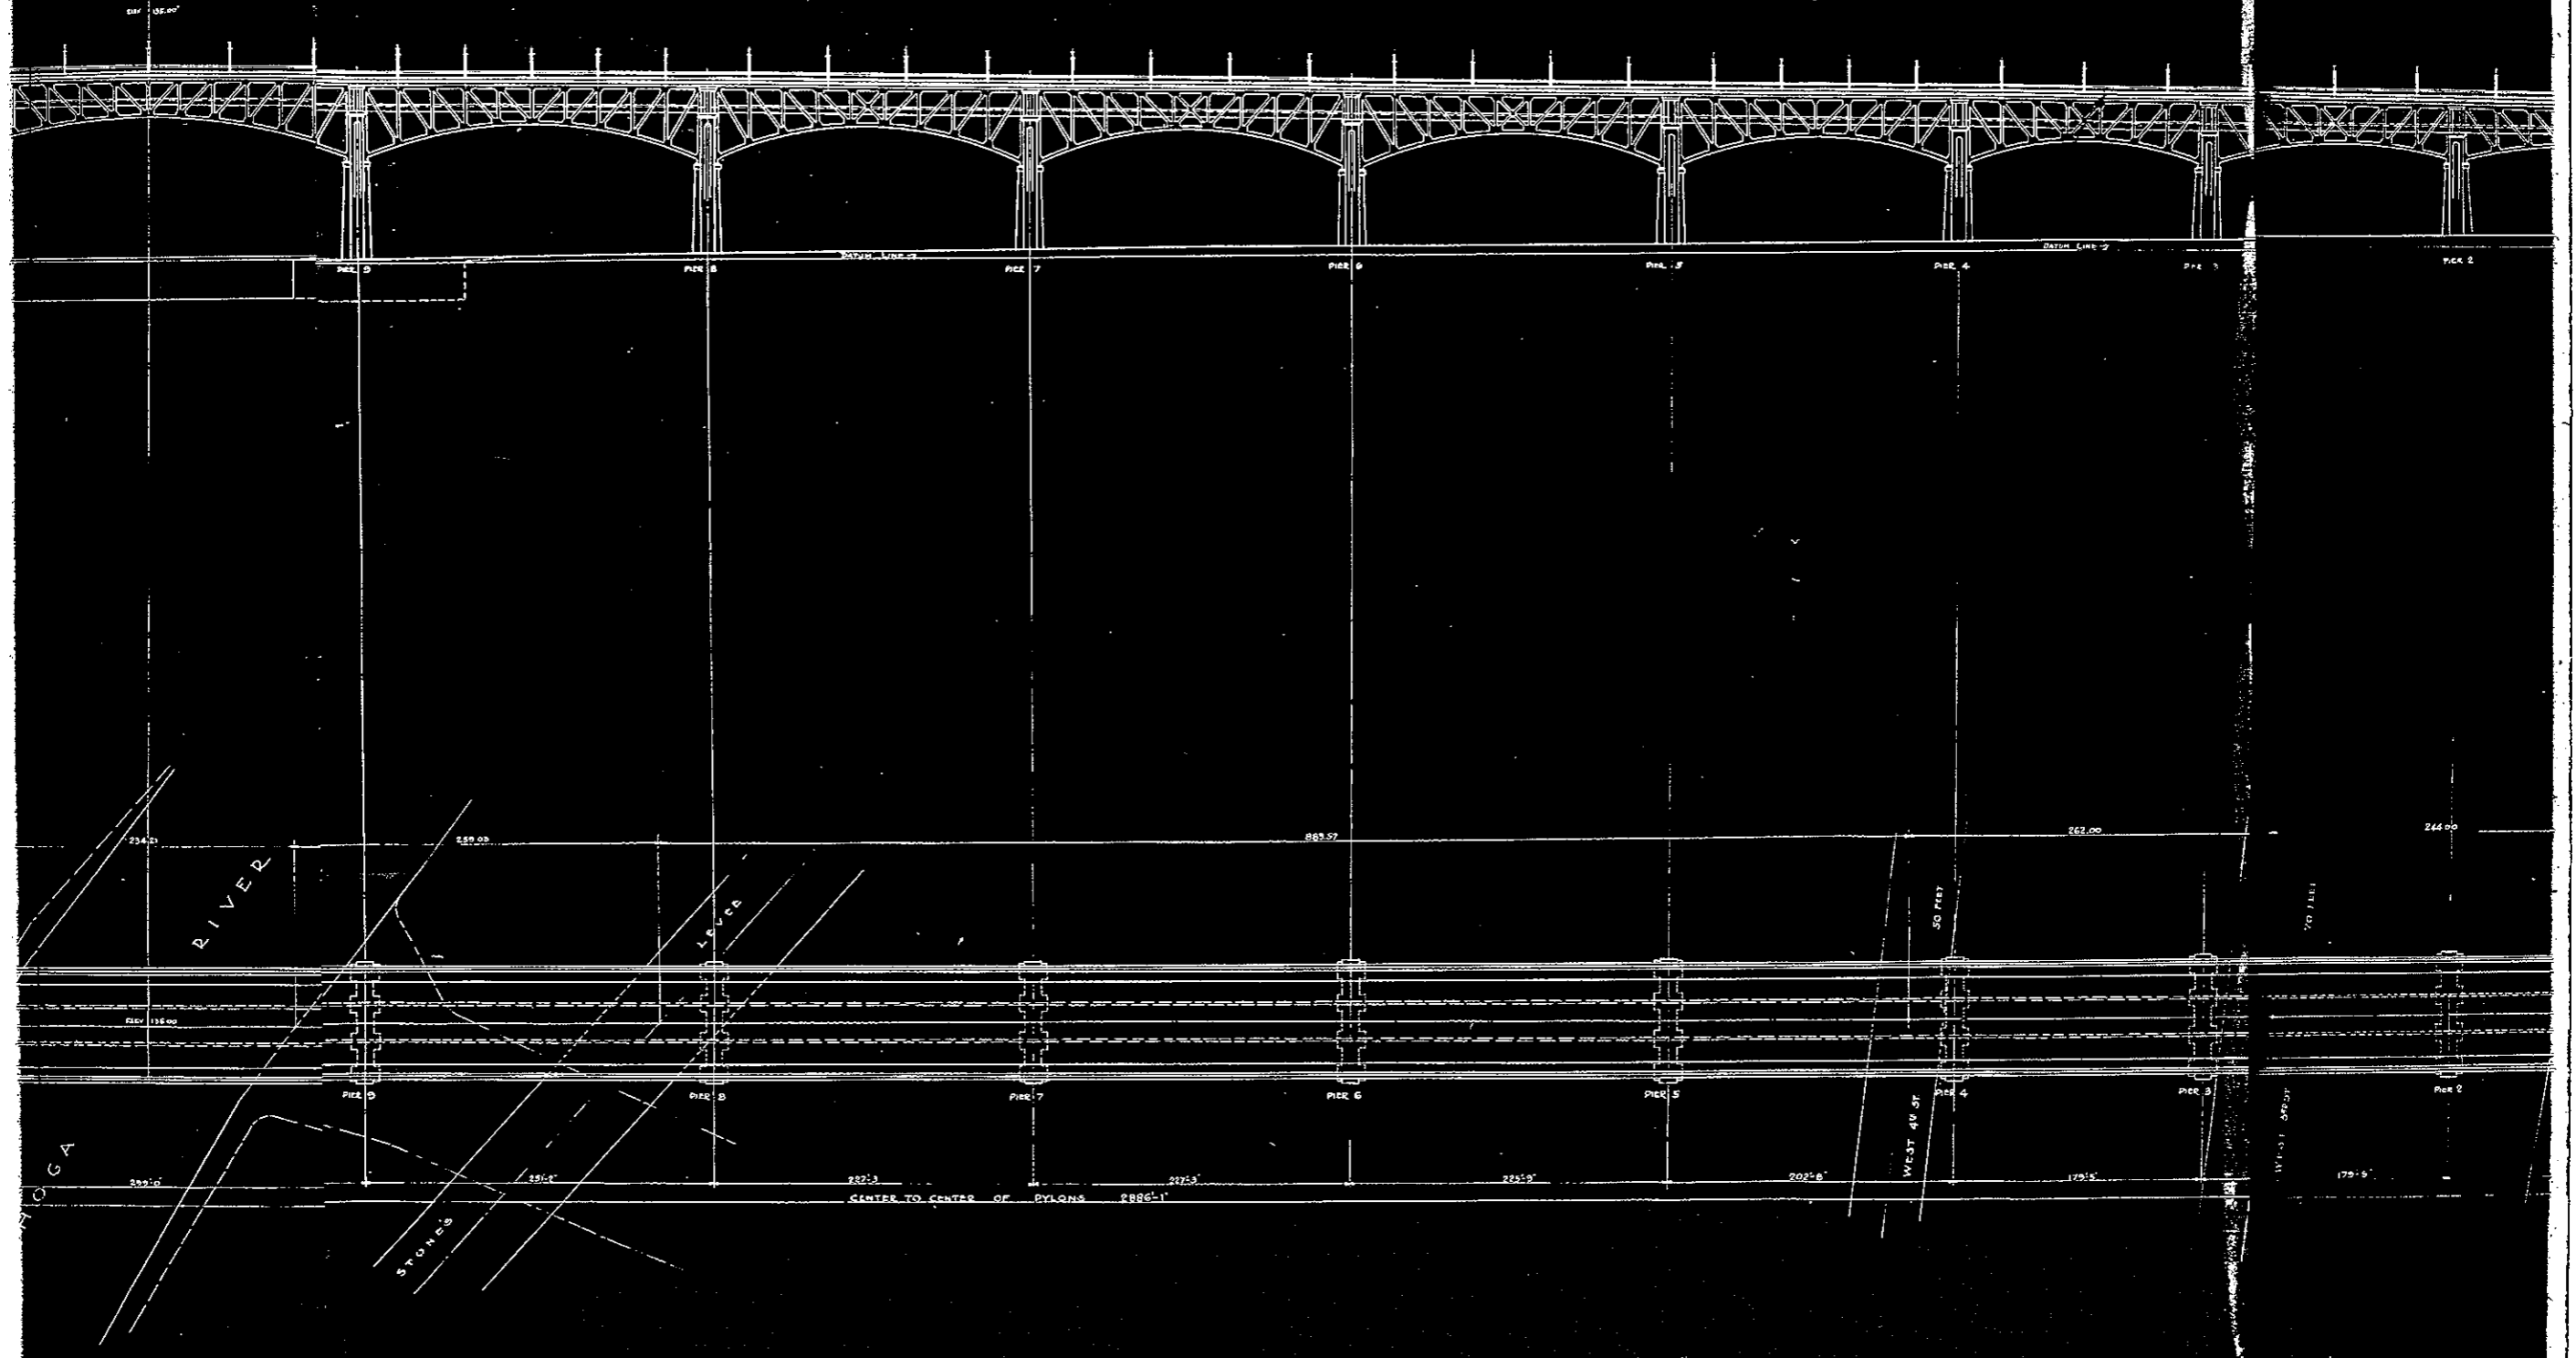

SFN 1801503

MICROFILMED
OCT 6 1987

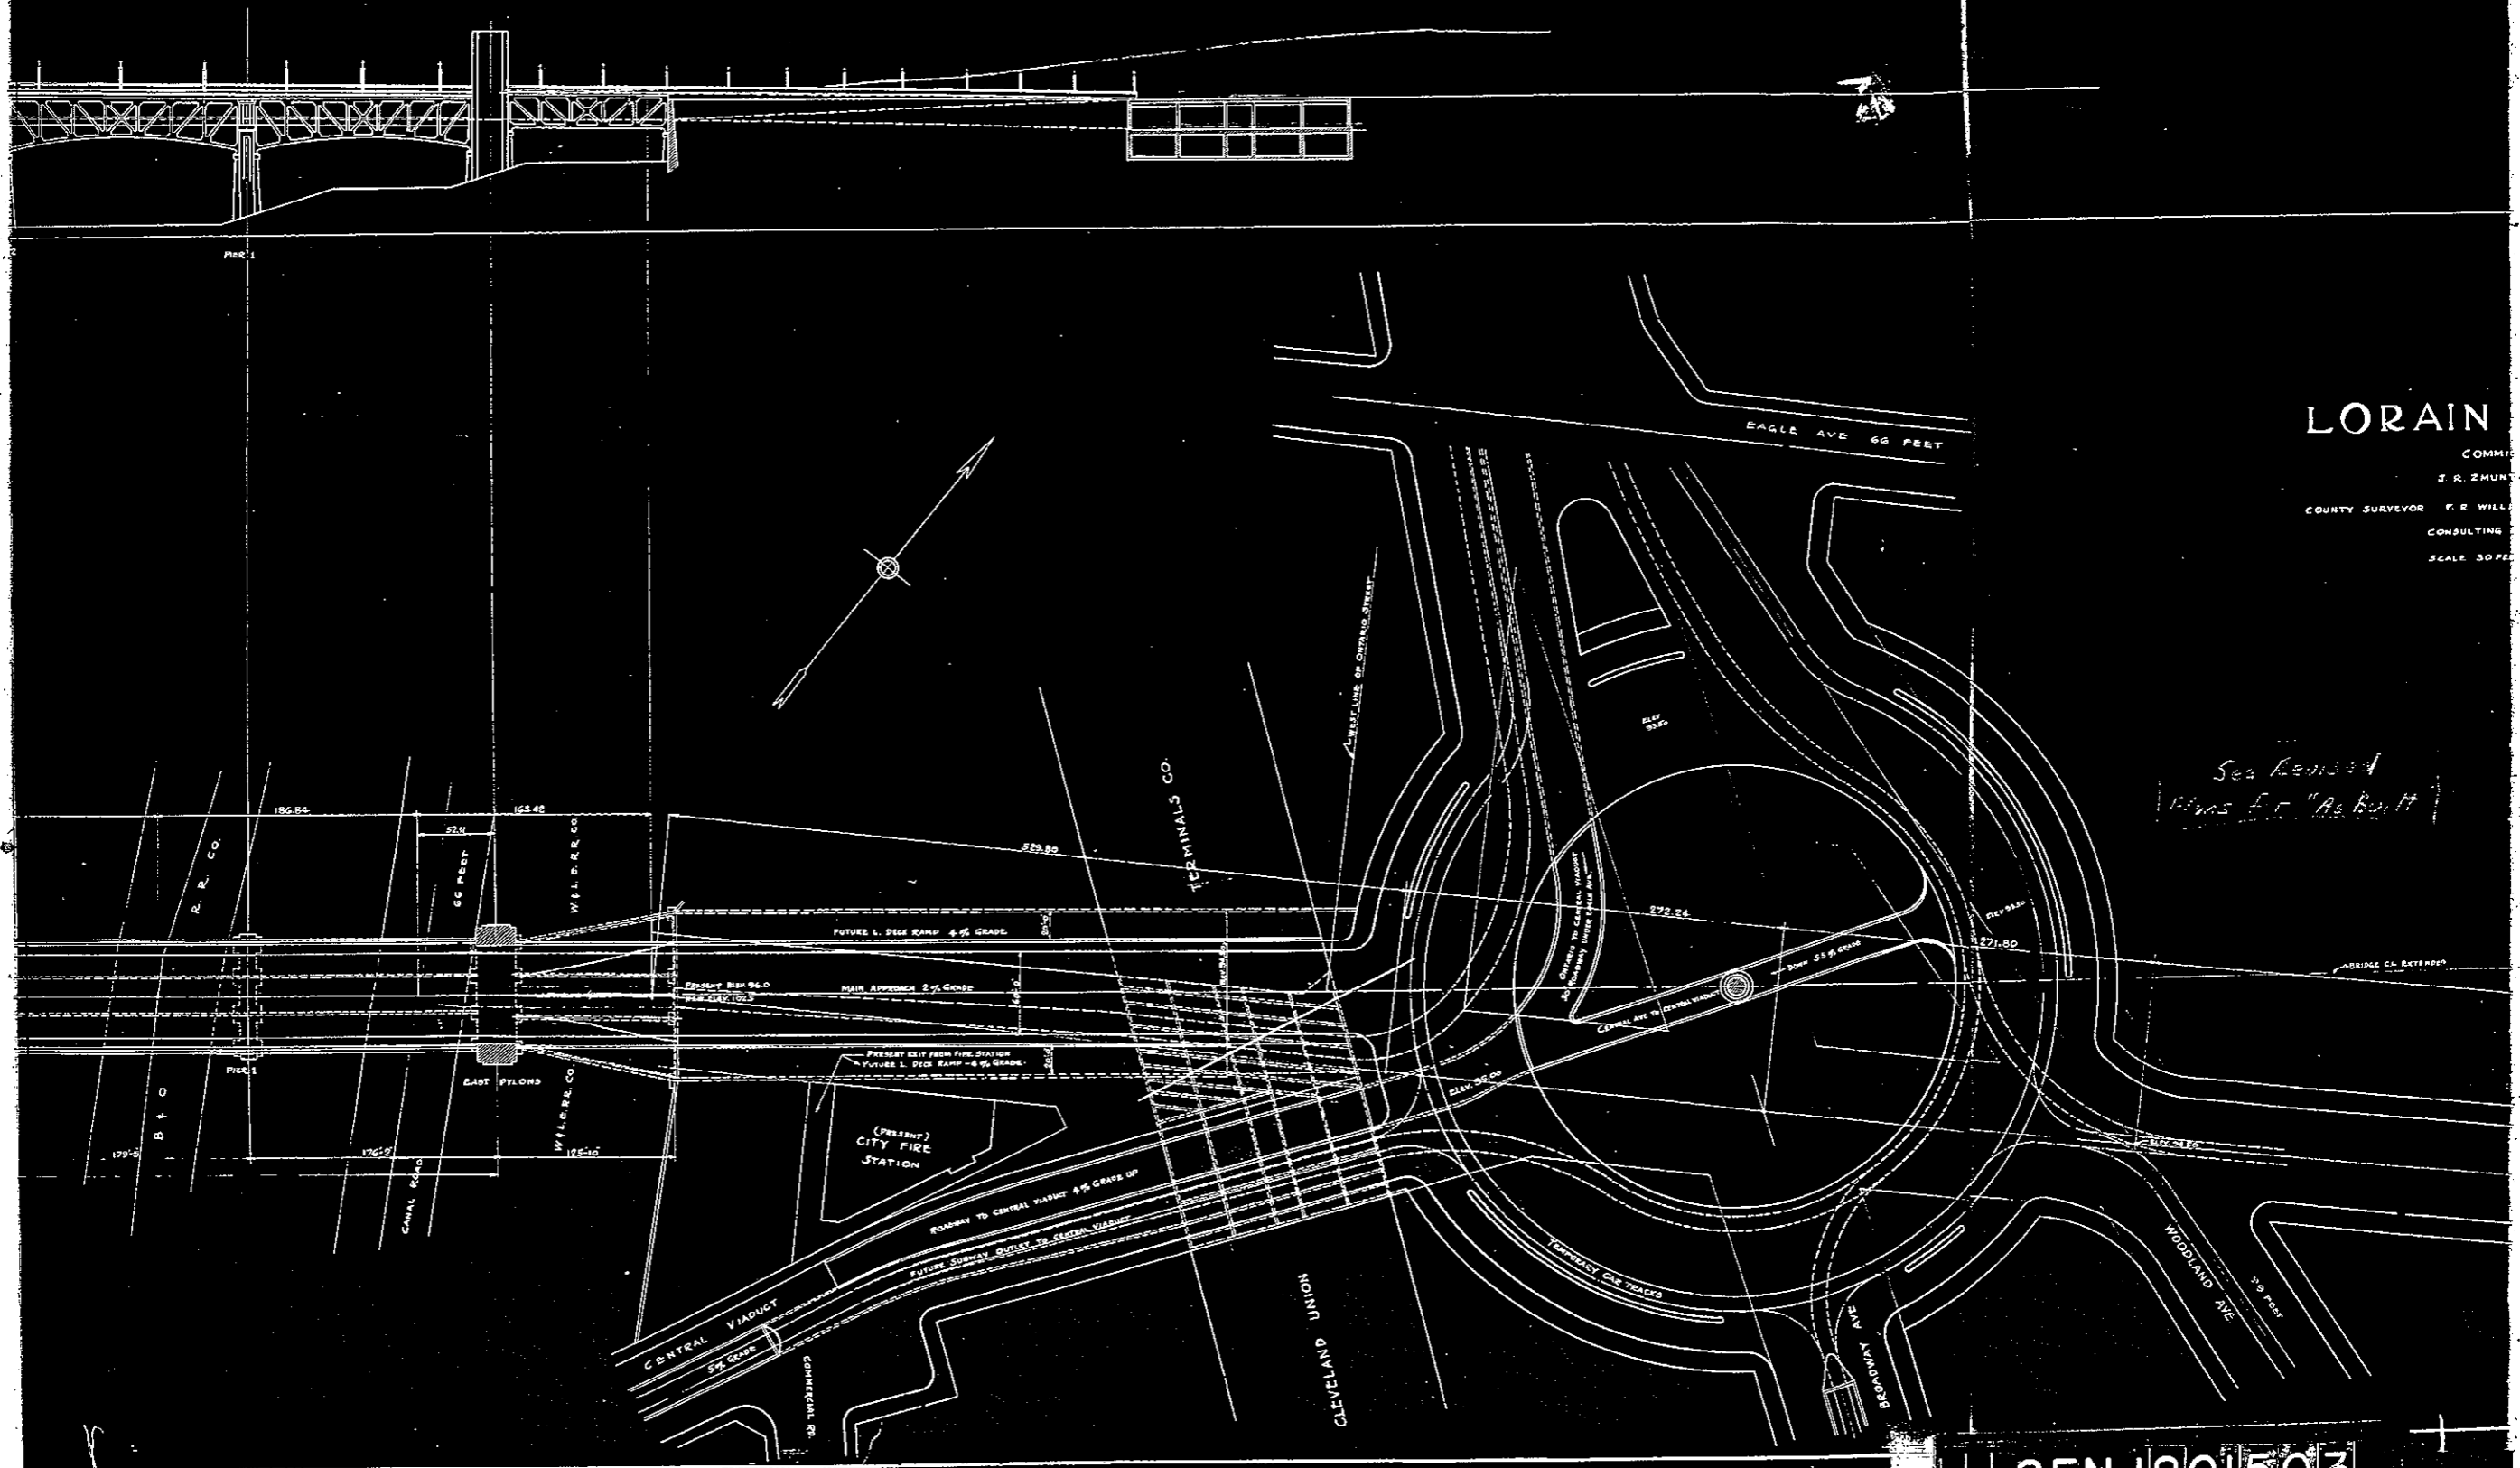


LORAIN

COMM. ...
J. R. ZMUNT ...
COUNTY SURVEYOR F. R. WILL ...
CONSULTING ...
SCALE 30 FEET

*See Revised
Plans For "As Built"*

SFN 1801503

MICROFILMED
OCT 6 1987

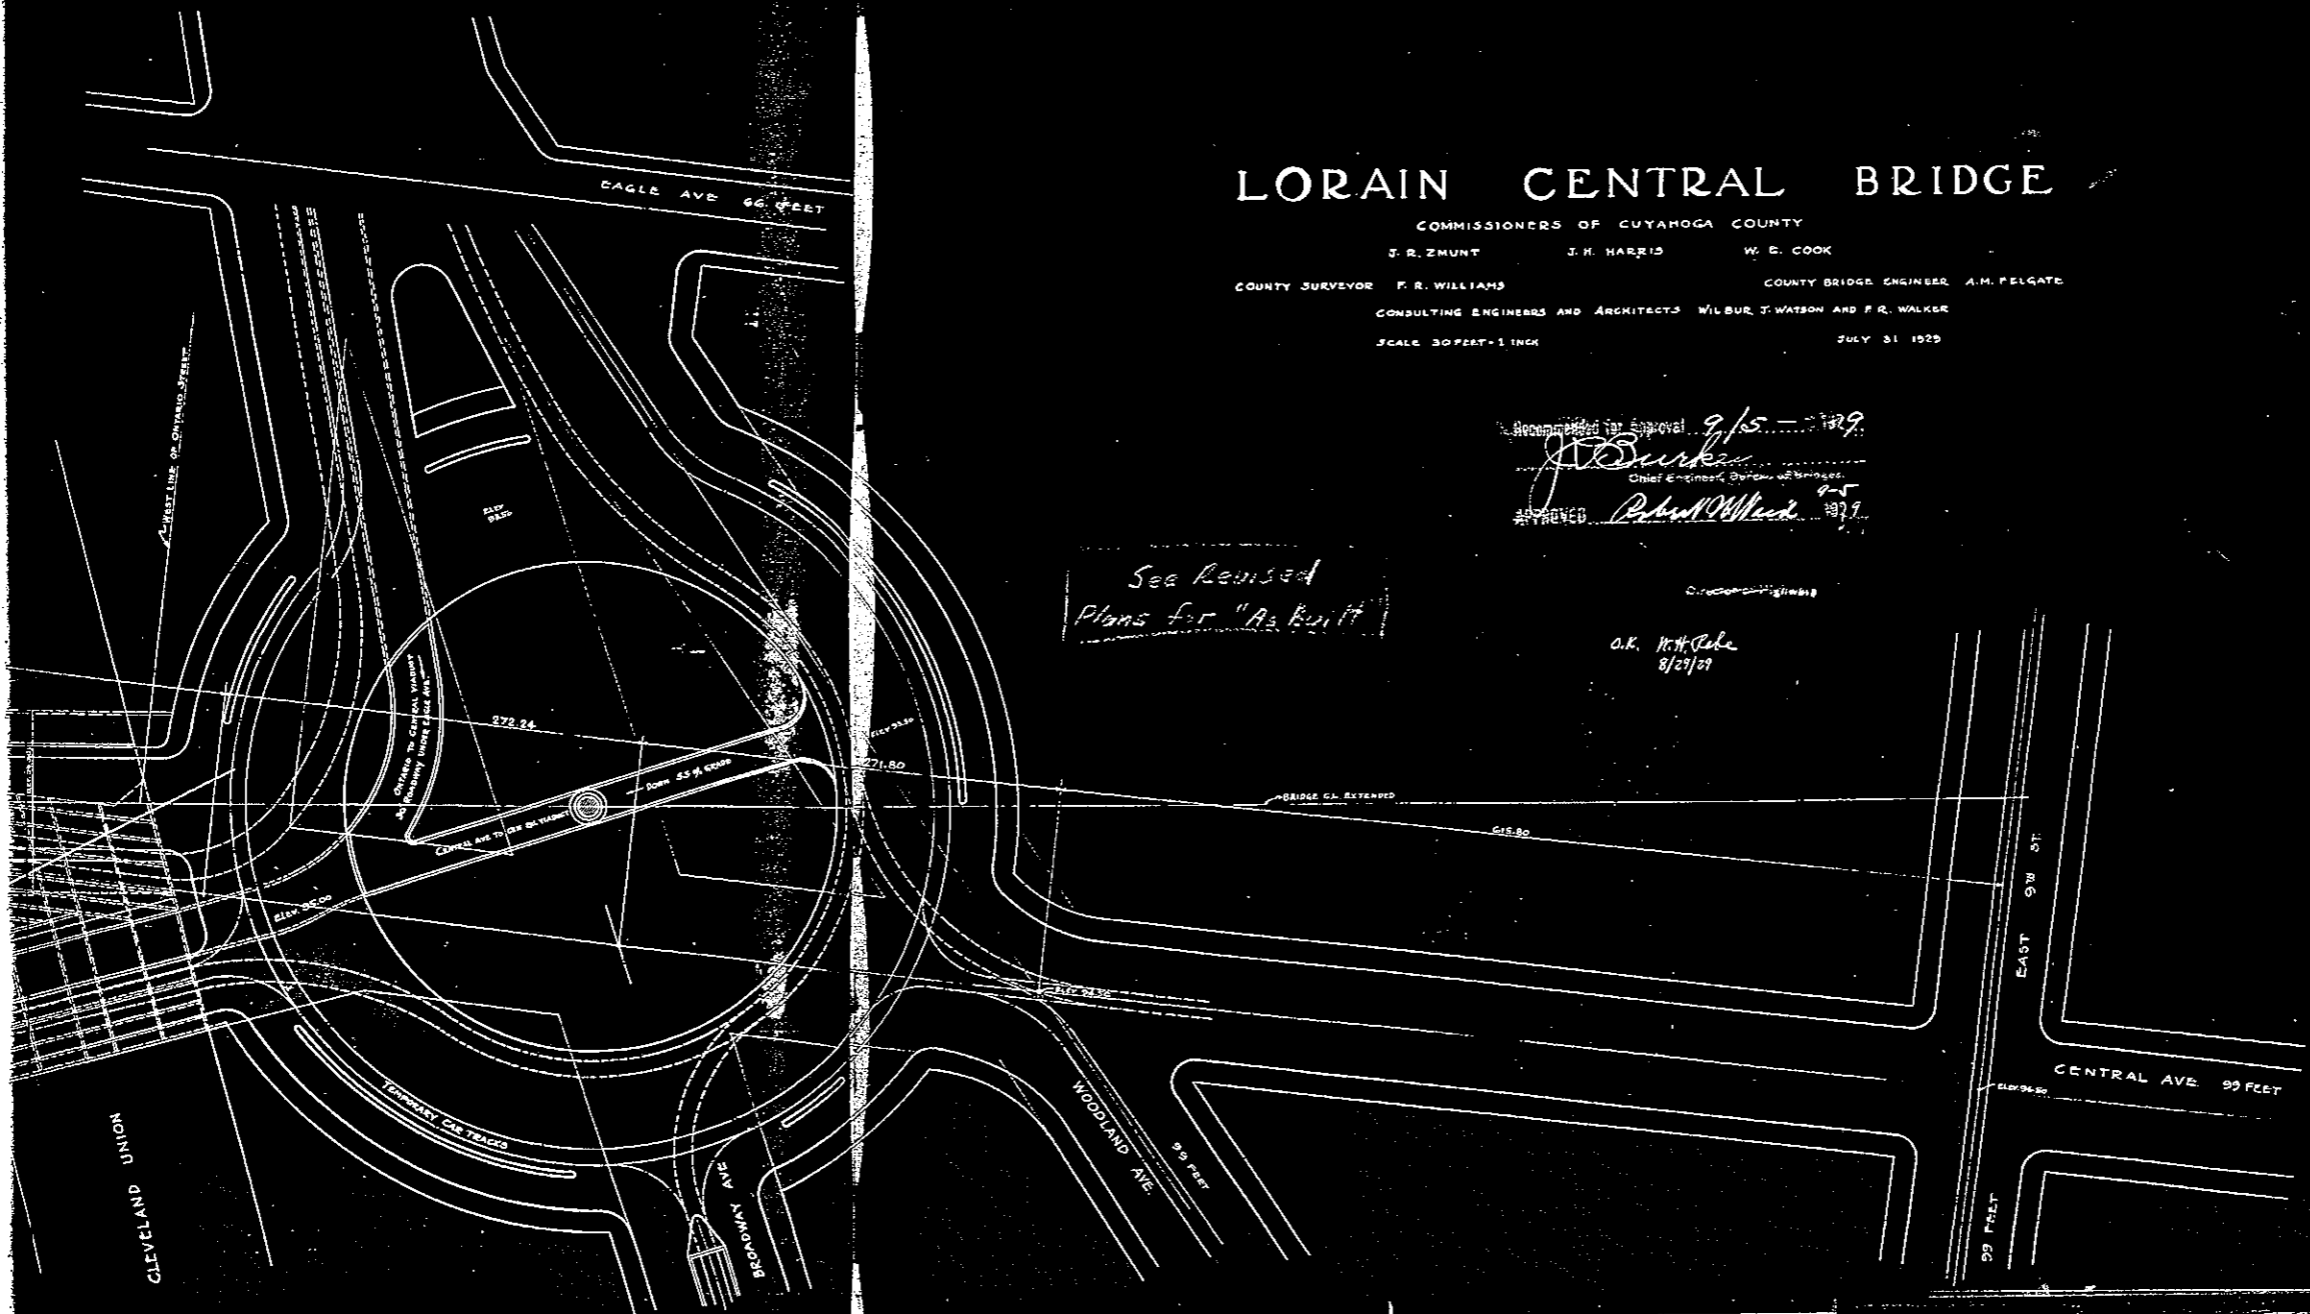

LORAIN CENTRAL BRIDGE

COMMISSIONERS OF CUYAHOGA COUNTY

J. R. ZMUNT J. H. HARRIS W. E. COOK

COUNTY SURVEYOR F. R. WILLIAMS COUNTY BRIDGE ENGINEER A. M. FELGATE

CONSULTING ENGINEERS AND ARCHITECTS WILBUR J. WATSON AND F. R. WALKER

SCALE 30 FEET = 1 INCH JULY 31 1929





Recommended for Approval 9/15 - 1929
J. D. Durkin
Chief Engineer, Division of Highways
APPROVED *Robert M. Wood* 9-5-29

See Revised
Plans for "As Built"

O.K. *W. H. Cole*
8/27/29

SFN 1801503

22
17
11
8.5
8.5
11
17
22

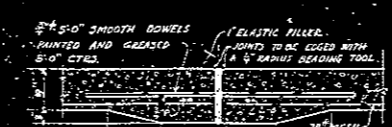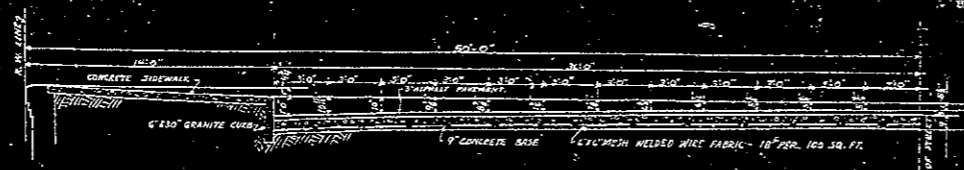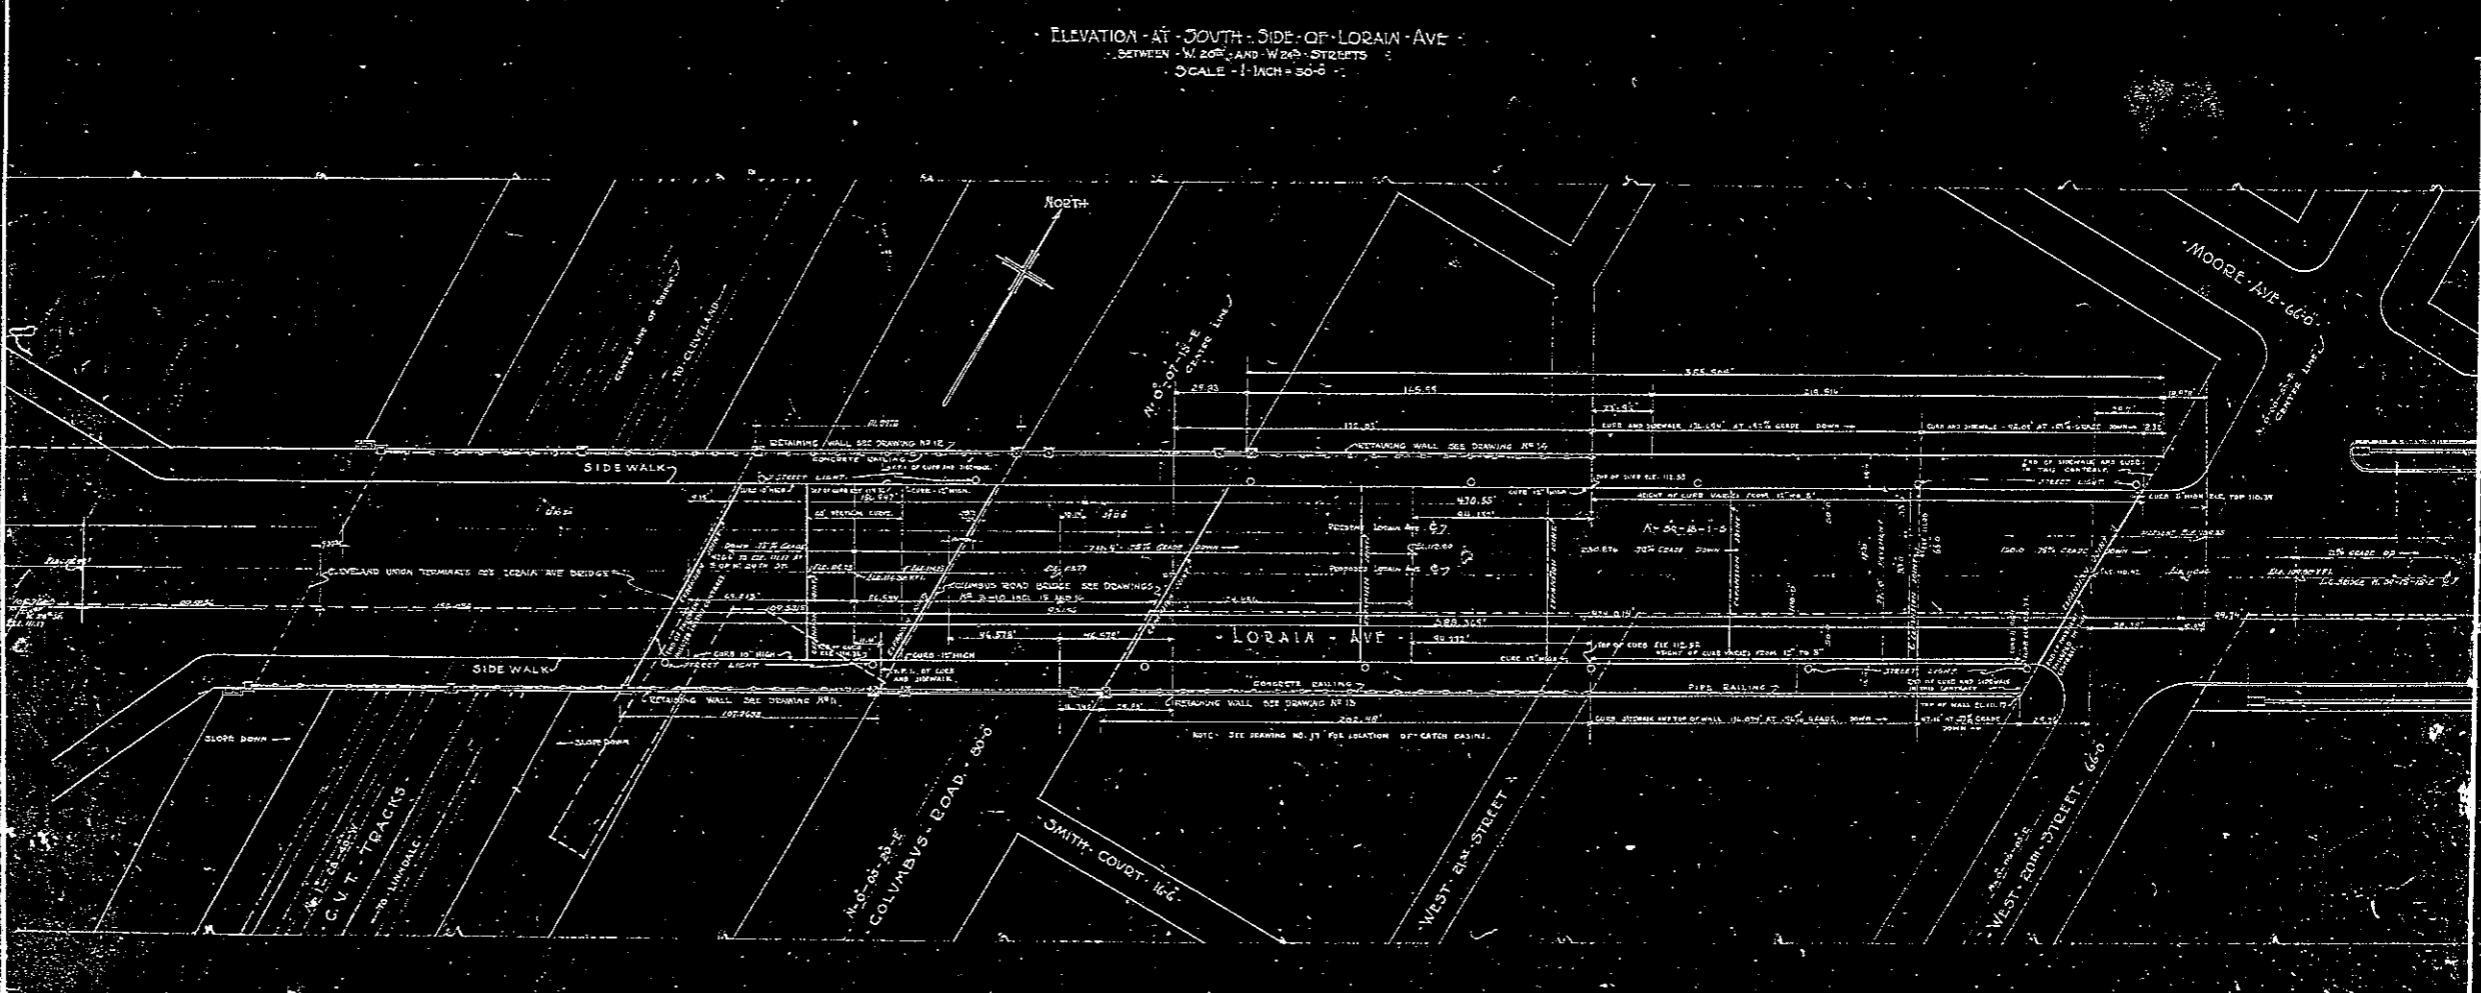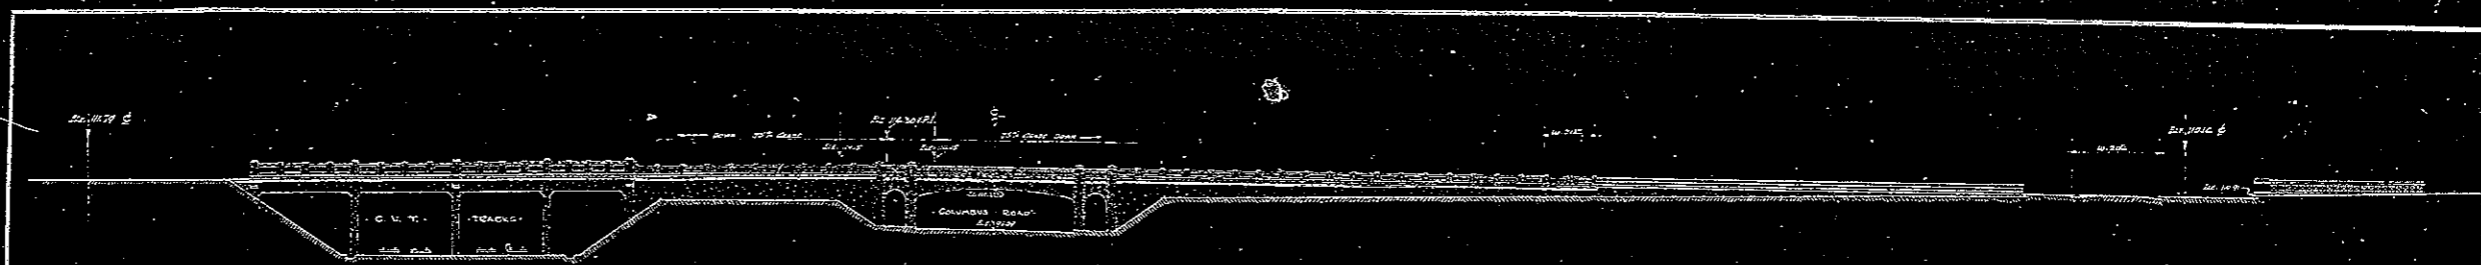

APPROVED BY
CITY ENG.
CO. COMM.
ENR.
AUDITOR
CO. SEC.
BRIDGE
TAG.

CUYAHOGA COUNTY	
BOARD OF COMMISSIONERS W. E. COOK J. H. HARRIS J. F. GORMAN	COUNTY SURVEYOR F. R. WILLIAMS COUNTY BRIDGE ENGINEER A. M. FELGATE
LORAIN CENTRAL BRIDGE COLUMBUS ROAD GRADE ELIMINATION CLEVELAND	
LOCATION PLAN WITH ELEVATION ALONG LORAIN AVE	
SCALE	4371
DESIGNED BY WILBUR WATSON AND ASSOCIATES CONSULTING ARCHITECTS & ENGINEERS CLEVELAND	DRAWN BY C. G. P. W. S. K.
CHECKED BY C. G. P. W. S. K.	DATE
APPROVED BY C. G. P. W. S. K.	DATE

SFN 1801503

22
17
11
8.5
5.8
2.7

SOUTH SIDE



APPROVED BY
Wm. E. Cook
 CO. COMM. *Wm. E. Cook*
 CO. AUDITOR *Wm. E. Cook*
 CO. ENG. *Wm. E. Cook*
 BRIDGE ENG. *Wm. E. Cook*

CUYAHOGA COUNTY
 BOARD OF COMMISSIONERS
 J. R. ZMUNT
 J. H. HARRIS
 W. E. COOK

COUNTY SURVEYOR
 F. R. WILLIAMS
 COUNTY BRIDGE ENGINEER
 A. M. PELGATE


LORAIN CENTRAL BRIDGE
 CLEVELAND

TYPICAL CROSS SECTION AT PIERS
 SCALE: 1/4" = 1'-0"

FILE NO. 4237
 DRAWING TITLE: LORAIN CENTRAL BRIDGE
 DRAWING NO. 3
 SHEET NO. 3

SFN 1801503

22"
17"
11"
8.5"
11"
17"
22"

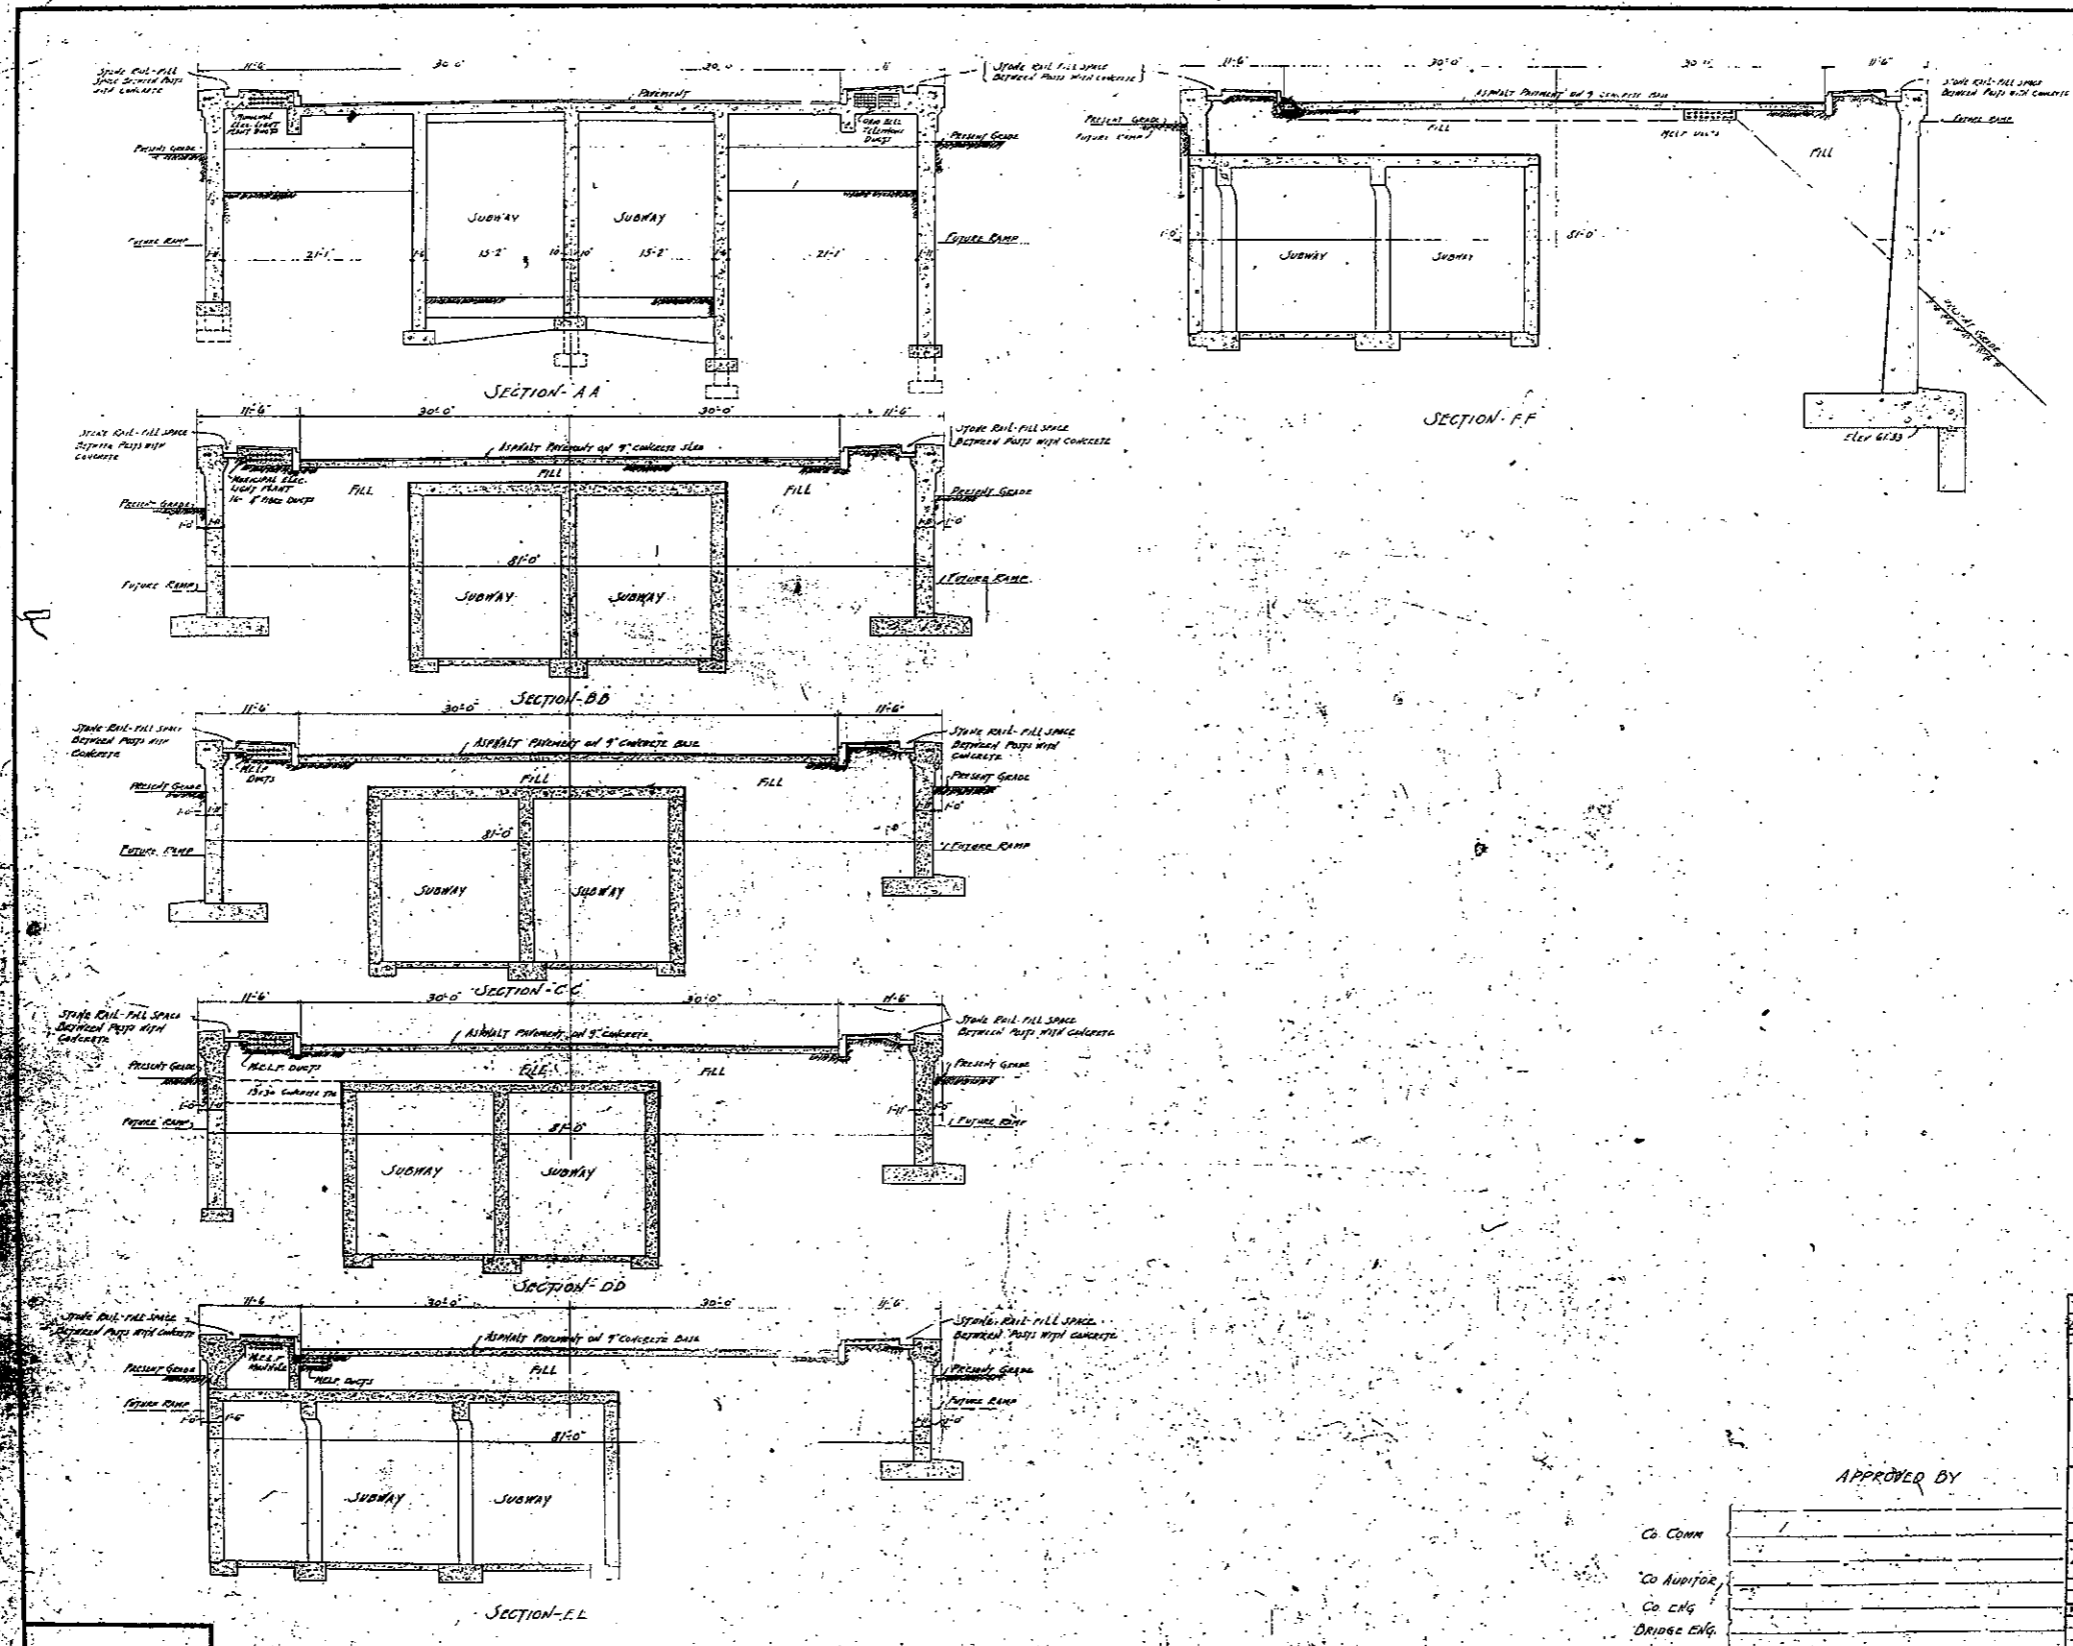

NOTE: FOR LOCATIONS OF SECTIONS SEE DRG. 412



CO. COMM.
CO. AUDITOR
CO. ENG.
BRIDGE ENG.

APPROVED BY

CUYAHOGA COUNTY	
BOARD OF COMMISSIONERS	COUNTY SURVEYOR
J. R. ZMUNT	F. R. WILLIAMS
J. H. HARRIS	COUNTY BRIDGE ENGINEER
W. E. COOK	A. H. FELGATE
LORAIN CENTRAL BRIDGE CLEVELAND	
EAST APPROACH CROSS SECTIONS	
SCALE 1/4" = 1'-0"	DATE 7-17-30
FILE NO. 4366	DRAWN BY WILBUR WATSON AND FRANK WALKER
	CONSULTING ENGINEERS AND ARCHITECTS
	CLEVELAND
REV. BY DATE	REV. BY DATE

SFN 1801503

22
17
11
9.8
8.5
11
17
22

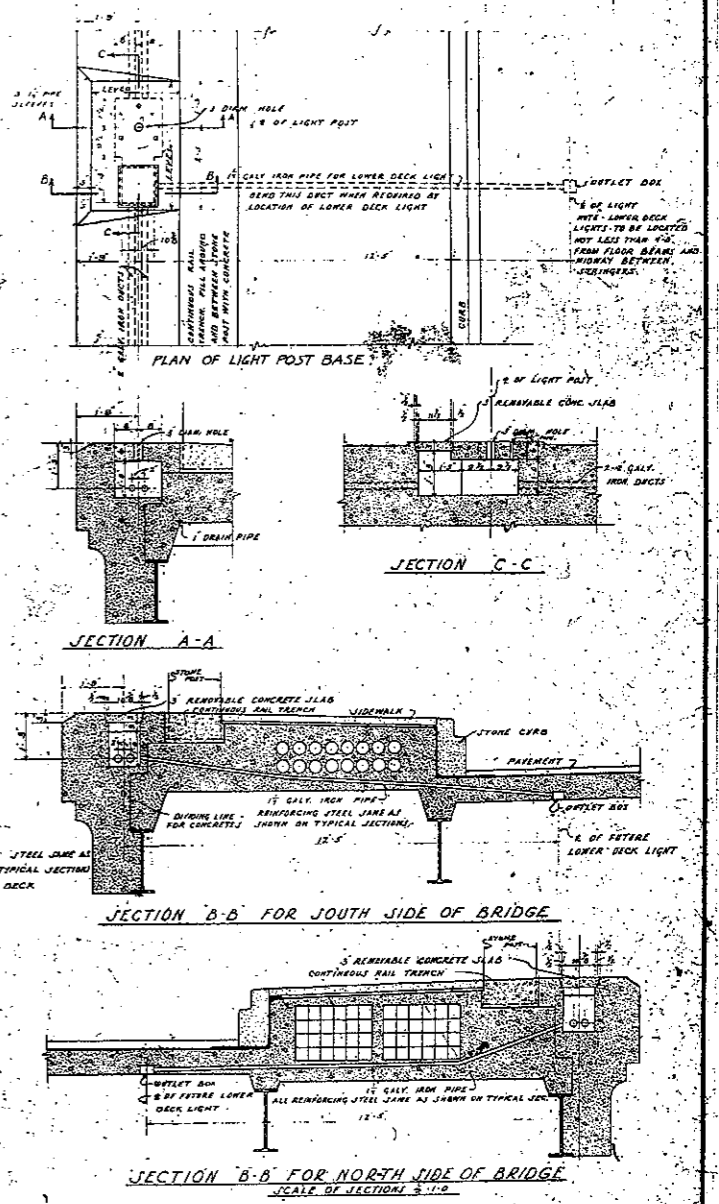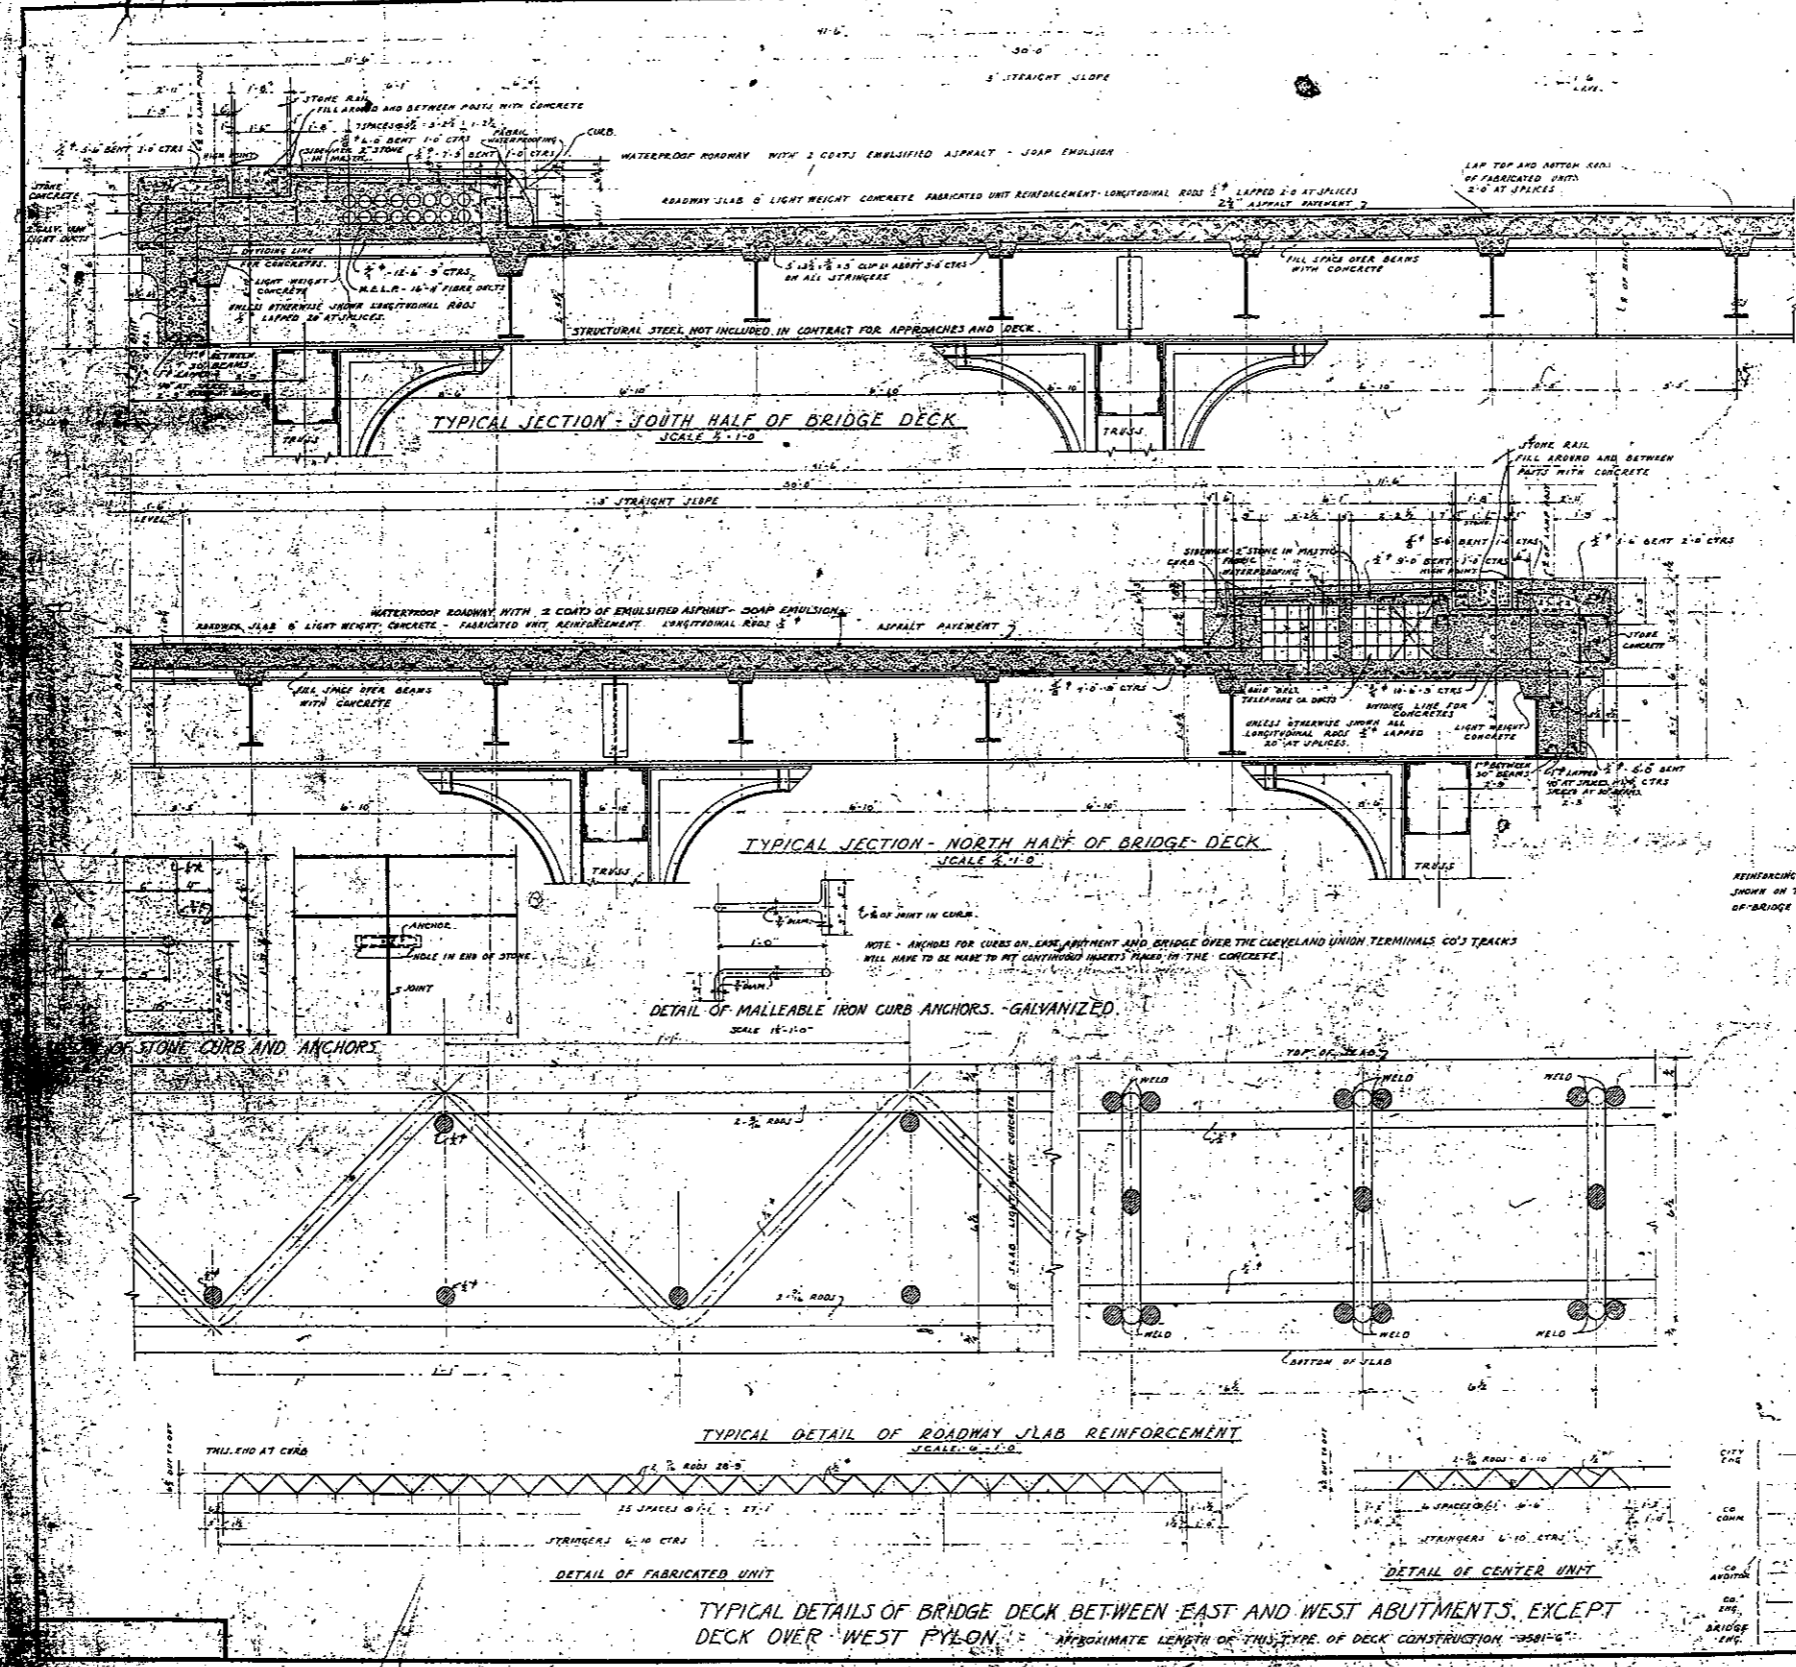

APPROVED BY

CITY ENGINEER

CO. COMM.

CO. ARCHT.

CO. ENG.

BRIDGE ENG.

CUYAHOGA COUNTY	
BOARD OF COMMISSIONERS	COUNTY SURVEYOR
J. R. ZIMMERT	F. R. WILLIAMS
J. H. HARRIS	COUNTY BRIDGE ENGINEER
H. E. COOK	A. M. FELGATE

LORAIN CENTRAL BRIDGE
CLEVELAND

TYPICAL SECTIONS OF DECK CONSTRUCTION


SCALE 3/4" = 1'-0" AND 3/8" = 1'-0"

FILE NO. 4366


WILBUR WATSON AND F. R. WALKER
CONSULTING ENGINEERS AND ARCHITECTS
CLEVELAND

DRAWING NO. 31


DATE	BY	REVISION

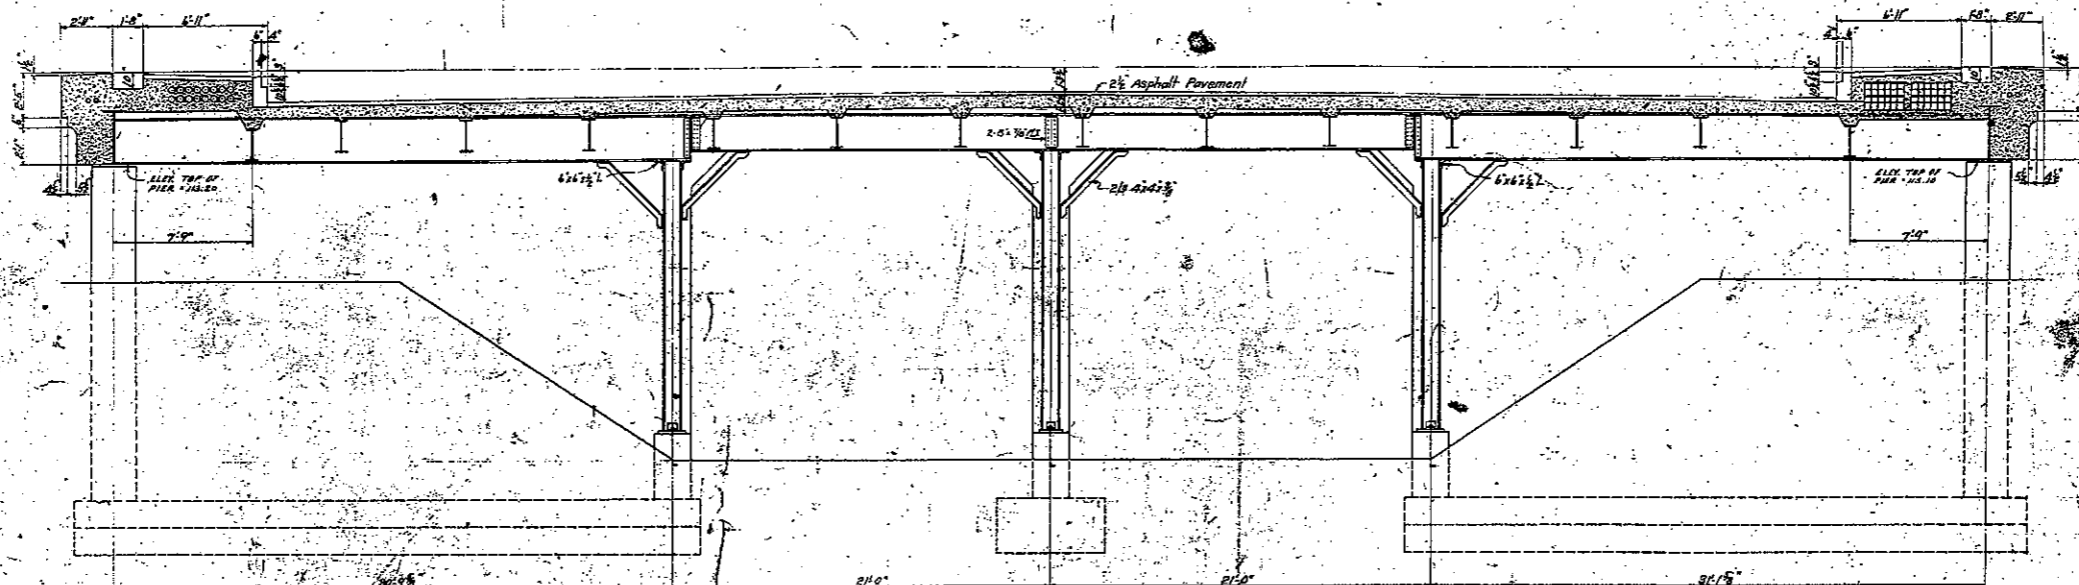

CROSS SECTION X-X

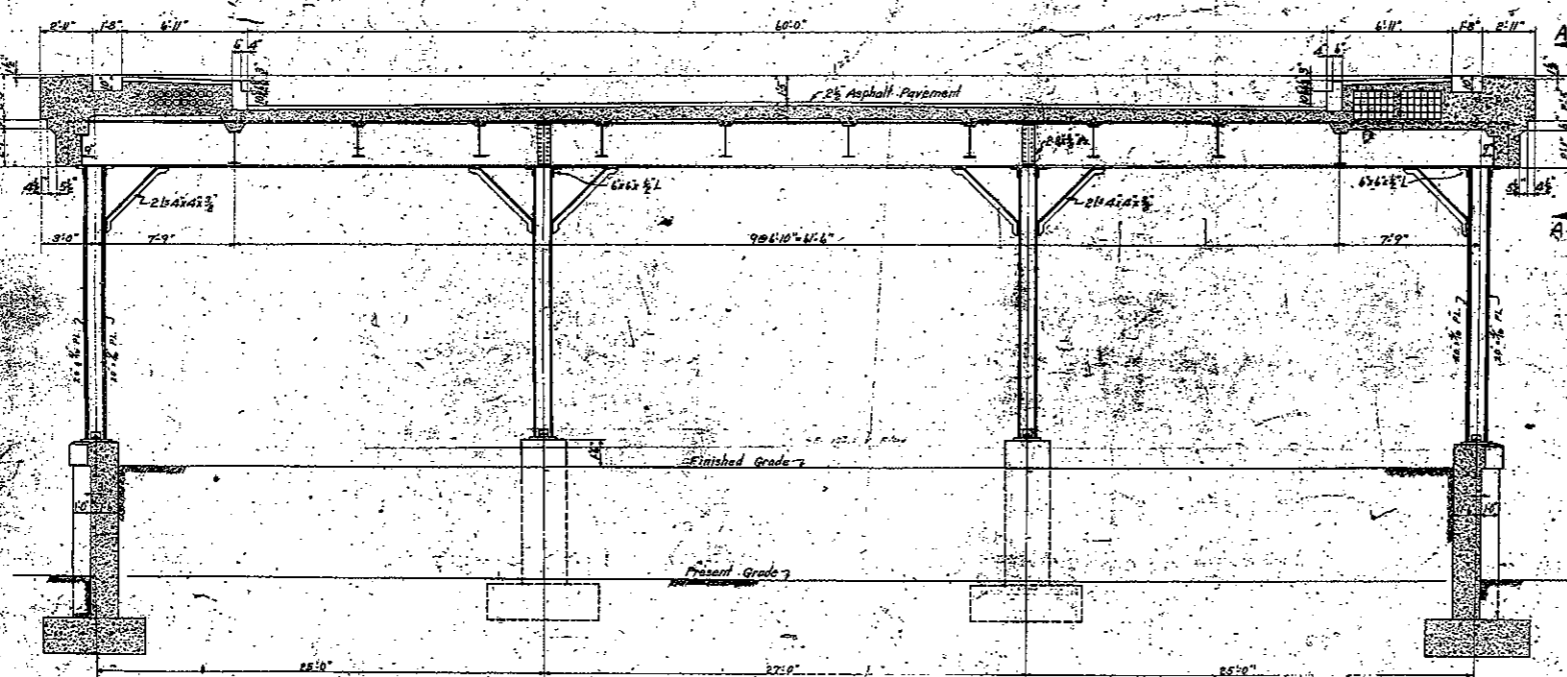

CROSS SECTION Y-Y

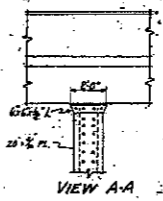

VIEW A-A

APPROVED BY

CITY ENG. *[Signature]*

CO. COMM. *[Signature]*

CO. ADJUT. *[Signature]*

CO. ENG. *[Signature]*

BRIDGE ENG. *[Signature]*

CUYAHOGA COUNTY
 BOARD OF COMMISSIONERS: J. R. ZIMMUT, J. H. HARRIS, W. E. COOK
 COUNTY SURVEYOR: T. R. WILLIAMS
 COUNTY BRIDGE ENGINEER: A. W. PELGATE

LORAIN CENTRAL BRIDGE
 CLEVELAND.

CROSS SECTIONS
 WEST APPROACH

SCALE: 1/4" = 1'-0"

DATE: 12-22-20

PROJECT: 123456

NO. 1234

WILBIE WATSON AND F. WALKER
 CONSULTING ENGINEERS AND ARCHITECTS
 CLEVELAND

SFN 1801503

22"

17"

11"

8.5"

8.5"

11"

17"

22"

22"

17"

11"



8.5"

8.5"

11"

17"

22"

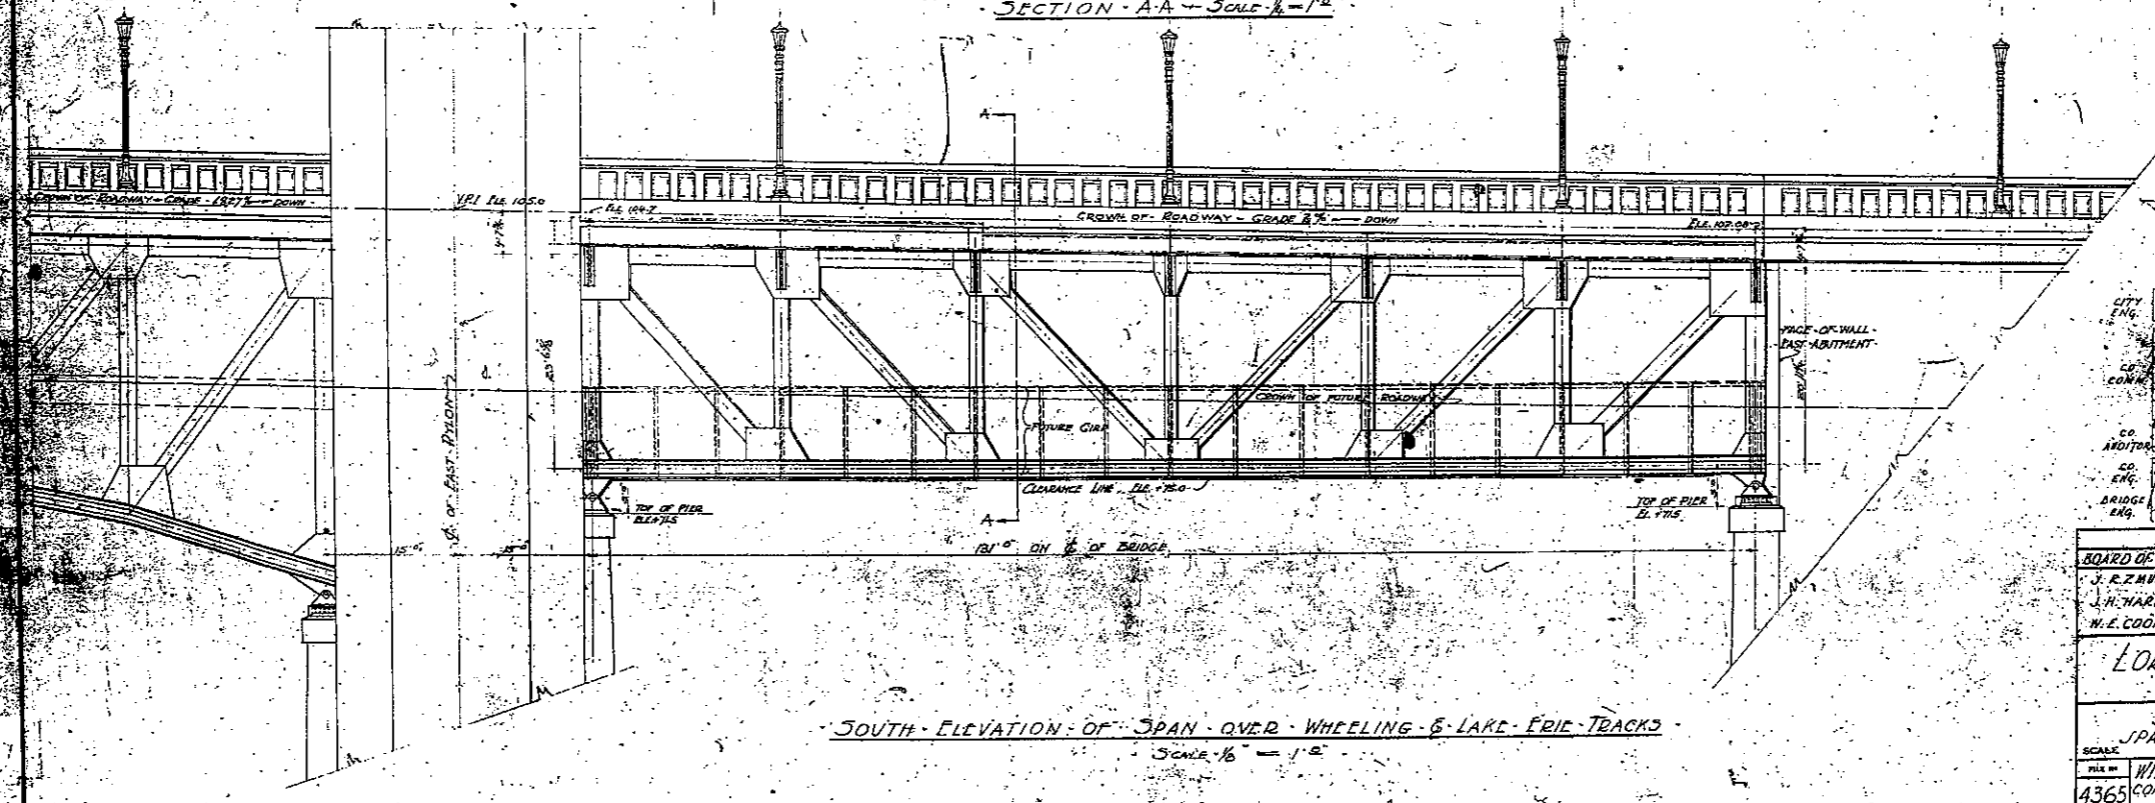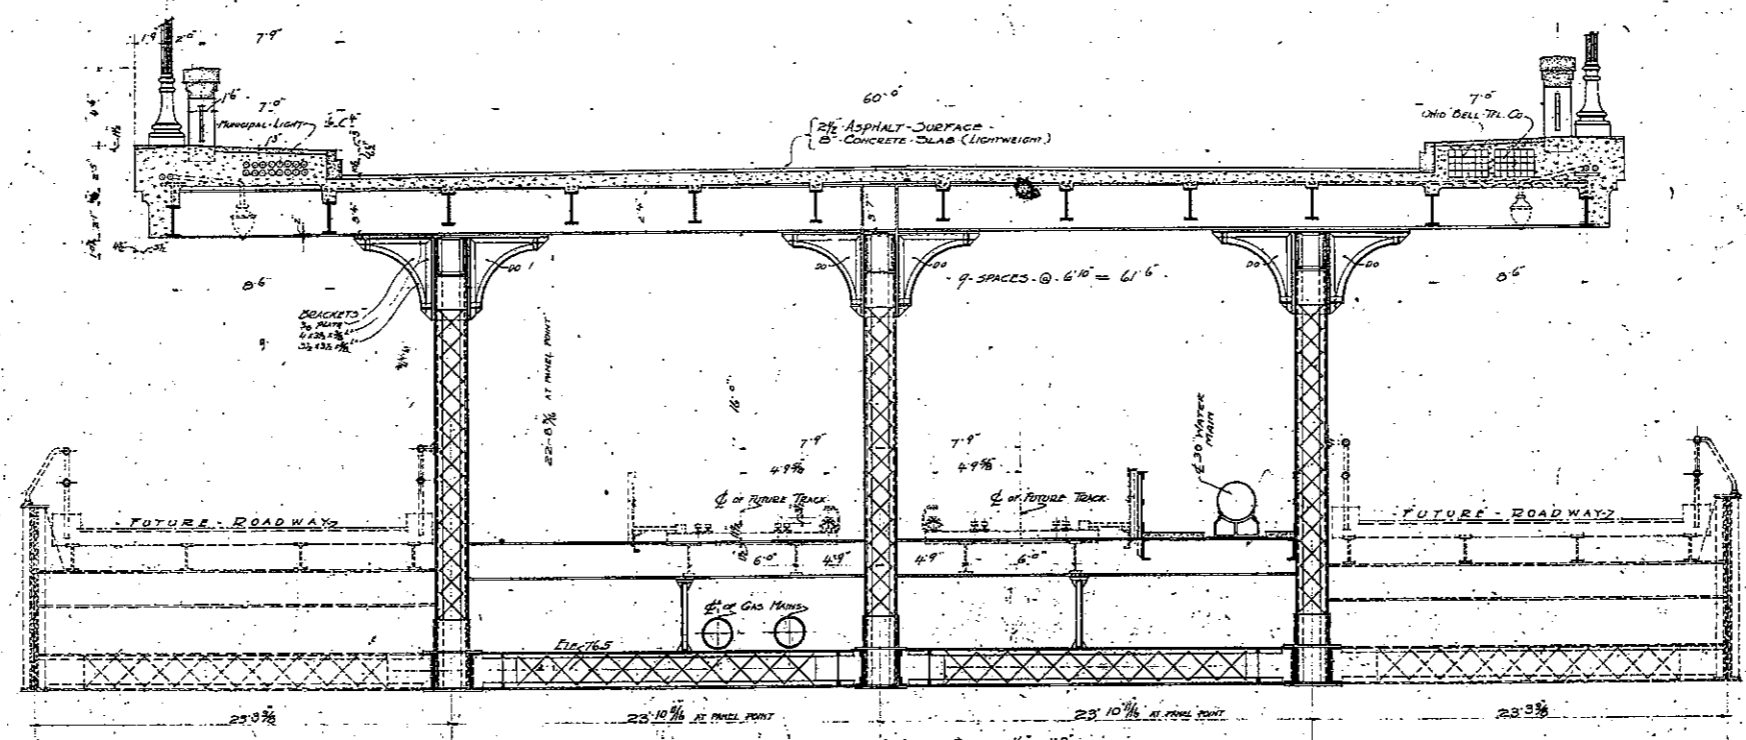

APPROVED BY

CITY ENG. *[Signature]*

CO. COMM. *[Signature]*

CO. AUDITOR *[Signature]*

CO. ENGR. *[Signature]*

BRIDGE ENGR. *[Signature]*

CUYAHOGA COUNTY

BOARD OF COMMISSIONERS

J. R. MINT

J. H. HARRIS

W. E. COOK

COUNTY SURVEYOR

E. WILLIAMS

COUNTY BRIDGE ENGINEER

A. M. FELGATE

LORAIN CENTRAL BRIDGE

CLEVELAND

SECTION & ELEVATION

SPAN OVER W. & L. E. TRACKS

SCALE	FILE NO.	DATE	BY	CHECKED BY	DATE
1/8" = 1'	4365	6-7-35	W.B.W.	F.W.W.	6-24-35
DRAWING MADE BY: W.B.W. CHECKED BY: F.W.W. DATE: 6-24-35					
DESIGNED BY: W.B.W. CHECKED BY: F.W.W. DATE: 6-24-35					
CONSTRUCTED BY: [Blank] CHECKED BY: [Blank] DATE: [Blank]					

SFN 1801503

22"

17"

11"

8.5"

8.5"

11"

17"

22"

22"

17"

11"


8.5"

8.5"

11"

17"

22"

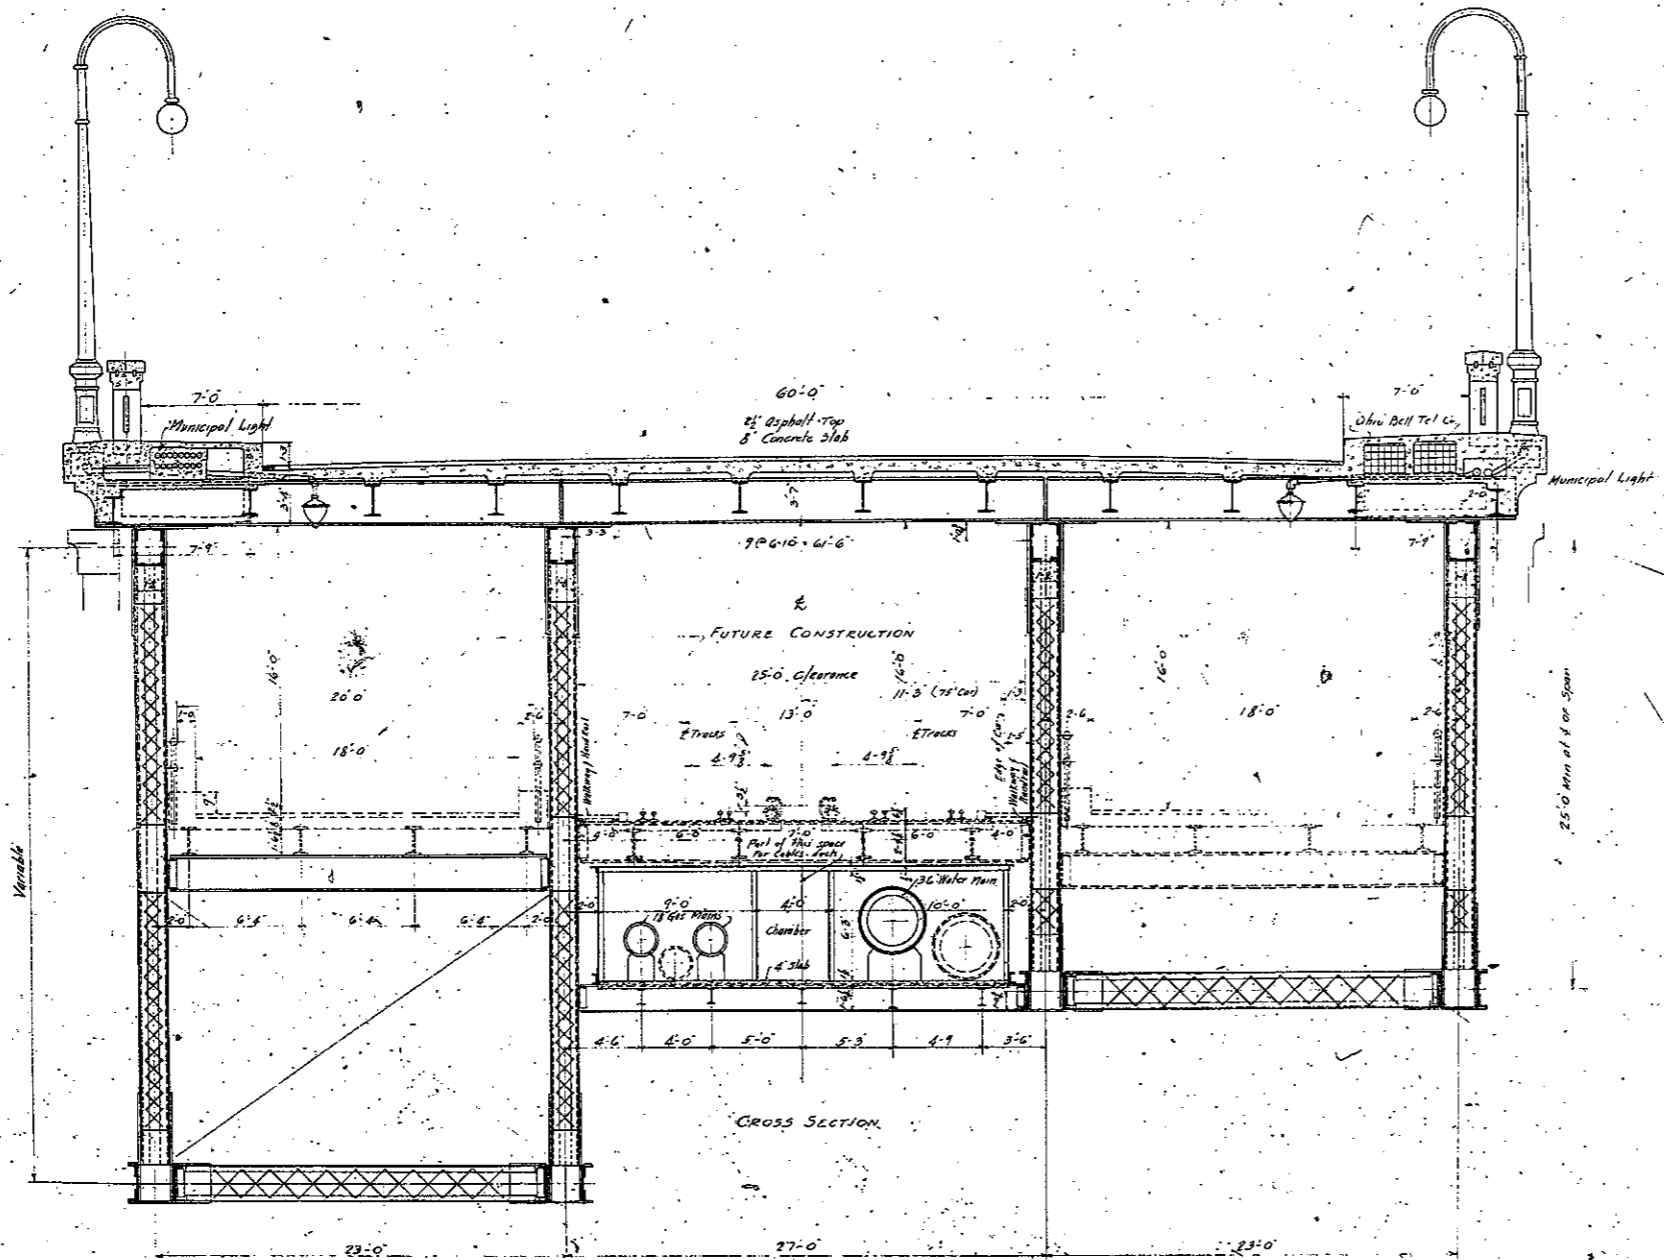

APPROVED BY -

CUYAHOGA COUNTY	
BOARD OF COMMISSIONERS J. R. MUMF J. H. HARRIS W. E. LOON	COUNTY SURVEYOR F. R. WILLIAMS COUNTY BRIDGE ENGINEER A. M. FELGATE
LORAIN CENTRAL BRIDGE CLEVELAND	
TYPICAL CROSS SECTION SCALE 1/4" = 1 FT	
DRAWING NO. 4237	DRAWING BY WILBUR WATSON AND F. R. WALKER CONSULTING ENGINEERS AND ARCHITECTS CLEVELAND
DESIGNED BY B. S. J.	CHECKED BY E. S. J.
DATE 8-27-19	DATE 8-27-19

SFN 1801503

17"

17"

11"

11"

8.5"

8.5"

8.5"

8.5"

11"

11"

17"

17"

WILBUR WATSON AND ASSOCIATES, CLEVELAND, OHIO

LORAIN-CENTRAL BRIDGE

July 12, 1929

LOADS AND STRESSES FOR FINAL DESIGN

The following loads and unit stresses will be used in final designs for the proposed Lorain-Central Bridge:

LOADS

ROADWAY:

The roadway slab shall be designed to carry 20 ton trucks with 50% impact distributed according to the Ohio State Specifications for Highway Bridges. The highway stringers shall be designed for 20 ton trucks with 25% impact. The floor beams and their immediate supports for the roadway shall be designed for 20 ton trucks with 25% impact. Use Haydite concrete or equivalent for weight.

The Ohio State Specifications shall also be followed for the distribution of loads to stringers and floor beams. Use Silicon Steel.

RAILWAY:

The stringers carrying the railway tracks shall be designed to carry 60 ton electric cars with 50% impact and with the wheels spaced as specified in the Ohio State Specifications for B-60 loading.

The floor beams and their immediate supports shall be designed for the same load with 50% impact.

SIWALKS:

The sidewalk slab and stringers shall be designed to carry a load of 100# per square foot without impact.

RAILING:

All railing shall be designed to carry a vertical load of 100# per lineal foot and a horizontal load of 150# per lineal foot.

TRUSSES & SUB-STRUCTURE:

The trusses and sub-structure shall be designed to carry the following loads without impact:

- 60# per square foot on sidewalks.
- 60# per square foot on roadways, which corresponds approximately to a congested loading of 15 ton trucks.
- 15,000# per lineal foot on electric railway tracks.

SFN 1801503

17"

17"

11"

11"

5.8"

5.8"

8.5"

8.5"

11"

11"

17"

17"

WIND LOADS:
 All trusses shall be designed to resist a lateral force of 500 lbs per sq ft on $\frac{1}{2}$ times the vertical projection of any truss including the floor beams and railing, and on one-half the vertical projection of each truss in excess of 500 ft. Also 200# per lineal foot on U. Upper Deck and 300# per lineal foot on the lower deck.

LONGITUDINAL FORCE:
 The structure shall be proportioned to resist a longitudinal force of 10% of the live load on the bridge, acting 4' above the floor level.

APPROACH GIRDESS:
 The plate girders in the east approach shall be designed for special loads specified elsewhere.

REVERSALS:
 Where members are subject to reversal of stresses the member shall be designed for the larger stress and the connections for the larger plus 50% of the smaller stress.

MILLED ENDS:
 In compression members 40% of the stress shall be assumed as taken by the milled ends.

SFN 1801503

11

11

11

11

5.8

5.8

8.5

8.5

11

11

17

17

- MICROFILMED -
OCT 6 1957

July 12, 1928

STRUCTURAL BEAMS AND RIVETS - STRESSES

See left of Letter Attached

	Carbon	Silicon
TENSION:		
Axial tension, structural members, net section	18,000	27,000
Rivets in tension, where permitted 50% of single shear values.		
AXIAL COMPRESSION:		
Axial compression, gross section	$\frac{18,000}{1 + \frac{1}{18000} \left(\frac{L}{r}\right)^2}$	$\frac{27,000}{1 + \frac{1}{18000} \left(\frac{L}{r}\right)^2}$
but not to exceed	15,000	22,500
<i>L</i> = unsupported length of member, in inches <i>r</i> = least radius of gyration, in inches.		
BENDING ON MEMBERS:		
Rolled shapes, built-up sections, and girders, net section	18,000	27,000
Pins	27,000	40,500
WEAR:		
Girder webs, gross section	12,000	18,000
Pins and shop driven rivets	15,500	
Power driven field rivets and turned bolts in reamed holes	12,000	
BEARING:		
Pins (except for rockers), steel parts in contact, and shop driven rivets	27,000	40,500
Rocker Pins	18,000	27,000
Power driven field rivets and turned bolts	24,000	
Expansion rollers, pounds per linear inch (where <i>d</i> = diameter of roller in inches)	600 <i>d</i>	
DIAGONAL TENSION:		
In webs of girders and rolled beams, at sections where maximum shear and bending occur simultaneously	18,000	27,000
NOTE: Stresses for Concrete shall follow the Specifications of the Joint Committee.		
NOTE: For special steel forgings - Class F Annealed ASTM, A18-27 - use stresses 33-1/3% greater than those for carbon steel.		

SFN 180503

11

11

11

11

8.5

8.5

8.5

8.5

11

11

MICROFILMED

W. WATSON AND E. L. HARDING, ENGINEERS - CIVIL, MECH., ARCHT.

WILBUR WATSON AND ASSOCIATES
ARCHITECTS AND ENGINEERS
464 PERSPECT AVENUE
CLEVELAND

August 24, 1929.

W. E. Rabe, Chief Designing Engineer of Bridges,
Department of Highways,
Columbus, Ohio.

Dear Sir:-

As requested in your letter of August 22nd, I am mailing you today, under separate cover, two additional copies of general plan and typical section of the proposed Lorain-Central High Level Bridge. One of the plans we have had photostated and am sending same for your files.

Please note also in regard to the specification for loads and stresses that the base stress for Silicon Steel has been reduced from 27,000# to 25,000#. Other stresses and loads to remain the same.

I shall be pleased at a later date to take up with you the question of approval of the detail plans.

Very truly yours,

Fred L. Plummer

FLP/IK

SFN 1801503