

Field Notes

PROJECT NO. P402230034

BRIDGE NO. LUC-2-1862


DATE _____

SHEET _____

CREW _____



① Floorbeam - sidewalk cantilever top flange cracked

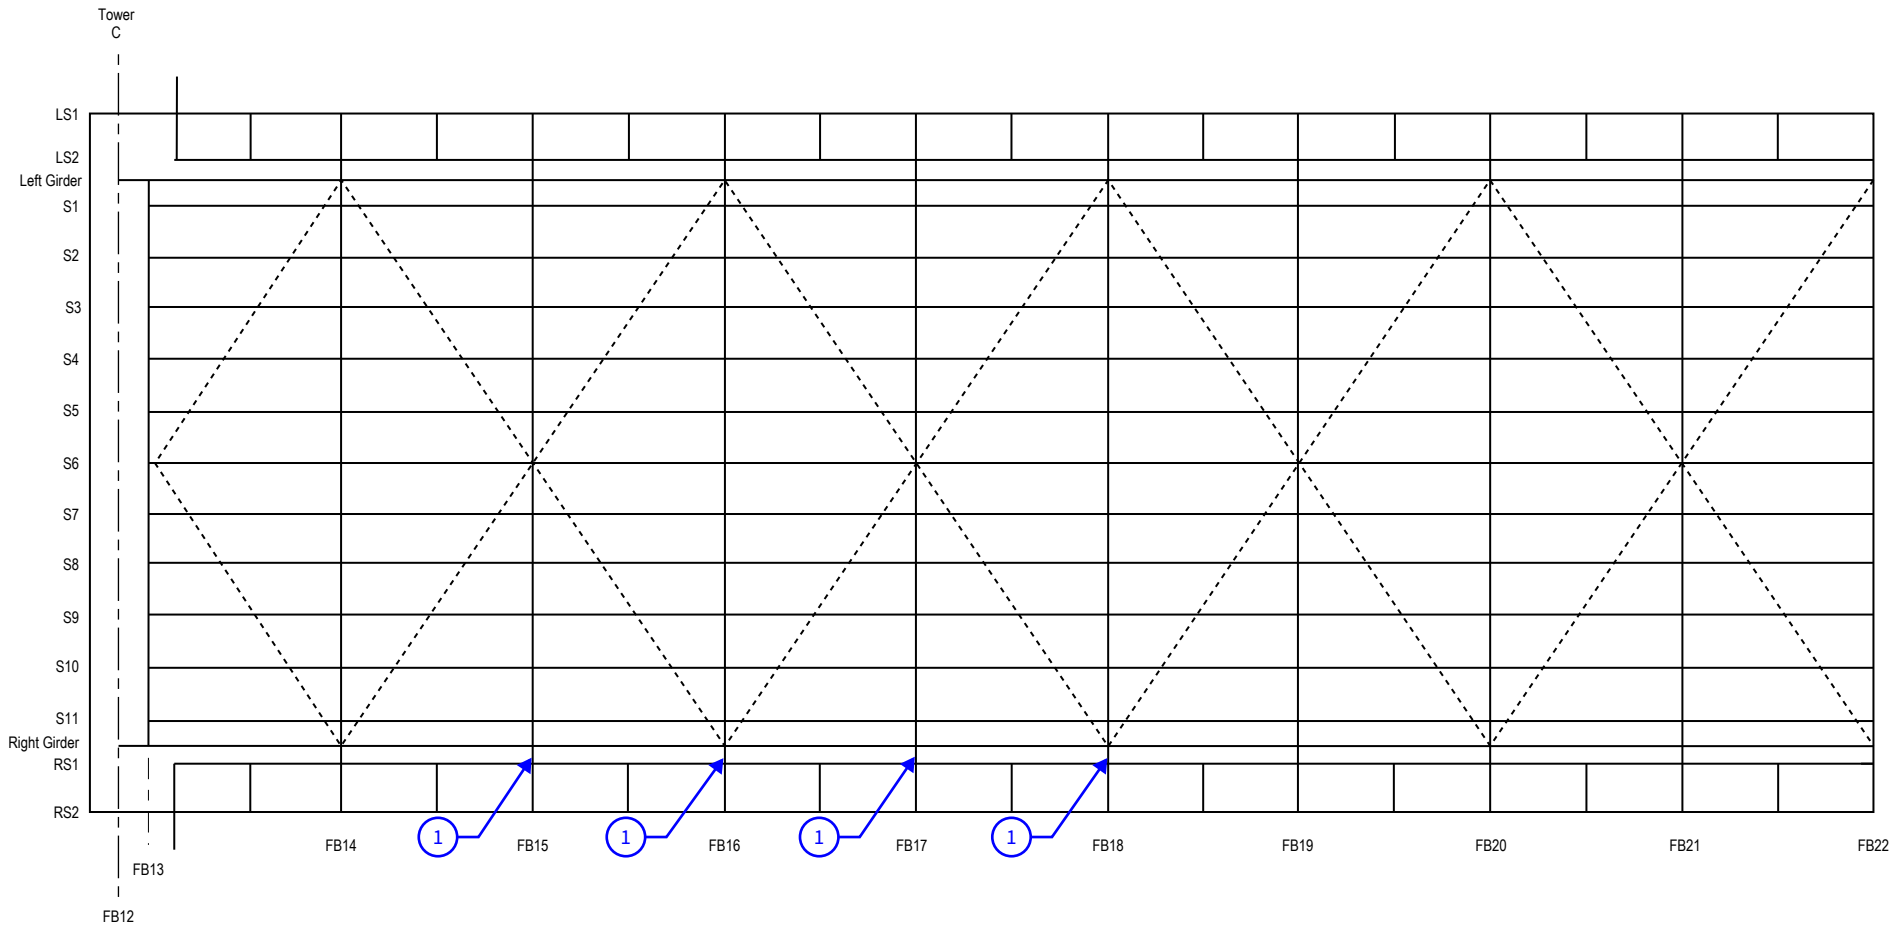

REVISION ①	DATE	CREW	REVISION ②	DATE	CREW	Main Suspension Span (FB12-22) Framing Plan
REVISION ③	DATE	CREW	REVISION ④	DATE	CREW	