


# Field Notes



PROJECT NO. P402230034 BRIDGE NO. LUC-2-1862  
 DATE \_\_\_\_\_ SHEET \_\_\_\_\_  
 CREW \_\_\_\_\_

① Girder - 10' of impact damage with distortion

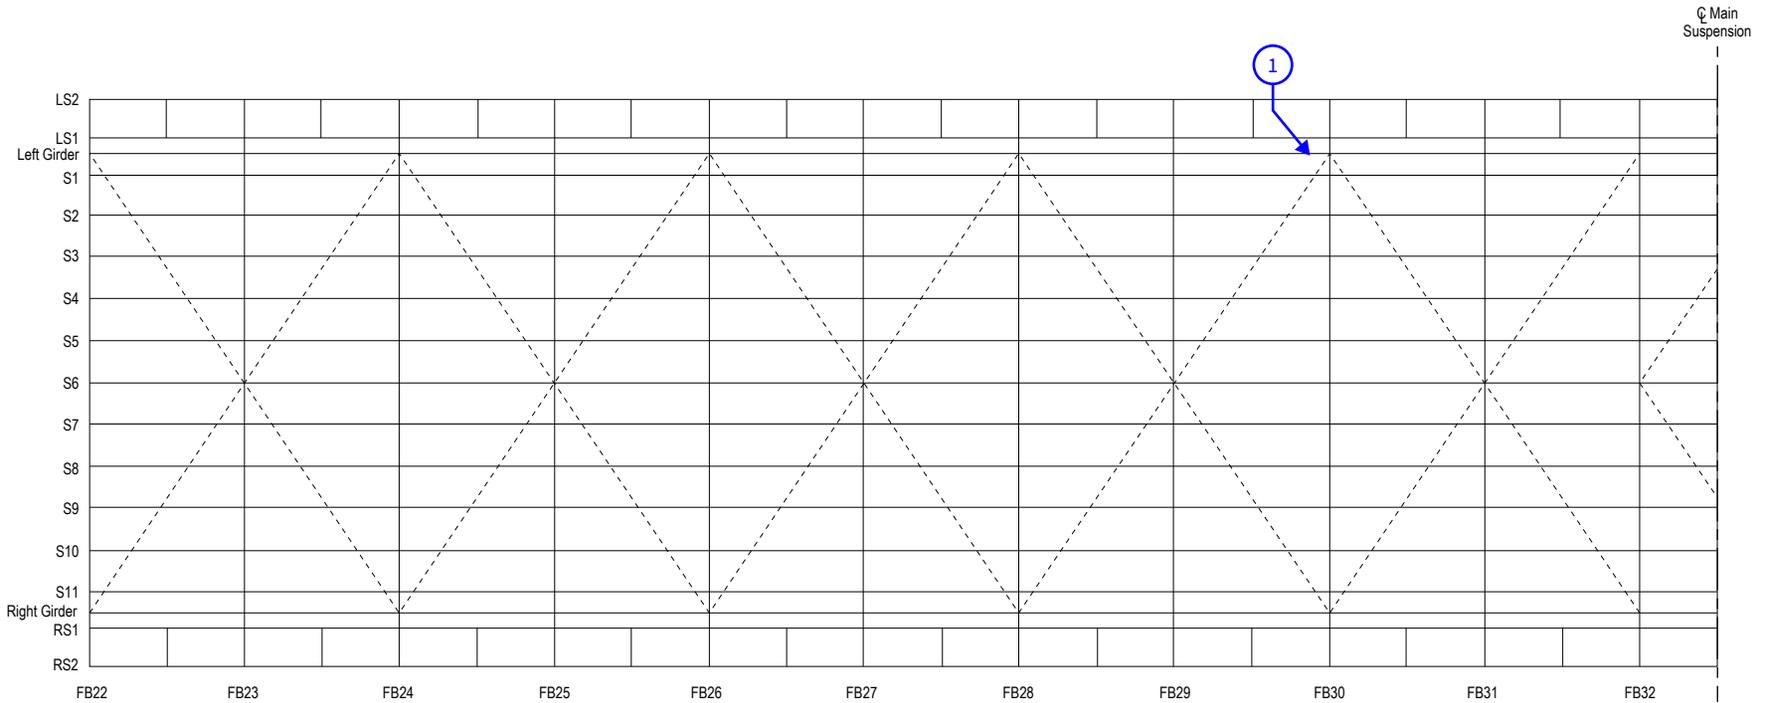

REVISION ①	DATE	CREW	REVISION ②	DATE	CREW	<b>Main Suspension Span (FB22-32) Framing Plan</b>
REVISION ③	DATE	CREW	REVISION ④	DATE	CREW	