


# Field Notes

PROJECT NO. P402230034 BRIDGE NO. LUC-2-1862  
DATE \_\_\_\_\_ SHEET \_\_\_\_\_  
CREW \_\_\_\_\_

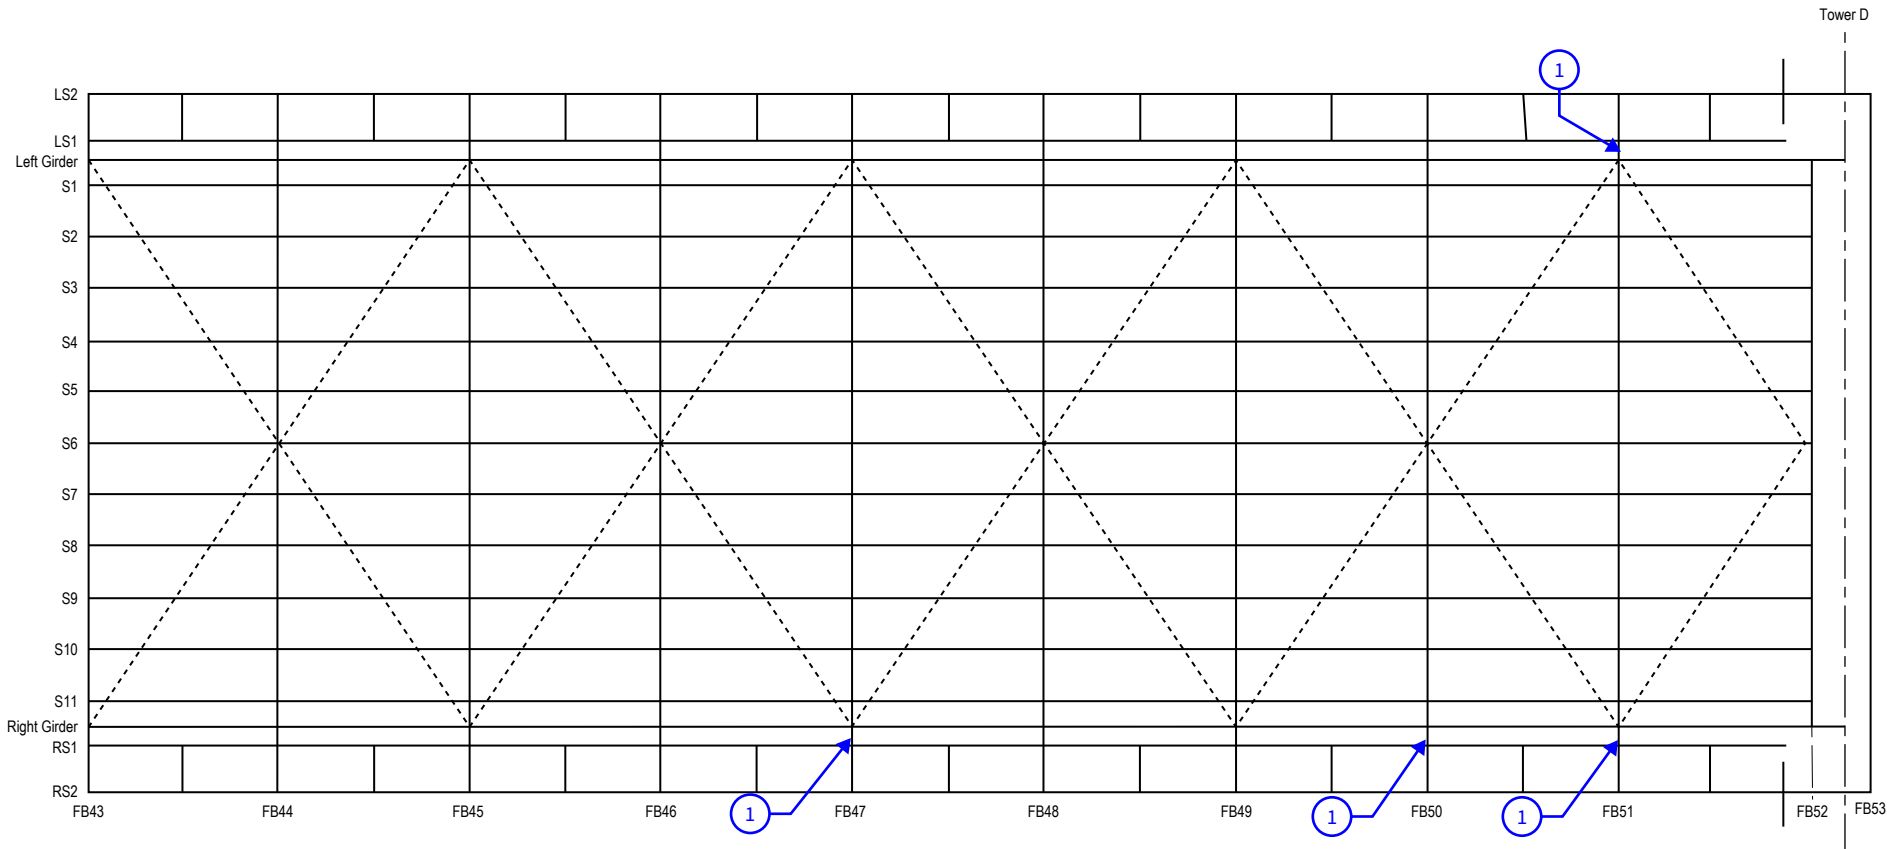

① Floorbeam - sidewalk cantilever top flange cracked



|            |      |      |            |      |      |                                                |
|------------|------|------|------------|------|------|------------------------------------------------|
| REVISION ① | DATE | CREW | REVISION ② | DATE | CREW | Main Suspension Span (FB44-53)<br>Framing Plan |
| REVISION ③ | DATE | CREW | REVISION ④ | DATE | CREW |                                                |