


Field Notes

PROJECT NO. P402230034 BRIDGE NO. LUC-2-1862
DATE _____ SHEET _____
CREW _____



① Bearing - Rotated 10° opposite of temperature

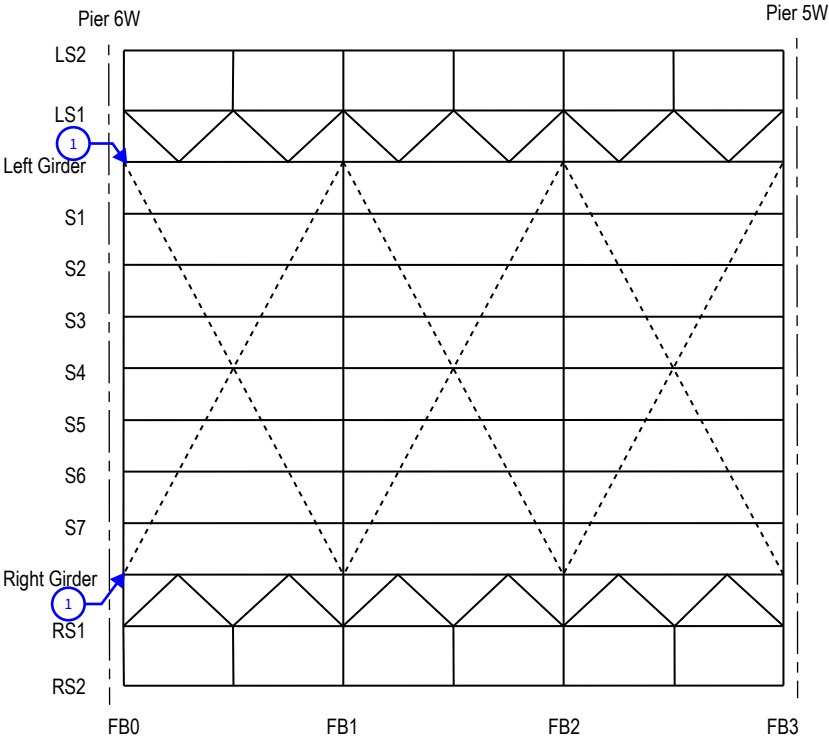

REVISION	①	DATE	CREW	REVISION	②	DATE	CREW
REVISION	③	DATE	CREW	REVISION	④	DATE	CREW

Span 6W - Framing Plan