

Field Notes

PROJECT NO. P402230034

DATE _____


CREW _____

BRIDGE NO. LUC-2-1862

SHEET _____



① Floorbeam - sidewalk cantilever top flange cracked

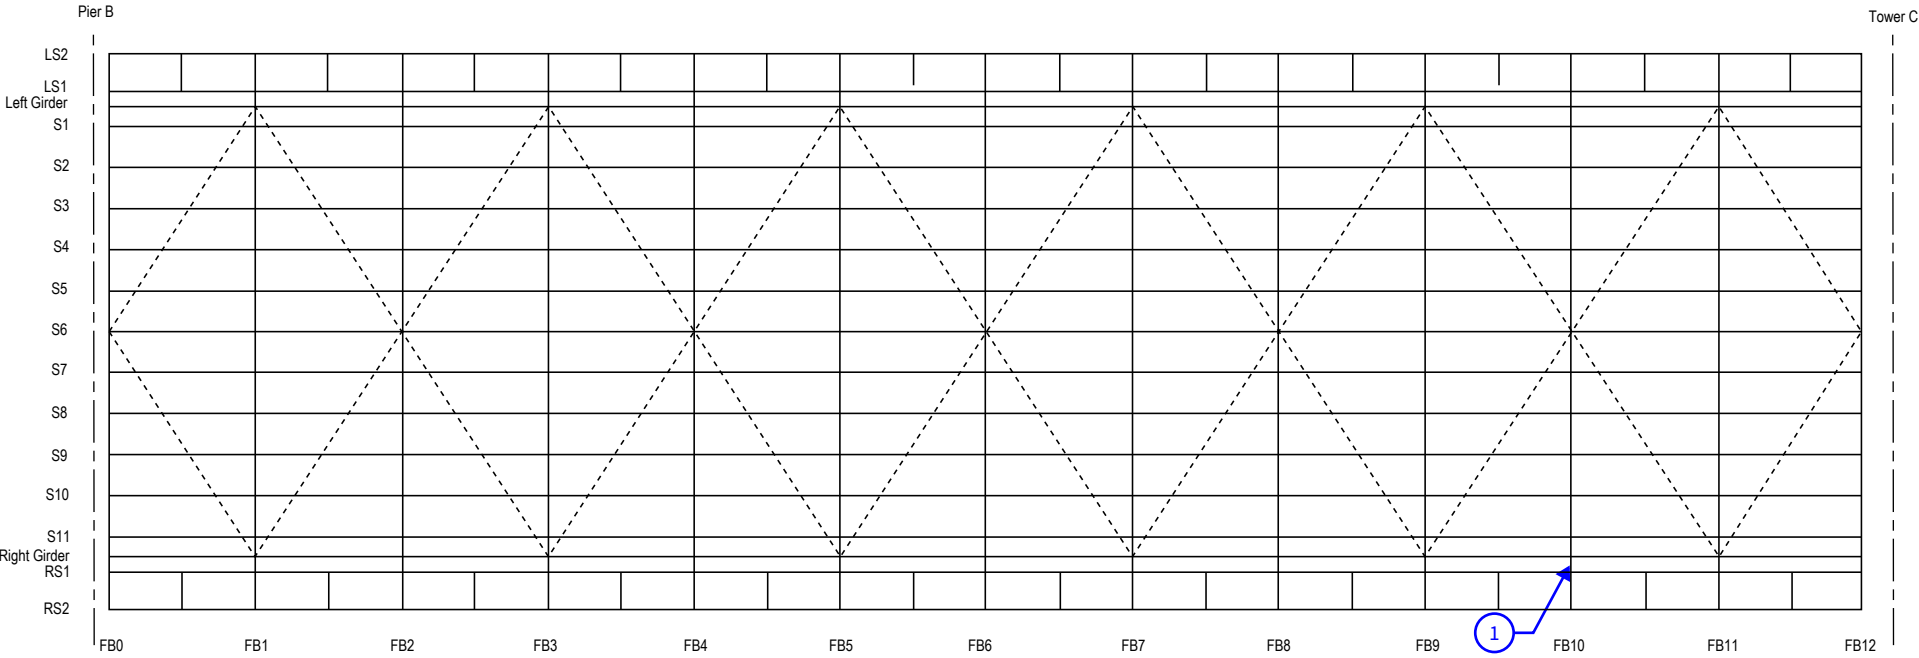

REVISION ①	DATE	CREW	REVISION ②	DATE	CREW
REVISION ③	DATE	CREW	REVISION ④	DATE	CREW

West Suspension Span - Framing Plan