

NOTES TO: B. Rosebrook 8-2-94

PRIORITY NO. 27 ✓ PART 1 OF 3 SHEET 1 OF 19
COUNTY Fulton ROUTE SR 2 SECTION 0.00
BEGIN LOG (SLM) 0.00 TERMINI Williams County Line
END LOG (SLM) 5.37 TERMINI SR 66
TOTAL LENGTH 5.37 MILES Sign on Rt. 152+95
MUNICIPALITY Archbold BEGIN LOG (SLM) 2.86 Rt. END LOG (SLM) 4.36 Rt.
MUNICIPALITY " BEGIN LOG (SLM) 3.11 Lt. END LOG (SLM) 4.73 Lt.
Meas. 230+47 247+47
No Sign 257+00 Meas. 257+00
SIGN ON Lt.

PROPOSED WORK: Resurface existing pavement & shoulder
PAVEMENT 1 1/2" 404 SHOULDER 1 1/2" 404, 617
OTHER Grind in town: full width from Williams St. to north end of curb 2'-0"
full width from Ditto St. to Williams St. 1 1/2"
STATION ESTABLISHED FROM: 5' along curb from Ditto St. to end of curb 1 1/2'-0"

Stationing → FULTON S.R. 2 REF #1 = Sta 0+00

STRUCTURES: NONE

NUMBER	STATION	WIDTH	LENGTH	PROPOSED WORK

RAILROAD CROSSING:

(NO WORK)

NAME NONE STATION _____ NO. TRACKS _____ LENGTH ALONG C L _____ FT
NAME _____ STATION _____ NO. TRACKS _____ LENGTH ALONG C L _____ FT

MISCELLANEOUS:

NO RAISED PAVEMENT MARKERS; EDGE OF PAVEMENT 22 CENTERLINE 245
NO. MAILBOX APPROACHES N/A MAILBOX SUPPORTS N/A

REMARKS: locate rutted pavement location @ SR 66 & SR 2
intersection down town

DATE 1-26-971995 ~~STATE~~ TWO-LANE RESURFACING PROGRAM
INTERSECTIONSSHEET 2 OF 19COUNTY FULTON ROUTE S.R. 2 SECTION 0.0

L = PROP PAVT DEPTH (IN) X 10; W = WIDTH @ MOUTH; W-I = WIDTH @ THROAT

STATION	SIDE	NAME OR NO.	L	W	W-I	ASPH	CONC	REMARKS
6+50	Lt	Co. Rd. 26-3	15	81	35	X		
26+45	Rt	Co. Rd. 26-2	15	84	36	X		
52+90	Lt	Co. Rd. 26	15	86	41	X		
105+89	Lt	Co. Rd. 25	15	86	46	Y		
105+89	Rt	Co. Rd. 25	15	82	43	X		
151+02	Lt	Co. Rd. 24	15	106	5	Y		
151+02	Rt	Co. Rd. 24	15	104	49	X		
52+90	Rt	Co. Rd. 26	15	61	29	X		- Dead END AFTER ±200
171+30	Lt	LACHOY	15	89	35	X		30' BACK BEGIN CONC
176+32	Lt	CHRISTINE	15	88	35		X	
178+56	Lt	DE GROFF	15	88	35		X	
181+04	Lt	BANKEY	15	88	35		X	
184+22	Lt	RUIHLEY	15	88	35		X	
187+20	Lt	Eicher	15	88	35		X	
188+99	Rt	LAUBER	15	53	24	X		
197+40	Rt	FRANKLIN	15	90	30	X	X	
198+81	Lt	Alley	15	51	21		X	
200+59	Lt	DITTO	15	61	44		Y	
205+11	Rt	DEPOT	15	44	36	X		

7-28-94

SHEET 3 OF 19

COUNTY FULTON ROUTE S.R. 2 SECTION 0.0

L = PROP PAVT DEPTH (IN) X 10; W = WIDTH @ MOUTH; W-I = WIDTH @ THROAT

[illegible]

DATE 7/28/94

1995 ~~0000~~ TWO-LANE RESURFACING PROGRAM
DEFECTIVE PAVEMENT AREAS

SHEET 4 OF 19

COUNTY FULTON ROUTE S.R.2 SECTION 0.0

[illegible]

1995 TWO-LANE RESURFACING PROGRAM SHEET 5 OF 19
 UTILITIES (CATCH BASIN, MANHOLE, INLET, WATER VALVE, BOX AND MONUMENT BOX)

COUNTY FULTON ROUTE S.R. 2 SECTION 0.0

R - RAISE F - FEATHER

STATION	OUT (FT) RT/LT OF C	CATCH BASIN	MAN- HOLE	INLET	W V BOX	MON BOX	CASTING		REMARKS ie: RECONSTRUCT, NO WORK
							R	F	
167+62	Rt CURB	X						X	OK (GOOD)
167+63	Lt CURB	X					X		GOOD COND.
169+67	Rt CURB	X		X				X	" "
170+61	Lt CURB	X					X		GOOD COND.
171+53	21' Lt			X			X		GOOD COND.
176+06	19' Lt			X			X		" "
176+33	♀ PAUT		X				X		COULD NOT OPEN
176+35	16' Lt		X				X		" "
177+76	♀ PAUT		X				X		GOOD
178+24	15' Lt			X			X		GOOD COND.
178+55	♀ PAUT		X				X		C NOT OPEN
178+59	Rt CURB			X			X		GOOD COND.
178+85	15' Lt			X			X		GOOD COND.
180+105	Rt CURB			X				X	GOOD
181+01	♀ PAUT		X				X		DID NOT OPEN
181+48	Lt CURB			X				X	GOOD
184+03	21' Lt & C				X		X		
184+09	23' Lt & C				X		X		
184+20	♀ PAUT		X				X		GOOD
184+25	Rt CURB			X			X		GOOD

COUNTY FULTON ROUTE S.R. 2 SECTION 0.0

R - RAISE F - FEATHER

STATION	OUT (FT) RT/LT OF C	CATCH BASIN	MAN- HOLE	INLET	W V BOX	MON BOX	CASTING		REMARKS ie: RECONSTRUCT, NO WORK
							R	F	
184+47	18' Lt CL		X					X	Good
184+65	Lt CURB			X				X	Good CONDITION
187+19	CL PAVT		X				X		Good
187+31	Rt CURB			X			X		"
187+63	Lt CURB			X			X		"
189+29	Rt CURB			X				X	"
190+28	C PAVT		X				X		"
190+86	Lt CURB			X				X	Good COND
190+87	Rt CURB			X				X	Good COND
193+78	C PAVT		X				X		Good
194+25	Rt CURB			X				X	"
194+45	18' 23' Lt			X				✓	"
194+50	18' Lt		X				X		"
195+30	13' Rt				X			X	
196+66	Lt CURB			X				X	"
197+31	C PAVT		X				X		Loose Rim - Did Not OPEN
197+39	21' Rt.		X				X		Good
197+40	C PAVT					X	X		
197+54	18' Rt				X			X	Good
198+81	C PAVT		X				X		Good
199+13	Lt CURB			X			X		Good
200+36	17' Lt			X				X	Good
200+74	Rt CURB			X				X	Good
201+03	Lt CURB			X				X	Good
201+85	C PAVT		X					X	Good
201+90	14' Rt			X				X	"
202+01	C PAVT		X					X	"

UTILITIES (CATCH BASIN, MANHOLE, INLET, WATER VALVE, BOX AND MONUMENT BOX)

COUNTY FULTON ROUTE S.R. 2 SECTION 0.0

R - RAISE F - FEATHER

STATION	OUT (FT) RT/LT OF C	CATCH BASIN	MAN- HOLE	INLET	W V BOX	MON BOX	CASTING		REMARKS ie: RECONSTRUCT, NO WORK
							R	F	
202+09	2' Lt C		X					X	GOOD
202+18	14' Lt			X			X		GOOD
202+23	20' Lt		X					X	GOOD
202+25	C PAUT		X					X	"
202+25	35' Lt		X					X	"
203+63	C PAUT		X					X	"
203+82	14' Rt		X					X	"
204+04	C PAUT		X					X	"
204+48	Lt CURB			X				X	"
204+96	22' Rt C		X					X	"
205+06	32' Rt C		X					X	"
205+19	20' Rt		X					X	"
205+19	25' Lt		X					X	"
205+34	Rt CURB			X				X	GOOD
205+62	Lt CURB			X				X	GOOD
206+75	Rt CURB	X						X	GOOD
206+98	Lt CURB	X						X	GOOD
208+08	Lt CURB	X						X	GOOD
208+08	Rt CURB	X						X	GOOD
208+37	27' Lt		X					X	GOOD
208+64	Lt CURB	X						X	GOOD
209+38	17' Rt		X				X		D.B. NOT OPENED
211+81	Rt CURB	X						X	
211+85	22' Lt C		X					X	
212+02	Lt CURB	X					X		
217+37	Rt CURB	X					X		
222+23	Rt CURB	X					X		
222+23	Lt CURB	X						X	

DATE 7-27-59

SHEET 7-A OF 19

UTILITIES (CATCH BASIN, MANHOLE, INLET, WATER VALVE, BOX AND MONUMENT BOX)

COUNTY FULTON ROUTE S.R. 2 SECTION 0.0

R = RAISE F = FEATHER

[illegible]

DATE 7-26-94

TWO-LANE RESURFACING PROGRAM
PAVEMENT DATA

SHEET 8 OF 19

**NOTE: LOCATE ALL
CHANGES IN PVMT WIDTH**

COUNTY FULTON ROUTE 2 SECTION 0.00

[illegible]


194SWH

PW1
OHIO DEPARTMENT OF TRANSPORTATION

SHEET NO. 9 of 19

PERSONNEL	TITLE	PERSONNEL	TITLE	COUNTY	DATE
LOEHRKE				FULTON	7-26-94
HERMILLER				S. R.	G.R.2
VOGEL				SEC.	D.00
					WEATHER Nice
					TEMP. +78

DESCRIPTION	PAVT Widths	JOB NO.
LEFT	CENTER LINE	RIGHT

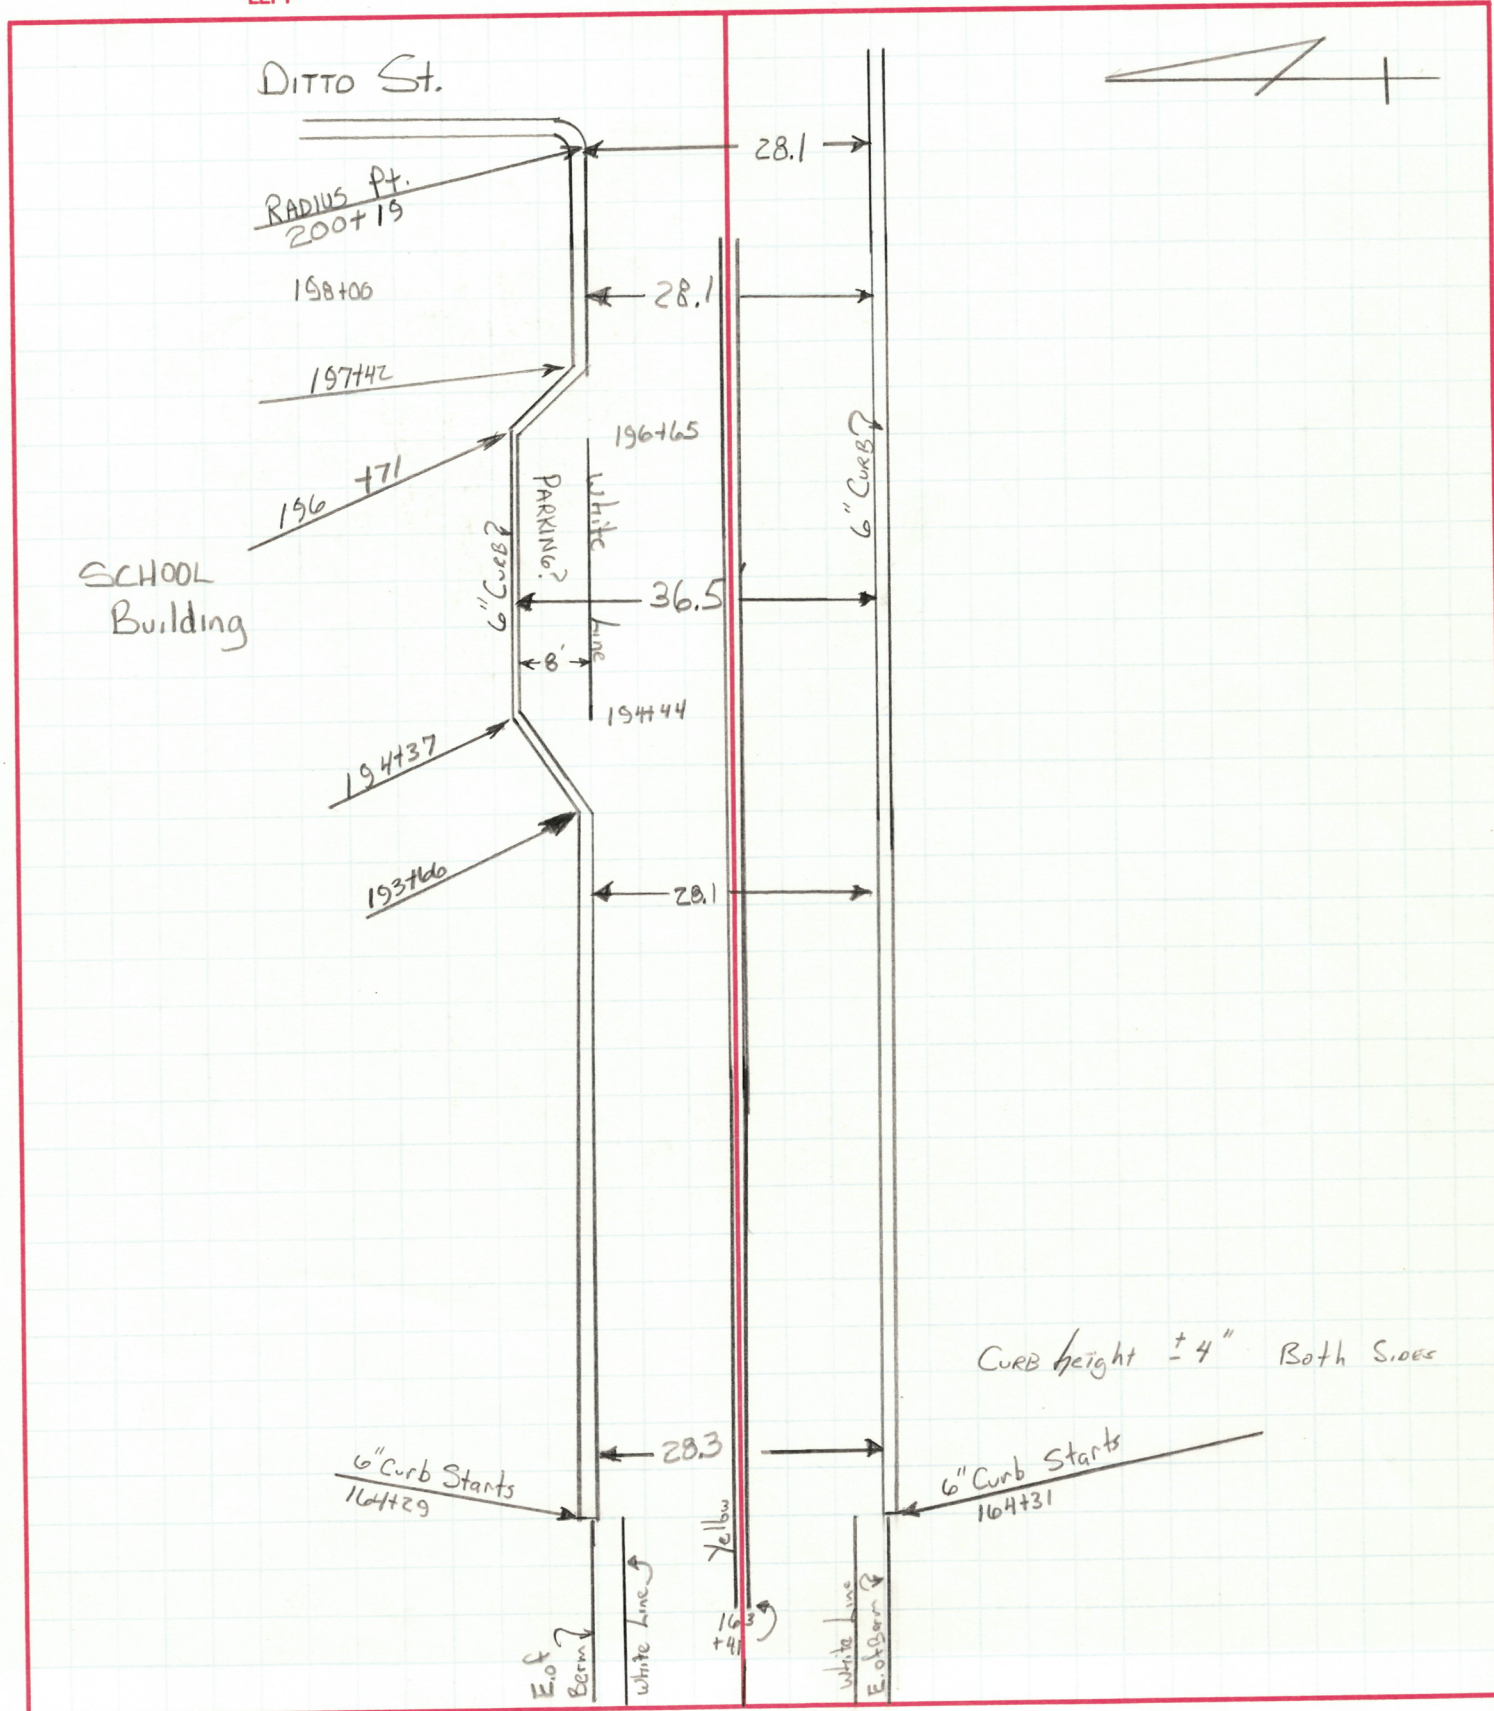


194SWH

PW²
OHIO DEPARTMENT OF TRANSPORTATION

SHEET NO. 10 of 19

PERSONNEL	TITLE	PERSONNEL	TITLE	COUNTY <u>FULTON</u>	DATE <u>7-26-94</u>
<u>Loehrke</u>				S. R. <u>S.R.2</u>	WEATHER <u>Nice</u>
<u>E</u>				SEC. <u>0.00</u>	TEMP. <u>+78</u>
<u>Crew</u>					

DESCRIPTION PAVT W. RTHS JOB NO. _____

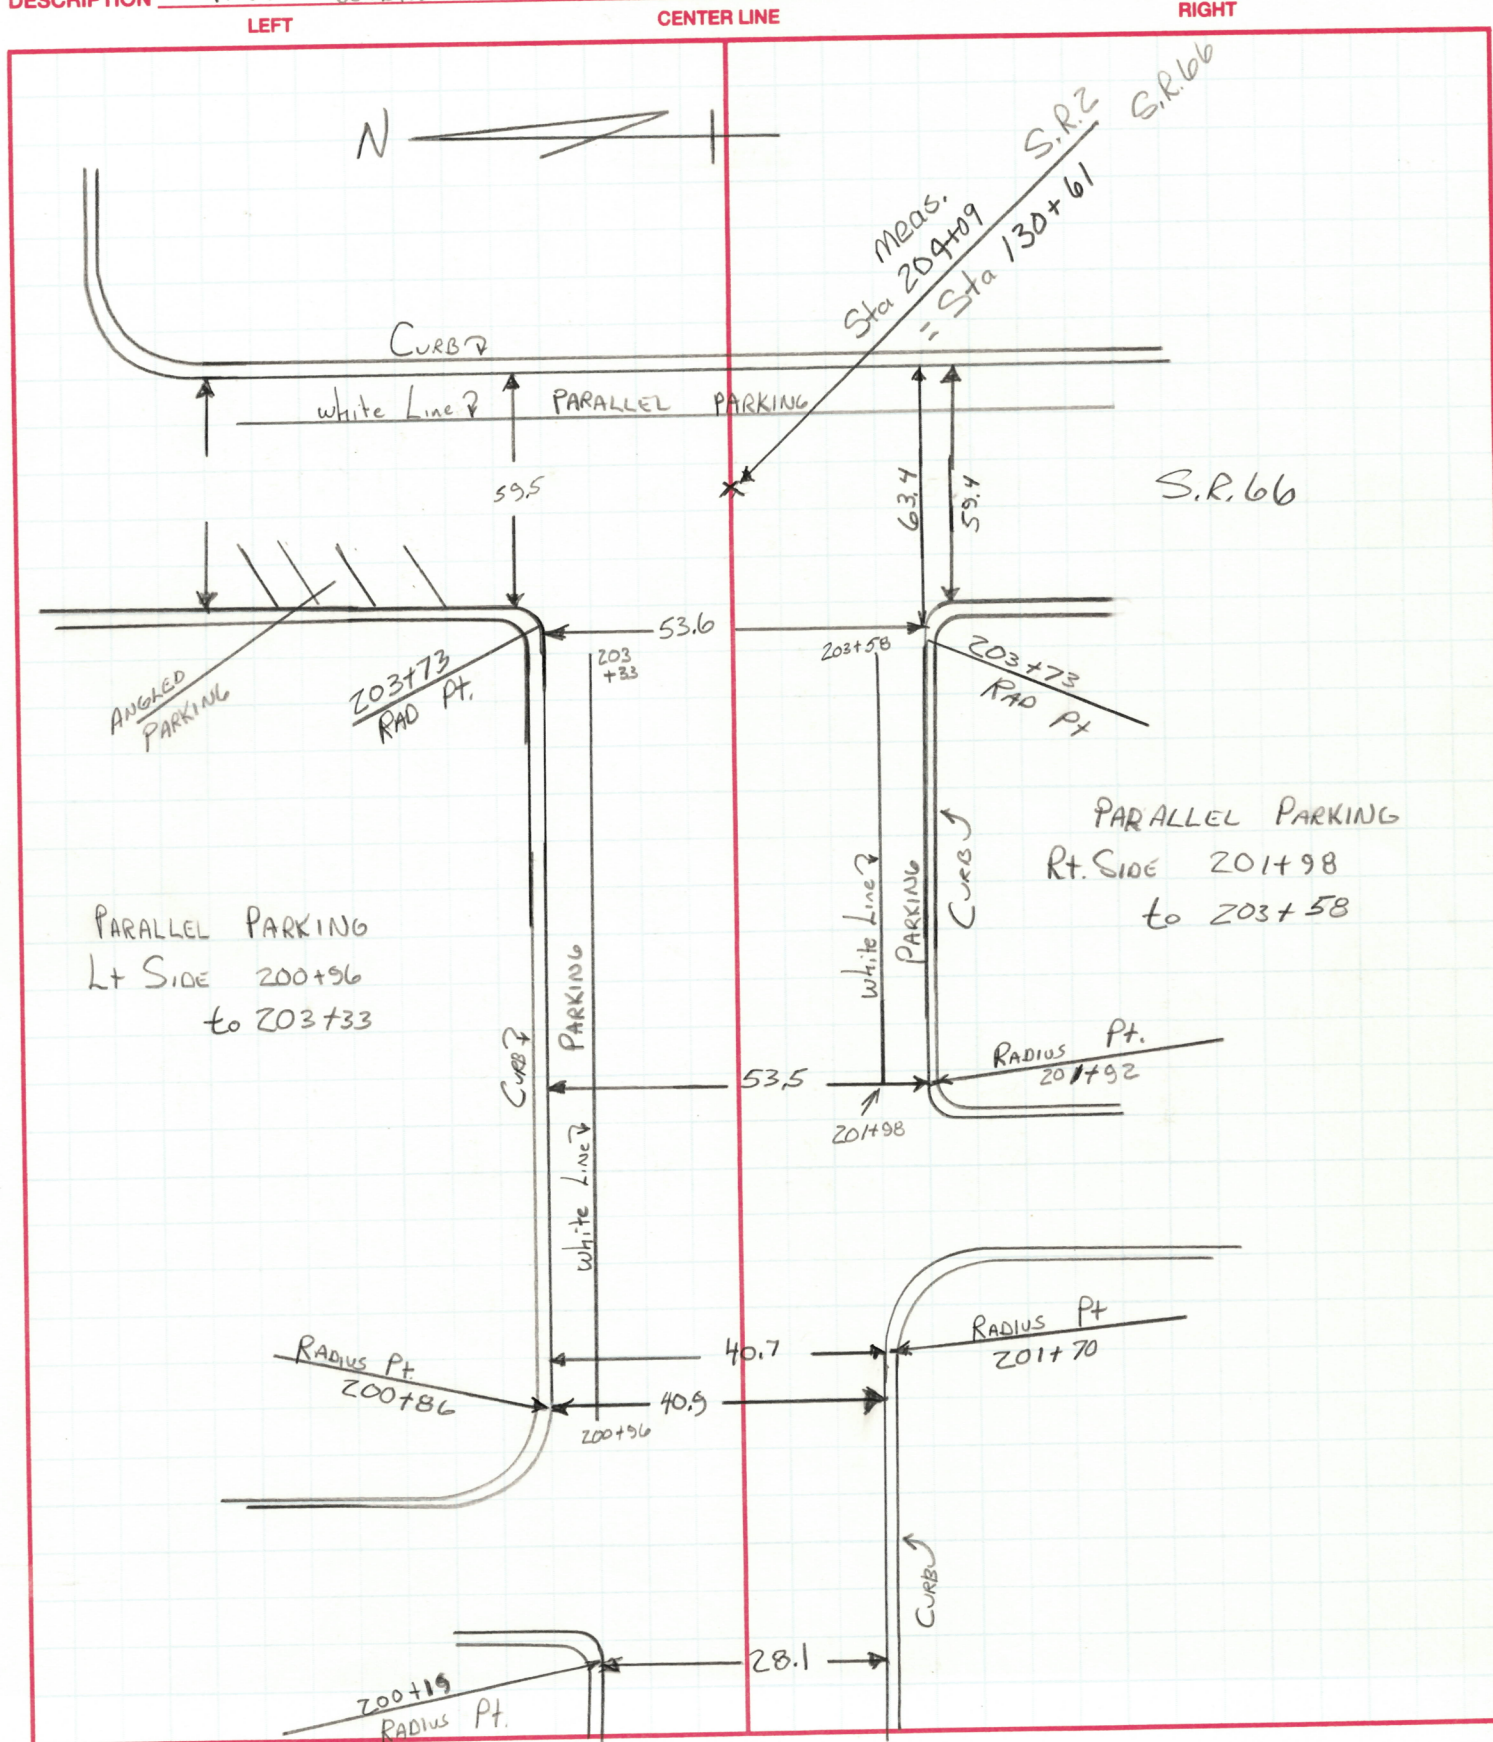


194SWH

pws
OHIO DEPARTMENT OF TRANSPORTATION

SHEET NO. 11 of 19

PERSONNEL	TITLE	PERSONNEL	TITLE	COUNTY <u>FULTON</u>	DATE <u>7-27-94</u>
<u>Loehrke</u>				S. R. <u>S.R.2</u>	WEATHER <u>Cloudy</u>
<u>Grew</u>				SEC. <u>0.0</u>	TEMP. <u>+74</u>

DESCRIPTION <u>PAVT</u>	WIDTHS	JOB NO.
-------------------------	--------	---------

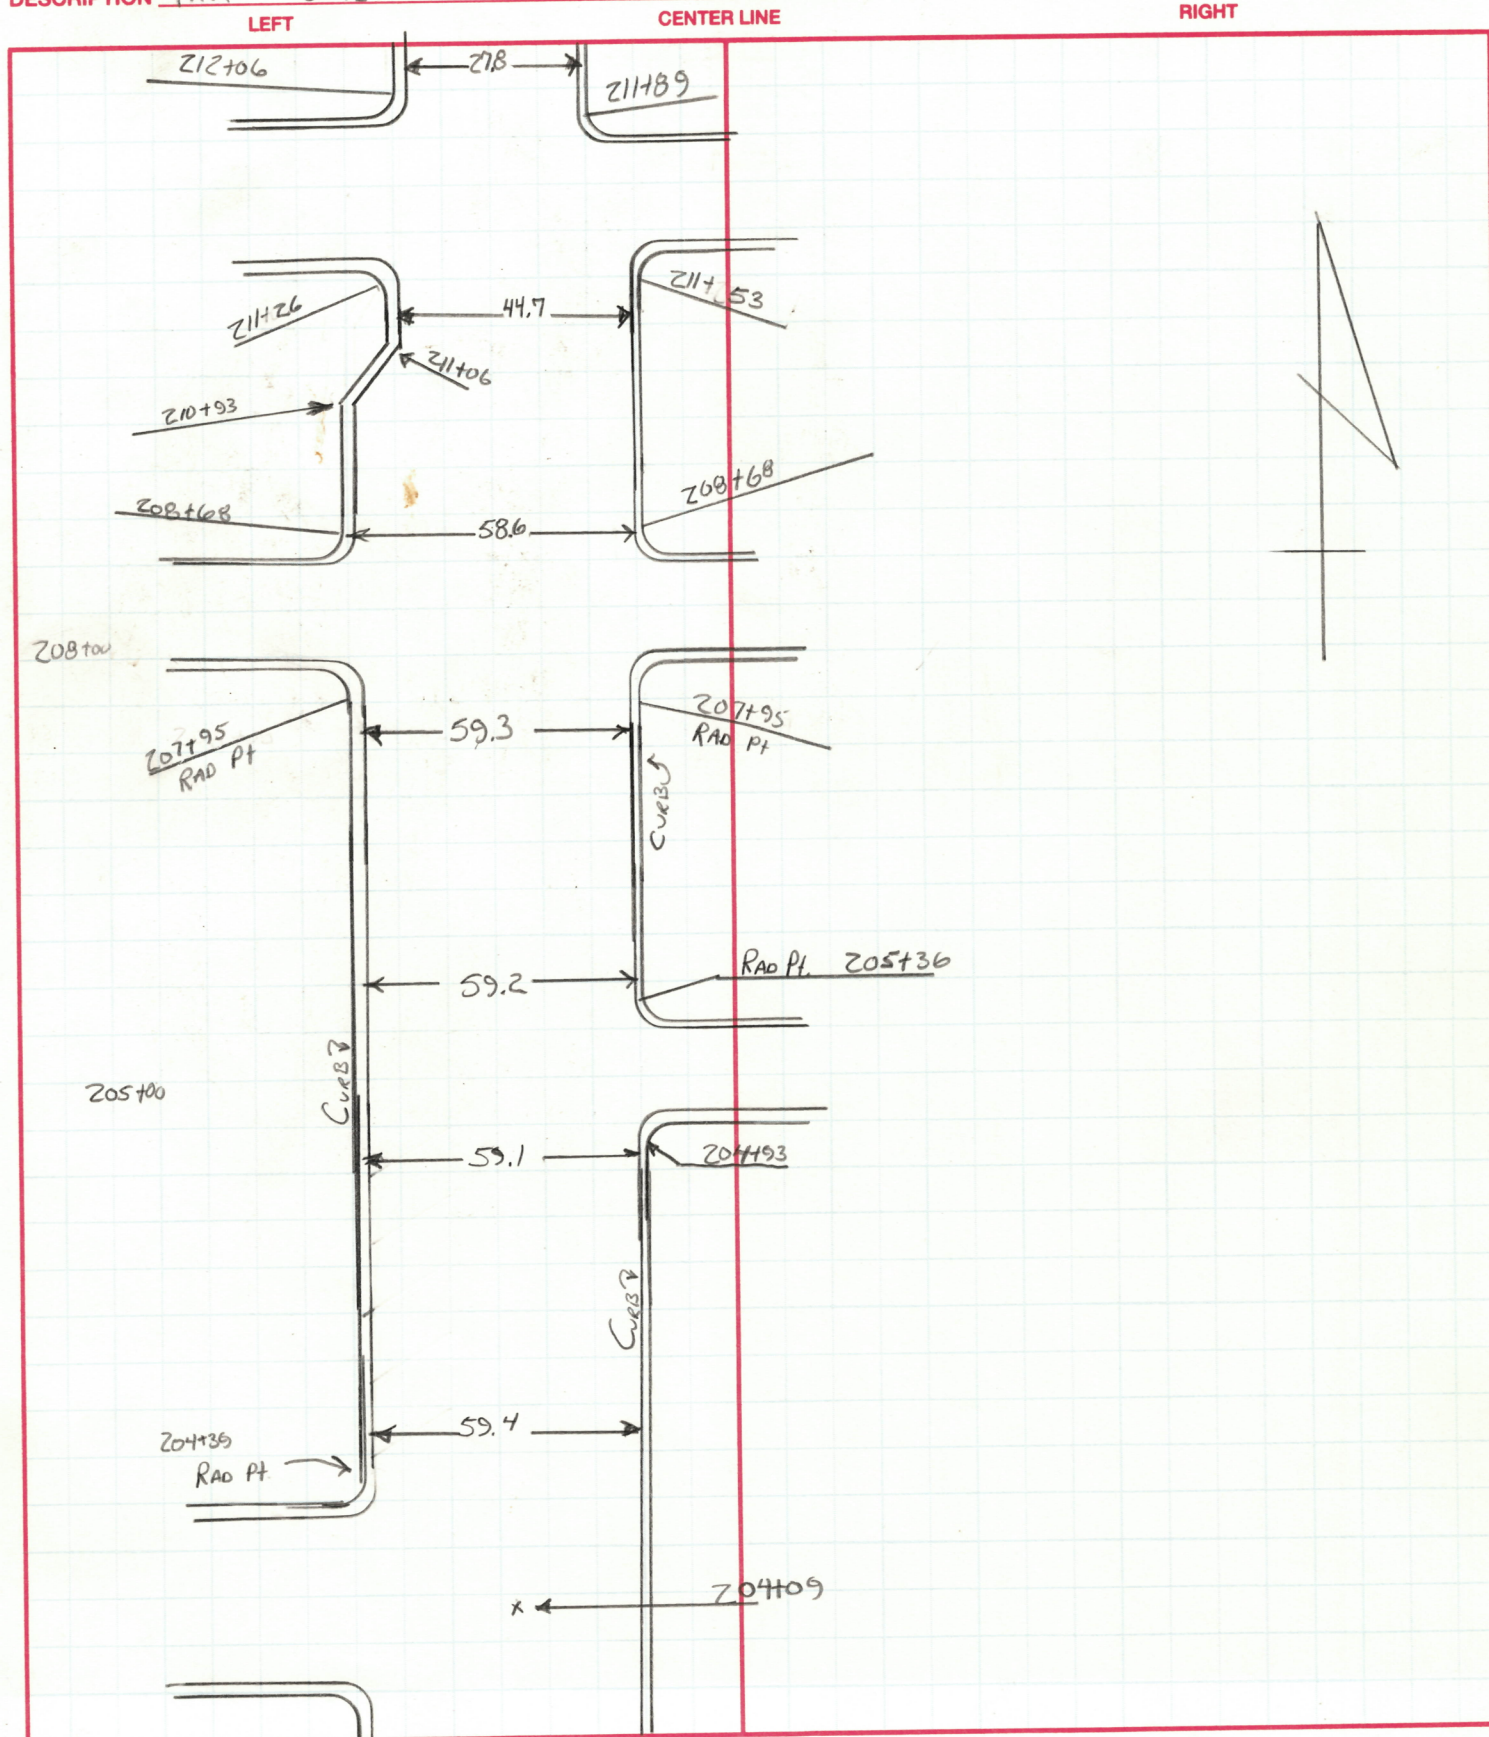


1945WH

PW 4
OHIO DEPARTMENT OF TRANSPORTATION

SHEET NO. 12 of 19

PERSONNEL	TITLE	PERSONNEL	TITLE	COUNTY <u>FULTON</u>	DATE <u>7-28-94</u>
<u>LOEHKE</u>				S. R. <u>S.R.2</u>	WEATHER <u>Cloudy</u>
<u>B</u>				SEC. <u>0.00</u>	TEMP. <u>+78</u>
<u>Crew</u>					

DESCRIPTION <u>PAVT</u>	WIDTH <u>W.DTH</u>	JOB NO. _____
LEFT	CENTER LINE	RIGHT

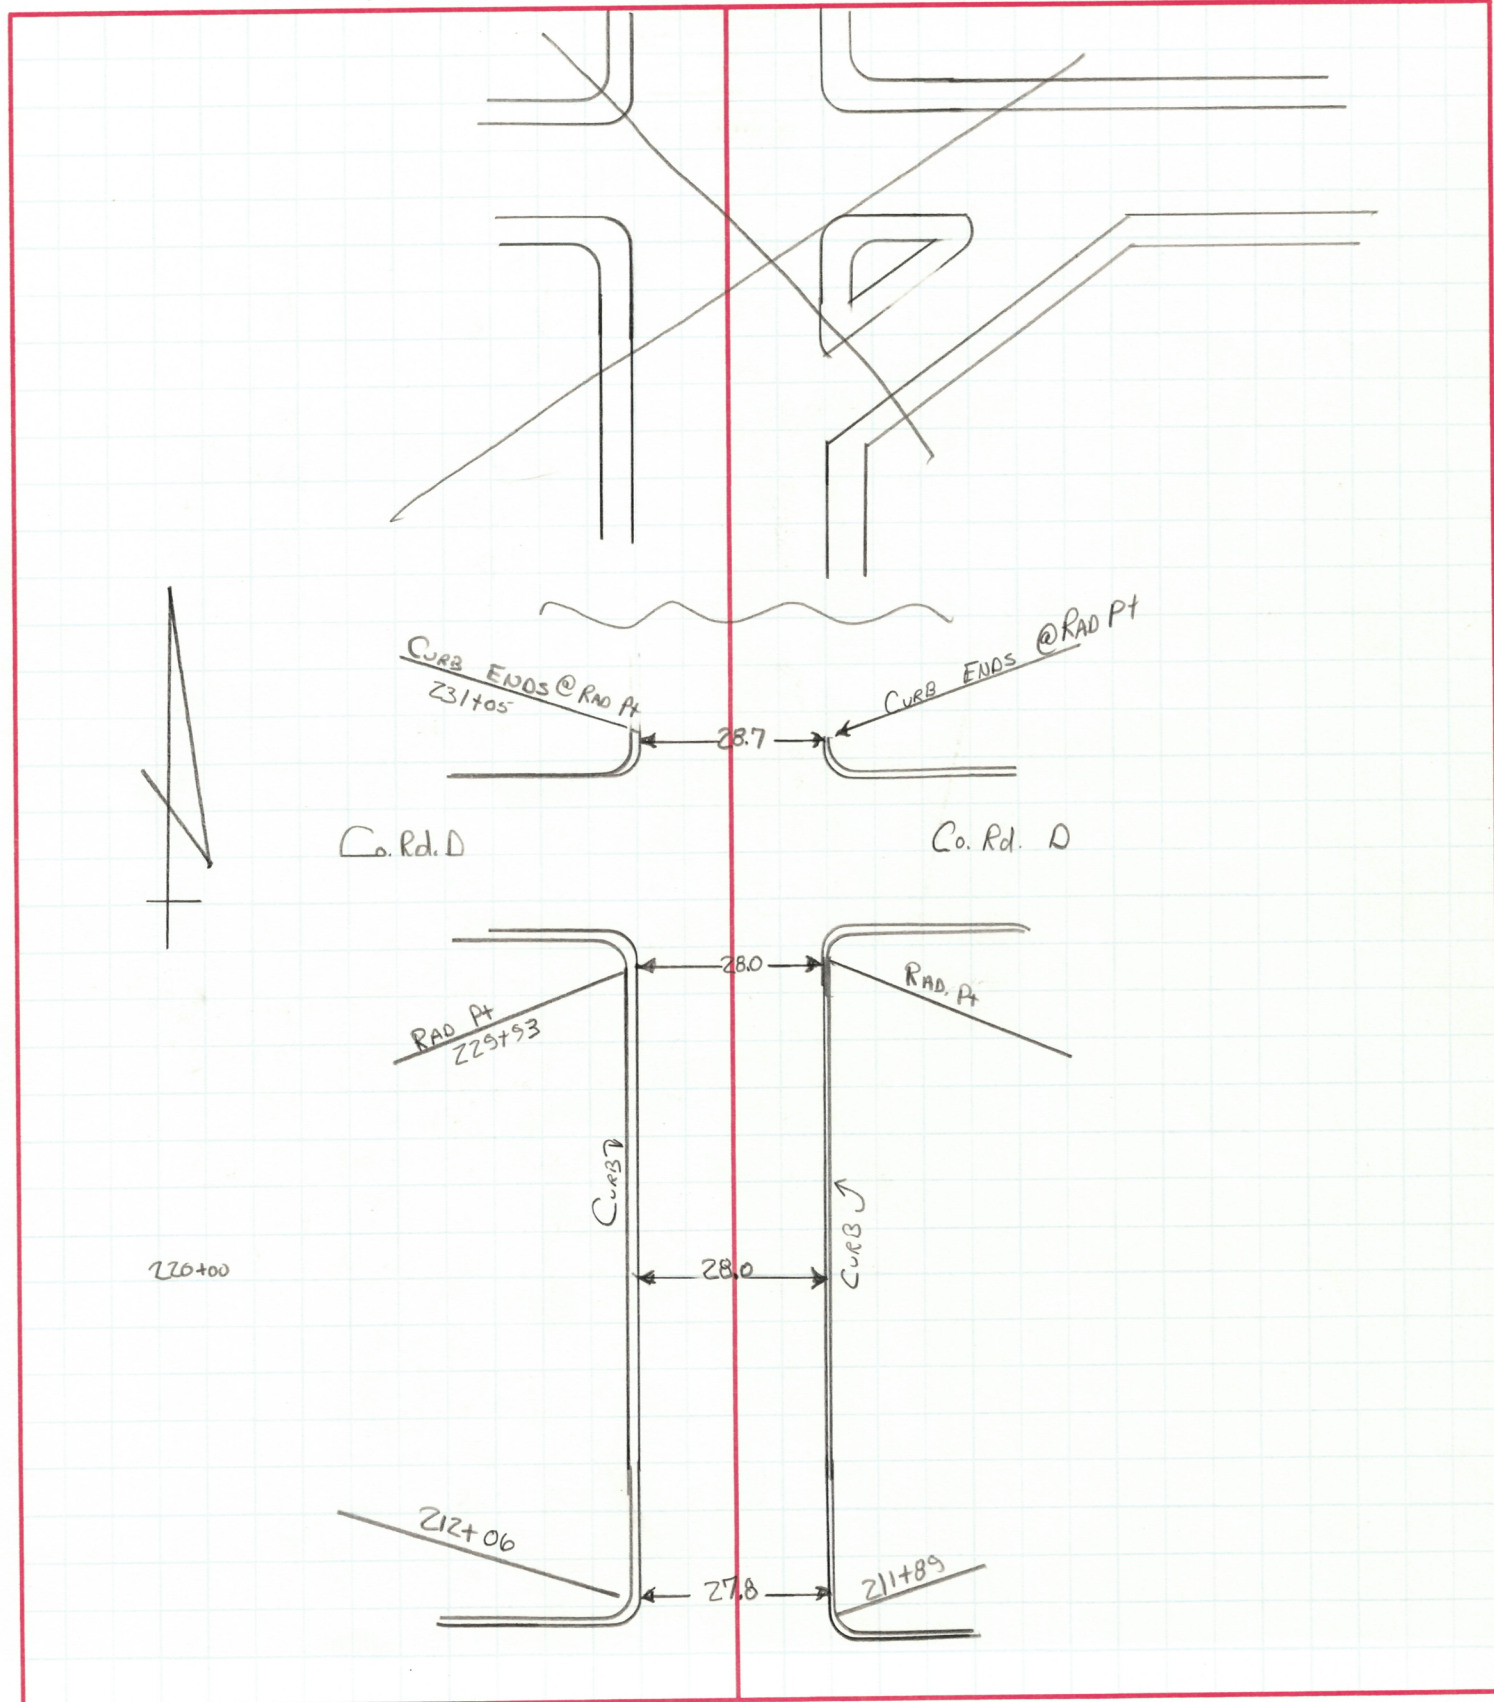


194SWH

OHIO DEPARTMENT OF TRANSPORTATION

SHEET NO. 13 of 19

PERSONNEL	TITLE	PERSONNEL	TITLE	COUNTY	DATE	WEATHER	TEMP.
LOEHRKE				FULTON	7-28-94	Cloudy	+60
E				S. R. 2			
Crew				SEC. 0.0			

DESCRIPTION PAUT WIDTHS JOB NO.

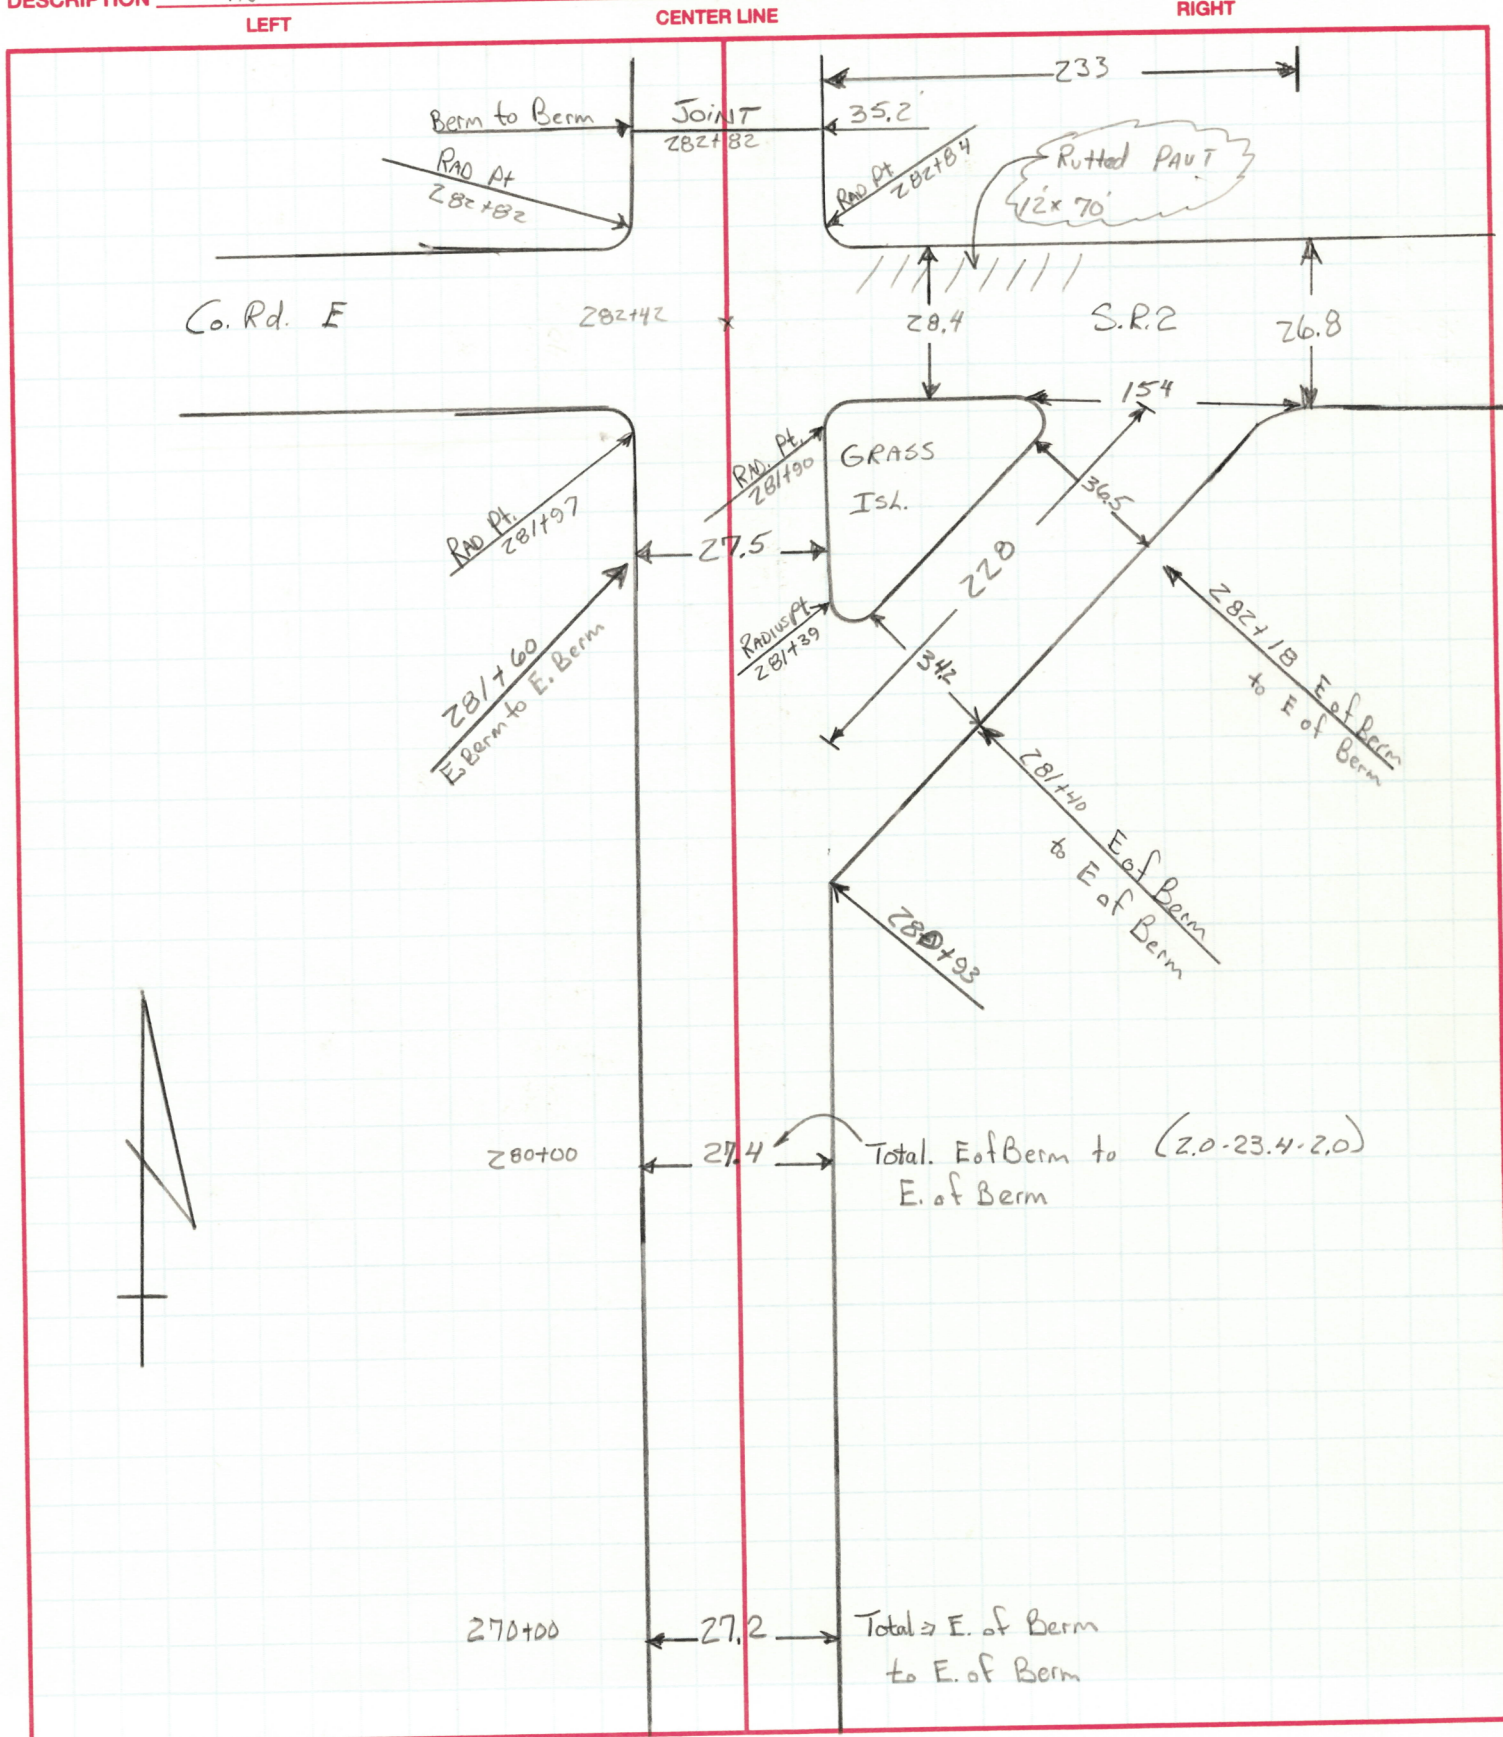


194SWH

pm¹
OHIO DEPARTMENT OF TRANSPORTATION


SHEET NO. 14 of 19

PERSONNEL	TITLE	PERSONNEL	TITLE	COUNTY <u>FULTON</u>	DATE <u>7-26-94</u>
<u>LOGHRKE</u>					
<u>E</u>				S. R. <u>S.R.2</u>	WEATHER <u>CLOUDY</u>
<u>Crew</u>				SEC. <u>0.0</u>	TEMP. <u>78</u>

DESCRIPTION PAVT MARKINGS JOB NO. _____

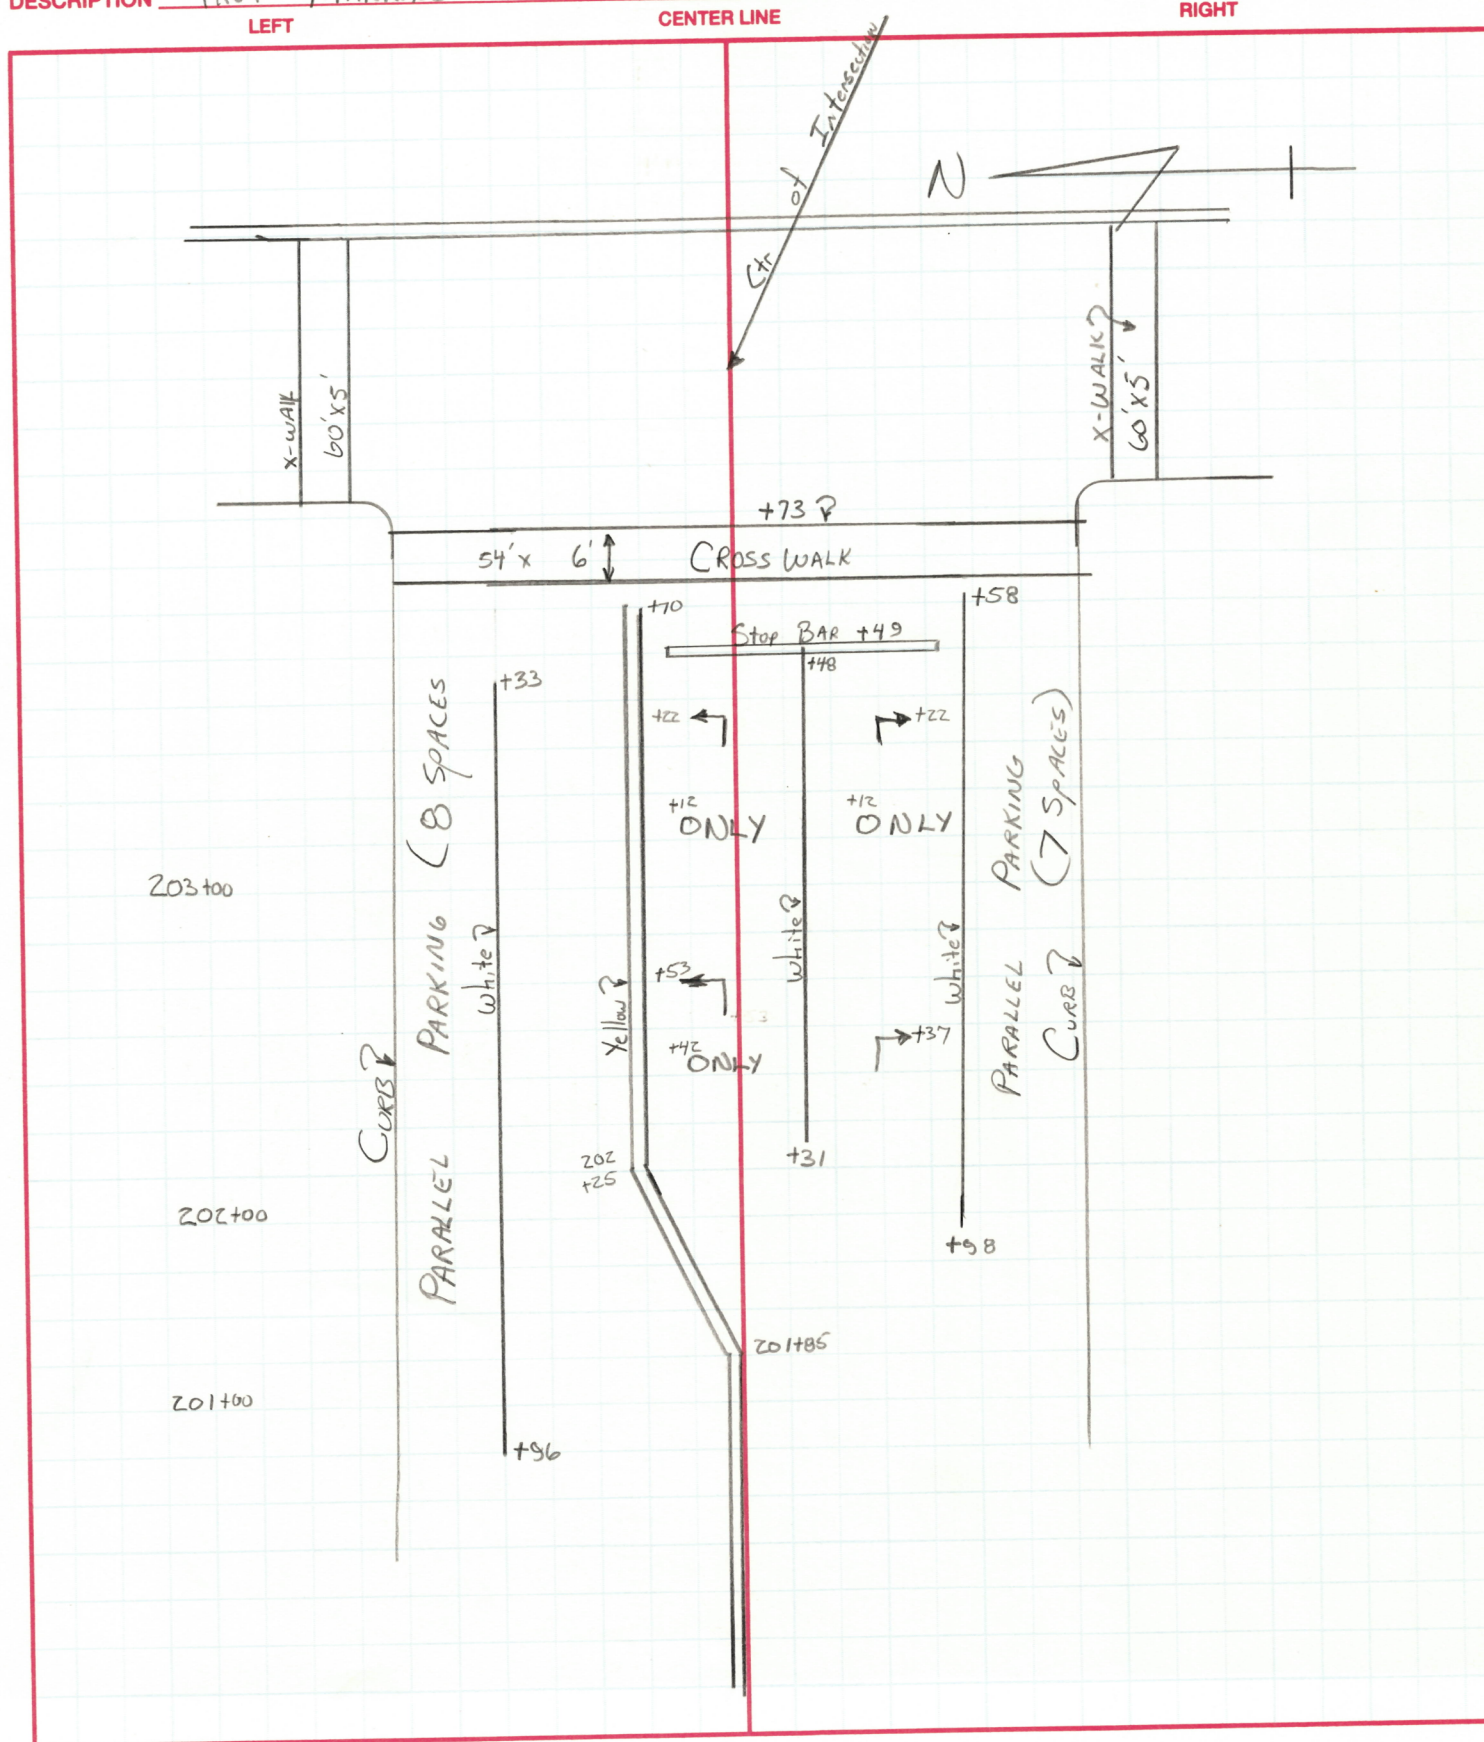

DESCRIPTION PAVEMENT MARKINGS JOB NO.

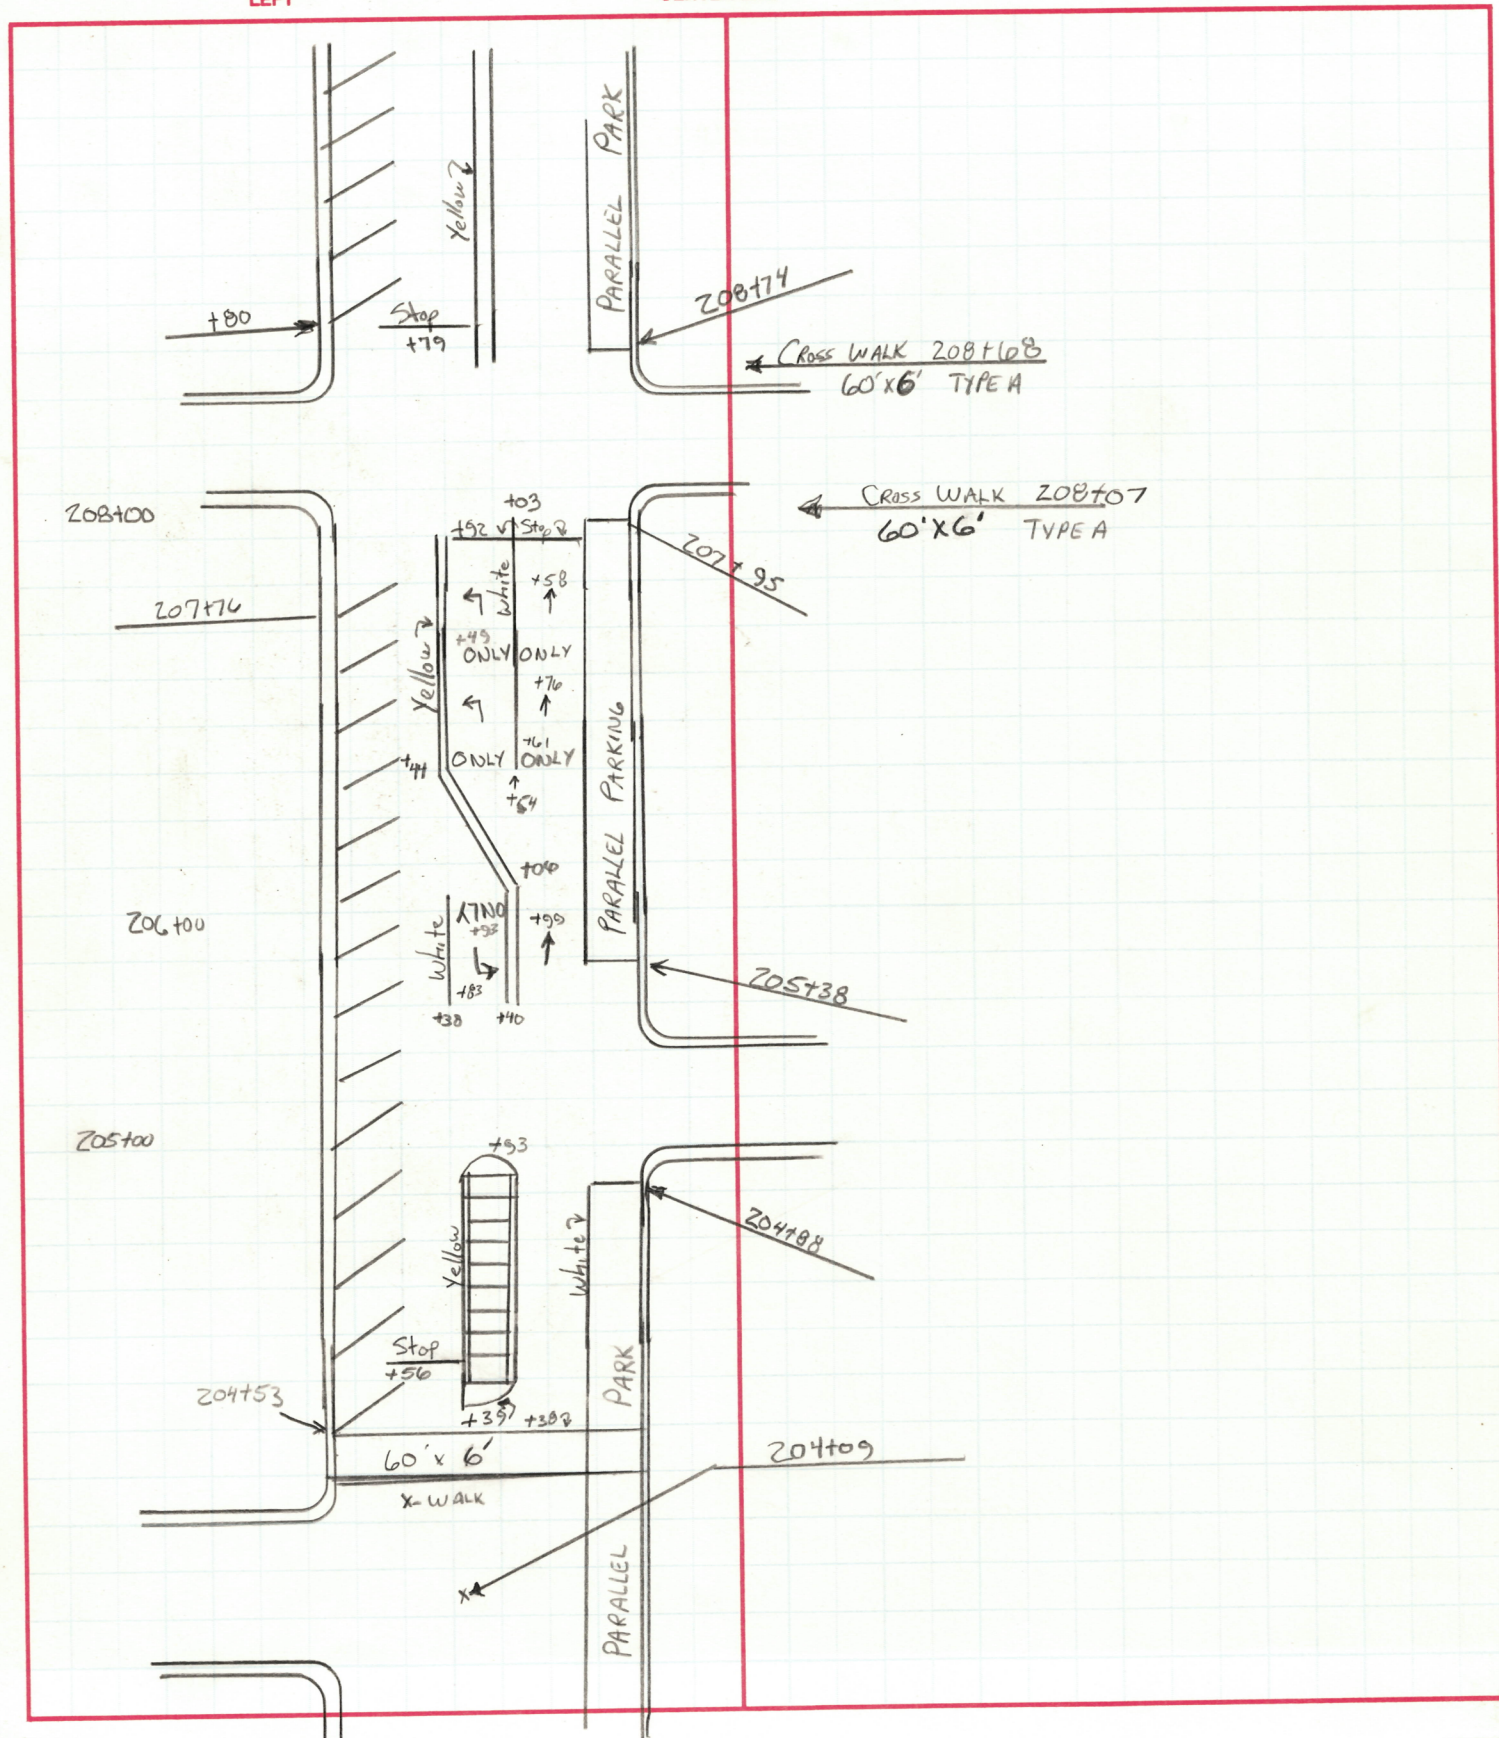

pm³

1945WH


OHIO DEPARTMENT OF TRANSPORTATION

SHEET NO. 16 of 19

PERSONNEL	TITLE	PERSONNEL	TITLE	COUNTY	DATE	S. R.	WEATHER	SEC.	TEMP.
Loehrke				FULTON	7-27-94	2	Cloudy	0.0	+76
i									
Crew									

DESCRIPTION PAV MARKINGS JOB NO. _____

LEFT CENTER LINE RIGHT

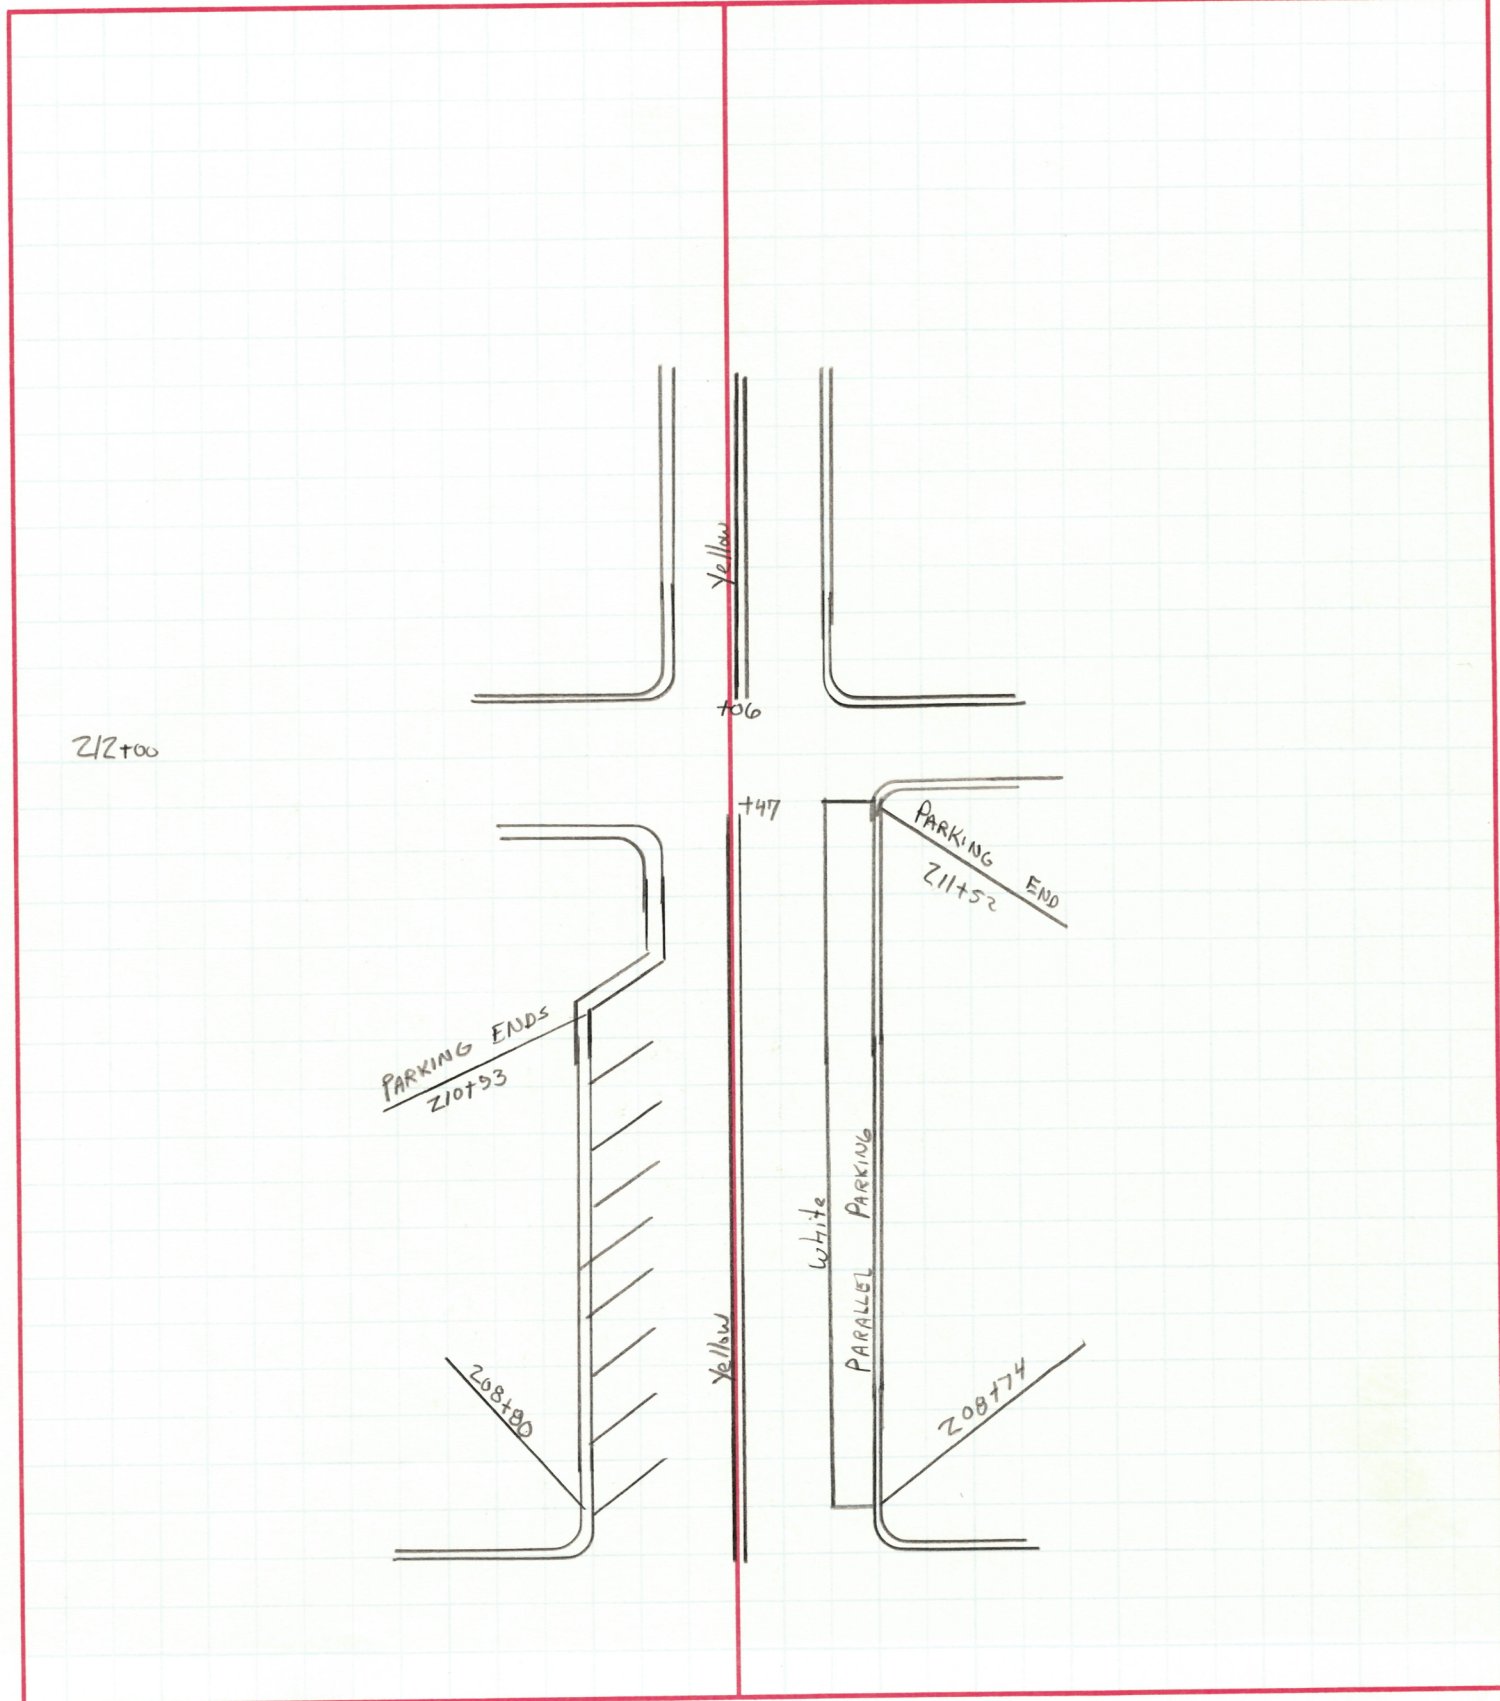

DATE 7-27-94

1995 ~~1994~~ TWO-LANE RESURFACING PROGRAM
CENTERLINE PAVEMENT MARKINGS
INSIDE CITY LIMITS ONLY

SHEET 17 OF 19

COUNTY FULTON ROUTE S.R. 2 SECTION 0.0

[illegible]

DATE 7-28-94

1995 ~~2020~~ TWO-LANE RESURFACING PROGRAM
CROSSWALKS AND STOP BARS

SHEET 18 OF 19

COUNTY FULTON ROUTE S.R. 2 SECTION 0.0

[illegible]

TWO-LANE RESURFACING PROGRAM
PAVEMENT DATA

SHEET 19 OF 19

COUNTY Fulton ROUTE S.R. 2 SECTION 0.00

* = STATION LOCATION

[illegible]