

NOTES TO:
B. Rosebrock
11-15-95

FY 1996

Moser

Huss

PRIORITY NO. 22 PART 1 OF 2 SHEET 1 OF
COUNTY Fulton ROUTE SR 2 SECTION 9.42
BEGIN LOG (SLM) 9.42 TERMINII const joint (near Co. Rd. 19)
END LOG (SLM) 14.55 TERMINII SR 108
TOTAL LENGTH 5.13 MILES
MUNICIPALITY Wauseon BEGIN LOG (SLM) END LOG (SLM)
MUNICIPALITY BEGIN LOG (SLM) END LOG (SLM)
PROPOSED WORK: Grind asphalt pavement full width @ curb areas & resurface
PAVEMENT 1 1/2" 404 SHOULDER SAME
OTHER

STATION ESTABLISHED FROM:

R.R. SPIKE IN INT OF C.R. 19 STA. 495+20

STRUCTURES:

NUMBER	STATION	WIDTH	LENGTH	PROPOSED WORK

RAILROAD CROSSING:

(NO WORK)

NAME STATION NO. TRACKS LENGTH ALONG C L FT
NAME STATION NO. TRACKS LENGTH ALONG C L FT

MISCELLANEOUS:

NO RAISED PAVEMENT MARKERS; EDGE OF PAVEMENT -D- CENTERLINE 296

NO. MAILBOX APPROACHES N/A MAILBOX SUPPORTS N/A

REMARKS: Butt joints @ Fulton Street - do not pave intersection

Begin Const. JT. 498+21

CONST. JOINT @ 108 SEE SKETCH

DATE 11-20-10

TWO-LANE RESURFACING PROGRAM
 UTILITIES (CATCH BASIN, MANHOLE, INLET, WATER VALVE, BOX AND MONUMENT BOX)

SHEET 1 OF 19

 COUNTY Fulton ROUTE 2 SECTION 9.42

R = RAISE F = FEATHER

STATION	OUT (FT) RT/LT OF C	CATCH BASIN	MAN- HOLE	INLET	W V BOX	MON BOX	CASTING		REMARKS (NW) ie: RECONSTRUCT, NO WORK
							R	F	
713+66	RT 16'				X			X	N.W.
713+78	RT 18.8'				X			X	N.W.
713+82	RT 16'				X			X	N.W.
713+61	Rt 22'			X					N.W. (offset)
720+40	Lt 13'			X					N.W. (offset)
723+03	Rt 13.8'	X							N.W.
723+34	Lt 15'			X					N.W. (offset)
723+62	Rt 10'				X			X	N.W.
723+67	Lt 17'		X					X	N.W.
723+72	Rt 15'			X					Reconstruct (offset)
724+03	Lt 14'			X					N.W. (offset)
727+29	Lt 17'		X					X	N.W.
729+93	Lt 15'			X					New - in conc. - No work
729+98	Lt 16'		X						New - in conc. - No work
730+37	Lt 18'		X						New - in conc. - No work
732+77	Lt 14'		X					X	N.W.
732+84	Lt 13'		X					X	N.W.
733+21	Rt 14'				X			X	N.W.
736+26	Lt 19'			X					N.W. (offset)
736+40	Lt 17'		X					X	N.W.
736+54	Lt 18'		X					X	N.W.
736+77	Lt 22'			X					N.W. (offset)
736+78	Lt 15'		X					X	N.W.
739+66	RT 15'			X					N.W. (offset)
739+92	Lt 16'			X					Reconstruct (offset)
742+77	RT 10'				X			X	N.W.
744+99	RT 23'		X						N.W.

DATE 11-01-11

TWO-LANE RESURFACING PROGRAM
 UTILITIES (CATCH BASIN, MANHOLE, INLET, WATER VALVE, BOX AND MONUMENT BOX)

SHEET 2 OF 19

 COUNTY Fulton ROUTE 2 SECTION 9.42

R = RAISE F = FEATHER

STATION	OUT (FT) RT/LT OF C	CATCH BASIN	MAN- HOLE	INLET	W V BOX	MON BOX	CASTING		REMARKS ie: RECONSTRUCT, NO WORK
							R	F	
				X					N.W.
745+13	Lt 23'							X	Reconstruct
746+70	RT - 25'	X						X	(Broken grate)
746+76	Lt - 24'	X						X	NW
746+75	RT 18'		X					X	NW
746+92	Lt 30'		X					X	NW
746+93	C		X					X	NW
747+38	Lt 1'		X					X	NW
747+50	Lt 17'		X					X	NW
747+50	RT 15'		X					X	NW
747+62	Lt 8'				X			X	NW
747+68	Lt 19'				X			X	NW
746+97	Lt 34'				X			X	NW
746+97	Lt 7'				X			X	NW
748+58	RT 12'	X						X	NW
749+04	RT 19'		X					X	NW
749+42	RT 1'		X					X	NW
749+59	RT 16'		X					X	NW
750+03	RT 18'	X						X	NW
753+52	Lt 16'			X				X	NW
753+65	C		X					X	NW
753+68	RT 15'			X				X	NW
756+33	RT 16'	X						X	NW
756+47	RT 9'		X					X	NW
759+96	Lt. 30'	X						X	NW
759+98	RT. 30'	X						X	NW
760+01	Lt 1'				X			X	NW
760+12	RT 30'				X			X	NW

SHEET 3 OF 19

SHEET 3 OF 19

UTILITIES (CATCH BASIN, MANHOLE, INLET, WATER VALVE, BOX AND MONUMENT BOX)

COUNTY Fulton ROUTE 2 SECTION 9.42

R = RAISE F = FEATHER

[illegible]

DATE 11-01-13TWO-LANE RESURFACING PROGRAM
PAVEMENT DATASHEET 4 OF 19NOTE: LOCATE ALL
CHANGES IN PVMT WIDTHCOUNTY Fulton ROUTE 2 SECTION 7.42

MILE MARKER	STATION	LEFT BERM WIDTH (TYPE)	PAVEMENT WIDTH OUT/OUT WHITE LINES	RIGHT BERM WIDTH (TYPE)
	498+21	1.9'	22.9'	2.2'
10	528+16	1.5'	22.1'	2.5'
	550+00	2.0'	21.1'	2.6'
11	579+81	2.0'	21.6'	2.3'
	604+00	2.2'	21.3'	1.6'
12	640+08	1.8'	21.8'	2.4'
	650+00	3.0'	27.9'	2.1'
	652+00	3.0'	27.4'	1.5'
	662+00	4.6'	25.7'	2.0'
	664+00	1.0'	23.5'	2.6'
13	691+52	2.4'	21.6'	1.4'
	710+00	2.8'	21.3'	1.2'
	713+36	(Curb Starts on Rt. side)		X
	714+32	(Curb Starts on Lt. side)	(Curb to Curb) 23.5'	
	722+00		Curb to Curb 23.3'	
	732+00		Curb to Curb 24.6'	
	744+66		Curb to Curb 40'	
	745+00		Curb to Curb 49'	
	746+24		Curb to Curb 49.6'	
	751+00		Curb to Curb 48'	
	751+20		Curb to Curb 40'	
	751+21		Curb to Curb 32'	
	756+00		Curb to Curb 32'	
	757+24		Curb to Curb 28'	
	761+00		Curb to Curb 28'	
	766+00		Curb to Curb 28'	

SHEET 5 OF 19

NOTE: LOCATE ALL
CHANGES IN PVMT WIDTH

COUNTY Fulton ROUTE 2 SECTION 9.42

* = STATION LOCATION

[illegible]

SHEET 6 OF 19

SHEET 6 OF 19

COUNTY Fulton ROUTE 2 SECTION 9.42

[illegible]

SHEET 7 OF 19

SECTION 9.42

COUNTY Fulton ROUTE 2 SECTION 1.12

[illegible]

COUNTY Fulton ROUTE 2 SECTION 9.42

[illegible]

DATE 11-01-11TWO-LANE RESURFACING PROGRAM
INTERSECTIONSSHEET 9 OF 19COUNTY Fulton ROUTE 2 SECTION 9.42

L = PROP PAVT DEPTH (IN) X 10; W = WIDTH @ MOUTH; W-I = WIDTH @ THROAT

STATION	SIDE	NAME OR NO.	L	W	W-I	ASPH	CONC	REMARKS
518+21	Lt.	Fulton 18-2	15'	62'	24.6'	X		
544+85	Rt.	Fulton 18	15'	90'	46.7'	X		
544+85	Lt.	Fulton 18	15'	79'	36'	X		
597+98	Rt.	Fulton 17	15'	77'	33'	X		
597+98	Lt.	Fulton 17	15'	84'	35.5'	X		
647+18 *	Rt.	Fulton E				X		(See Sketch)
652+14	Rt.	Fulton 16				X		(See Sketch)
658+93 *	Lt.	Fulton 16						(See Sketch)
664+22 *	Lt.	Fulton 16 (Access)						(See Sketch)
700+98	Lt.	West Elm Apts.	15'	62'	32'		X	Apt Lot Entrance
706+81	Lt.	Enterprise Rd	15'	141'	53'	X		
713+87	Rt.	Lawrence Ave	15'	96'	39'	X		2' Conc. Ribbon/Meas. Curb to Curb
720+75	Lt.	Grant St.	15'	60'	21'	X		
723+69	LT.	McKINLEY AVE	15'	53'	20'	X		
727+45	LT.	DETROIT AVE	15'	67'	25'	X		
730+18	LT.	IRONTON ST.	15'	78'	29.4'		X	
733+05	RT.	N. BRUNELL ST.	15'	80'	35'	X		
733+05	LT.	N. BRUNELL ST.	15'	82'	40'	X		
736+54	LT.	MONROE ST.	15'	114'	34'	X		2' CONC. RIBBONS MEAS. ASPHALT
739+77	LT.	MADISON	15'	37'	19'	X		
743+16	LT.	CLINTON ST.	15'	85'	52'	X		
743+16	RT.	CLINTON ST.	15'	80'	40'	X		
747+08		FULTON ST.						(SEE SKETCH)
756+56	LT.	N. FRANKLIN	15'	72'	26'	X		
756+56	RT.	N. FRANKLIN	15'	72'	28'	X		
760+19	LT.	MARSHALL ST.	15'	94'	37'	X		MEAS ASPHALT 2 CONC. RIBBONS
760+19	RT.	MARSHALL ST.	15'	97'	36'	X		" " "

* = Extended Point of Intersection Sta.

194SWH


OHIO DEPARTMENT OF TRANSPORTATION

SHEET NO. 10 of 19

PERSONNEL	TITLE	PERSONNEL	TITLE	COUNTY	DATE
<u>VAN DUSEN</u>				<u>FULTON</u>	<u>11-1-25</u>
<u>MOSEK</u>				S. R. <u>2</u>	WEATHER <u>Cloudy</u>
<u>HUSS</u>				SEC. <u>9.42</u>	TEMP. <u>+60° F</u>

DESCRIPTION INTERSECTION SKETCH S.R. 2 & Co. RD. E JOB NO. _____

LEFT CENTER LINE RIGHT

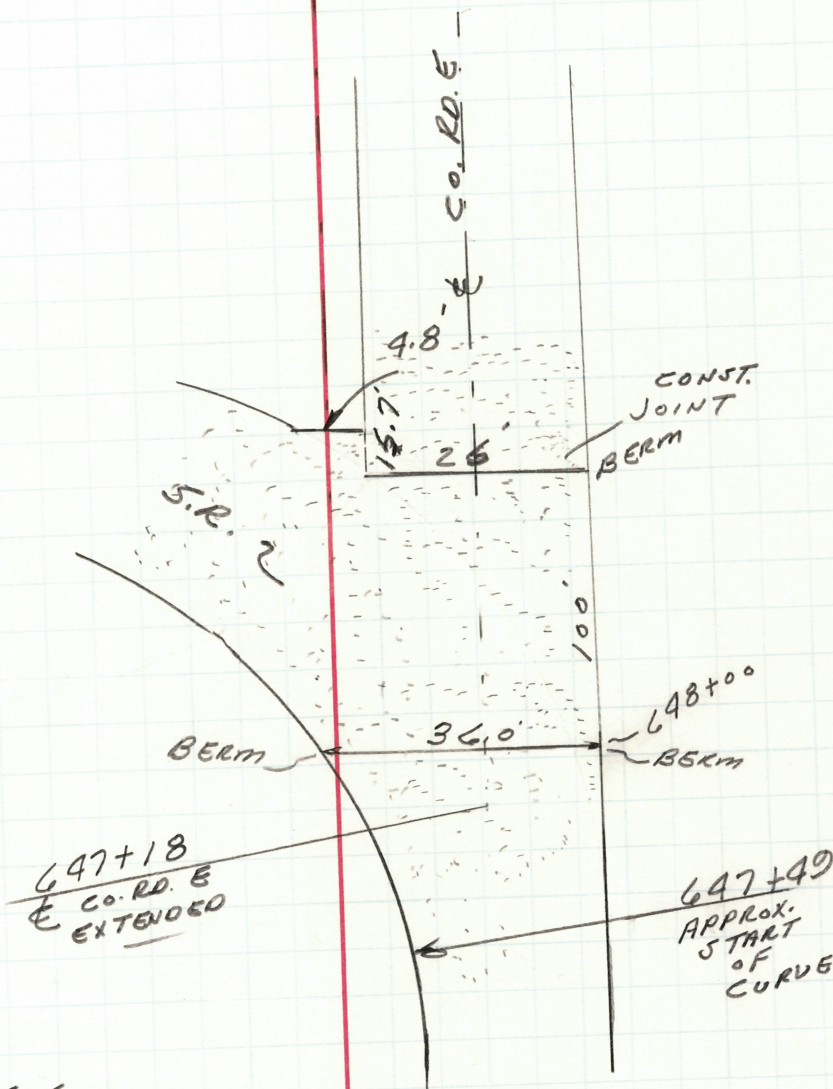

194SWH

OHIO DEPARTMENT OF TRANSPORTATION

SHEET NO. 11 of 19

PERSONNEL

TITLE

PERSONNEL

TITLE

COUNTY FULTONDATE 11-1-95VAN DUENMOSEKHUSSS. R. 2WEATHER CLOUDYSEC. 9.42TEMP. +60°F

JOB NO. _____


DESCRIPTION

INTERSECTION DETAIL

LEFT


CENTER LINE

RIGHT

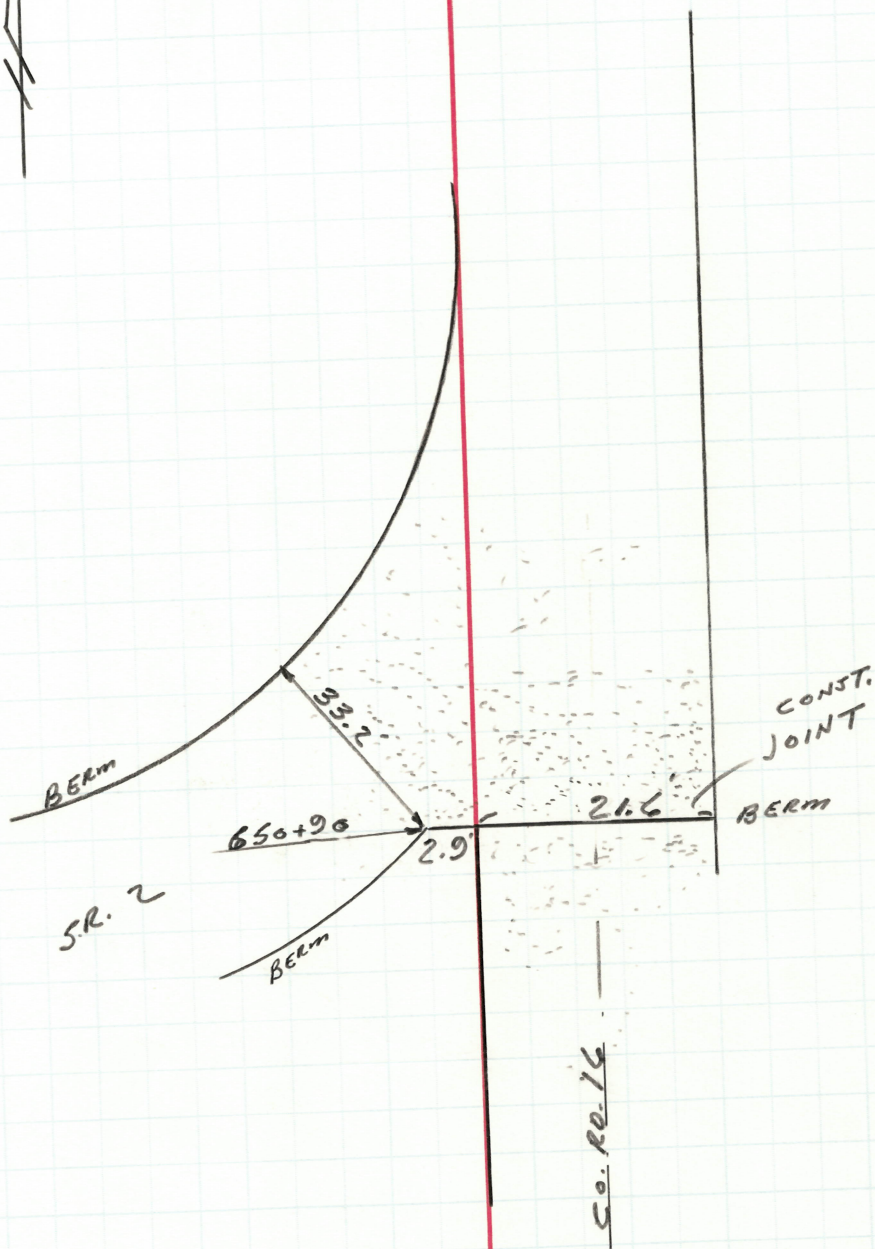


PERSONNEL	TITLE	PERSONNEL	TITLE	COUNTY	DATE	WEATHER	TEMP.
<u>VAN DUSEN</u>	_____	_____	_____	<u>FULTON</u>	<u>11-1-25</u>	<u>CLOUDY</u>	<u>+60°F</u>
<u>MOSEK</u>	_____	_____	_____	S. R. <u>2</u>			
<u>HUSS</u>	_____	_____	_____	SEC. <u>9.42</u>			

DESCRIPTION INTERSECTION DETAIL JOB NO. _____
LEFT CENTER LINE RIGHT

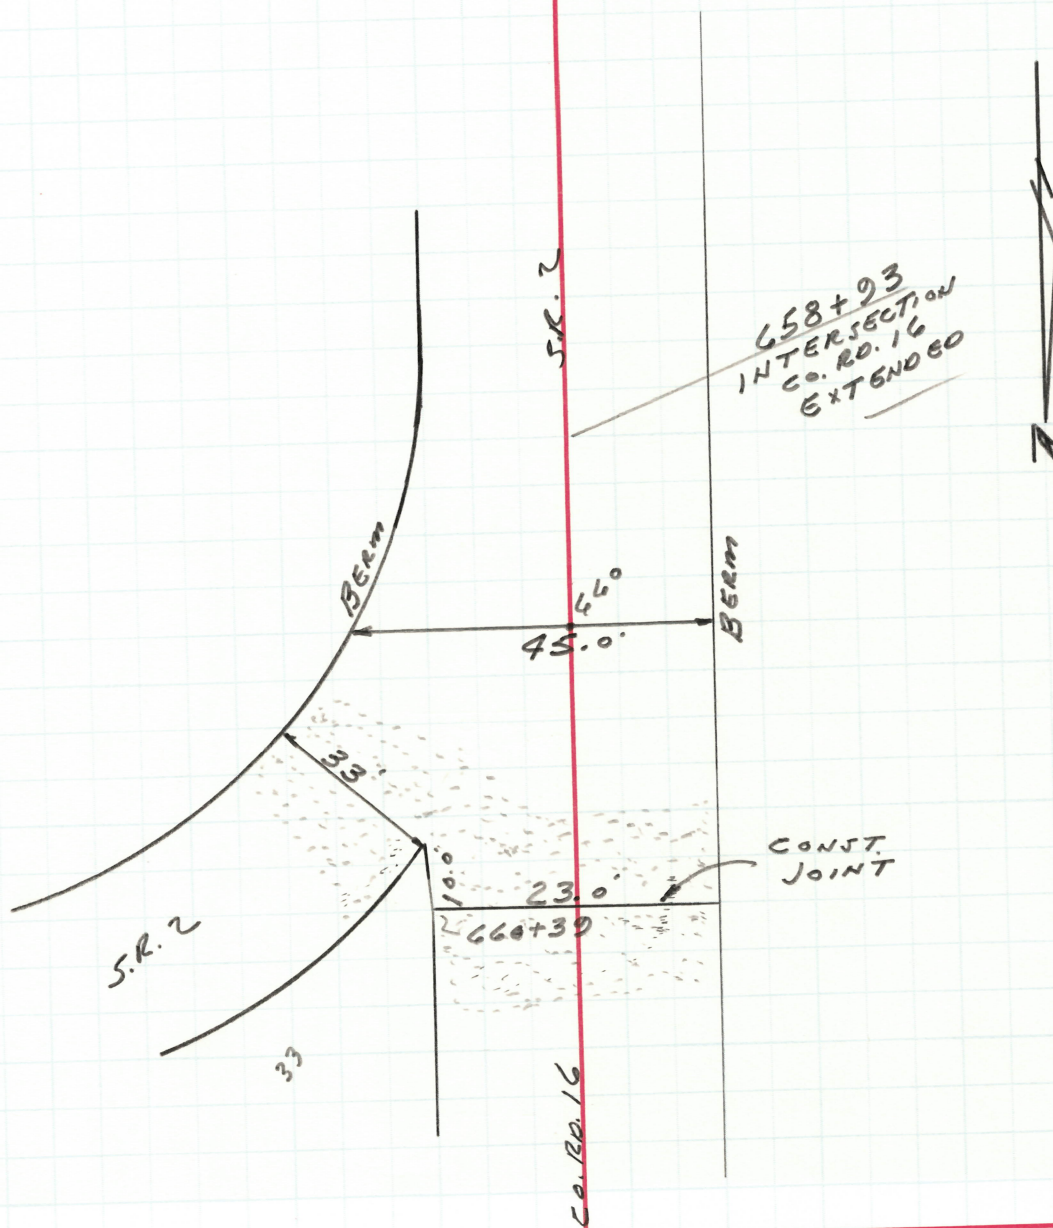

DESCRIPTION INTERSECTION DETAIL JOB NO. _____
 LEFT CENTER LINE RIGHT

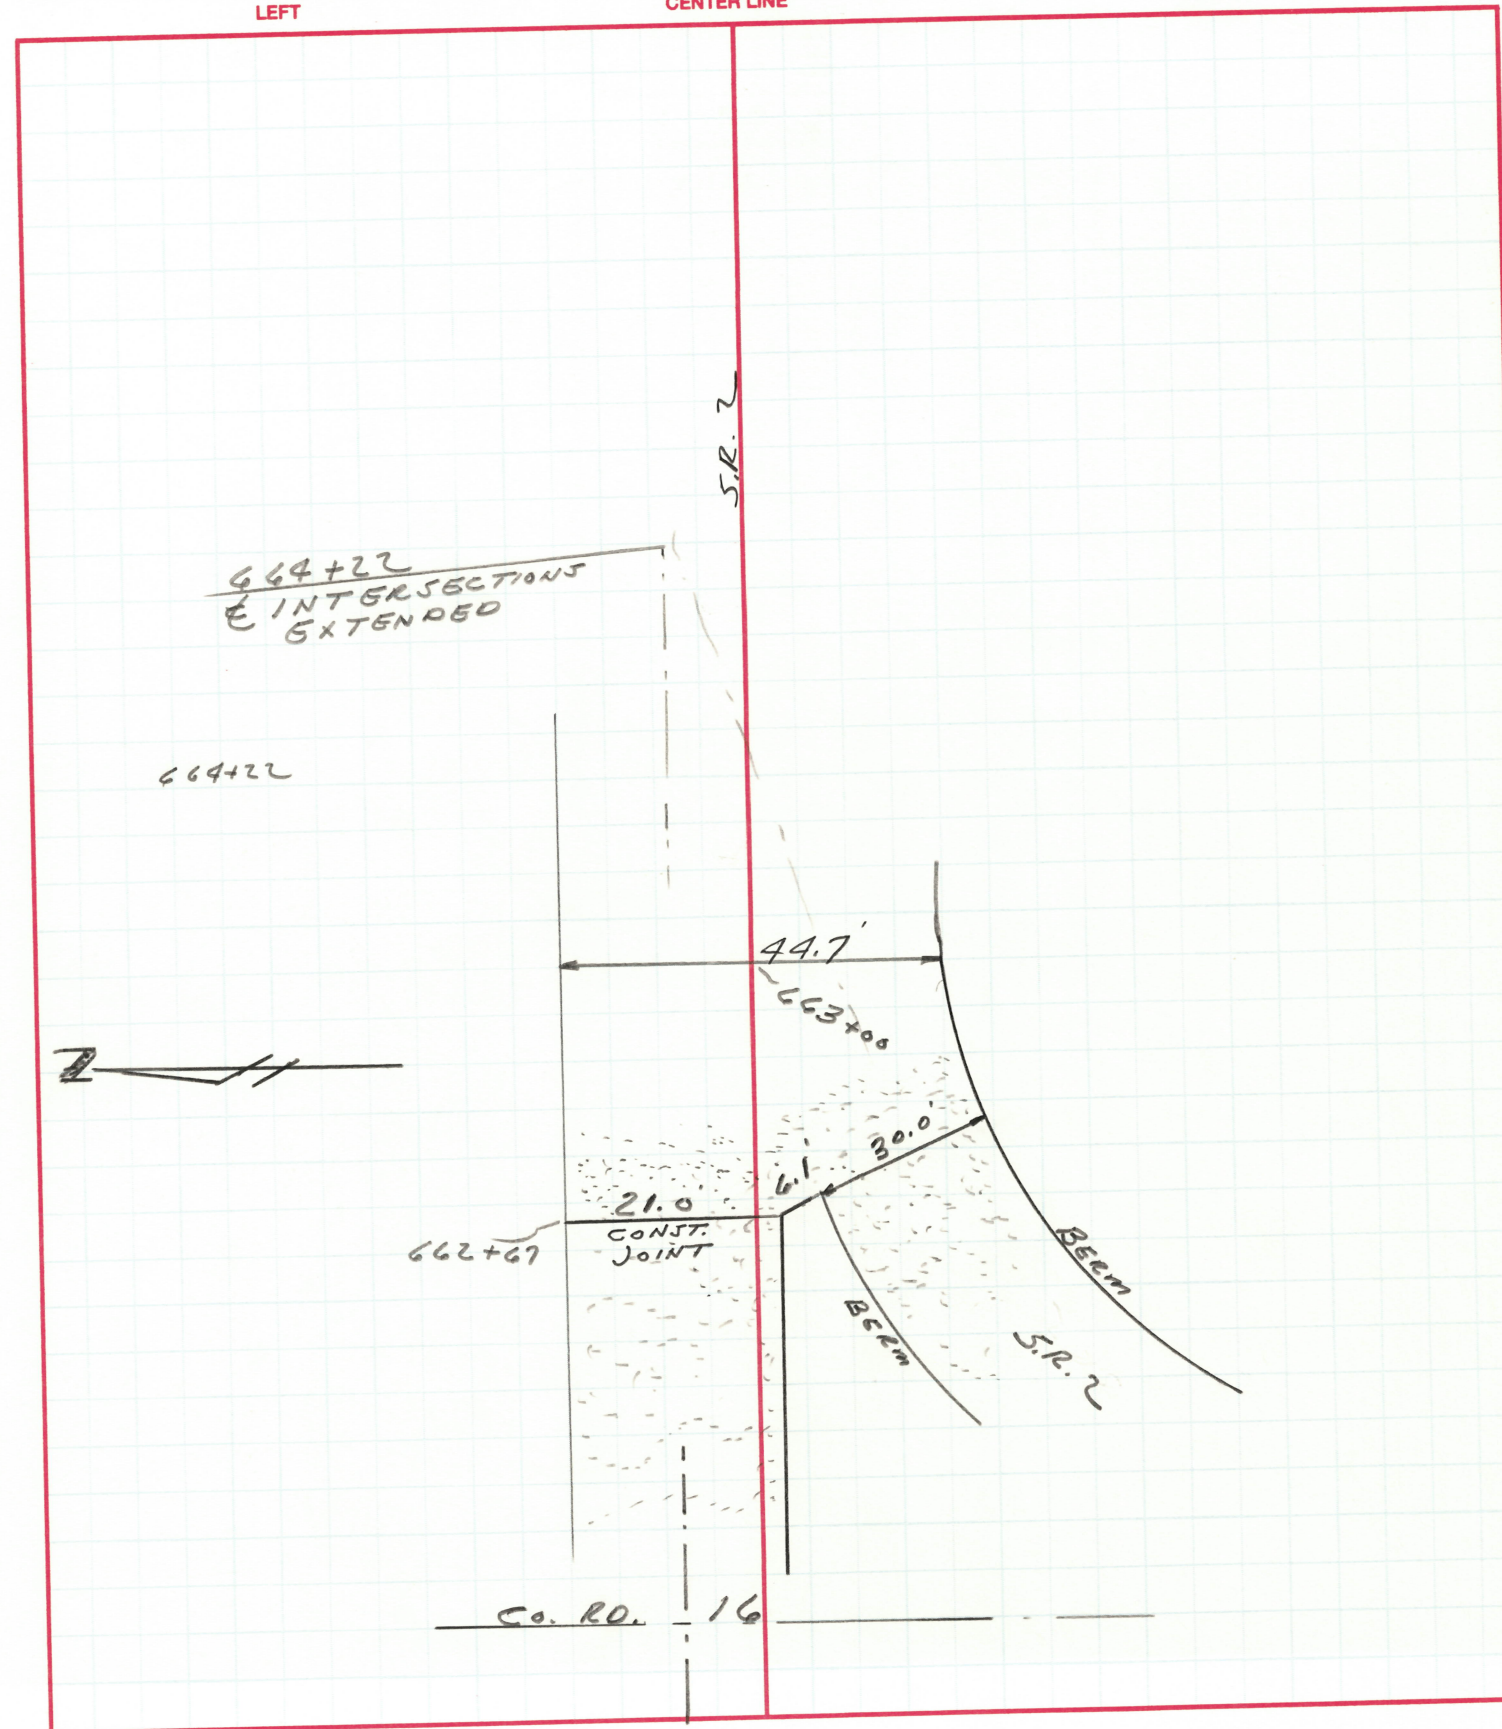


194SWH

OHIO DEPARTMENT OF TRANSPORTATION

SHEET NO. 14 of 19

PERSONNEL	TITLE	PERSONNEL	TITLE	COUNTY	DATE	WEATHER	TEMP.
<u>VAN DUSEN</u>				<u>FULTON</u>	<u>11-3-95</u>	<u>CLOUDY</u>	<u>+35°F</u>
<u>MOSEK</u>				S. R. <u>2</u>			
<u>HUSS</u>				SEC. <u>9.42</u>			
DESCRIPTION <u>INTERSECTION DETAIL</u>				JOB NO. _____			
LEFT		CENTER LINE		RIGHT			

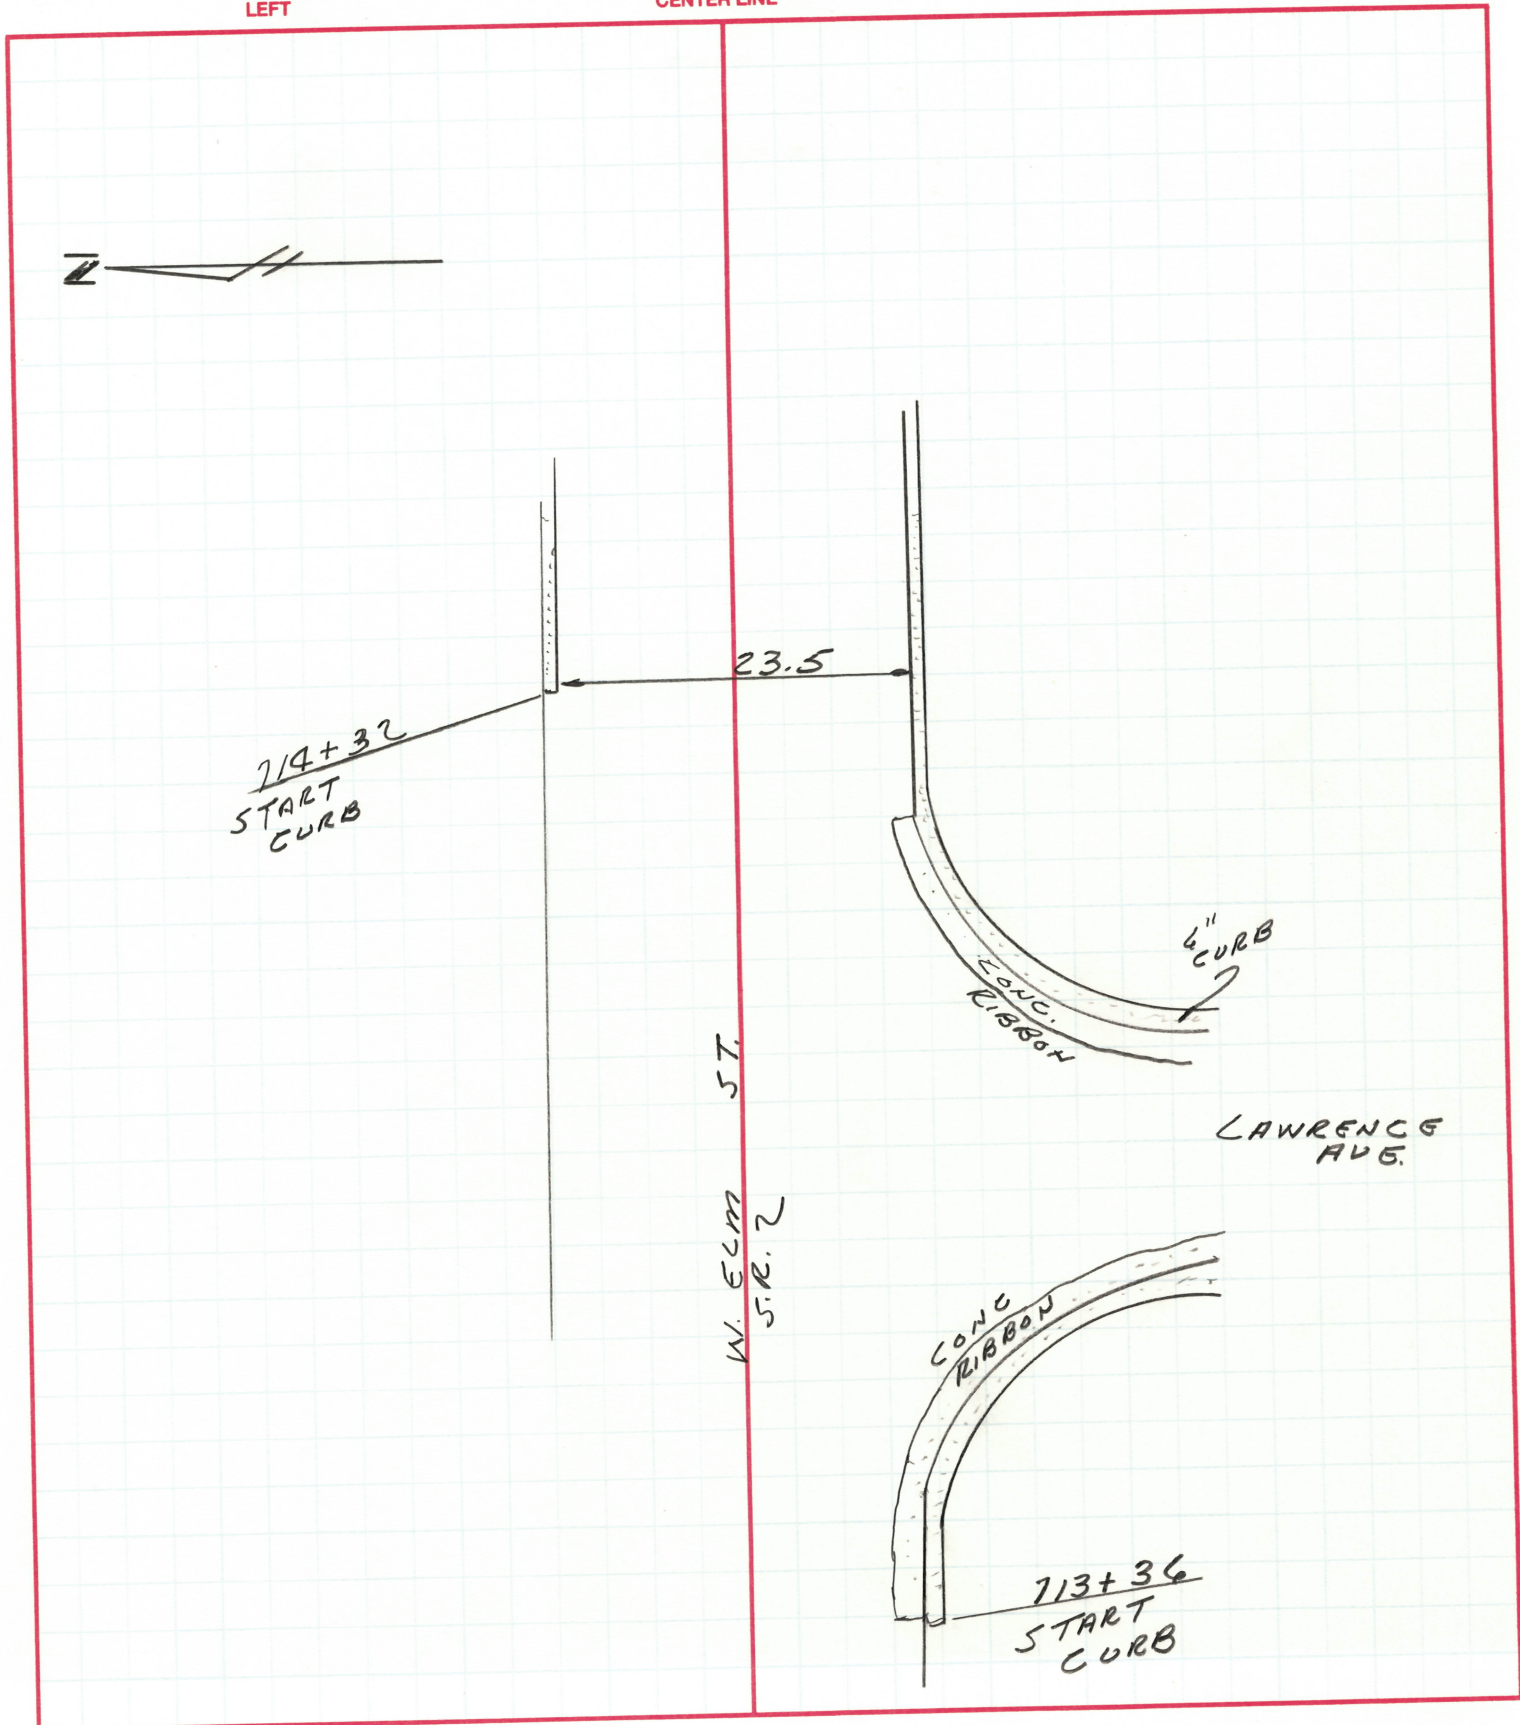


194SWH

OHIO DEPARTMENT OF TRANSPORTATION

SHEET NO. 15 of 19


PERSONNEL	TITLE	PERSONNEL	TITLE	COUNTY	DATE
<u>VAN DUSEN</u>				<u>FULTON</u>	<u>11-3-9</u>
<u>MOSEK</u>				S. R. <u>2</u>	WEATHER <u>cloudy</u>
<u>HUSS</u>				SEC. <u>9.42</u>	TEMP. <u>+35° F</u>
DESCRIPTION <u>PAVEMENT WIDTH CHANGE</u>				JOB NO. _____	
LEFT		CENTER LINE		RIGHT	

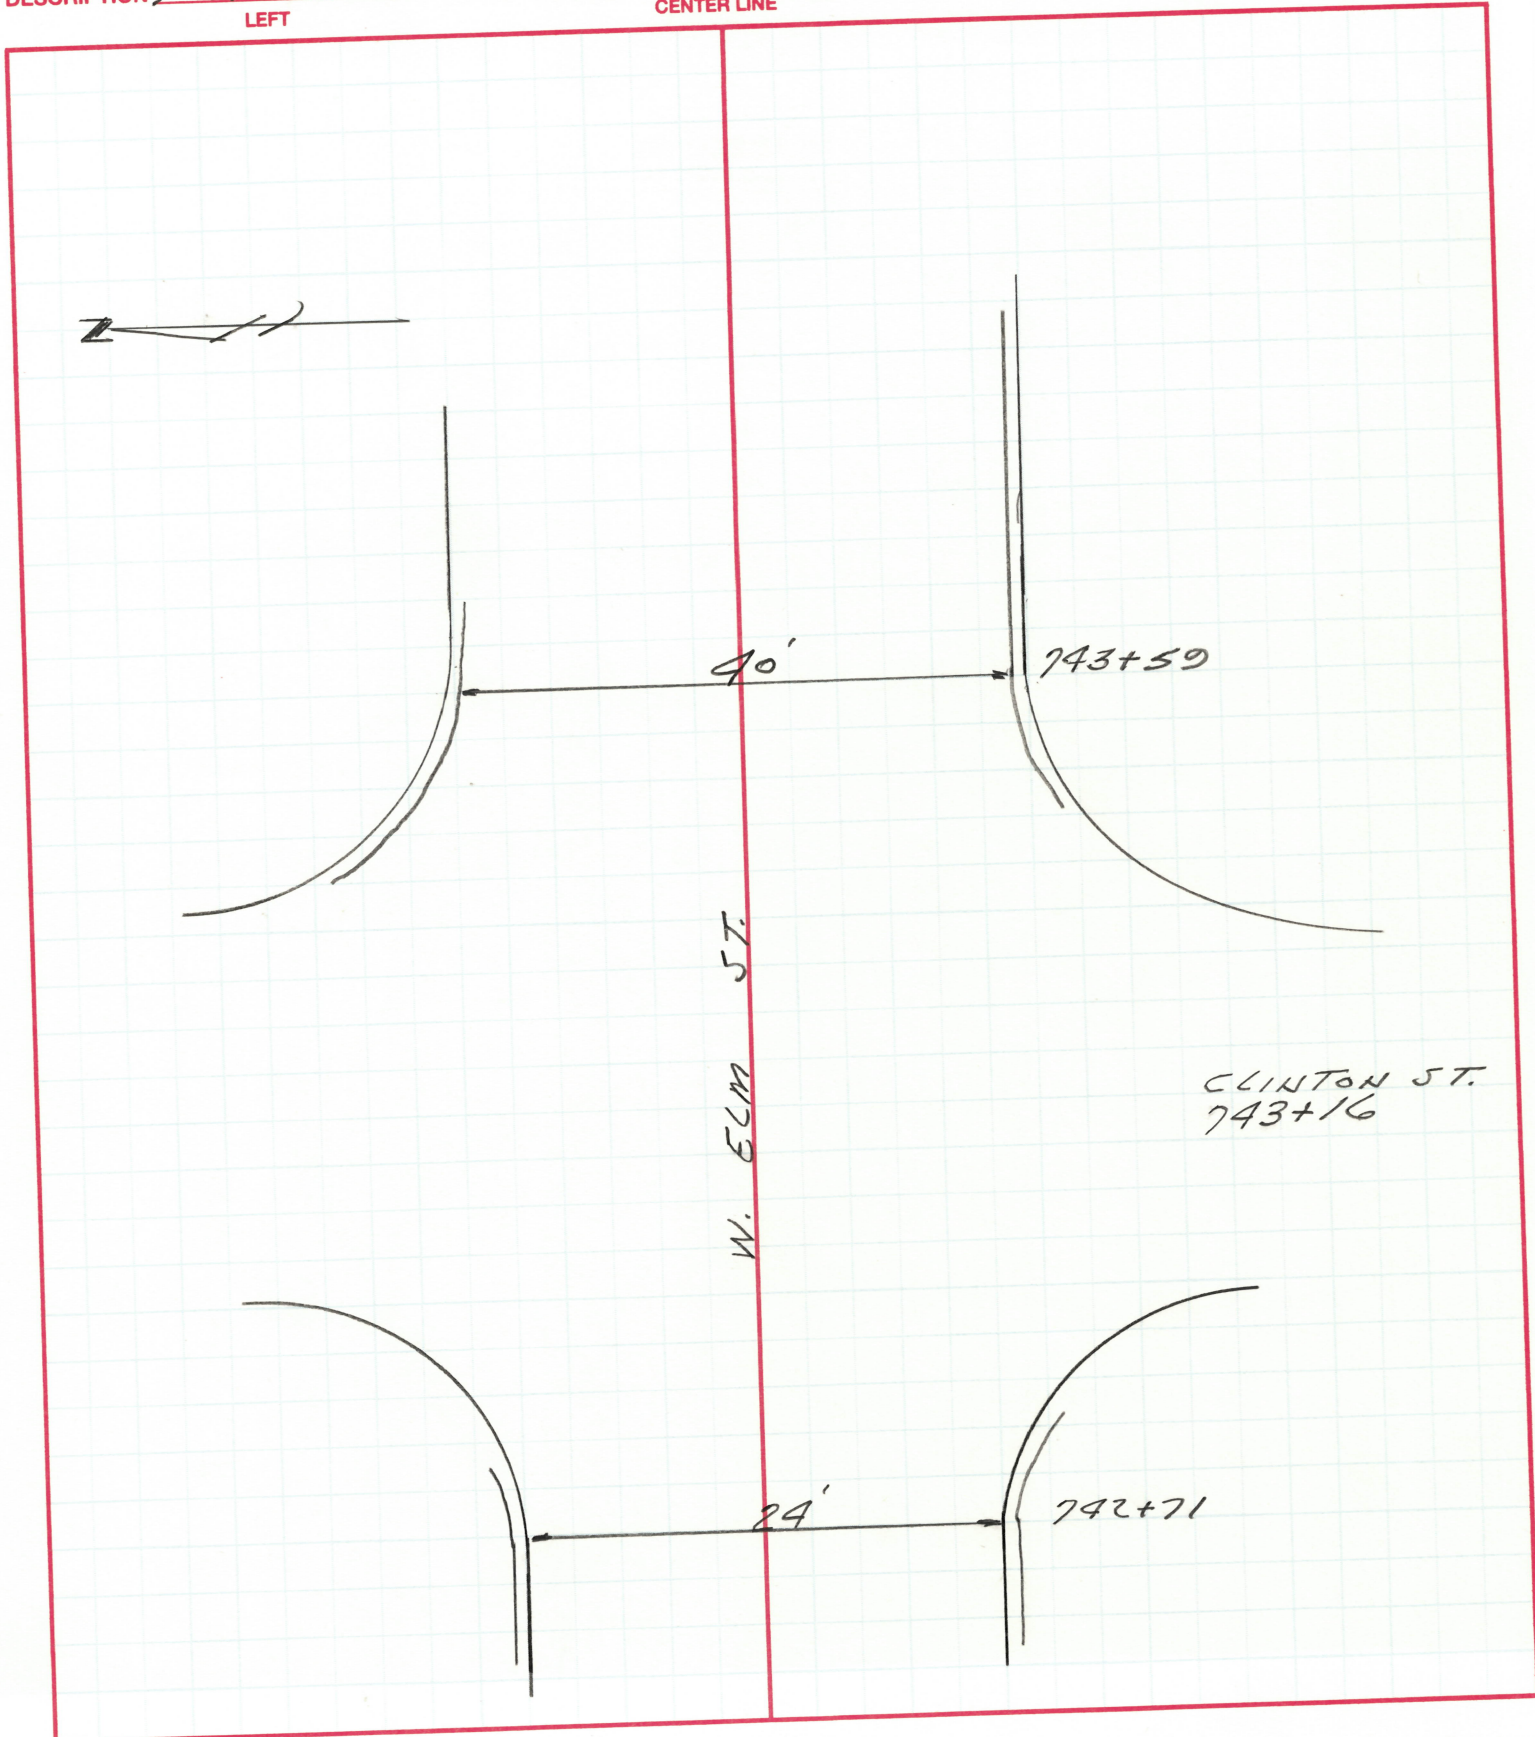

PERSONNEL	TITLE	PERSONNEL	TITLE	COUNTY	DATE	WEATHER	TEMP.
VANDUSEN				FULTON	11-3-95	CLOUDY	+35°F
MOSEK				S. R. 2			
HUSS				SEC. 9.42			

DESCRIPTION PAVEMENT WIDTH @ INTERSECTION OF FULTON ST. & S.R. 2

LEFT CENTER LINE RIGHT

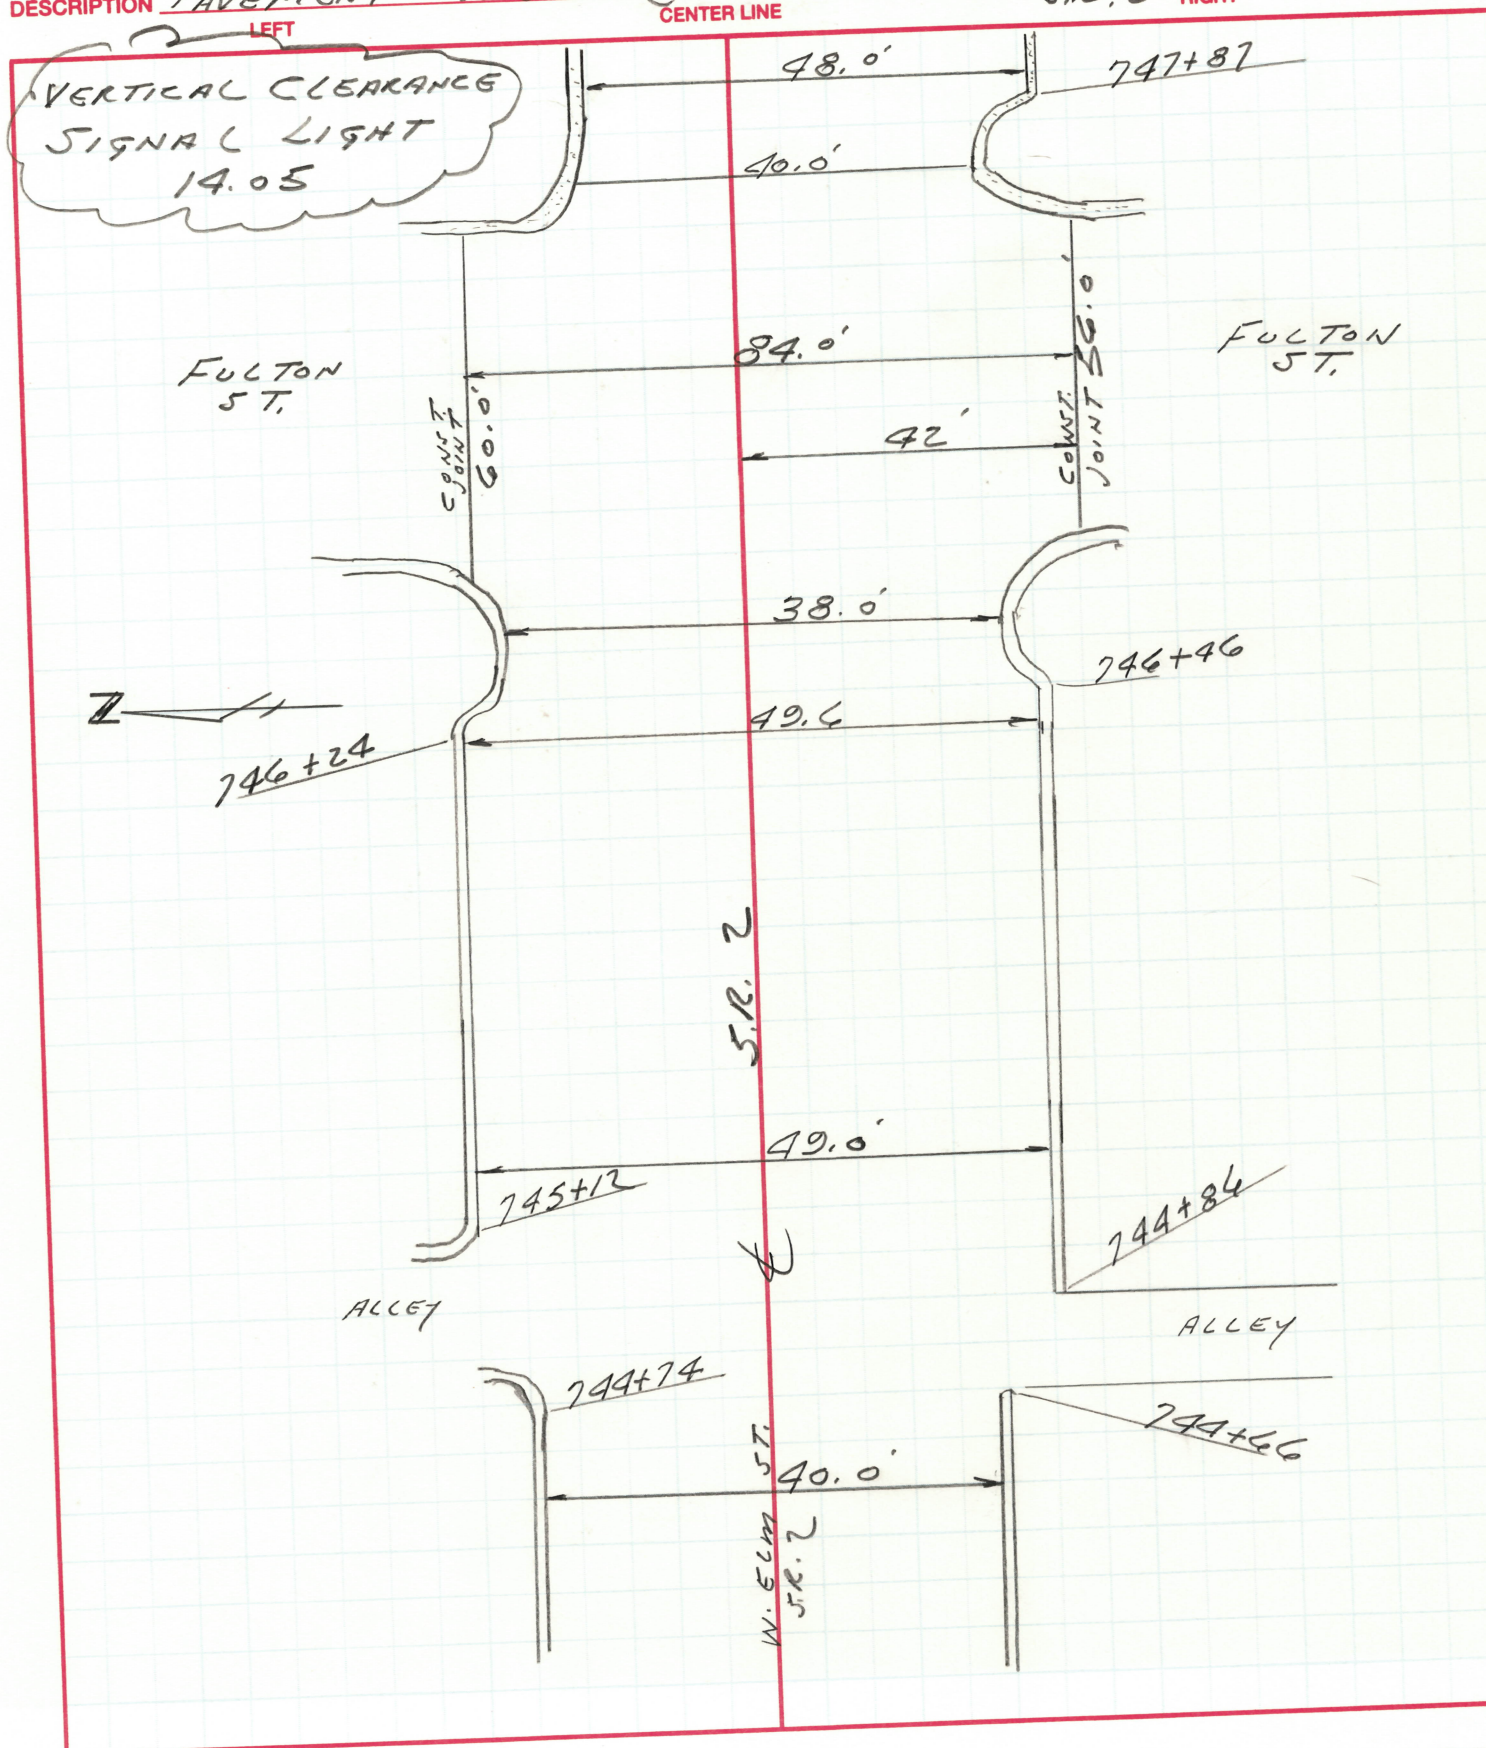


194SWH

OHIO DEPARTMENT OF TRANSPORTATION

SHEET NO. 17 of 19

PERSONNEL	TITLE	PERSONNEL	TITLE	COUNTY	DATE	WEATHER	TEMP.	JOB NO.
<u>VAN DUSEN</u>				<u>FULTON</u>	<u>11-3-95</u>	<u>CLOUDY</u>	<u>+35°F</u>	
<u>MOSEER</u>				S. R. <u>2</u>				
<u>HUSS</u>				SEC. <u>9.42</u>				
DESCRIPTION <u>PAVEMENT WIDTHS</u>								
LEFT				CENTER LINE		RIGHT		

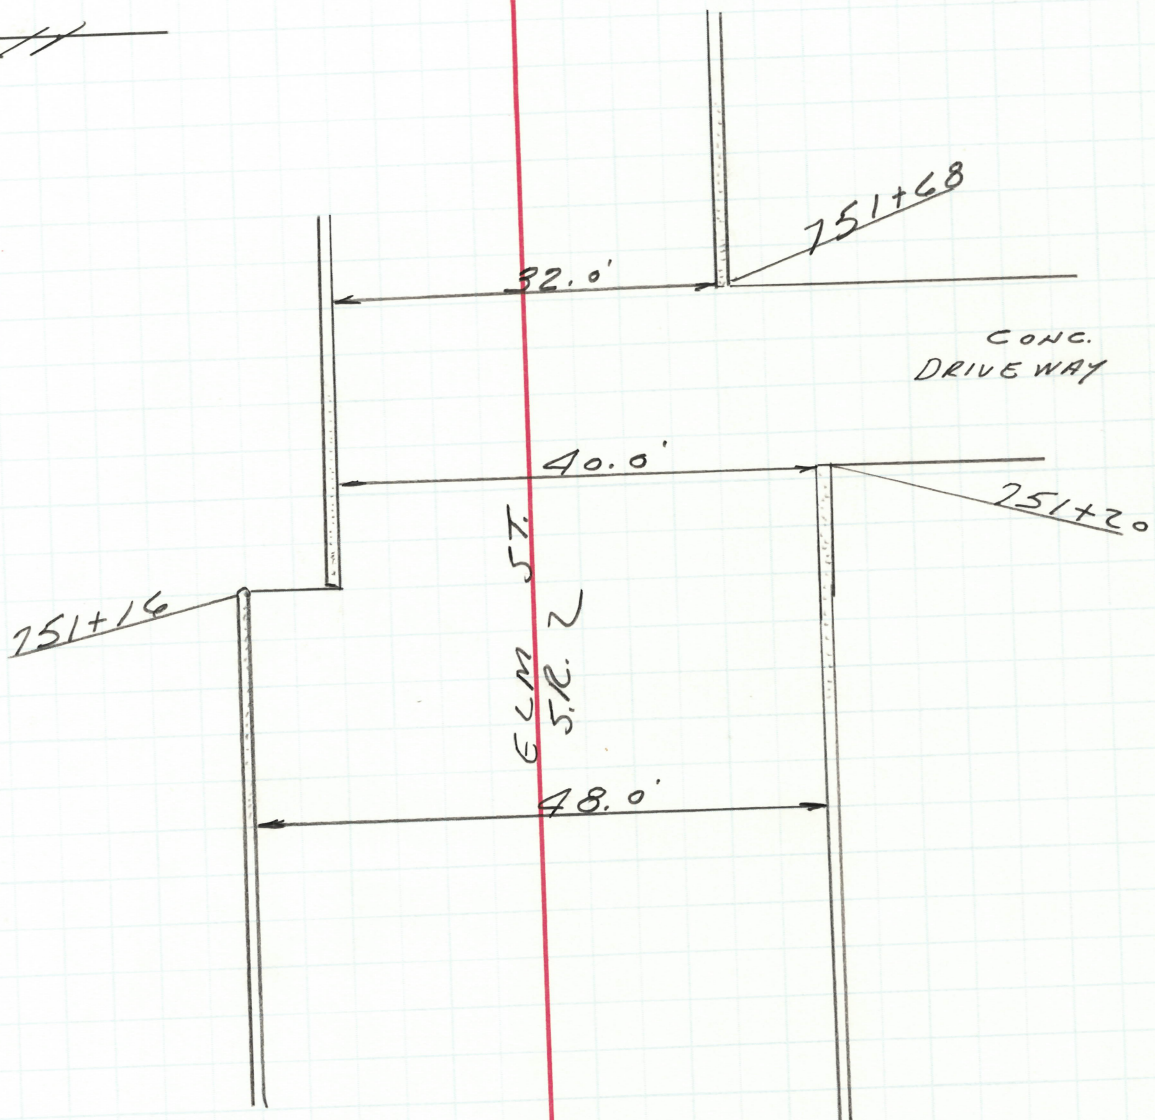


1945WH

OHIO DEPARTMENT OF TRANSPORTATION

SHEET NO. 18 of 19

PERSONNEL	TITLE	PERSONNEL	TITLE	COUNTY	DATE	WEATHER	TEMP.	JOB NO.
VAN DUSEN				FULTON	11-6-95	SUNNY	+30°F	
MOSEK				S. R. 2				
HUSS				SEC. 9.42				
DESCRIPTION				PAVEMENT WIDTHS FRANKLIN & S.R. 2				
LEFT		CENTER LINE		RIGHT				

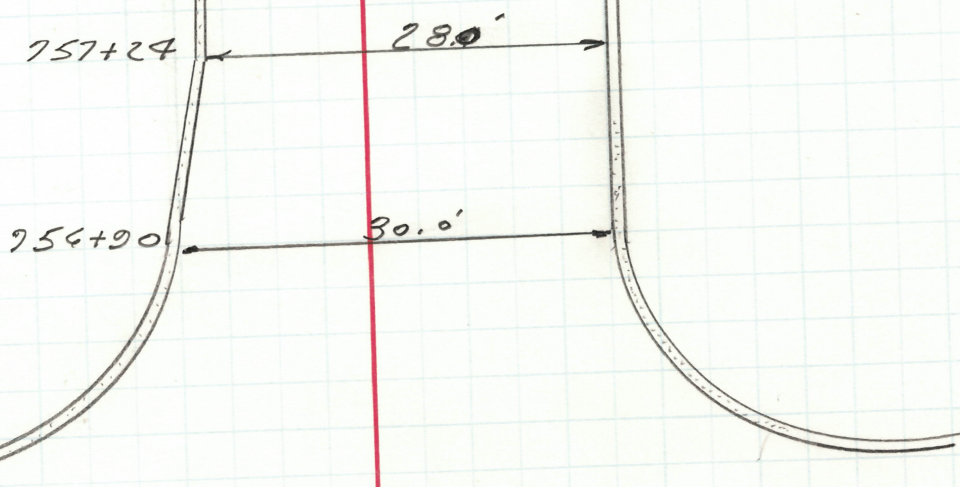

N. FRANKLIN

756+56

S.T.
ELM
S.R. 2

766+47
194SWH
+ 01 106

OHIO DEPARTMENT OF TRANSPORTATION

SHEET NO. 19 of 19

PERSONNEL	TITLE	PERSONNEL	TITLE	COUNTY	DATE	WEATHER	TEMP.
VAN DUSEN				FULTON	11-6-95	JUNNY	+35°F
MOSEK				S. R. 2			
HUSS				SEC. 9.42			

DESCRIPTION INTERSECTION OF S.R. 2 & 108
LEFT CENTER LINE RIGHT JOB NO.

7

