


O.D.O.T. DISTRICT 2 SURVEY OFFICE (USE ONLY)

PERSONNEL _____ REFERENCE NO. 6 SHEET 6 OF 15
 NOTES HOMAN DATE 5/30/12 ROUTE SR 2
 H.C. ROUSOS WEATHER SUNNY COUNTY FULTON
 R.C. HOMAN TEMP. 75° TOWNSHIP GERMAN
 _____ SECTION 31
 _____ T 7 N R 5 E


TYPE MONUMENT P.K./WASHER
 ON SURFACE - ~~BELOW~~ ON
~~LEFT~~ - CL PAV'T - ~~RIGHT~~ ON
10.1' TO RT EDGE PAVEMENT
 S.L.M. 124+36

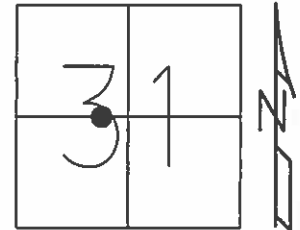

GRID: NORTHING: 681073.435 EASTING: 1465936.621

RECORD

RESET PK/WASHER
 9-4-1996 MC
 RESET PK/WASHER
 8-21-2012 DCH

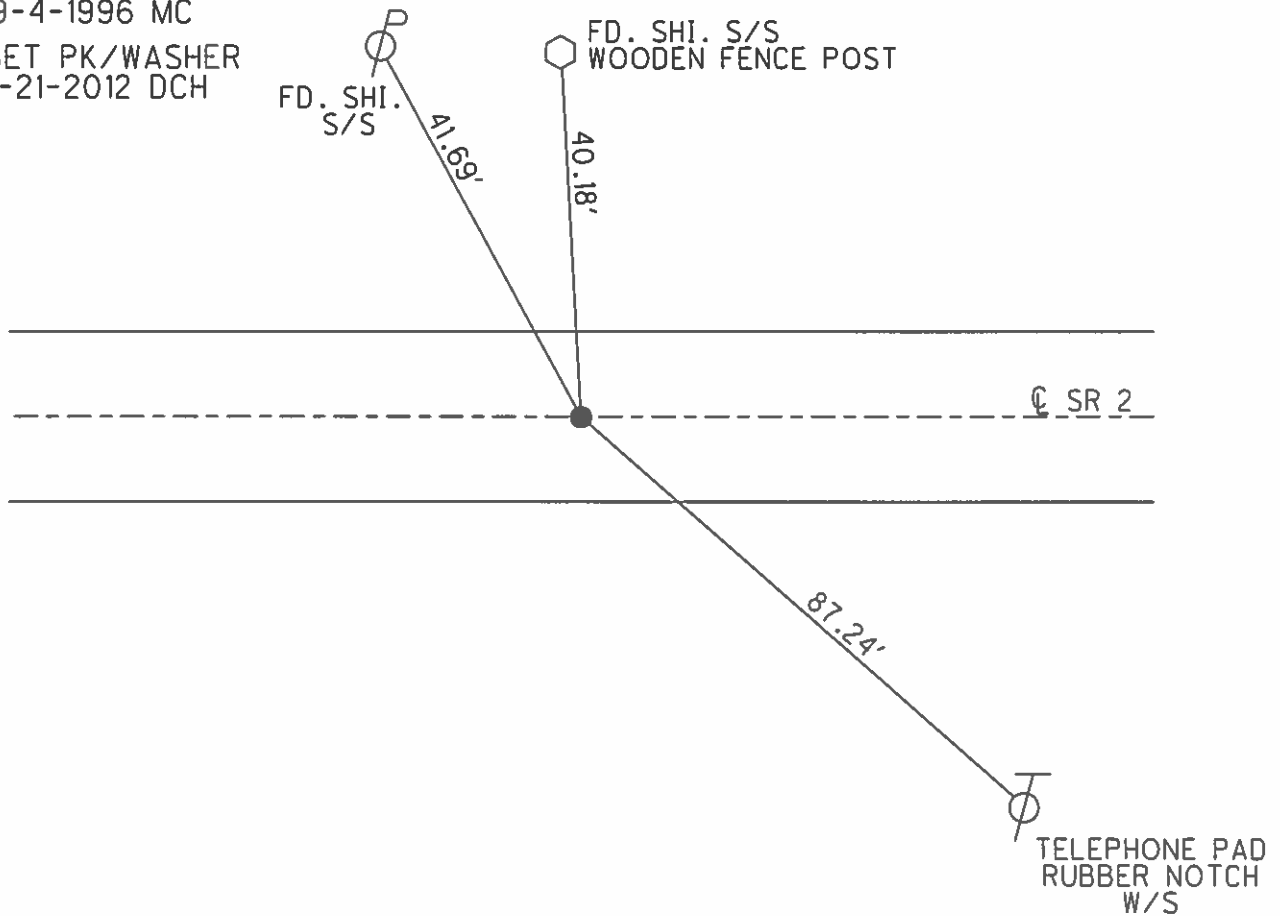

O.D.O.T. DISTRICT 2 SURVEY OFFICE

PERSONNEL

REFERENCE NO. 6

SHEET 6 OF 23

NOTES LOEHRKE

H.C. ROUSOS

R.C. CANTERBURY

DATE 8-8-95

WEATHER CLOUDY

TEMP. +78°F

ROUTE S.R. #2

COUNTY FULTON

TOWNSHIP GERMAN

SECTION 31

T 7 N R 5 E

Reset



TYPE MONUMENT PK/WASHER 9-4-96

ON SURFACE - ~~BELOW~~ ON SURFACE

LEFT - Q PAVT. - RIGHT ON Q PAVT

10.1' TO RT EDGE PAVEMENT

S.L.M. 124 + 36

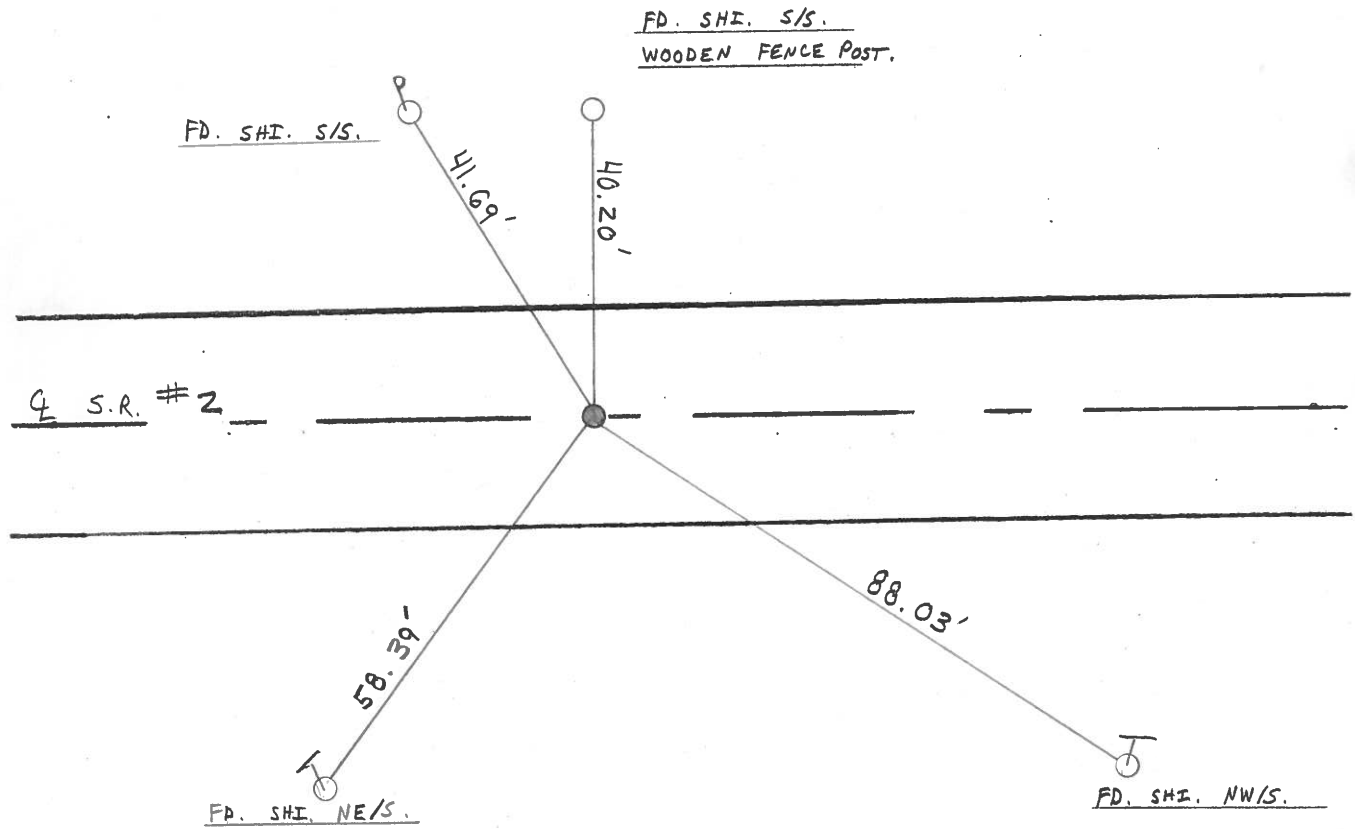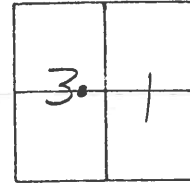

County FULTON S.R. 2

Township GERMAN

Section 31

T7N, R5E

Personnel LOEHRKE


HOUSE HOLDER

BARNEY

Date 7-3-84

Weather CLEAR

Temp. +83

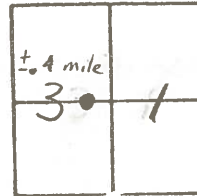

#6

Fd. PK NAIL @ SURFACE

SLM 124 +24


11.2 NEP

11.0 SEP

GN @ PWT SR2


SET PK + WASHER

10-5-84

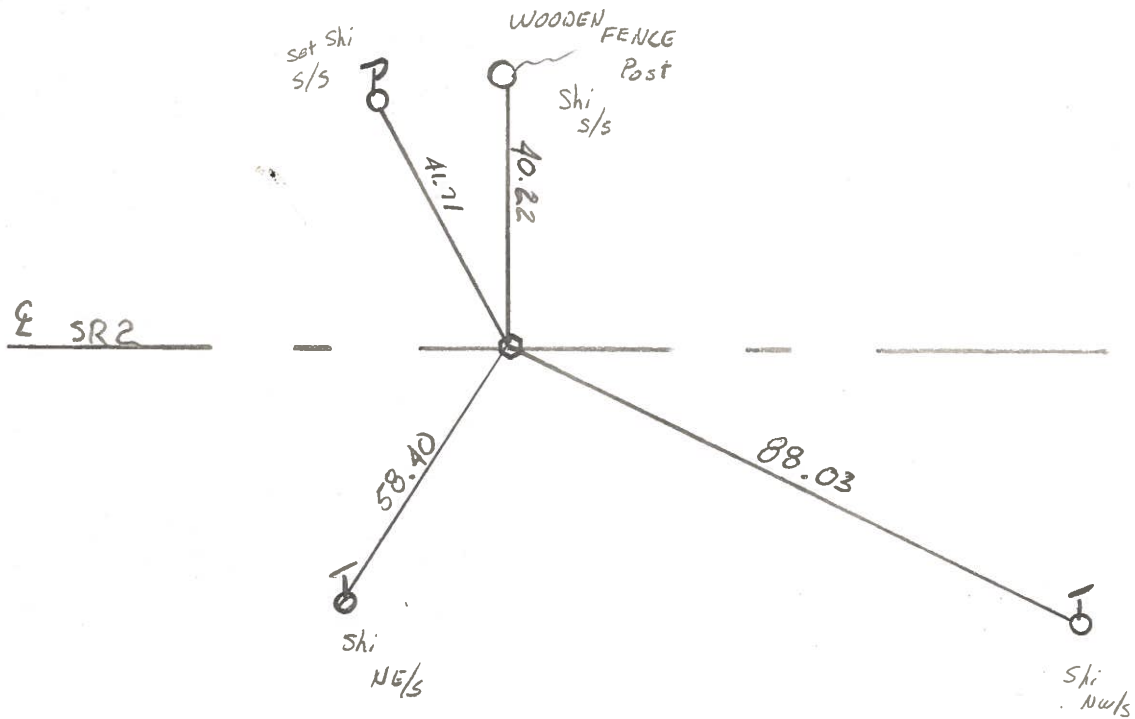


PERSONNEL	TITLE	PERSONNEL	TITLE	COUNTY	DATE
Stanc	Notes			Fulton	13 June 72
Michelak	R.C.			S. R. #2	WEATHER Humid
Denno	H.C.			SEC. Co. Line to Archbold	TEMP. 78°

DESCRIPTION References to Control Points JOB NO. _____

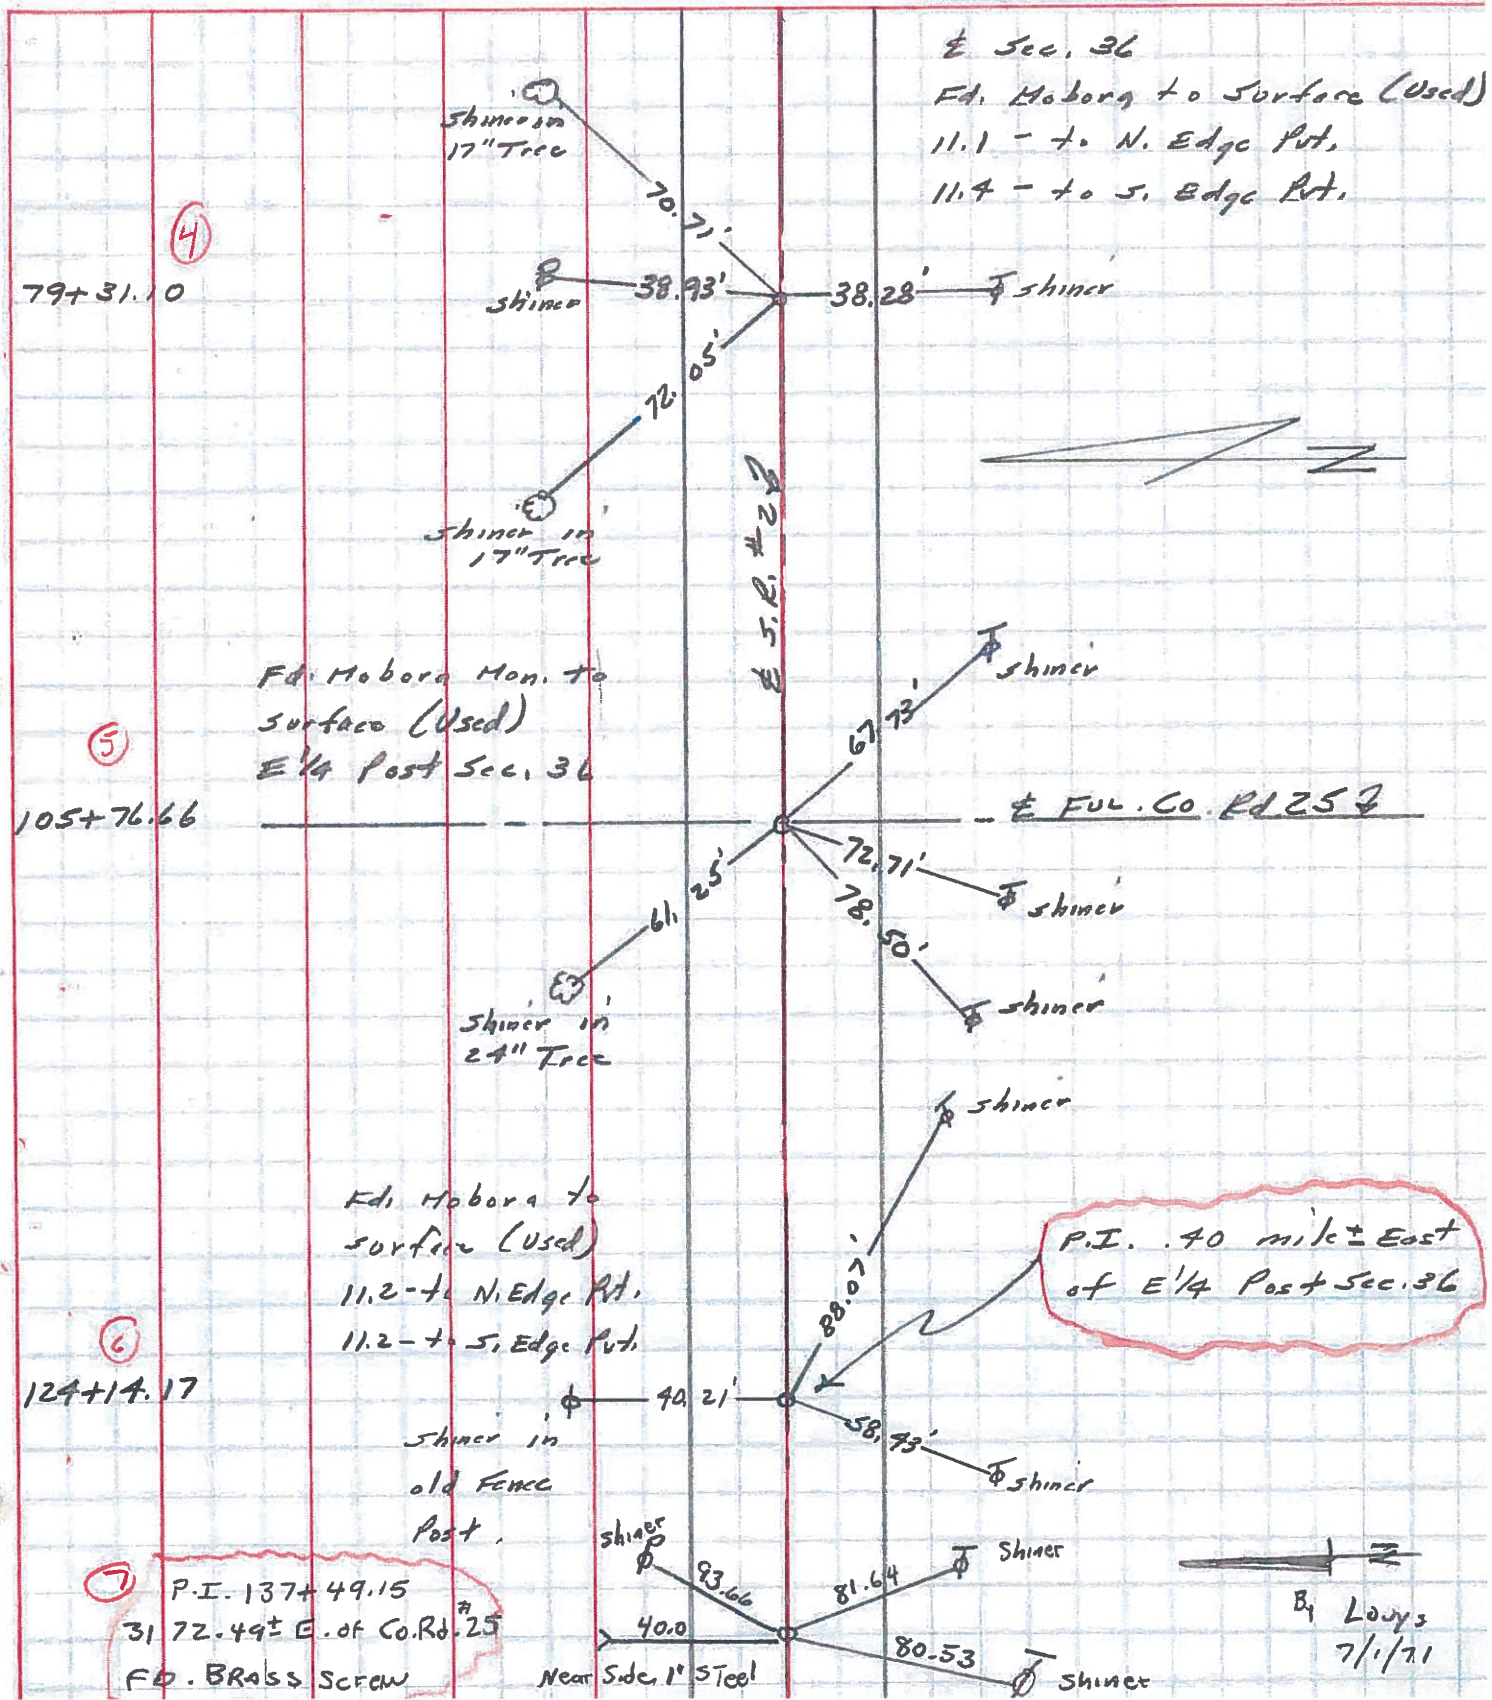


PERSONNEL	TITLE	PERSONNEL	TITLE	COUNTY	DATE
Lovus				Fv	7/1/71
Eriksen				S. R. # 2	WEATHER Fair
Pav				SEC W. E. Co line to int 2E'66	TEMP. 80°
Badschop					

DESCRIPTION Rewit pass to Control points JOB NO. _____

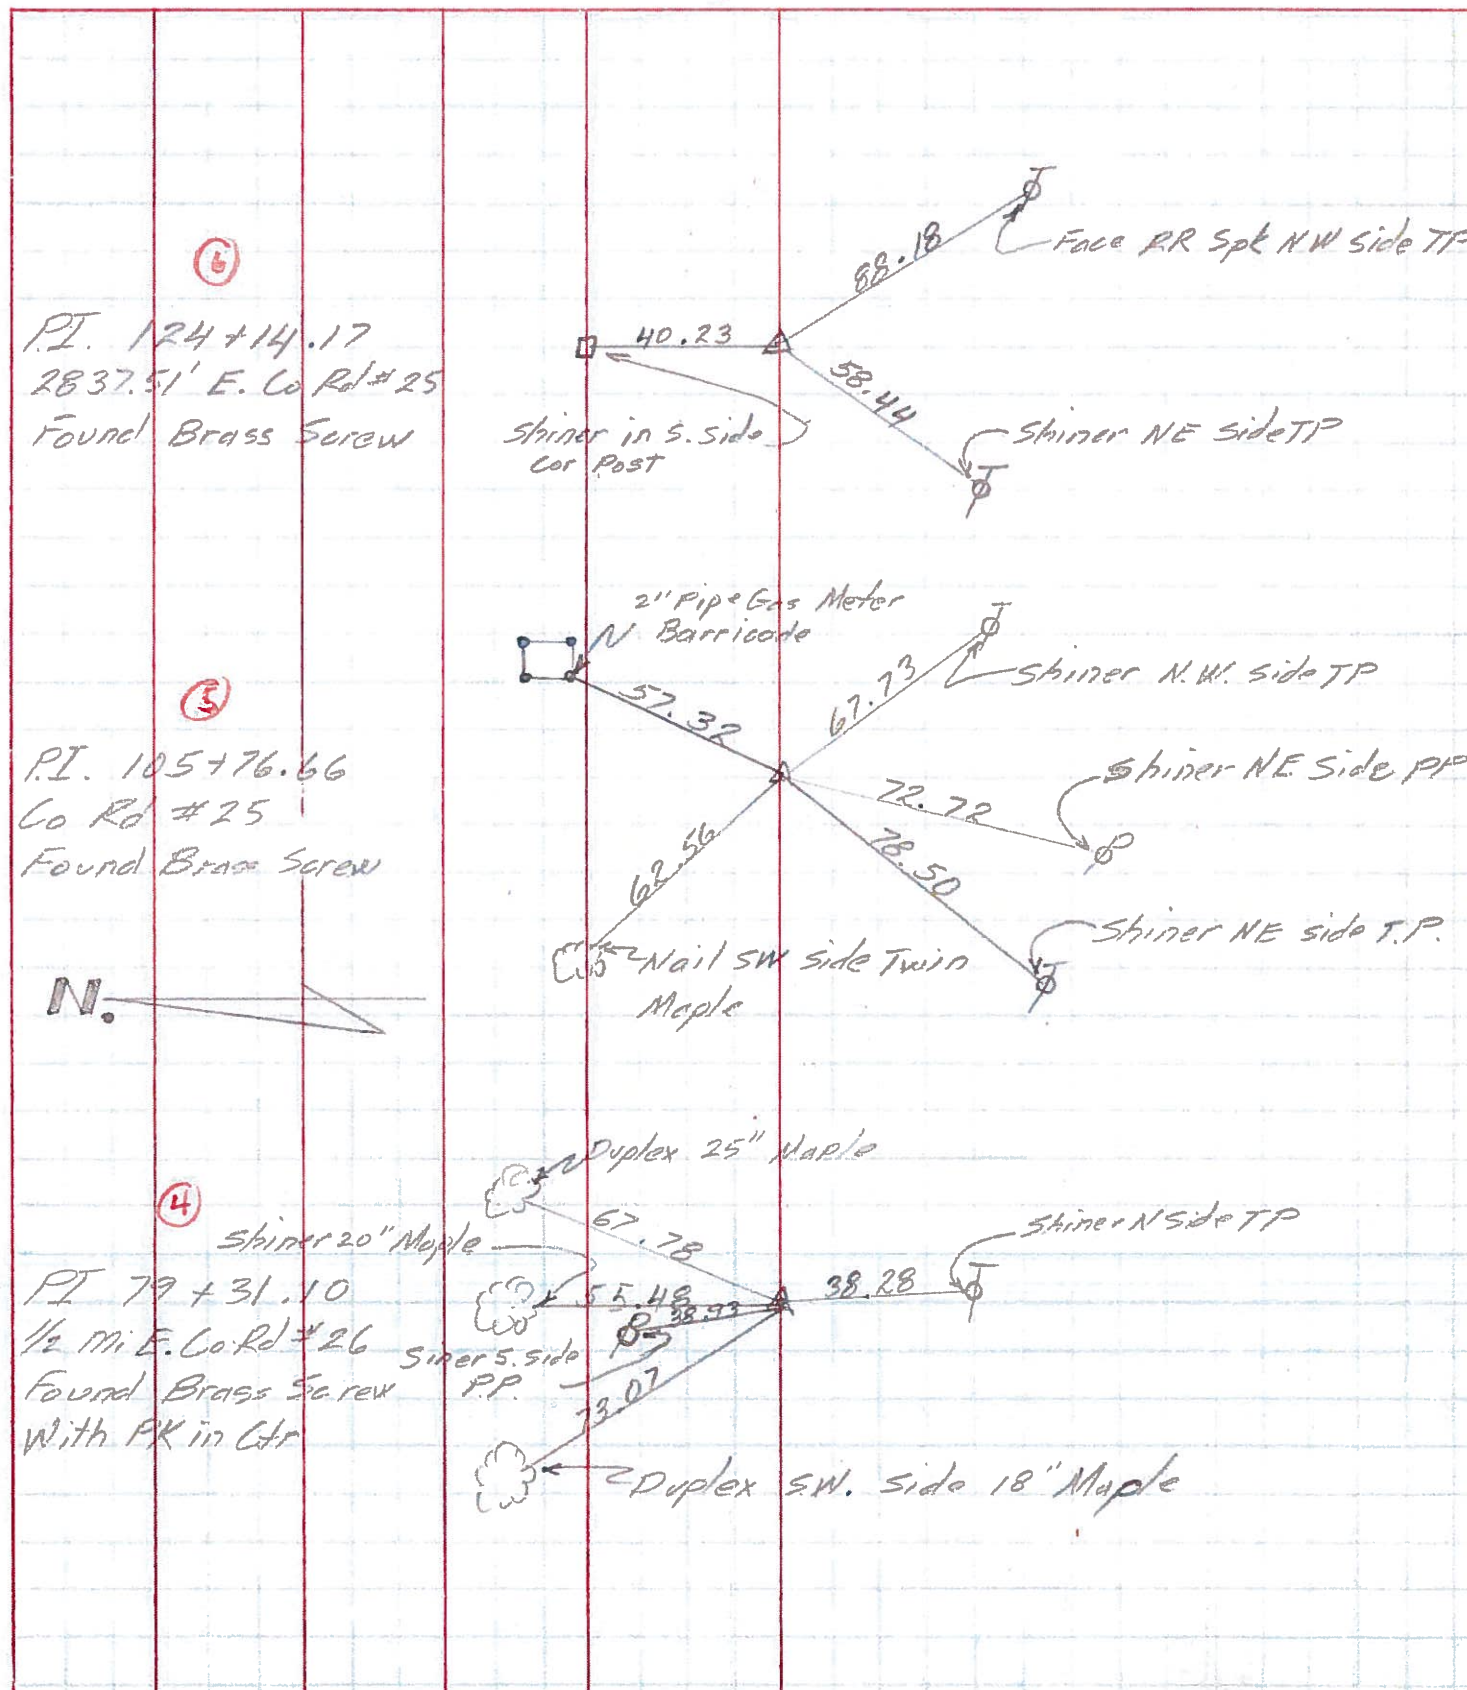


⑥

P.I. 124+14.17
2837.51' E. Co Rd #25
Found Brass Screw

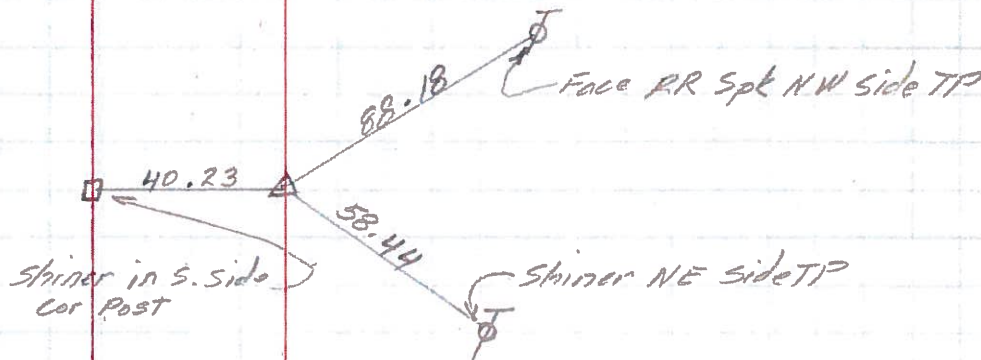

⑤


P.I. 105+76.66
Co Rd #25
Found Brass Screw

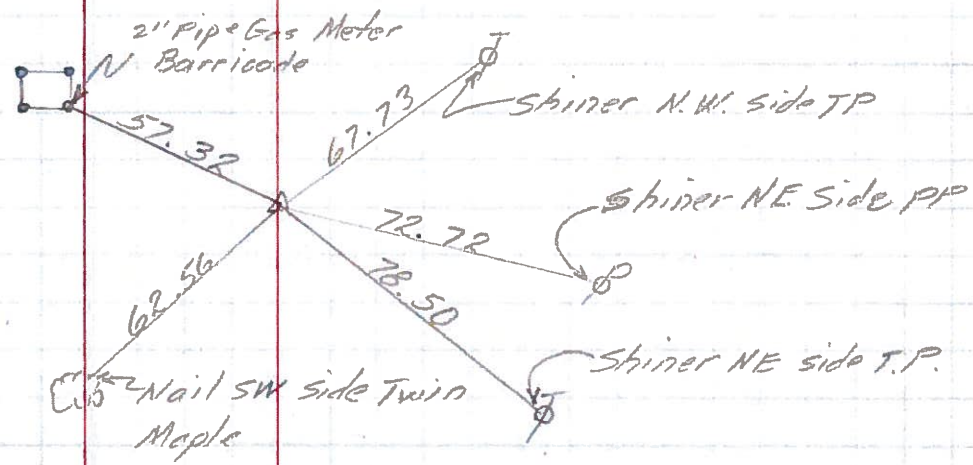

N.

④

P.I. 79+31.10
1/2 mi E. Co Rd #26
Found Brass Screw
With PK in Ctr

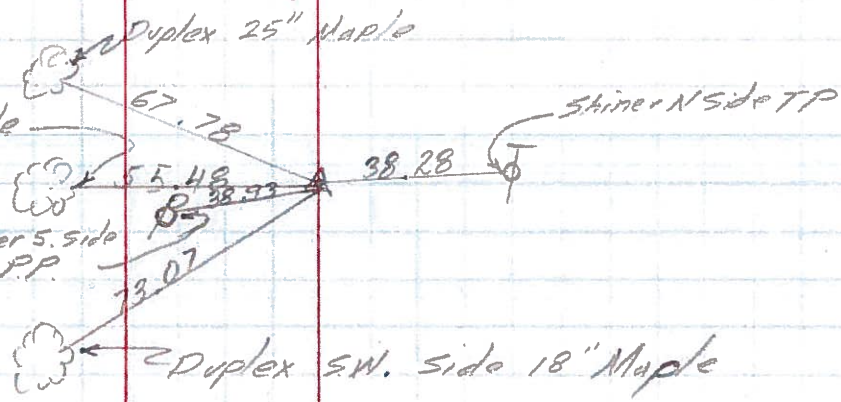

PERSONNEL TITLE PERSONNEL TITLE

COUNTY Fulton

DATE OK-1-22-58

S. R. # 2

WEATHER 12-12-58
OK 11-26-61

SEC.

TEMP. Lowys 7-17-63

DESCRIPTION

LEFT

CENTER LINE

RIGHT

JOB NO.

