


O.D.O.T. DISTRICT 2 SURVEY OFFICE (USE ONLY)

PERSONNEL _____ REFERENCE NO. 13 SHEET 14 OF 15

NOTES HOMADMAN DATE 5/31/12 ROUTE SR 2
 H.C. ROUSOS WEATHER CLOUDY COUNTY FULTON
 R.C. HOMADMAN TEMP. 70° TOWNSHIP GERMAN
 _____ SECTION 32
 _____ T 7 N R 5 E

TYPE MONUMENT MON.BOX
 ON SURFACE - ~~BELOW~~ ON
 LEFT - ~~☉ PAV'T~~ RIGHT 0.7'
14.1' TOLT FACE OF CURB
 S.L.M. 197+41
 GRID: NORTHING: 680925.992 EASTING: 1473235.713

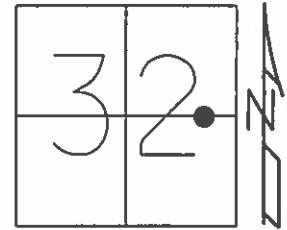


RECORD

MON BOX RIM WAS NOTCHED
 AND LID HAD "+" - DID NOT OPEN
 7-5-1984

MON. BOX
 RAISED 10-5-1984

MON. BOX
 RAISED 9-4-96

FND. MON. BOX WITH
 'X' ON LID
 5-31-2012
 DCH

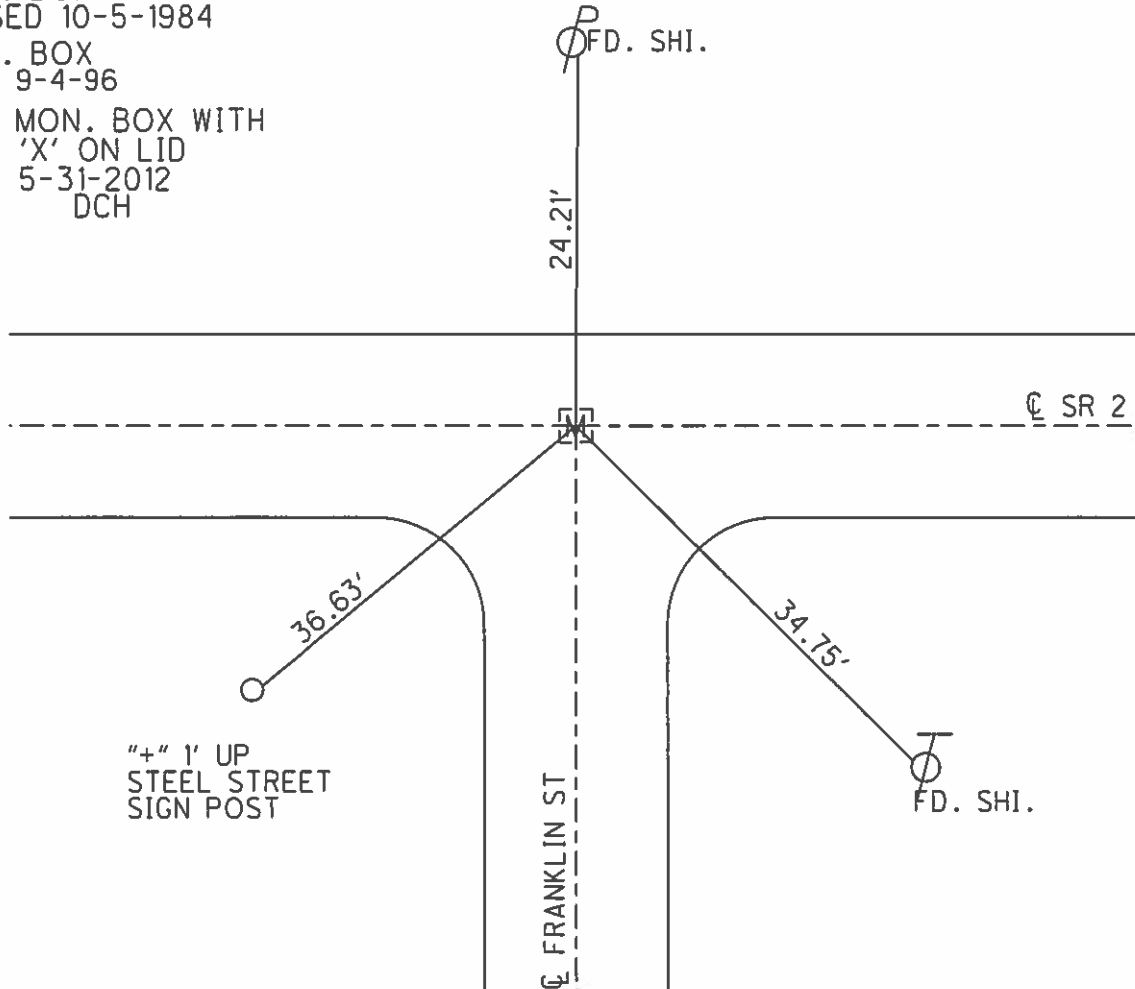

O.D.O.T. DISTRICT 2 SURVEY OFFICE

PERSONNEL _____

REFERENCE NO. 13

SHEET 14 OF 23

NOTES C. LOEHRKE

H.C. TED ROUSOS

DATE 8-9-95

ROUTE S.R.2

R.C. M. CANTERBURY

WEATHER CLOUDY

COUNTY FULTON

TEMP. +75

TOWNSHIP GERMAN

SECTION 32

T 7 N R 5 E


TYPE MONUMENT MON Box RAISED - 9-4-96

ON SURFACE - ~~BELOW~~ Yes


LEFT - ~~PAV'T.~~ RIGHT 0.7 Lt

~~14.1 TO LT~~ EDGE PAVEMENT FACE of Curb

S.L.M. 197+41

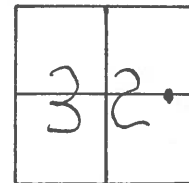

Mon Box Rim Was Notched
AND LID HAD "+" - DID NOT OPEN

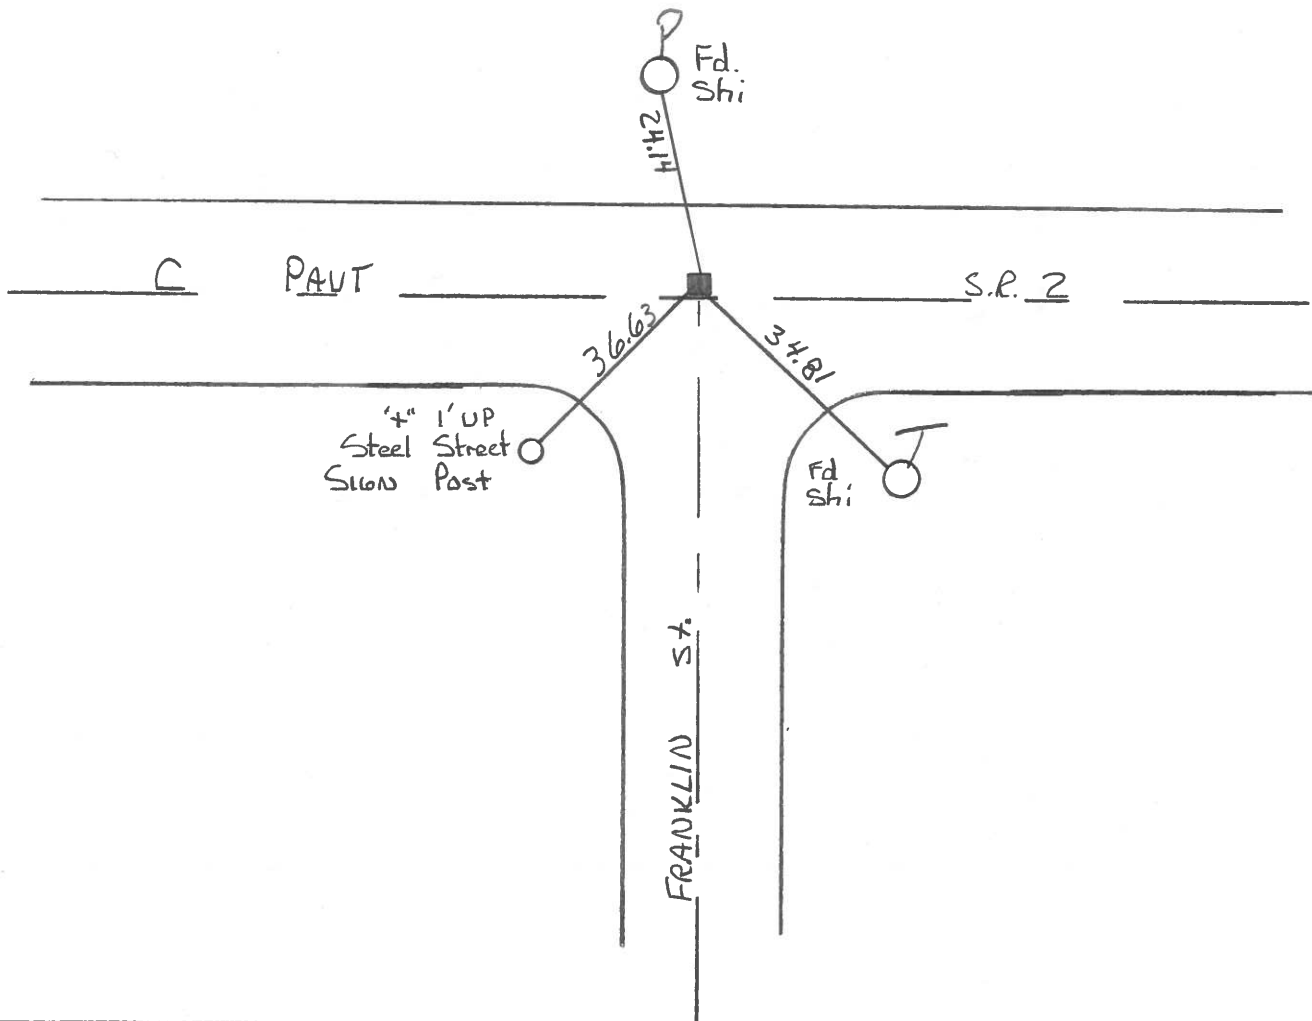

County FULTON S.R. 2

Date 7-5-84

Township GERMAN

Weather PT CLOUDY

Section 32


Temp. +70

T2N, R5E

Personnel Hoffman

HOUSEHOLDER

BARNHISEL

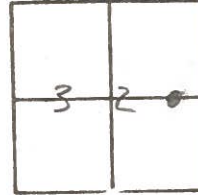

#13

Fd: Mon. Box @ SURFACE
 W "X" CUT DID NOT OPEN
 14.1 to NEP.
 1.1 LP of ♀ PAUT SR. 2
 ON ♀ PAUT FRANKLIN ST.

SLM 197+15

Mon. Box

RAISED TO SURFACE
 10-5-84
 C.L.

