

O.D.O.T. DISTRICT 2 SURVEY OFFICE (USE ONLY)

PERSONNEL

REFERENCE NO. 18

SHEET 4 OF 11

NOTES NIESE

DATE 3/5/21

ROUTE SR 2

H.C. RHOADES

WEATHER SUNNY

COUNTY FULTON

R.C. \_\_\_\_\_

TEMP. 35°

TOWNSHIP GERMAN

DWG BY NIESE PID PAVETRAIN

SECTION 23

T 7 N R 5 E

TYPE MONUMENT MAG NAIL

ON SURFACE - ~~BELOW~~ ON

OFFSET  $\odot$  PAVEMENT ON \_\_\_\_\_ LT : RT

- TO - EDGE PAVEMENT


STATION: 389+35

HORZ.DATUM: NAD83 2011


GEOID: NAVD88 2012A

GRID: NORTHING: 688627.776

EASTING: 1484531.442

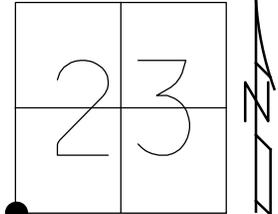

RECORD:  
STA. 389+82  
FD P.K.NAIL  
5/13/02, DCH  
SET MAG/WASHER  
11-26-02, DCH  
FD MAG NAIL  
REF18  
9/25/20, JFO  
3/5/21, JMR  
7/14/22, TDN

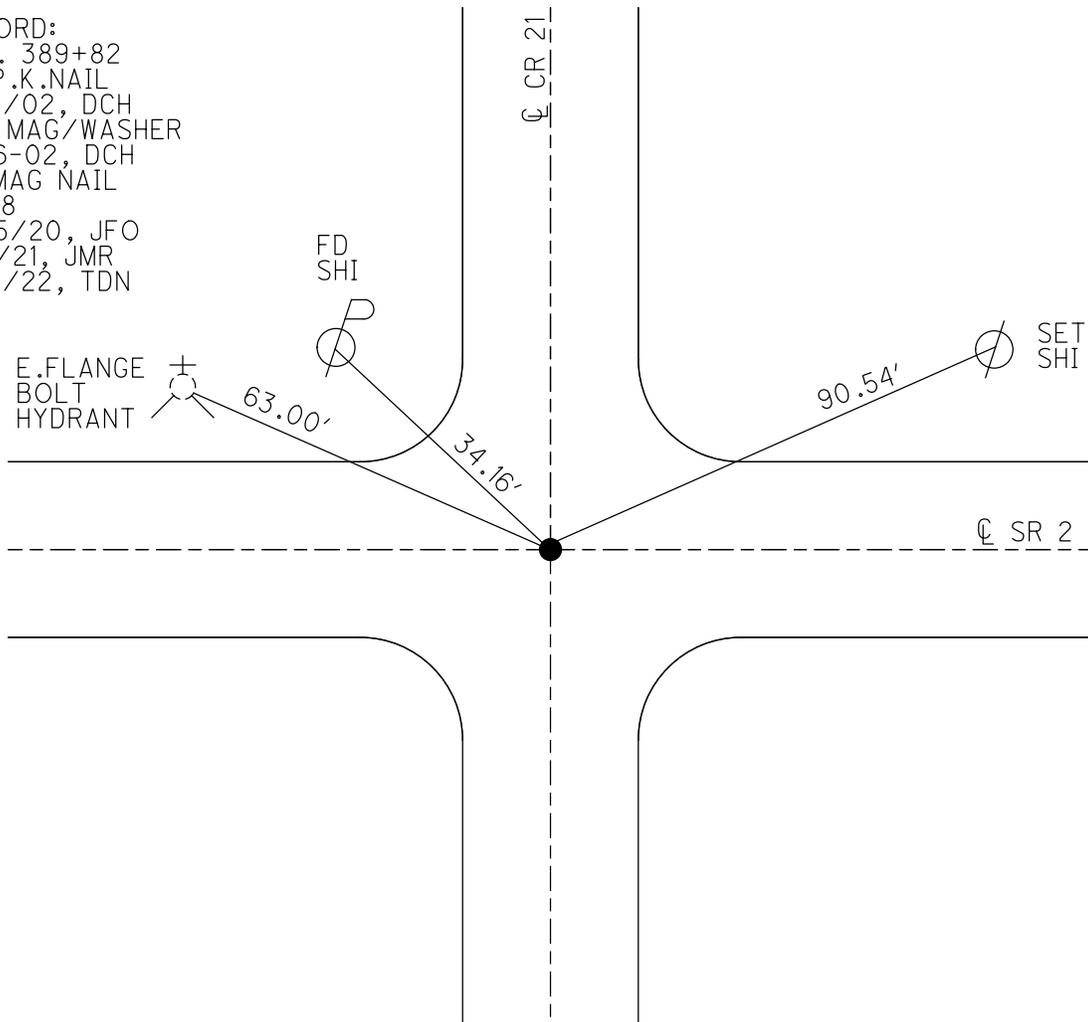

O.D.O.T. DISTRICT 2 SURVEY OFFICE (USE ONLY)

PERSONNEL

REFERENCE NO. 18

SHEET 4 OF 11

NOTES NIESE

DATE 3/5/21

ROUTE SR 2

H.C. RHOADES

WEATHER SUNNY

COUNTY FULTON

R.C. \_\_\_\_\_

TEMP. 35°

TOWNSHIP GERMAN

DWG BY NIESE

PID PAVETRAIN

SECTION 23

T 7 N R 5 E

TYPE MONUMENT MAG NAIL

ON SURFACE - ~~BELOW~~ ON

OFFSET  $\varnothing$  PAVEMENT ON LT : RT

- TO - EDGE PAVEMENT


STATION: 389+35

HORZ.DATUM: NAD83 2011


GEOID: NAVD88 2012A

GRID: NORTHING: 688627.776

EASTING: 1484531.442

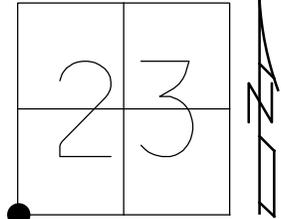

RECORD:  
 STA. 389+82  
 FD P.K.NAIL  
 5/13/02, DCH  
 SET MAG/WASHER  
 11-26-02, DCH  
 FD MAG NAIL  
 REF18  
 9/25/20, JFO  
 3/5/21, JMR

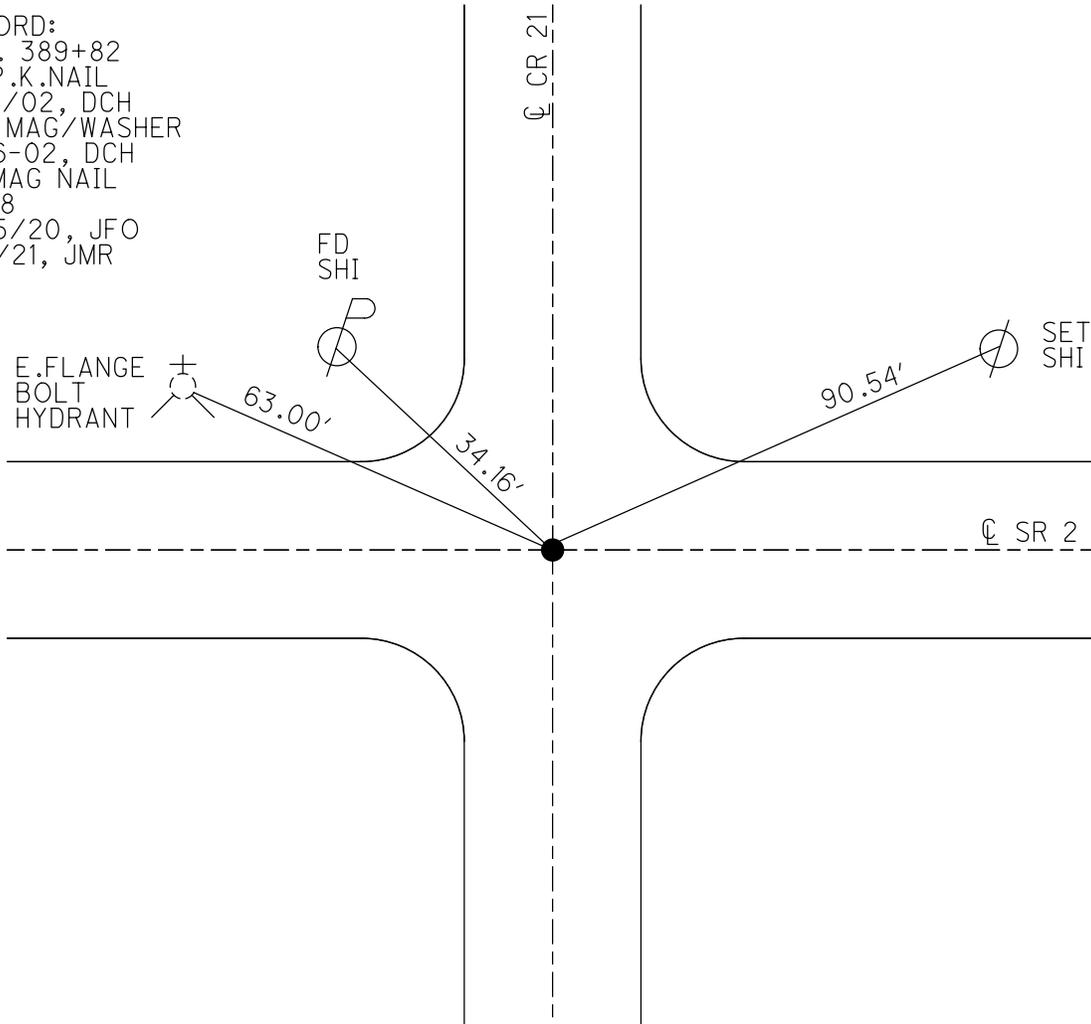

O.D.O.T. DISTRICT 2 SURVEY OFFICE (USE ONLY)

PERSONNEL

REFERENCE NO. 18

SHEET 4 OF 11

NOTES RHOADES

DATE 9/25/20

ROUTE SR 2

H.C. O'DONNELL

WEATHER SUNNY

COUNTY FULTON

R.C. AUBLE

TEMP. 54°

TOWNSHIP GERMAN

SECTION 23

DWG BY RHOADES

PID PAVETRAIN

T 7 N R 5 E

TYPE MONUMENT MAG NAIL

ON SURFACE - ~~BELOW~~ ON

OFFSET ☉ PAVEMENT ON LT : RT

- TO - EDGE PAVEMENT


STATION: 389+35

HORIZ.DATUM: NAD83 2011


GEOID: NAVD88 2012A

GRID: NORTHING: 688627.776

EASTING: 1484531.442

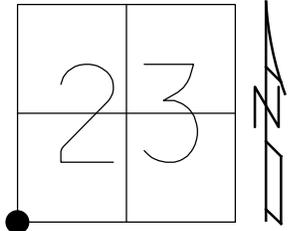

RECORD:  
 STA. 389+82  
 FD P.K.NAIL  
 5/13/02, DCH  
 SET MAG/WASHER  
 11-26-02, DCH  
 FD MAG NAIL  
 REF18  
 9/25/20, JFO

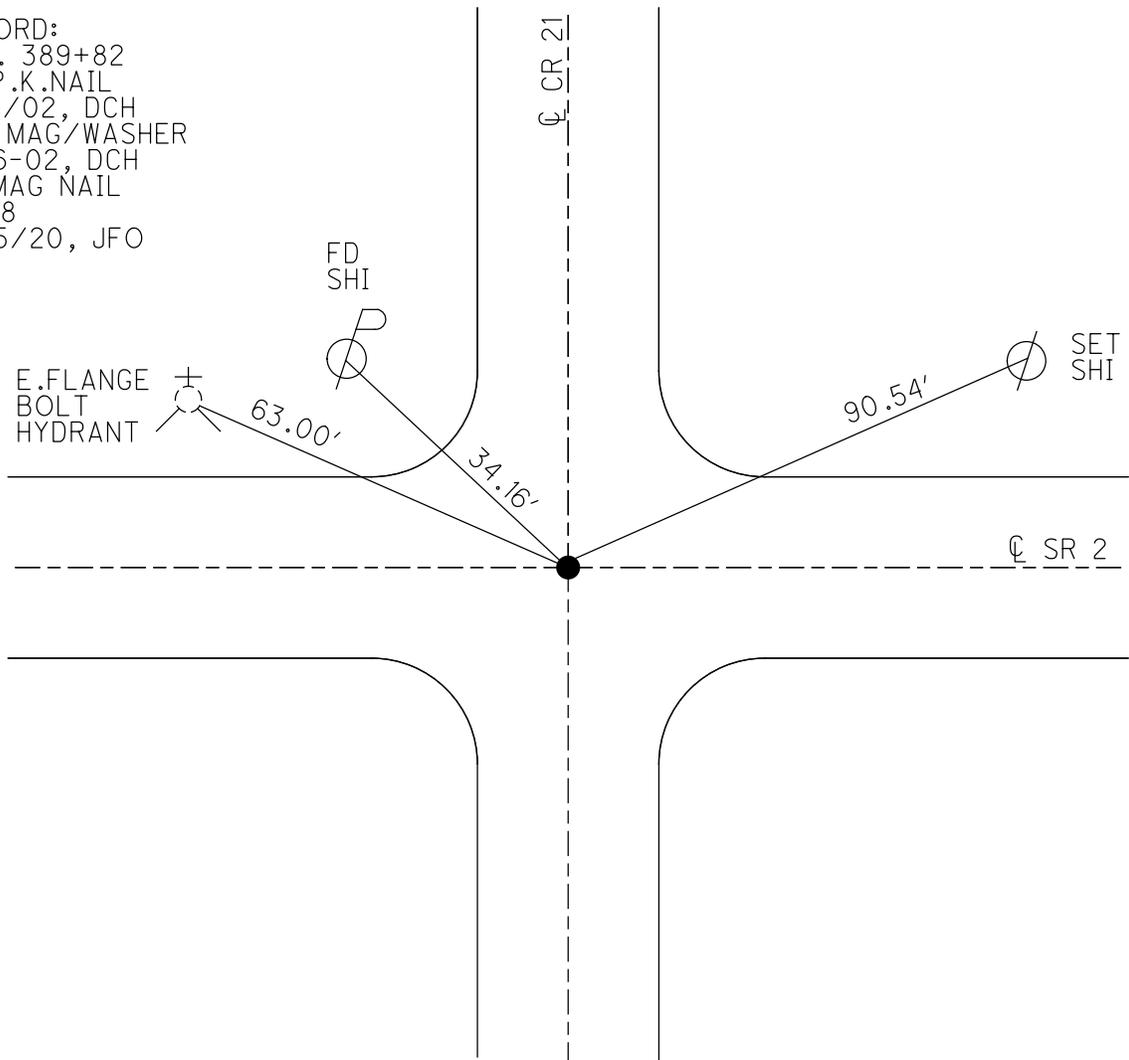

O.D.O.T. DISTRICT 2 SURVEY OFFICE(USE ONLY)

PERSONNEL \_\_\_\_\_ REFERENCE NO. 18 SHEET 4 OF 11

NOTES ROUSOS DATE 5/13/02 ROUTE SR 2

H.C. HOMAN WEATHER WINDY COUNTY FULTON

R.C. MICHALAK TEMP. 52° TOWNSHIP GERMAN

SECTION 23

T 7 N R 5 E

TYPE MONUMENT P.K.NAIL


ON SURFACE - ~~BELOW~~ ON

~~LEFT~~ - Q PAV'T - ~~RIGHT~~ ON


- TO - EDGE PAVEMENT

S.L.M. 389+35

GRID: NORTHING: \_\_\_\_\_ EASTING: \_\_\_\_\_

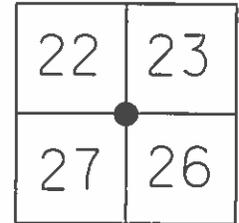

SET MAG NAIL  
& WASHER  
11-26-02  
DCH

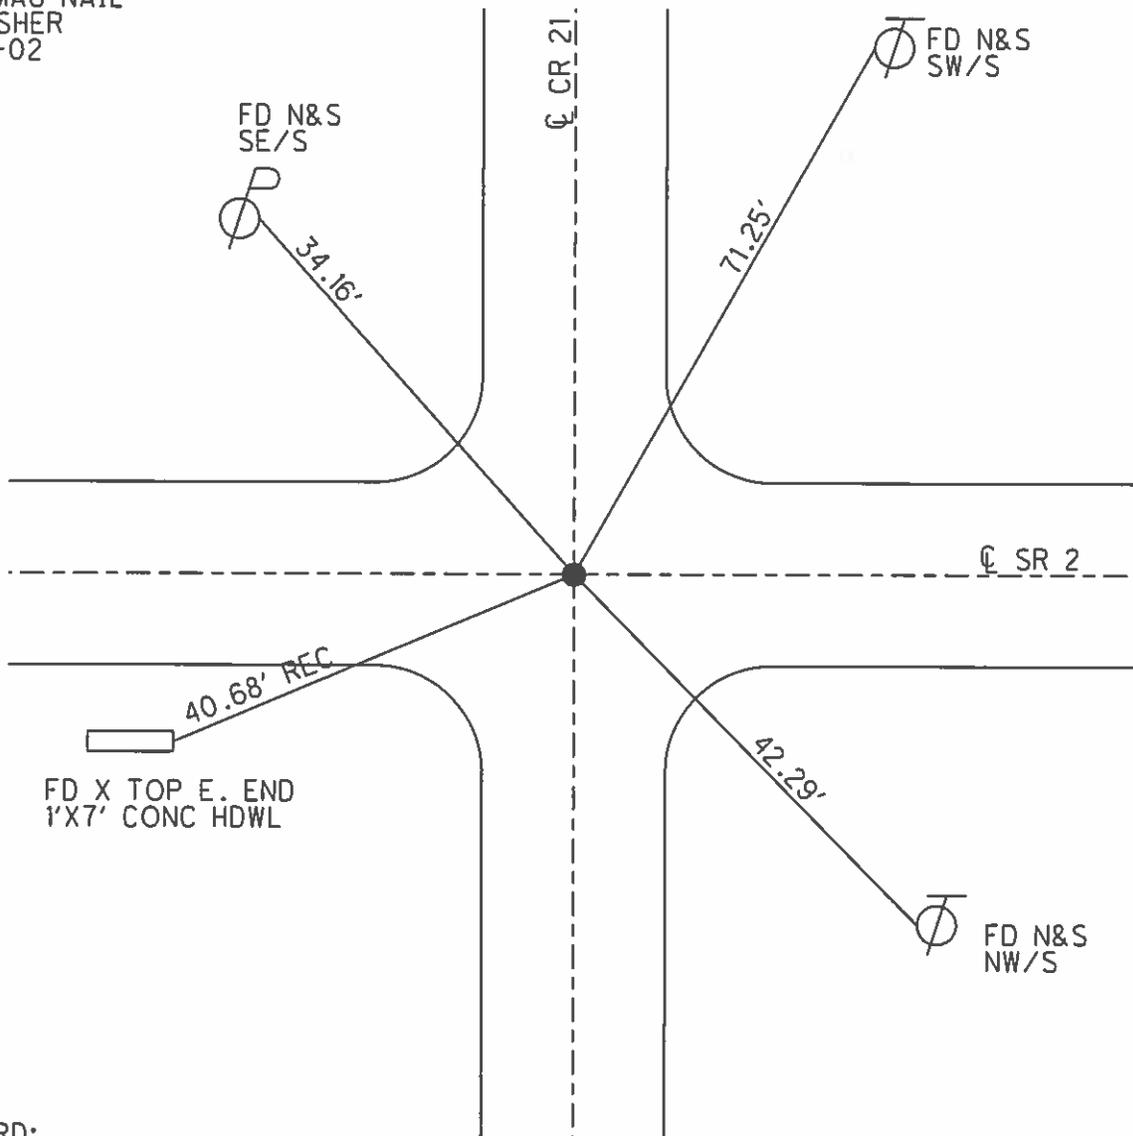

RECORD:  
STA 389+82.00

# O.D.O.T. DISTRICT 2 SURVEY OFFICE

PERSONNEL

REFERENCE NO. 18

SHEET 5 OF 13

NOTES 1. Stone

H.C. D. Curtis'

R.C. J. Householder

DATE 17 Aug. 87

WEATHER Warm

TEMP. 80°

ROUTE SR 2

COUNTY Fulton

TOWNSHIP GERMAN

SECTION 23

T 7 N R 5 E

TYPE MONUMENT P.K.

ON SURFACE - ~~BELOW~~ YES

LEFT- & PAV'T. - ~~RIGHT~~ BOTH Pav'ts

TO EDGE PAVEMENT


S.L.M. 389 + 35

22	23
27	26




Recoed:  
sta 389+82.00

SET P.K. NAIL TO SURFACE  
4-29-88

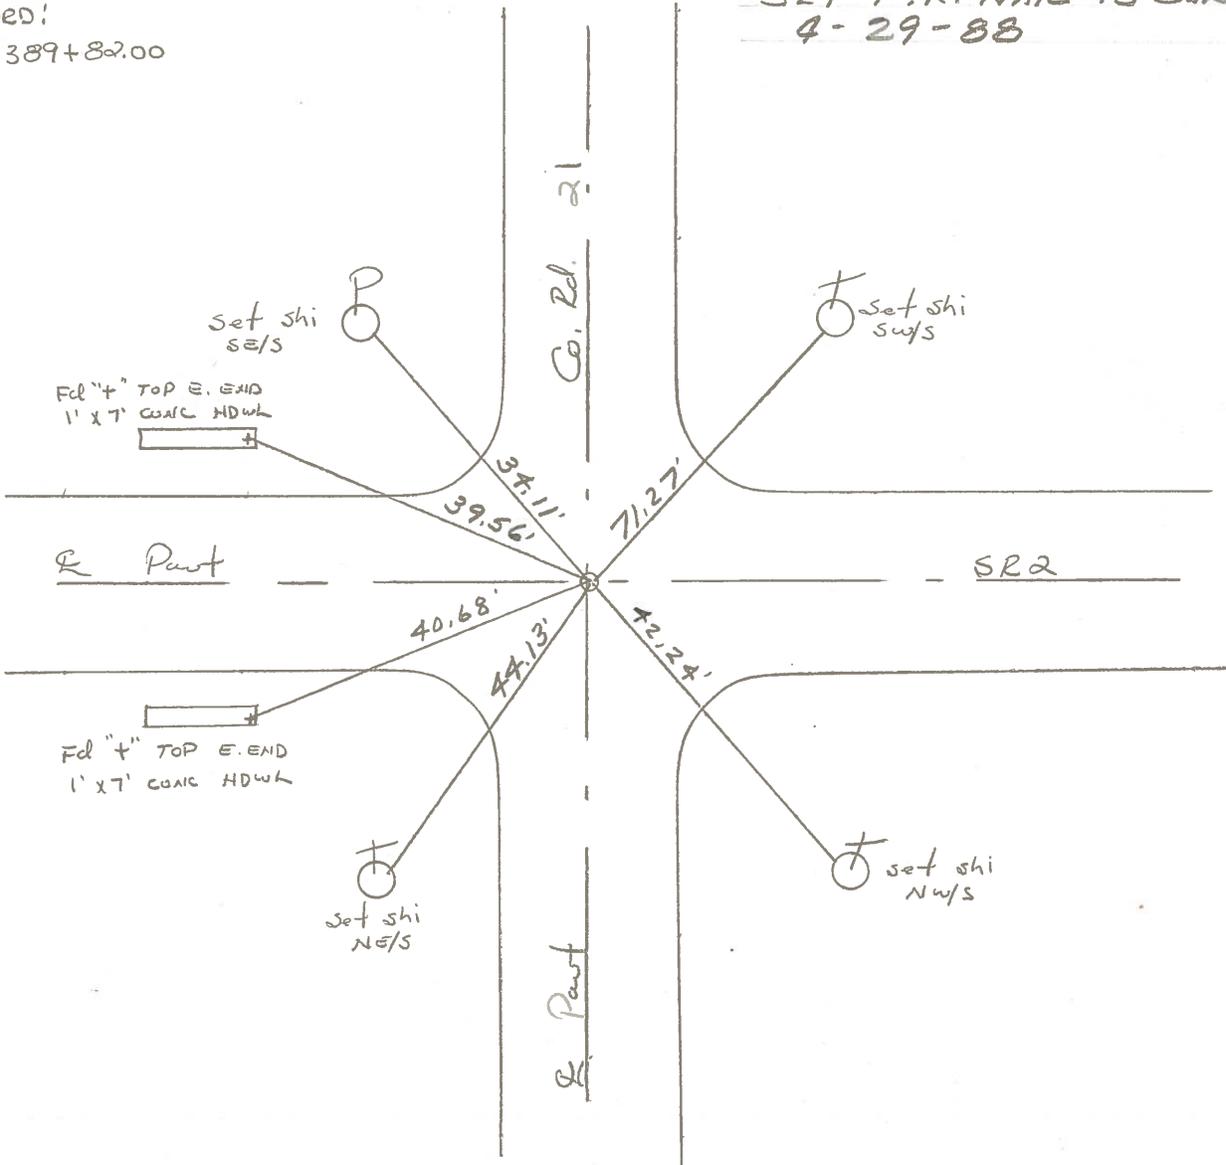


PERSONNEL	TITLE	PERSONNEL	TITLE	COUNTY	DATE	WEATHER	TEMP.
Tomsic				Fulton	MAY 17, 1973		
Newser				S. R. 2			
Granata							
Vanyo							

DESCRIPTION \_\_\_\_\_ LEFT \_\_\_\_\_ CENTER LINE \_\_\_\_\_ RIGHT \_\_\_\_\_ JOB NO. \_\_\_\_\_

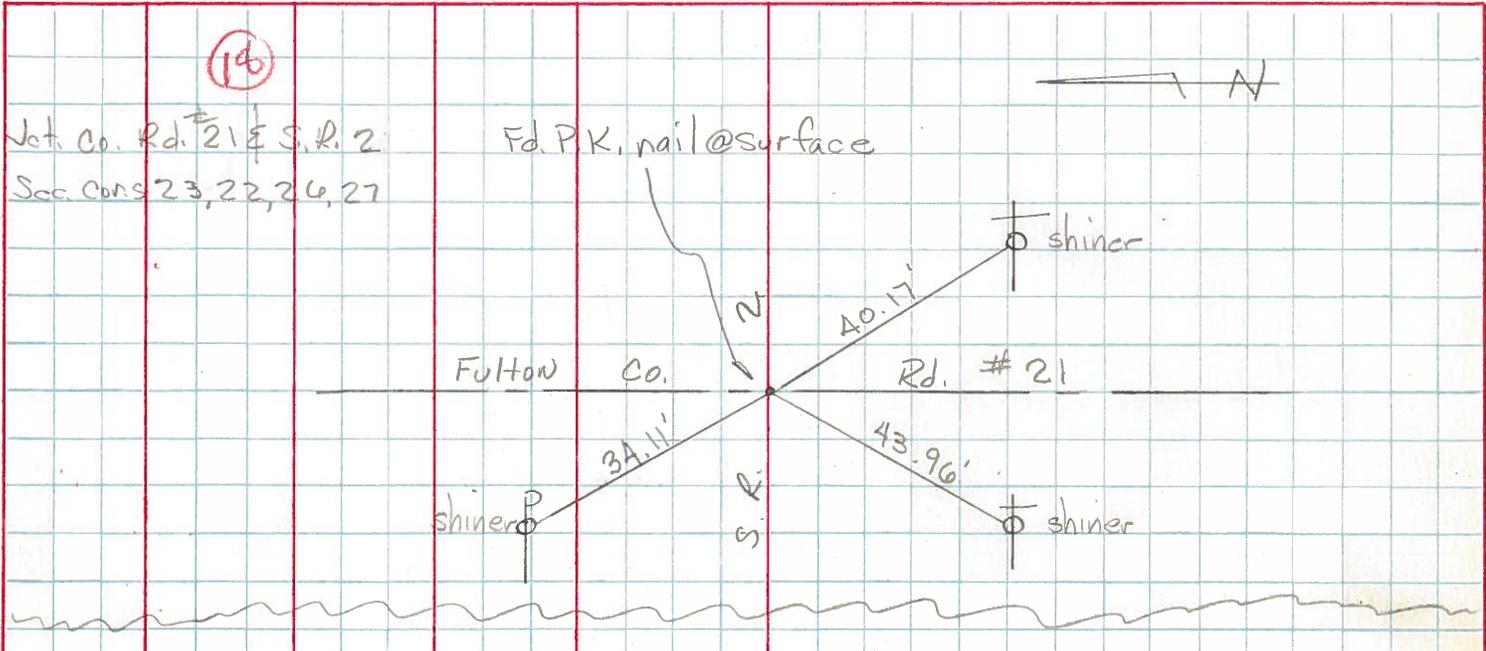


S. 1/4 Post Sec. 23 19  
 German TWP.  
 Ref. by Red Beech & Crew July '72  
 see following additional pages

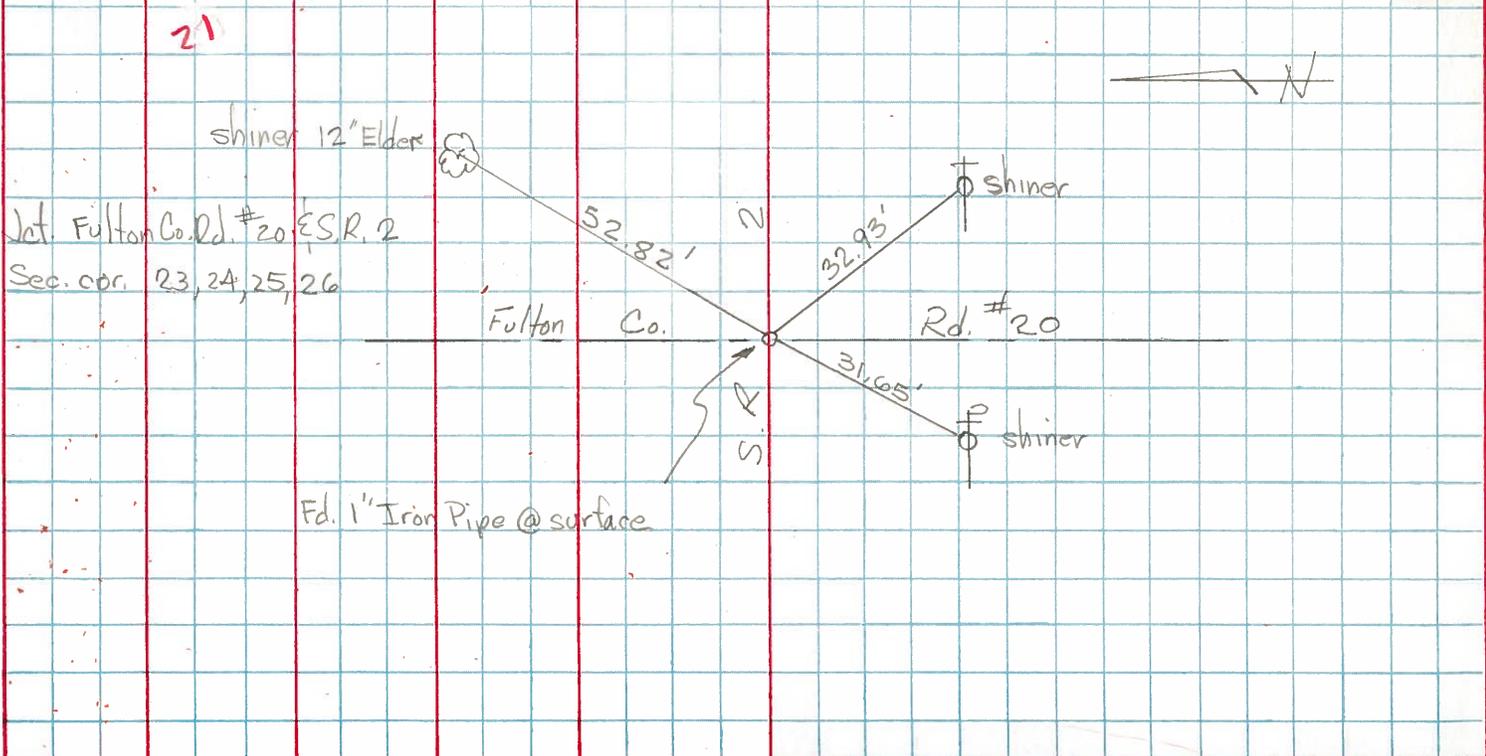



PERSONNEL TITLE PERSONNEL TITLE COUNTY FULTON DATE MAR. 1972  
 Red Beach, Newcomb S. R. #2 WEATHER Marchy  
 Knappe  
 Wise SEC. NW 1/4 Sec. 26 TEMP.

DESCRIPTION GERMAN TWP. T-7-N R-5-E JOB NO. 02825 (0)

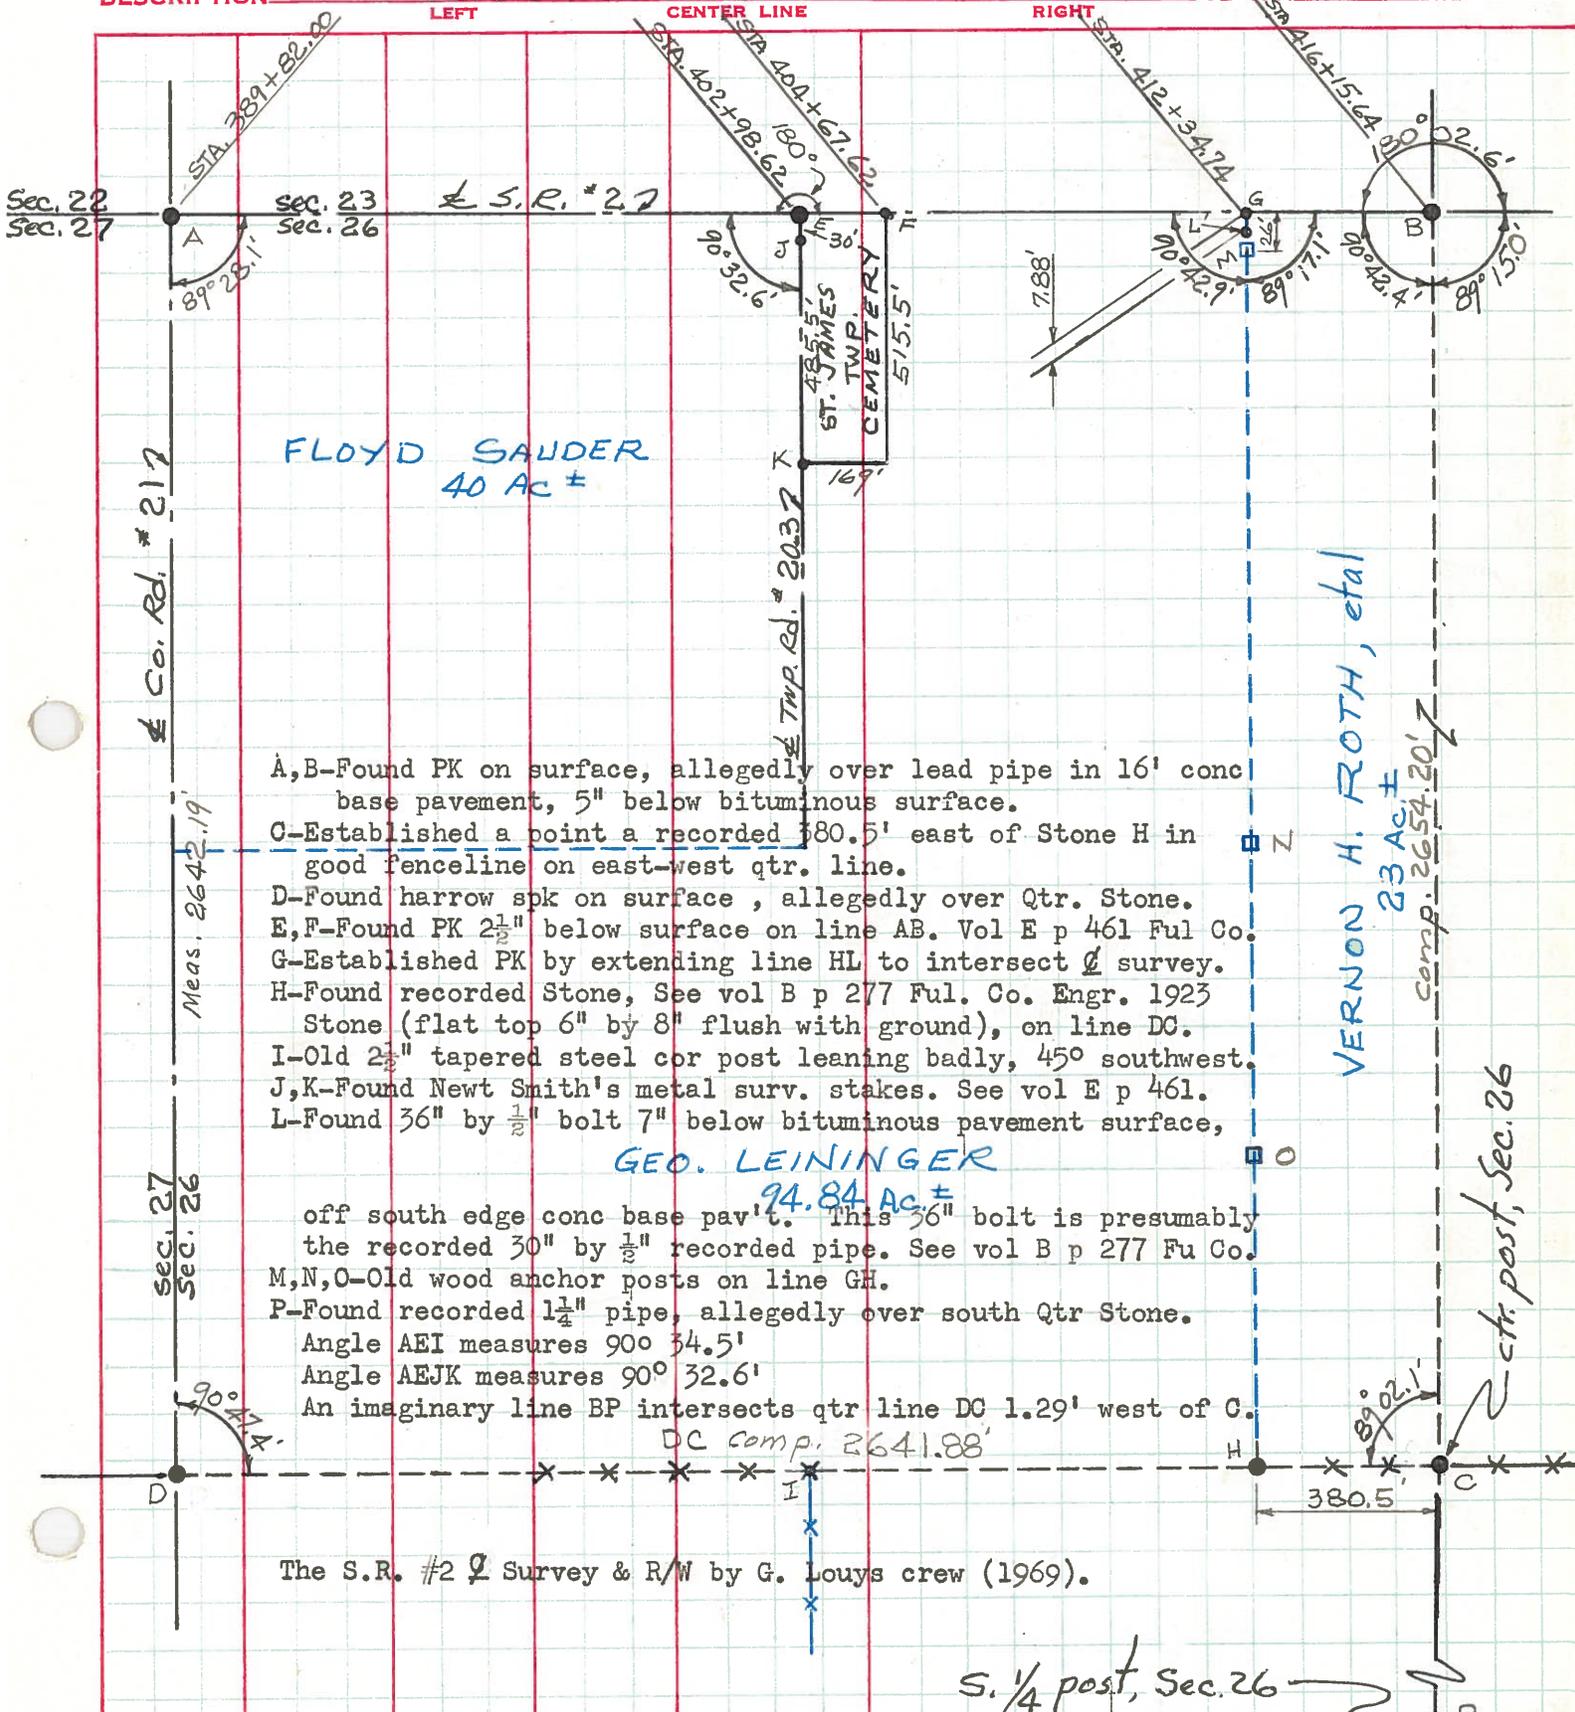

FLOYD SAUDER  
40 Ac ±

VERNON H. ROTH, et al  
23 Ac ±  
comp. 2654.20'

GEO. LEININGER  
94.84 Ac ±

- A, B-Found PK on surface, allegedly over lead pipe in 16' conc base pavement, 5" below bituminous surface.
- C-Established a point a recorded 380.5' east of Stone H in good fenceline on east-west qtr. line.
- D-Found harrow spk on surface, allegedly over Qtr. Stone.
- E, F-Found PK 2 1/2" below surface on line AB. Vol E p 461 Ful Co.
- G-Established PK by extending line HL to intersect Q survey.
- H-Found recorded Stone, See vol B p 277 Ful. Co. Engr. 1923 Stone (flat top 6" by 8" flush with ground), on line DC.
- I-Old 2 1/2" tapered steel cor post leaning badly, 45° southwest.
- J, K-Found Newt Smith's metal surv. stakes. See vol E p 461.
- L-Found 3/8" by 1/2" bolt 7" below bituminous pavement surface,

off south edge conc base pav't. This 3/8" bolt is presumably the recorded 30" by 1/2" recorded pipe. See vol B p 277 Fu Co.  
 M, N, O-Old wood anchor posts on line GH.  
 P-Found recorded 1 1/4" pipe, allegedly over south Qtr Stone.  
 Angle AEI measures 90° 34.5'  
 Angle AEJK measures 90° 32.6'  
 An imaginary line BP intersects qtr line DC 1.29' west of C.  
 DC comp. 2641.88'

The S.R. #2 Survey & R/W by G. Louys crew (1969).

S. 1/4 post, Sec. 26



PERSONNEL TITLE PERSONNEL TITLE

COUNTY Fa. DATE 6-6-69

Louys

Eriksen

Rau

Stickney

S. R. 2 - (756-7.90) WEATHER Fair.


SEC. 3-mi NE Archbold TEMP. 70°

DESCRIPTION

Witnesses to Control Points

JOB NO.

LEFT CENTER LINE RIGHT

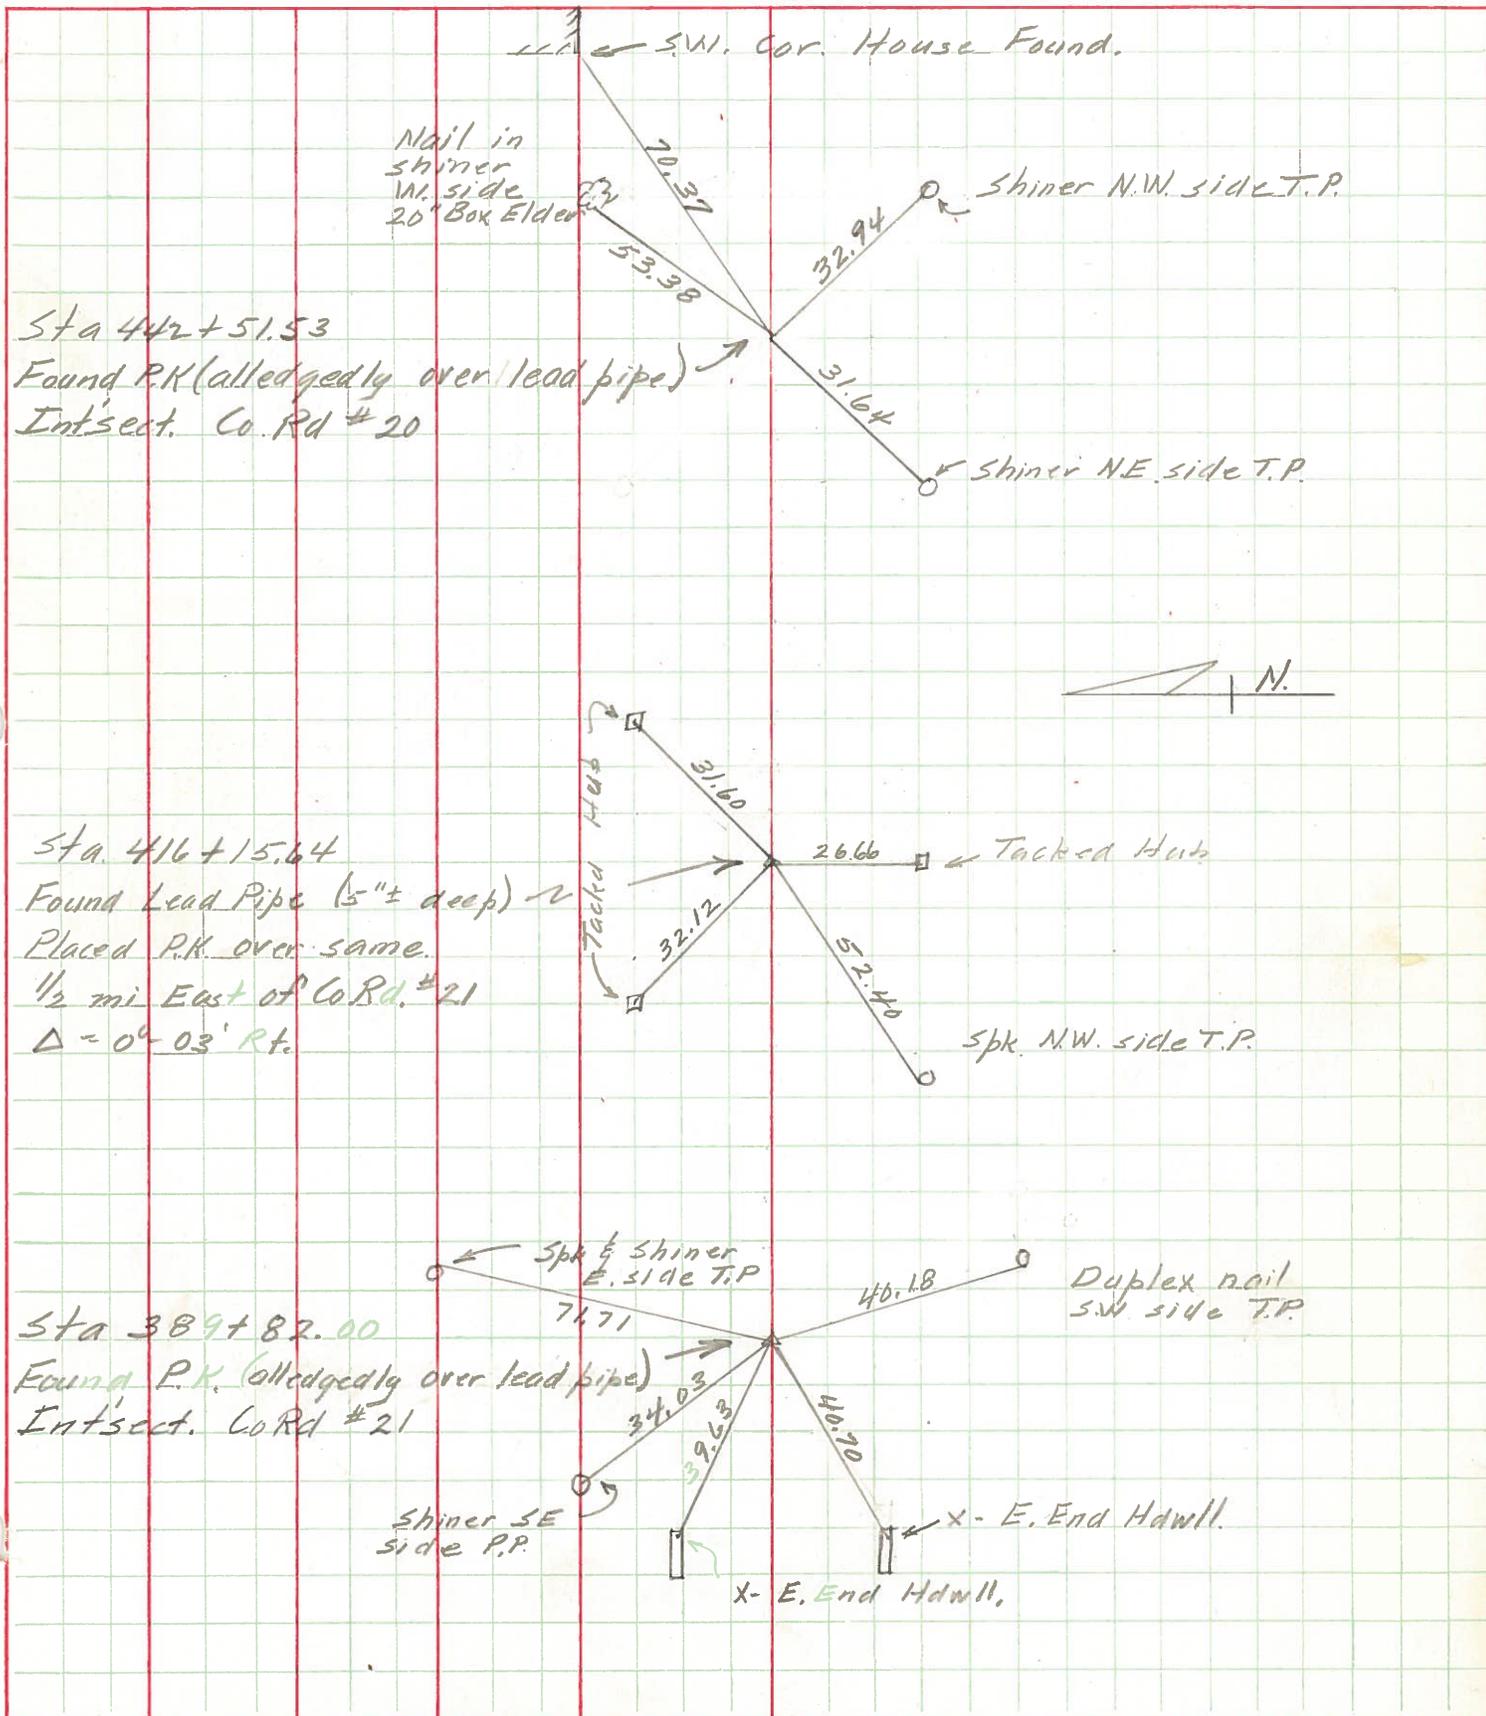

PERSONNEL TITLE  
Red Beach  
Newcomb  
Knappe  
Eriksen  
Wise

PERSONNEL TITLE

COUNTY Fulton

DATE Mar 72


S. R. #2

WEATHER Marchy

SEC. GERMAN TWP



TEMP.

DESCRIPTION CONTROL POINTS JOB NO. 02825(0)

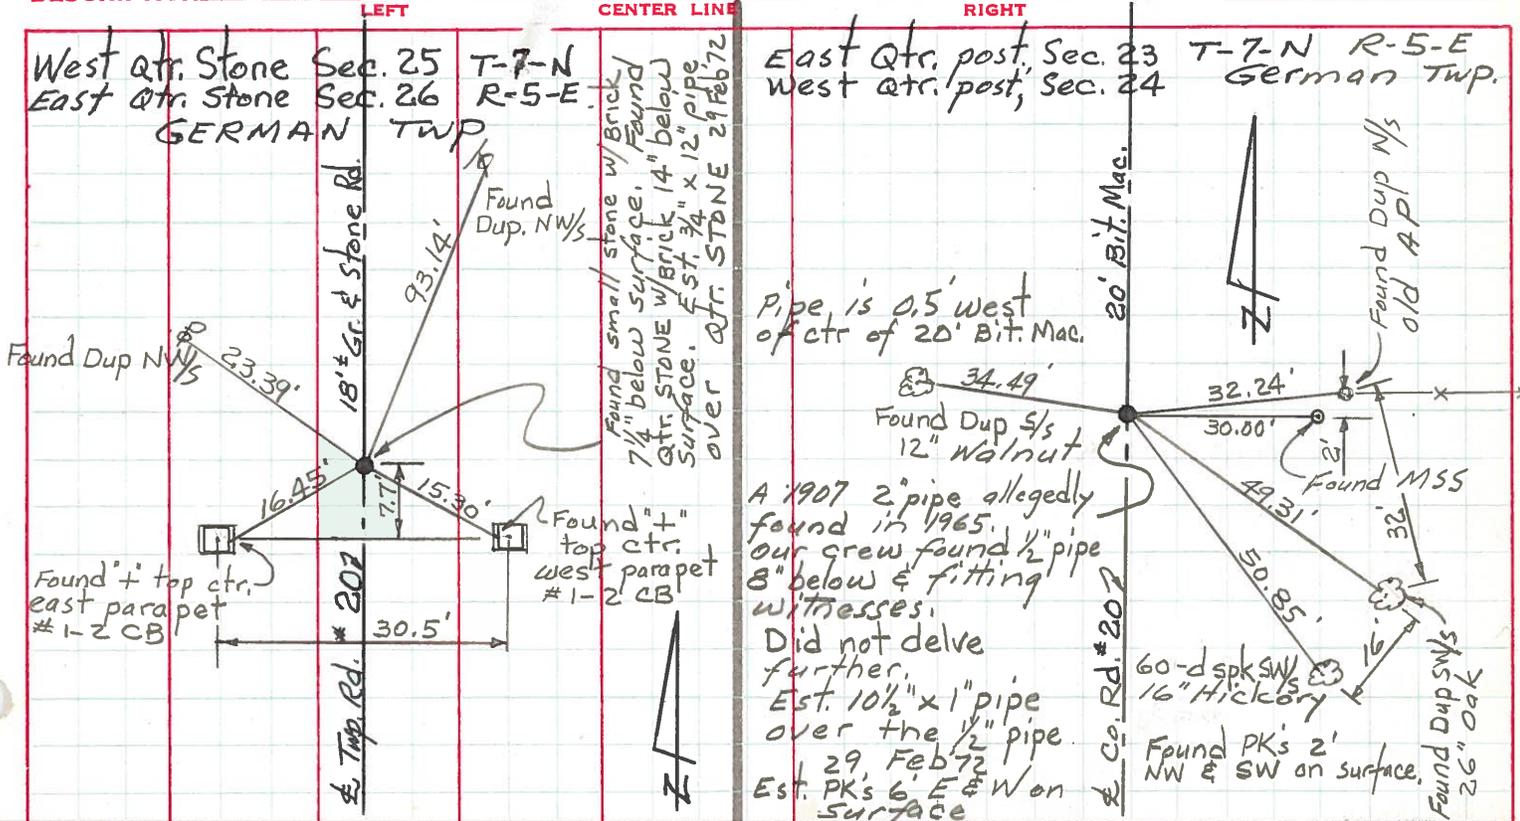

West. QTR. STONE Sec. 26 T-7-N R-5-E  
East QTR. STONE Sec. 27 GERMAN TWP.

West Qtr. STONE Sec. 23 T-7-N R-5-E  
East QTR. STONE Sec. 22 GERMAN TWP

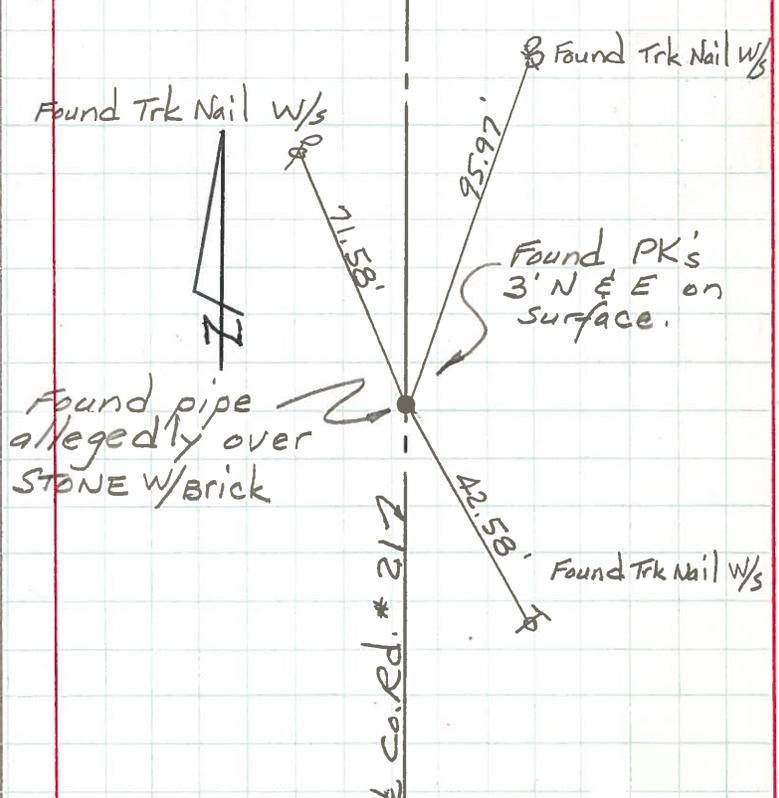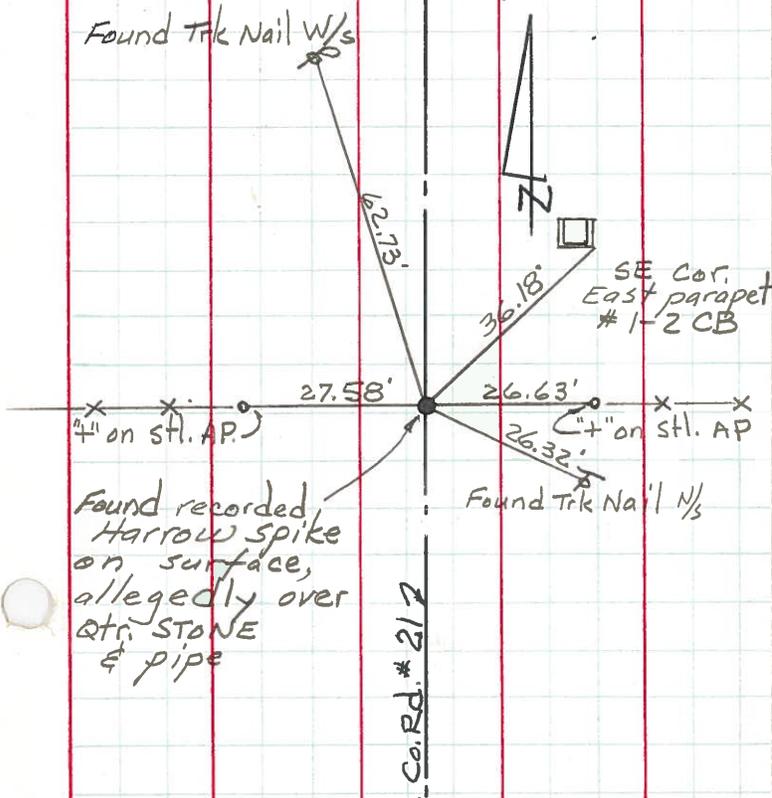


PERSONNEL TITLE PERSONNEL TITLE  
Personall \_\_\_\_\_  
Wier \_\_\_\_\_  
Erikson Recorder \_\_\_\_\_

COUNTY FV DATE 5-2-67

S. R. # 2 WEATHER Cloudy

SEC. 50# 66 to Mauson TEMP. 45°

DESCRIPTION Witness to Control Points JOB NO. \_\_\_\_\_

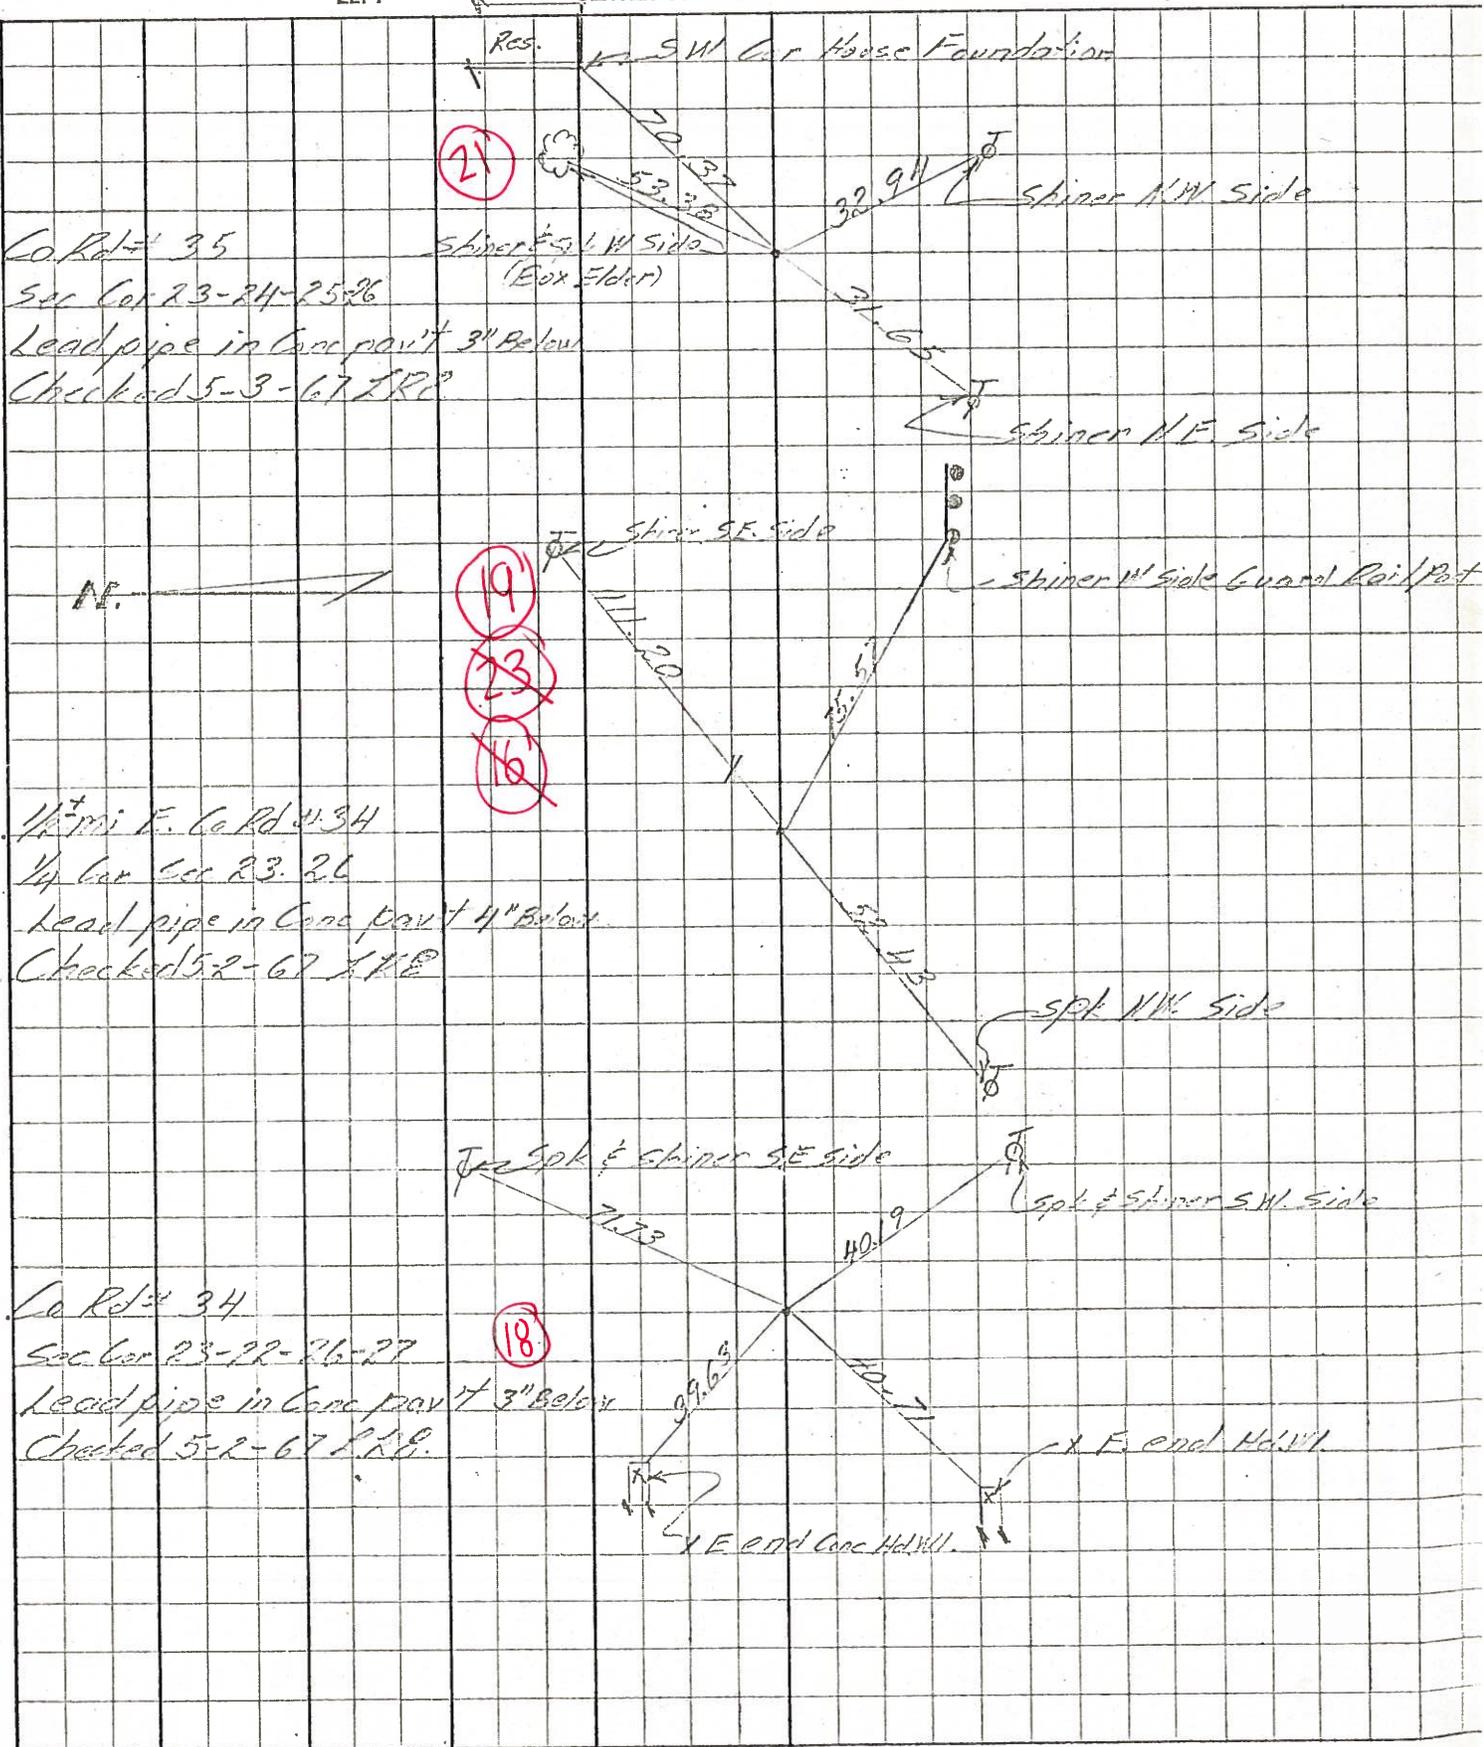

PERSONNEL TITLE PERSONNEL TITLE

COUNTY Fulton

DATE OK-1-22-58  
12-12-58

S. R. #2

WEATHER OK, 10-26-61 W. Wind

SEC. 22

TEMP.

DESCRIPTION

LEFT

CENTER LINE


RIGHT

JOB NO.

Sec. 7.36-2  
Lead pipe in conc. pait.  
Sec. Cor. 23-22-26-27

#97  
18

x-N. end  
Hdw. l. (plumb)  
Fd. O.K.

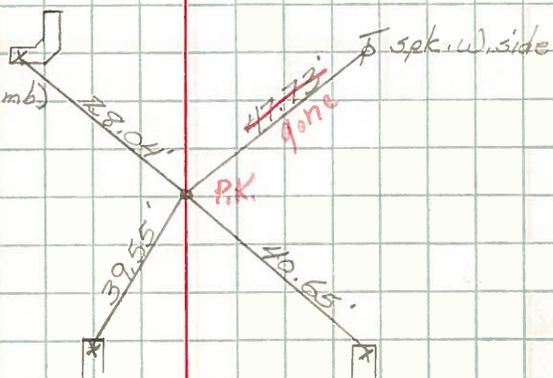


x-East end Hdws R. & L.

Sec. 7.86-2  
Lead pipe in conc. pait.  
1/4 cor. Sec. 23-26  
German Twp.

#98  
19

Fd. O.K.

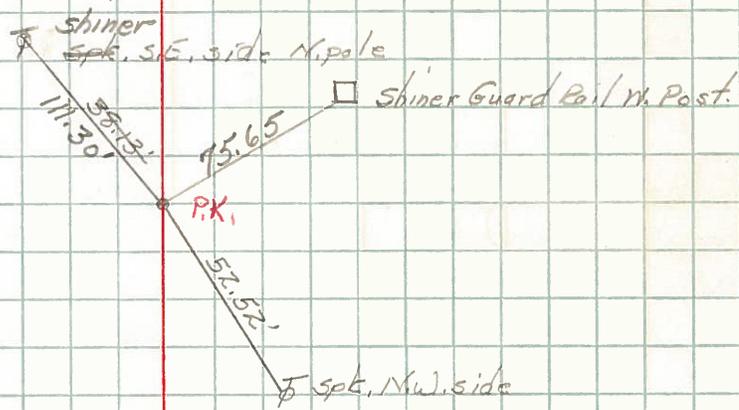

Sec. 8.36-2  
Lead pipe in conc. pait.  
Sec. Cor. 23-24-25-26  
German Twp.

#99  
21

Fd. O.K.

spt. w. side maple

