
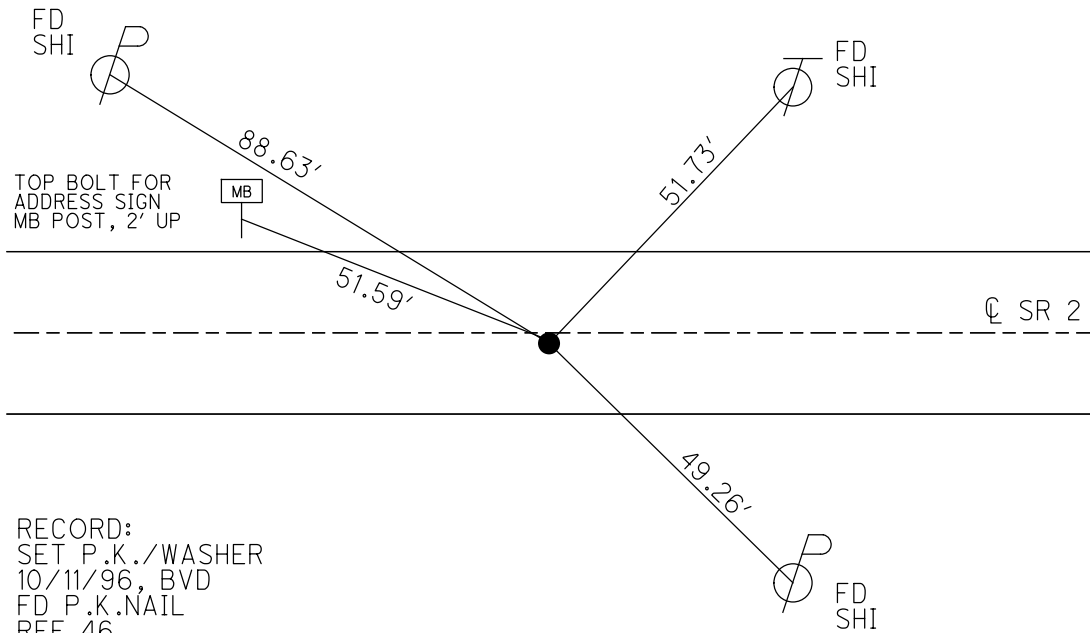
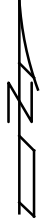


O.D.O.T. DISTRICT 2 SURVEY OFFICE (USE ONLY)

PERSONNEL	REFERENCE NO.	29 A	SHEET	9	OF	16
NOTES	HOMAN	DATE	6/8/12	ROUTE	SR 2	
H.C.	ROUSOS	WEATHER	SUNNY	COUNTY	FULTON	
R.C.	HOMAN	TEMP.	80°	TOWNSHIP	CLINTON	
				SECTION	22	
				T	7	N
				R	6	E

TYPE MONUMENT P.K.NAIL
 ON SURFACE - ~~BELOW~~ ON
 LEFT - ☉ PAV'T - ~~RIGHT~~ 0.5'
10.0' TO LT EDGE PAVEMENT
 S.L.M. 691+18.40
 Grid: Northing: 689660.215 Easting: 1513304.781


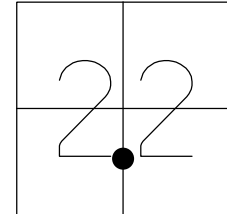


RECORD:
 SET P.K./WASHER
 10/11/96, BVD
 FD P.K.NAIL
 REF 46
 5/31/12
 SET MAG/WASHER
 NEWREF 46
 3/4/13, DCH
 FD MAG/WASHER
 REFA29
 6/15/21, TDM
 9/15/21, JFO

O.D.O.T. DISTRICT 2 SURVEY OFFICE (USE ONLY)

PERSONNEL _____ REFERENCE NO. 29 A SHEET 9 OF 15
 NOTES HOMAN DATE 6/8/12 ROUTE SR 2
 H.C. ROUSOS WEATHER SUNNY COUNTY FULTON
 R.C. HOMAN TEMP. 80° TOWNSHIP CLINTON
 _____ SECTION 22
 _____ T 7 N R 6 E

TYPE MONUMENT P.K.NAIL
 ON SURFACE - ~~BELOW~~ ON _____
 LEFT - ☉ PAV'T - ~~RIGHT~~ 0.5'
10.0' TO LT EDGE PAVEMENT
 S.L.M. 691+18.40
 Grid: Northing: 689660.215 Easting: 1513304.781

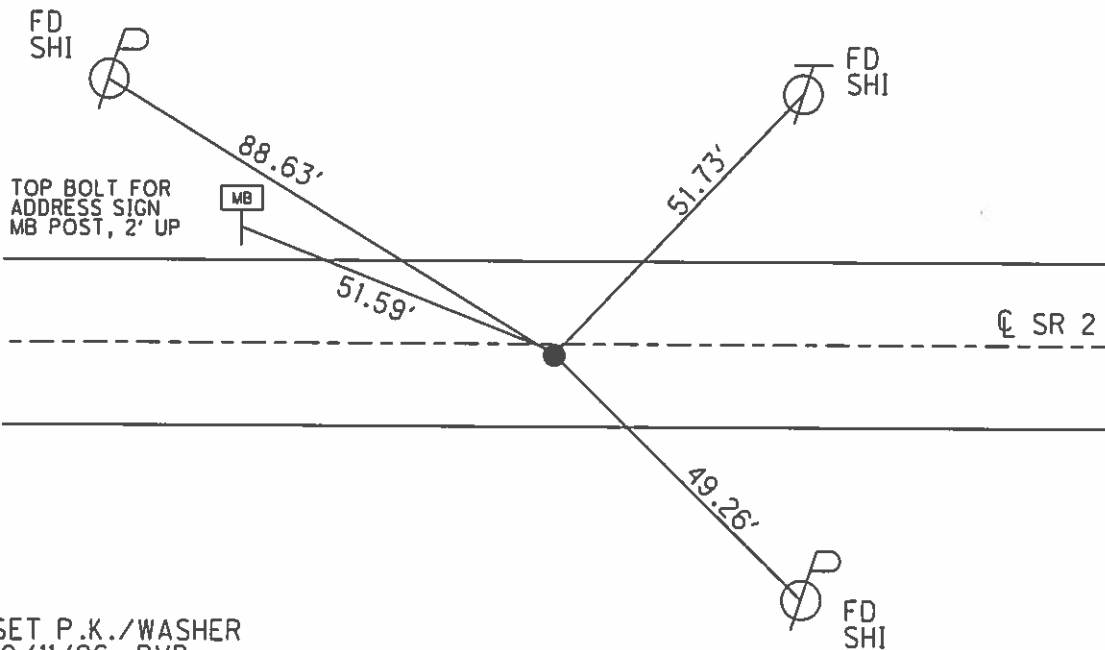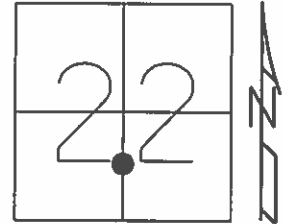

SET P.K./WASHER
 10/11/96, BVD

FD PK
 GPS, REF 46
 5/31/12

SET MAG/WASHER
 GPS, NEWREF 46
 3/4/13, DCH

O.D.O.T. DISTRICT 2 SURVEY OFFICE

PERSONNEL

REFERENCE NO. 29-A SHEET 8 OF 14

NOTES BARNHISEL

H.C. CORDES

DATE 9-24-96

ROUTE S.R. 2

R.C. BARNHISEL

WEATHER SUNNY

COUNTY FULTON

TEMP. +70° F

TOWNSHIP CANTON

SECTION 22

T 7 N R 6 E


TYPE MONUMENT PK NAIL

ON SURFACE - BELOW YES


LEFT- & PAV'T. - RIGHT 0.5

10.0 TOLT EDGE PAVEMENT

S.L.M. 687+57

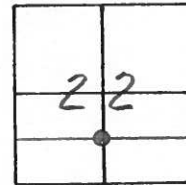

*SET PK/WASHER
10-11-96
BVD*

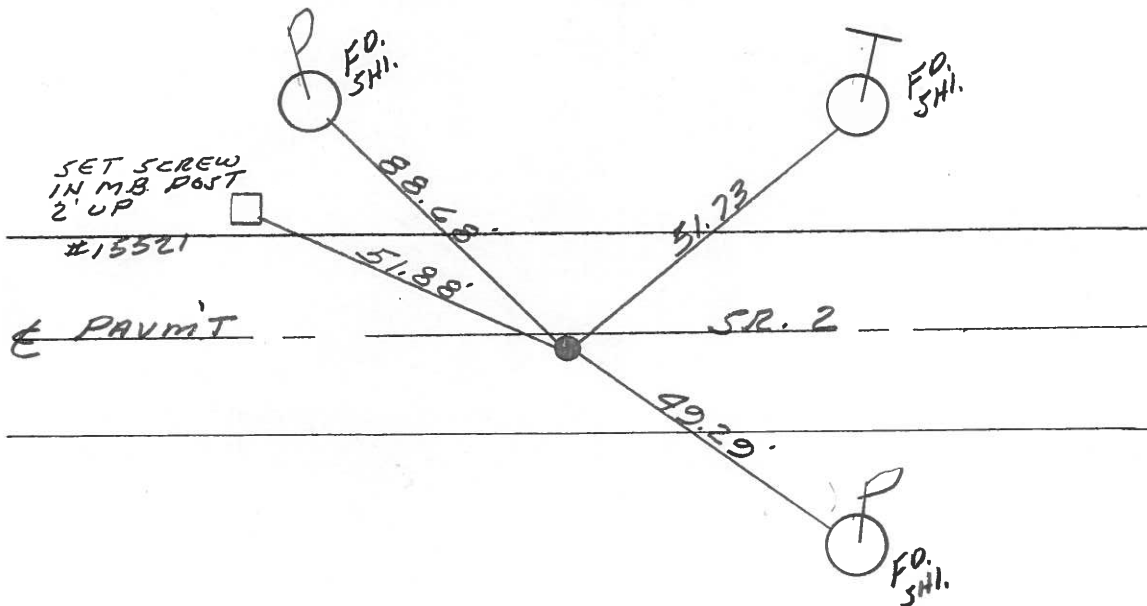

O.D.O.T. DISTRICT 2 SURVEY OFFICE

PERSONNEL _____

REFERENCE NO. 29-A

SHEET 8 OF _____

NOTES 1. Stone

H.C. D. Curtis

R.C. J. Hauscholder

DATE 25 April 89

WEATHER Cloudy

TEMP. 65.0

ROUTE SR#2

COUNTY Fulton

TOWNSHIP Clinton

SECTION 22

T. _____ R. _____


TYPE MONUMENT PK Nail

ON SURFACE - BELOW Surface

LEFT- & PAW'T. - RIGHT _____

TO _____ EDGE PAVEMENT

S.L.M. 689+46

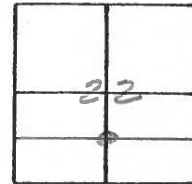

OK 5/30/89 IRS

