
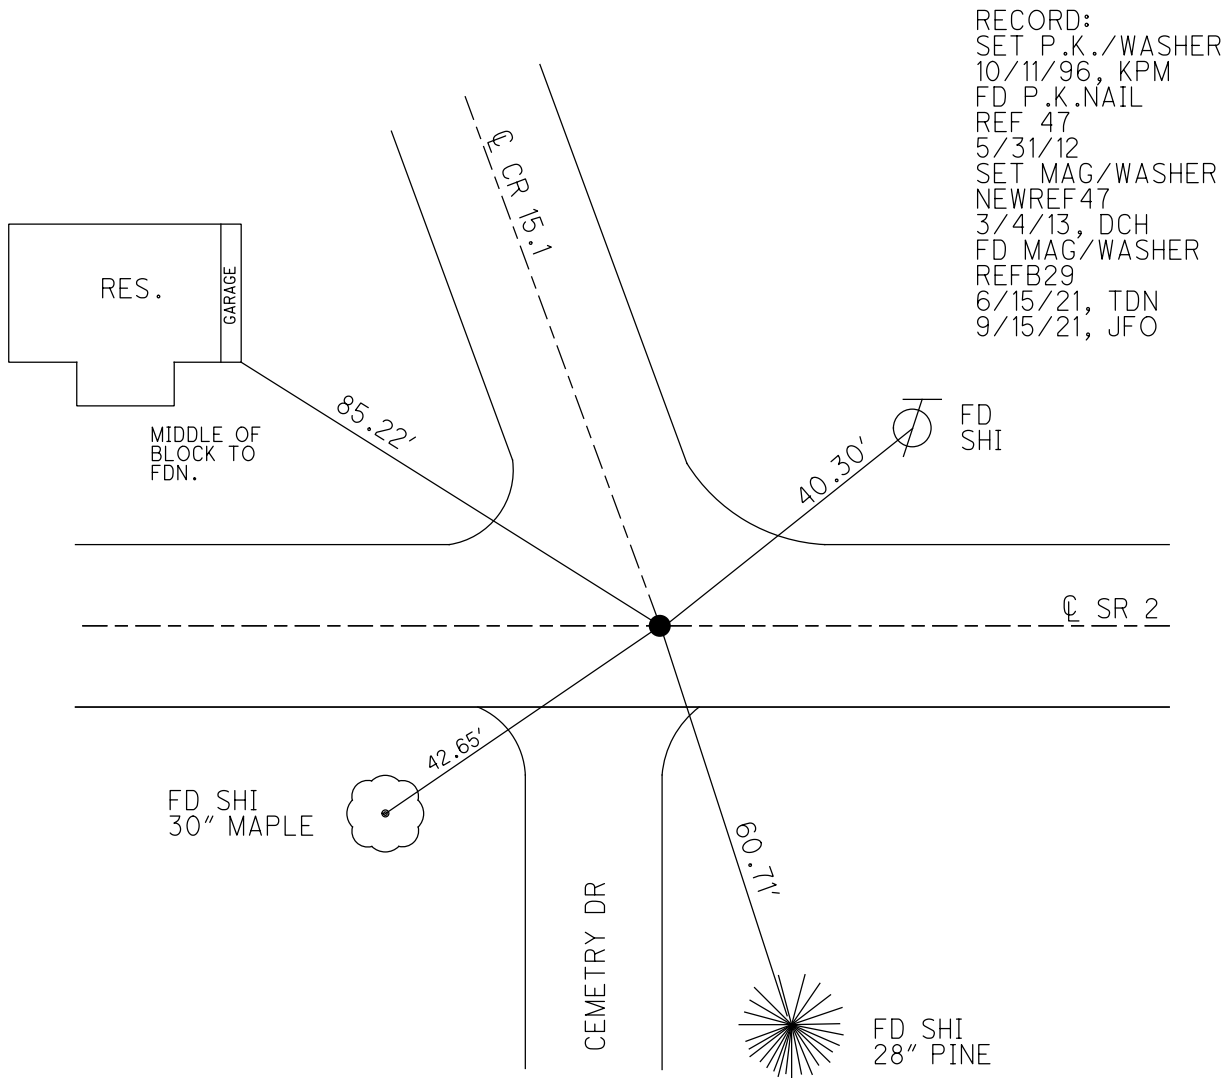


O.D.O.T. DISTRICT 2 SURVEY OFFICE (USE ONLY)

PERSONNEL _____ REFERENCE NO. 29 B SHEET 10 OF 16
 NOTES HOMAN DATE 6/8/12 ROUTE SR 2
 H.C. ROUSOS WEATHER SUNNY COUNTY FULTON
 R.C. HOMAN TEMP. 80° TOWNSHIP CLINTON
 _____ SECTION 22
 _____ T 7 N R 6 E


TYPE MONUMENT P.K.NAIL
 ON SURFACE - ~~BELOW~~ ON _____
 LEFT - ☉ PAV'T - ~~RIGHT~~ 1.8'
13.7' TO RT EDGE PAVEMENT
 S.L.M. 710+39.45
 Grid: Northing: 689674.489 Easting: 1515225.777

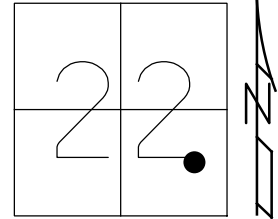


O.D.O.T. DISTRICT 2 SURVEY OFFICE (USE ONLY)

PERSONNEL _____ REFERENCE NO. 29 B SHEET 10 OF 15
 NOTES HOMAN DATE 6/8/12 ROUTE SR 2
 H.C. ROUSOS WEATHER SUNNY COUNTY FULTON
 R.C. HOMAN TEMP. 80° TOWNSHIP CLINTON
 _____ SECTION 22
 _____ T 7 N R 6 E

TYPE MONUMENT P.K.NAIL
 ON SURFACE - ~~BELOW~~ ON
 LEFT - ☉ PAV'T - RIGHT 1.8', (LT-RT?)
13.7' TO RT EDGE PAVEMENT
 S.L.M. 710+39.45

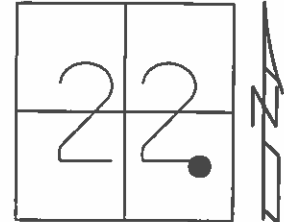

Grid: Northing: 689674.489 Easting: 1515225.777

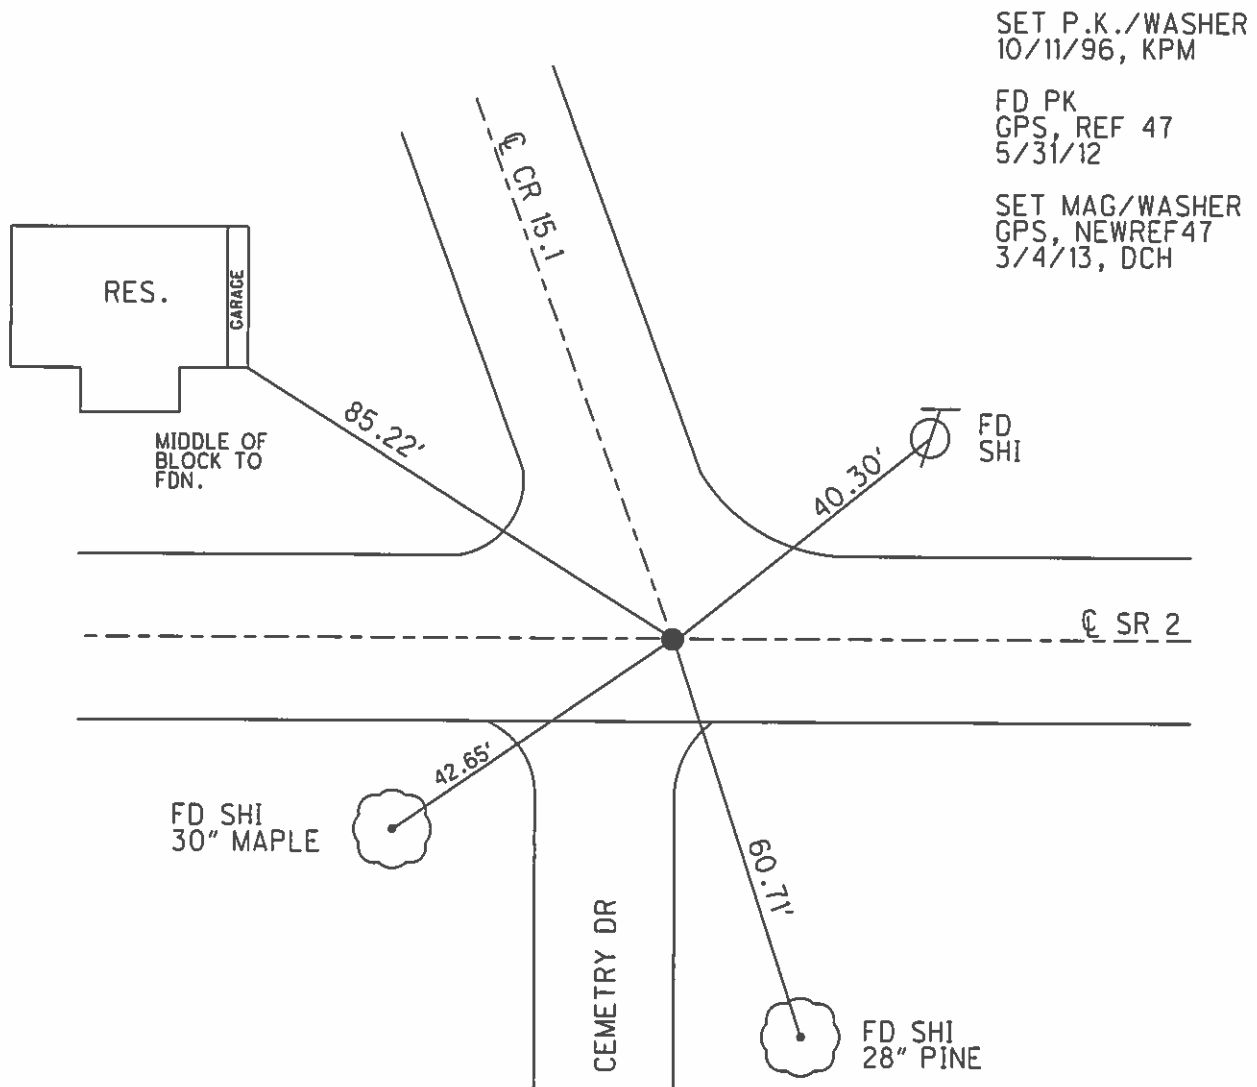

O.D.O.T. DISTRICT 2 SURVEY OFFICE

PERSONNEL

REFERENCE NO. 29-B

SHEET 9 OF 14

NOTES MIKE BARNHISEL

H.C. BEN CORDES

DATE 9-24-96

ROUTE S.R. 2

R.C. _____

WEATHER Sunny

COUNTY FULTON

TEMP. + 70°

TOWNSHIP CLINTON

SECTION 22

T 7 N R 6 E


TYPE MONUMENT PK NAIL

ON SURFACE - ~~BELOW~~ SURFACE


LEFT - CL PAV'T. - RIGHT 1.8

13.7 TO RT EDGE PAVEMENT

S.L.M. 706 + 78

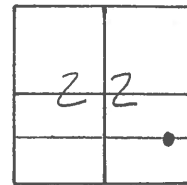

SET PK/WASHERS
10-11-96
KPM

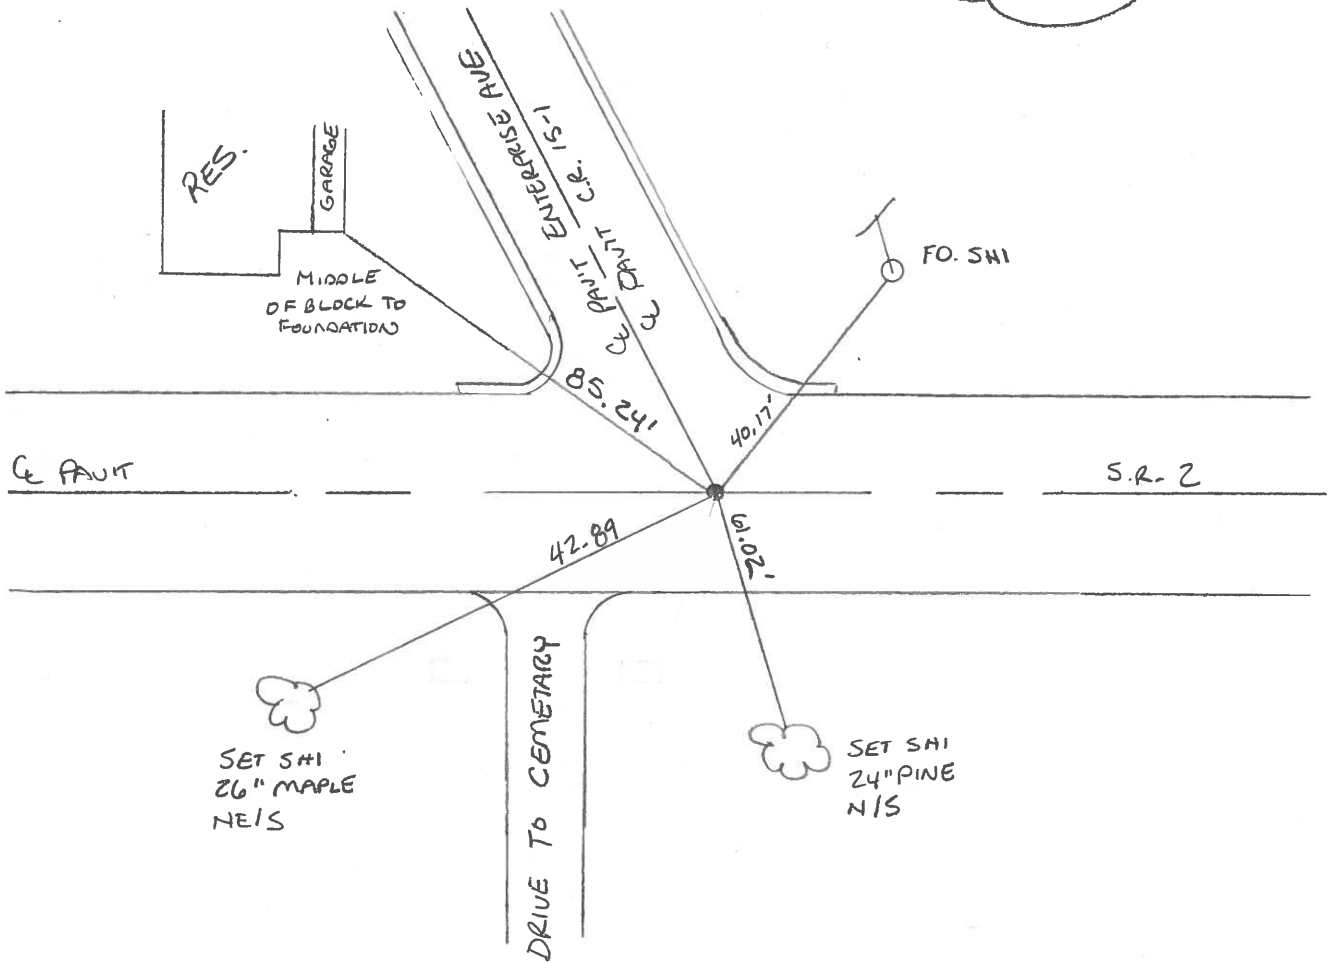

SET SHI
26" MAPLE
NE/S

SET SHI
24" PINE
N/S

O.D.O.T. DISTRICT 2 SURVEY OFFICE

PERSONNEL _____ REFERENCE NO. 29-B SHEET 9 OF _____

NOTES 1. Stone

H.C. D. Curtis

R.C. J. Householder

DATE 25 April 89

WEATHER Cloudy

TEMP. 65°

ROUTE SR # 2

COUNTY Fulton

TOWNSHIP Clinton

SECTION 22

T _____ R _____


TYPE MONUMENT PK Nail

ON SURFACE - BELOW Surface


LEFT - & PAV'T. - RIGHT _____

_____ TO _____ EDGE PAVEMENT

S.L.M. 708+68

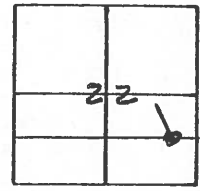

OK 5/30/89 IRS

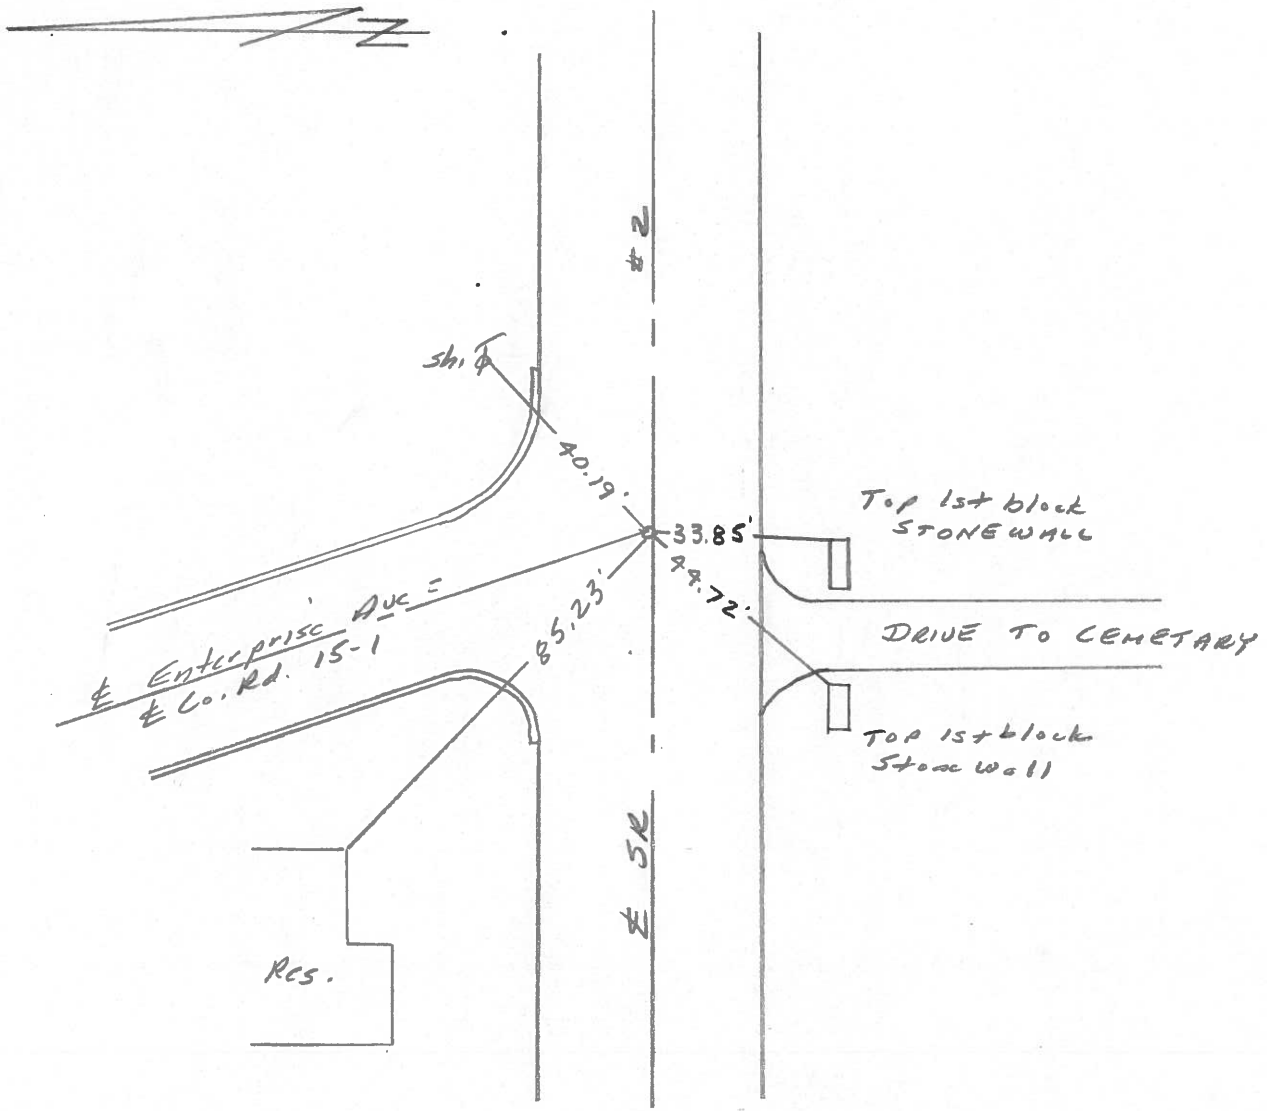

PERSONNEL	TITLE	PERSONNEL	TITLE	COUNTY	DATE	WEATHER	TEMP.
Slope				Fulton	22 Aug. 77	cloudy	60°
Crew				#2			
				Wauseon			

DESCRIPTION _____ *References* _____ JOB NO. _____

LEFT _____ CENTER LINE _____ RIGHT _____

