


PERSONNEL TITLE PERSONNEL TITLE

COUNTY Fulton DATE 22 Aug. 77

S. R. # 2 WEATHER cloudy

SEC. Wauscon TEMP. 63°


DESCRIPTION LEFT CENTER LINE RIGHT JOB NO.

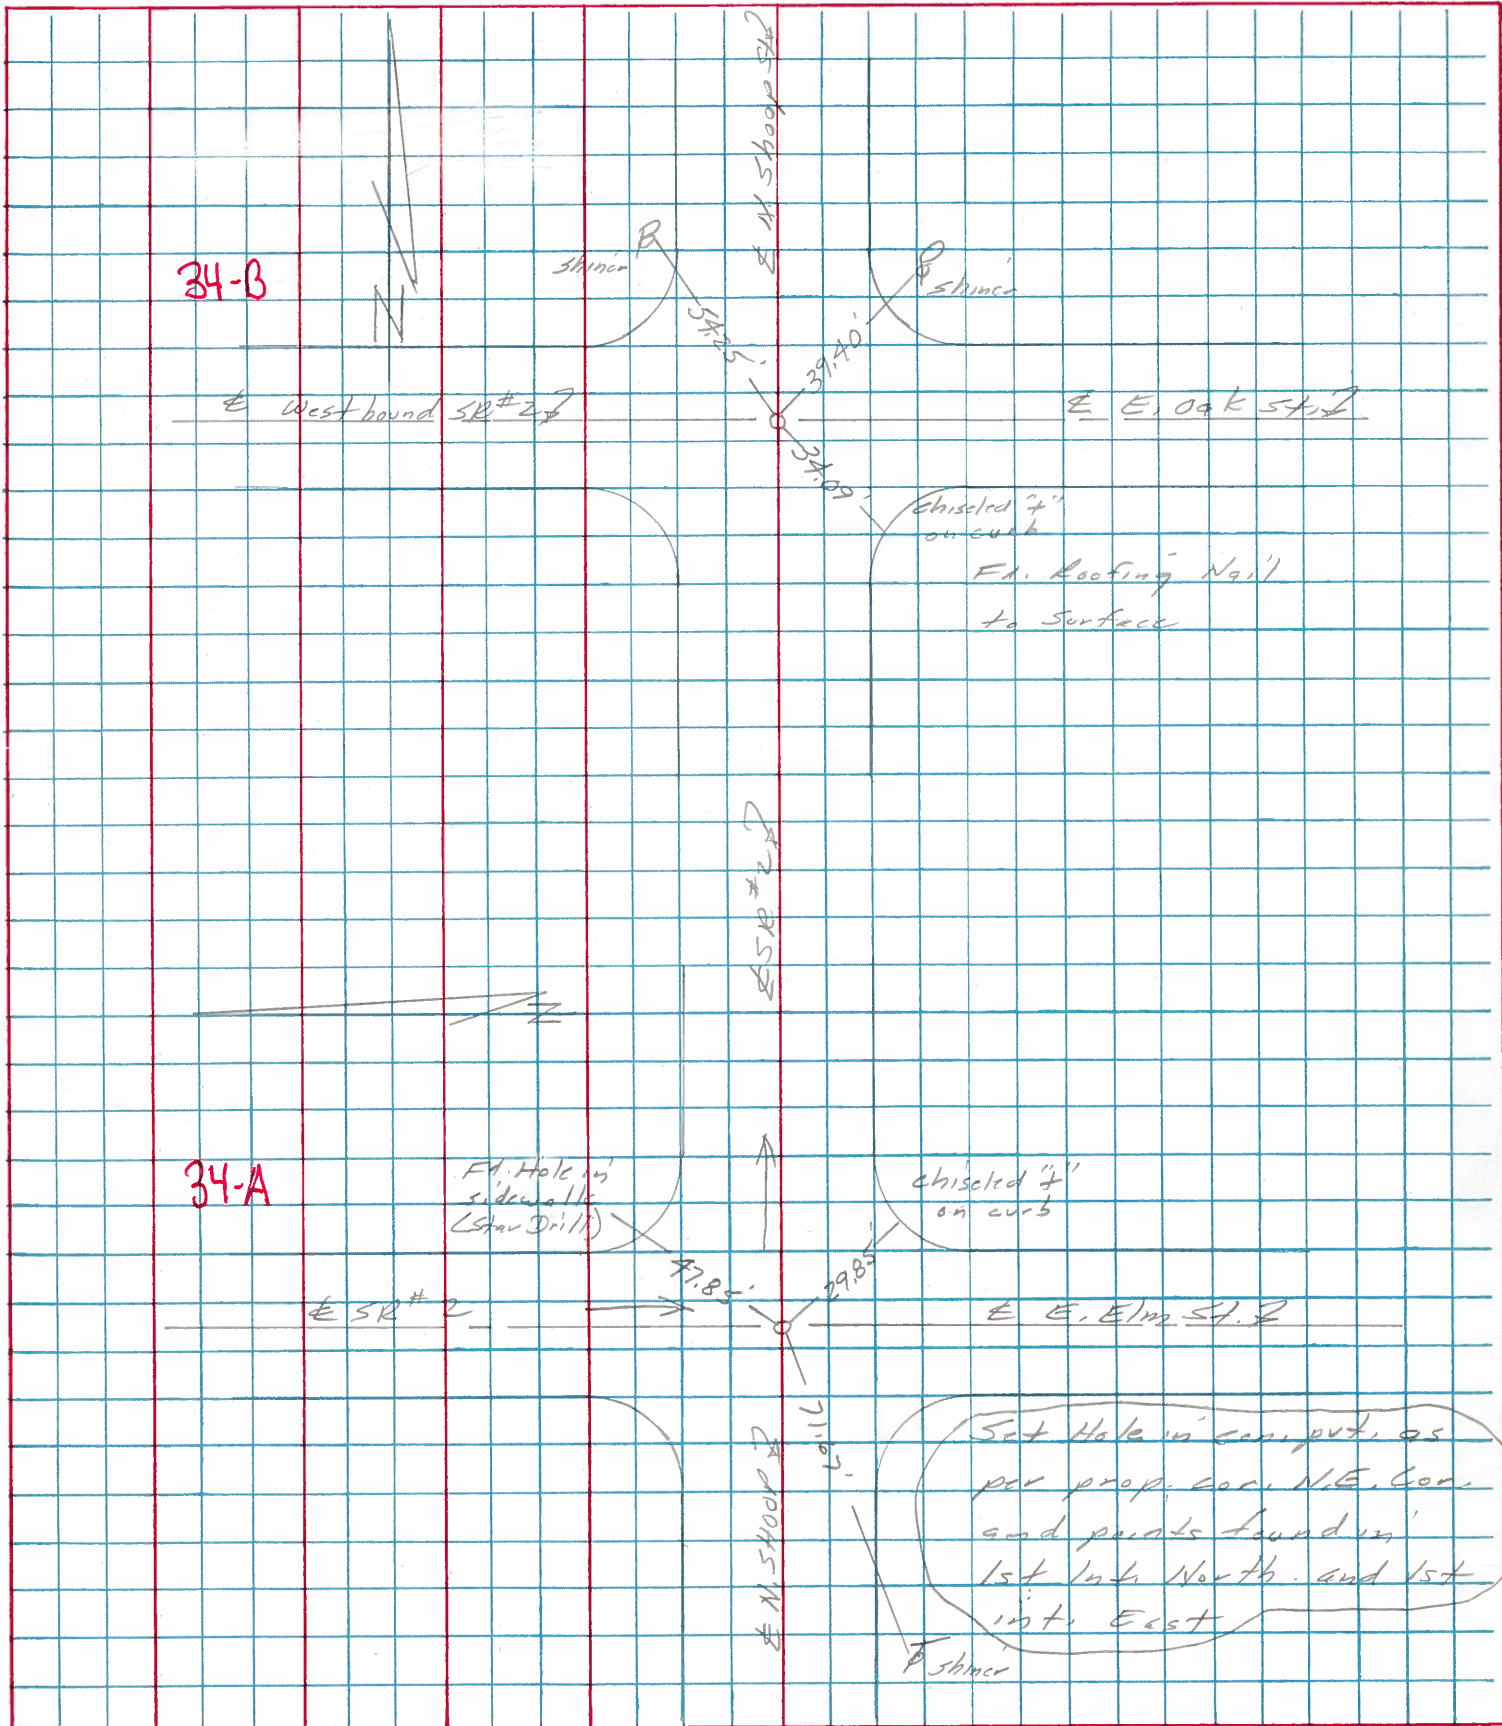

PERSONNEL TITLE PERSONNEL TITLE

Blair COUNTY Full House DATE 22 Aug. 77
Crawford S. R. # 2 WEATHER Cloudy
SEC. Wagon Secs TEMP 63°

DESCRIPTION LEFT CENTER LINE RIGHT JOB NO.

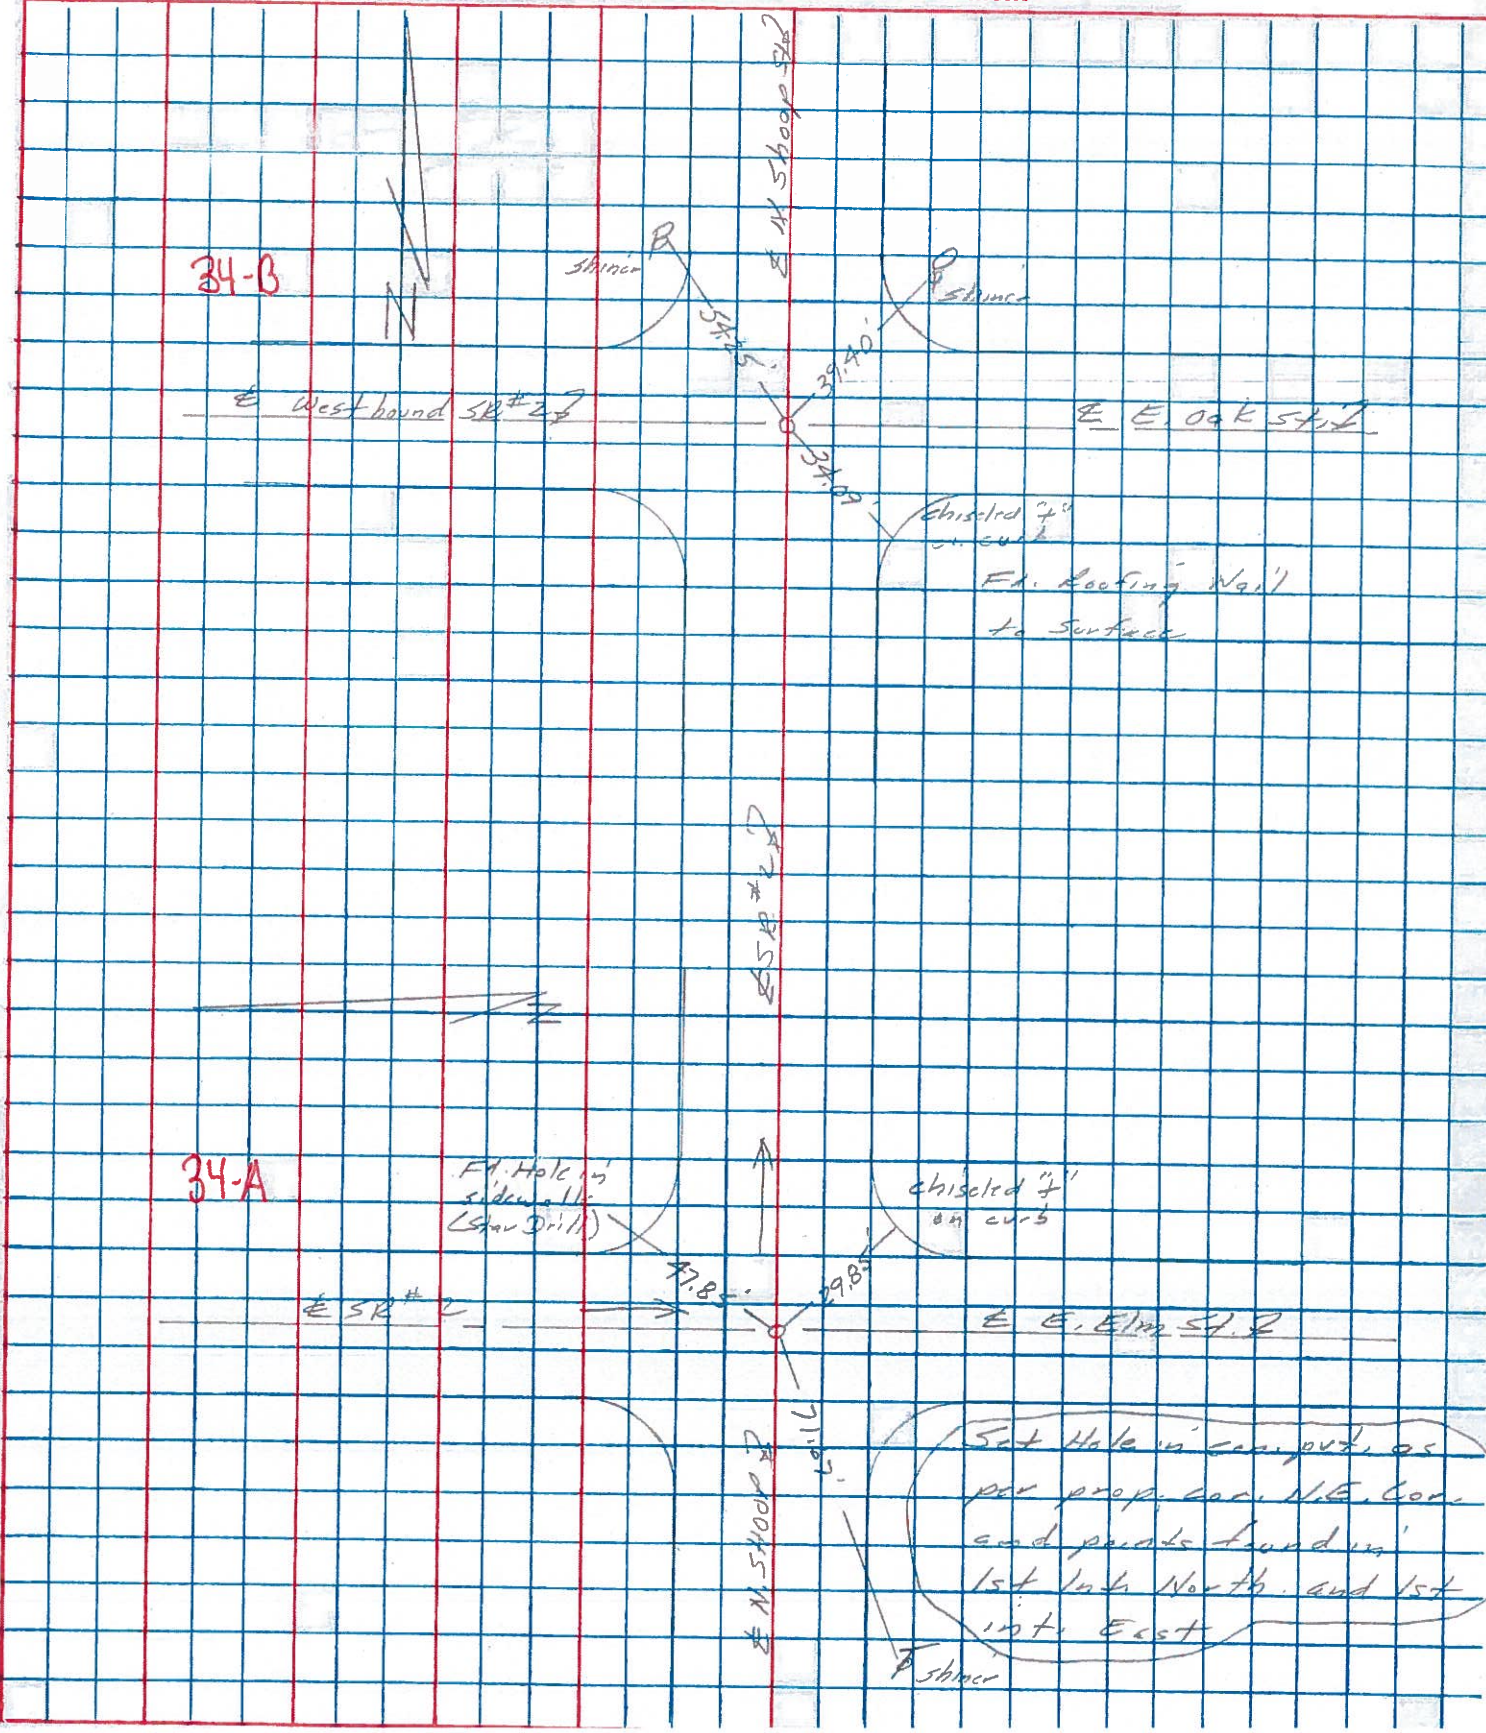

PERSONNEL TITLE PERSONNEL TITLE

COUNTY Fulton

DATE OK 1-23-58
12-12-58

S. R. # 2


WEATHER 10-27-61 W. X

SEC. _____ TEMP. _____

DESCRIPTION LEFT CENTER LINE RIGHT JOB NO. _____


Sec. 12.32
Lead pipe in conc. pav't.
Cor. sec. 21-22-27-28
Clinton twp.

#106-A
28

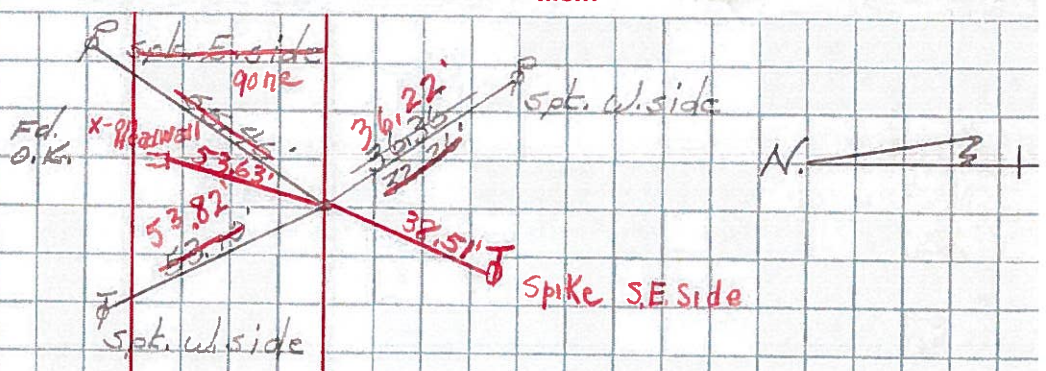


Sec. 12.32
X-1" conc. pav't.
1303.2' Map
Sec. cor. 21-22 7-28
Clinton twp.

#107
29

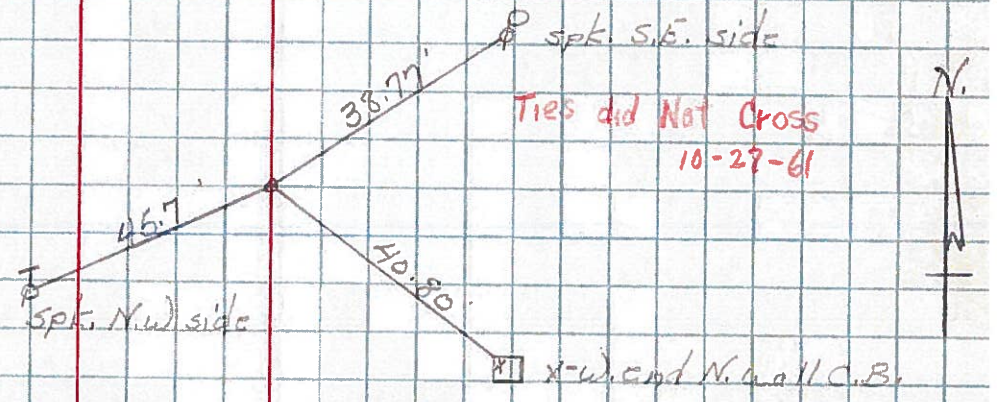

S.W. cor. ho. fdn.
1" Iron pin
Corp. Line
Jauseon

#108
34-B

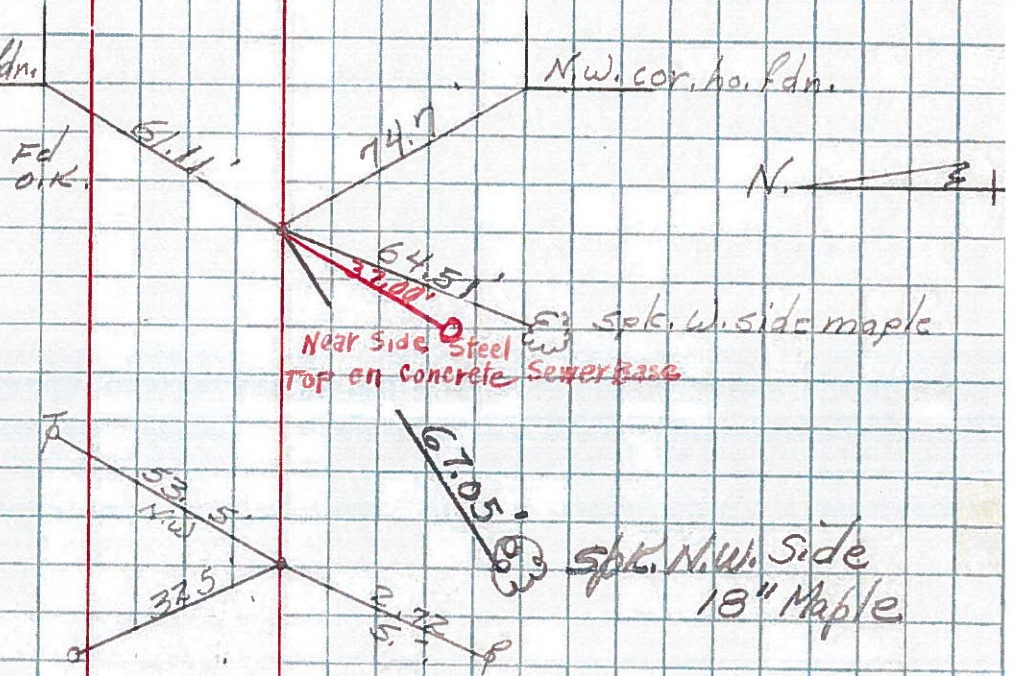

E. End of Sheep Ave.
Wauseon Ohio
Iron bolt.