



PERSONNEL TITLE PERSONNEL TITLE COUNTY Kulham DATE 5 Oct. 81
 PERSONNEL TITLE PERSONNEL TITLE S. R. US # 20 WEATHER Cloudy
 PERSONNEL TITLE PERSONNEL TITLE SEC. 1.50 - 6.91 TEMP. 62°
 DESCRIPTION LEFT CENTER LINE RIGHT JOB NO. 026112

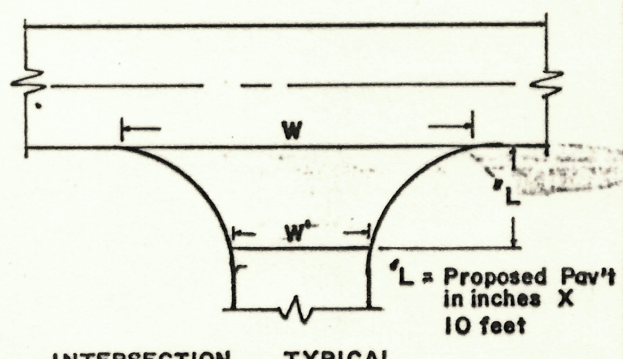


INTERSECTION TYPICAL

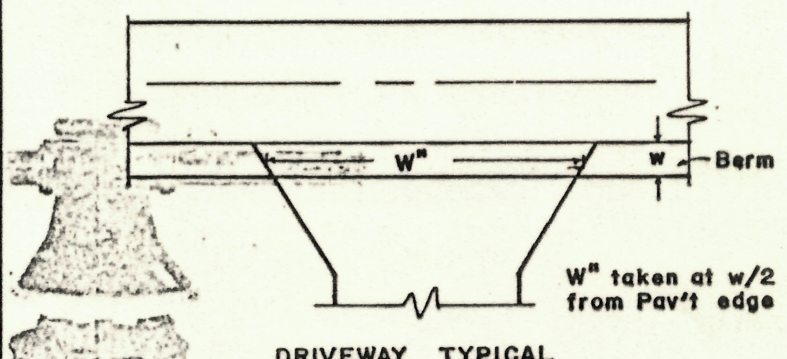


DRIVEWAY TYPICAL

STATION	RT. LT.	L	W	W'	Asph	Conc		STATION	RT. LT.	w	W'	Asph	Conc	Aggr	Dropped Curb Feather NOT Req'd
112+00	RT.	12.5	100	45	✓		26	103+90	RT.	3	32	✓			174' - 175'
200+70	RT	12.5	50	29	✓		Walnut	114+00	RT.	3	34	✓			200' East of 26
203+95	RT	12.5	47	23	✓		College	118+90	LT.	3	30	✓			600' East of 26
209+54	RT	12.5	48	30	✓		Maple	192+80	RT	3	24		✓		In curb area
212+77	LT	12.5	48	27	✓		Goehman	203+85	LT	3	23	✓			College St
212+77	RT.	12.5	50	29	✓		"	204+56	LT	3	18		✓		"
215+95	LT	12.5	51	30	✓		Cherry	205+73	LT	3	11		✓		E. of " "
215+95	RT	12.5	52	38	✓		"	206+54	RT	3	21		✓		
219+25	LT	12.5	73	56	✓		Lebanon	208+21	RT	3	12		✓		
219+25	RT	12.5	73	56	✓		"	208+48	LT	3	19		✓		
222+50	LT	12.5	52	30	✓		Ohio	214+38	RT	3	18	✓			West of Cherry St
222+50	RT	12.5	62	34	✓		"	219+75	LT	3	35		✓		Sabia
225+65	LT	12.5	41	23	✓		Eagle	220+50	LT	3	32		✓		
225+65	RT.	12.5	46	28	✓		"	221+80	LT	3	34		✓		
228+78	LT	12.5	42	24	✓		Lebanon	221+90	RT	3	42		✓		
228+78	RT	12.5	43	24	✓	(16)	"	222+25	LT	3	24		✓		
325+57	LT	12.5	61	29	✓		22	218+28	LT	3	30		✓		
325+57	RT	12.5	86	51	✓		22	224+04	RT	3	9		✓		
								225+90	LT	3	32	✓			
								226+40	RT	3	42		✓		
								226+50	LT	3	49		✓		
								227+11	RT	3	10	✓			
								229+85	LT	3	11		✓		

PERSONNEL	TITLE	PERSONNEL	TITLE	COUNTY	DATE
<i>Stone</i>				<i>Fulton</i>	<i>5 Oct. 81</i>
				S. R.	WEATHER
<i>Crew</i>				<i>US # 20</i>	<i>Cloudy</i>
				SEC.	TEMP.
				<i>1.50-6.91</i>	<i>620</i>
DESCRIPTION	LEFT	CENTER LINE	RIGHT	JOB NO. <i>026112</i>	

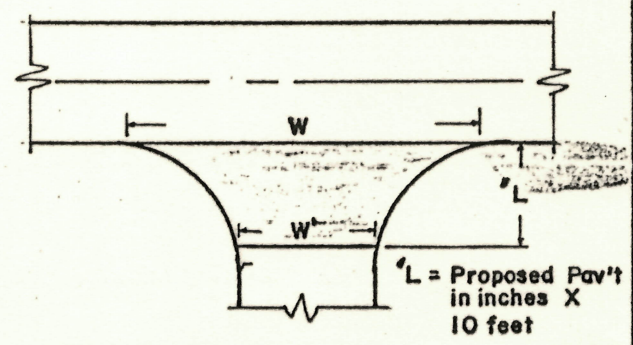

INTERSECTION TYPICAL

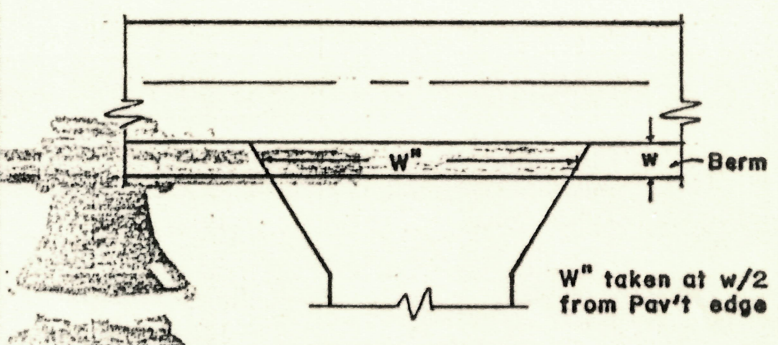

DRIVEWAY TYPICAL

STATION	RT. LT.	L	W	W'	Asph	Conc	STATION	RT. LT.	w	W''	Asph	Conc	Aggr	Dropped Curb Feather NOT Req'd
							230+50	RT	3	10		✓		
							230+80	LT	3	22		✓		
							231+15	RT	3	9		✓		
							232+00	LT	3	27		✓		
							232+60	RT	3	12		✓		
							233+30	LT	3	10		✓		
							234+30	RT	3	48		✓		
							234+50	LT	3	30		✓		
							235+20	RT	3	80	✓			
							236+25	LT	3	20	✓			
							236+40	RT	3	80	✓			
							237+40	LT	3	71		✓		


PERSONNEL TITLE PERSONNEL TITLE COUNTY Kulhan DATE 5 Oct. 81
5600 _____ _____ _____
5 _____ _____ _____ S. R. US # 20 WEATHER cloudy
Cond _____ _____ _____ SEC. 1.50 - 6.91 TEMP. 62°
DESCRIPTION _____ _____ _____ _____ _____ JOB NO. 02611C

STATION	OUT Rt-Lt	CB	TYPE 1,2,3	MH	TYPE San. Storm	MONU	TYPE Box Other	WV	CASTING		Remarks
									Raise	Feather	
236+89	15' Lt			✓	San.					✓	
197+55	Lt	✓	2						✓		
197+55	Rt	✓	2							✓	
203+75	Lt	✓	2						✓		College St
203+75	Rt	✓	2						✓		" "
205+85	Lt	✓	2							✓	E. of " "
205+85	Rt	✓	2							✓	" " " "
212+60	Lt	✓	2							✓	Gorham
212+60	Rt	✓	2							✓	"
215+76	23 Rt	✓	2							✓	
215+80	30 Rt	✓	2							✓	
215+79	Lt	✓	2							✓	
218+83	Lt	✓	2							✓	
218+83	Rt	✓	1							✓	
221+40	Rt	✓	1							✓	
222+23	Lt	✓	2							✓	
222+32	Rt	✓	2							✓	
225+35	Lt	✓	2							✓	
225+35	Rt	✓	2							✓	
225+52	20 Lt			✓	San.					✓	
225+83	15 Rt			✓	San.					✓	
227+31	15 Rt			✓	San.					✓	
228+77	15 Rt			✓	San.				✓		
228+51	Lt	✓	2							✓	
228+51	Rt	✓	2							✓	
230+34	15 Rt			✓	San.					✓	
232+12	Rt	✓	2							✓	
232+17	15 Rt			✓	Storm					✓	
233+88	Lt	✓	2							✓	
234+18	15 Lt			✓	Storm					✓	
235+78	Rt	✓	2							✓	
235+88	15 Rt			✓	Storm					✓	
236+89	15 Lt			✓	"					✓	

PERSONNEL	TITLE	PERSONNEL	TITLE
Stojc			
Craw			

COUNTY Fulton DATE 1 Oct. 81
 S. R. US #20 WEATHER Cloudy
 SEC. 1.50-4.66 TEMP. 15°C

DESCRIPTION Pavement Widths JOB NO. 026112

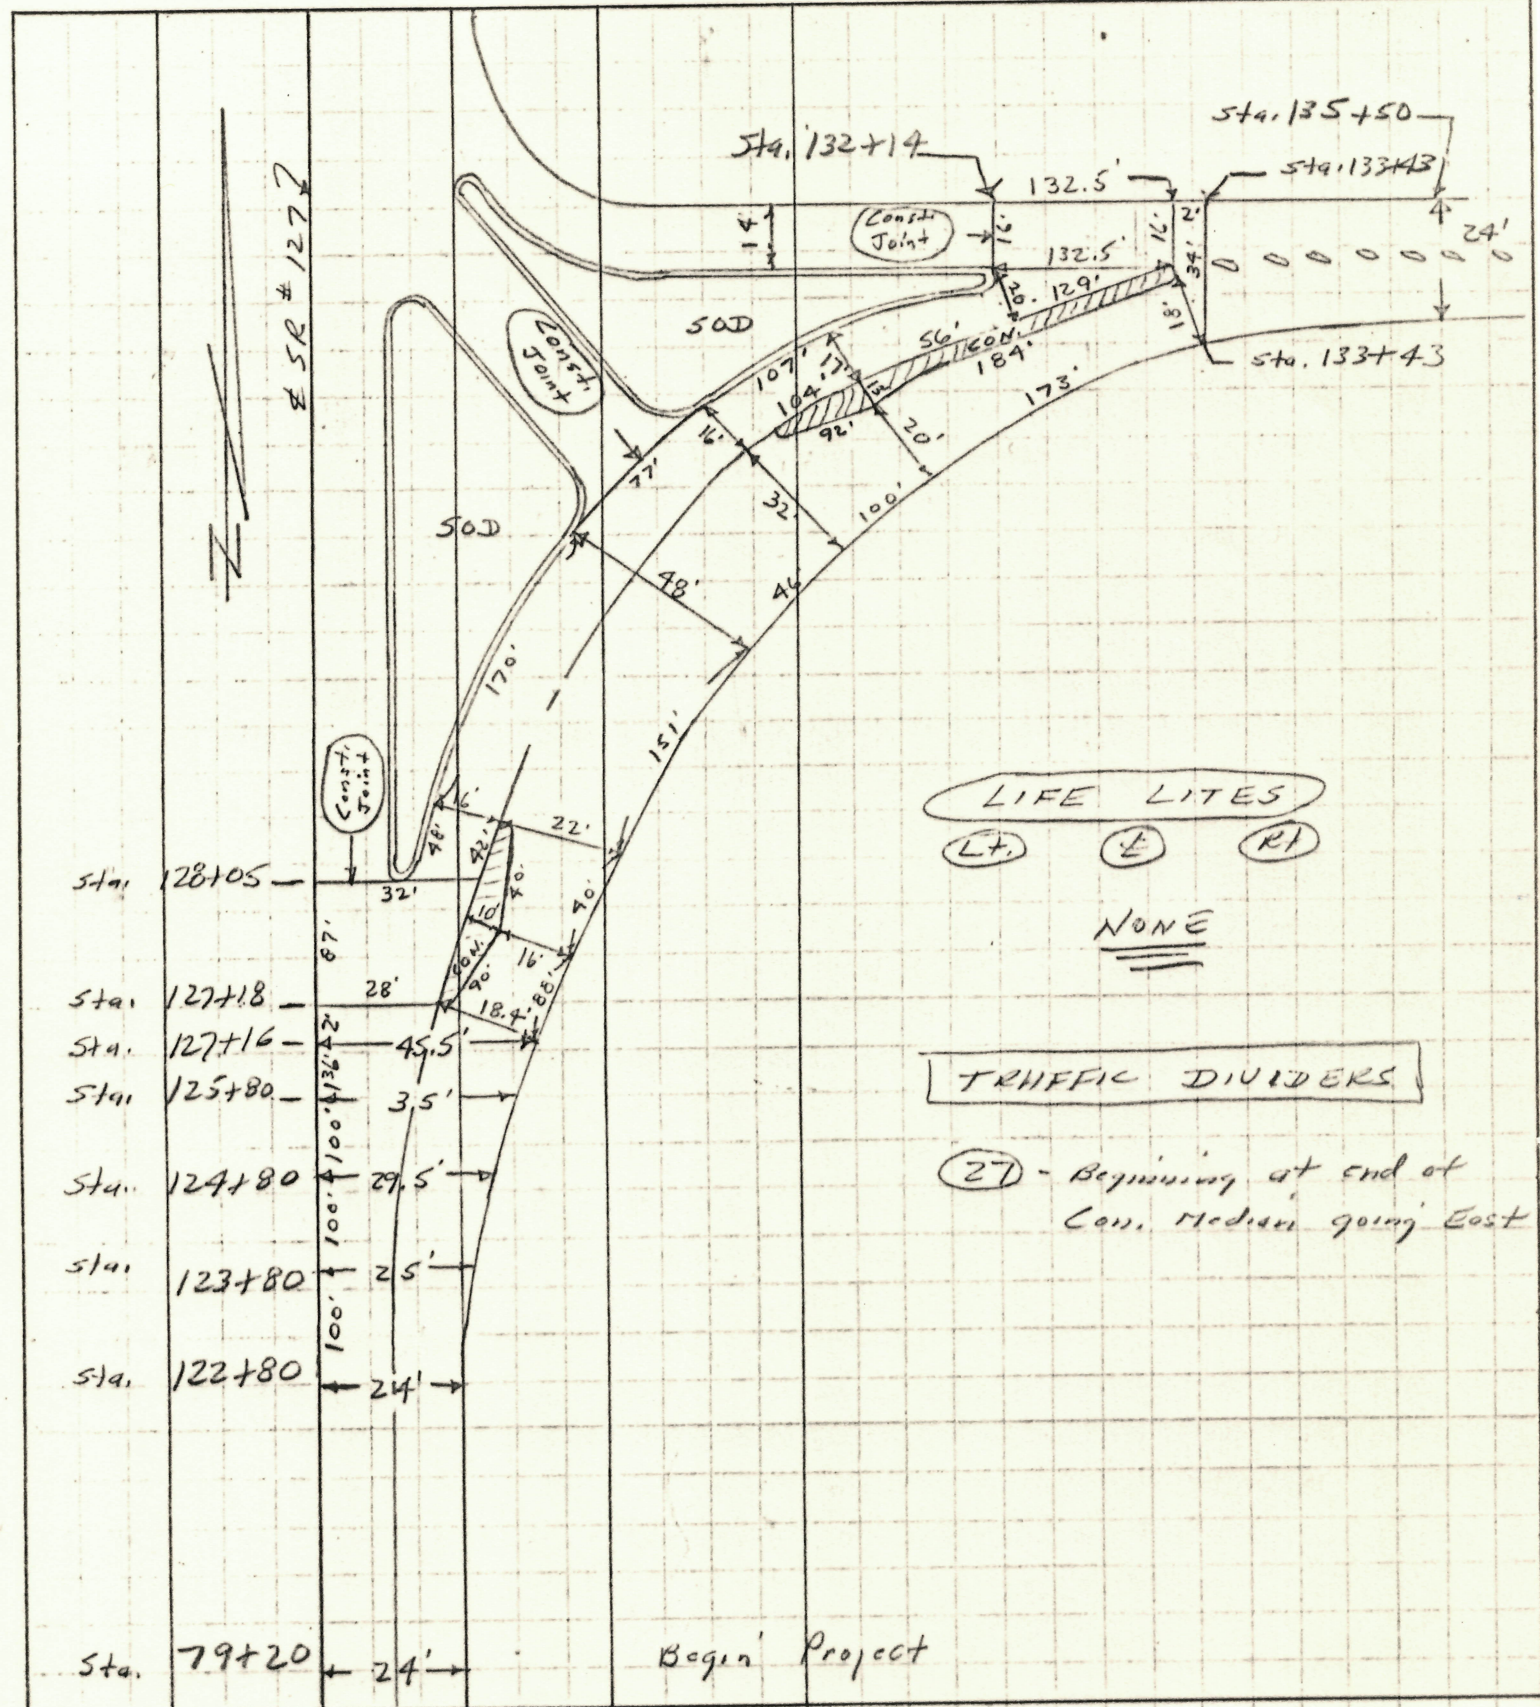

PERSONNEL	TITLE	PERSONNEL	TITLE
Stone			
Crew			

COUNTY Fulton DATE 16 Sept. 81
 S. R. DC#20 WEATHER Cool
 SEC. 1.50 - 4.53 TEMP. 58°

DESCRIPTION Extra pavement JOB NO. 026112

