

Measured and painted 3-9-87

ODOT (D-2)

1988 TWO-LANE RESURFACING PROGRAM

PRIORITY NO. 28 PART ____ OF ____ SHEET ____ OF ____

COUNTY Fulton ROUTE US 20 SECTION 10.86

BEGIN LOG (SLM) 10.86 TERMINII SR108 573+40.8 (Butt)

END LOG (SLM) 13.87 TERMINII SR 108 Meas., 731+89 (Butt)

TOTAL LENGTH 3.01 MILES

MUNICIPALITY _____ BEGIN LOG (SLM) _____ END LOG (SLM) _____

MUNICIPALITY _____ BEGIN LOG (SLM) _____ END LOG (SLM) _____

PROPOSED WORK: 1 1/2" - 404 SHOULDER 1 1/2" - 404, \$6.17 (5mg/11)

OTHER _____

EXISTING DATA:

[illegible]

STRUCTURES:

STRUCTURES:

STR. NO.	FOL. 20-10.96	, WIDTH	31	, LENGTH	36	, PROP. WORK	
STR. NO.		, WIDTH		, LENGTH		, PROP. WORK	
STR. NO.		, WIDTH		, LENGTH		, PROP. WORK	
STR. NO.		, WIDTH		, LENGTH		, PROP. WORK	
STR. NO.		; WIDTH		, LENGTH		, PROP. WORK	
STR. NO.		, WIDTH		, LENGTH		, PROP. WORK	

RAILROAD CROSSING:

RAILROAD CROSSING:					(no work)	
NAME <u>None</u>	STATION _____	NO. TRACKS _____	LENGTH ALONG C	L _____	ft	
NAME _____	STATION _____	NO. TRACKS _____	LENGTH, ALONG C	L _____	ft	
NAME _____	STATION _____	NO. TRACKS _____	LENGTH ALONG C	L _____	ft	

MISCELLANEOUS:

MISCELLANEOUS:
NO. RAISED PAVEMENT MARKERS; EDGE OF PAVEMENT 35, CENTERLINE 219
NO. MAILBOX APPROACHES None, AVERAGE AREA _____

REMARKS: No drainage


COUNTY Fulton DATE 6 March 87

S. R. US #20 WEATHER Sunny

SEC. 10.86 - 13.87 TEMP. 50°

DESCRIPTION	LEFT	CENTER LINE	RIGHT	JOB NO.
Pavement Widths				

LEFT	CENTER LINE	RIGHT
1	2	3
4	5	6
7	8	9
364	365	366
367		

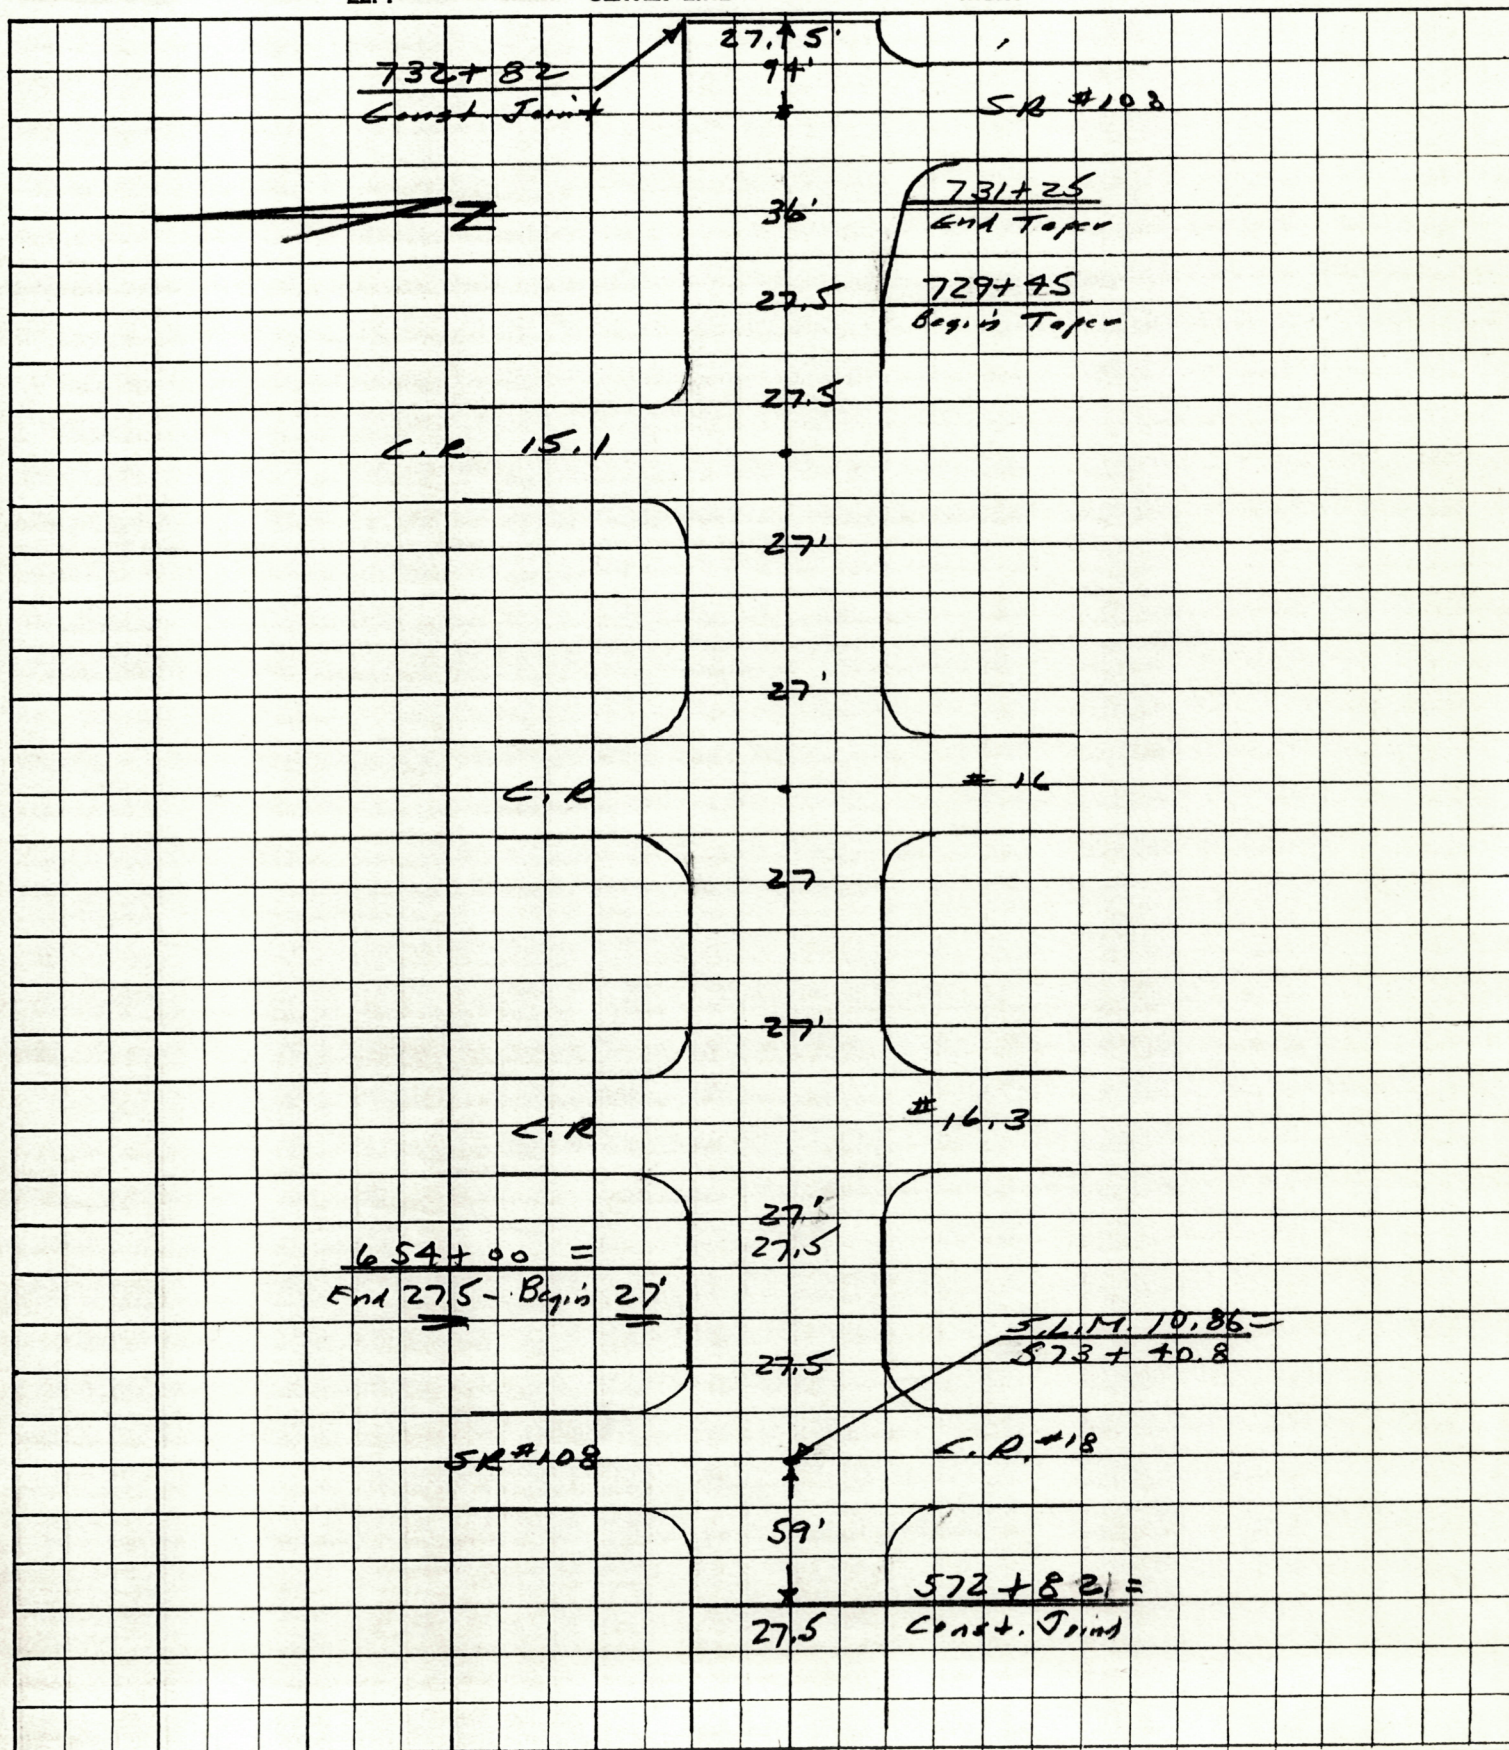

APPROACHES (INTERSECTIONS & DRIVES)

COUNTY Fulton

ROUTE US #20

SECTION 10.86-13.87

L = Prop Pav't Depth (in.) x 10; W = Width @ Mouth; W-1 = Width @ Throat

[illegible]