


PERSONNEL TITLE PERSONNEL TITLE COUNTY Fulton DATE 8-6-97
 PERSONNEL TITLE PERSONNEL TITLE S.R. U.S. 20 WEATHER SUNNY
Van Dusen Huss Judson SEC 52K: 6.6785 TEMP. + 24° C
 JCM: 4.15

DESCRIPTION PAVEMENT INFORMATION JOB NO. _____
 LEFT RIGHT CENTER LINE

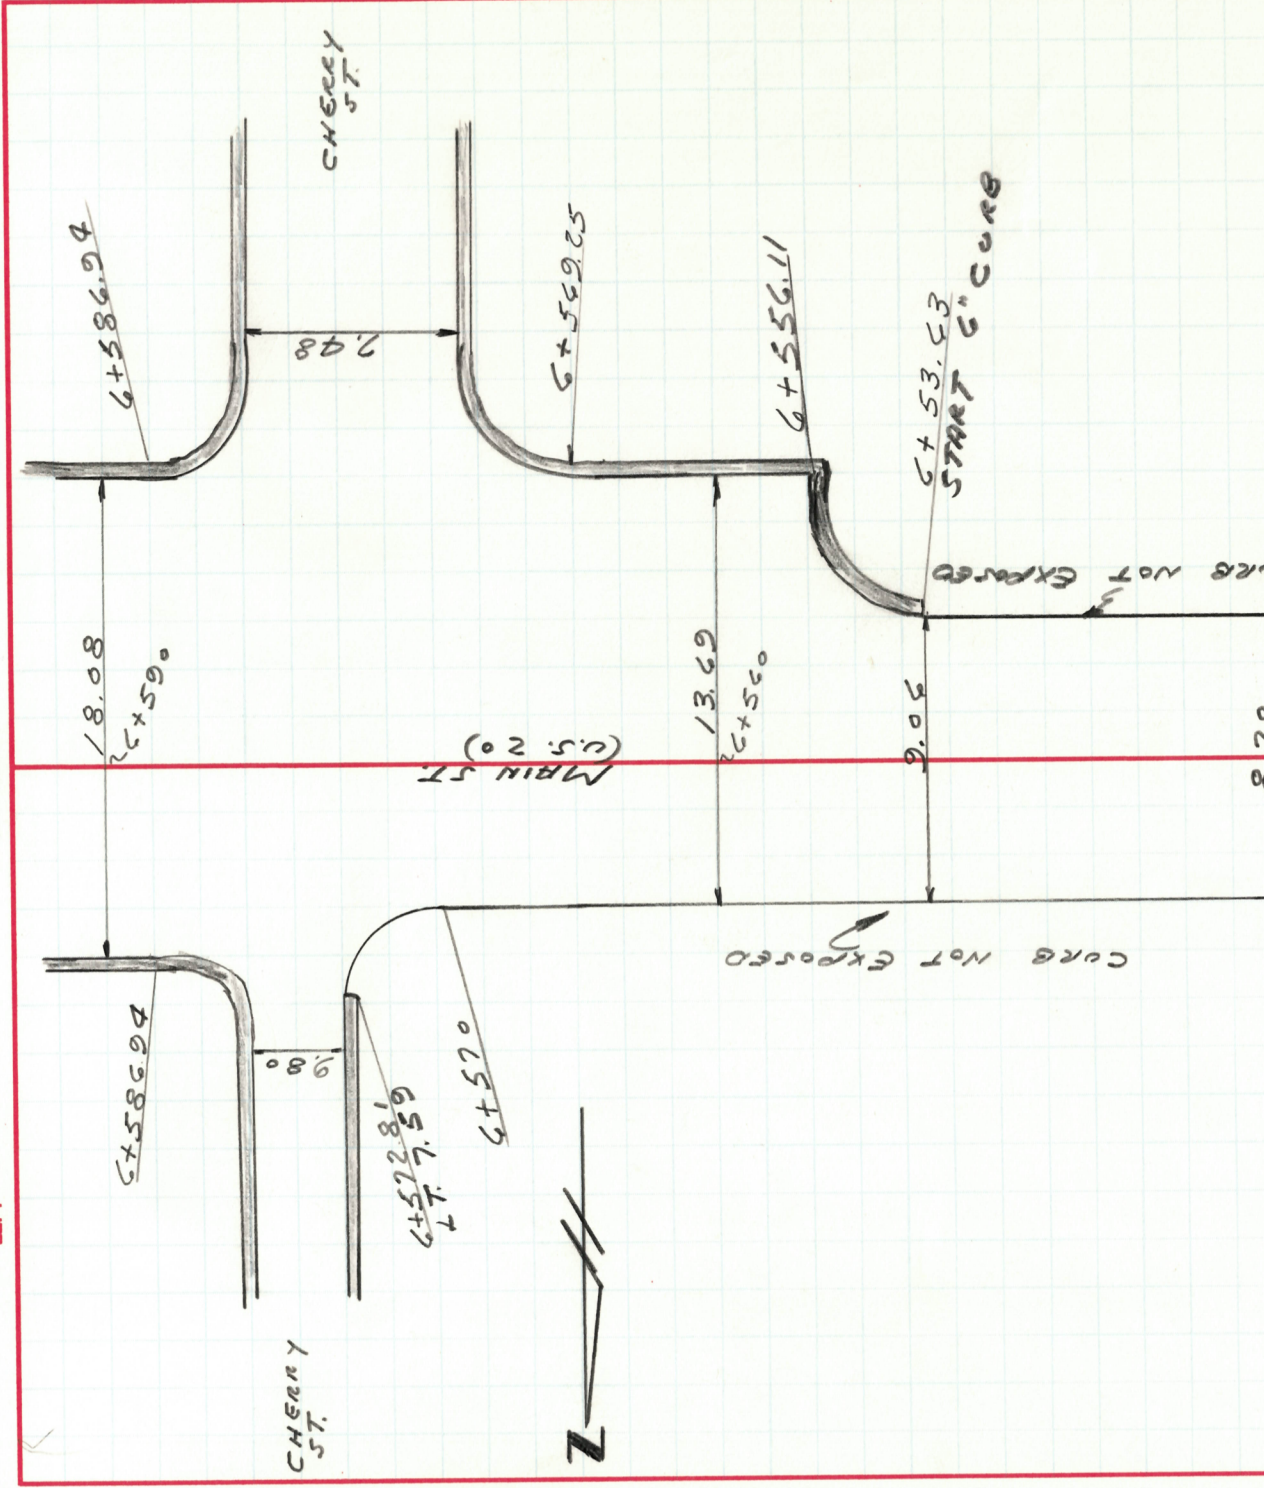

PERSONNEL TITLE PERSONNEL TITLE COUNTY Fulton DATE 8-6-27
 VAN DUSEN Huss U.S. 20 WEATHER SUNNY
Judson 5.0m = 4.15 TEMP. +24°C
SEC. 5.6785

DESCRIPTION PAVEMENT INFORMATION JOB NO. _____
 LEFT CENTER LINE RIGHT



194SWH

OHIO DEPARTMENT OF TRANSPORTATION


SHEET NO. 3 of 16

PERSONNEL	TITLE	PERSONNEL	TITLE	COUNTY	DATE	WEATHER
VAN DUSEN				Fulton	8-6-97	SUNNY
HUSS						
JORDSON						

S.R. 0.5.20
SUM=9.15
SECK=6.6785

TEMP. +29°C

DESCRIPTION PAVEMENT INFORMATION IN FORMATION CENTER LINE LEFT RIGHT JOB NO.

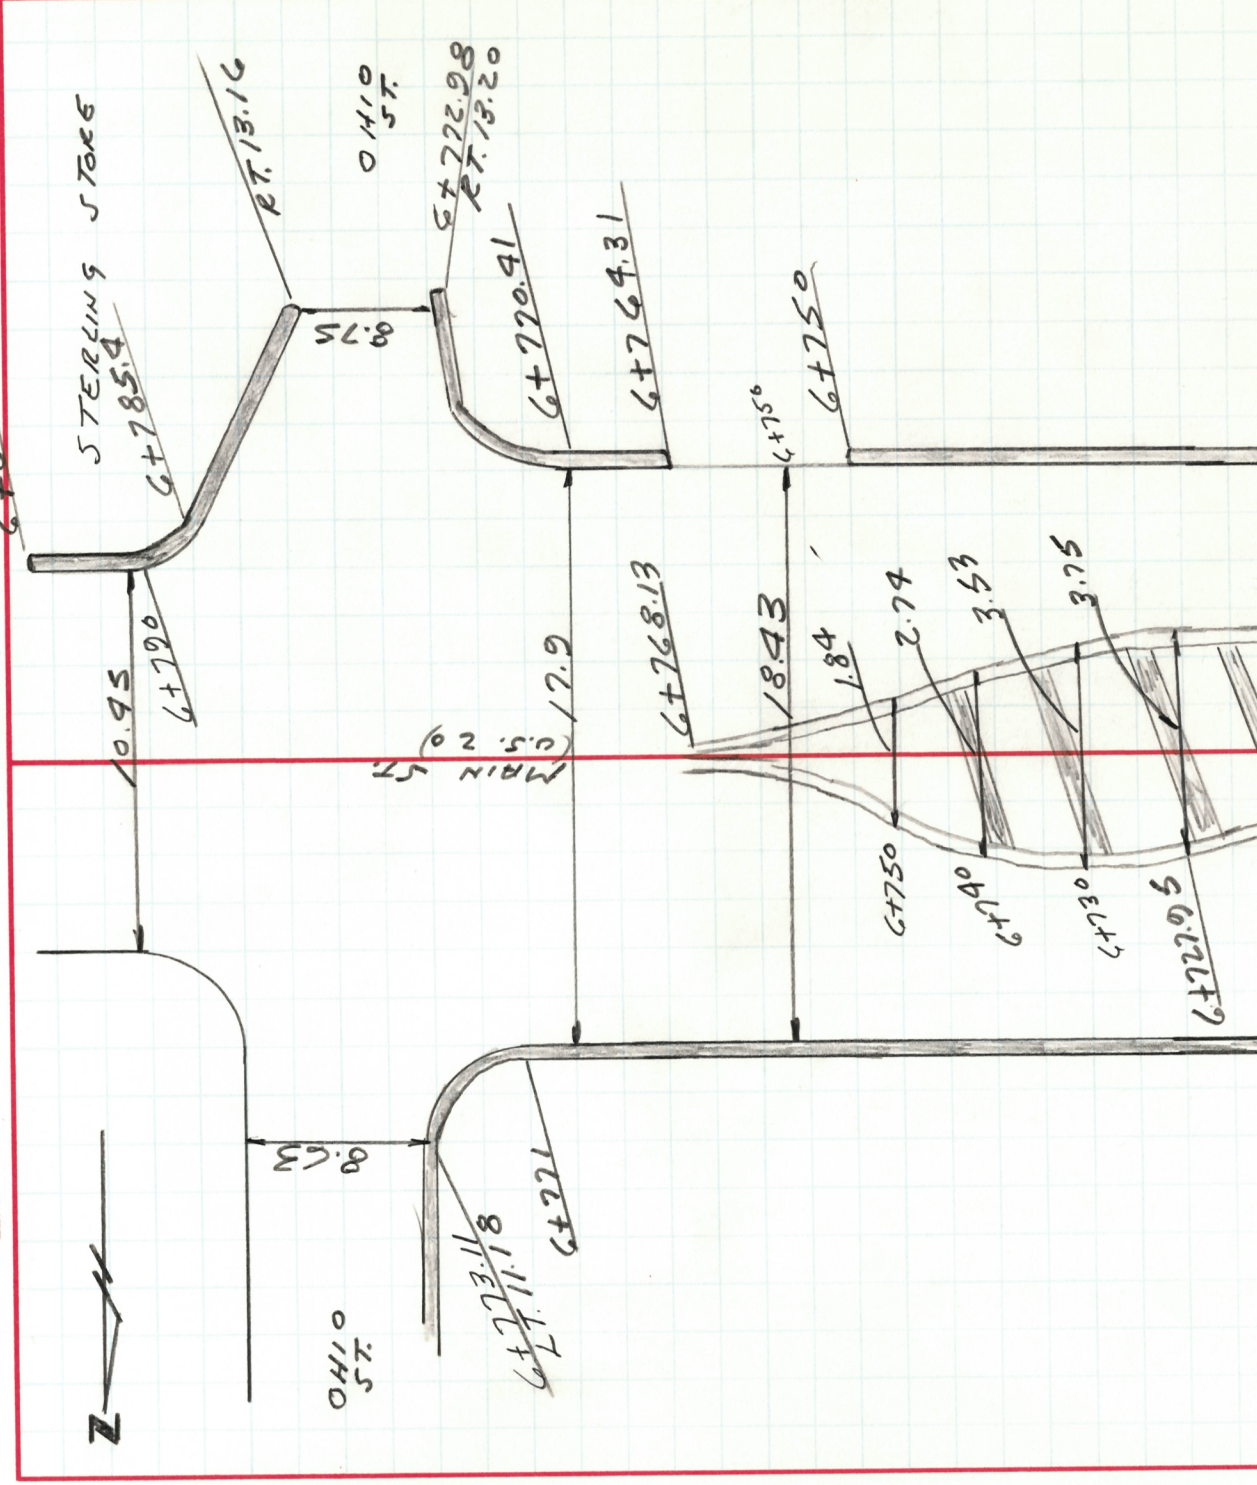

194SWH

OHIO DEPARTMENT OF TRANSPORTATION

SHEET NO. 4 of 16

PERSONNEL TITLE

PERSONNEL

COUNTY Eucation

DATE 8-6-97

VAN DUSEN

HUSS

JURSON

S.R. 45.20

WEATHER SUNNY

SCM: 9.15

TEMP: 24°C

SEQ. 568: 6.6785


DESCRIPTION PAVEMENT INFORMATION

JOB NO.

LEFT

CENTER LINE

RIGHT

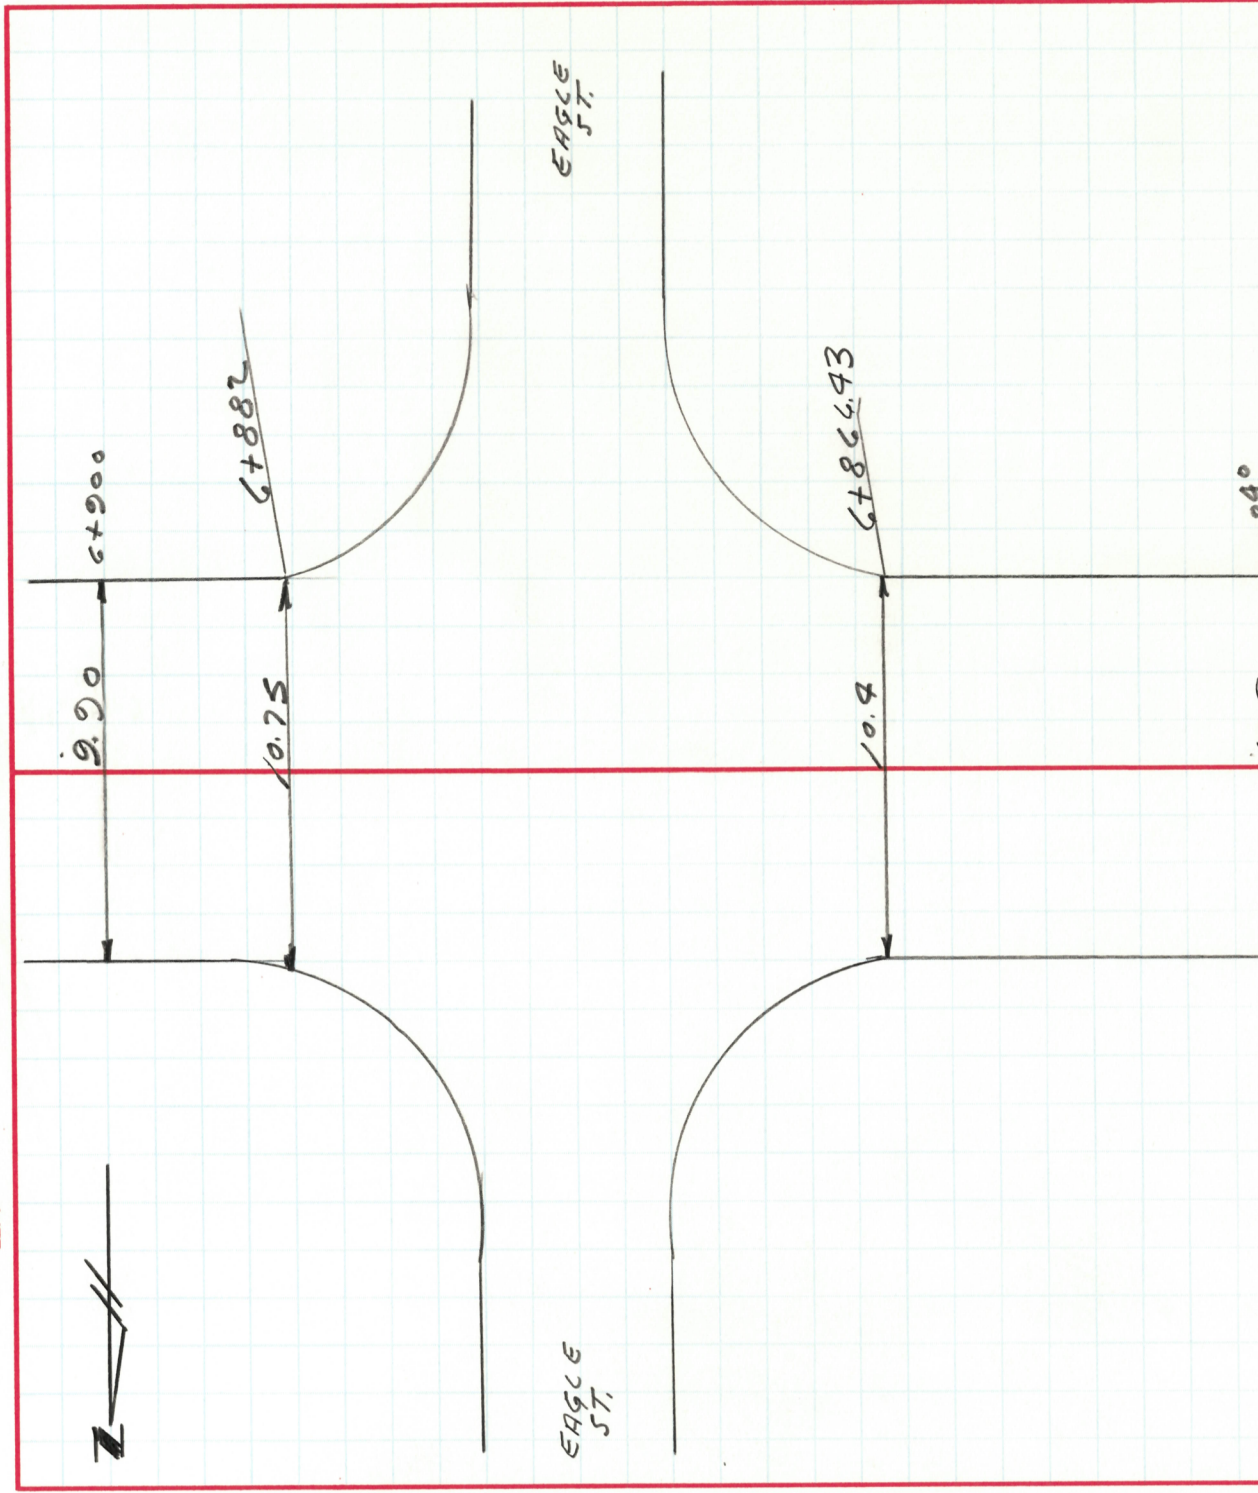


PERSONNEL	TITLE	PERSONNEL	TITLE	COUNTY	DATE	WEATHER	TEMP.
VAN DUSEN				FULTON	8-6-27	SUNNY	29° C
HUSS							
JEDSON							

DESCRIPTION PAVEMENT INFORMATION SEC 56m-9.15 S&K 6.6785 JOB NO.

CENTER LINE

LEFT

RIGHT

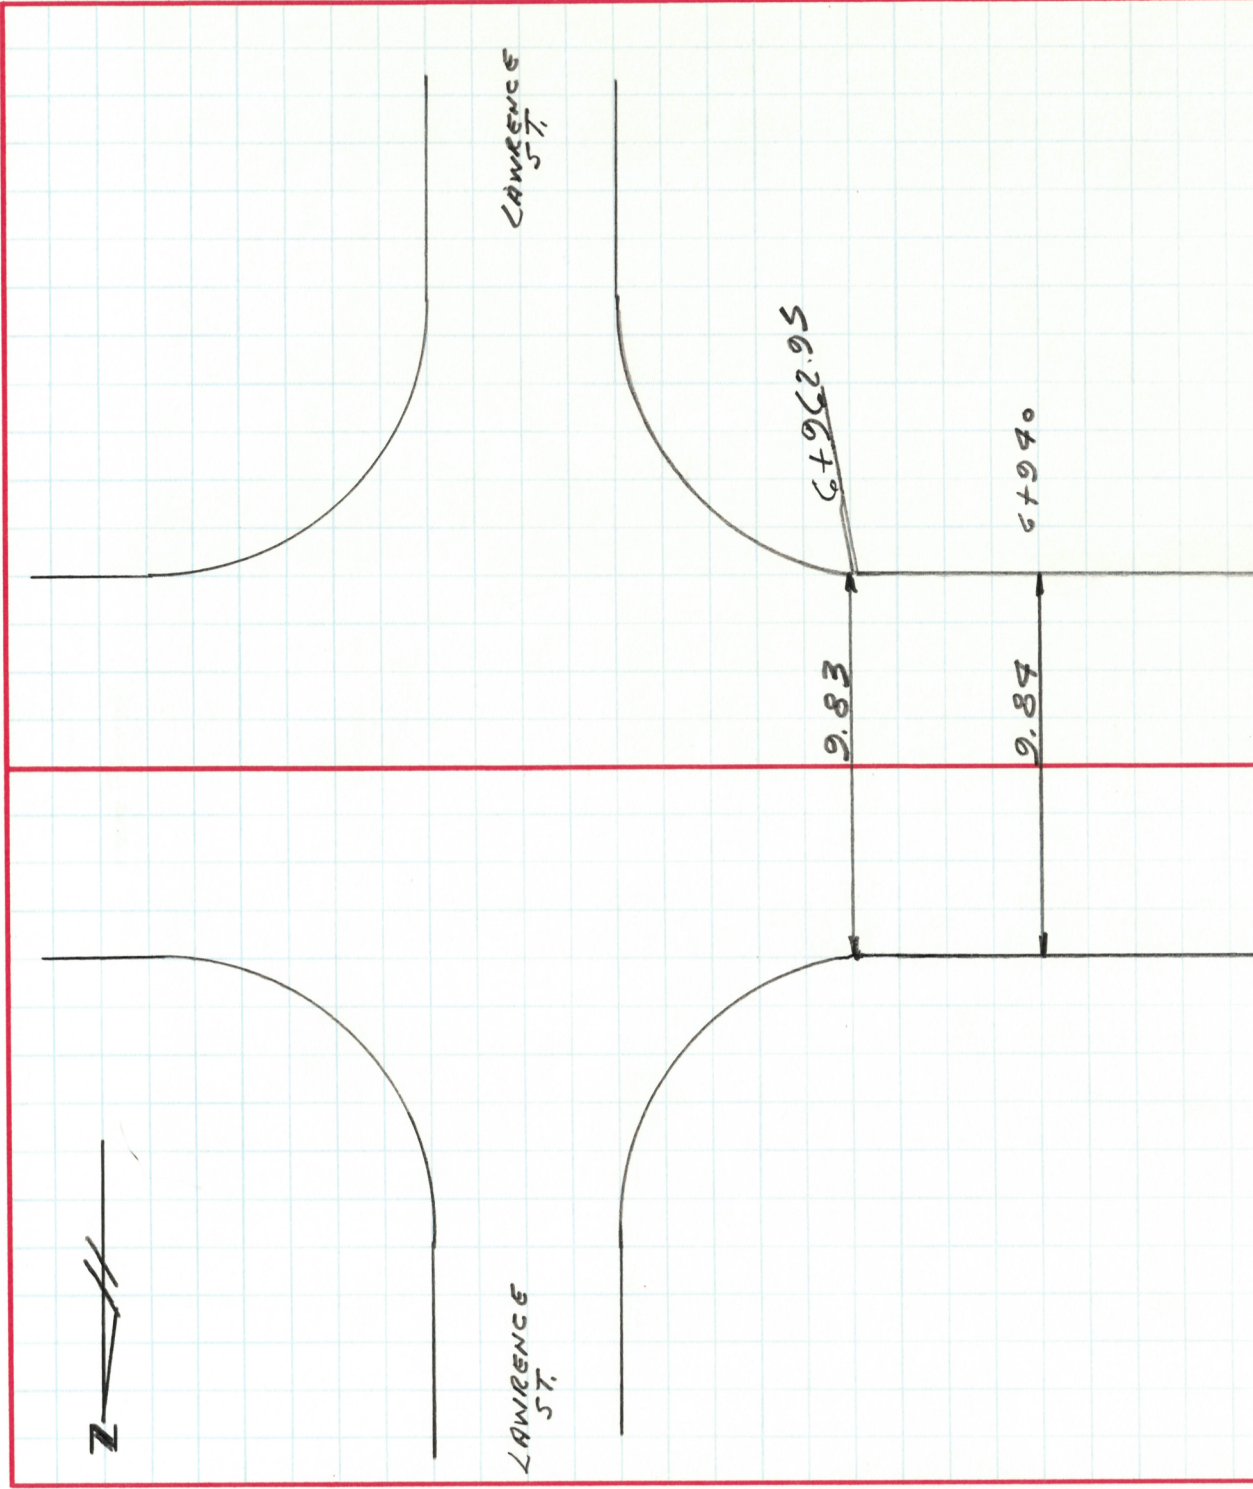

TWO-LANE RESURFACING PROGRAM
DEFECTIVE PAVEMENT AREAS

COUNTY Fulton ROUTE 20 SECTION 6.566

[illegible]

DATE 0-6-11

1994 TWO-LANE RESURFACING PROGRAM

SHEET 7 OF 7

✓

NOTE: LOCATE ALL
CHANGES IN PVMT WIDTH

PAVEMENT DATA

COUNTY	ROUTE	SECTION
<u>Fulton</u>	<u>20</u>	<u>6.566</u>

[illegible]

DATE 8-6-97TWO-LANE RESURFACING PROGRAM
CROSSWALKS AND STOP BARSSHEET 8 OF 16COUNTY Fulton ROUTE 20 SECTION 6.566

STATION AT LEADING EDGE	CROSS WALK	STOP BAR	WIDTH OUT/OUT	LENGTH	CROSS HATCHING SIZE/SPACING	A = ACROSS ROUTE P = PARALLEL TO ROUTE
6+476.4 RT	X		2.15 ^M	8.16 ^M		P
6+476.4 LT	X		2.15 ^M	8.16 ^M		P
6+481		X	.61 ^M	2.53 ^M		P
6+569.7	X		2.51 ^M	14.73 ^M		A
6+572.26 RT	X		2.2 ^M	11.70 ^M		P
6+573.26 LT	X		2.64 ^M	16.80 ^M		P
6+573.26 LT		X	.61 ^M	4.81 ^M		P
6+578.31 RT		X	.61 ^M	2.95 ^M		P
6+584.13	X		2.5 ^M	18.51 ^M		A
6+664.5		X	.61 ^M	9.0 ^M		A
6+666.4	X		2.44 ^M	18.7 ^M		A
6+669 RT	X		2.56 ^M	17.6 ^M		P
6+669 LT	X		2.40 ^M	17.09 ^M		P
6+670 LT		X	.61 ^M	8.36 ^M		P
6+678.04 RT		X	.61 ^M	7.09 ^M		P
6+687.8	X		2.50	18.56 ^M		A
6+690.5		X	.61 ^M	10.83 ^M		A
6+745.5		X	.61 ^M	8.28 ^M		A Five Sta.
6+769	X		2.45 ^M	17.70 ^M		A
6+772 RT	X		2.03 ^M	11.06 ^M		P

DATE 8-6-97

SHEET 9 OF 16

SECTION 6.566

[illegible]

DATE 8-6-97

TWO-LANE RESURFACING PROGRAM

SHEET 10 OF 16

UTILITIES (CATCH BASIN, MANHOLE, INLET, WATER VALVE, BOX AND MONUMENT BOX)

COUNTY Fulton ROUTE 20 SECTION 6.566

R = RAISE F = FEATHER

STATION	OUT (FT) RT/LT OF C	CATCH BASIN	MAN- HOLE	INLET	W V BOX	MON BOX	CASTING		REMARKS fe: RECONSTRUCT, NO WORK
							R	F	
6+476.4	5.04 ^M RT	X							
6+476.4	5.49 ^M LT	X							
6+482.34	11.89 ^M RT				X				
6+572.05	6.84 RT	X							
6+573.16	9.11 RT	X							
6+665.8	9.46 RT			X					
6+665.8	8.84 LT			X					
6+671.3	15.16 LT				X				
6+706.55	5.29 LT				X				
6+721.26	5.29 LT				X				
6+685.4	5.40 LT				X				
6+744.5	9.56 RT			X					
6+769	8.70 LT			X					
6+772	9.33 ^M RT	X							
6+865 LT	4.81 ^M LT			X					
6+865.5	4.90 ^M RT			X					
6+870	6.0 ^M LT		X						
6+870	11.5 ^M LT			X					
6+880	4.5 ^M RT		X						
6+880	4.39 ^M RT		X						

7-9-67

TWO-LANE RESURFACING PROGRAM INTERSECTIONS

SHEET 11 OF 16

10

COUNTY Fulton ROUTE 20 SECTION 6.566

6.566

L - PROP PAVT DEPTH (IN.) X 10; W - WIDTH @ MOUTH; W-I - WIDTH @ THROAT

9.14

[illegible]

*TWO-LANE RESURFACING PROGRAM
CENTERLINE PAVEMENT MARKINGS
INSIDE CITY LIMITS ONLY*

COUNTY Fulton ROUTE 70 SECTION 6.566

[illegible]

State of Ohio Department of Transportation
Field Notes

SHEET NO. 15 of 16

PERSONNEL <u>VanDusen</u>	TITLE <u>Inst., tape</u>	PERSONNEL	TITLE	COUNTY <u>Fulton</u>	DATE
<u>Huss</u>	<u>Notes</u>			<u>S. R.</u>	<u>WEATHER</u> <u>Clear-Sunny</u>
<u>Judson</u>	<u>Rod</u>			<u>SEC.</u>	<u>TEMP.</u> <u>+ 68° F</u>

DESCRIPTION Rav. " " Sections (Fayette Rutting) JOB NO. 025723-6112-2C

Sta	CENTER LINE				RIGHT			
	BS	HI	FS	ELEV				
(Lt Lane Rutting)								
<u>6+690</u>	<u>1.51</u>	<u>1.51</u>	<u>1.48</u>	<u>1.51</u>	<u>1.54</u>	<u>1.59</u>	<u>1.60</u>	<u>Rt</u> <u>Gut.</u> <u>1.82</u>
	<u>12.8</u>	<u>12.2</u>	<u>11.7</u>	<u>7.6</u>	<u>6.7</u>	<u>5.0</u>	<u>4.2</u>	<u>Tot.</u> <u>1.76</u>
	<u>1.53</u>	<u>1.57</u>	<u>1.56</u>	<u>1.75</u>	<u>1.68</u>			
	<u>13.2</u>	<u>14.0</u>	<u>14.5</u>	<u>18.2</u>				
(Lt. Lane Rutting)								
<u>6+720</u>	<u>1.50</u>	<u>1.48</u>	<u>1.50</u>	<u>1.45</u>	<u>1.50</u>	<u>1.54</u>	<u>1.55</u>	<u>Rt</u> <u>Gut.</u> <u>1.81</u>
	<u>12.9</u>	<u>12.3</u>	<u>11.7</u>	<u>9.3</u>	<u>6.8</u>	<u>5.1</u>	<u>4.4</u>	<u>Tot.</u> <u>1.69</u>
	<u>1.53</u>	<u>1.52</u>	<u>1.53</u>	<u>1.77</u>				
	<u>13.5</u>	<u>14.2</u>	<u>14.5</u>	<u>18.2</u>				
(Normal Pav.)								
					<u>Lt</u> <u>EOP</u>	<u>Q</u>	<u>Q</u>	<u>Rt</u> <u>Gut.</u> <u>1.76</u>
						<u>1.48</u>		<u>Tot.</u> <u>1.61</u>

State of Ohio Department of Transportation
Field Notes

PERSONNEL Van Dusen TITLE Inst. & Tape PERSONNEL _____ TITLE _____
Huss Notes _____
Judson Red _____

SHEET NO. 16 of 16
 DATE 08-07-97
 COUNTY Fulton
 S. R. 20 WEATHER (Clear - Sunny)
 SEC. 6,566 TEMP. +68°F

JOB NO. 025763-6112-26

Pay. " " Sections (Fayette Rutting)

DESCRIPTION

Sta	CENTER LINE				RIGHT			
	BS	HI	FS	ELEV				
(Normal Pav.)								
<u>6+400</u>			<u>1.71</u>	<u>1.78</u>	<u>4</u>	<u>1.56</u>	<u>1.92</u>	<u>1.0</u>
			<u>11.0</u>	<u>10.3</u>				