


PERSONNEL	TITLE	PERSONNEL	TITLE
Red Beach			
W. Knappe			


COUNTY Fulton DATE 5 Sept 74
 S. R. Garham Twp. Rds "S" & "27" WEATHER _____
 SEC. 13/24 T-9-S R-1-W TEMP. _____
 DESCRIPTION CONTROL POINTS JOB NO. _____

(A)

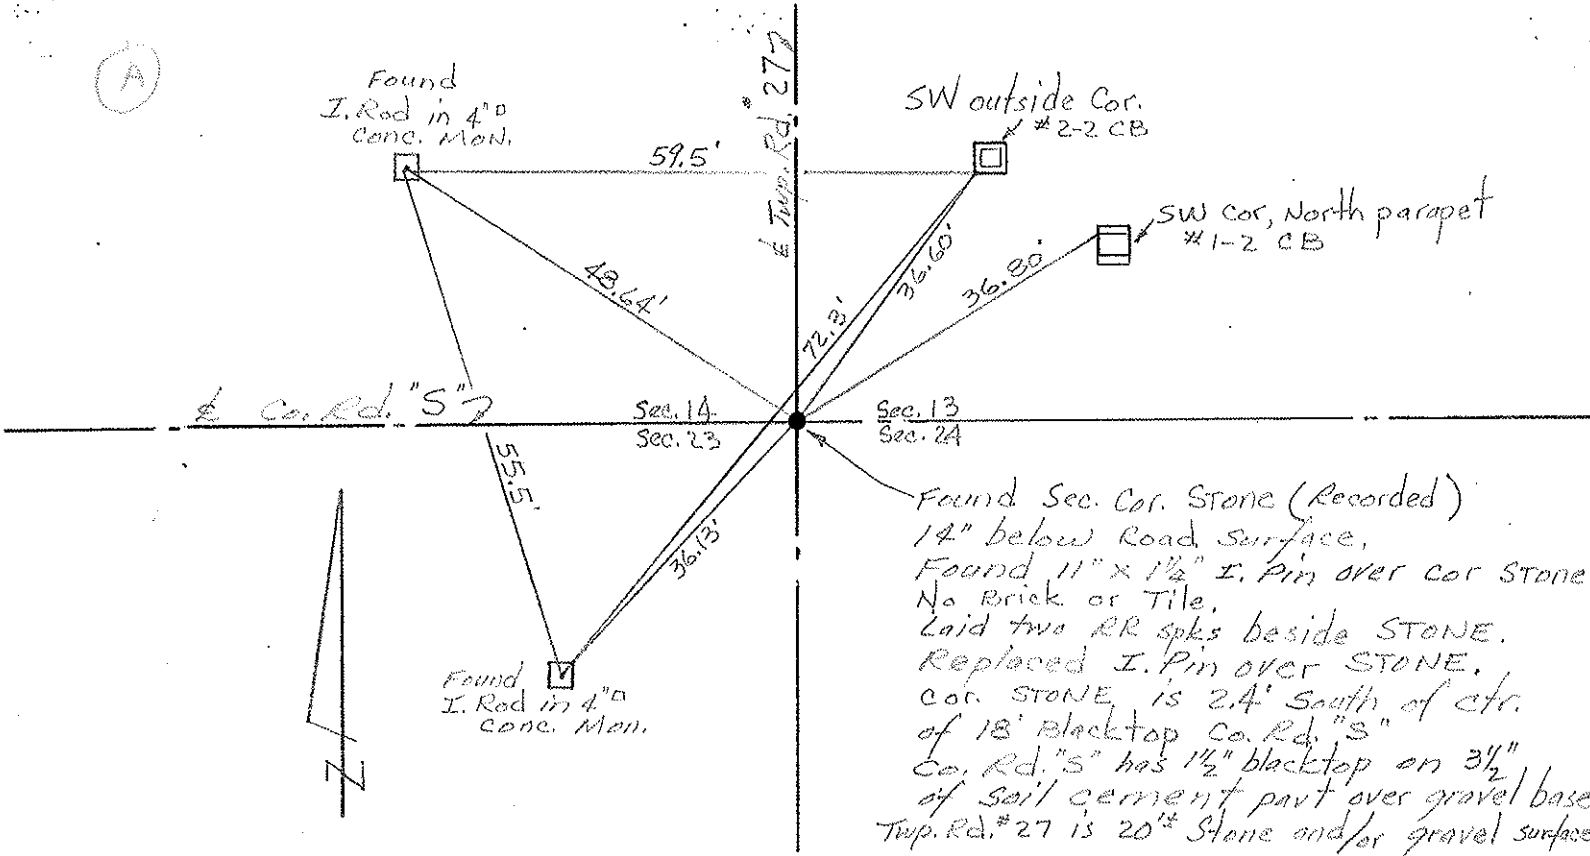

Found Sec. Cor. Stone (Recorded)
 14" below Road surface,
 Found 11" x 1 1/2" I. Pin over cor Stone
 No Brick or Tile.
 Laid two RR spks beside STONE.
 Replaced I. Pin over STONE.
 Cor. STONE is 2.4' South of ctr.
 of 18' Blacktop Co. Rd. "S"
 Co. Rd. "S" has 1 1/2" blacktop on 3 1/2"
 of soil cement part over gravel base.
 Twp. Rd. #27 is 20" Stone and/or gravel surface.

(B)

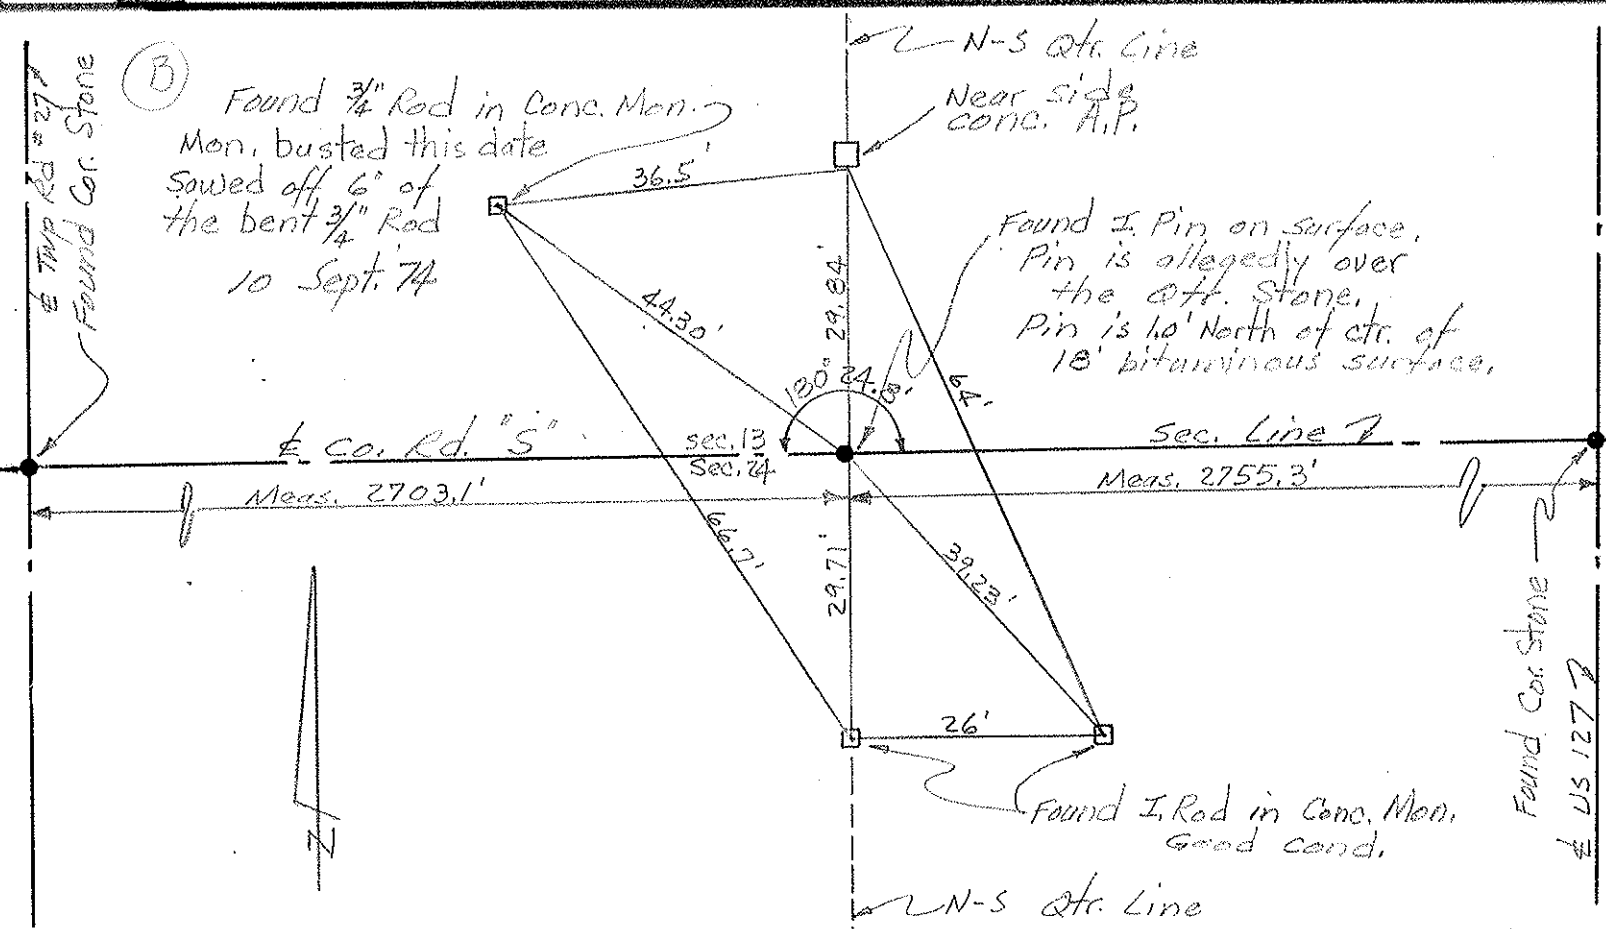

Found 3/4" Rod in Conc. Mon.
 Mon. busted this date
 Sawed off 6" of
 the bent 3/4" Rod
 10 Sept. 74

Found I. Pin on surface.
 Pin is allegedly over
 the off. Stone.
 Pin is 10' North of ctr. of
 18' bituminous surface.

Found Cor. Stone
 US 127