


PERSONNEL	TITLE	PERSONNEL	TITLE
Red Beach			
W. Knape			

COUNTY FULTON DATE JUNE 74
 S. R. TWP. Rd. "R" WEATHER _____
 SEC. Garham R-1-E TEMP. _____

DESCRIPTION SECTION LINE MEASUREMENTS JOB NO. _____

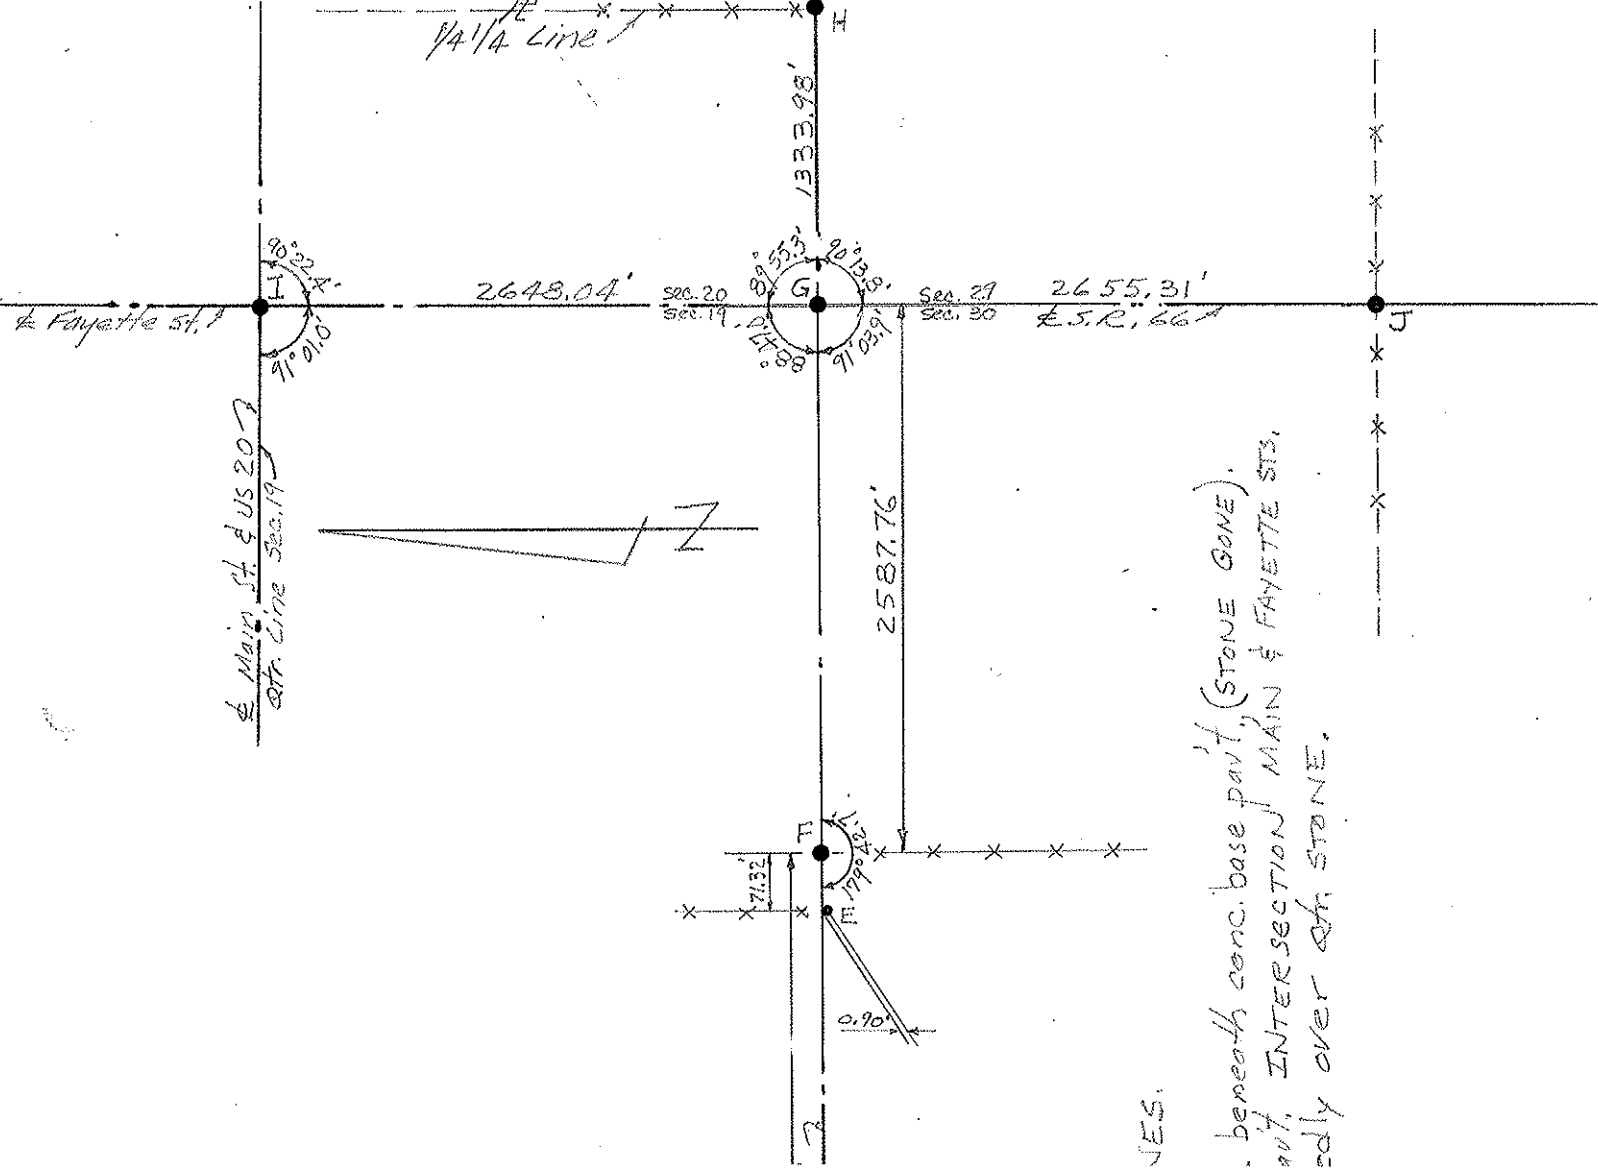

YES.