

O.D.O.T. DISTRICT 2 SURVEY OFFICE (USE ONLY)

PERSONNEL \_\_\_\_\_ REFERENCE NO. 4 SHEET 4 OF 38  
 NOTES LEU DATE 4/12/17 ROUTE US 20  
 H.C. HOMAN WEATHER SUNNY COUNTY FULTON  
 R.C. LEU TEMP. 42°F TOWNSHIP GORHAM  
 \_\_\_\_\_ SECTION 24  
 \_\_\_\_\_ T 9 S R 1 W

TYPE MONUMENT 1" IPIPE


~~ON SURFACE~~ - BELOW 3"

~~LEFT~~ - Q PAV'T - RIGHT 1.4'


10.9 TO LT EDGE PAVEMENT

S.L.M. 79+30

Grid: Northing: 733969.141 Easting: 1457552.043

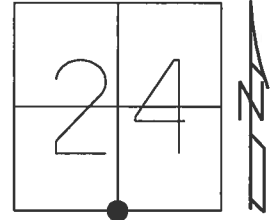

RECORD:  
 1/2" I. PIPE  
 4" DEEP  
 7-24-91  
 FD PK/WASHER  
 5-16-02, MB  
 FD 1" I PIPE  
 4-12-2017, DCH  
 SET MAG/WASHER  
 08-11-2017, DCH

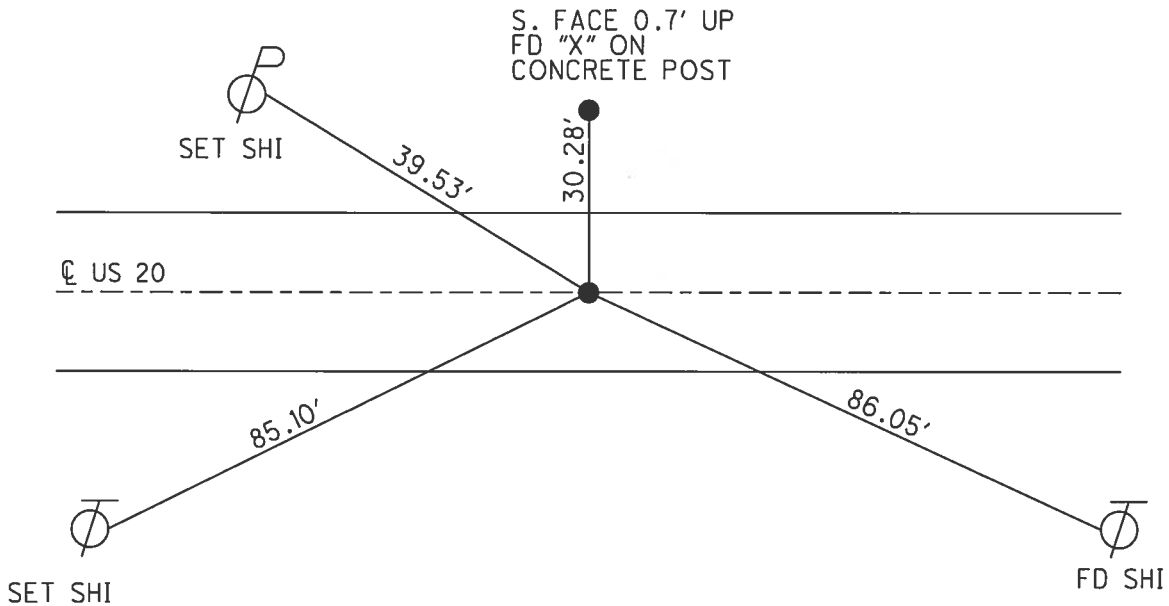

# O.D.O.T. DISTRICT 2 SURVEY OFFICE

PERSONNEL

REFERENCE NO. 4

SHEET 1 OF 13

NOTES M. Canterbury

H.C. M. Barwick

R.C. K. Moser

DATE 5-16-92

WEATHER overcast

TEMP. 72°

ROUTE US 20

COUNTY FULTON

TOWNSHIP GORHAM

SECTION 24

T. 9 S. R 1. W


TYPE MONUMENT P.R. w/ washer

ON SURFACE - BELOW yes


LEFT - & PART - RIGHT 1.4

10.9 TO LT. EDGE PAVEMENT

S.L.M. 79+30

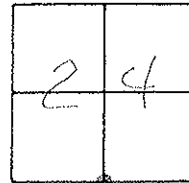

Records;  
 1/2" I.P. Pipe  
 4" Loop  
 7-24-91

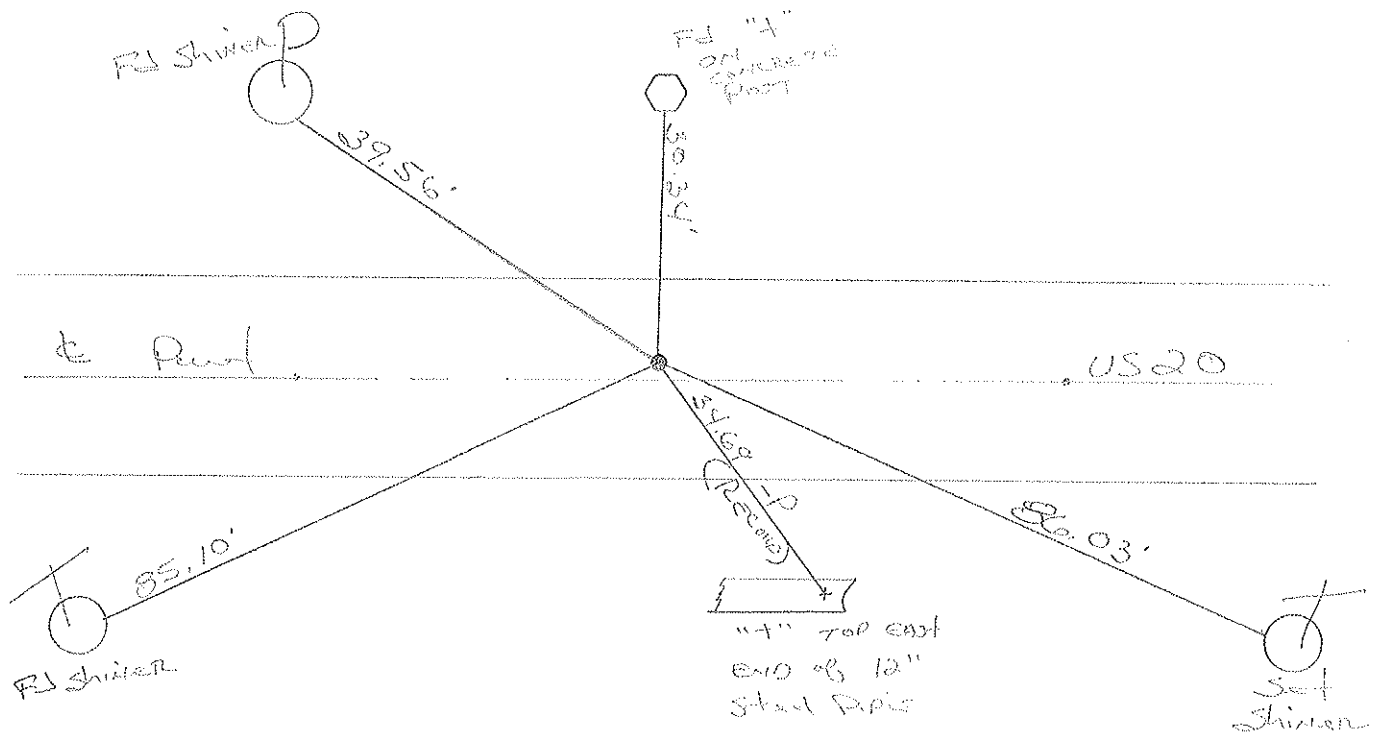

Resurfaced 2002

O.D.O.T. DISTRICT 2 SURVEY OFFICE

PERSONNEL

REFERENCE NO. 4

SHEET 1 OF     

NOTES 1. Stone

H.C. D. Curtis

R.C. C. Lochrke

DATE 24 July 91

WEATHER Warm

TEMP. 82°

ROUTE US #20

COUNTY Fulton

TOWNSHIP Gorham

SECTION 24

T      R     

TYPE MONUMENT 1/2" I. pipe



ON SURFACE - BELOW 4" deep

LEFT - & PAW'T. - RIGHT 1' Rt & Pot.

TO      EDGE PAVEMENT

S.L.M. 81+79

Set P.K. / WASHER  
3-26-92

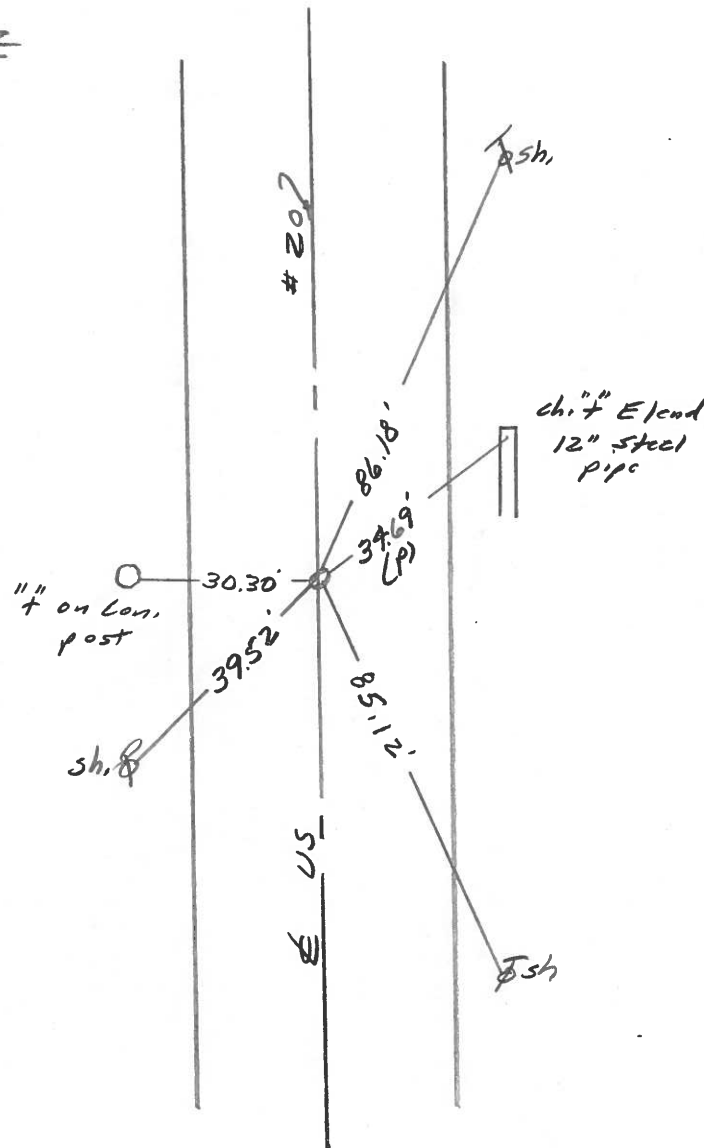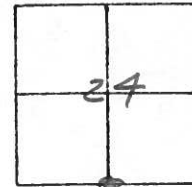

County Fulton S.R. US #20

Township Gorham

Section 24


T, N, R, E

Personnel I. Stone  
P. Nousev  
R. Michalak  
D. Curtis


Date 17 May 82

Weather Warm

Temp. 77°

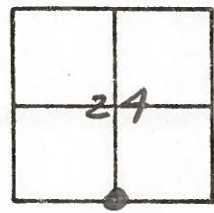

REF. No. 4

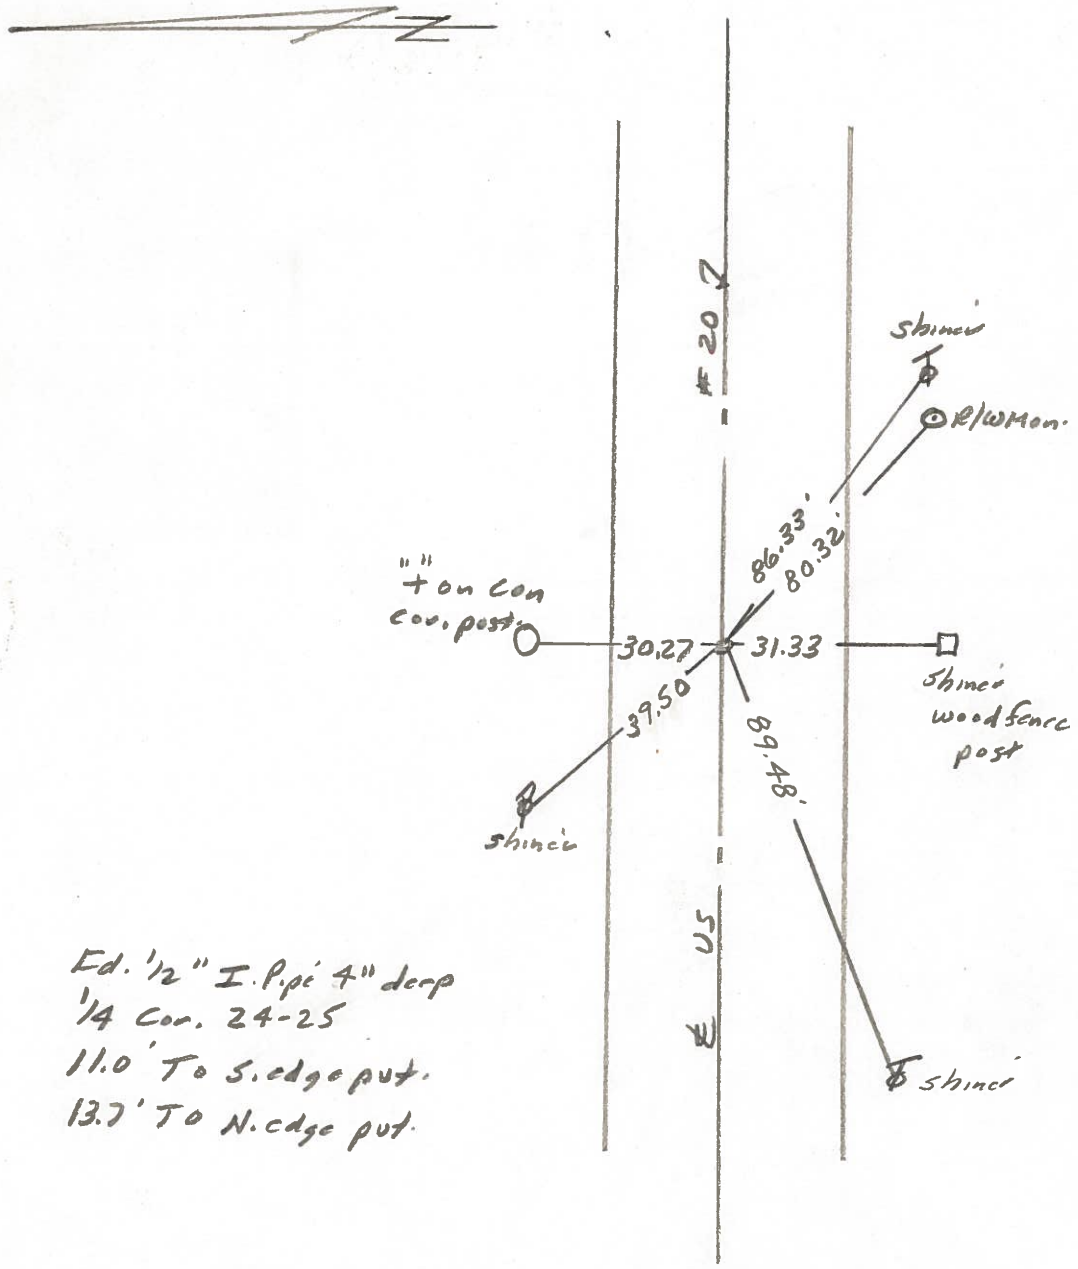


Ed. 1/2" I. Pipe 4" deep  
 1/4 Cor. 24-25  
 11.0' To S. edge put.  
 13.7' To N. edge put.

PERSONNEL	TITLE	PERSONNEL	TITLE	COUNTY	DATE
Red Beach				Fulton	10 June 74
W. Knape				US 20	
				R-1-W Gorham Twp.	

DESCRIPTION CONTROL POINTS JOB NO. \_\_\_\_\_

3

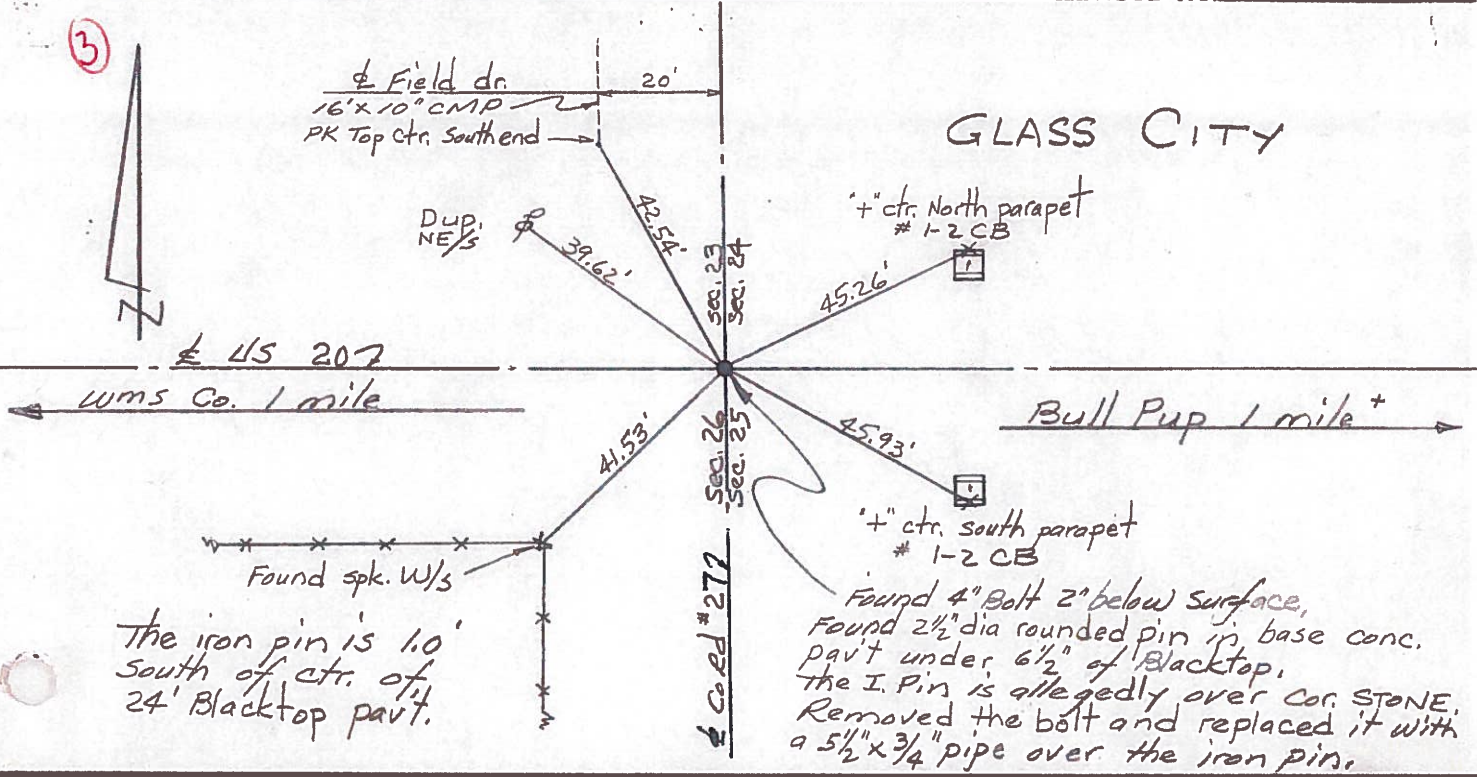

4

