


O.D.O.T. DISTRICT 2 SURVEY OFFICE (USE ONLY)


PERSONNEL \_\_\_\_\_ REFERENCE NO. 5 SHEET 5 OF 38  
 NOTES LEU DATE 4/12/17 ROUTE US 20  
 H.C. HOMAN WEATHER PARTLY CLOUDY COUNTY FULTON  
 R.C. LEU TEMP. 42°F TOWNSHIP GORHAM  
 \_\_\_\_\_ SECTION 24  
 \_\_\_\_\_ T 9 S R 1 W

TYPE MONUMENT P.K./WASHER  
 ON SURFACE - ~~BELOW~~ ON  
 LEFT - ☉ PAV'T - RIGHT ON  
12.4 TO RT EDGE PAVEMENT  
 S.L.M. 92+87

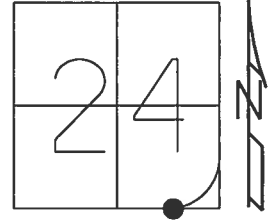

Grid: Northing: 733959.779 Easting: 1458917.224

RECORD:  
 1" I. PIPE  
 4" DEEP  
 7-24-91  
 FD P.K./WASHER  
 5-16-02, MB  
 SET P.K./WASHER  
 6-6-02, MB  
 FD P.K./WASHER  
 REF5  
 4-12-2017, DCH  
 SET MAG/WASHER  
 08-11-2017, DCH

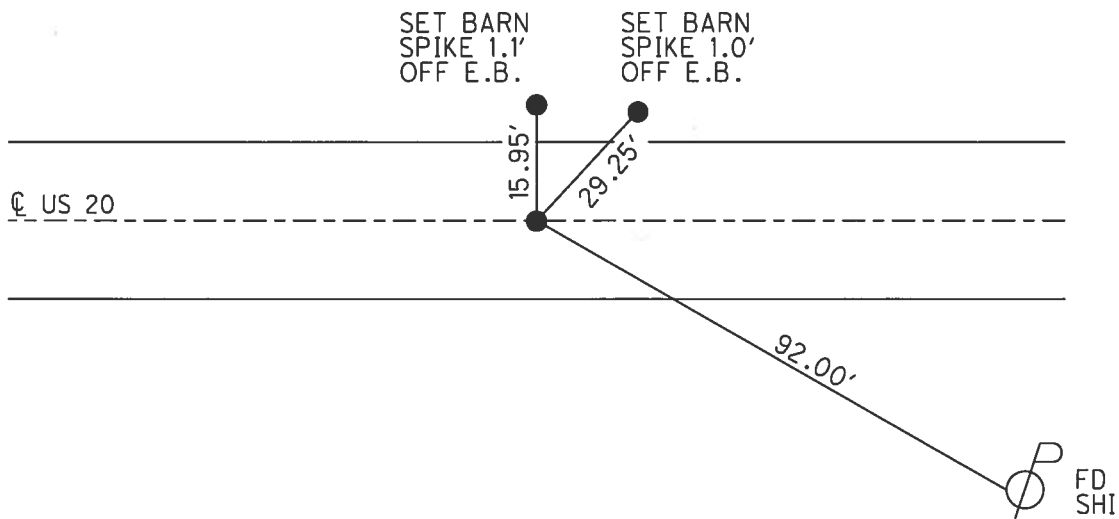

# O.D.O.T. DISTRICT 2 SURVEY OFFICE

PERSONNEL

REFERENCE NO. 5

SHEET 2 OF 13

NOTES M. Canterbury

H.C. M. Barnitzel

R.C. K. Moser

DATE 5/16/02

WEATHER overcast

TEMP. 72°

ROUTE US20

COUNTY Fulton

TOWNSHIP Gordons

SECTION 24

T 5 R 1 W

TYPE MONUMENT PK. w/ washer

ON SURFACE - BELOW yes

LEFT - 0 PAV'T. - RIGHT 0.2


124 TO 117 EDGE PAVEMENT

S.L.M. 92 + 87



Records:  
1" I.Pipe  
4" diam  
7.24.91

Reset PK/washer  
6-6-02 MB

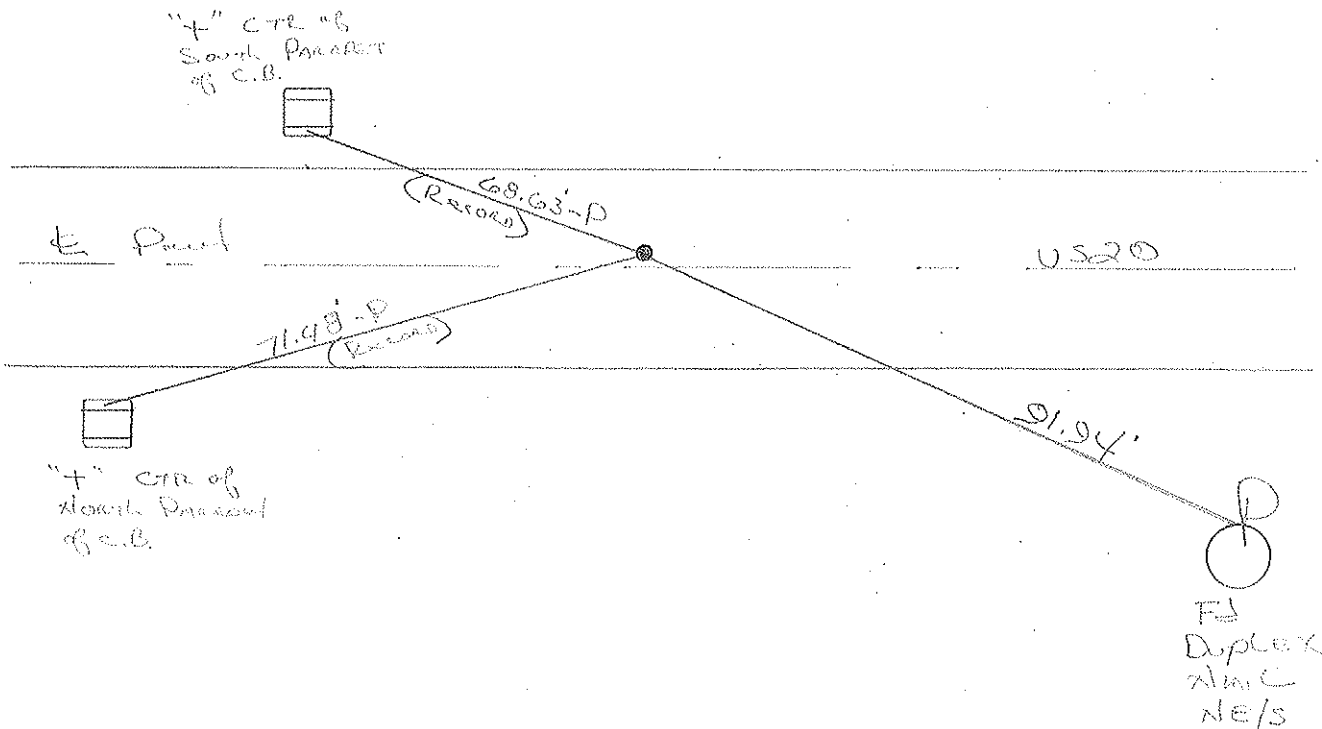

O.D.O.T. DISTRICT 2 SURVEY OFFICE

PERSONNEL \_\_\_\_\_

REFERENCE NO. 5

SHEET 2 OF \_\_\_\_\_

NOTES 1. Stone

H.C. D. Curtis

R.C. C. Lochrke

DATE 24 July 91

WEATHER Warm

TEMP. 82°

ROUTE US#20

COUNTY Fulton

TOWNSHIP Garham

SECTION 24

T. \_\_\_\_\_ R. \_\_\_\_\_

TYPE MONUMENT 1" I. Pipe Set P.K./WASHER



ON SURFACE - BELOW 4" deep

3-26-92

LEFT- & PAV'T. - RIGHT ctr.

TO \_\_\_\_\_ EDGE PAVEMENT

S.L.M. 95+44

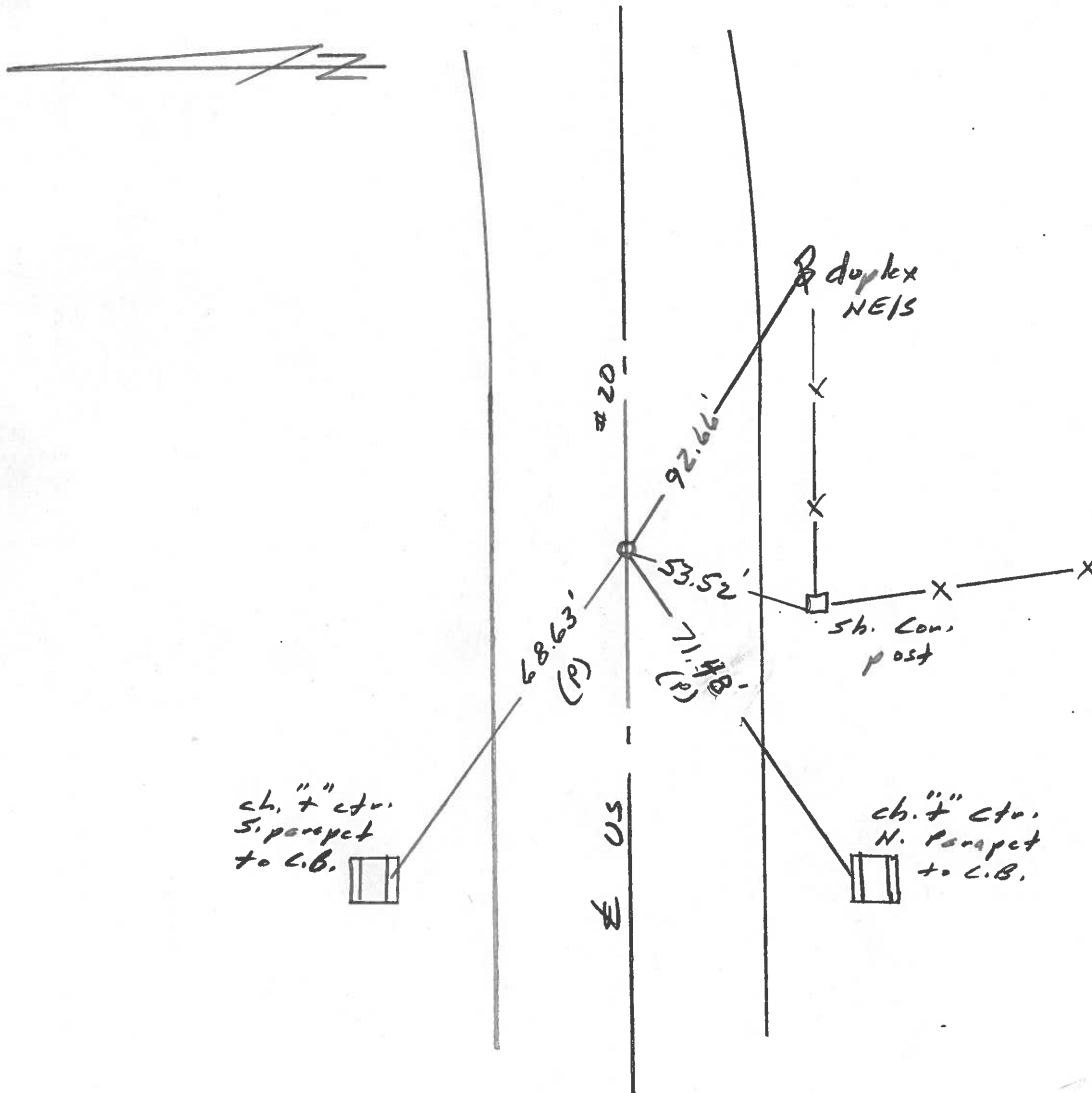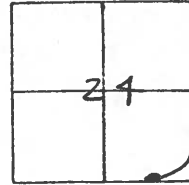

County Fulton S.R. US#20

Date 17 May 82

Township Gorham

Weather Warm

Section 24

Temp. 78°


T, N, R, E

Personnel I. Stone

P. Newser

R. Michaelok


D. Curtis

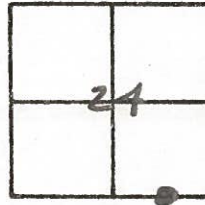

REF. No. 5



Ed. 1" E Pipe 4" deep  
T. S. TO CURVE  
S.L.M. Sta. 97+19  
12.2 to N. edge put.  
12.3 to S. edge put.

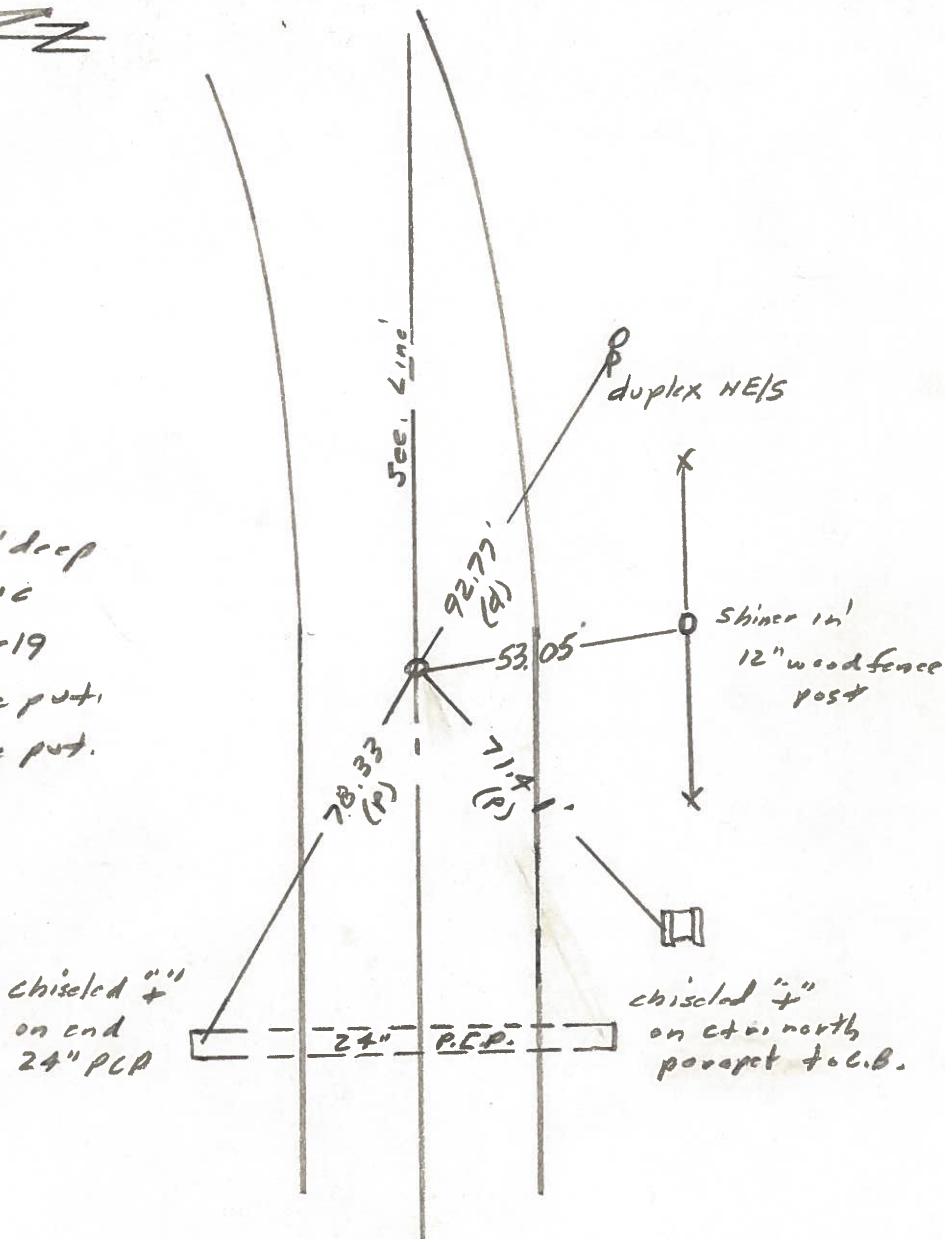

PERSONNEL TITLE PERSONNEL TITLE

Red Beach

COUNTY Fulton

DATE 4 Sept. 1974

W. Knappe

S. R. US 20

WEATHER \_\_\_\_\_

SEC. \_\_\_\_\_

TEMP \_\_\_\_\_

DESCRIPTION

CONTROL POINTS

JOB NO. \_\_\_\_\_

