


O.D.O.T. DISTRICT 2 SURVEY OFFICE (USE ONLY)


PERSONNEL \_\_\_\_\_ REFERENCE NO. 14 SHEET 23 OF 38  
 NOTES LEU DATE 4/17/17 ROUTE US 20  
 H.C. HOMAN WEATHER SUNNY COUNTY FULTON  
 R.C. LEU TEMP. 70°F TOWNSHIP GORHAM  
 SECTION 21  
 T 9 S R 1 E

TYPE MONUMENT SM.R.R.SPIKE  
 ON SURFACE - ~~BELOW~~ ON \_\_\_\_\_  
 LEFT - ℄ PAV'T - ~~RIGHT~~ 1.5'  
 - TO - EDGE PAVEMENT  
 S.L.M. 327+79

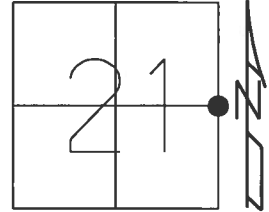

Grid: Northing: 736481.843 Easting: 1479951.107

RECORD:  
 FD R.R.SPIKE  
 6-18-90, IRS  
 SET SM.R.R.SPIKE  
 8-9-90, IRS  
 FD SM.R.R.SPIKE  
 REF14  
 4-17-2017, DCH  
 SET MAG/WASHER  
 8-15-17, DCH

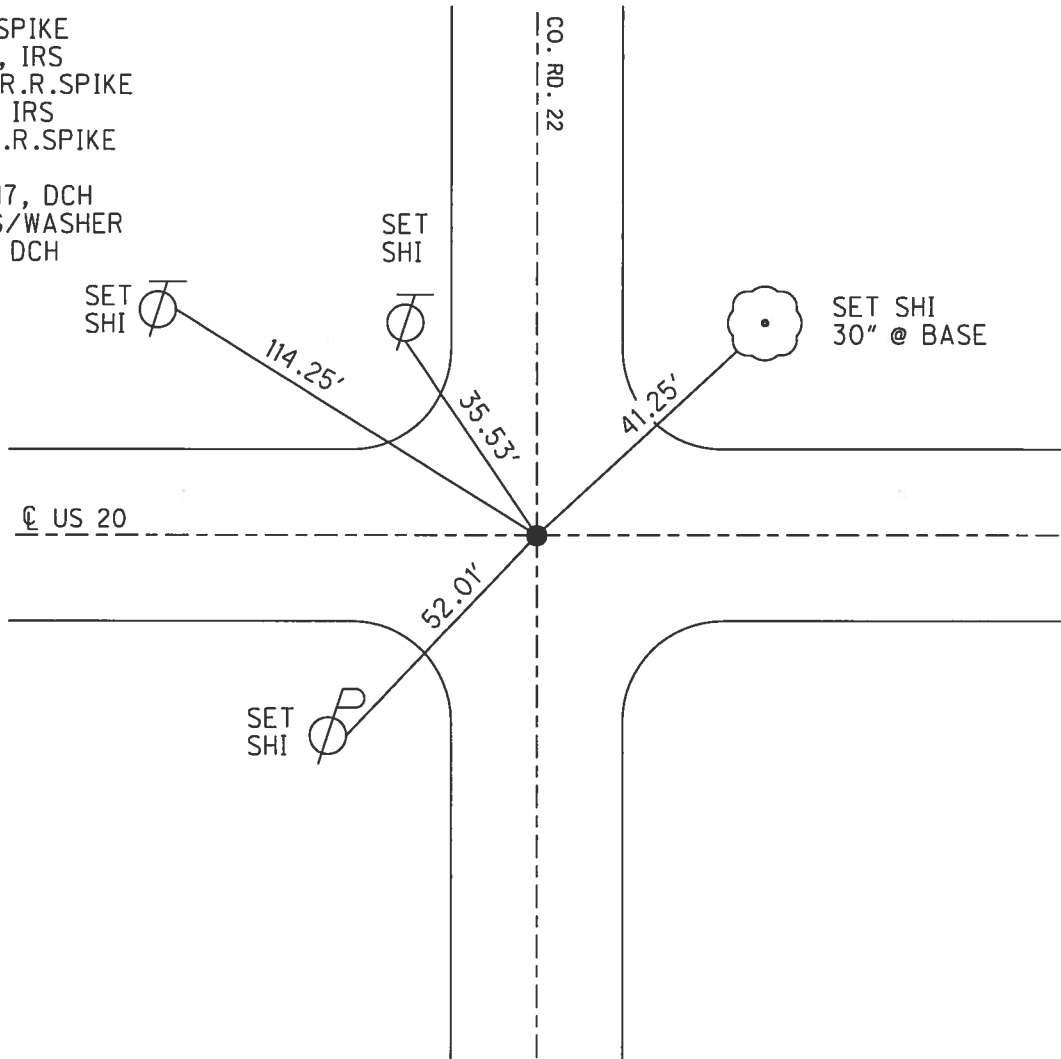

# O.D.O.T. DISTRICT 2 SURVEY OFFICE

PERSONNEL \_\_\_\_\_ REFERENCE NO. 14 SHEET 2 OF \_\_\_\_\_

NOTES 1. Stone

H.C. D. Curtis

R.C. J. Hauschalter

DATE 18 June 90

WEATHER Warm

TEMP. \_\_\_\_\_

ROUTE US # 20

COUNTY Fulton

TOWNSHIP Goebau

SECTION 21

T. \_\_\_\_\_ R. \_\_\_\_\_


TYPE MONUMENT RR Spt

ON SURFACE - BELOW Surface



LEFT - & PAV'T. - RIGHT 1' Left

TO \_\_\_\_\_ EDGE PAVEMENT

S.L.M. 327+79

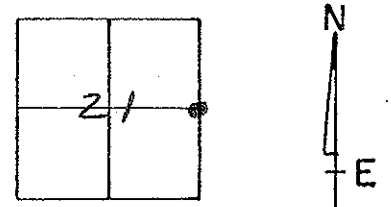

*Set Small RR Spt. 8-9-90 IRS*

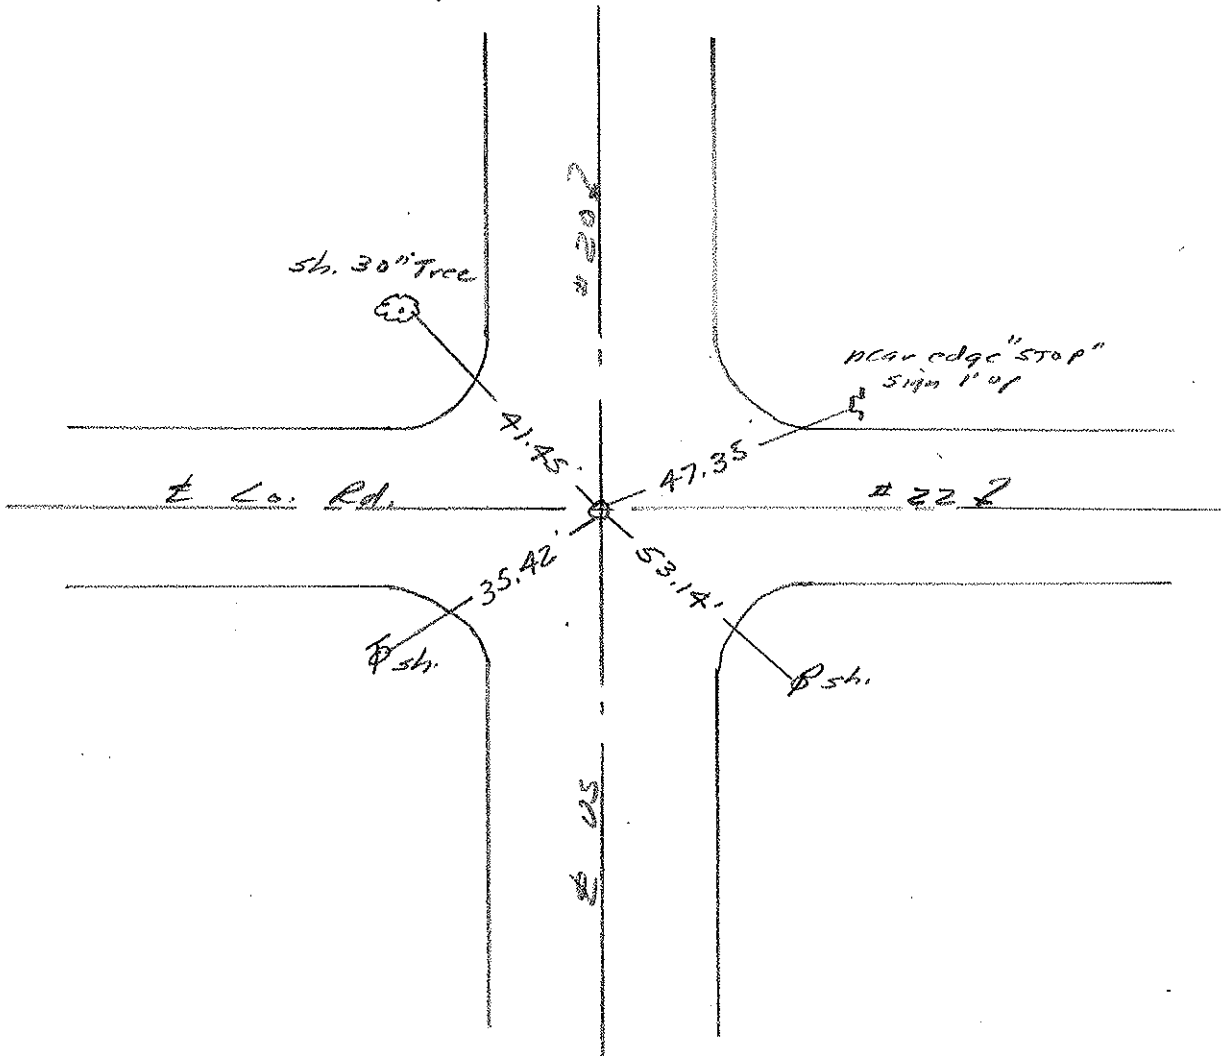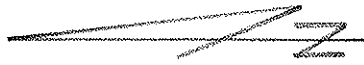

County Fulton S.R. 15 #20

Date 18 May 82

Township Gorham

Weather Warm

Section 21-22

Temp. 80°


T, N, R E

Personnel J. Stone


P. Neuser

R. Michalak

D. Curtis

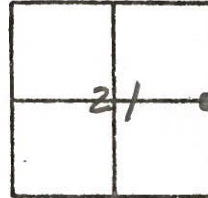

REF. NO. 14

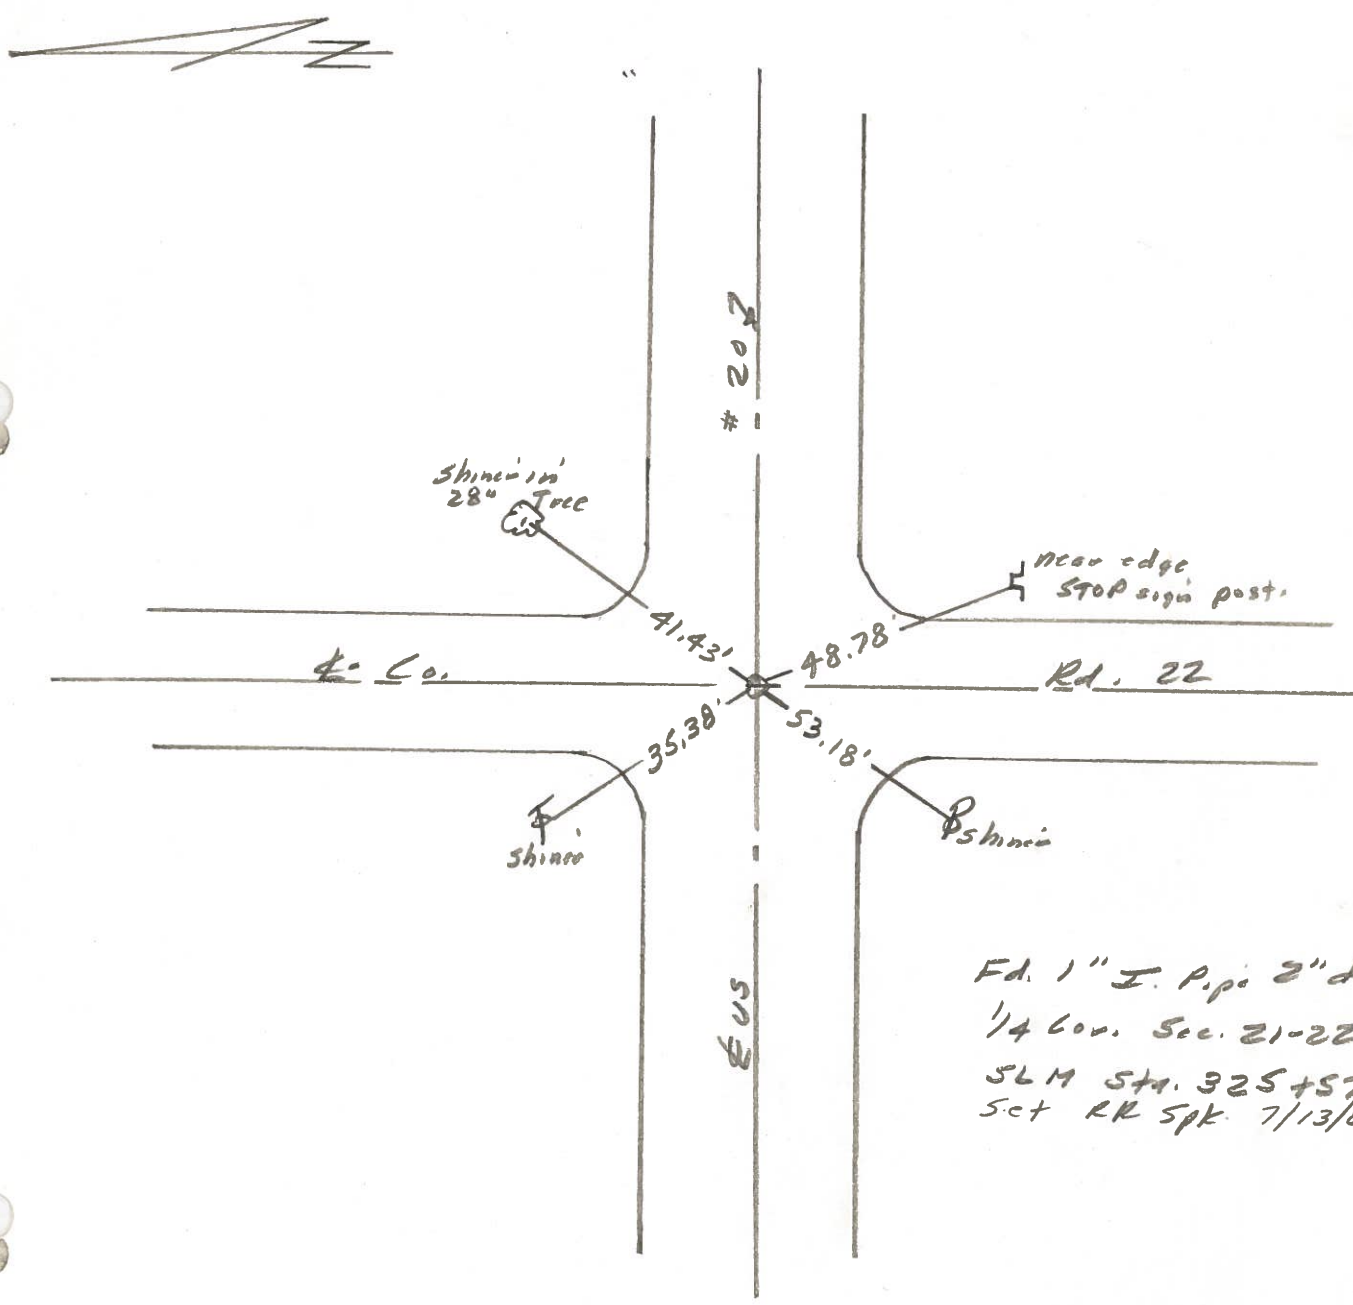

PERSONNEL TITLE PERSONNEL TITLE

COUNTY Fulton DATE JUNE 4, 1973

\* Tomsic  
Neuser  
Granata

S. R. U. S. 20 WEATHER \_\_\_\_\_

SEC. Gorham TWP. TEMP. \_\_\_\_\_

DESCRIPTION LEFT CENTER LINE RIGHT JOB NO.

