


O.D.O.T. DISTRICT 2 SURVEY OFFICE (USE ONLY)

PERSONNEL _____ REFERENCE NO. 15 SHEET 24 OF 38
 NOTES LEU DATE 4/17/17 ROUTE US 20
 H.C. HOMAN WEATHER SUNNY COUNTY FULTON
 R.C. LEU TEMP. 70°F TOWNSHIP GORHAM
 _____ SECTION 22
 _____ T 9 S R 1 E


TYPE MONUMENT SM.R.R.SPIKE
 ON SURFACE - ~~BELOW~~ ON _____
 LEFT - ☉ PAV'T - ~~RIGHT~~ 0.8'
 _____ TO _____ EDGE PAVEMENT
 S.L.M. 354+09

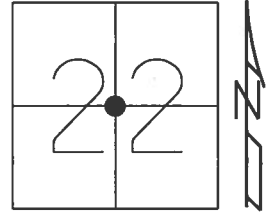

Grid: Northing: 736410.029 Easting: 1482580.832

RECORD:
 FD 1" IPIPE
 6-18-90, IRS
 SET SM.R.R.SPIKE
 8-9-90, IRS
 FD SM.R.R.SPIKE
 REF15
 4-17-2017, DCH
 SET MAG/WASHER
 8-15-17, DCH

DIST. 15-15A= 7.97'

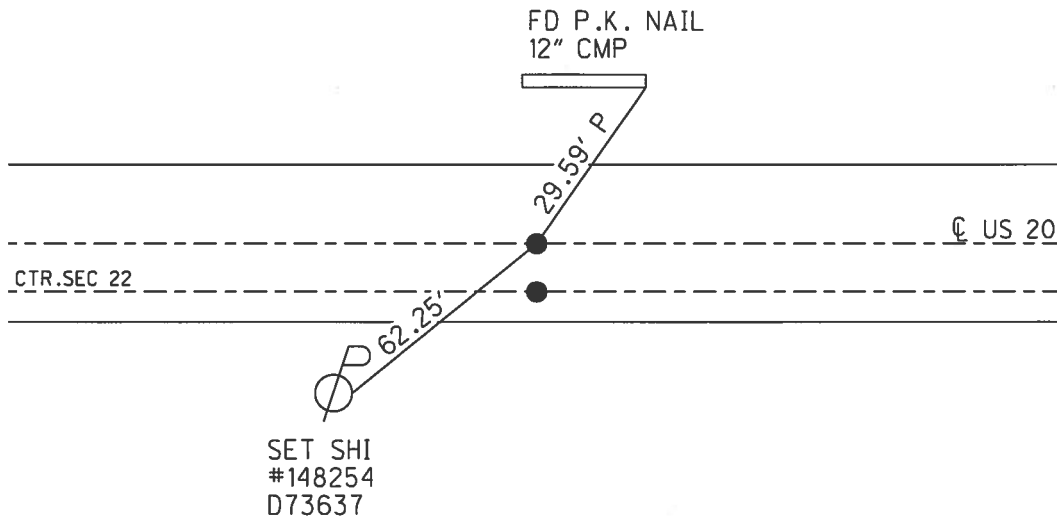

O.D.O.T. DISTRICT 2 SURVEY OFFICE

PERSONNEL _____

REFERENCE NO. 15

SHEET 3 OF _____

NOTES 1. Stone

H.C. D. Curtis

R.C. J. Householder

DATE 18 June 90

WEATHER Warm

TEMP. 81°

ROUTE US # 20

COUNTY Fulton

TOWNSHIP Garbans

SECTION 22

T _____ R _____



TYPE MONUMENT 1" I. pipes (both)

ON SURFACE - BELOW 3" deep

LEFT - \odot PAV'T. - RIGHT _____

_____ TO _____ EDGE PAVEMENT

S.L.M. 354+09

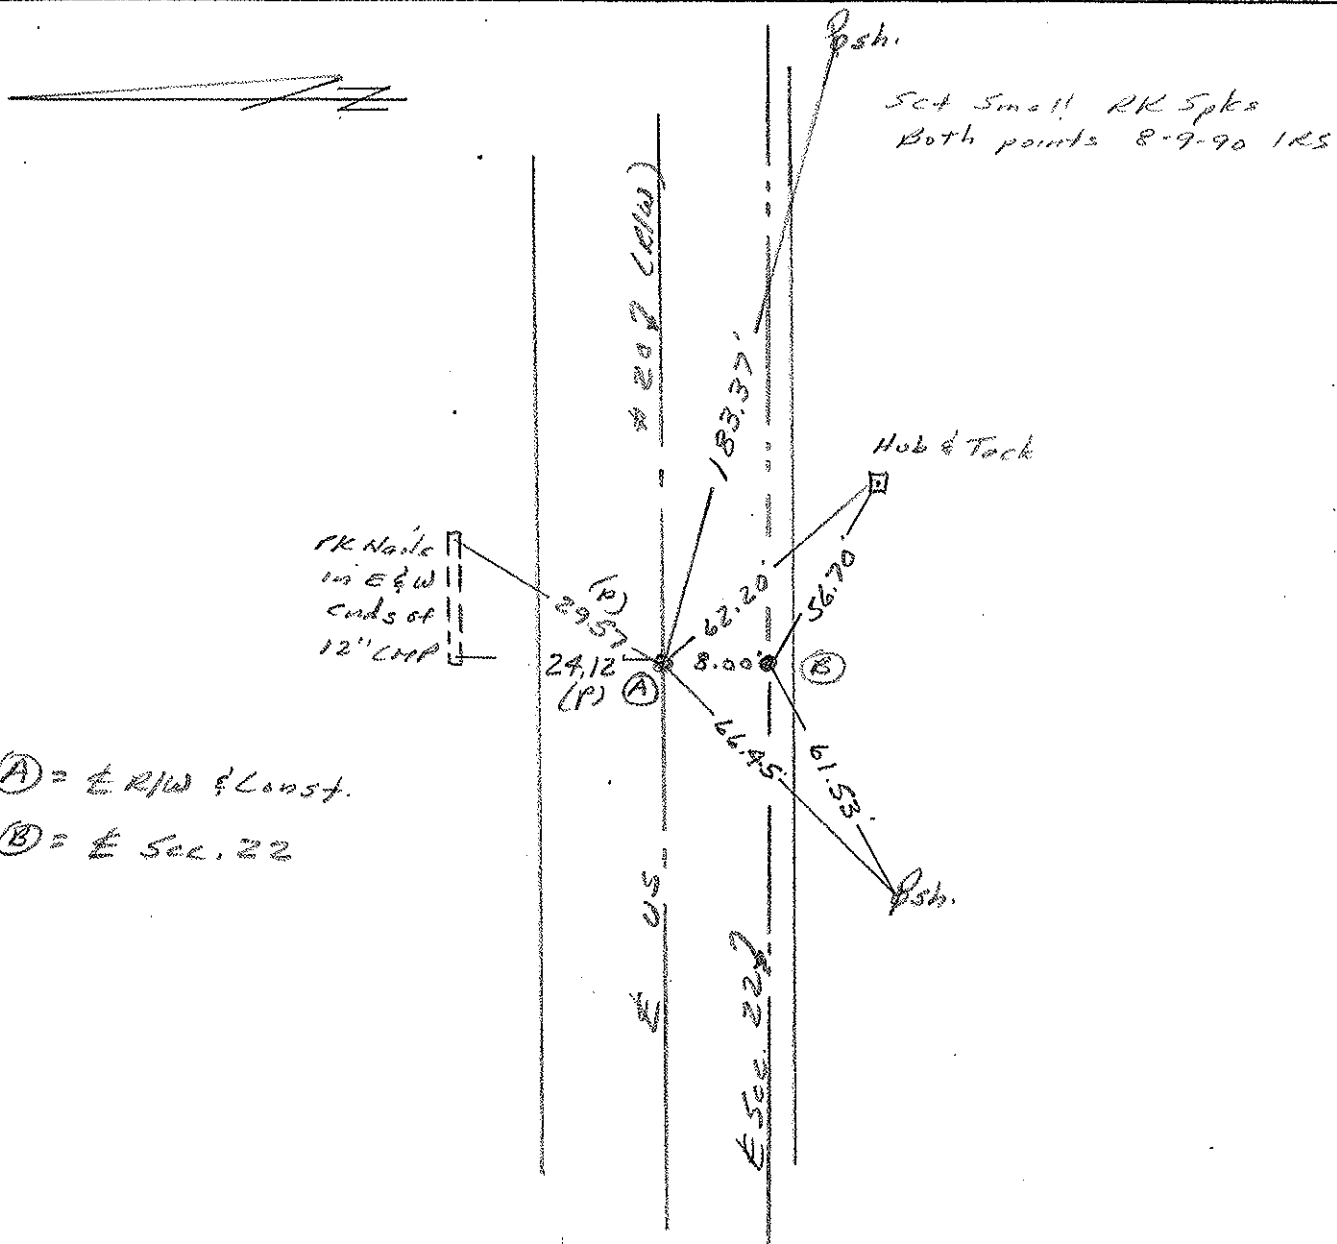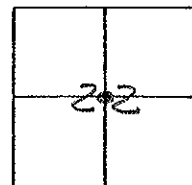

(A) = \pm R/W & Const.

(B) = \pm Sec. 22

County Fulton S.R. US#20

Date 18 May 82

Township Gorham

Weather Warm

Section 22

Temp. 80°


T, N, R, E

Personnel L. Stone


R. Michalak

P. Newser

D. Curtis

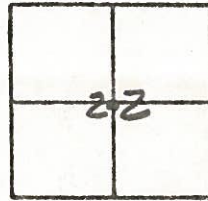

REF. NO. 15

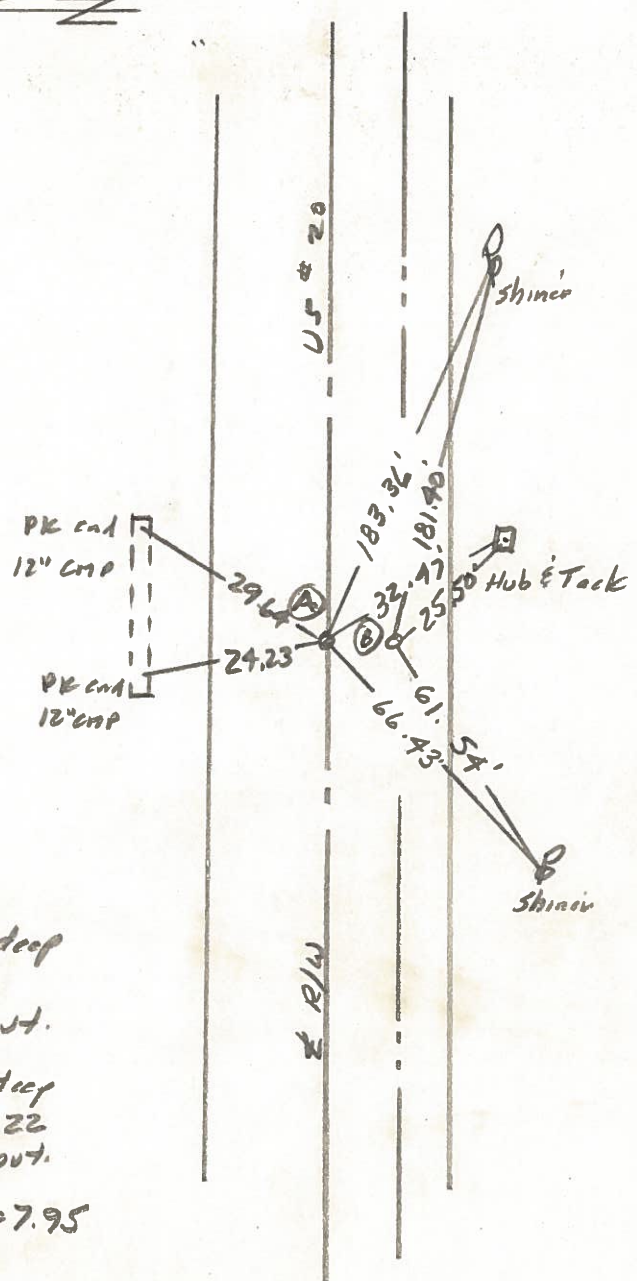

- Ⓐ Fd. 1" I. Pipe 4" deep
E R/W & Const.
9.5' To N. edge put.
 - Ⓑ Fd. 1" I. Pipe 4" deep
Sec. Line & Sec. 22
2.3' To S. Edge put.
- Dist Btwn. Ⓐ & Ⓑ = 7.95
SLM Sta. 351+88

PERSONNEL	TITLE	PERSONNEL	TITLE	COUNTY	DATE
Tomsic				Fulton	JUNE 5, 197
Neuser				S. R. U.S. 20	WEATHER
Granata				SEC. Gorham TWP.	TEMP

DESCRIPTION _____ LEFT _____ CENTER LINE _____ RIGHT _____ JOB NO. _____

