


O.D.O.T. DISTRICT 2 SURVEY OFFICE (USE ONLY)

PERSONNEL _____ REFERENCE NO. 15 A SHEET 25 OF 38
 NOTES LEU DATE 4/17/17 ROUTE US 20
 H.C. HOMAN WEATHER SUNNY COUNTY FULTON
 R.C. LEU TEMP. 70°F TOWNSHIP GORHAM
 _____ SECTION 22
 _____ T 9 S R 1 E

TYPE MONUMENT SM.R.R.SPIKE
 ON SURFACE - ~~BELOW~~ ON _____
~~LEFT~~ - ☉ PAV'T - RIGHT 7.2'
 - TO - EDGE PAVEMENT
 S.L.M. 354+09

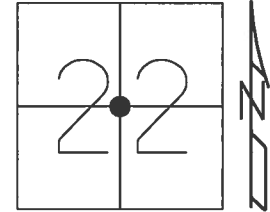


Grid: Northing: 736402.085 Easting: 1482580.819

RECORD:
 FD 1" IPIPE
 6-18-90, IRS
 SET SM.R.R.SPIKE
 8-9-90, IRS
 FD SM.R.R.SPIKE
 REFA15
 4-17-2017, DCH
 SET MAG/WASHER
 8-15-17, DCH

DIST. 15-15A= 7.97'

36.25' P

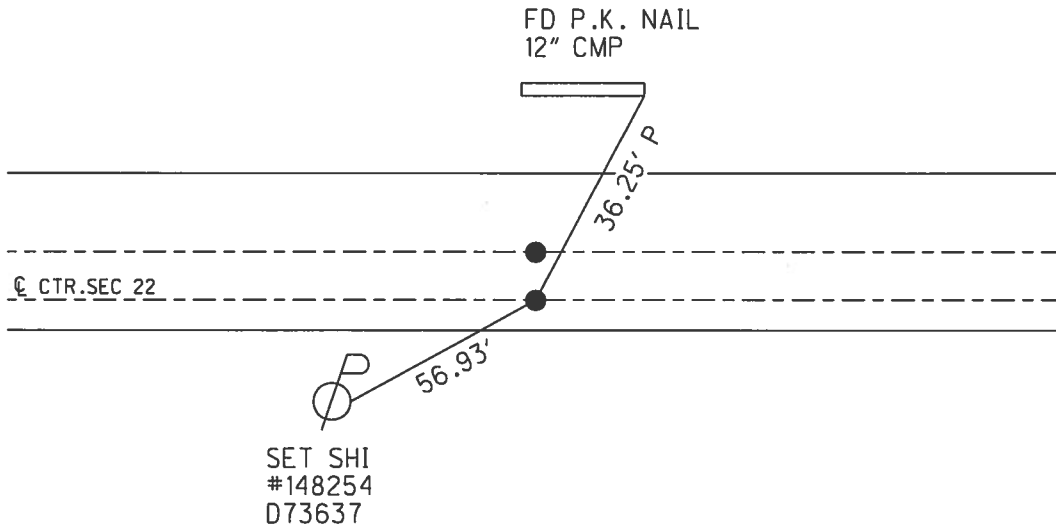

O.D.O.T. DISTRICT 2 SURVEY OFFICE

PERSONNEL _____

REFERENCE NO. 15

SHEET 3 OF _____

NOTES 1. Stone

H.C. D. Curtis

R.C. J. Householder

DATE 18 June 90

WEATHER Warm

TEMP. 81°

ROUTE US # 20

COUNTY Fulton

TOWNSHIP Garbans

SECTION 22

T _____ R _____



TYPE MONUMENT 1" I. pipes (both)

ON SURFACE - BELOW 3" deep

LEFT - \odot PAV'T. - RIGHT _____

_____ TO _____ EDGE PAVEMENT

S.L.M. 354+09

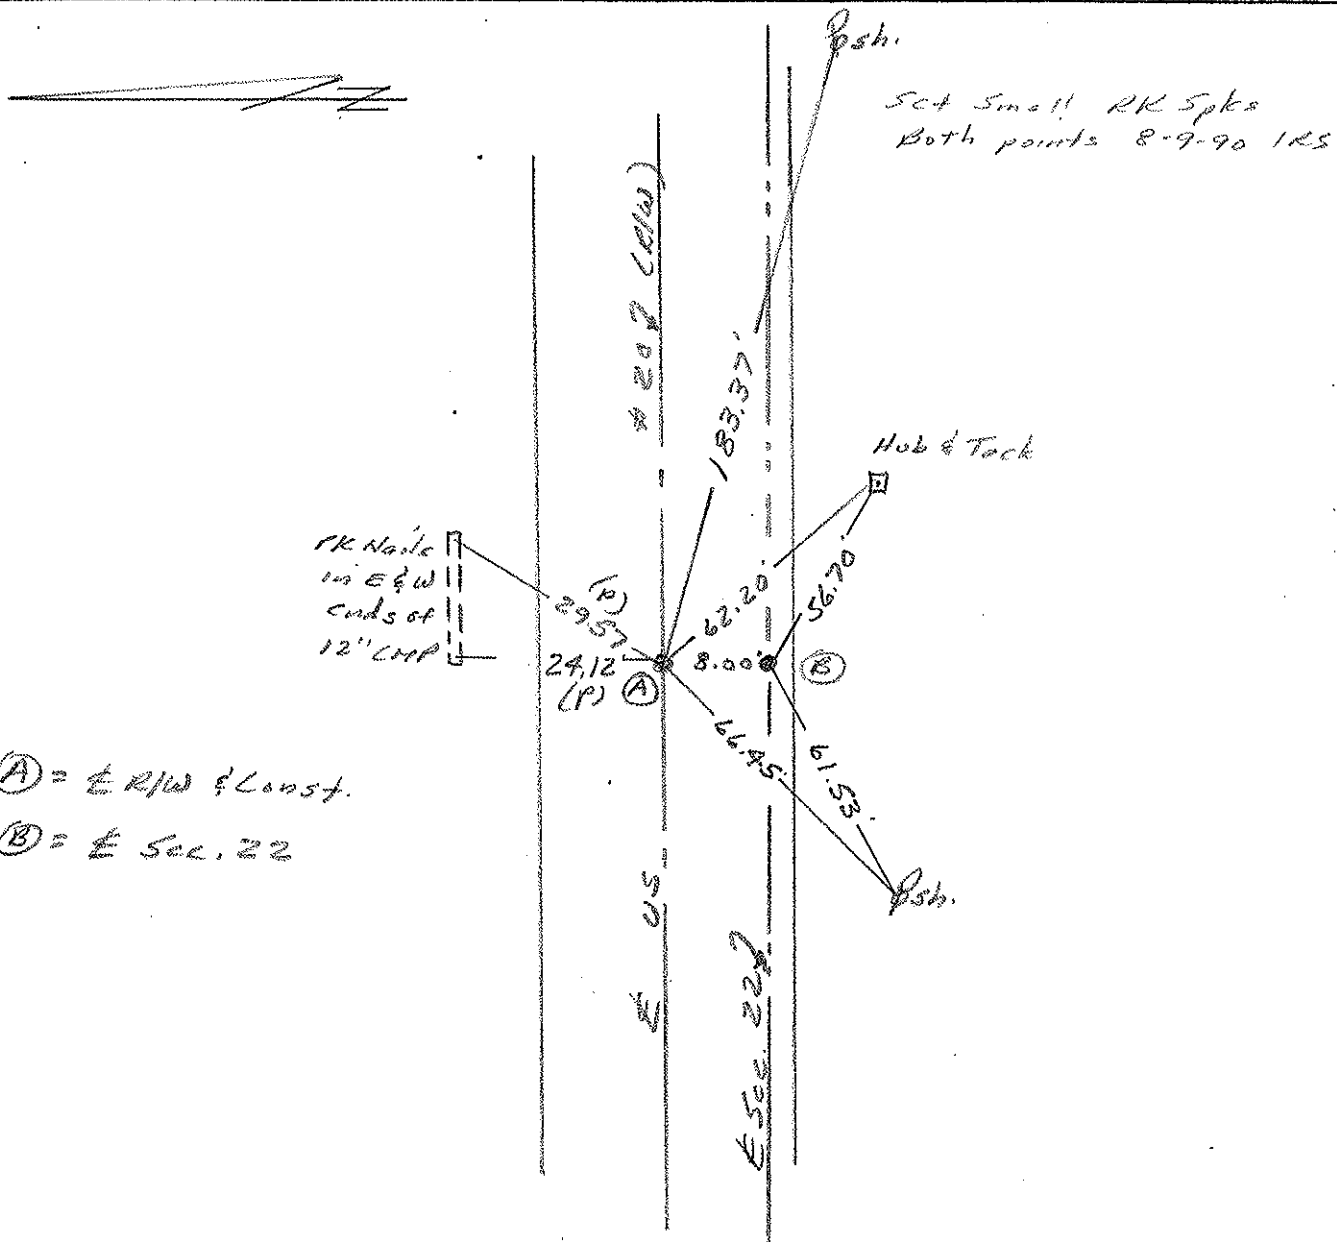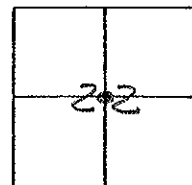

(A) = \pm R/W & Const.

(B) = \pm Sec. 22

County Fulton S.R. US#20

Date 18 May 82

Township Gorham

Weather Warm

Section 22

Temp. 80°


T N, R E

Personnel L. Stone


R. Michalak

P. Neuser

D. Curtis

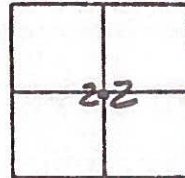


REF. NO. 15

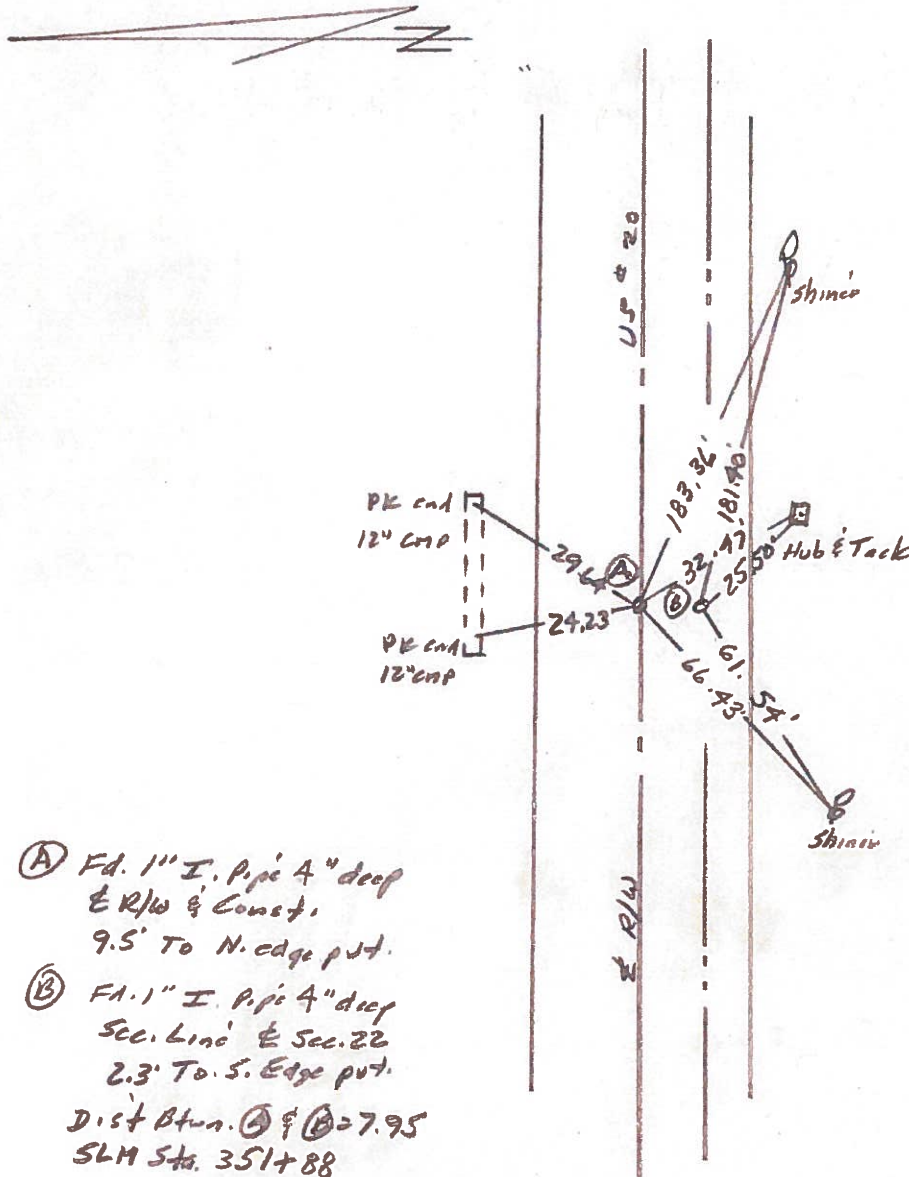

PERSONNEL	TITLE	PERSONNEL	TITLE	COUNTY	DATE	WEATHER	TEMP.
Tomsic				Fulton	JUNE 5, 1973		
Neuser				S. R. U.S. 20			
Granata				SEC. Gorham TWP			

DESCRIPTION	LEFT	CENTER LINE	RIGHT	JOB NO.
-------------	------	-------------	-------	---------

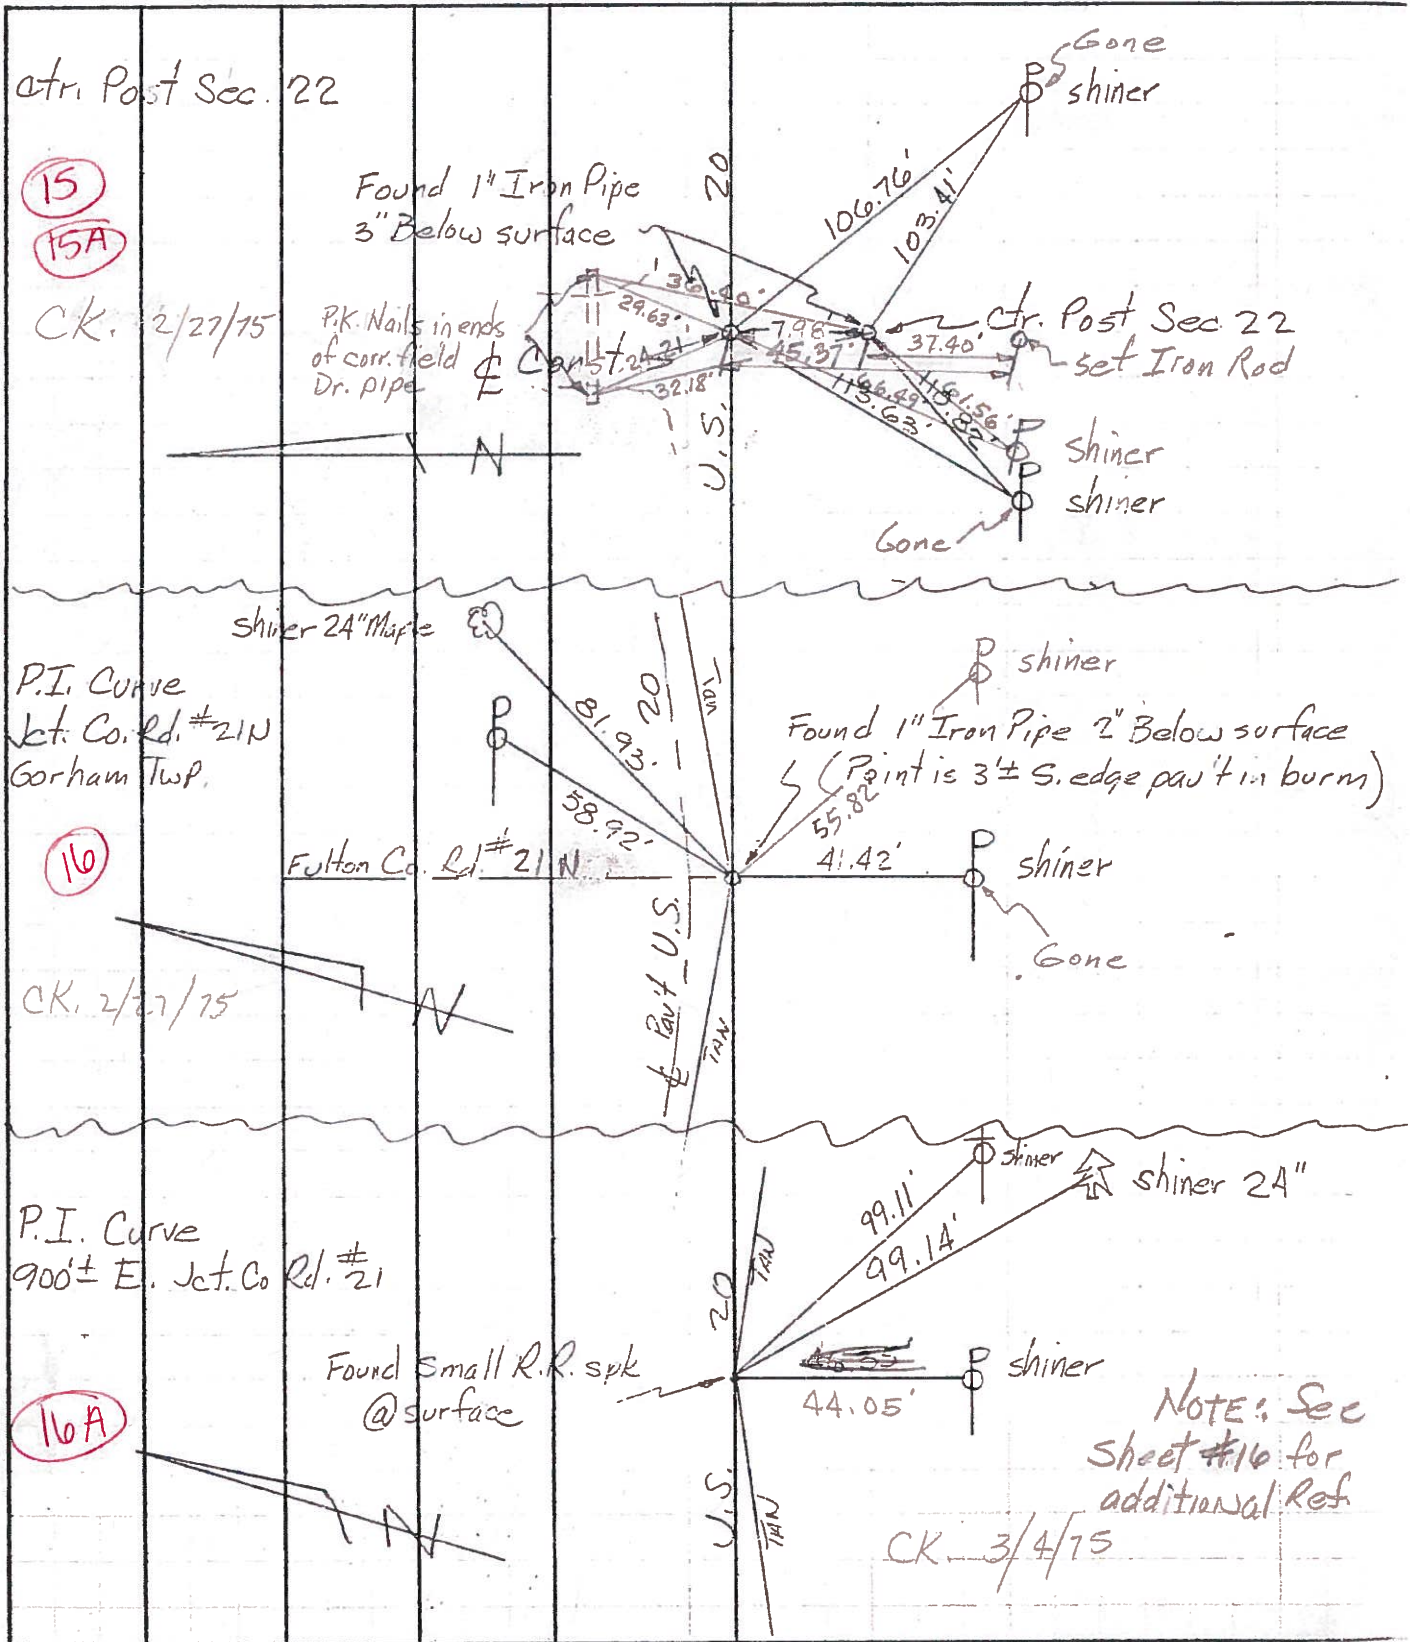

(15)
(15A)

CK. 2/27/75

P.I. Curve
Jct. Co. Rd. #21 N
Gorham Twp.

(16)

CK. 2/27/75

P.I. Curve
900± E. Jct. Co Rd. #21

(16A)

Found Small R.R. spk
@ surface

NOTE: See
Sheet #16 for
additional Ref

CK 3/4/75