



O.D.O.T. DISTRICT 2 SURVEY OFFICE (USE ONLY)

PERSONNEL _____ REFERENCE NO. 16 B SHEET 28 OF 38
 NOTES LEU DATE 4/18/17 ROUTE US 20
 H.C. HOMAN WEATHER SUNNY COUNTY FULTON
 R.C. LEU TEMP. 44°F TOWNSHIP GORHAM
 _____ SECTION 23
 _____ T 9 S R 1 E

TYPE MONUMENT CMON W/IPIN
~~ON SURFACE~~ - BELOW 3 1/2"
 LEFT - ☉ PAV'T - RIGHT - _____
 - TO - _____ EDGE PAVEMENT
 S.L.M. 389+14
 Grid: Northing: 737668.537 Easting: 1490241.780

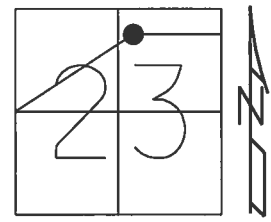

RECORD:
 FD CMON W/IPIN
 3 1/2" DOWN
 REFB16
 4/18/17, DCH

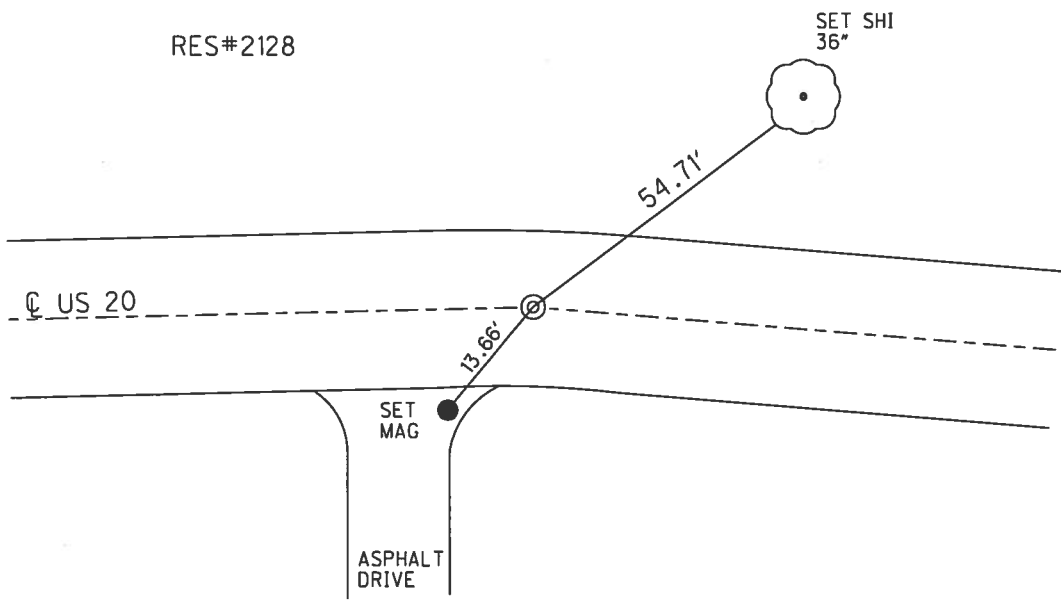

PERSONNEL TITLE PERSONNEL TITLE COUNTY Fulton DATE JUNE 5, 19
Tamsic _____
Neuser _____
Gravata _____
 S. R. U. S. 20 WEATHER _____
 SEC. Gorham TWP. TEMP. _____

DESCRIPTION LEFT CENTER LINE RIGHT JOB NO.

