

Red Beach
W. Knape


COUNTY Tulter DATE 20 Nov 1969

S. R. US 20 WEATHER _____

SEC. 802 Garham Twp TEMP _____

DESCRIPTION CONTROL POINTS JOB NO. _____

#16-C

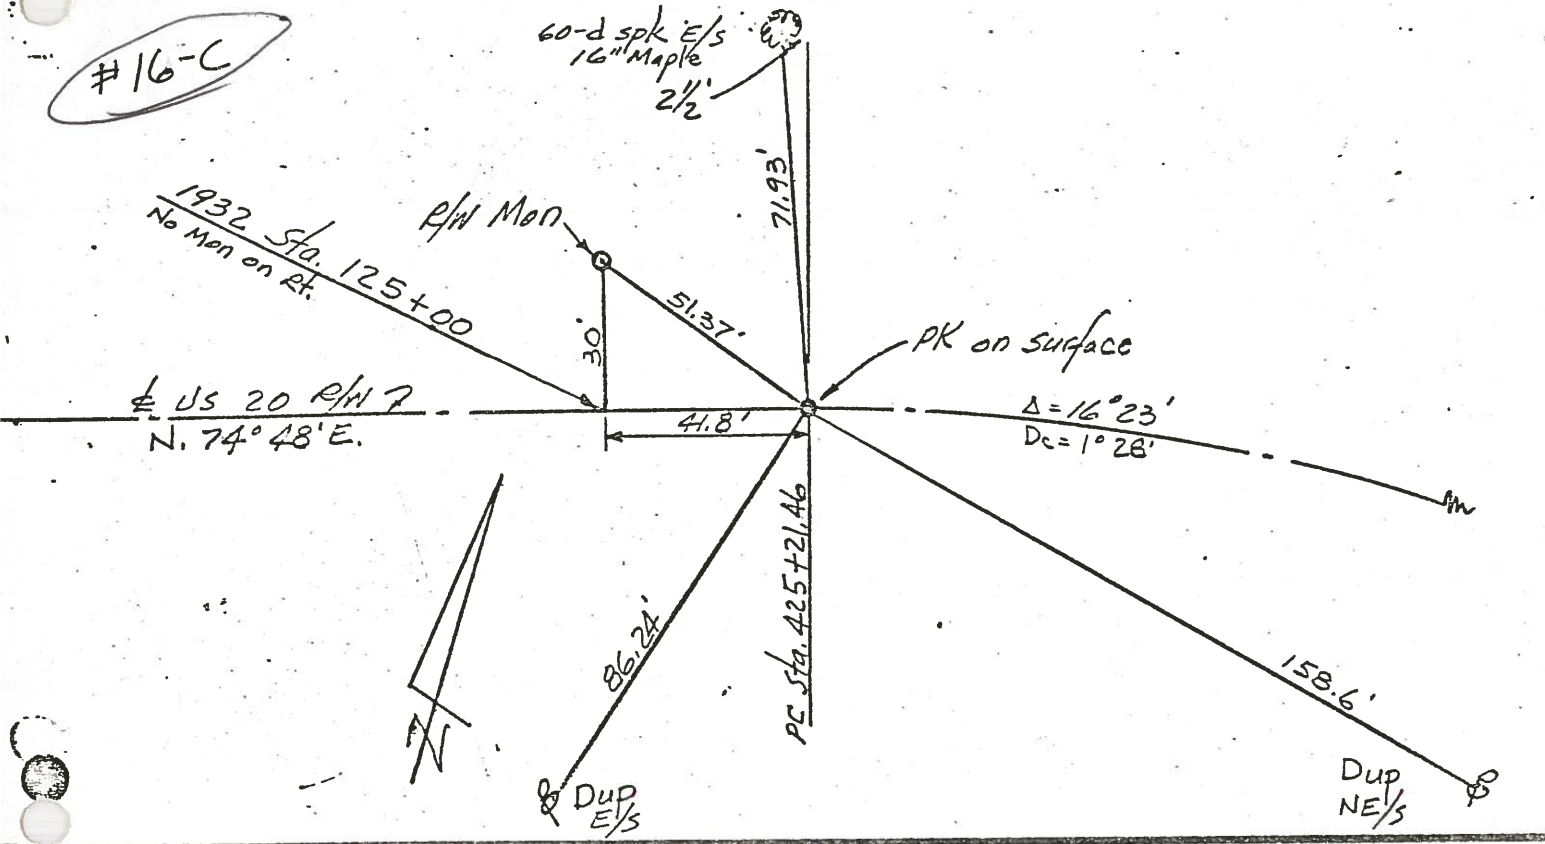

#17

