



O.D.O.T. DISTRICT 2 SURVEY OFFICE (USE ONLY)

PERSONNEL \_\_\_\_\_ REFERENCE NO. 17 A SHEET 30 OF 38  
 NOTES LEU DATE 4/18/17 ROUTE US 20  
 H.C. HOMAN WEATHER SUNNY COUNTY FULTON  
 R.C. LEU TEMP. 50°F TOWNSHIP GORHAM  
 \_\_\_\_\_ SECTION 24  
 \_\_\_\_\_ T 9 S R 1 E

TYPE MONUMENT 1" IPIPE  
~~ON SURFACE~~ - BELOW 4"  
~~LEFT~~ - Q PAV'T - RIGHT 1.3'  
9.4' TO RT EDGE PAVEMENT  
 S.L.M. 449+29  
 Grid: Northing: 737612.544 Easting: 1492068.510

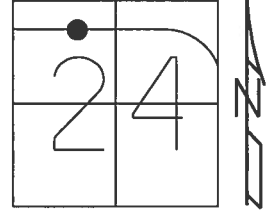

RECORD:  
 FD 1" IPIPE  
 2" DEEP  
 11-05-84  
 FD SM.R.R.SPIKE  
 5-8-98, SAH  
 FD 1" IPIPE  
 REFA17  
 4-18-2017, DCH  
 SET MAG/WASHER  
 8-15-2017, DCH

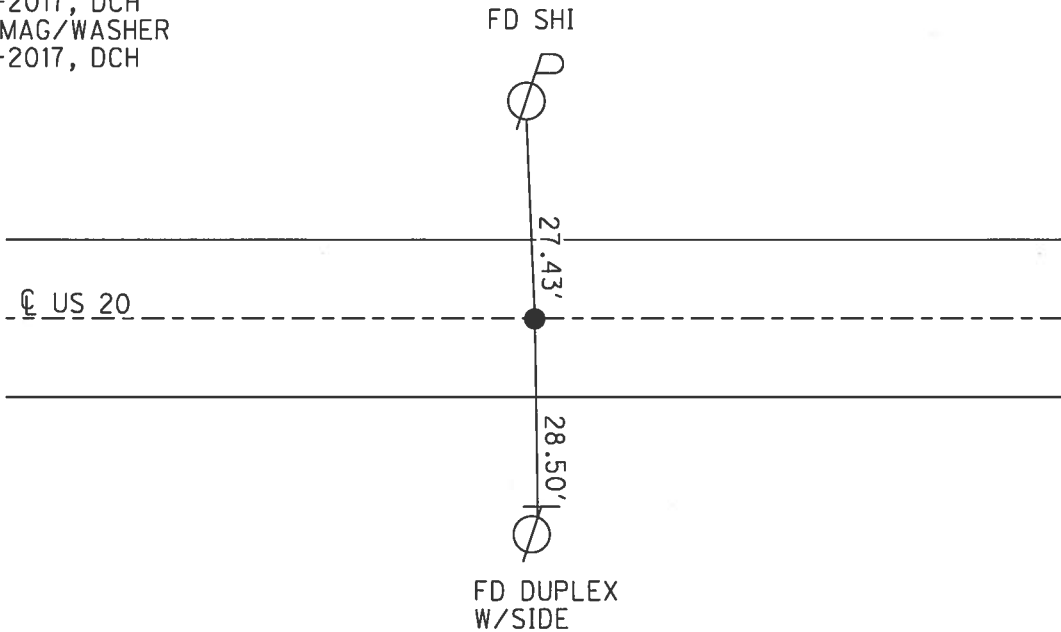

O.D.O.T. DISTRICT 2 SURVEY OFFICE

PERSONNEL

REFERENCE NO. 17-A

SHEET 4 OF 11

NOTES S. HOSS

H.C. B. VAN DUSEN

R.C. BEN. COLOES

DATE 5-8-98

WEATHER CLOUDY - RAIN

TEMP. +62°F

ROUTE 20

COUNTY FULTON

TOWNSHIP GORHAM

SECTION 24

T. 9 S. R 1 E


TYPE MONUMENT SMALL RR SPIKE

ON SURFACE - BELOW YES

~~LEFT - C~~ PAV'T. - RIGHT O. 8 RT. C

9.4' TO RT EDGE PAVEMENT


S.L.M. 449+29

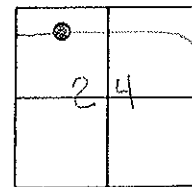

RECORD:

FO. 5M RR SPIKE 5-8-98 ~ SET "11-05-84"

FO. 1" I. PIPE 2" DEEP ~ "1984"

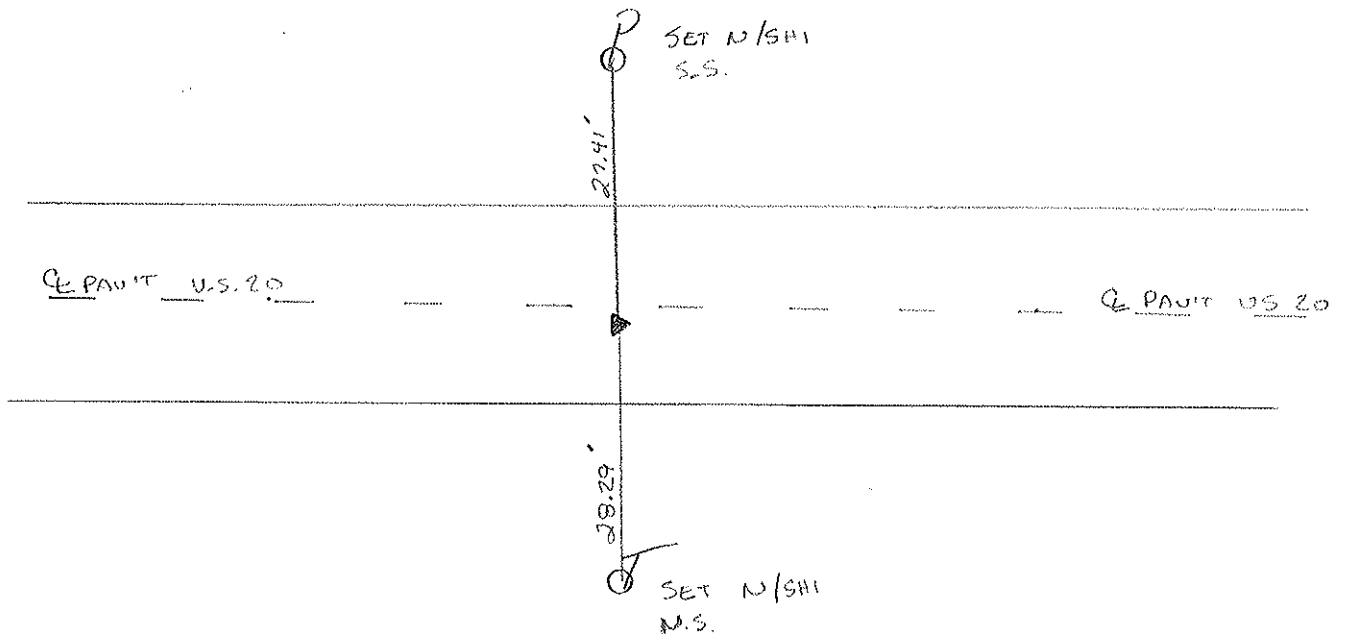

County Fulton S.R. US#20

Date 27 July 84

Township Go-hans

Weather Cloudy

Section 24


Temp. 70°

T N, R E

Personnel I. Stone


P. Neuser

R. Michalak

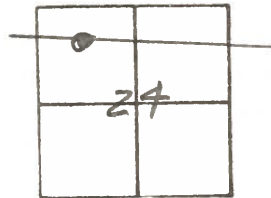

SLM STA. 449+52

REF. NO 17-A

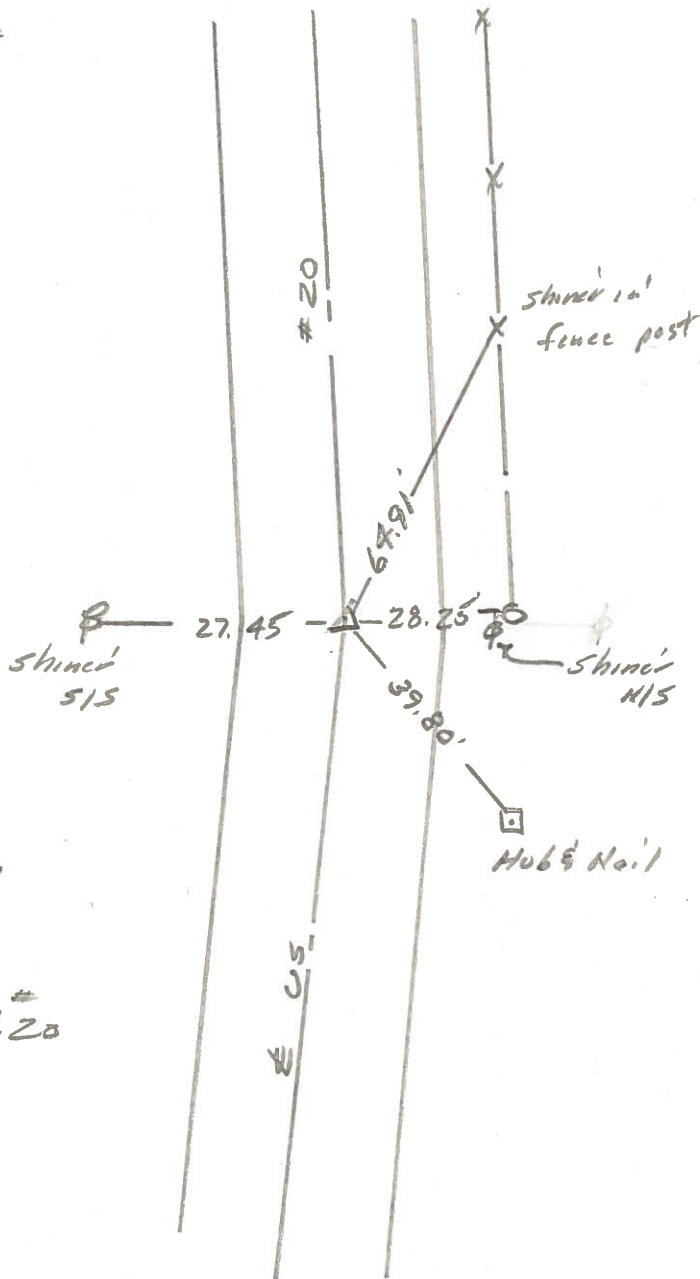

Fd. 1" I. pipe 2" deep  
 9.3' to S. edge put  
 11.7' to N. edge put  
 1/4 mile E. Co. Rd. 20  
 Set Small spt. 11/05/84

PERSONNEL TITLE PERSONNEL TITLE  
Red Beach  
W. Knape

COUNTY Fulton DATE 26 Aug 75


S. R. US 20 WEATHER \_\_\_\_\_

SEC. 24 R-1-E Gerhart Twp TEMP. \_\_\_\_\_

DESCRIPTION CONTROL POINTS JOB NO. \_\_\_\_\_

17A

Near Side Conc. AP

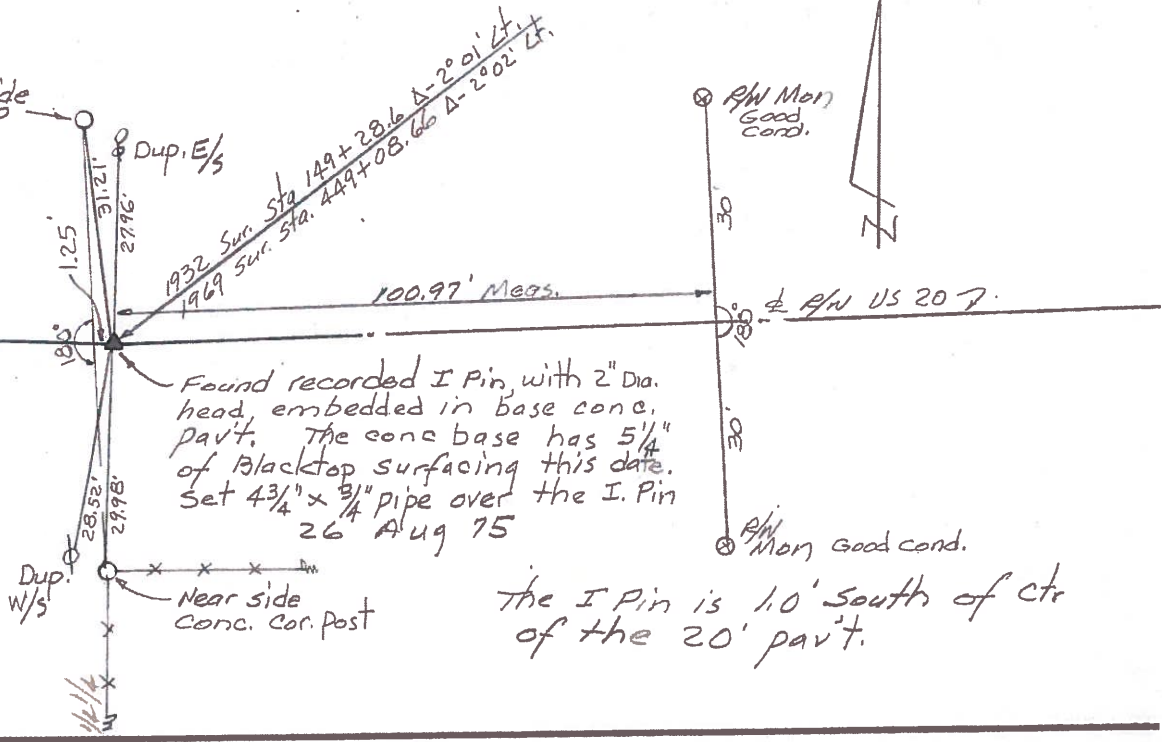


18

Found recorded I Pin with 2" dia head embedded in base conc. pavt. conc pavt has 5" of blacktop surfacing this date. Set 4 1/2" x 3/4" pipe over the I. Pin 26 Aug 1975

1932 Δ-Meas. 0°55'40"  
1969 Sur. Sta. 162+57.25 Δ-0°56'24" REC.  
1969 Sur. Sta. 462+37.30 END SURV. 1969

Pole #1763

Dup. SW/S

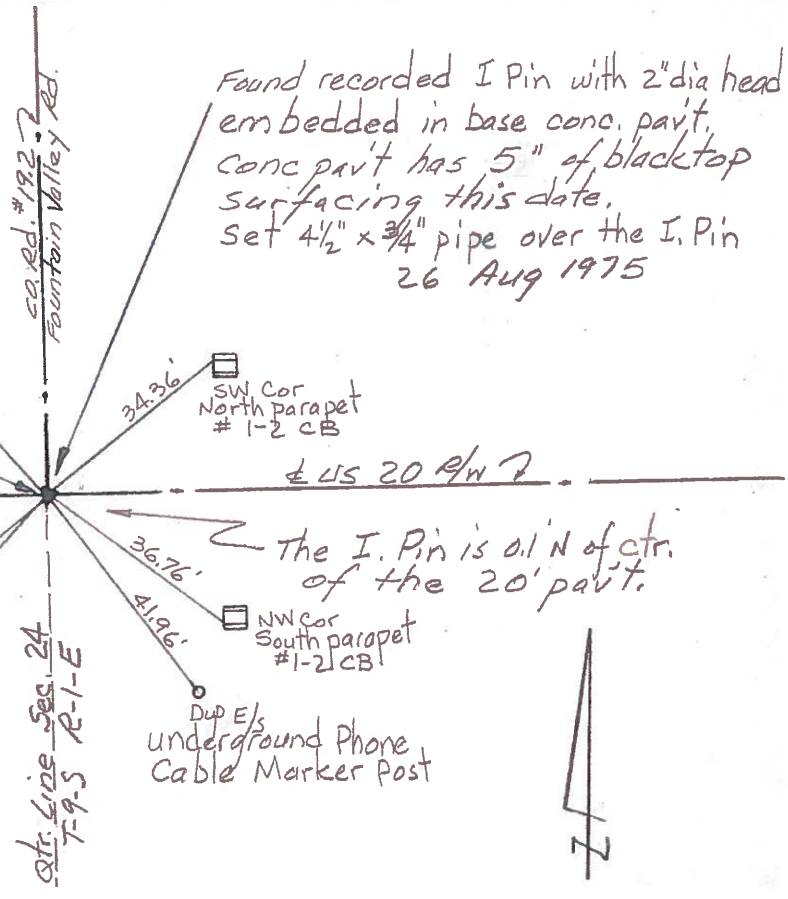

PERSONNEL	TITLE	PERSONNEL	TITLE	COUNTY	DATE	WEATHER	TEMP
Tamsic				Fulton	JUNE 5, 1992		
Neuser				S. R. U. S. 20			
Granata				SEC. Gorham TWP.			

