

O.D.O.T. DISTRICT 2 SURVEY OFFICE (USE ONLY)

PERSONNEL

REFERENCE NO. 27

SHEET 4 OF 4

NOTES LEU

DATE 7-5-18

ROUTE US 20

H.C. LEU

WEATHER PT.CLOUDY,FAIR

COUNTY FULTON

R.C. HAGEMEYER

TEMP. 84°F

TOWNSHIP CHESTERFIELD

DWG BY JAMES

PID 101272

SECTION 21

T 9 N R 2 E

TYPE MONUMENT P.K./WASHER

ON SURFACE - ~~BELOW~~ ON

OFFSET Q PAVEMENT 1.1' ~~LT~~ : RT

TO EDGE PAVEMENT


STATION: 679+22

HORZ.DATUM: NAD83 2011


GEOID: NAVD88 2012A

GRID: NORTHING: 733707.091

EASTING: 1511751.563

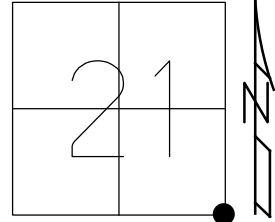

RECORD:
 SET P.K./WASHER
 8-28-00, SAH
 FD PK/WASHER
 CP2
 1-29-13, DH
 REF27
 9/22/15, JFO
 7-5-18, JLL
 SET MAG/WASHER
 4-9-19, JLL
 FD MAG/WASHER
 7/5/22, DSA

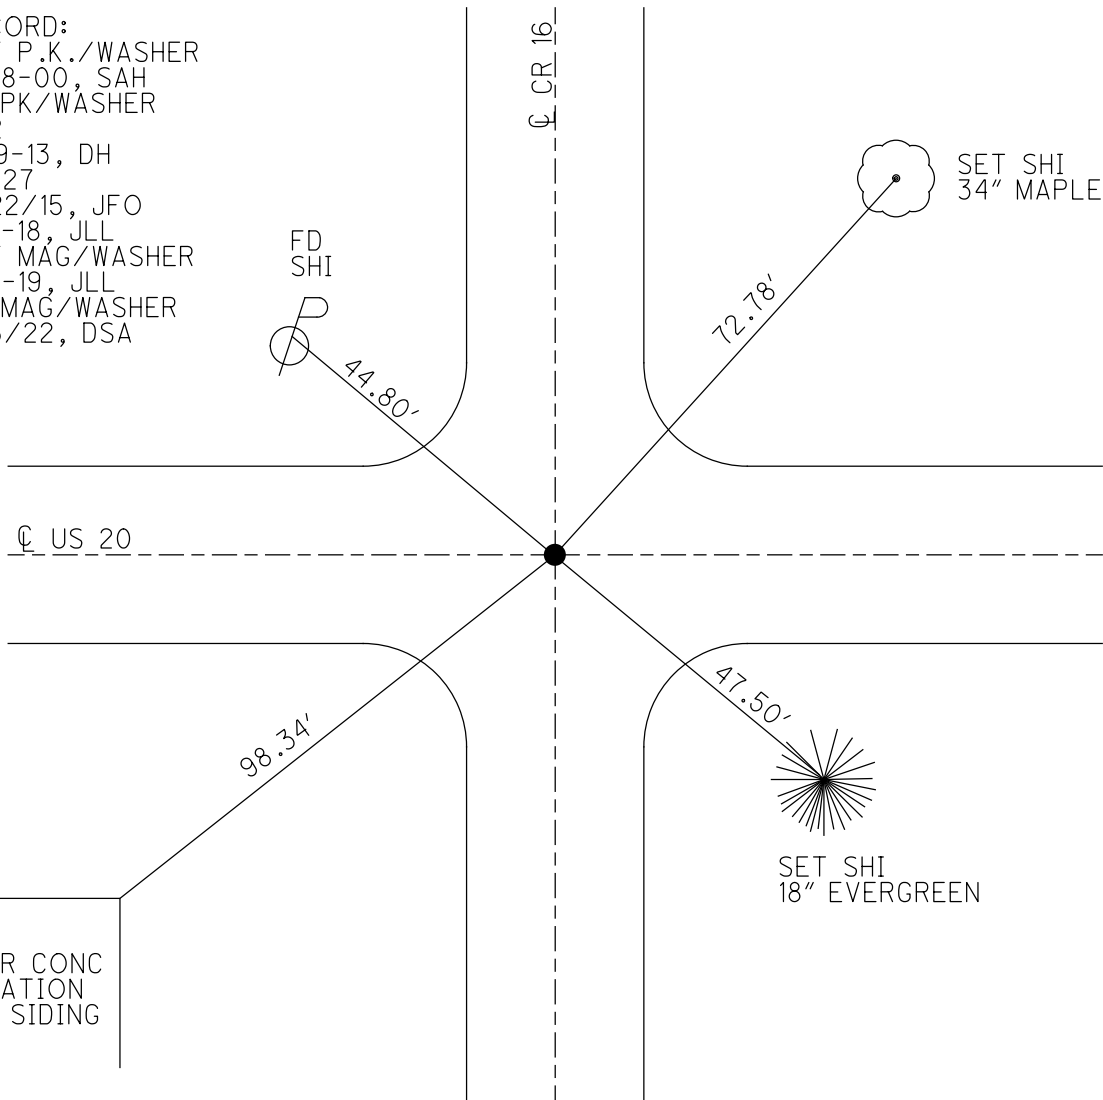

O.D.O.T. DISTRICT 2 SURVEY OFFICE (USE ONLY)

PERSONNEL

REFERENCE NO. 27

SHEET 3 OF 3

NOTES LEU

DATE 7-5-18

ROUTE US 20

H.C. LEU

WEATHER PT. CLOUDY, FAIR

COUNTY FULTON

R.C. HAGEMeyer

TEMP. 84°F

TOWNSHIP CHESTERFIELD

DWG BY JAMES

PID 101272

SECTION 21

T 9 N R 2 E

TYPE MONUMENT P.K./WASHER

ON SURFACE - ~~BELOW~~ ON

OFFSET \odot PAVEMENT 1.1' \pm : RT

TO EDGE PAVEMENT


STATION: 679+22

HORIZ. DATUM: NAD83 2011


GEOID: NAVD88 2012A

GRID: NORTHING: 733707.091

EASTING: 1511751.563

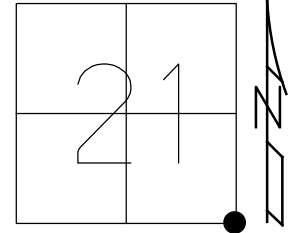


RECORD:
 SET P.K./WASHER
 8-28-00, SAH
 FD PK/WASHER
 CP2
 1-29-13, DH
 REF27
 9/22/15, JFO
 7-5-18, JLL
 SET MAG/WASHER
 4-9-19, JLL

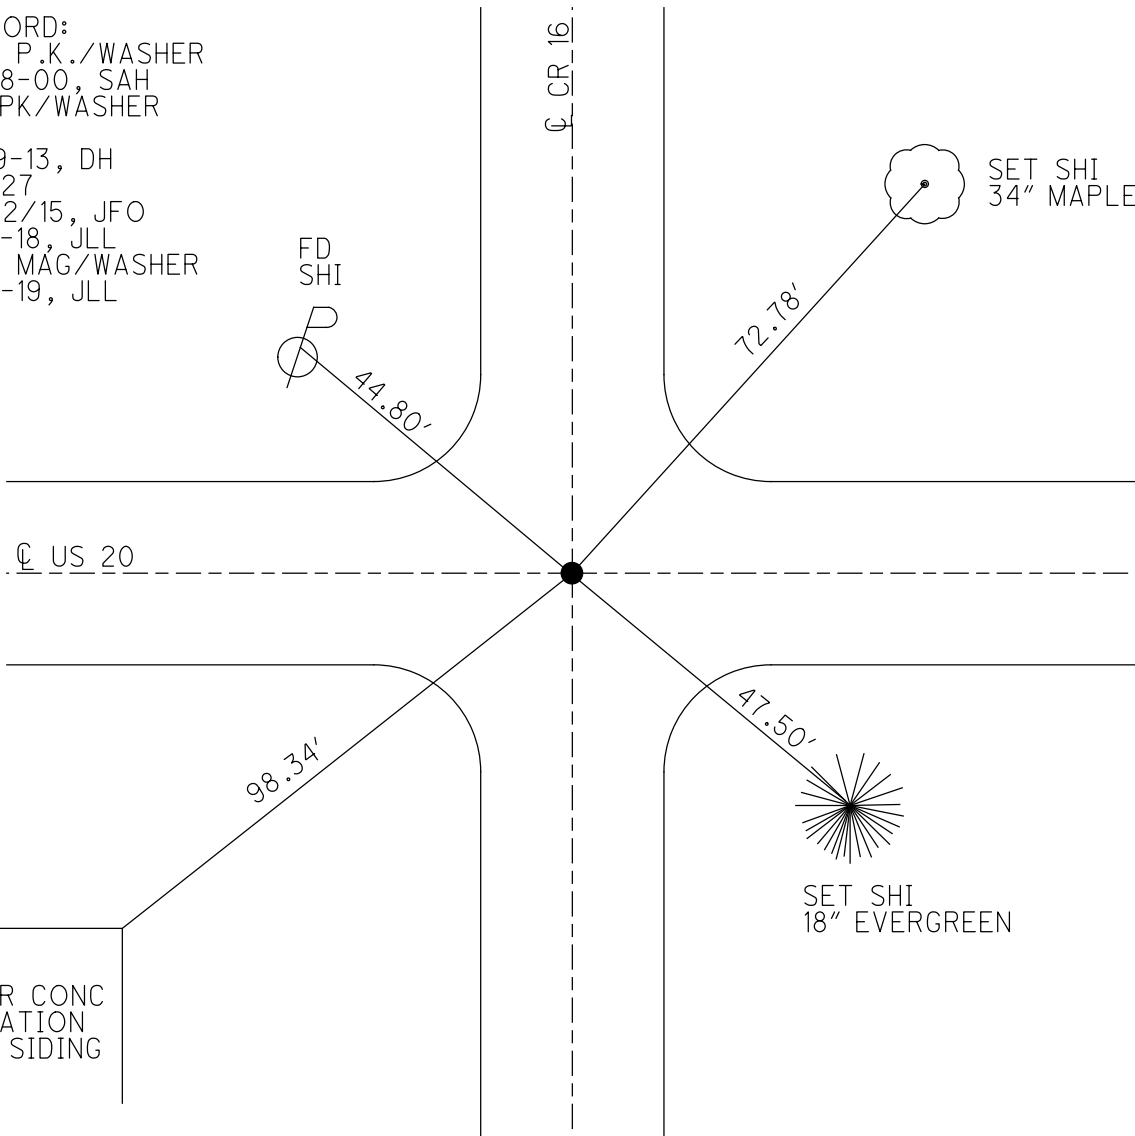

O.D.O.T. DISTRICT 2 SURVEY OFFICE (USE ONLY)


PERSONNEL _____ REFERENCE NO. 27 SHEET 1 OF 21
 NOTES HUSS _____ DATE 7/19/00 ROUTE US 20
 H.C. CORDES _____ WEATHER PT. CLOUDY COUNTY FULTON
 R.C. KARGER _____ TEMP. 72° TOWNSHIP CHESTERFIELD
 _____ SECTION 21
 _____ T 9 S R 2 E

TYPE MONUMENT _____ SM. R.R. SPIKE
~~ON SURFACE~~ - BELOW 2"
~~LEFT - C~~ PAV'T - ~~RIGHT~~ ON
 _____ TO _____ EDGE PAVEMENT
 S.L.M. 673+42.478

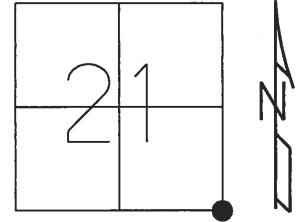

GRID: NORTHING: 733707.087 EASTING: 1511751.562

RECORD:
 SET P.K./WASHER
 8-28-00, SAH
 FD P.K./WASHER
 01-29-13, DH
 FD P.K./WASHER
 REF27
 9-22-15, JFO

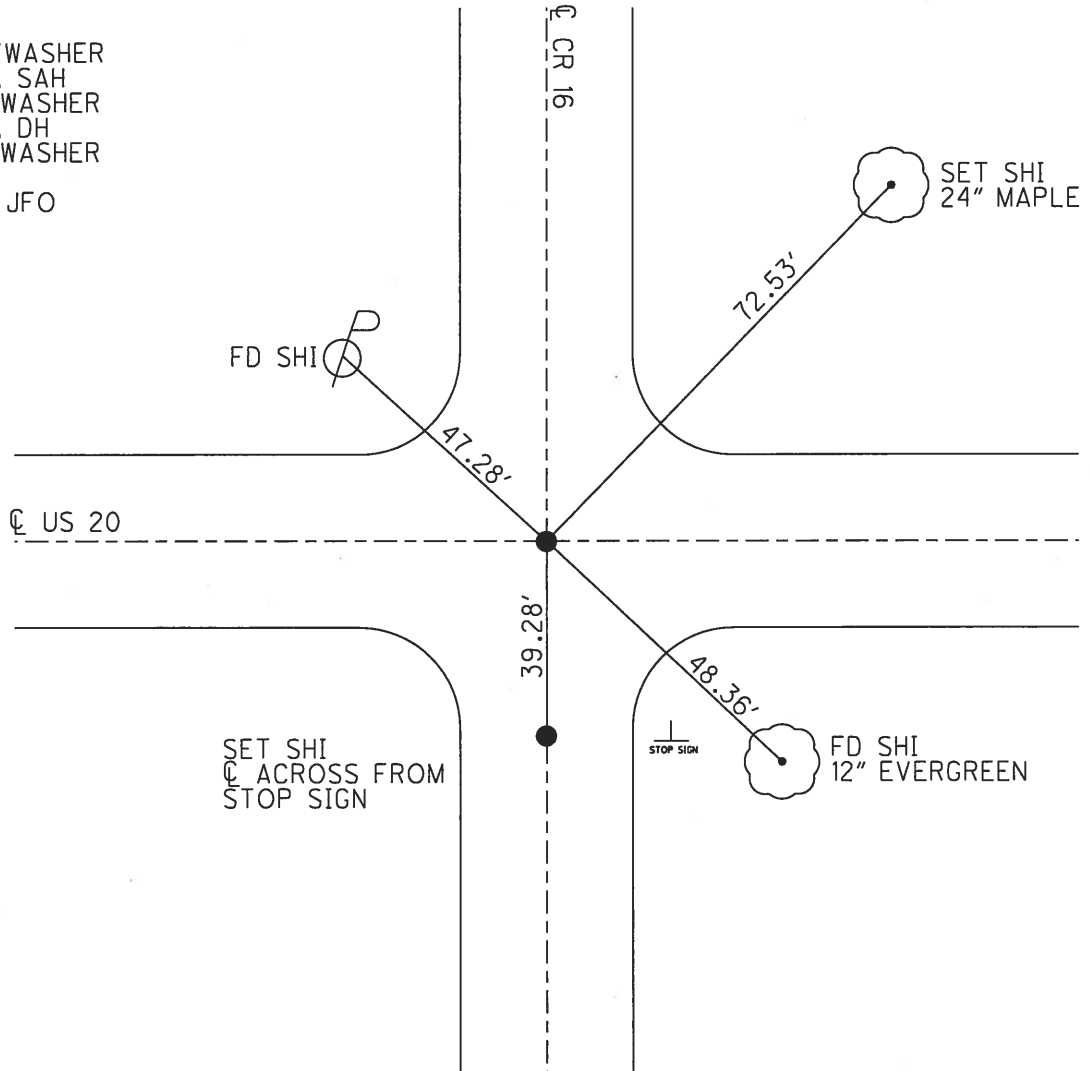

O.D.O.T. DISTRICT 2 SURVEY OFFICE (USE ONLY)

PERSONNEL _____ REFERENCE NO. 27 SHEET 3 OF 5

NOTES HUSS DATE 7/19/00 ROUTE US 20

H.C. CORDES WEATHER PT.CLOUDY,FAIR COUNTY FULTON

R.C. KARGER TEMP. 72° TOWNSHIP CHESTERFIELD

SECTION 21,22,27,28

T 9 S R 2 E

TYPE MONUMENT SM.R.R.SPIKE

~~ON SURFACE~~ - BELOW 2"

LEFT - ☉ PAV'T - RIGHT ON

_____ TO _____ EDGE PAVEMENT

S.L.M. 679+22


GRID: NORTHING: 733707.031 EASTING: 1511751.504

21	22
28	27



SET P.K./WASHER
8/28/00, SAH

*FD PK/W
1-29-13, DCI*

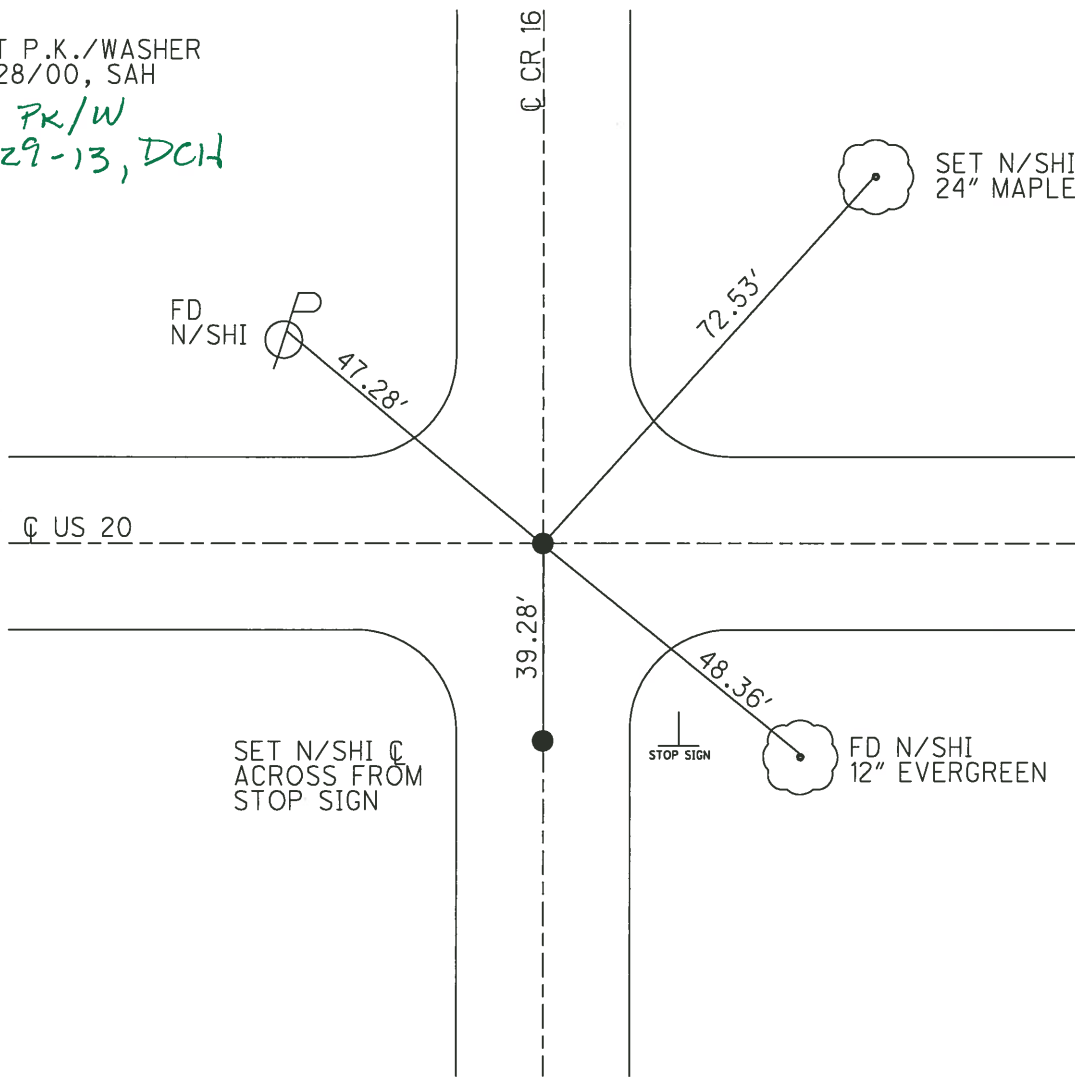

O.D.O.T. DISTRICT 2 SURVEY OFFICE (USE ONLY)

PERSONNEL _____ REFERENCE NO. 27 SHEET 3 OF 5

NOTES HUSS DATE 7/19/00 ROUTE US 20

H.C. CORDES WEATHER PT.CLOUDY,FAIR COUNTY FULTON

R.C. KARGER TEMP. 72° TOWNSHIP CHESTERFIELD

SECTION 21,22,27,28

T 9 S R 2 E

TYPE MONUMENT SM.R.R.SPIKE

~~ON SURFACE~~ - BELOW 2"

LEFT - ☉ PAV'T - RIGHT ON

TO EDGE PAVEMENT


S.L.M. 679+22

GRID: NORTHING: _____ EASTING: _____

21	22
28	27



SET P.K./WASHER
8/28/00, SAH

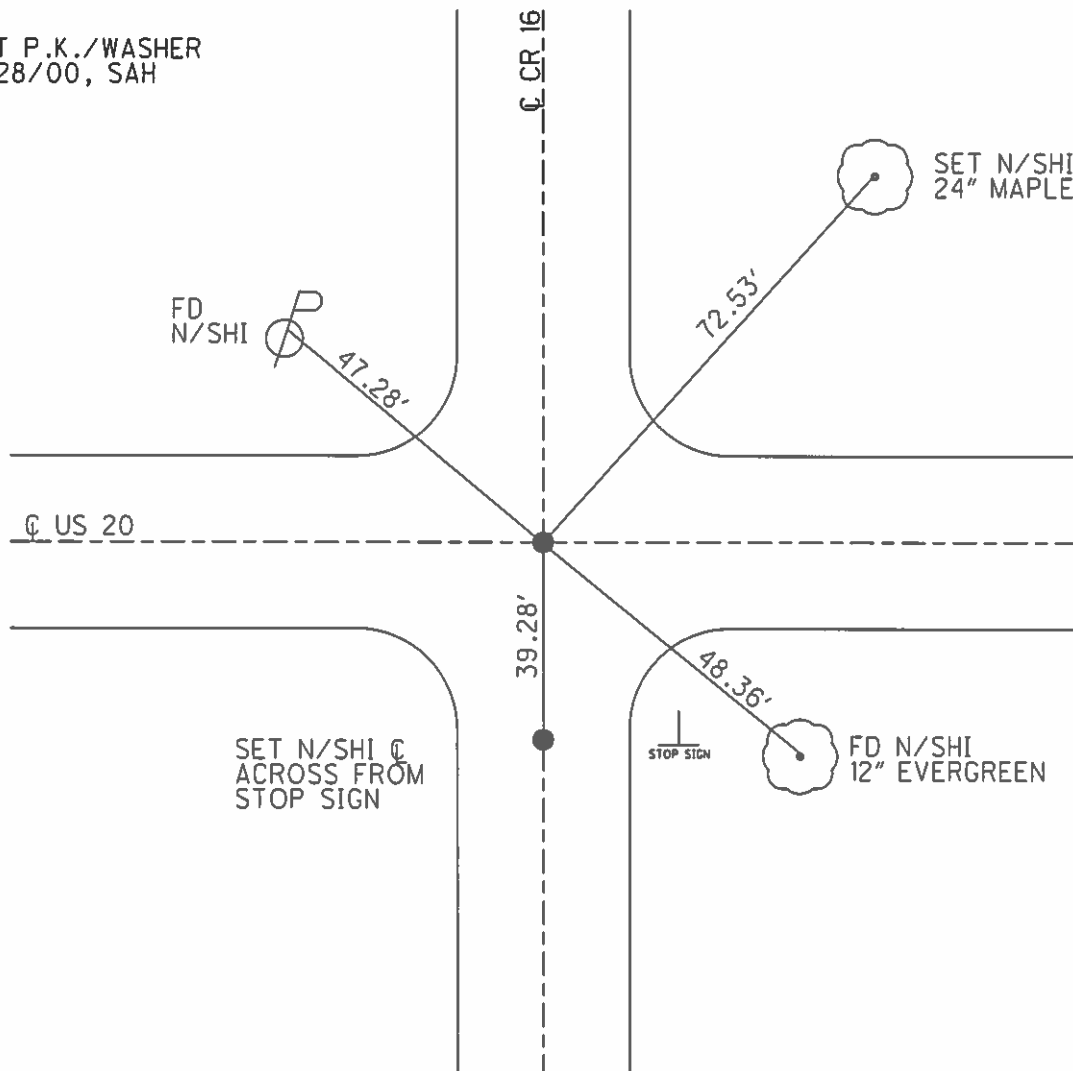

FD N/SHI
47.28'

SET N/SHI
24" MAPLE

☉ US 20

39.28'

STOP SIGN

SET N/SHI ☉
ACROSS FROM
STOP SIGN

FD N/SHI
12" EVERGREEN

O.D.O.T. DISTRICT 2 SURVEY OFFICE

PERSONNEL _____

REFERENCE NO. 27

SHEET 3 OF 4

NOTES Huss

H.C. Cordes

R.C. Karger

DATE 7-19-00

WEATHER Pt Cldy - Fair

TEMP. +72°F

ROUTE US 20

COUNTY FULTON

TOWNSHIP CHESTERFIELD

SECTION 21-22-27-28

T 9 S R 2 E

TYPE MONUMENT Sm. RR Spk.

~~ON SURFACE~~ BELOW 2" Below

~~NEAR~~ CE PAV'T. 4 Pavt.


TO EDGE PAVEMENT

S.L.M. 679+22

21	22
28	27



8-28-00
Set RR/W
SRH

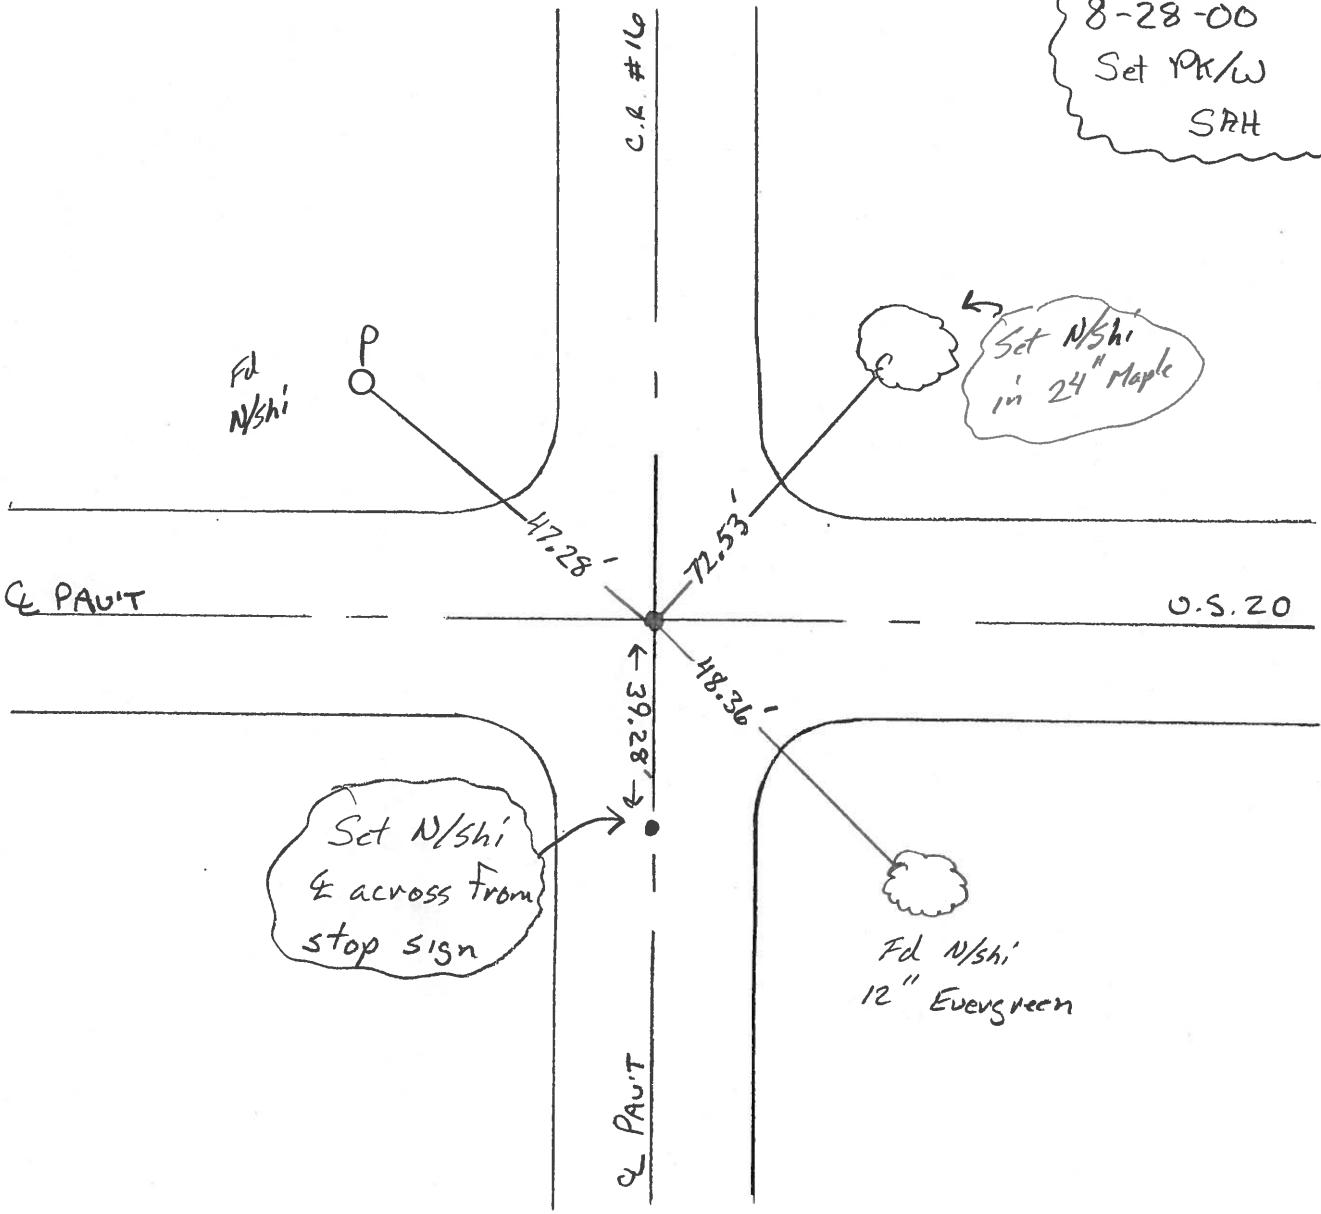

O.D.O.T. DISTRICT 2 SURVEY OFFICE

PERSONNEL _____ REFERENCE NO. 27 SHEET 25 OF _____

NOTES D. CURTIS

H.C. J. HOUSEHOLDER

R.C. _____

DATE 5-13-88

WEATHER MILD

TEMP. 75° ±

ROUTE U.S. #20

COUNTY FULTON

TOWNSHIP CHESTERFIELD

SECTION 21, 22, 27, 28

T. _____ R. _____

TYPE MONUMENT SM. R.R. SPK.


ON SURFACE - BELOW ON SURFACE

LEFT- & PAV'T. - RIGHT & PAV'T.

TO _____ EDGE PAVEMENT

S.L.M. 678 + 79

21	22
28	27

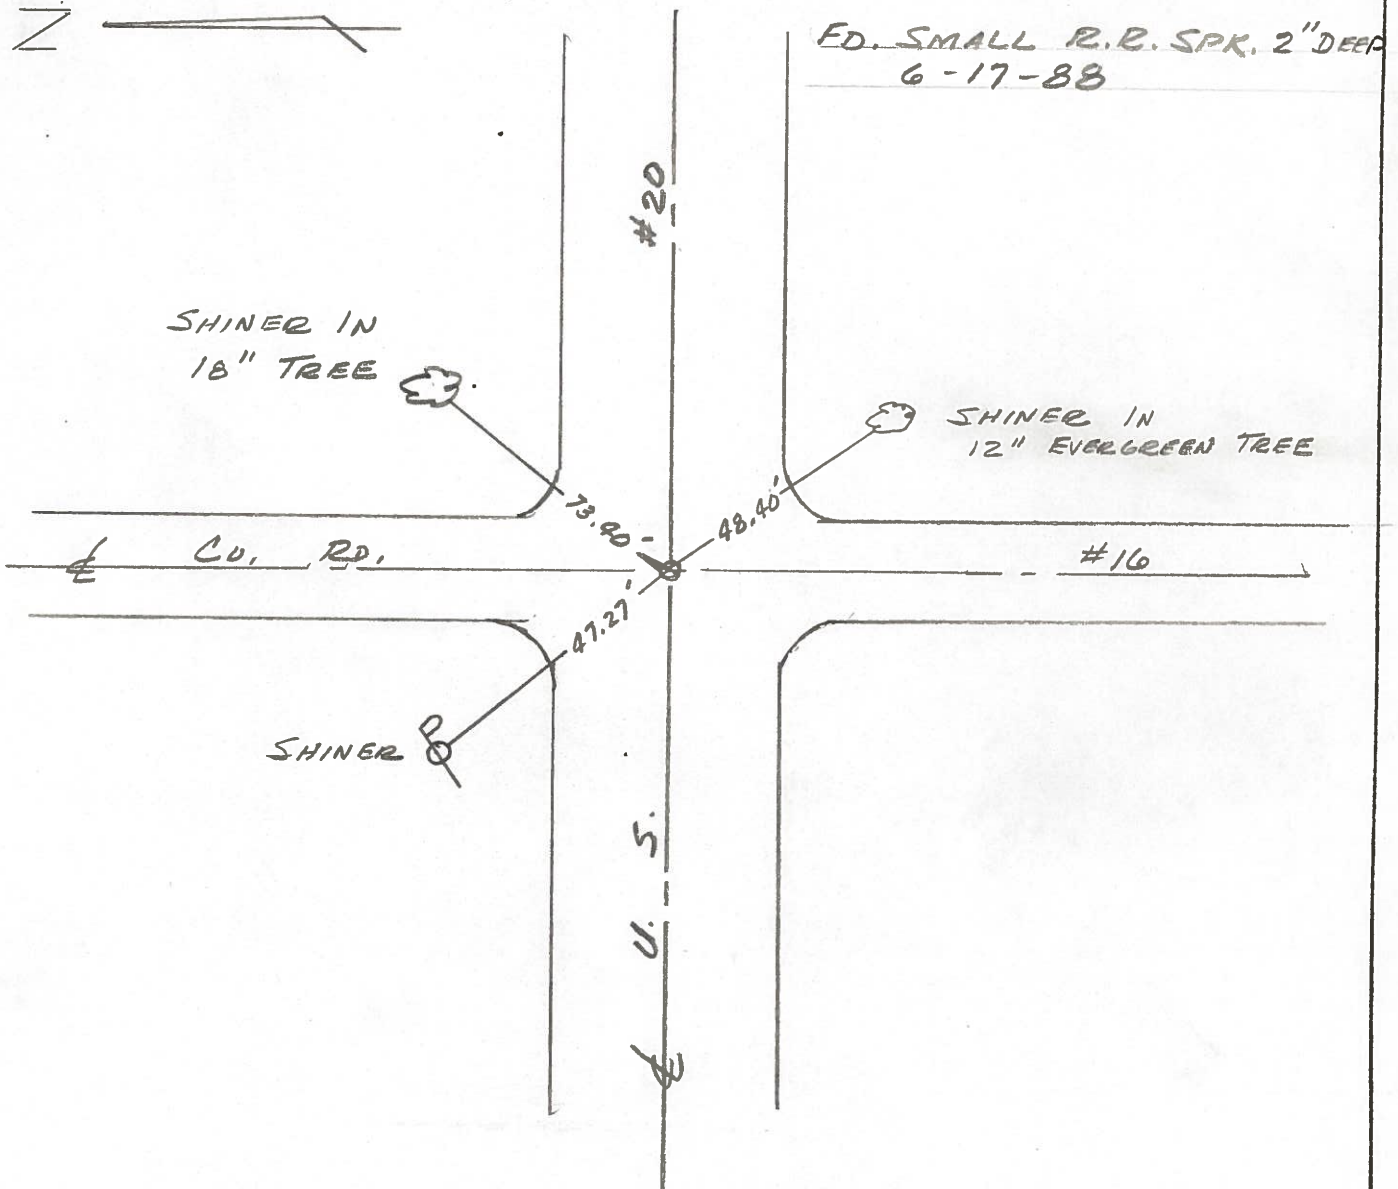

County Fulton S.R. US #20

Date 19 May 82

Township Chesterfield

Weather Windy

Section 21-22-27-28

Temp. 75°

T , N , R , E

Personnel I. Stove

P. Neuser


R. Michalek

D. Curtis

21	22
28	27



REF. No. 27

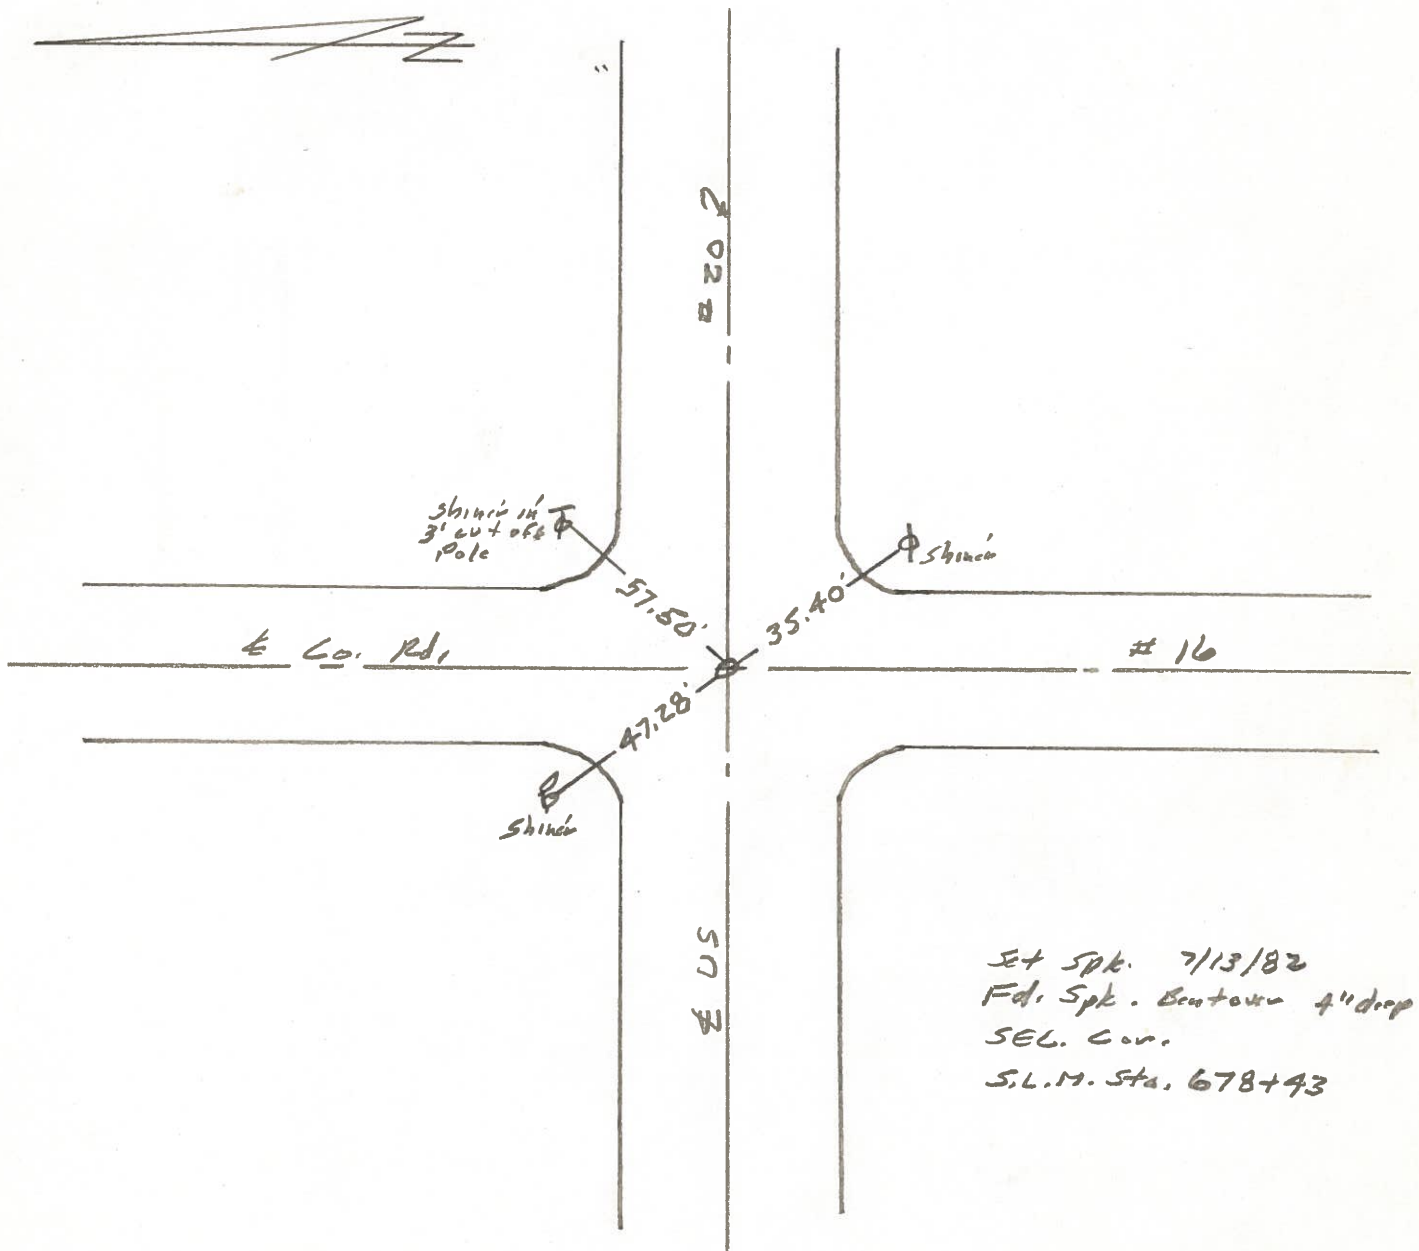

PERSONNEL	TITLE	PERSONNEL	TITLE	COUNTY	DATE	WEATHER	TEMP
TOMSK		Boyle		Fulton	June 11, 1977		
Weuser				S. R. U. S. 20			
Granata				SEC. Chesterfield TWP			
Janyo							

DESCRIPTION _____ LEFT _____ CENTER LINE _____ RIGHT _____ JOB NO. _____

