

O.D.O.T. DISTRICT 2 SURVEY OFFICE (USE ONLY)

PERSONNEL

REFERENCE NO. 27

SHEET 4 OF 4

NOTES LEU

DATE 7-5-18

ROUTE US 20

H.C. LEU

WEATHER PT.CLOUDY,FAIR

COUNTY FULTON

R.C. HAGEMEYER

TEMP. 84°F

TOWNSHIP CHESTERFIELD

DWG BY JAMES

PID 101272

SECTION 21

T 9 N R 2 E

TYPE MONUMENT P.K./WASHER

ON SURFACE - ~~BELOW~~ ON

OFFSET Q PAVEMENT 1.1' ~~LT~~ : RT

TO EDGE PAVEMENT


STATION: 679+22

HORZ.DATUM: NAD83 2011


GEOID: NAVD88 2012A

GRID: NORTHING: 733707.091

EASTING: 1511751.563

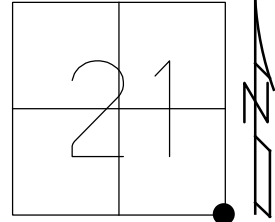

RECORD:
 SET P.K./WASHER
 8-28-00, SAH
 FD PK/WASHER
 CP2
 1-29-13, DH
 REF27
 9/22/15, JFO
 7-5-18, JLL
 SET MAG/WASHER
 4-9-19, JLL
 FD MAG/WASHER
 7/5/22, DSA

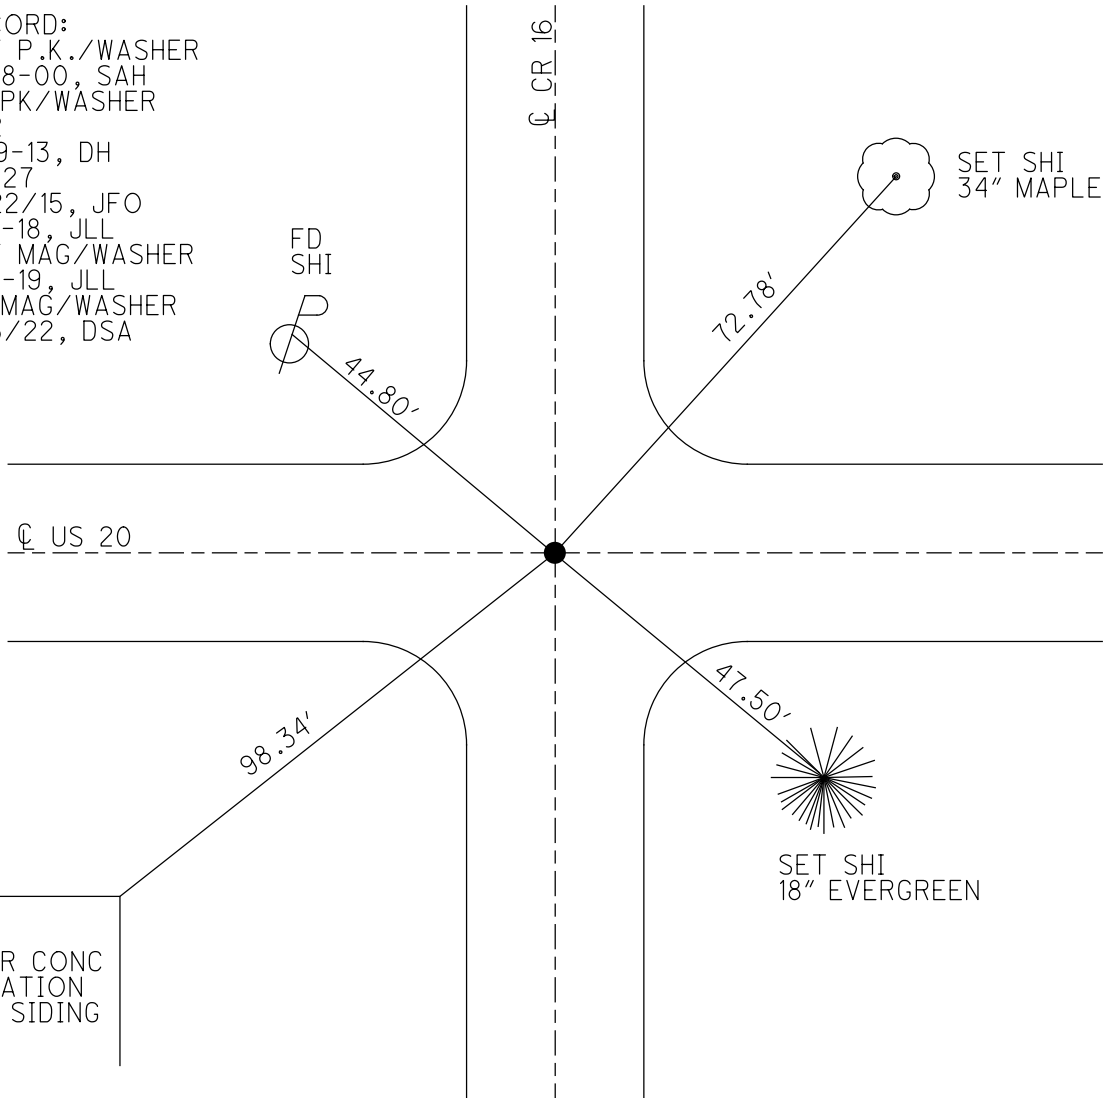

O.D.O.T. DISTRICT 2 SURVEY OFFICE (USE ONLY)

PERSONNEL

REFERENCE NO. 28

SHEET 2 OF 21

NOTES HAGEMEYER

DATE 7-5-18

ROUTE US 20

H.C. LEU

WEATHER SUNNY/HUMID

COUNTY FULTON

R.C. HAGEMEYER

TEMP. 86°F

TOWNSHIP CHESTERFIELD

SECTION 22

DWG BY JAMES

PID 101272

T 9 N R 2 E

TYPE MONUMENT P.K. NAIL

~~ON SURFACE~~ - BELOW 3"

OFFSET Q PAVEMENT 0.3' LT : RT

12.7' TO LT EDGE PAVEMENT



STATION: 726+52.83

HORZ.DATUM: NAD83 2011

GEOID: NAVD88 2012A

GRID: NORTHING: 733768.858

EASTING: 1517061.539

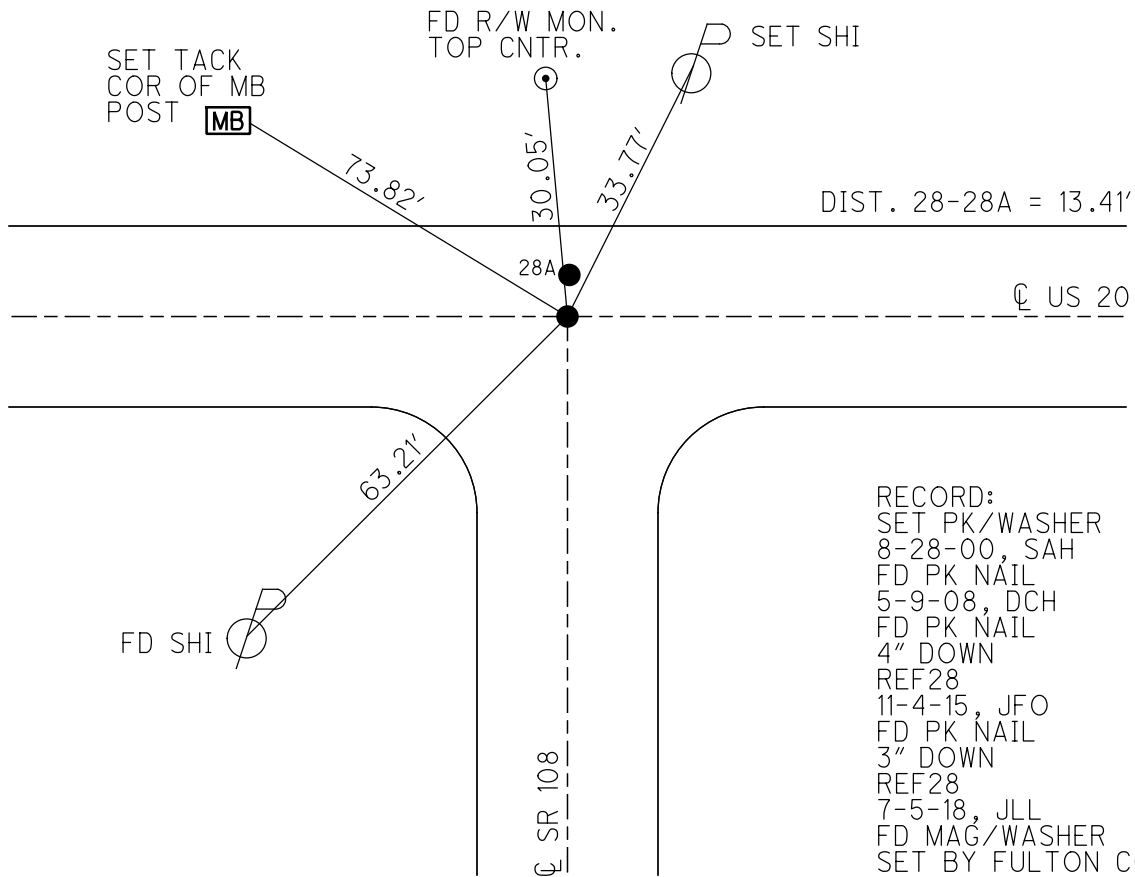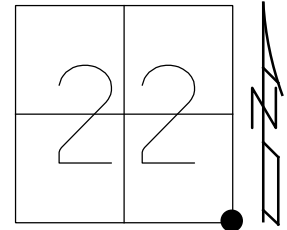


RECORD:
 SET PK/WASHER
 8-28-00, SAH
 FD PK NAIL
 5-9-08, DCH
 FD PK NAIL
 4" DOWN
 REF28
 11-4-15, JFO
 FD PK NAIL
 3" DOWN
 REF28
 7-5-18, JLL
 FD MAG/WASHER
 SET BY FULTON CO.
 4-26-19, JLL


O.D.O.T. DISTRICT 2 SURVEY OFFICE (USE ONLY)

PERSONNEL _____ REFERENCE NO. 28 SHEET 2 OF 21
 NOTES HOMAN DATE 5/9/08 ROUTE US 20
 H.C. HOMAN WEATHER CLOUDY COUNTY FULTON
 R.C. ROUSOS TEMP. 58° TOWNSHIP CHESTERFIELD
 _____ SECTION 22
 _____ T 9 S R 2 E

TYPE MONUMENT _____ P.K.NAIL _____
~~ON SURFACE~~ - BELOW _____ 1"
~~LEFT -~~ ☉ PAV'T - ~~RIGHT~~ _____ ON _____
 _____ TO _____ EDGE PAVEMENT
 S.L.M. 726+52.83
 GRID: NORTHING: 733768.851 EASTING: 1517061.550

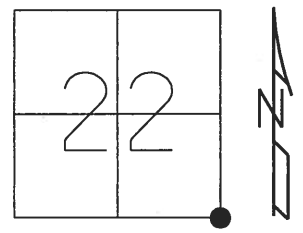

RECORD:
 SET P.K./WASHER
 8/28/00, SAH
 FD P.K. NAIL
 5/09/08, DCH
 FD P.K. NAIL
 4" DOWN
 REF28
 11-4-15, JFO

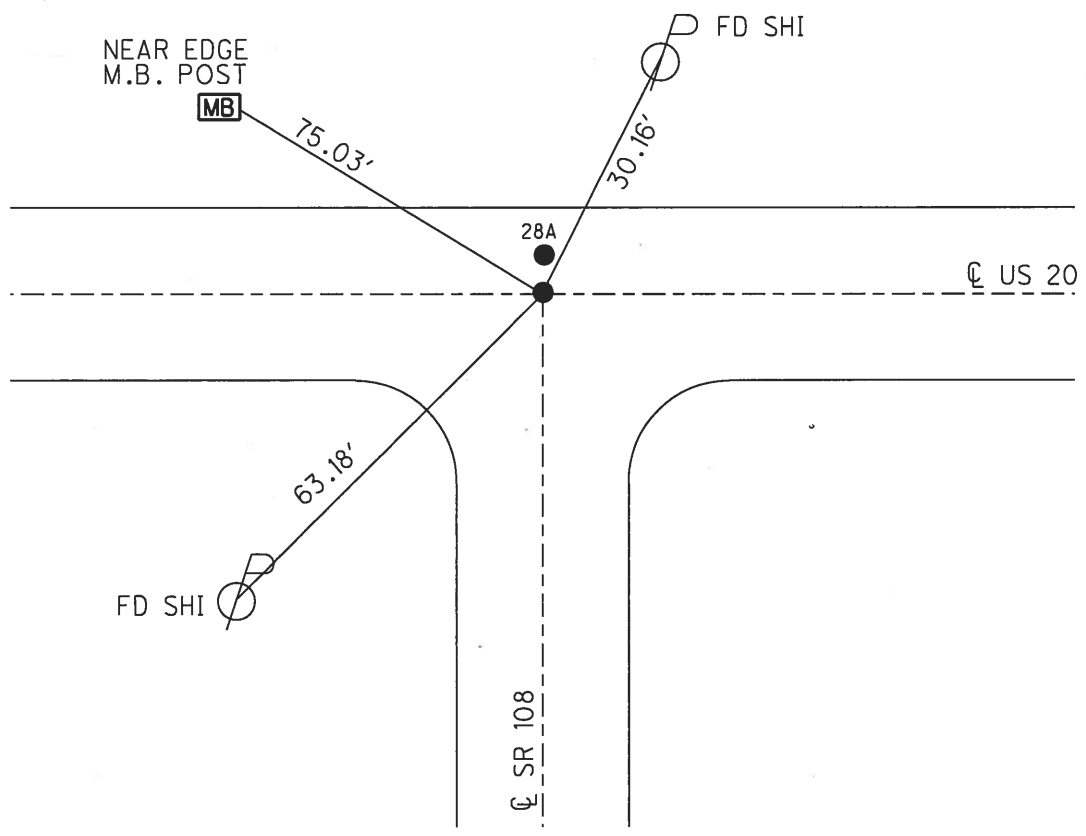

O.D.O.T. DISTRICT 2 SURVEY OFFICE (USE ONLY)

PERSONNEL _____ REFERENCE NO. 28 SHEET 4 OF 5
 NOTES HOMAN DATE 5/9/08 ROUTE US 20
 H.C. HOMAN WEATHER CLOUDY COUNTY FULTON
 R.C. ROUSOS TEMP. 58° TOWNSHIP CHESTERFIELD
 SECTION 22-23-26-27
 T 9 S R E

TYPE MONUMENT P.K.NAIL
~~ON SURFACE~~ - BELOW 1"
~~LEFT~~ - ☉ PAV'T - ~~RIGHT~~ ON
_____ TO _____ EDGE PAVEMENT
 S.L.M. 726+52.80


22	23
27	26



GRID: NORTHING: 733768.837 EASTING: 1517061.525

SET P.K./WASHER
 8/28/00
 SAH

FD P.K. NAIL
 5/09/08
 DCH

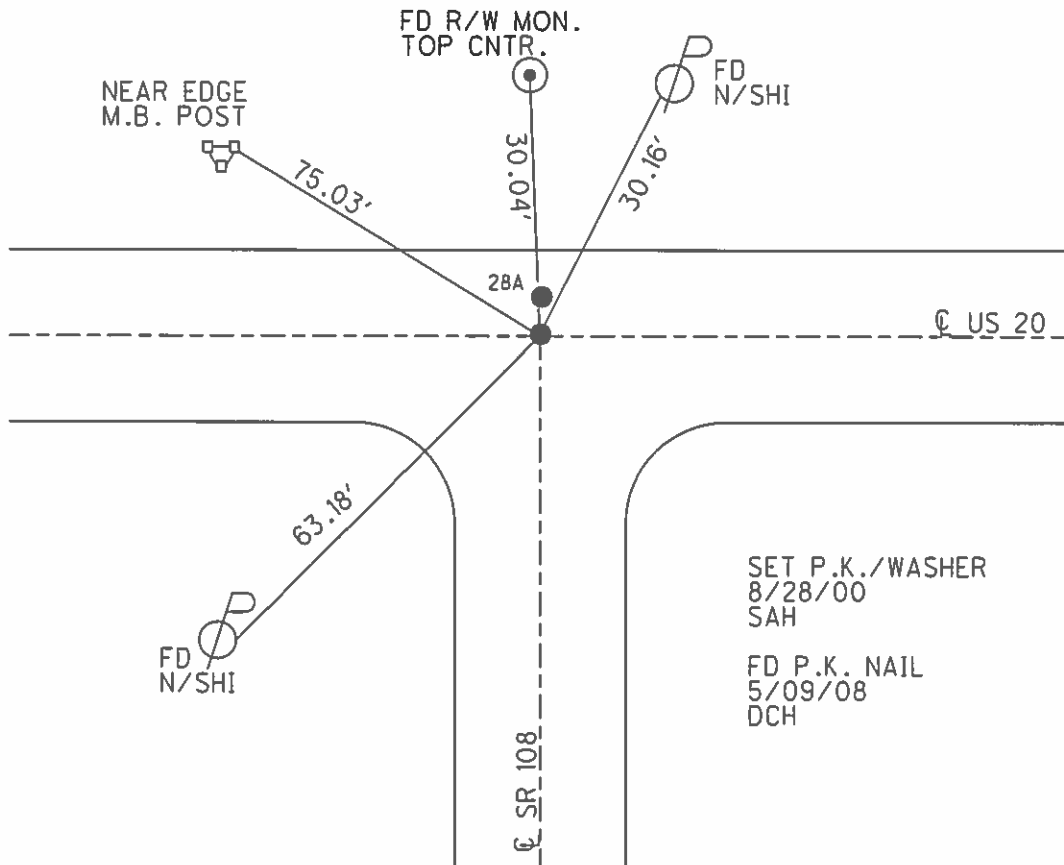

O.D.O.T. DISTRICT 2 SURVEY OFFICE

PERSONNEL _____

REFERENCE NO. 28

SHEET 4 OF 4

NOTES Huss

H.C. Cordes

R.C. Karger

DATE 7-19-00

WEATHER Pt Cldy - Rain

TEMP. +72°F

ROUTE U.S. 20

COUNTY FULTON

TOWNSHIP CHESTERFIELD

SECTION 22-23-26-27

T 9 S R 2 E

TYPE MONUMENT PK/w

~~ON SURFACE~~ - BELOW 1" below

~~TO~~ - PAV'T. - ~~PAV'T.~~ to Paut.


TO EDGE PAVEMENT

S.L.M. 732 + 52

22	23
27	26



Set PK/w
8-28-00
SAH

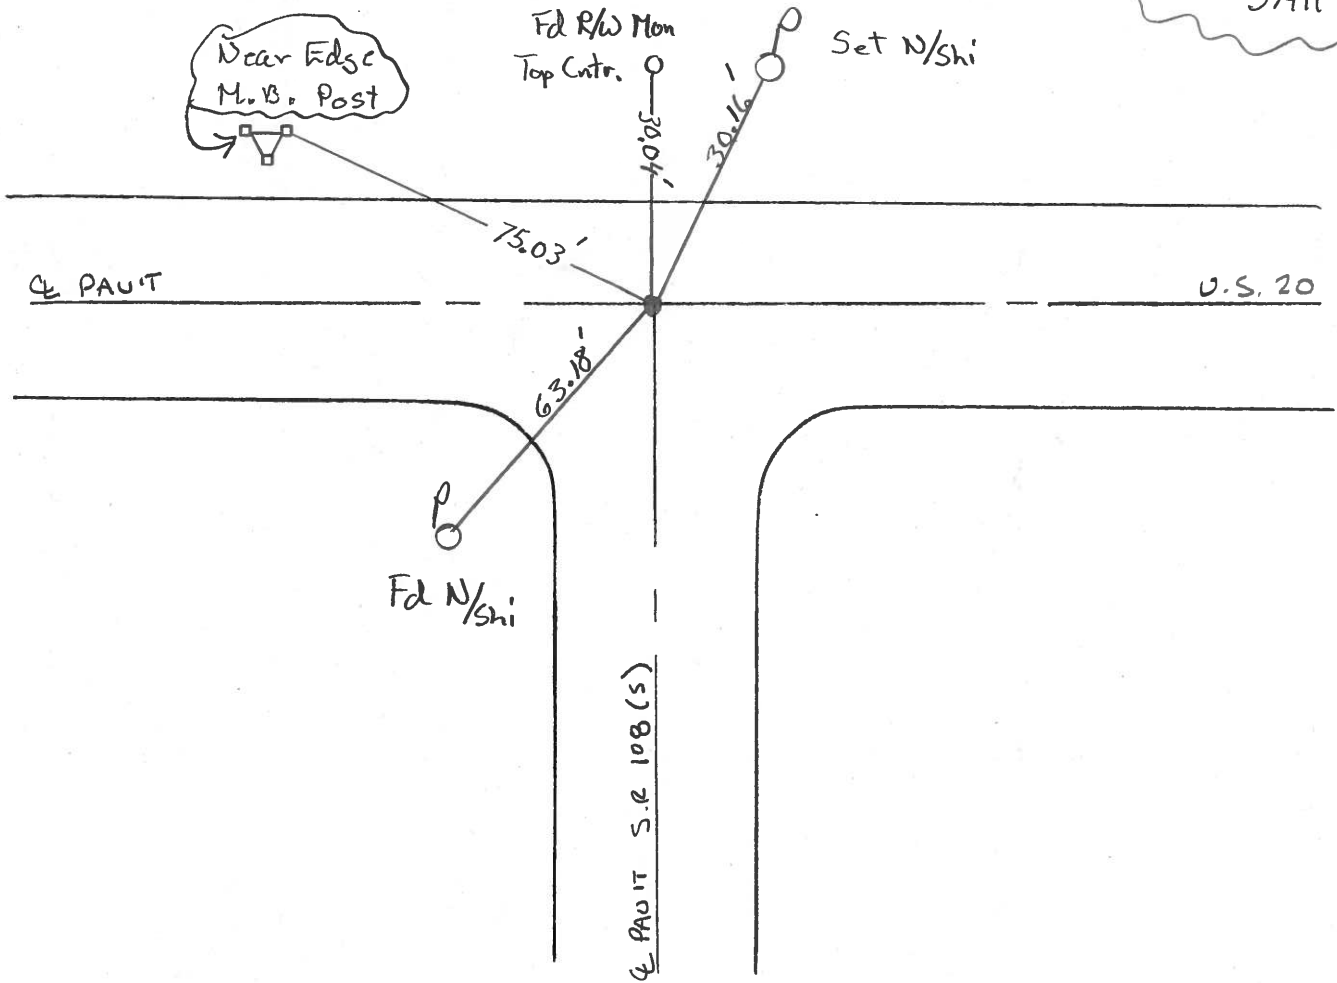

O.D.O.T. DISTRICT 2 SURVEY OFFICE

PERSONNEL _____ REFERENCE NO. 28 SHEET 27 OF _____

NOTES D. CURTIS

H.C. J. HOUSEHOLDER DATE 5-13-88

R.C. _____ WEATHER MILD

_____ TEMP. 75° ±

ROUTE U.S. #20

COUNTY FULTON

TOWNSHIP CHESTERFIELD

SECTION 22-23-26-27

T _____ R _____

TYPE MONUMENT P.K. NAIL


ON SURFACE - ~~BELOW~~ ON SURFACE

LEFT - ~~☉~~ PAV'T. - RIGHT ☉ PAV'T.


_____ TO _____ EDGE PAVEMENT

S.L.M. 731 + 89

22	23
27	26

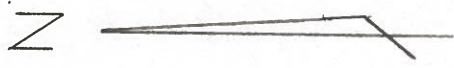

SET P.K. NAIL TO SURFACE
6-17-88

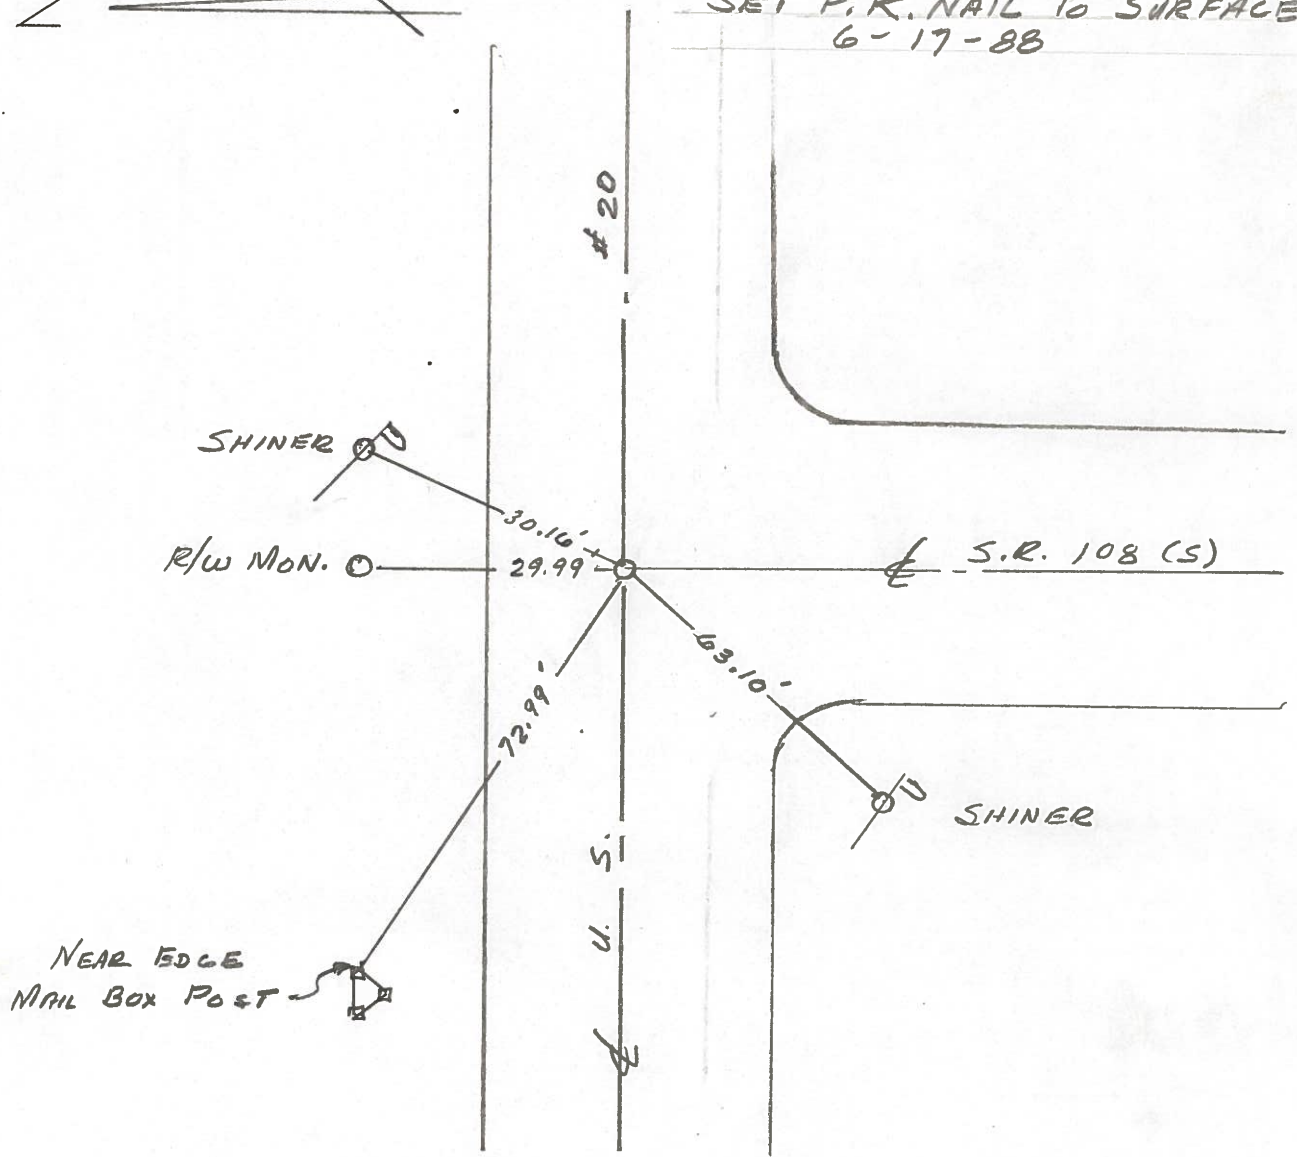

County Fulton S.R. US#20

Date 19 May 82

Township Chesterfield

Weather Warm

Section _____

Temp. 79°

T, N, R, E

Personnel J. Stone

22	23
27	26




P. Newson

R. Micholok

D. Curtis

REF. NO. 28

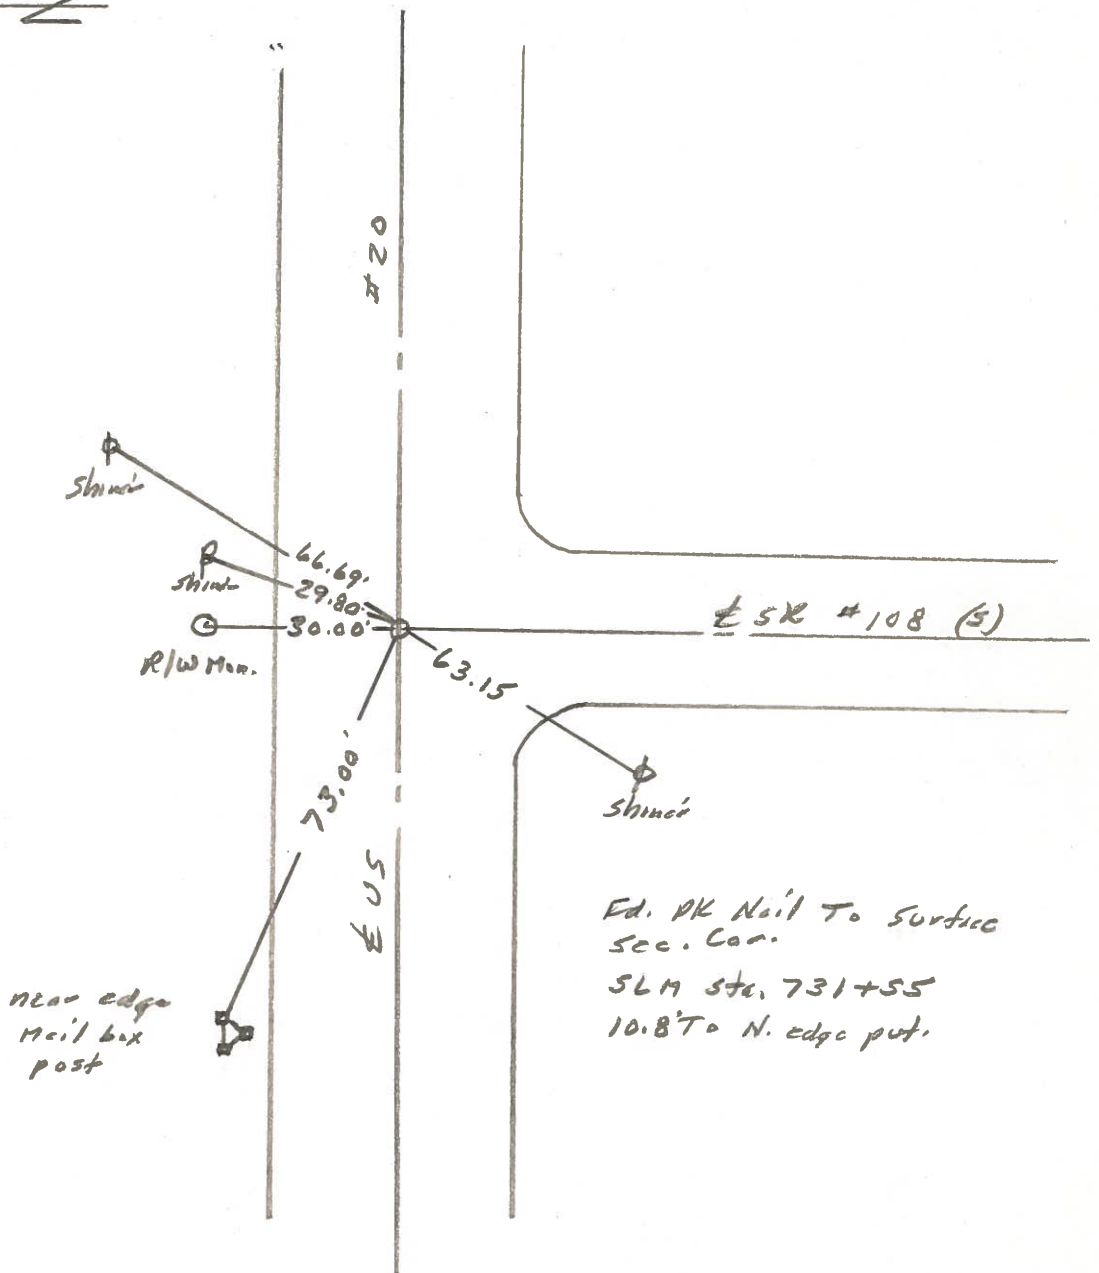

PERSONNEL	TITLE	PERSONNEL	TITLE	COUNTY	DATE	WEATHER	TEMP.
TOMSK		Boyle		Fulton	June 11, 1972		
Weuser				U.S. 20			
Granata				Chesterfield TWP			
Janya							

DESCRIPTION LEFT CENTER LINE RIGHT JOB NO.

