

**O.D.O.T. DISTRICT 2 SURVEY OFFICE (USE ONLY)**

PERSONNEL \_\_\_\_\_ REFERENCE NO. 29A SHEET 5 OF 21

NOTES RHOADES DATE 7/2/18 ROUTE US 20

H.C. O'DONNELL WEATHER CLOUDY COUNTY FULTON

R.C. RENKA TEMP. 78° TOWNSHIP CHESTERFIELD

SECTION 23

T 9 S R 2 E

TYPE MONUMENT \_\_\_\_\_ MAG/WASHER \_\_\_\_\_


ON SURFACE - ~~BELOW~~ \_\_\_\_\_ ON \_\_\_\_\_

LEFT - ☉ PAV'T - ~~RIGHT~~ \_\_\_\_\_ 19.89'

\_\_\_\_\_ TO \_\_\_\_\_ EDGE PAVEMENT


S.L.M. 752+95.88

GRID: NORTHING: 733816.206 EASTING: 1519704.141

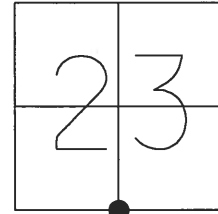

29 TO 29A = 19.89'

- RECORD:  
 SET P.K.NAIL  
 8-5-87  
 FD P.K. NAIL  
 5-9-09, DCH  
 (PER FULTON CO. SEC.COR.)  
 5-26-08, DCH  
 RESET MAG/WASHER  
 8-3-09, DCH  
 DNF  
 3-29-15, JFO  
 DMF  
 9-22-15, JFO  
 FD HOLE W/2 TIES  
 11-4-15, JFO  
 SET MAG/WASHER  
 7-2-18, JFO

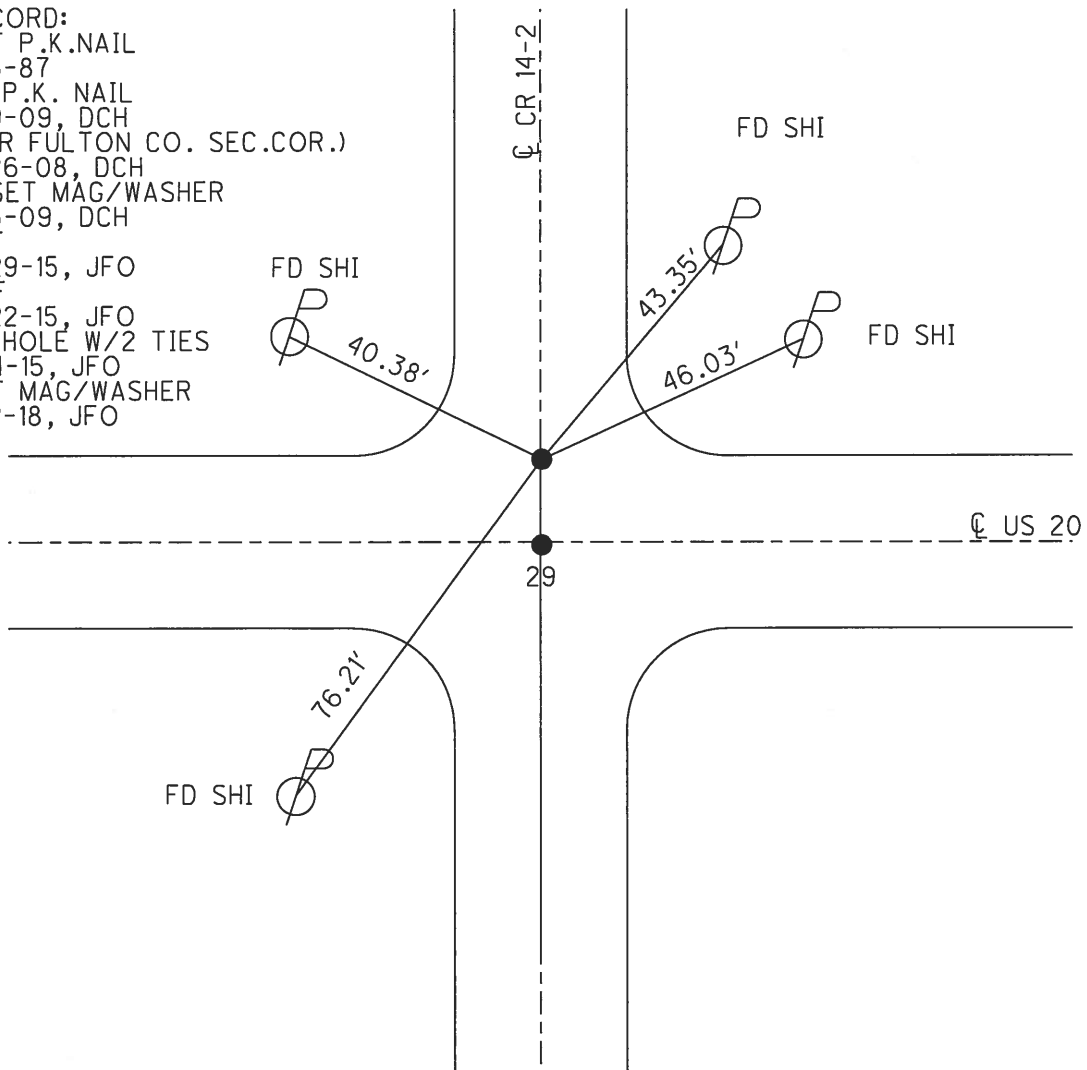

**O.D.O.T. DISTRICT 2 SURVEY OFFICE (USE ONLY)**

PERSONNEL \_\_\_\_\_ REFERENCE NO. 29A SHEET 2 OF 17

NOTES ROUSOS DATE 5-26-09 ROUTE US 20

H.C. HOMAN WEATHER CLEAR COUNTY FULTON

R.C. ROUSOS TEMP. 68° TOWNSHIP CHESTERFIELD

SECTION 26

T 9 S R 2 E

TYPE MONUMENT P.K.NAIL


ON SURFACE - ~~BELOW~~ ON \_\_\_\_\_

LEFT - ☉ PAV'T - ~~RIGHT~~ 19.89'

\_\_\_\_\_ TO \_\_\_\_\_ EDGE PAVEMENT

S.L.M. 752+75.99


GRID: NORTHING: 733816.206 EASTING: 1519704+141

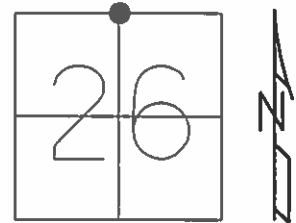

SET P.K.NAIL  
TO SURFACE  
8/5/87

FD P.K. NAIL 5/9/09 DCH  
(PER FULTON CO. SEC. COR.)  
5/26/08 DCH

RESET MAG/WASHER  
8/3/09 DCH

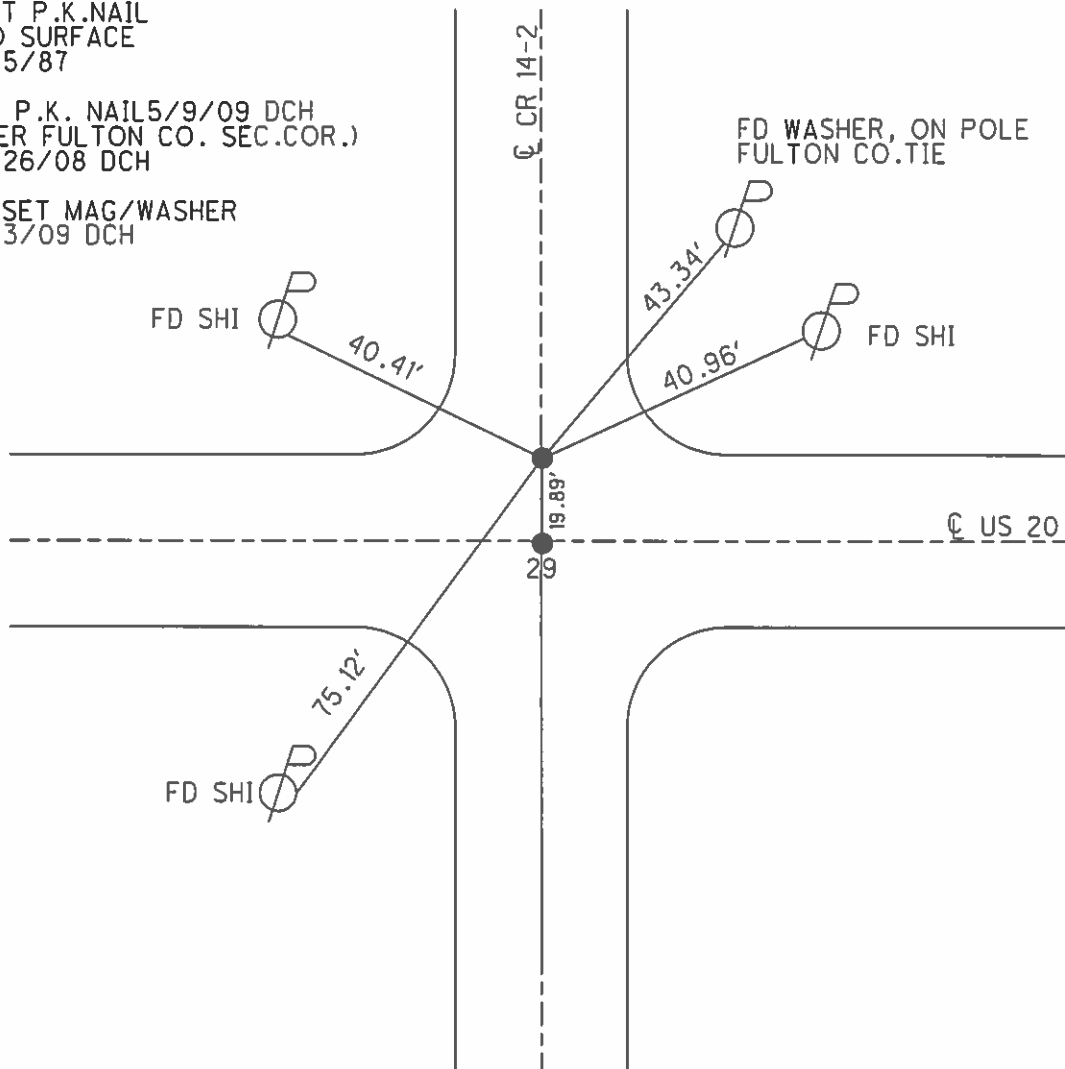

County FULTON S.R. U.S. 20

Date 3-10-80

Township CHESTERFIELD

Weather CLEAR

Section 26

Temp. +30°

T2 R2E


Personnel BOWERS

MEAD


\_\_\_\_\_

\_\_\_\_\_

\_\_\_\_\_

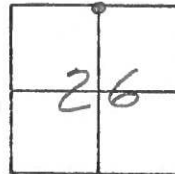

#29

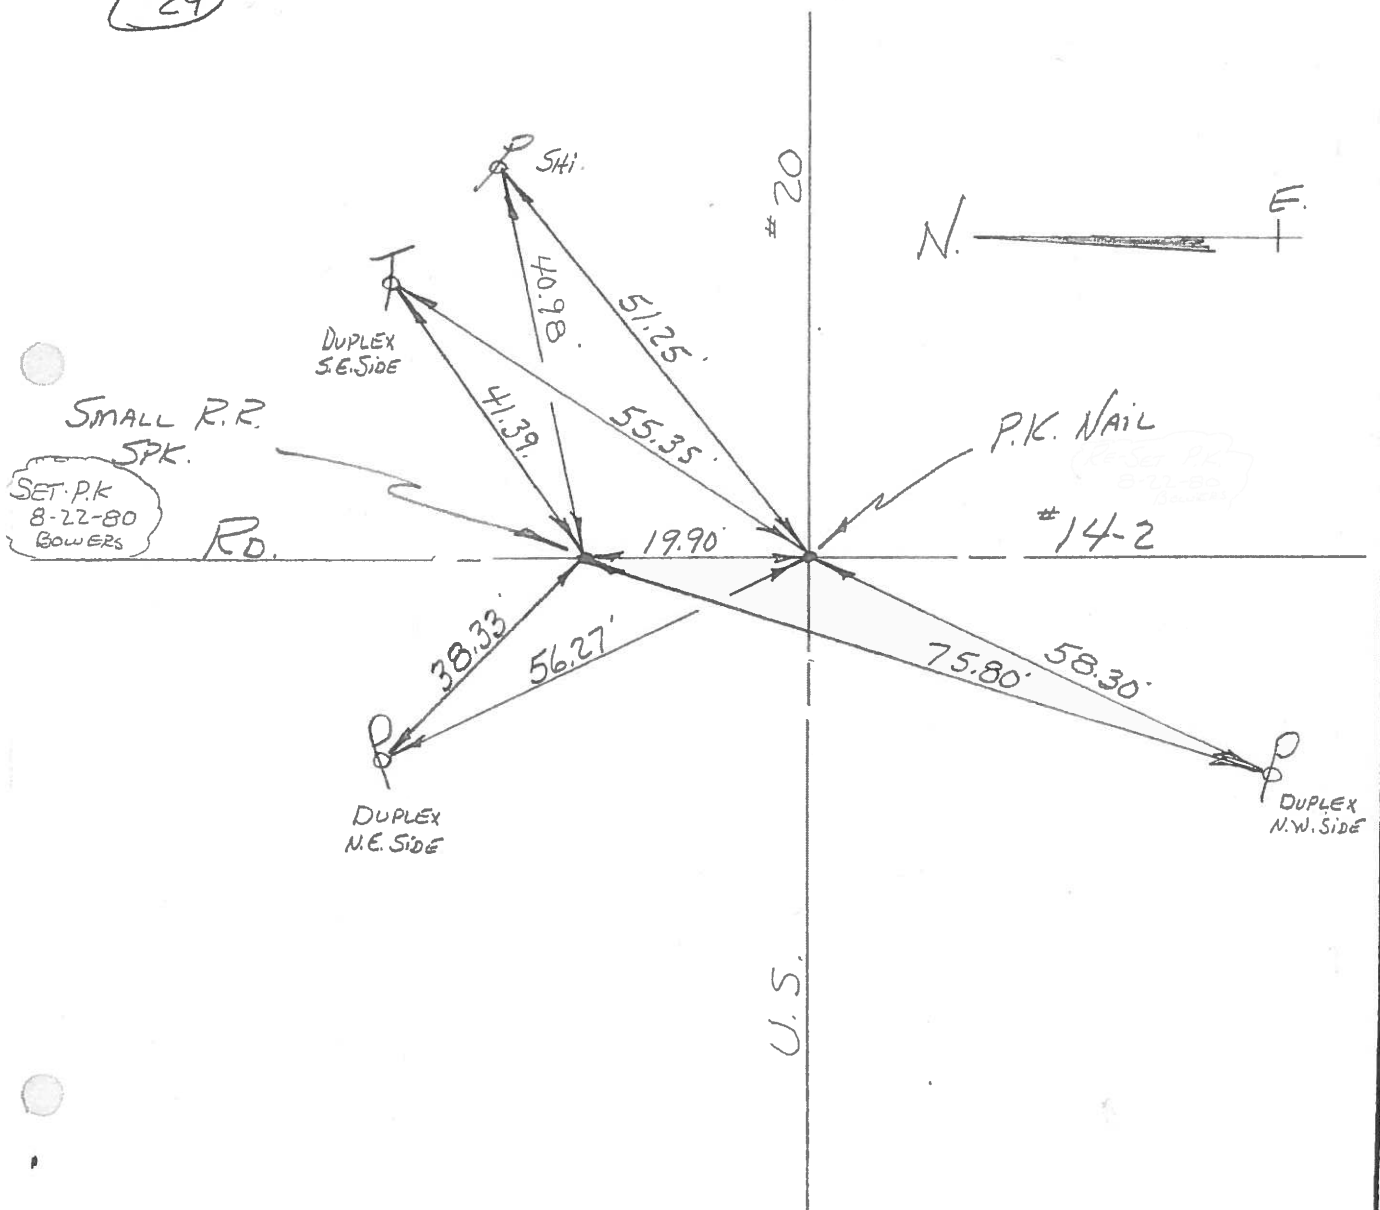

PERSONNEL	TITLE	PERSONNEL	TITLE	COUNTY	DATE	WEATHER	TEMP.
Tomsic		Boyle		Fulton	June 12, 1977		
Weuser				U.S. 20			
Granata				SEC. Chesterfield TWP.			
Janyo							

DESCRIPTION \_\_\_\_\_ LEFT \_\_\_\_\_ CENTER LINE \_\_\_\_\_ RIGHT \_\_\_\_\_ JOB NO. \_\_\_\_\_

