

O.D.O.T. DISTRICT 2 SURVEY OFFICE (USE ONLY)

PERSONNEL \_\_\_\_\_ REFERENCE NO. 30 SHEET 6 OF 21

NOTES RHOADES \_\_\_\_\_ DATE 3/29/17 ROUTE US 20  
 H.C. O'DONNELL \_\_\_\_\_ WEATHER CLEAR COUNTY FULTON  
 R.C. HELDMAN \_\_\_\_\_ TEMP. 40° TOWNSHIP CHESTERFIELD  
 \_\_\_\_\_ SECTION 23  
 \_\_\_\_\_ T 9 S R 2 E

TYPE MONUMENT \_\_\_\_\_ MAG/WASHER \_\_\_\_\_


ON SURFACE - ~~BELOW~~ \_\_\_\_\_ ON \_\_\_\_\_

LEFT - ☉ PAV'T - ~~RIGHT~~ \_\_\_\_\_ 0.6' \_\_\_\_\_

\_\_\_\_\_ TO \_\_\_\_\_ EDGE PAVEMENT


S.L.M. 779+24.48

GRID: NORTHING: 733812.311 EASTING: 1522333.017

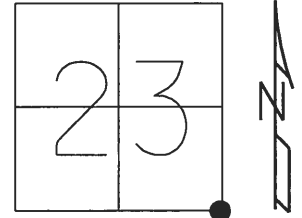

30 TO 30 A = 26.69'

RECORD:  
 SET P.K. NAIL  
 TO SURFACE  
 8-5-87  
 FD P.K. NAIL  
 5-9-08, DCH  
 SET MAG/WASHER  
 8-3-09, DCH  
 FD MAG/WASHER  
 REF30  
 9-22-15, JFO  
 SET MAG/WASHER  
 6-25-18, JLL

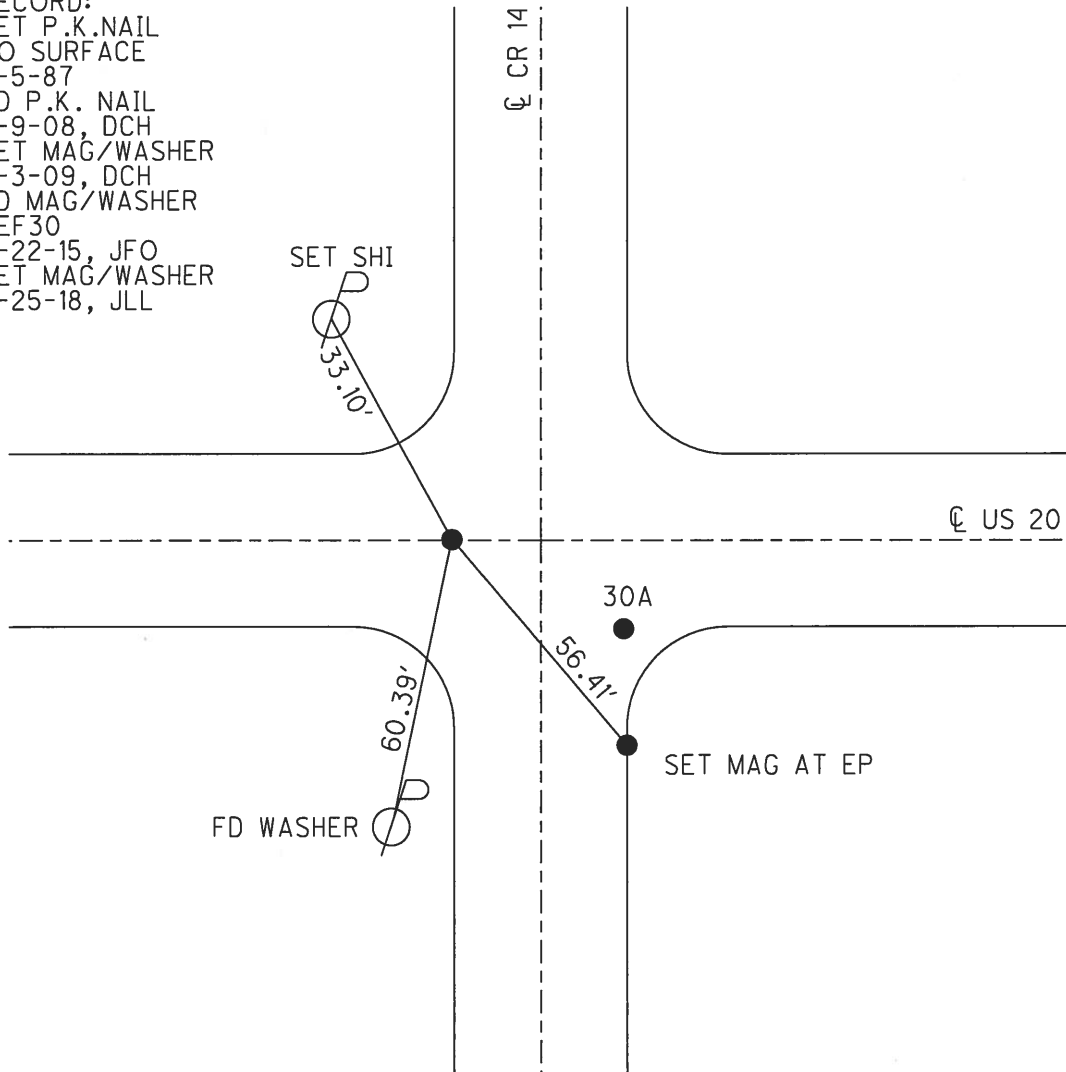


**O.D.O.T. DISTRICT 2 SURVEY OFFICE (USE ONLY)**

PERSONNEL \_\_\_\_\_ REFERENCE NO. 30 SHEET 3 OF 17

NOTES ROUSOS DATE 5/26/09 ROUTE US 20  
 H.C. HOMAN WEATHER CLEAR COUNTY FULTON  
 R.C. ROUSOS TEMP. 68° TOWNSHIP CHESTERFIELD  
 \_\_\_\_\_ SECTION 26  
 \_\_\_\_\_ T 9 S R 2 E

TYPE MONUMENT P.K.NAIL  
 ON SURFACE - ~~BELOW~~ ON \_\_\_\_\_  
 LEFT - ☉ PAV'T - RIGHT ON, 13" L. OF ☉ CR 14  
 \_\_\_\_\_ TO \_\_\_\_\_ EDGE PAVEMENT  
 S.L.M. 779+24.51

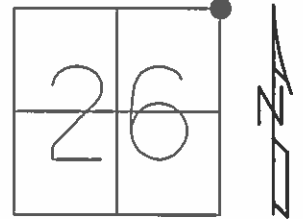


GRID: NORTHING: 733812.317 EASTING: 1522332.995

SET P.K.NAIL  
 TO SURFACE  
 8/5/87

FD P.K. NAIL  
 5/9/08 DCH

RESET MAG/WASHER  
 8/3/09 DCH

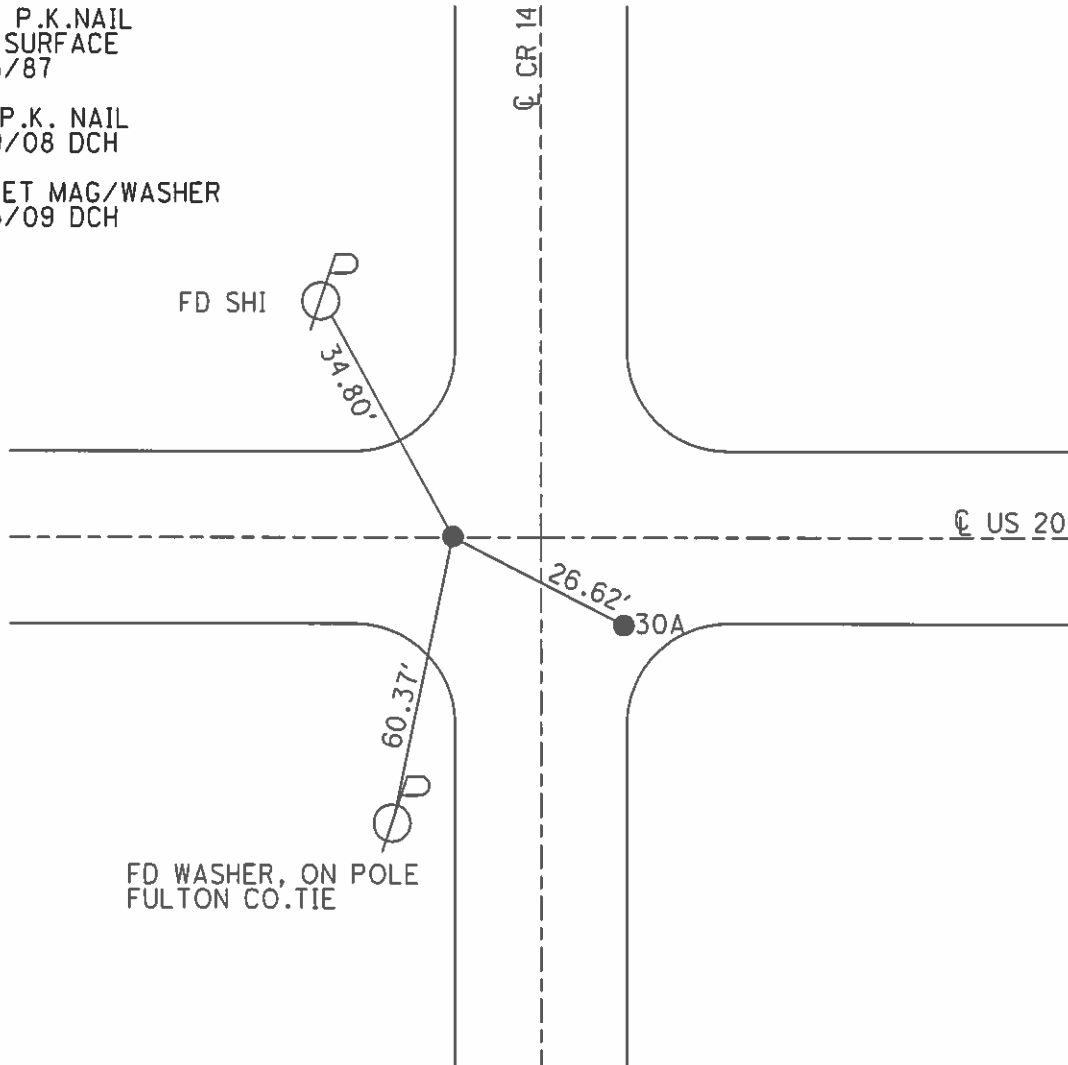

O.D.O.T. DISTRICT 2 SURVEY OFFICE

PERSONNEL

REFERENCE NO. 30

SHEET 2 OF 12

NOTES J. Householder

H.C. D. Curtis

DATE March 5, 1986

ROUTE U.S. 20

R.C. I. Stone

WEATHER Cloudy

COUNTY Fulton

R. Michalak

TEMP. 35°

TOWNSHIP Chesterfield

SECTION 26

T.      R.     


TYPE MONUMENT P.K. NAIL

ON SURFACE - BELOW Surface


LEFT -      PAV'T. - RIGHT     

TO      EDGE PAVEMENT

S.L.M. 785 + 07

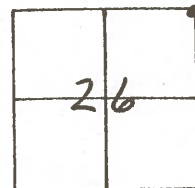

SET P.K. NAIL TO SURFACE  
8-5-87

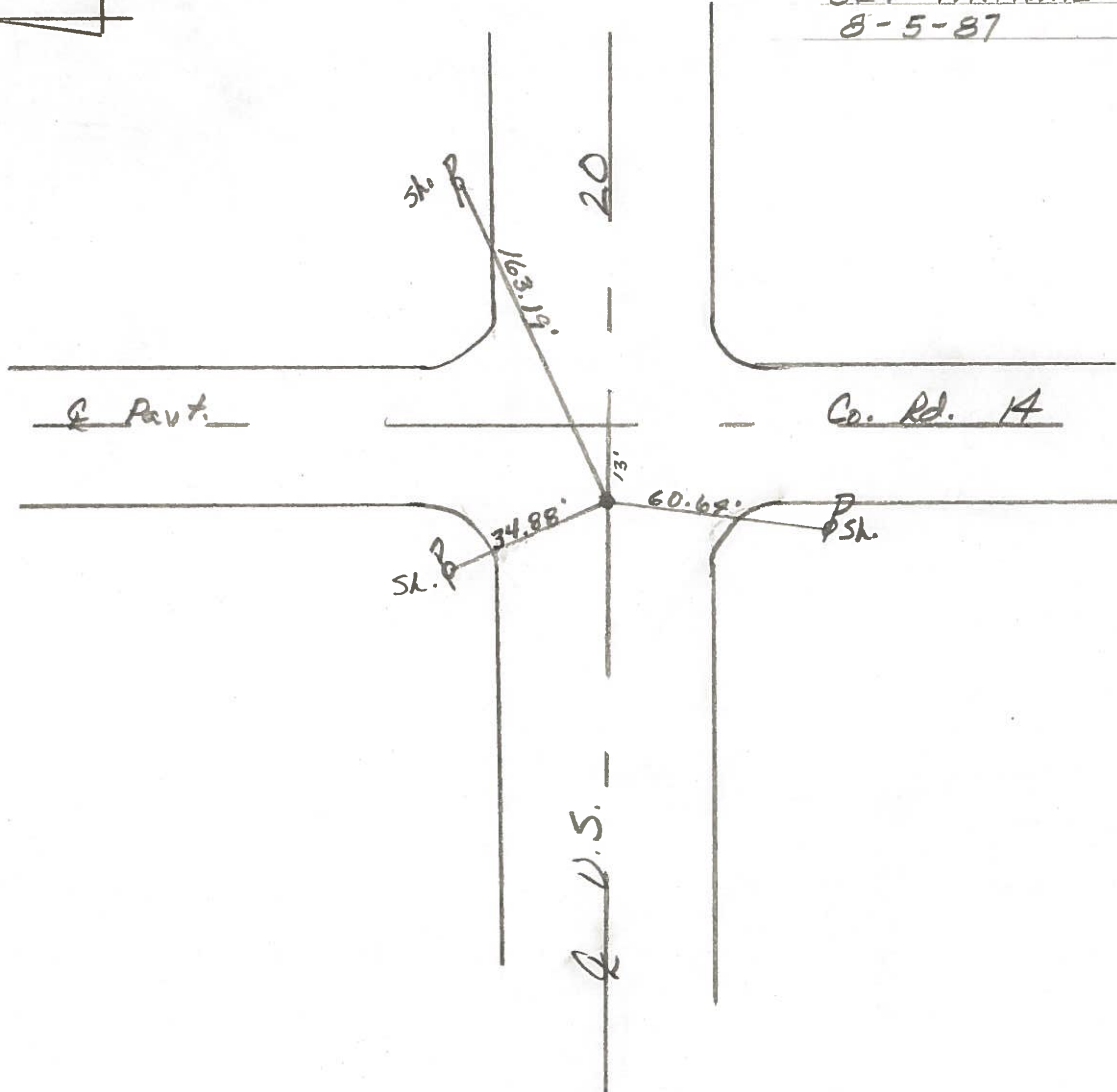

County FULTON S.R. U.S. 20

Date 3-10-80

Township CHESTERFIELD


Weather CLEAR

Section 26


Temp. +30°

T9 ~~R~~ 5 R 2 E

Personnel BOWERS  
MEAD

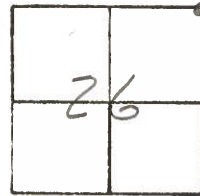

#30

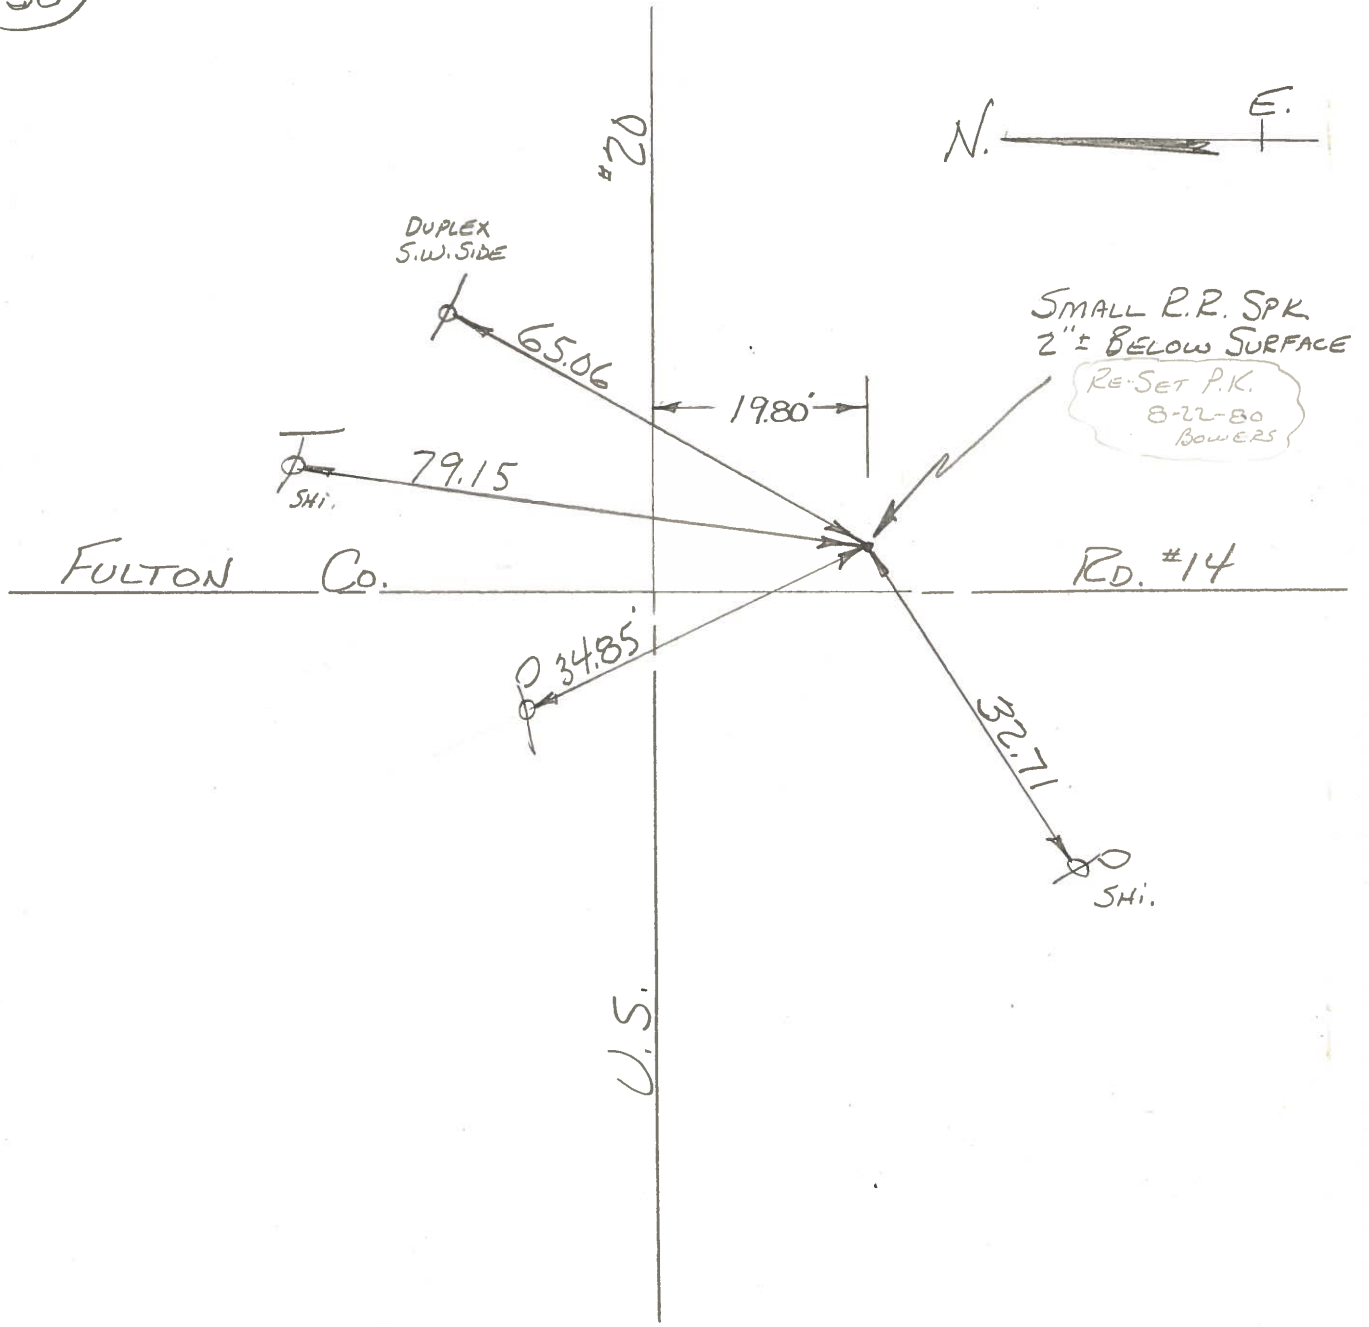

PERSONNEL	TITLE	PERSONNEL	TITLE	COUNTY	DATE	WEATHER	TEMP.
Tomsic		Boyle		Fulton	June 12, 1977		
Neuser				S. R. U.S. 20			
Granata				SEC. Chesterfield TWP.			
Janyo							

DESCRIPTION \_\_\_\_\_ LEFT \_\_\_\_\_ CENTER LINE \_\_\_\_\_ RIGHT \_\_\_\_\_ JOB NO. \_\_\_\_\_

