
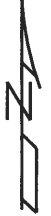


O.D.O.T. DISTRICT 2 SURVEY OFFICE (USE ONLY)


PERSONNEL _____ REFERENCE NO. 32 SHEET 10 OF 21
 NOTES HAGEMeyer _____ DATE 6/25/18 ROUTE US 20
 H.C. LEU _____ WEATHER CLEAR COUNTY FULTON
 R.C. HAGEMeyer _____ TEMP. 68° TOWNSHIP ROYALTON
 _____ SECTION 19
 _____ T 9 S R 3 E

TYPE MONUMENT _____ SET MAG/WASHER _____
~~ON SURFACE~~ - BELOW _____ ON _____
~~LEFT~~ - Q PAV'T - RIGHT _____ 1' _____
10.1' TO RT EDGE PAVEMENT
 S.L.M. 859+42.12

GRID: NORTHING: 733828.884 EASTING: 1530351.632

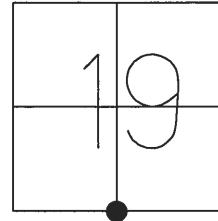


RECORD:
 FD R.R.SPIKE
 6/04/09, DCH
 RESET MAG/WASHER
 8/03/09M, DCH
 FD MAG/WASHER
 REF 32
 9-22-15, JFO
 SET MAG/WASHER
 6-25-18, JLL

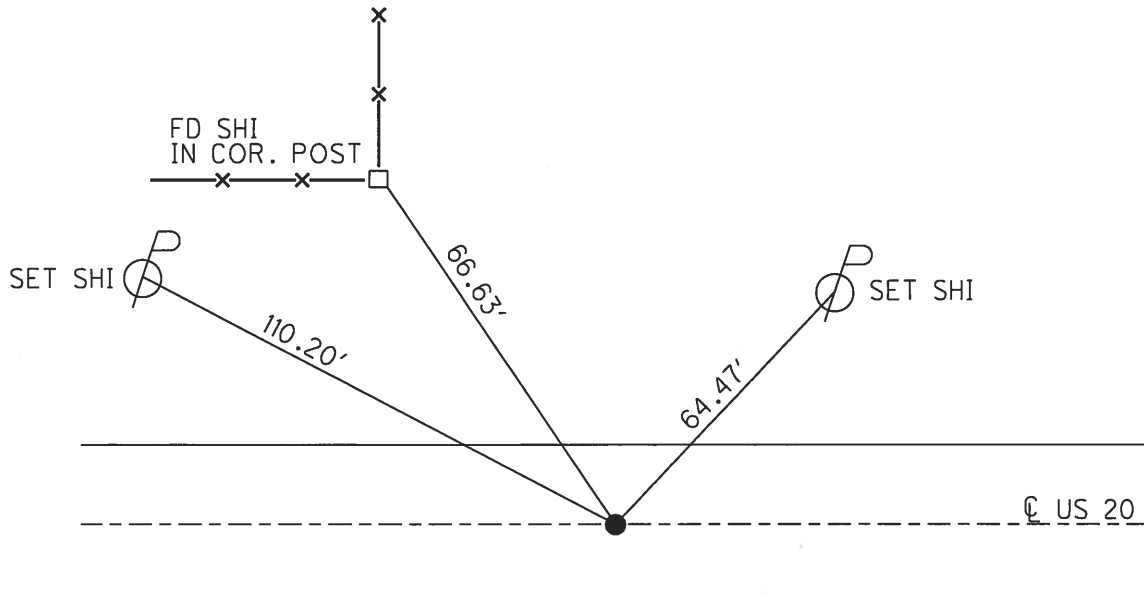


O.D.O.T. DISTRICT 2 SURVEY OFFICE (USE ONLY)

PERSONNEL	REFERENCE NO.	<u>32</u>	SHEET	<u>7</u>	OF	<u>17</u>
NOTES	<u>HOMAN</u>	DATE	<u>6/4/09</u>	ROUTE	<u>US 20</u>	
H.C.	<u>HOMAN</u>	WEATHER	<u>CLEAR</u>	COUNTY	<u>FULTON</u>	
R.C.	<u>ROUSOS</u>	TEMP.	<u>69°</u>	TOWNSHIP	<u>ROYALTON</u>	
				SECTION	<u>19</u>	
				T	<u>9</u>	R
				S	<u>2</u>	E

TYPE MONUMENT R.R.SPIKE
~~ON SURFACE~~ - BELOW 9"
 LEFT - ☉ PAV'T - RIGHT ON
TO EDGE PAVEMENT
 S.L. M59+42

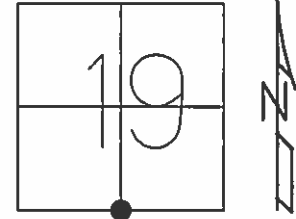

GRID: NORTHING: 733828.835 EASTING: 1530351.590

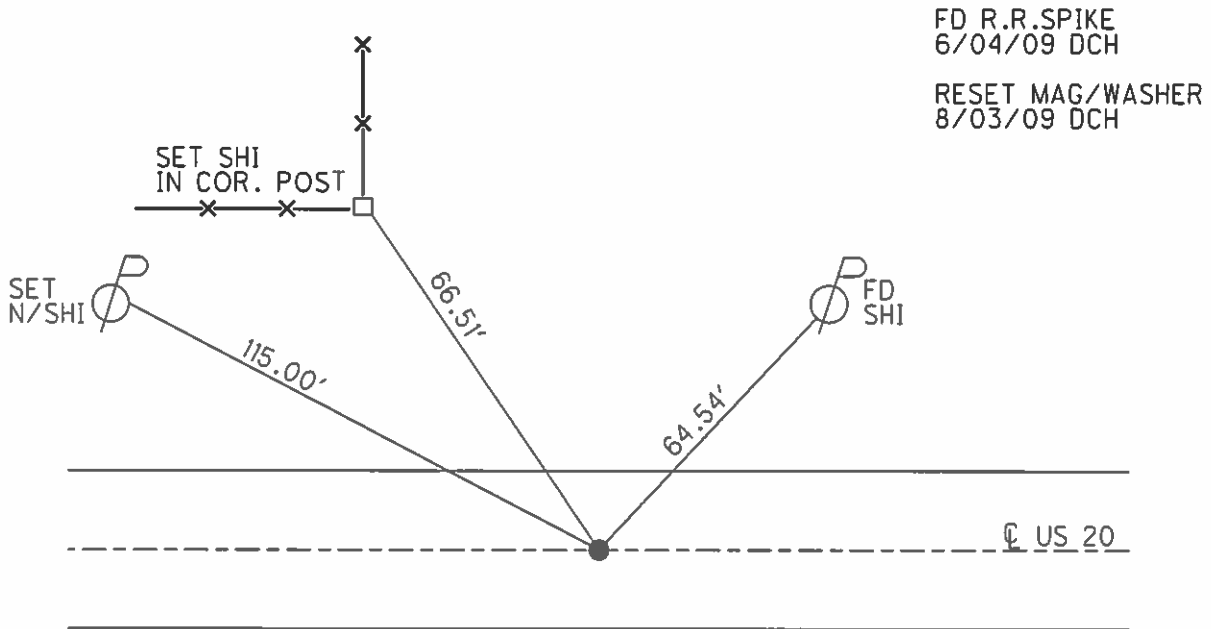

County FULTON SR. U.S. 20

Date 3-11-80

Township ROYALTON


Weather CLEAR

Section 19

Temp. +30°

~~T9N5~~ R2E


Personnel BOWERS
MEAD

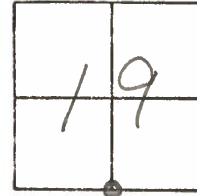

Sta 865+93

#32

ALL TIES GONE
COULD NOT LOCATE

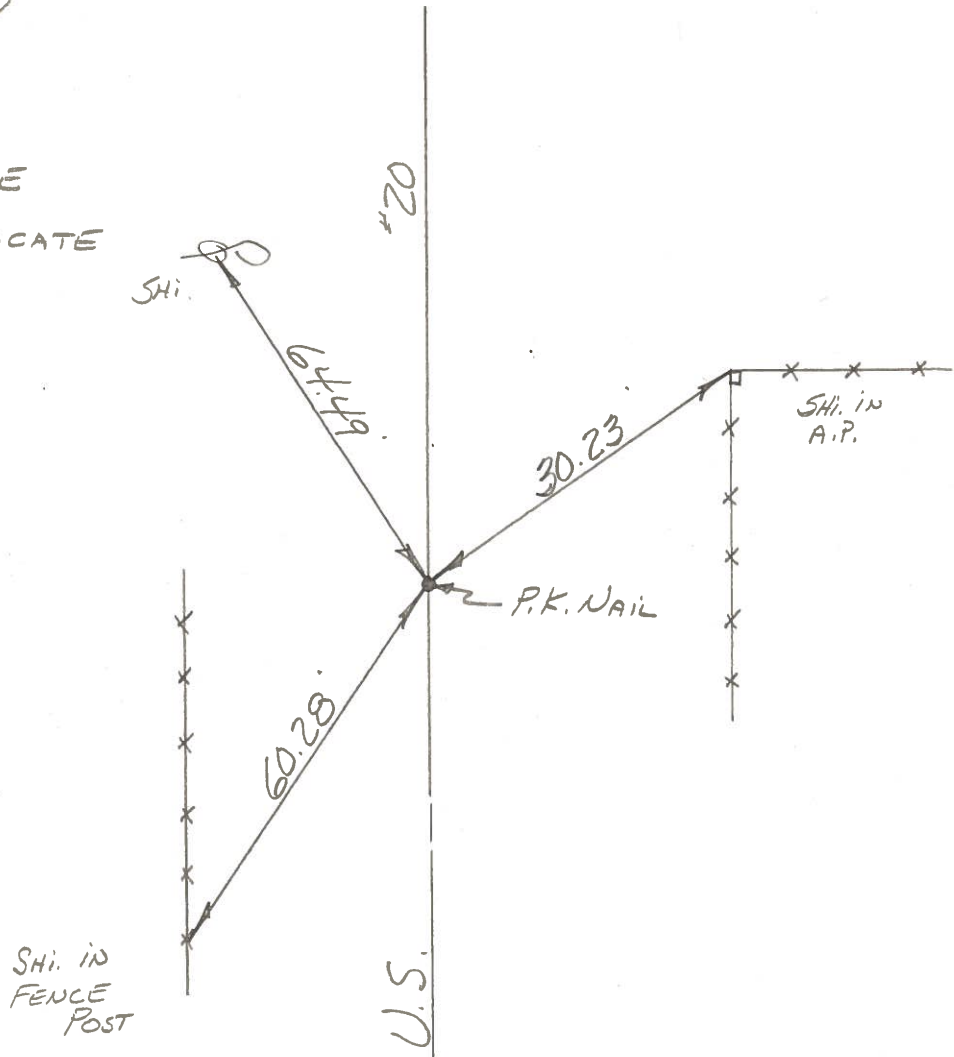

PERSONNEL	TITLE	PERSONNEL	TITLE	COUNTY	DATE	WEATHER	TEMP
Tomsic		Boyle		Fulton	JUNE 14, 1975		
Neuser				S. R. U.S. 20			
Grunata				SEC. Royalton TWP.			
Vanyo							

DESCRIPTION _____ LEFT _____ CENTER LINE _____ RIGHT _____ JOB NO. _____

