


O.D.O.T. DISTRICT 2 SURVEY OFFICE (USE ONLY)

PERSONNEL _____ REFERENCE NO. 33 SHEET 11 OF 21


NOTES RHOADES _____ DATE 3/29/17 ROUTE US 20
 H.C. O'DONNELL _____ WEATHER CLEAR COUNTY FULTON
 R.C. HELDMAN _____ TEMP. 40° TOWNSHIP ROYALTON
 _____ SECTION 19
 T 9 S R 3 E

TYPE MONUMENT _____ MAG/WASHER _____
 ON SURFACE - ~~BELOW~~ _____ ON _____
~~LEFT~~ - C PAV'T - RIGHT _____ 0.6' _____
 _____ TO _____ EDGE PAVEMENT _____
 S.L.M. 885+82.06

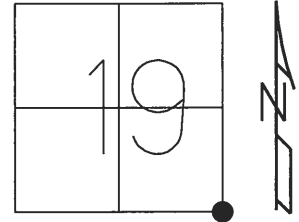

GRID: NORTHING: 733844.999 EASTING: 1532990.524


RECORD:
 SET P.K. NAIL
 8-5-87
 FD P.K.NAIL
 5-9-08, DCH
 RESET MAG/WASHER
 8-03-09, DCH
 FD MAG/WASHER
 REF33
 9-2-15, JFO
 SET MAG/WASHER
 06-25-18

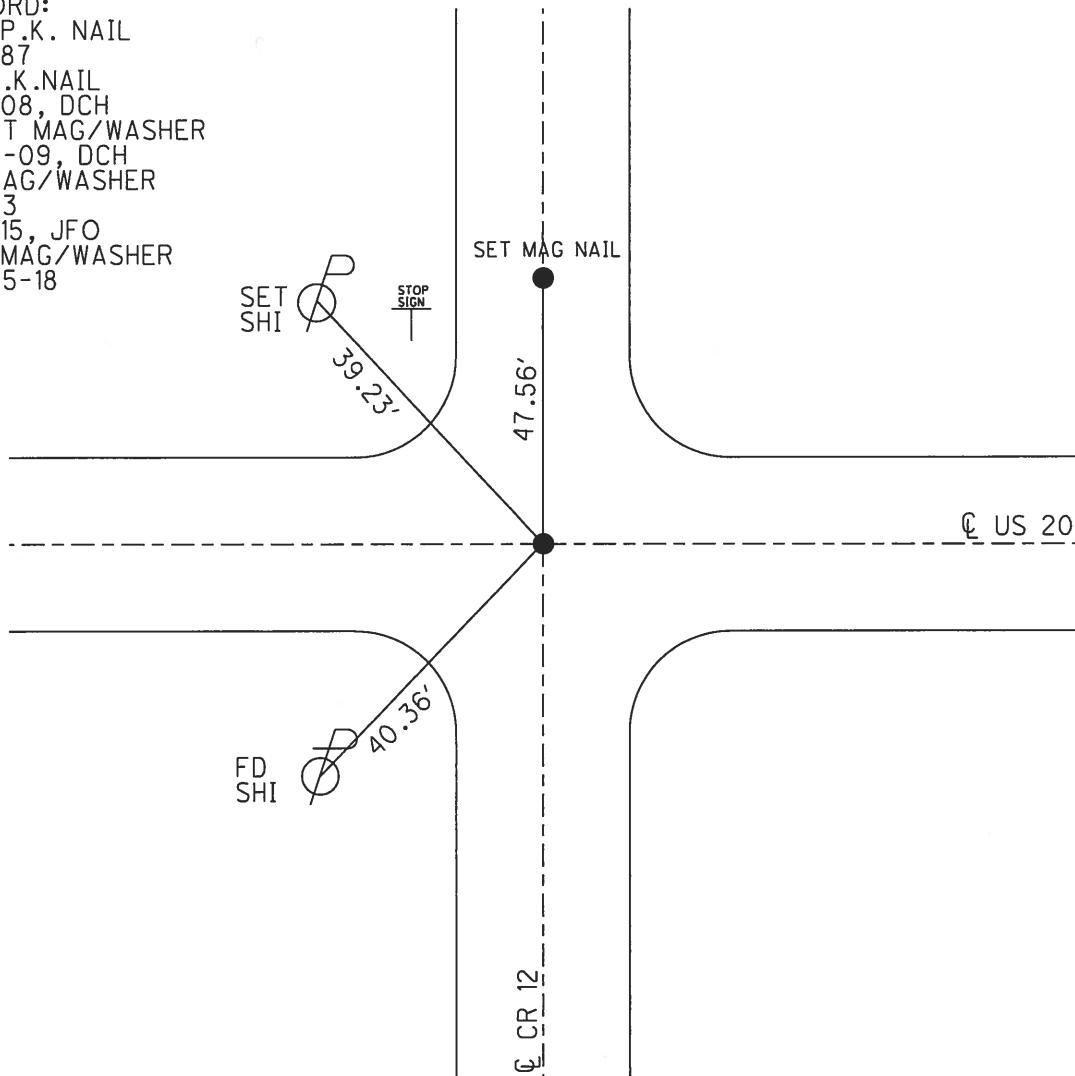

O.D.O.T. DISTRICT 2 SURVEY OFFICE (USE ONLY)

PERSONNEL _____ REFERENCE NO. 33 SHEET 8 OF 17
 NOTES ROUSOS DATE 5/29/09 ROUTE US 20
 H.C. HOMAN WEATHER CLEAR COUNTY FULTON
 R.C. ROUSOS TEMP. 69° TOWNSHIP ROYALTON
 _____ SECTION 19
 _____ T 9 S R 2 E

TYPE MONUMENT P.K.NAIL
 ON SURFACE - ~~BELOW~~ ON _____
 LEFT - ☉ PAV'T - RIGHT ON
 _____ TO _____ EDGE PAVEMENT
 S.L.M. 885+82.10

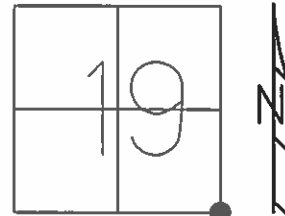


GRID: NORTHING 733848.475 EASTING: 1512329.669

SET P.K.NAIL
 TO SURFACE 8/5/87

FD P.K.NAIL
 5/9/08 DCH

RESET MAG/WASHER
 8/03/09 DCH

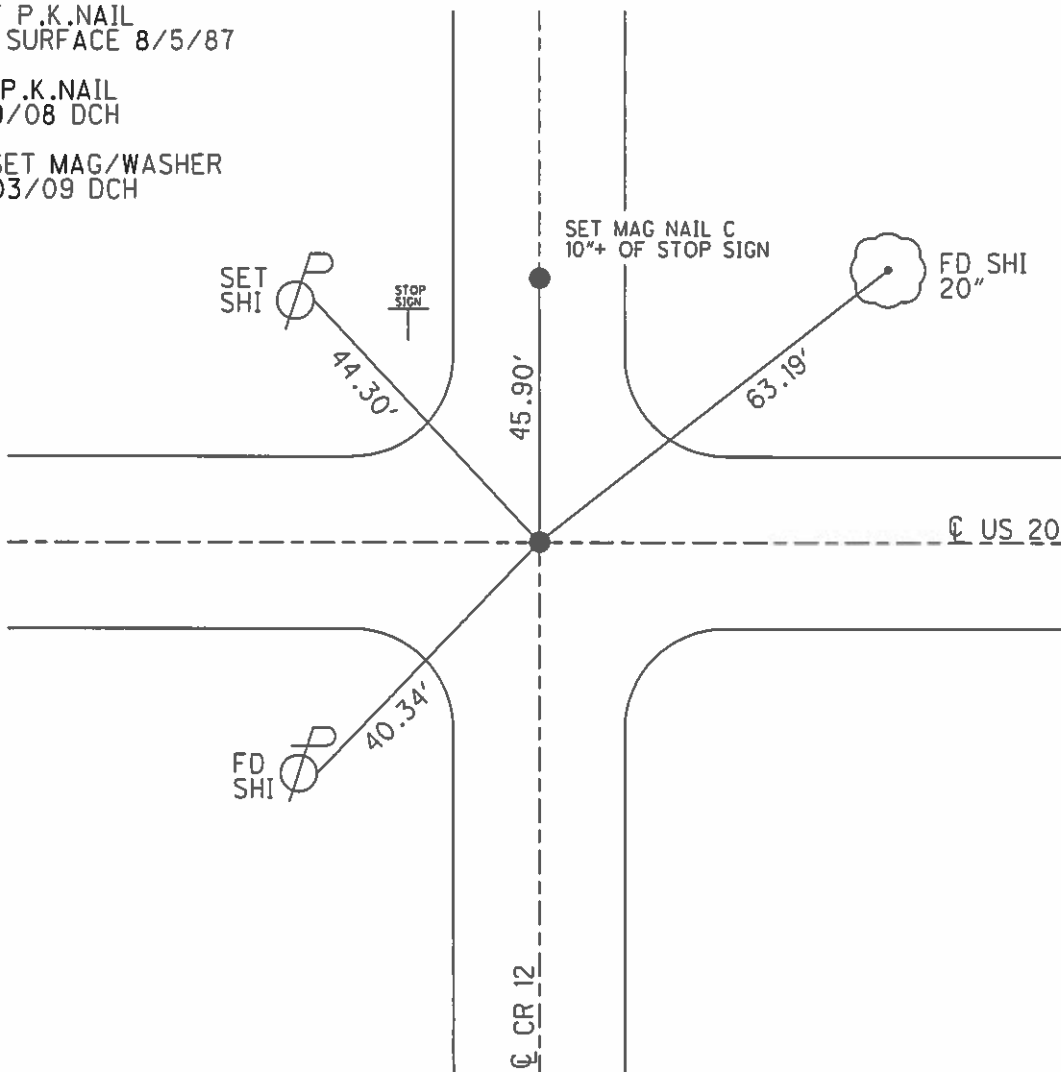

O.D.O.T. DISTRICT 2 SURVEY OFFICE

PERSONNEL

REFERENCE NO. 33

SHEET 4 OF 12

NOTES J. Householder

H.C. D. Curtis

R.C. I. Stone

R. Michalak

DATE March 5, 1986

WEATHER Cloudy

TEMP. +36°

ROUTE U.S. 20

COUNTY Fulton

TOWNSHIP Royalton

SECTION 19

T. R.


TYPE MONUMENT P.K. Nail

ON SURFACE - BELOW Surface


LEFT- & PAV'T. - RIGHT

TO EDGE PAVEMENT

S.L.M. 891 + 64

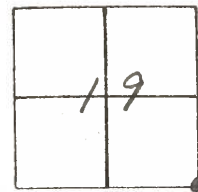

SET P.K. NAIL TO SURFACE
8-5-87

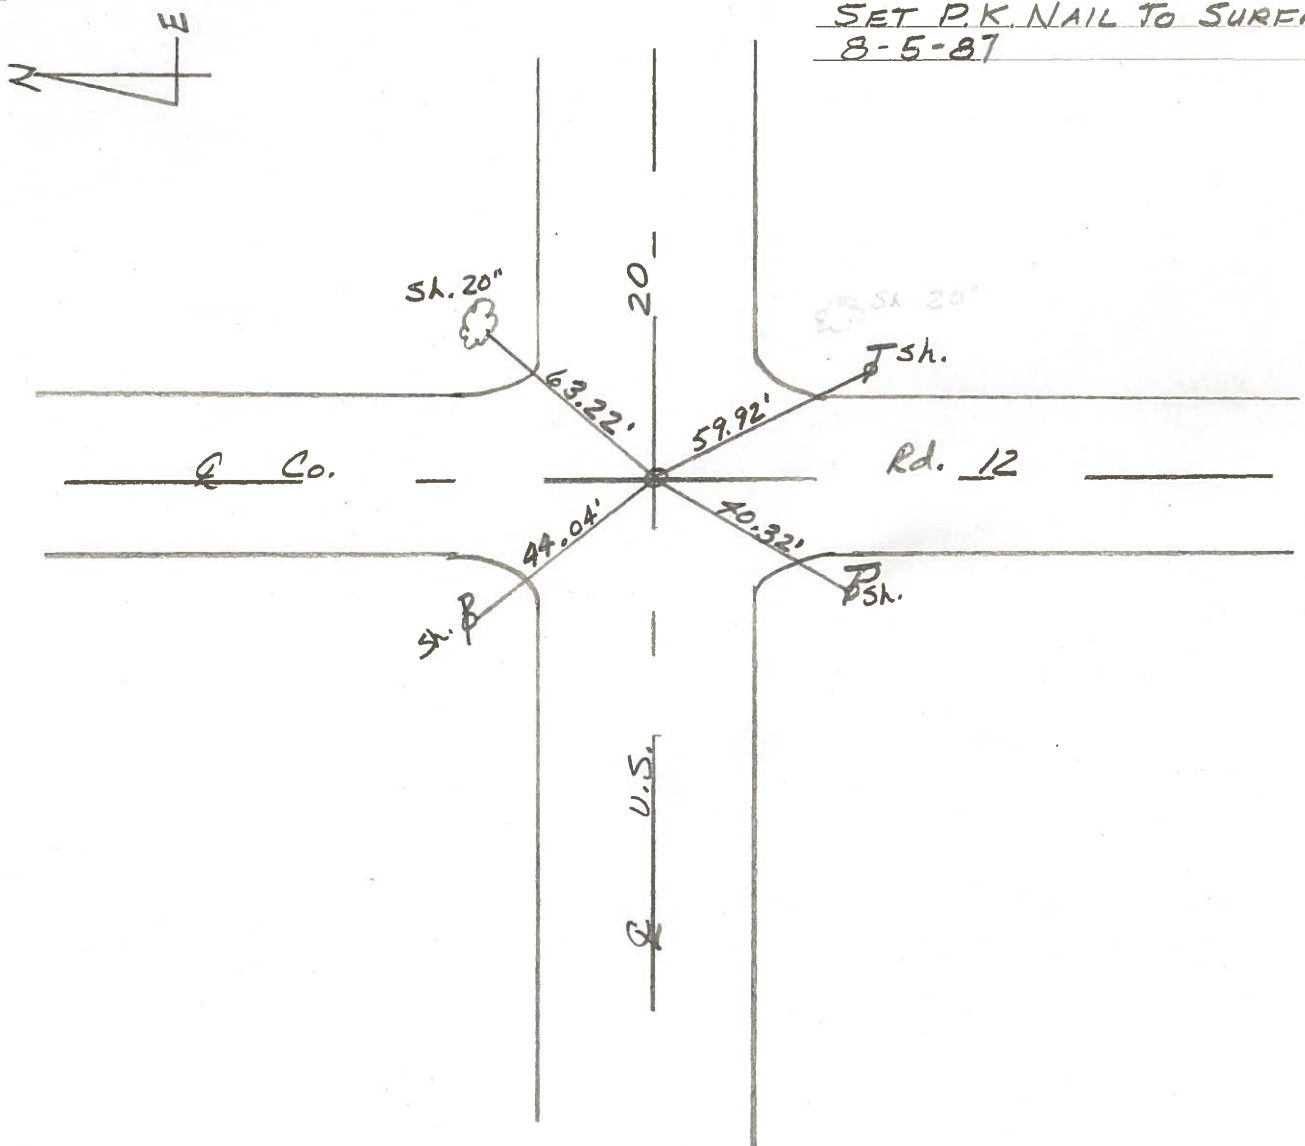

County FULTON ~~S.R.~~ U.S. 20

Date 3-11-80

Township ROYALTON


Weather CLEAR

Section 19

Temp. +30°

~~T9 N5~~ R3E


Personnel BOWERS

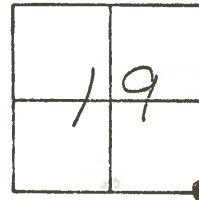

#33

P.K. NAIL

RE-SET P.K.
8-25-80
SMITH

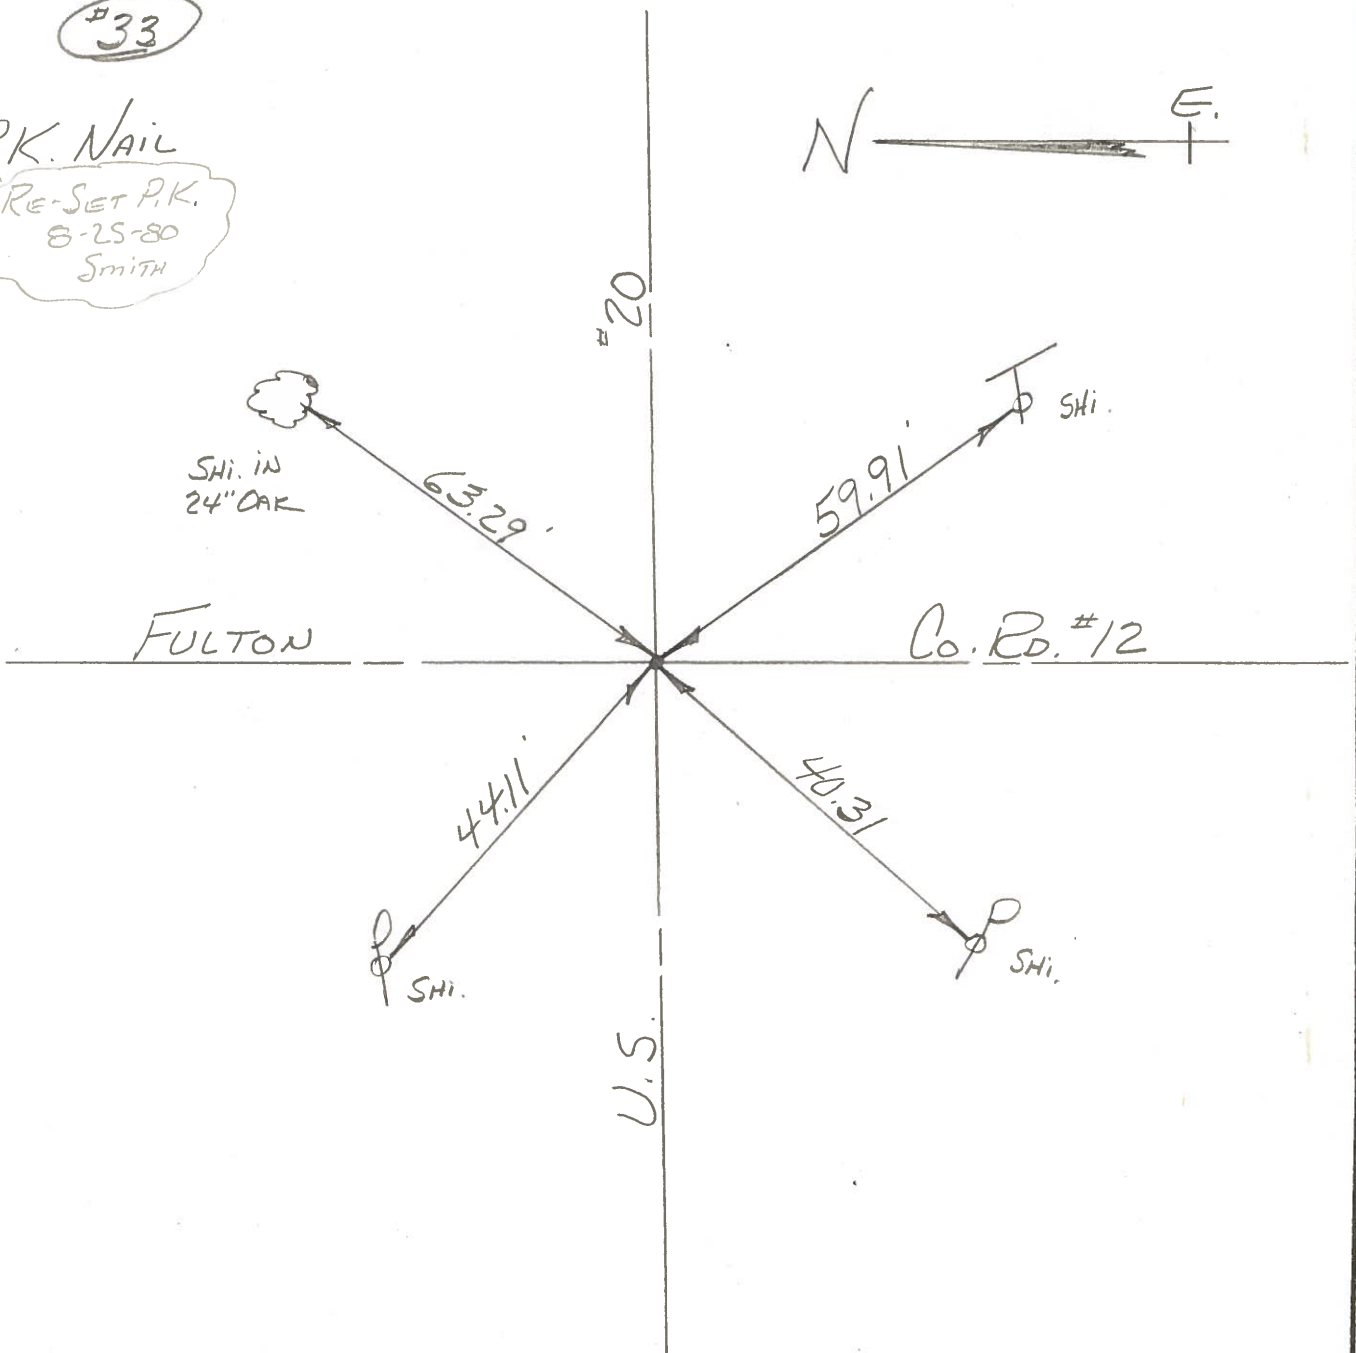

PERSONNEL	TITLE	PERSONNEL	TITLE	COUNTY	Fulton	DATE	JUNE 14, 1973
Tomsic		Boyle		S. R.	U.S. 20	WEATHER	
Neuser				SEC.	Royalton TWP.	TEMP.	
Grunata							
Vanyo							

DESCRIPTION _____ LEFT _____ CENTER LINE _____ RIGHT _____ JOB NO. _____

