


O.D.O.T. DISTRICT 2 SURVEY OFFICE (USE ONLY)


PERSONNEL	REFERENCE NO.	<u>36</u>	SHEET	<u>15</u>	OF	<u>21</u>
NOTES	RHOADES	DATE	<u>3/29/17</u>	ROUTE	<u>US 20</u>	
H.C.	<u>O'DONNELL</u>	WEATHER	<u>CLEAR</u>	COUNTY	<u>FULTON</u>	
R.C.	<u>HELDMAN</u>	TEMP.	<u>40°</u>	TOWNSHIP	<u>ROYALTON</u>	
				SECTION	<u>21</u>	
				T	<u>9</u>	S
				R	<u>3</u>	E

TYPE MONUMENT _____ MAG/WASHER _____
 ON SURFACE - ~~BELOW~~ _____ ON _____
~~LEFT~~ - C PAV'T - ~~RIGHT~~ _____ ON _____
 _____ TO _____ EDGE PAVEMENT
 S.L.M. 952+25.89

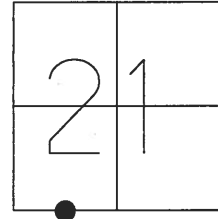

GRID: NORTHING: 733868.095 EASTING: 1539634.304

RECORD:
 SET P.K. NAIL
 8/6/87
 FD P.K. NAIL
 5/9/08, DCH
 RESET MAG/WASHER
 8/3/09, DCH
 FD MAG/WASHER
 REF36
 9-22-15, JFO
 SET MAG/WASHER
 6-25-18, JLL

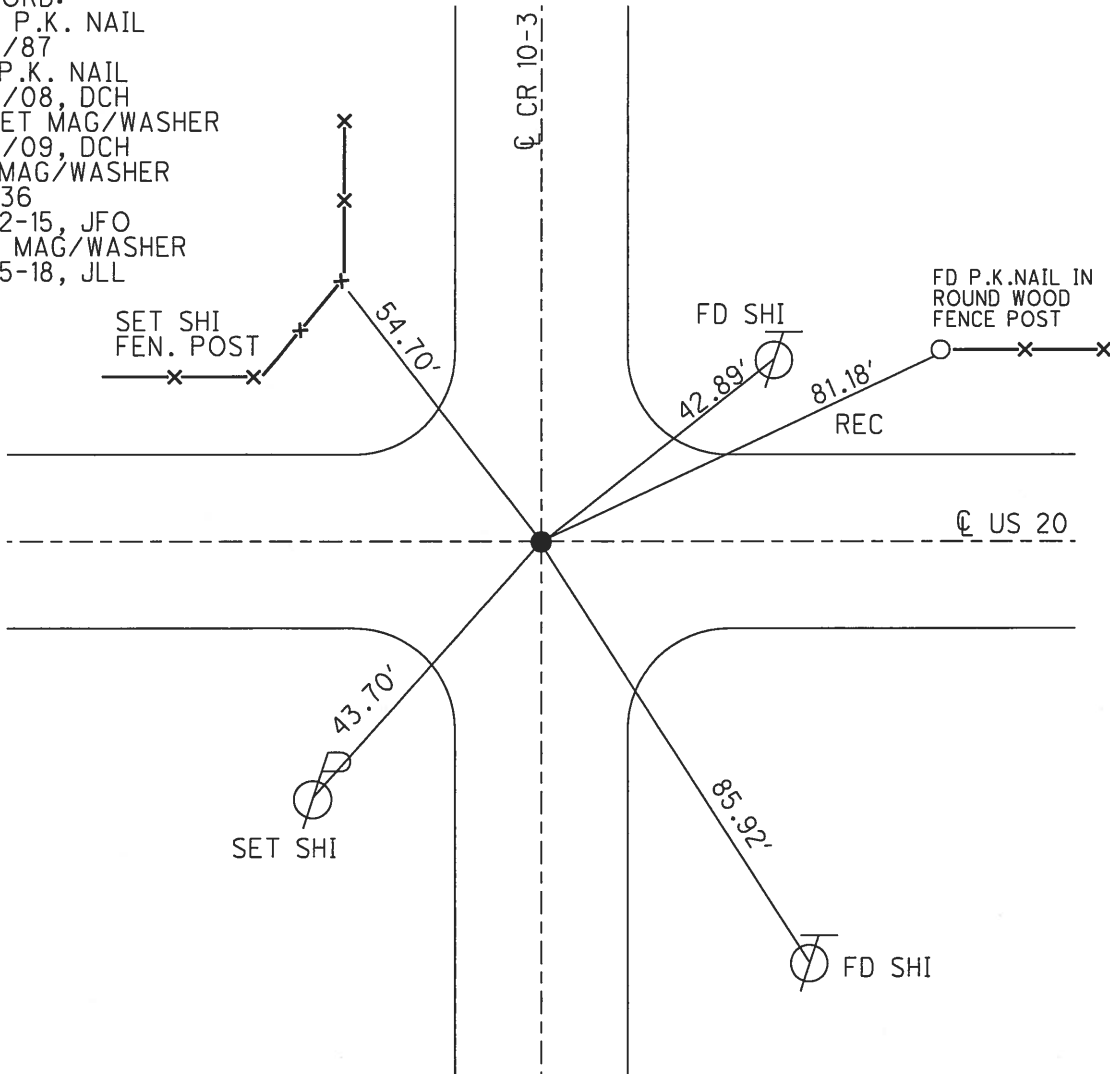


FD P.K.NAIL IN
 ROUND WOOD
 FENCE POST


O.D.O.T. DISTRICT 2 SURVEY OFFICE (USE ONLY)

PERSONNEL _____ REFERENCE NO. 36 SHEET 11 OF 17
 NOTES ROUSOS DATE 5/29/08 ROUTE US 20
 H.C. HOMAN WEATHER CLEAR COUNTY FULTON
 R.C. ROUSOS TEMP. 69° TOWNSHIP ROYALTON
 _____ SECTION 21
 _____ T 9 S R 2 E

TYPE MONUMENT P.K.NAIL
 ON SURFACE - ~~BELOW~~ ON
 LEFT - ☉ PAV'T - RIGHT ON
_____ TO _____ EDGE PAVEMENT
 S.L.M. 952+25.79
 GRID: NORTHING: 733868.097 EASTING: 1539634.264

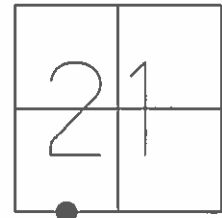

SET P.K.NAIL
 TO SURFACE
 8/6/87
 FD P.K. NAIL
 5/9/08 DCH
 RESET MAG/WASHER
 8/3/09 DCH

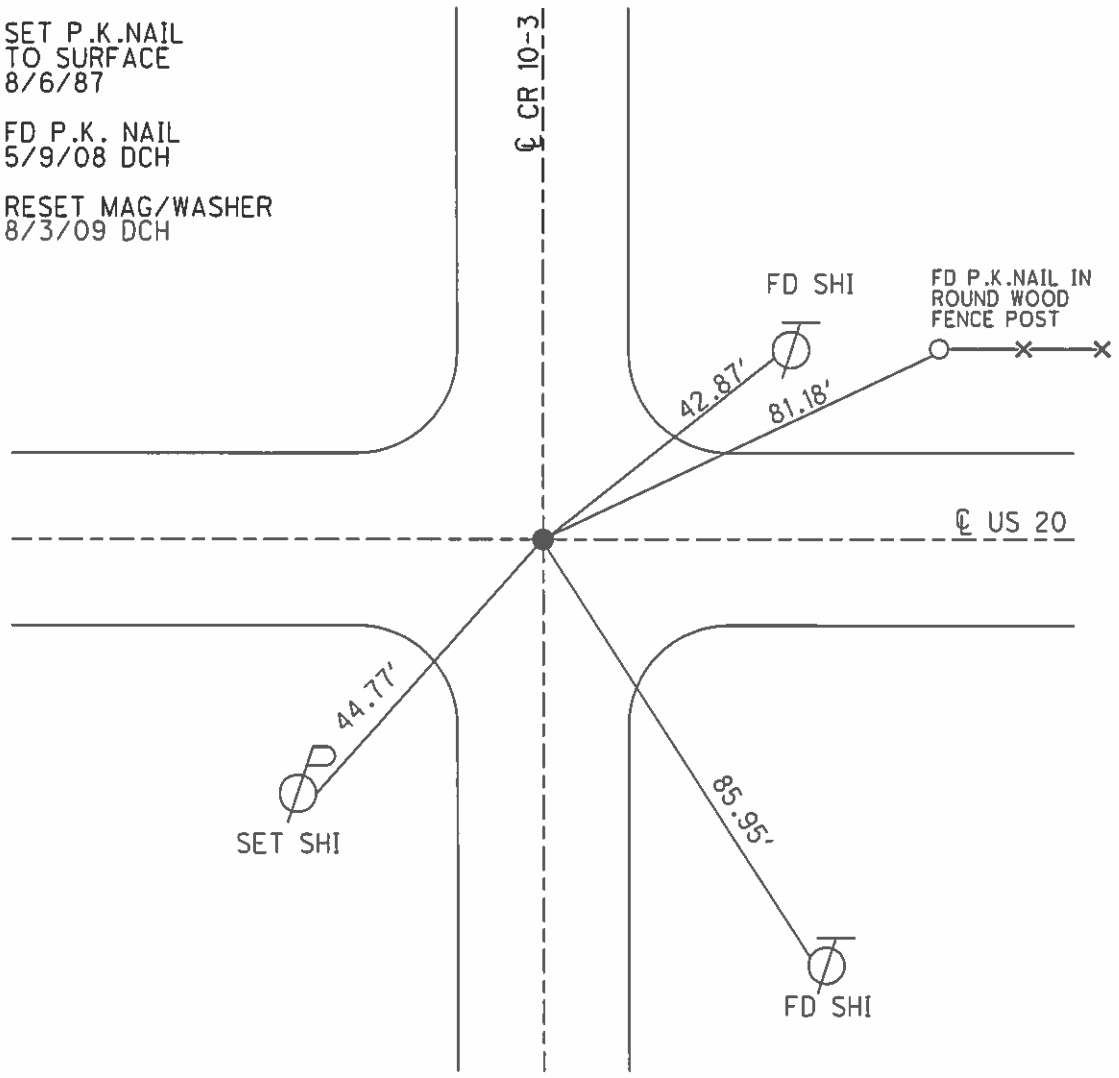

O.D.O.T. DISTRICT 2 SURVEY OFFICE

PERSONNEL

REFERENCE NO. 36

SHEET 7 OF 12

NOTES J. Householder

H.C. D. Curtis

R.C. R. Michalak

DATE March 21, 1986

WEATHER P. Cloudy

TEMP. 25°

ROUTE U.S. 20

COUNTY Fulton

TOWNSHIP Royalton

SECTION 21

T. R.


TYPE MONUMENT P.K. Nail

ON SURFACE - BELOW Surface


LEFT - ☉ PAV'T. - RIGHT

 TO EDGE PAVEMENT

S.L.M.

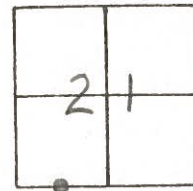

SET P.K. NAIL TO SURFACE
8-6-87

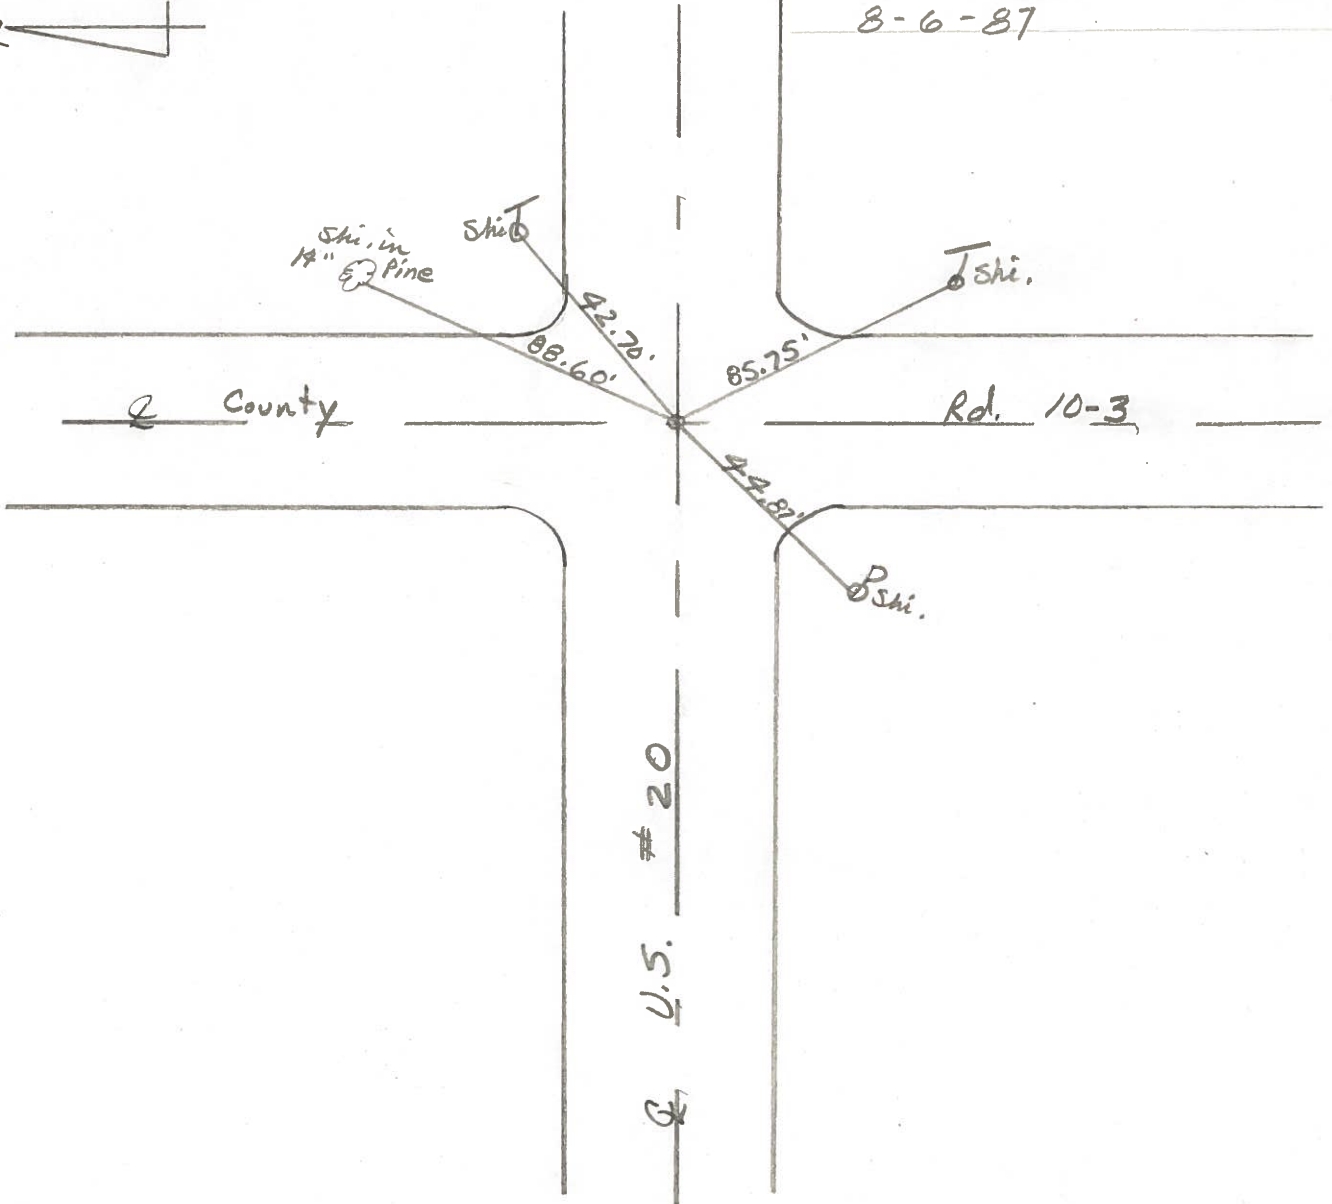

County FULTON SR. U.S. 20

Date 3-11-80

Township ROYALTON


Weather CLEAR

Section 21


Temp. +30°

T9N, R3E

Personnel BOWERS

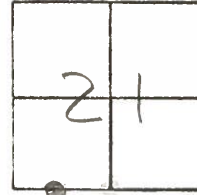

#36

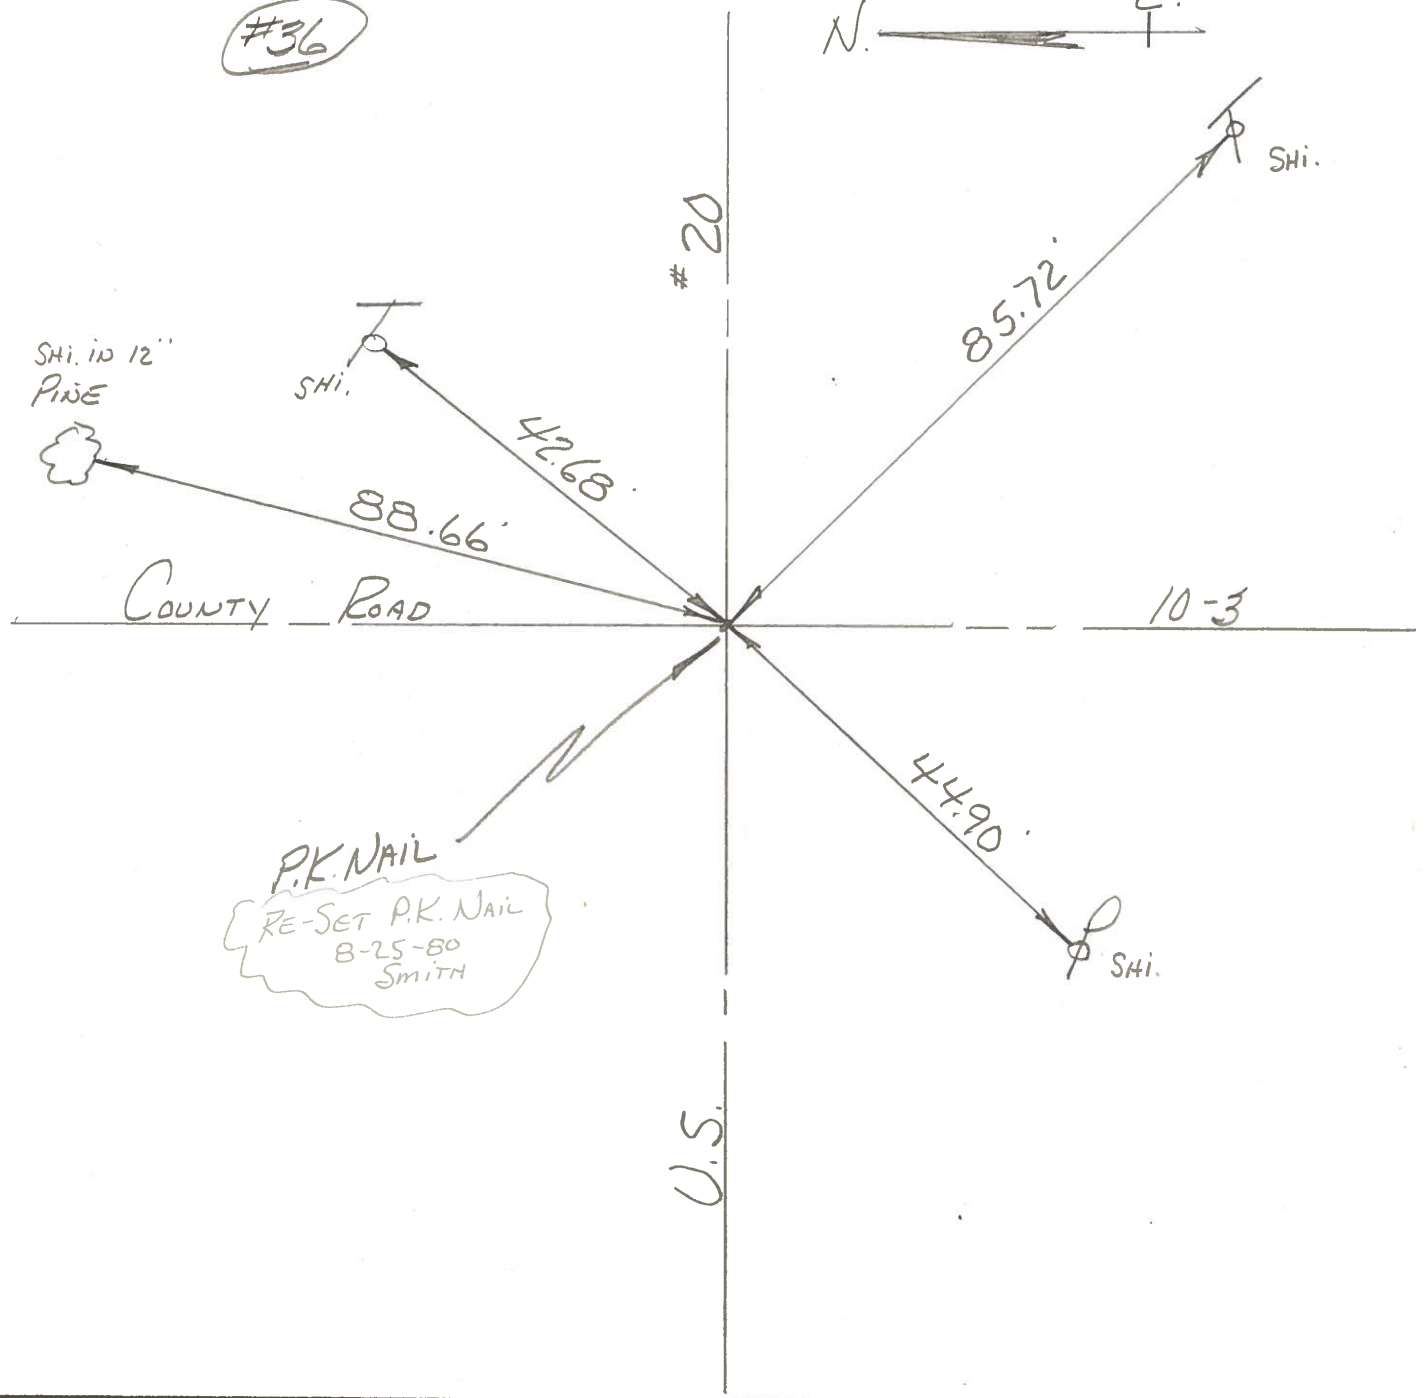

PERSONNEL	TITLE	PERSONNEL	TITLE	COUNTY	DATE	WEATHER	TEMP
Tomsic		Boyle		Fulton	JUN 13, 1973		
Neuser				U.S. 20			
Granata				Royalton TWP.			
Vanyo							

DESCRIPTION LEFT CENTER LINE RIGHT JOB NO.

