
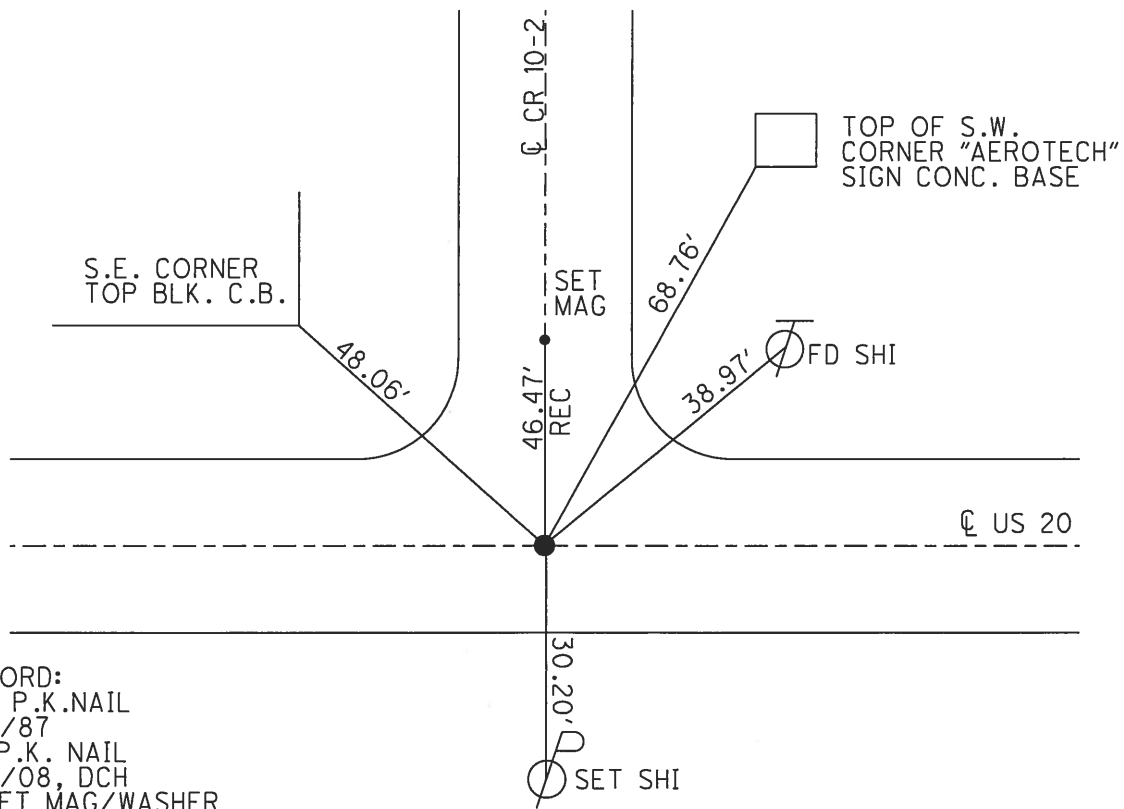


O.D.O.T. DISTRICT 2 SURVEY OFFICE (USE ONLY)

PERSONNEL _____ REFERENCE NO. 37 SHEET 16 OF 21
 NOTES RHOADES DATE 3/29/17 ROUTE US 20
 H.C. O'DONNELL WEATHER CLEAR COUNTY FULTON
 R.C. HELDMAN TEMP. 40° TOWNSHIP ROYALTON
 _____ SECTION 21
 _____ T 9 S R 3 E

TYPE MONUMENT _____ MAG/WASHER _____
 ON SURFACE - ~~BELOW~~ _____ ON _____
~~LEFT~~ - Q PAV'T - ~~RIGHT~~ _____ ON _____
11.9' TO RT EDGE PAVEMENT
 S.L.M. 965+45.63
 GRID: NORTHING: 733870.566 EASTING: 1540954.049

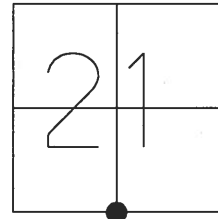



RECORD:
 SET P.K.NAIL
 8/6/87
 FD P.K. NAIL
 5/9/08, DCH
 RESET MAG/WASHER
 8/3/09, DCH
 FD MAG/WASHER
 REF37
 9-22-15, JFO
 SET ,AH/WASHER
 6-25-18, JLL

O.D.O.T. DISTRICT 2 SURVEY OFFICE (USE ONLY)

PERSONNEL	REFERENCE NO.	<u>37</u>	SHEET	<u>12</u>	OF	<u>17</u>
NOTES	<u>ROUSOS</u>	DATE	<u>6/2/09</u>	ROUTE	<u>US 20</u>	
H.C.	<u>HOMAN</u>	WEATHER	<u>CLOUDY</u>	COUNTY	<u>FULTON</u>	
R.C.	<u>ROUSOS</u>	TEMP.	<u>57°</u>	TOWNSHIP	<u>ROYALTON</u>	
				SECTION	<u>21</u>	
				T	<u>9</u>	S
				R	<u>2</u>	E

TYPE MONUMENT P.K.NAIL
 ON SURFACE - ~~BELOW~~ ON _____
 LEFT - ℄ PAV'T - RIGHT ON _____
 _____ TO _____ EDGE PAVEMENT
 S.L.M. 965+45.57

GRID: NORTHING: 733870.684 EASTING: 1540953.973

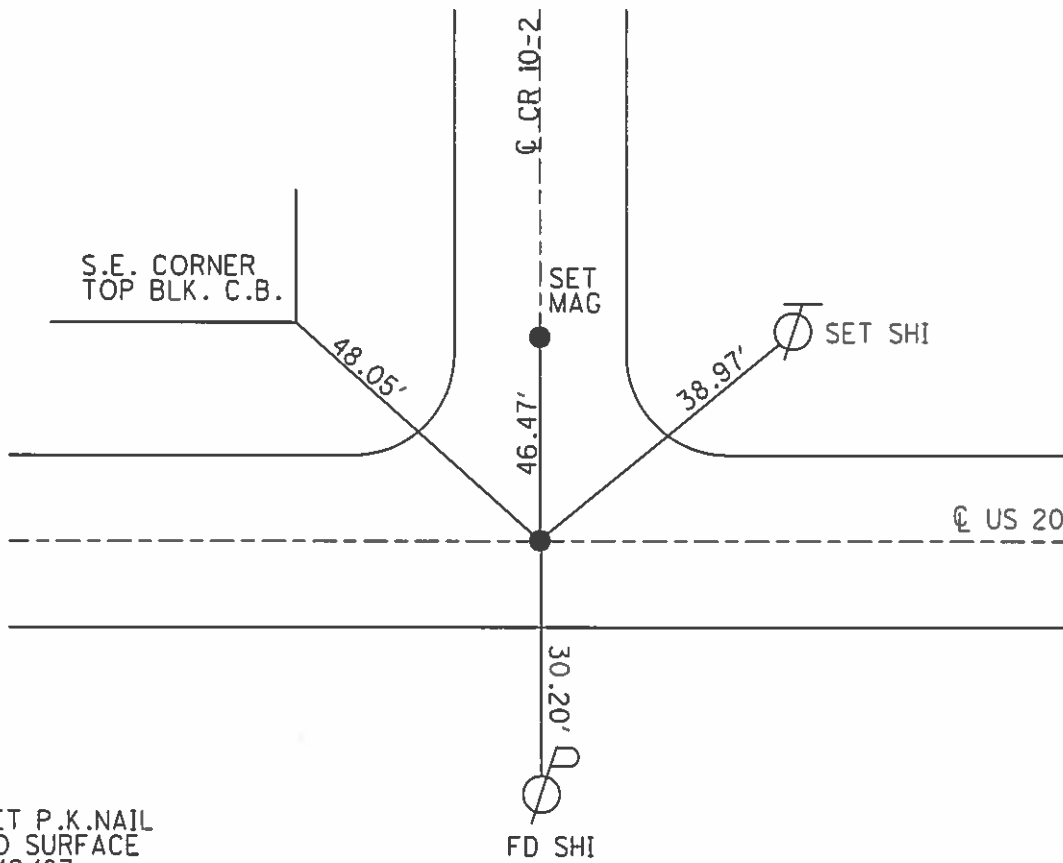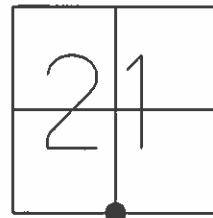

SET P.K.NAIL
 TO SURFACE
 8/6/87

FD P.K. NAIL
 5/9/08 DCH

RESET MAG/WASHER
 8/3/09 DCH

O.D.O.T. DISTRICT 2 SURVEY OFFICE

PERSONNEL

REFERENCE NO. 37 SHEET 8 OF 12

NOTES J. Householder

H.C. D. Curtis

R.C. R. Michalak

DATE March 21, 1986

WEATHER P. Cloudy

TEMP. 25°

ROUTE U.S. 20

COUNTY Fulton

TOWNSHIP Royalton

SECTION 21

T. R.


TYPE MONUMENT P.K. Nail

ON SURFACE - BELOW Surface


LEFT - PAV'T. - RIGHT

TO EDGE PAVEMENT

S.L.M. 971 + 28

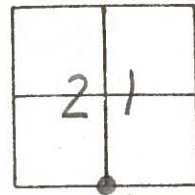

SET P.K. NAIL TO SURFACE
8-6-87

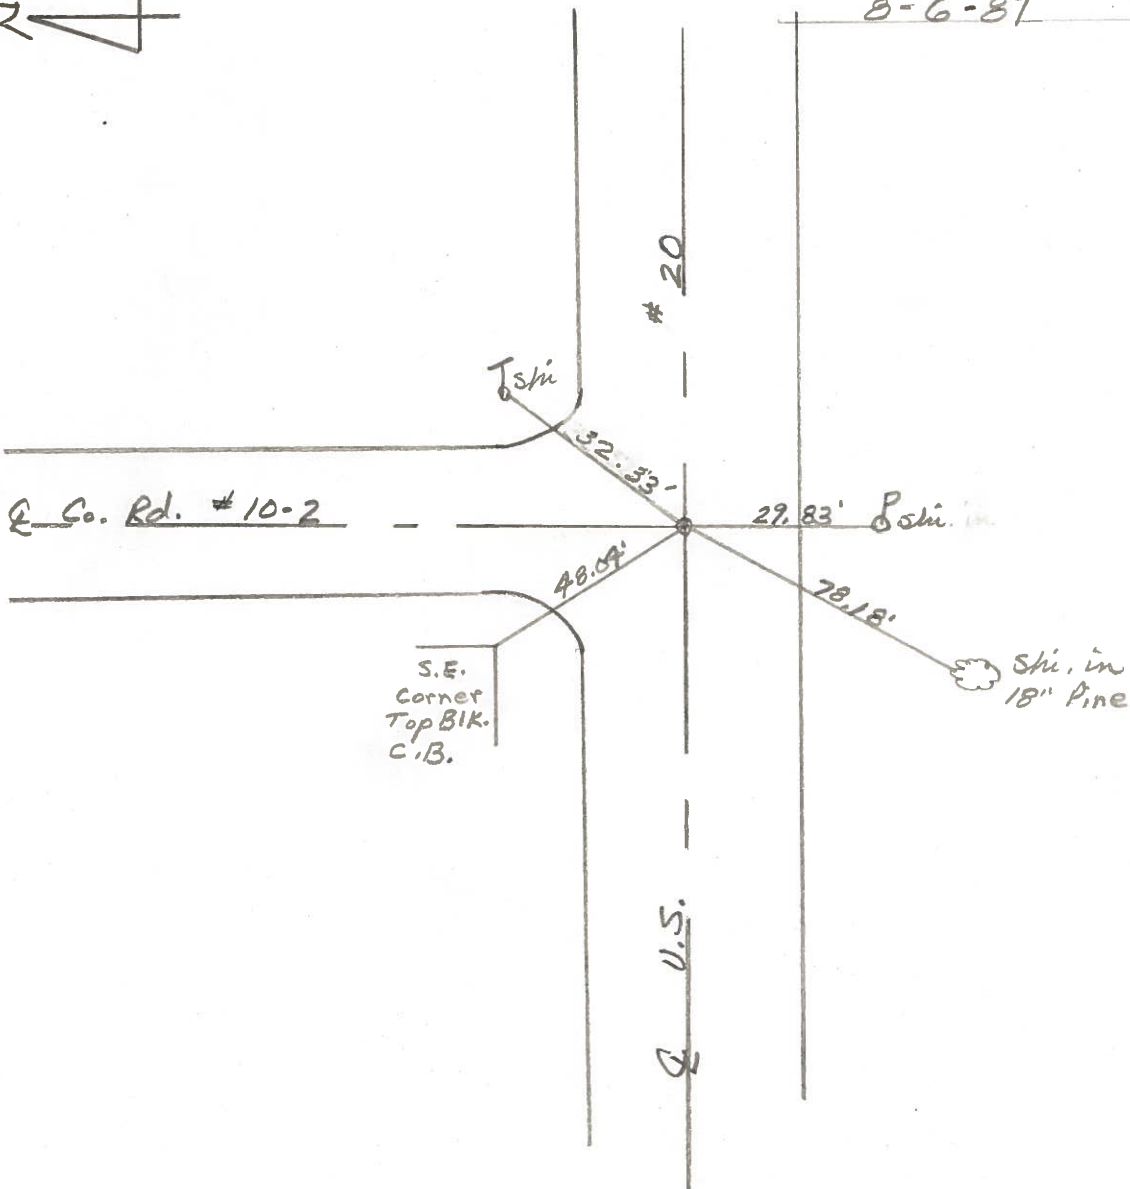

County FULTON S.R. U.S. 20

Date 3-11-80

Township ROYALTON

Weather CLEAR


Section 21

Temp. +30°±

T9NS, R3E


Personnel BOWERS

MEAD

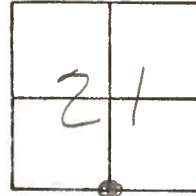

#37

OK 9/19/83
CLOUDY 75°
S.W.H.

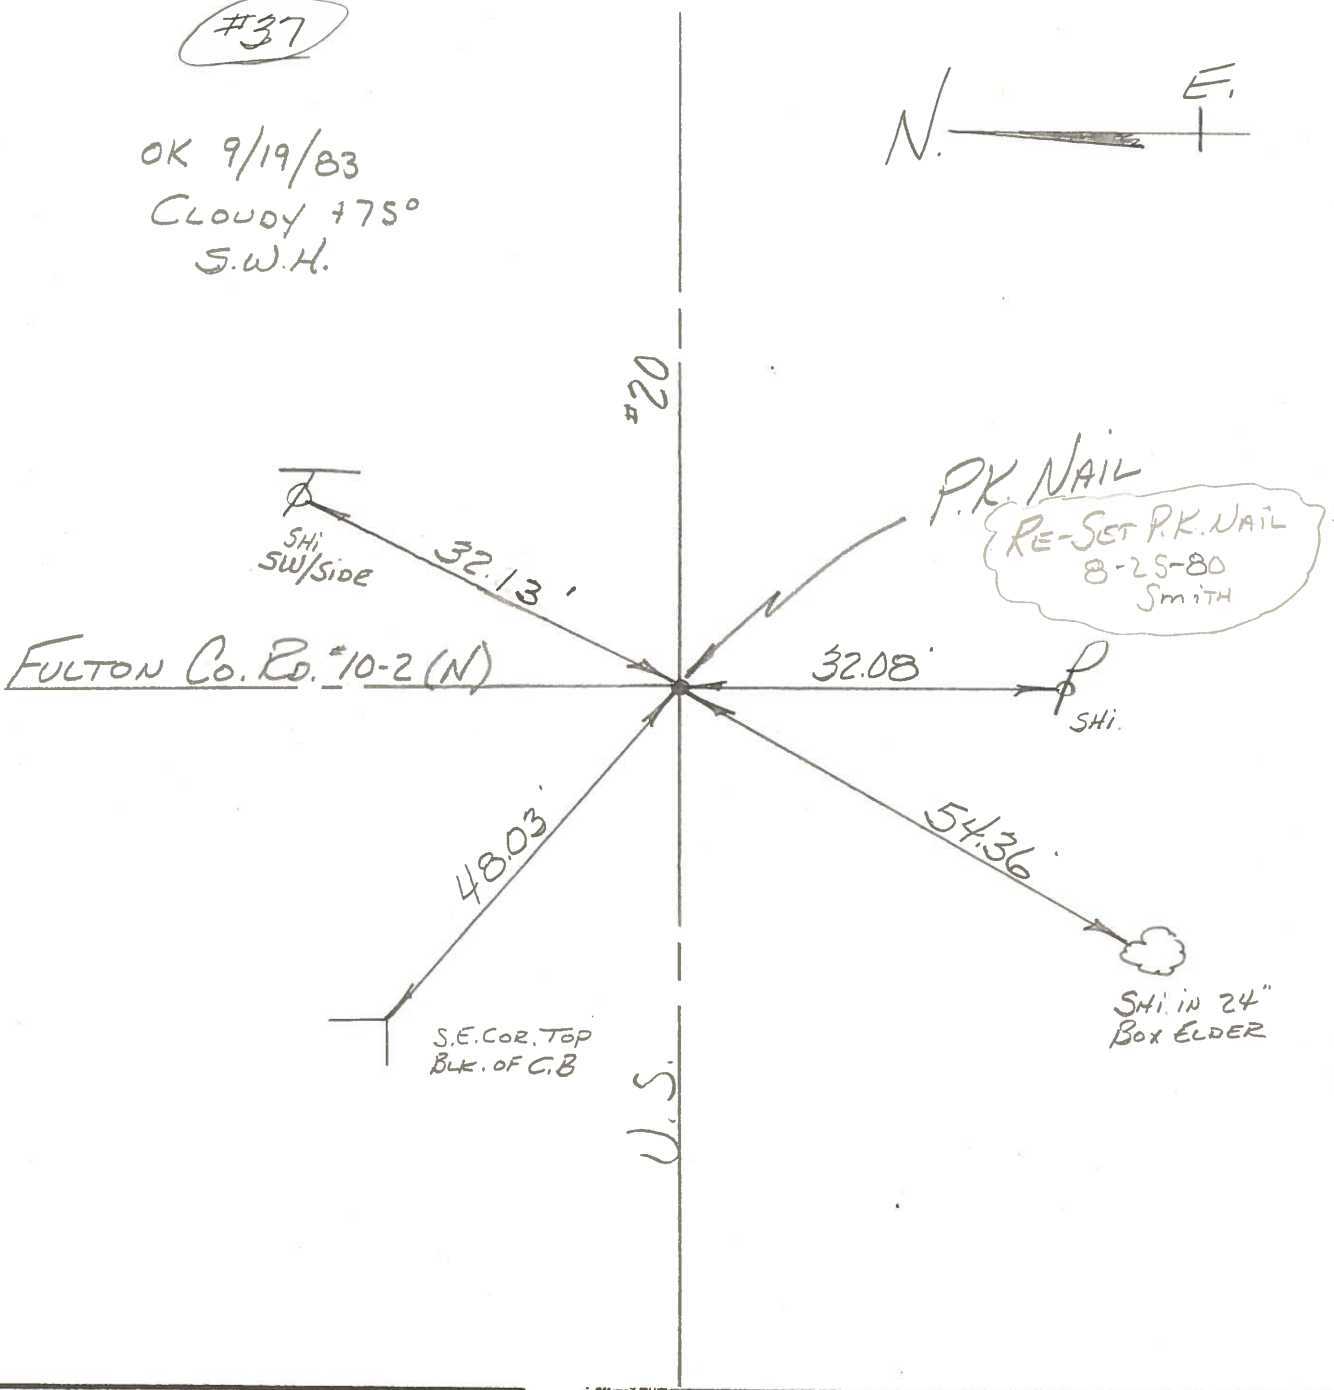

PERSONNEL	TITLE	PERSONNEL	TITLE	COUNTY	DATE	WEATHER	TEMP
Tomsic		Boyle		Fulton	JUN 13, 1973		
Neuser				U.S. 20			
Granata				Royalton Twp.			
Vanyo							

DESCRIPTION LEFT CENTER LINE RIGHT JOB NO.

